


CONTRACTORS SHALL VERIFY JOB DIMENSIONS BEFORE ANY JOB COMMENCES. ALL SHOP DRAWINGS SHALL BE SUBMITTED TO THE SUPERINTENDENT AND MANUFACTURERS SHALL NOT COMMENCE FROM THE RETURN OF DIMENSIONS SHOP DRAWINGS ISSUED BY THE CONSULTANT. FIGURED DIMENSIONS SHALL TAKE PRECEDENCE OVER SCALES. THIS DRAWING SHOULD BE READ IN CONJUNCTION WITH ALL RELEVANT CONTRACT SPECIFICATIONS AND DRAWINGS COPYRIGHT OF THIS DRAWING IS VESTED IN WARDLE.

- General Notes
- REFER TO LANDSCAPE AND CIVIL DRAWINGS
 - SETOUT POINT - NORTHING AND EASTING LOCATION BASED ON AURECON SURVEY DRAWING SV-011 DATED 20.05.11



Rev	Issue	Revision Description	Amd	Date
A	SG	ISSUED FOR CONSTRUCTION	-	18.01.14
12	JW	ISSUED FOR INFORMATION	-	28.03.13
11	VA	TENDER ADDENDUM 4	-	08.10.12
10	SG	100% CD - TENDER ISSUE	-	07.08.12
09	SG	FOR TENDER	-	07.08.12
08	SG	100% ENABLING WORKS - DRAWING ISSUE	-	29.06.12
07	SG	50% CD ISSUE	-	01.06.12
06	SG	55% ENABLING WORKS - DRAWING ISSUE	-	18.05.12
05	SG	25% CD ISSUE	-	20.04.12
04	SG	FINAL DD ISSUE	-	24.02.12
03	SG	DD UPDATE	-	20.01.12
02	SG	PRELIMINARY DD	-	28.10.11
01	SG	PRELIMINARY DD	-	07.10.11
S01	SG	PRELIMINARY SD	-	13.05.11
S02	JW	PRELIMINARY SD	-	31.05.11
S03	SG	PRELIMINARY SD	-	03.06.11
S04	SG	PRELIMINARY SD	-	10.06.11
S05	SG	PRELIMINARY SD	-	23.06.11
S06	SG	PRELIMINARY SD - COST PLAN C1 ISSUE	-	30.06.11
S07	JW	PRELIMINARY SD - ISSUE FOR CLIENT REVIEW	-	13.07.11
S08	SG	SD - DRAFT ISSUE	-	19.07.11
S09	SG	SD ISSUE	-	29.07.11

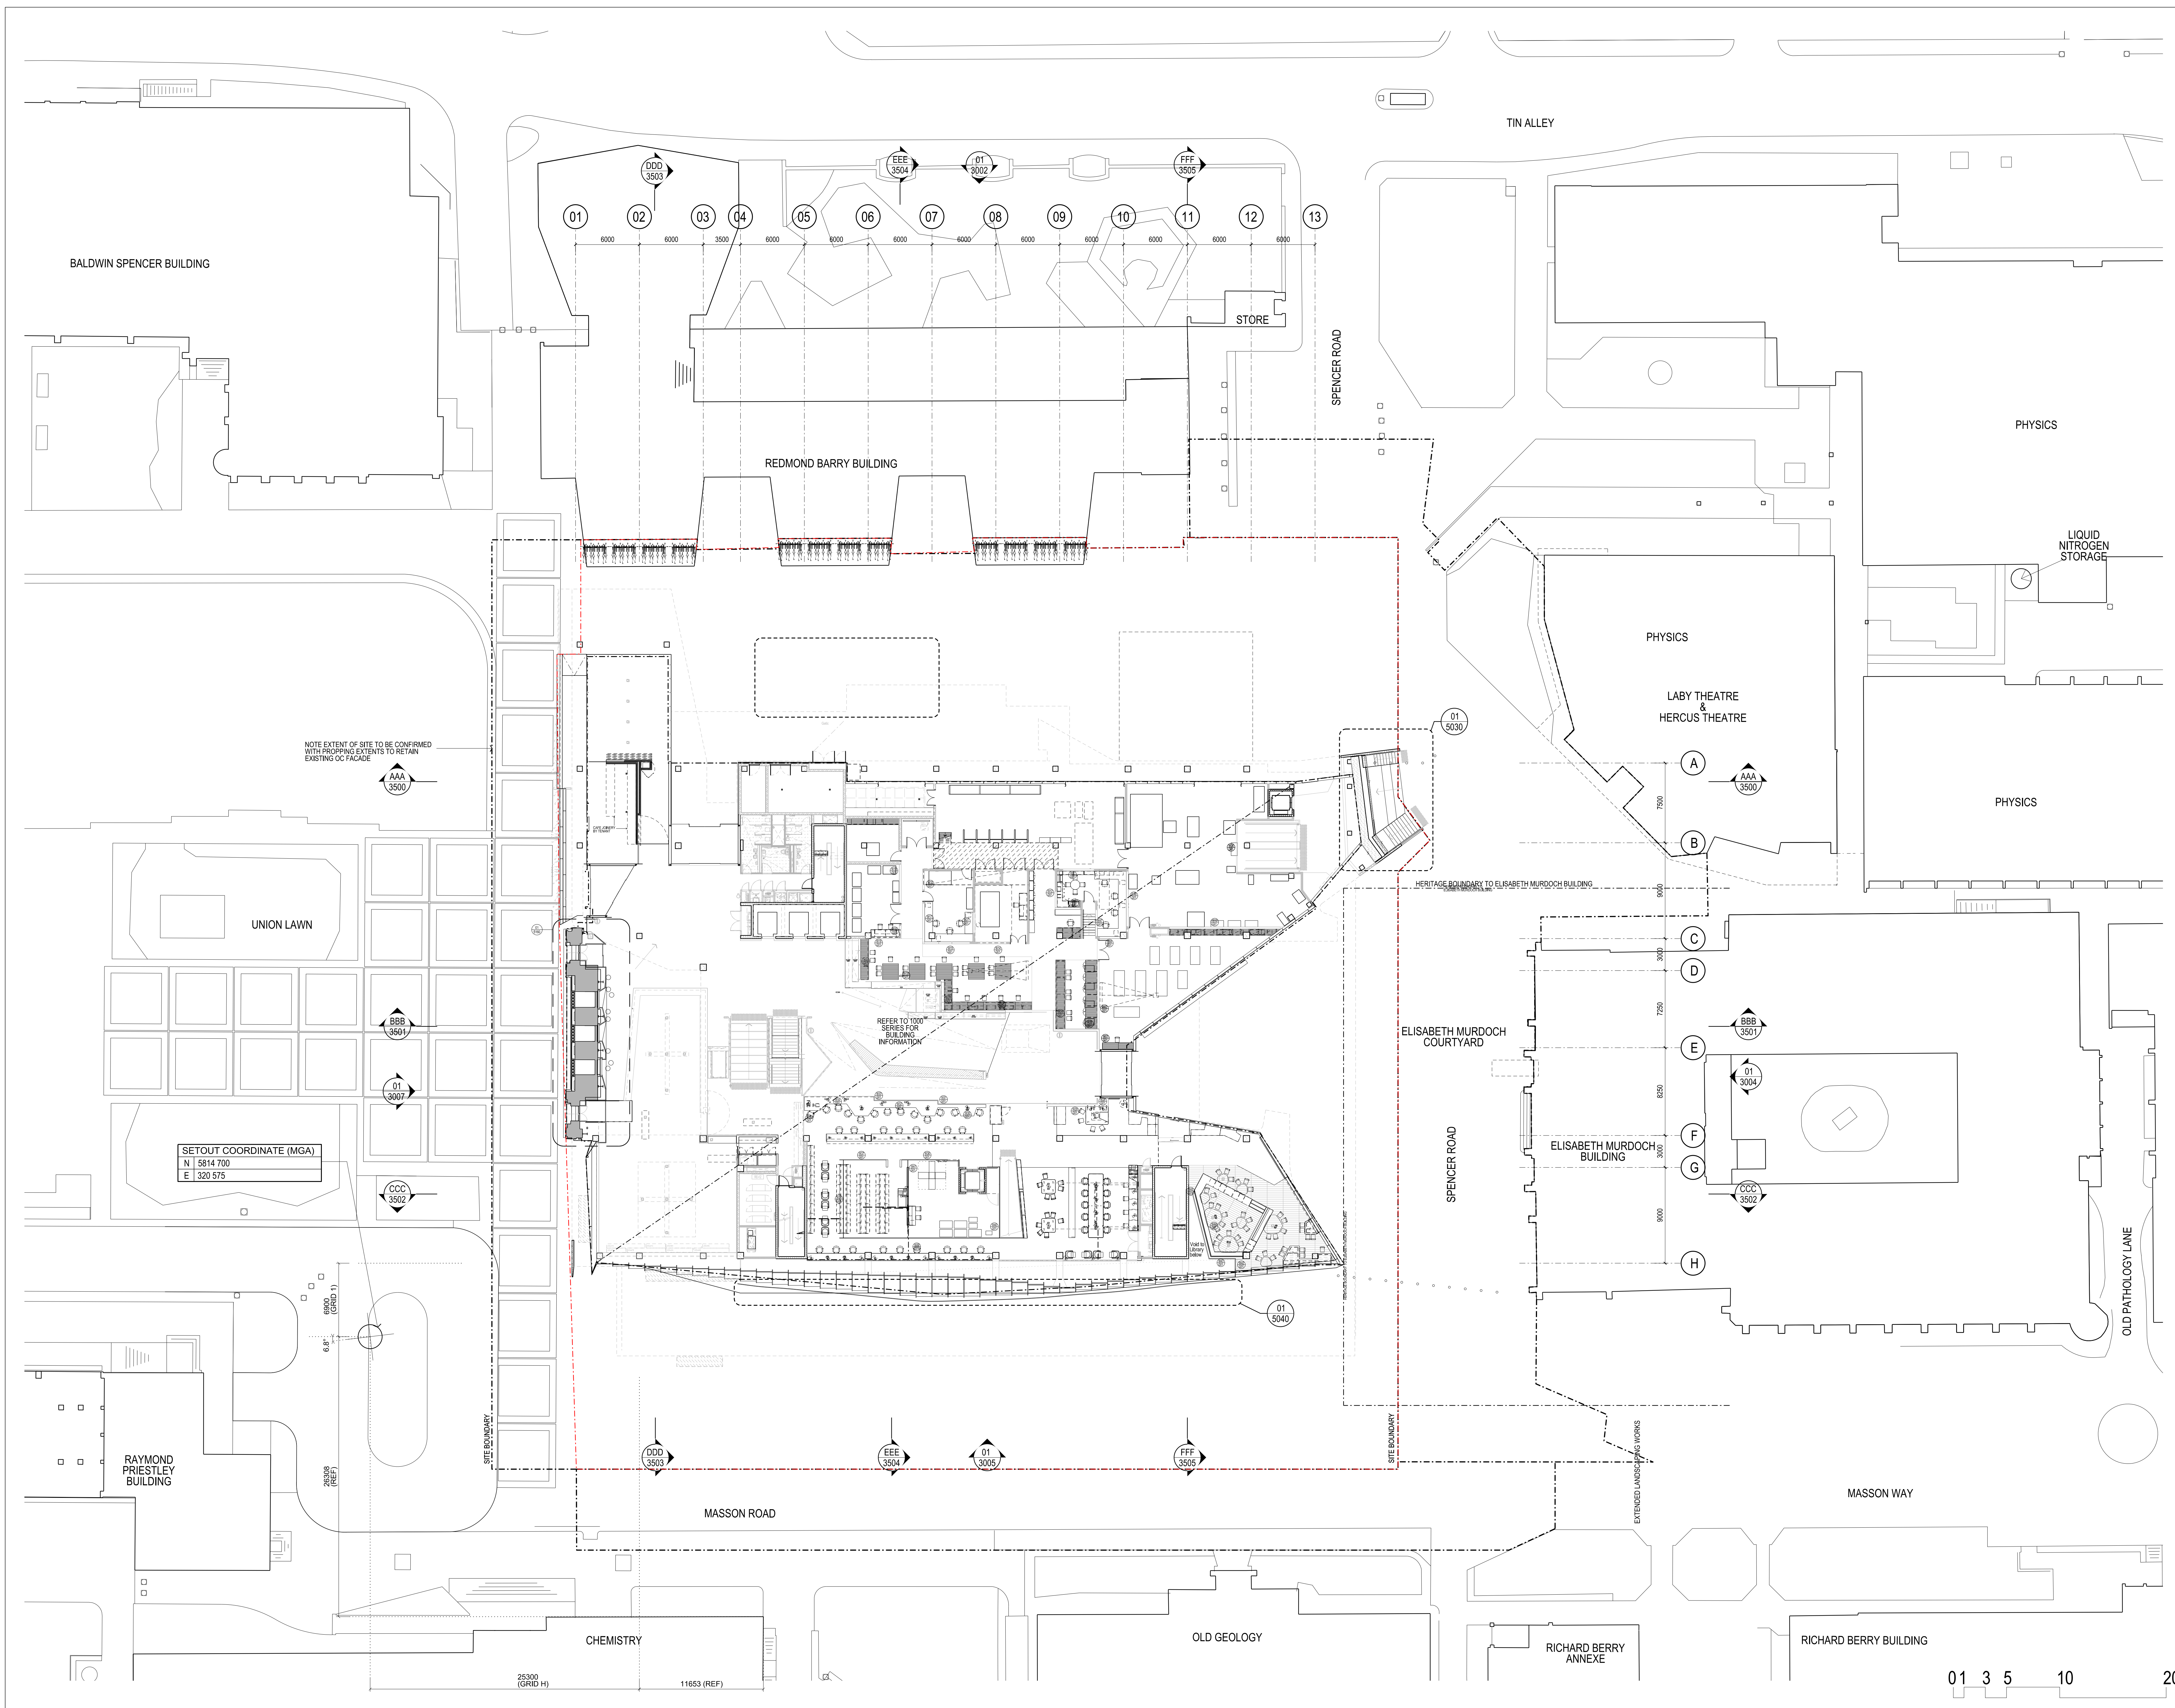

NADAAA

NADAAA
1320 Wellington
Street No.2
Boston
Massachusetts
02115 USA

Telephone
+1 617 442 8232
Facsimile
+1 688 442 1417
Email
nad@nadaaa.com

John Wardle Architects

25 Rokeby Street, Collingwood, Victoria 3066 Australia
Tel : +61 3 8662 0400 www.johnwardlearchitects.com
© 2012 John Wardle Architects ABN 83 006 814 268

Client **University of Melbourne
Parkville Campus**

Project **Faculty of Architecture
Building and Planning**

Title **SITE PLAN**

Project No.	0913	Scale	1:200 @ A0 1:500 @ A3
Drawing No.	AR0501	Revision	A

Date: Oct 2011 Drawn: Co-Ord: Check:

FILENAME - \$FILES

FOR CONSTRUCTION

01 3 5 10 20