

THIS DRAWING IS AN UNCONTROLLED COPY UNLESS STAMPED OTHERWISE




CONTRACTORS SHALL VERIFY ALL DIMENSIONS BEFORE ANY JOB COMMENCES. ALL SHOP DRAWINGS SHALL BE SUBMITTED TO THE SUPERINTENDENT AND MANUFACTURE SHALL NOT COMMENCE PRIOR TO THE RETURN OF UNAWARDED SHOP DRAWINGS SIGNED BY THE CONSULTANT. FIGURED DIMENSIONS SHALL TAKE PRECEDENCE OVER SCALED. THIS DRAWING SHOULD BE READ IN CONJUNCTION WITH ALL RELEVANT CONTRACT SPECIFICATIONS AND DRAWINGS COPYRIGHT OF THIS DRAWING IS VESTED IN WARDLE

General Notes

R - value ratings for external building :

■ Roof - Typical	XA-01
■ Roof - Insulation located below structural slab	XA-02
■ Roof - Above Basement	XA-03
External Wall - Typical	XA-04
External Wall South Facing	XA-06
■ Floors above unenclosed external areas (overhangs etc)	XA-07

Full Height Glazing - Ref. to ESD/Glazing Calc. - Note sections of external walls, bulkheads, etc. above full height glazing to receive insulation to match minimum required R-value ratings

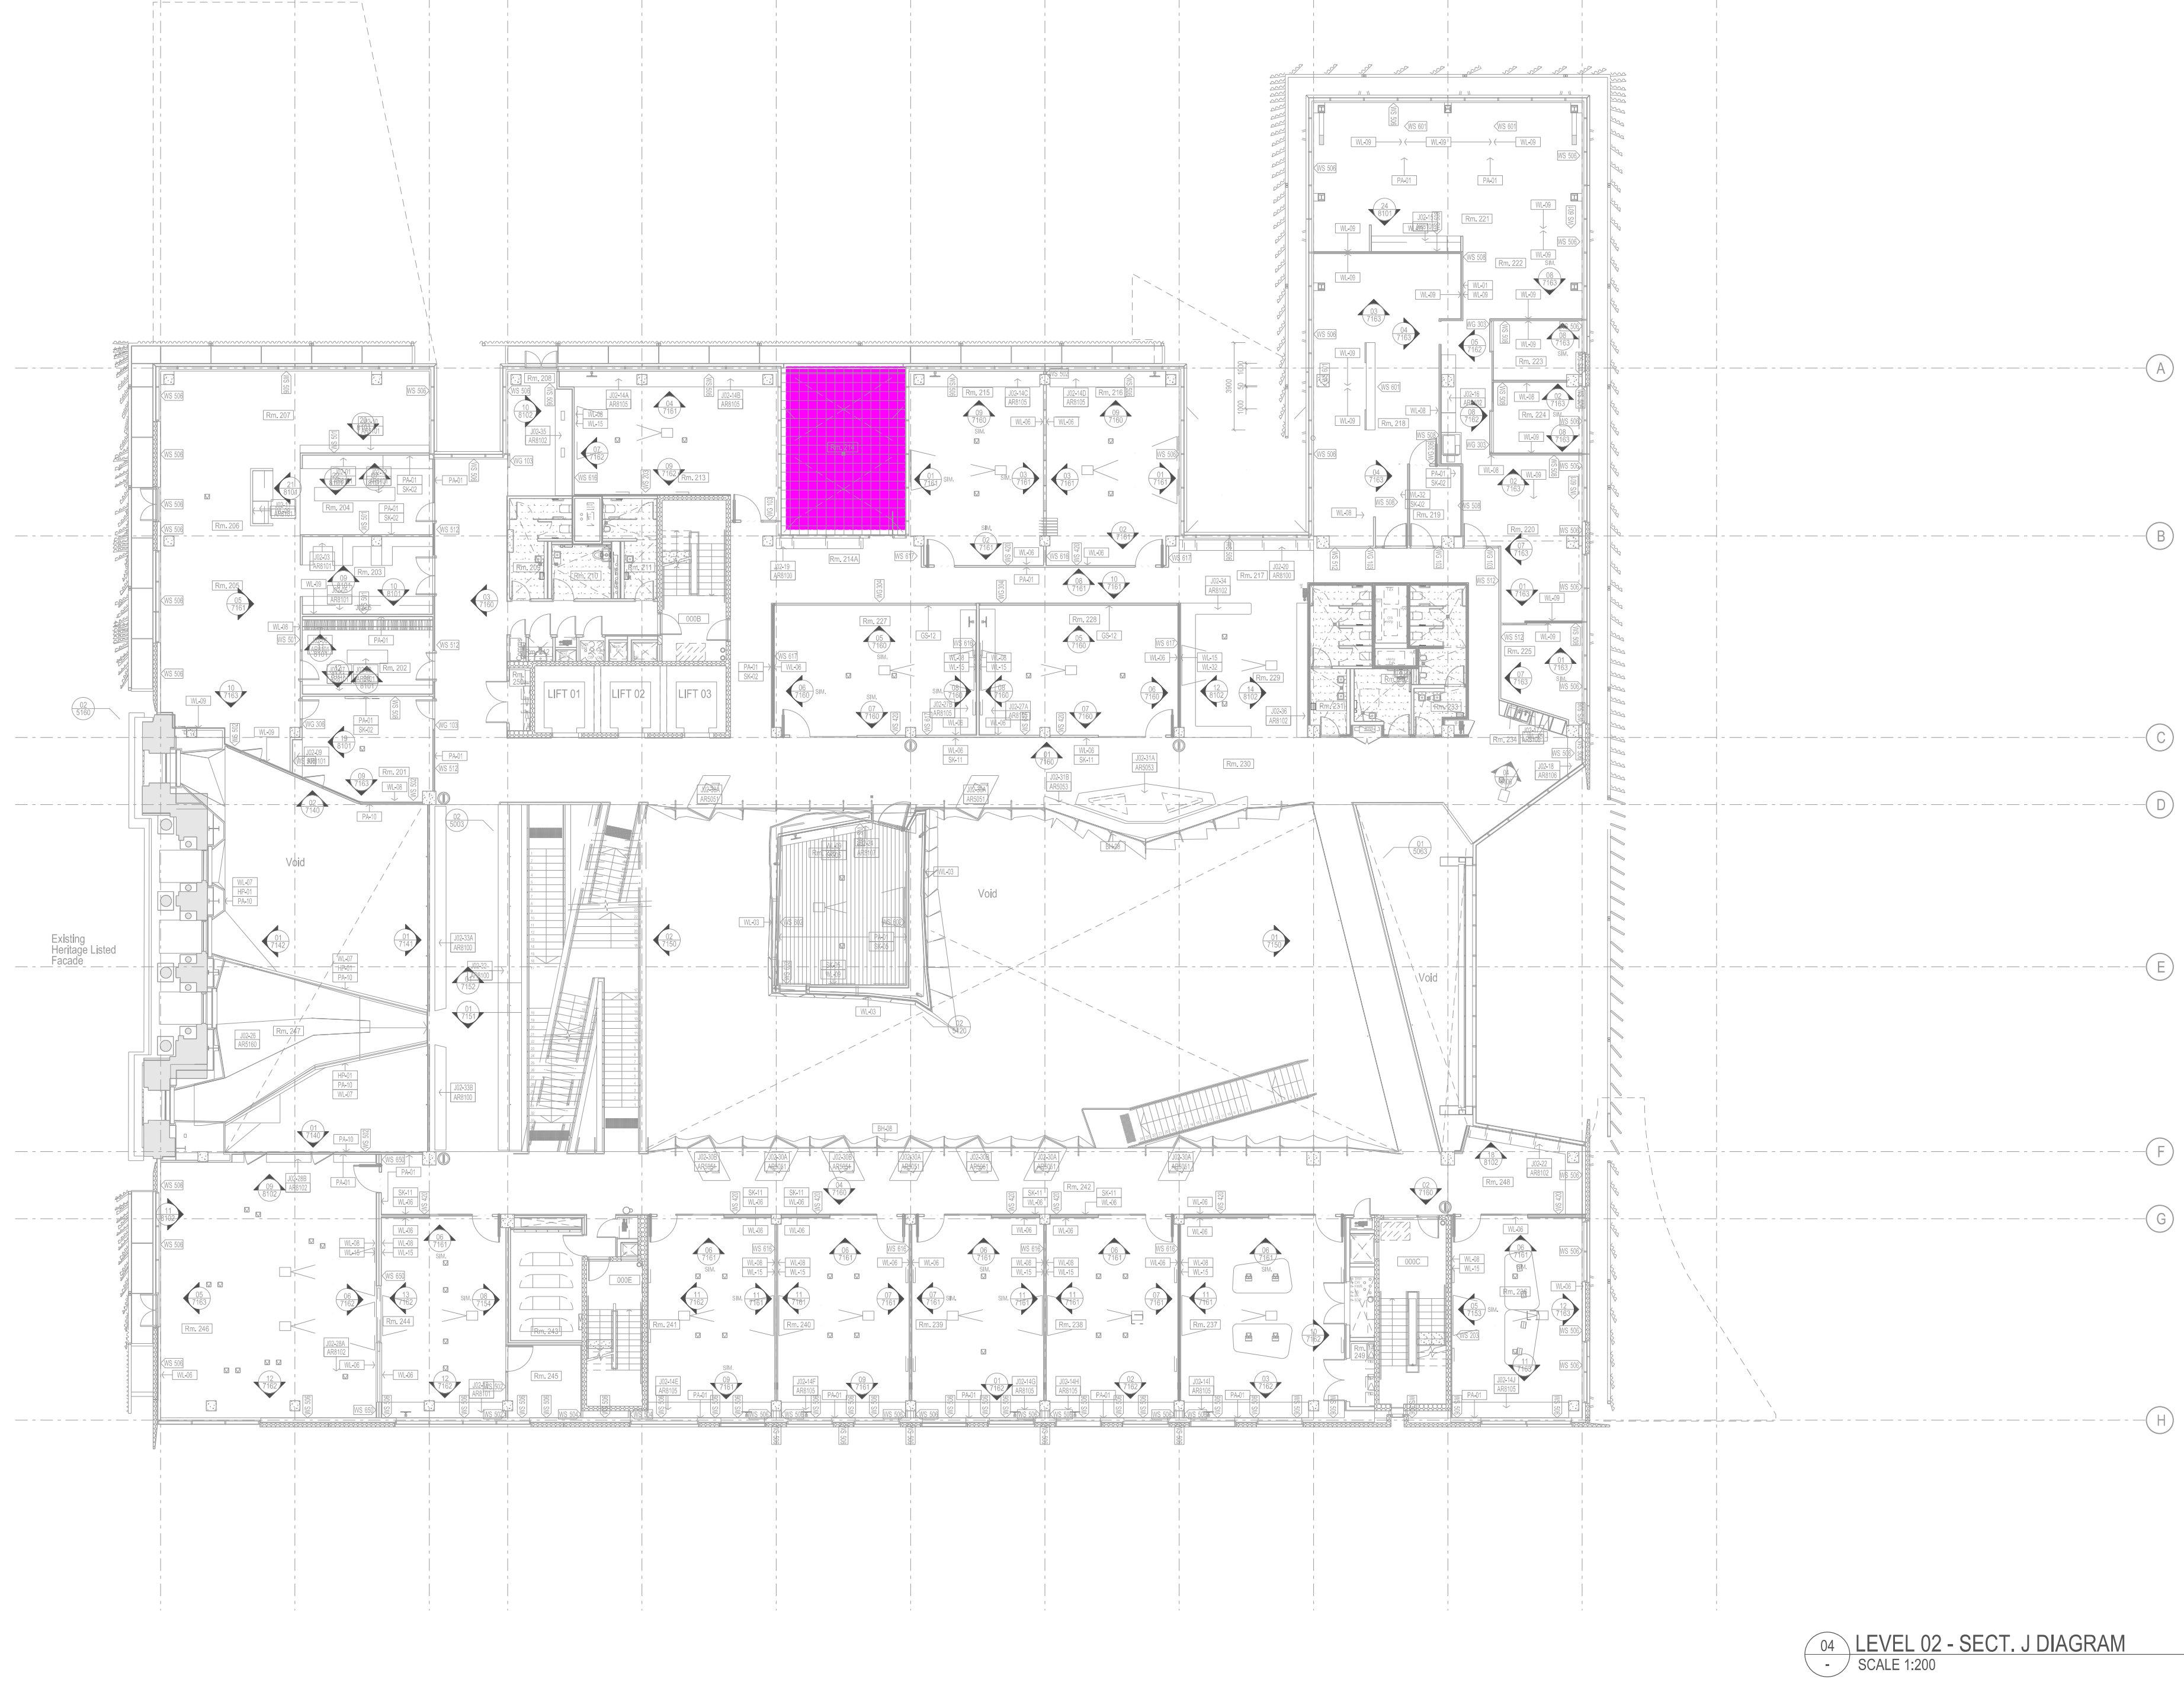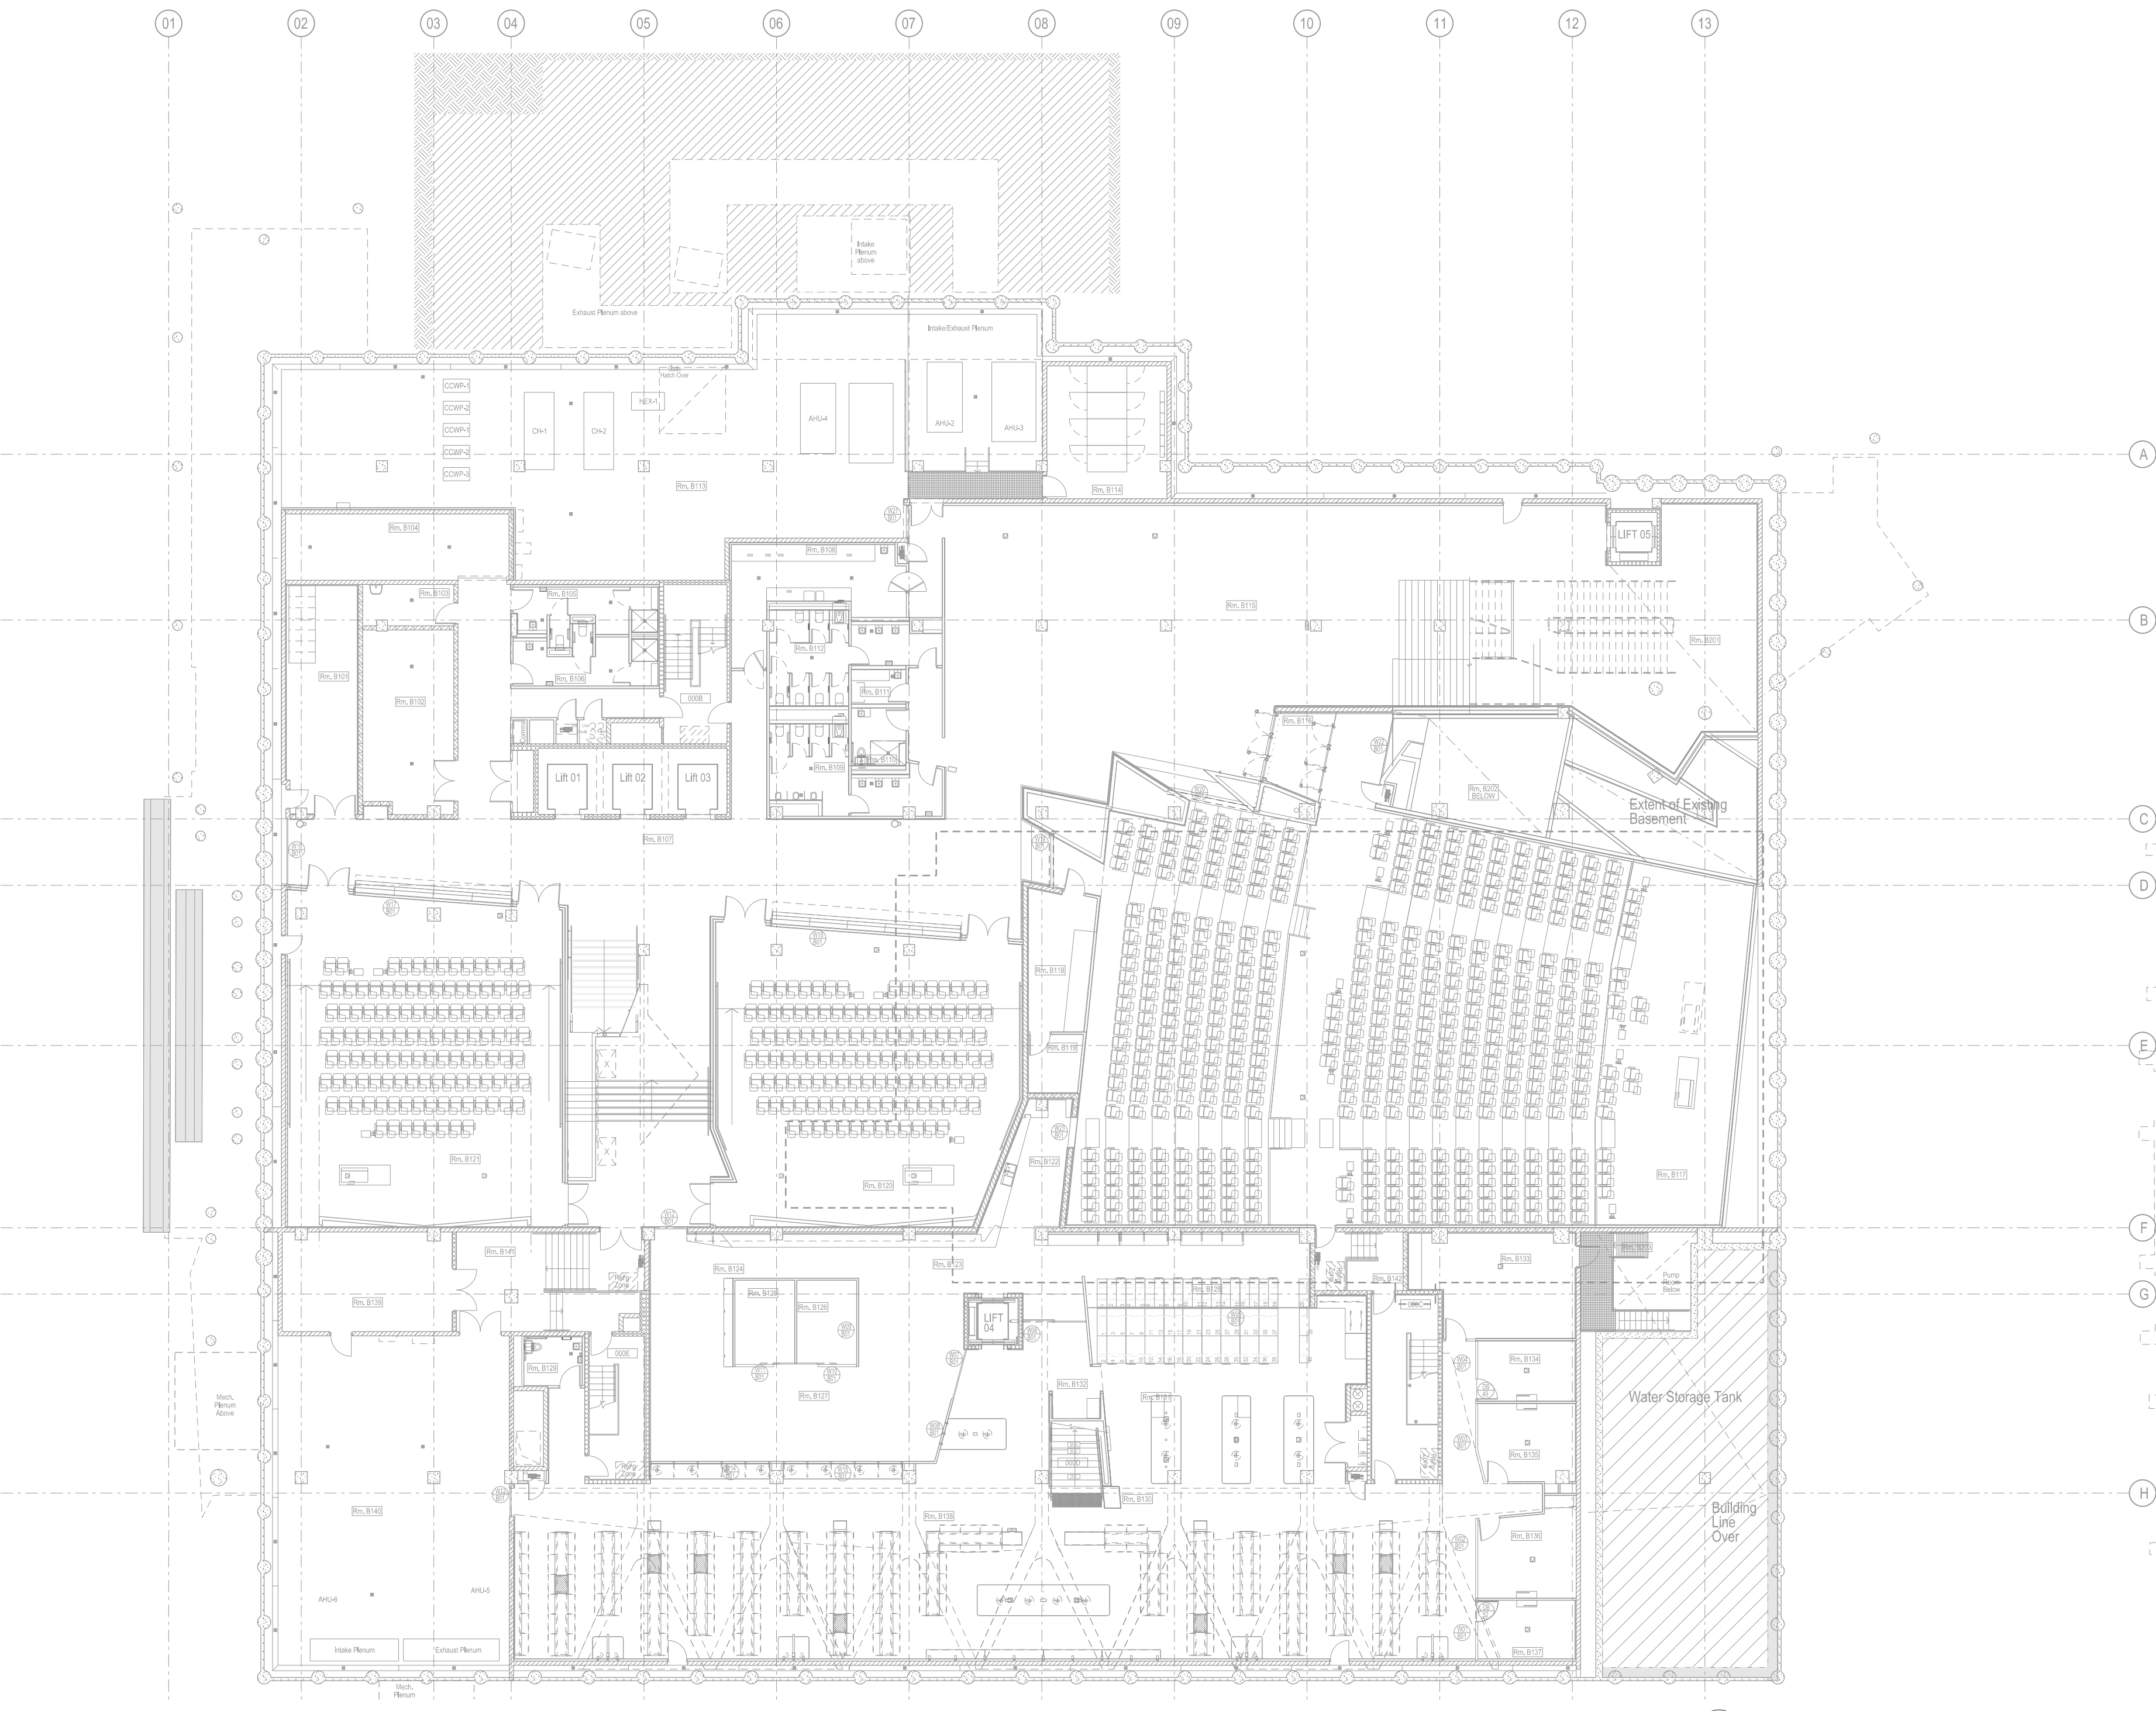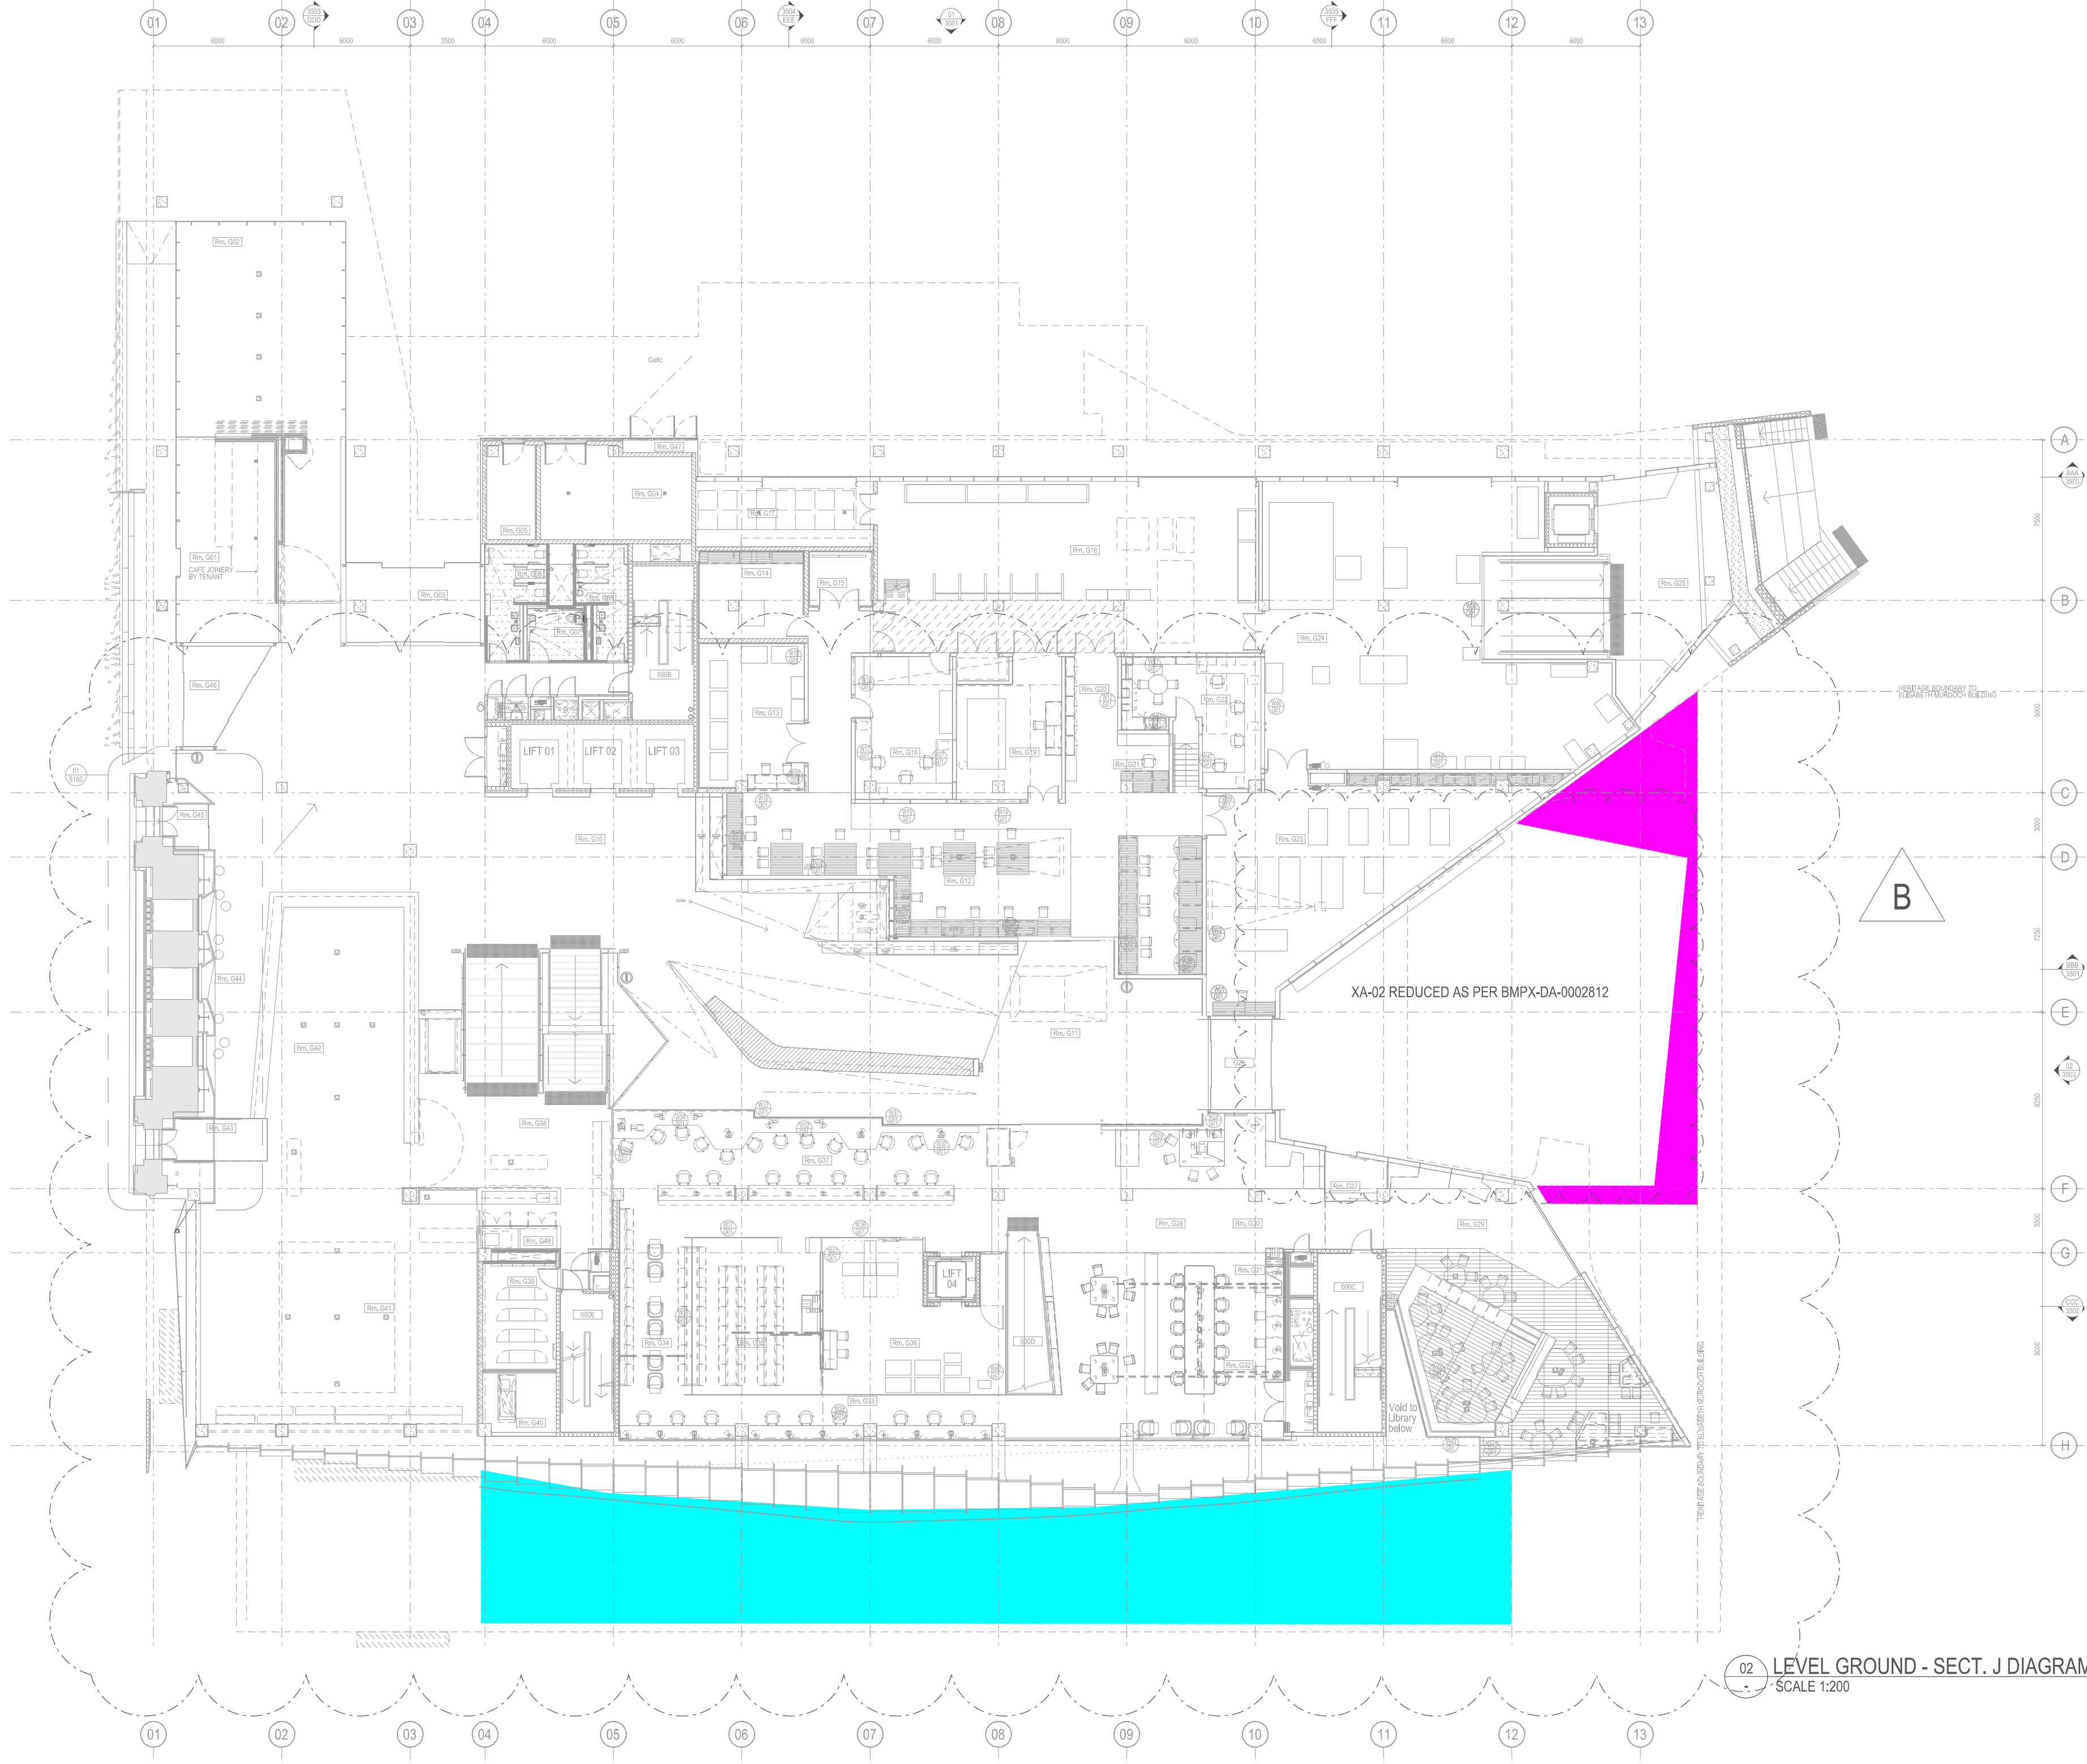

B	SG	UPDATES AS CLOUDED	06.01.14
A	SG	ISSUE FOR CONSTRUCTION	20.09.13
07	SG	100% CD - TENDER ISSUE	07.09.12
06	SG	75% CD ISSUE	13.09.12
05	SG	50% CD ISSUE	01.06.12
04	SG	25% CD ISSUE	20.04.12
03	SG	FINAL CD ISSUE	24.02.12
02	SG	DO UPDATE	20.01.12
01	SG	DESIGN DEVELOPMENT ISSUE	22.12.11

Rev	Issue	Revision Description	Amd	Date

NADAAA
 NADAAA
 1320 Washington Street No.2
 Boston Massachusetts 02118 USA
 Telephone +1 617 442 6232
 Facsimile +1 617 442 1417
 Email nadaaa@nadaaa.com

John Wardle Architects
 25 Rokeby Street, Collingwood, Victoria 3066 Australia
 Tel: +61 3 8662 0400 www.johnwardlearchitects.com
 © 2012 John Wardle Architects ABN 83 006 814 268

Client University of Melbourne
 Parkville Campus
 Project Faculty of Architecture
 Building and Planning

Title BCA Section J - Zone Diagrams
 B01, G01, L01, L02

Project No.	0913	Scale	1:200 @ A0 1:400 @ A2
Drawing No.	AR0600	Revision	B

Date: Dec-2011 Drawn: Co-Ord: Check:

FILENAME: \$FILES
FOR CONSTRUCTION