


THIS DRAWING IS AN UNCONTROLLED COPY UNLESS STAMPED OTHERWISE

CONTRACTORS SHALL VERIFY DIMENSIONS BEFORE ANY JOB COMMENCES. ALL SHOP DRAWINGS SHALL BE SUBMITTED TO THE SUPERINTENDENT AND MANUFACTURE SHALL NOT COMMENCE PRIOR TO THE RETURN OF UNDRAWN SHOP DRAWINGS SIGNED BY THE CONSULTANT. FIGURED DIMENSIONS SHALL TAKE PRECEDENCE OVER SCALED. THIS DRAWING PROCEDURE READ TO CONSTRUCTION WITH ALL RELEVANT CONTRACT SPECIFICATIONS AND DRAWINGS COPYRIGHT OF THIS DRAWING IS VESTED IN WARDLE


General Notes

**R - value ratings for external building :**


	Roof - Typical	XA-01
	Roof - Insulation located below structural slab	XA-02
	Roof - Above Basement	XA-03
	External Wall - Typical	XA-04
	External Wall South Facing	XA-06
	Floors above unenclosed external areas (overhangs etc)	XA-07
	Full Height Glazing - Ref. to ESD/Glazing Calc. - Note sections of external walls, bulkheads, etc. above full height glazing to receive insulation to match minimum required R-value ratings	

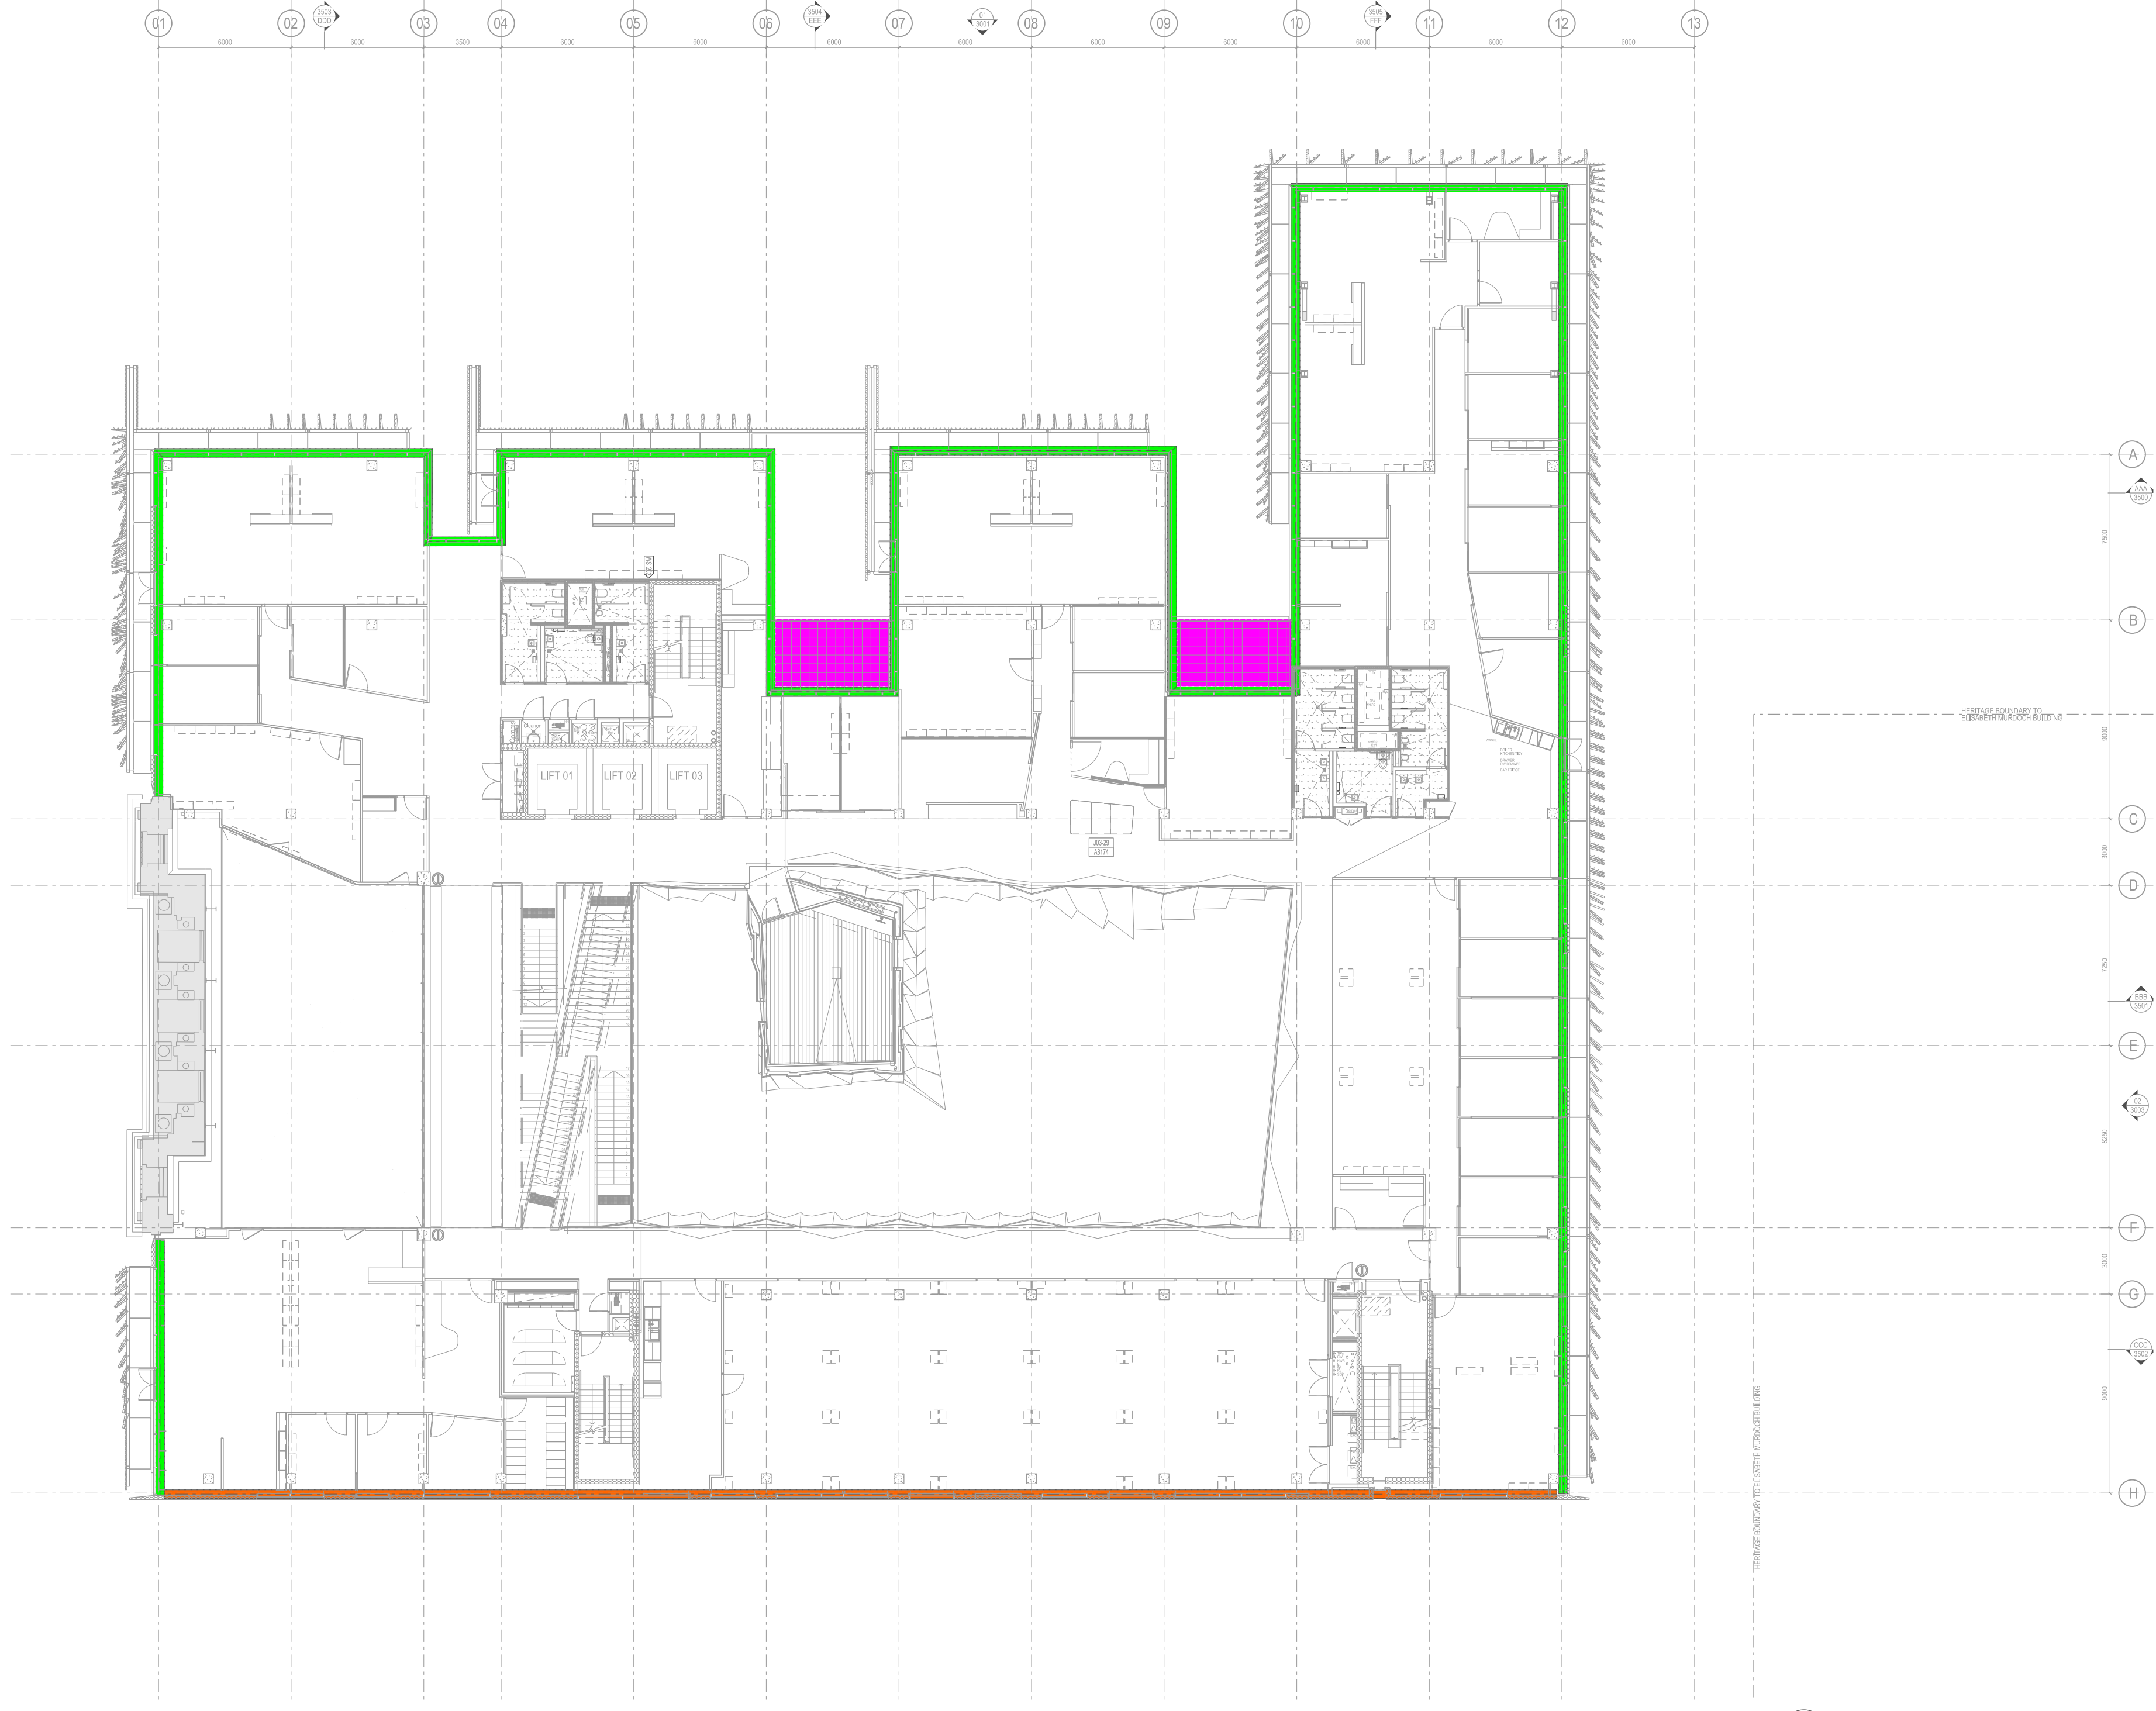

02 LEVEL 03 - Sect. J Diagram  
SCALE 1:200

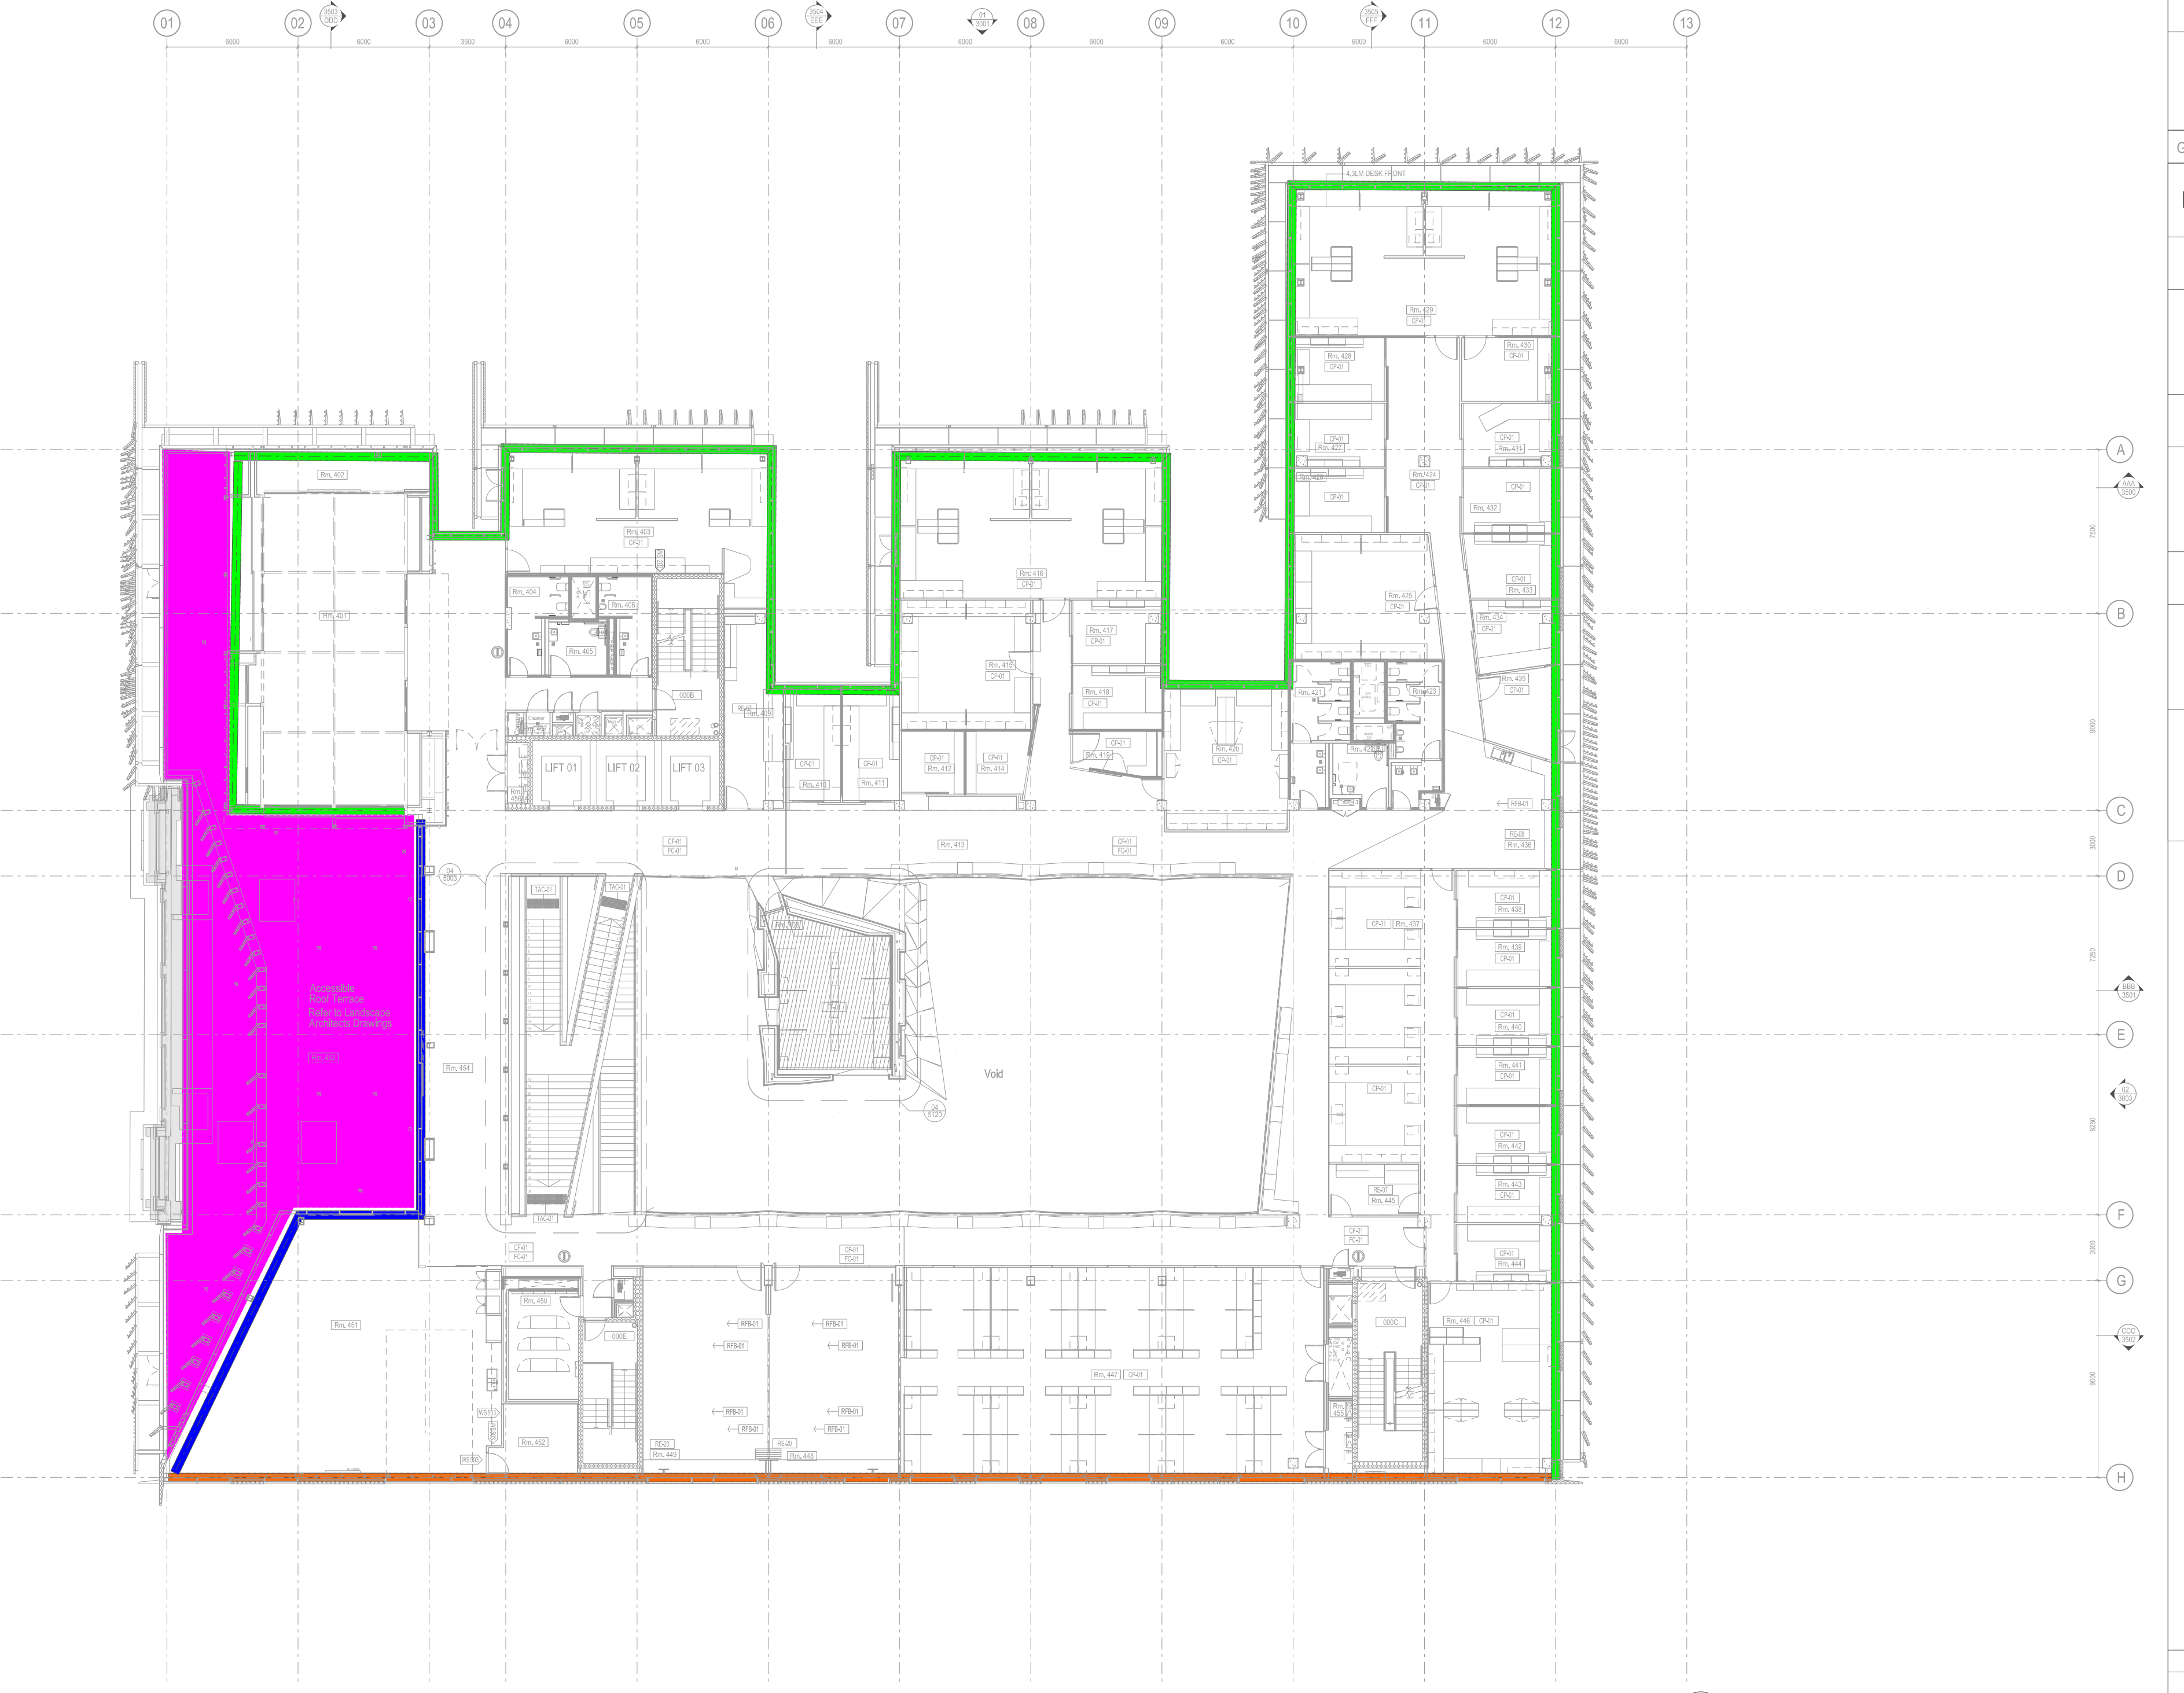

01 LEVEL 04 - SECT. J DIAGRAM  
SCALE 1:200

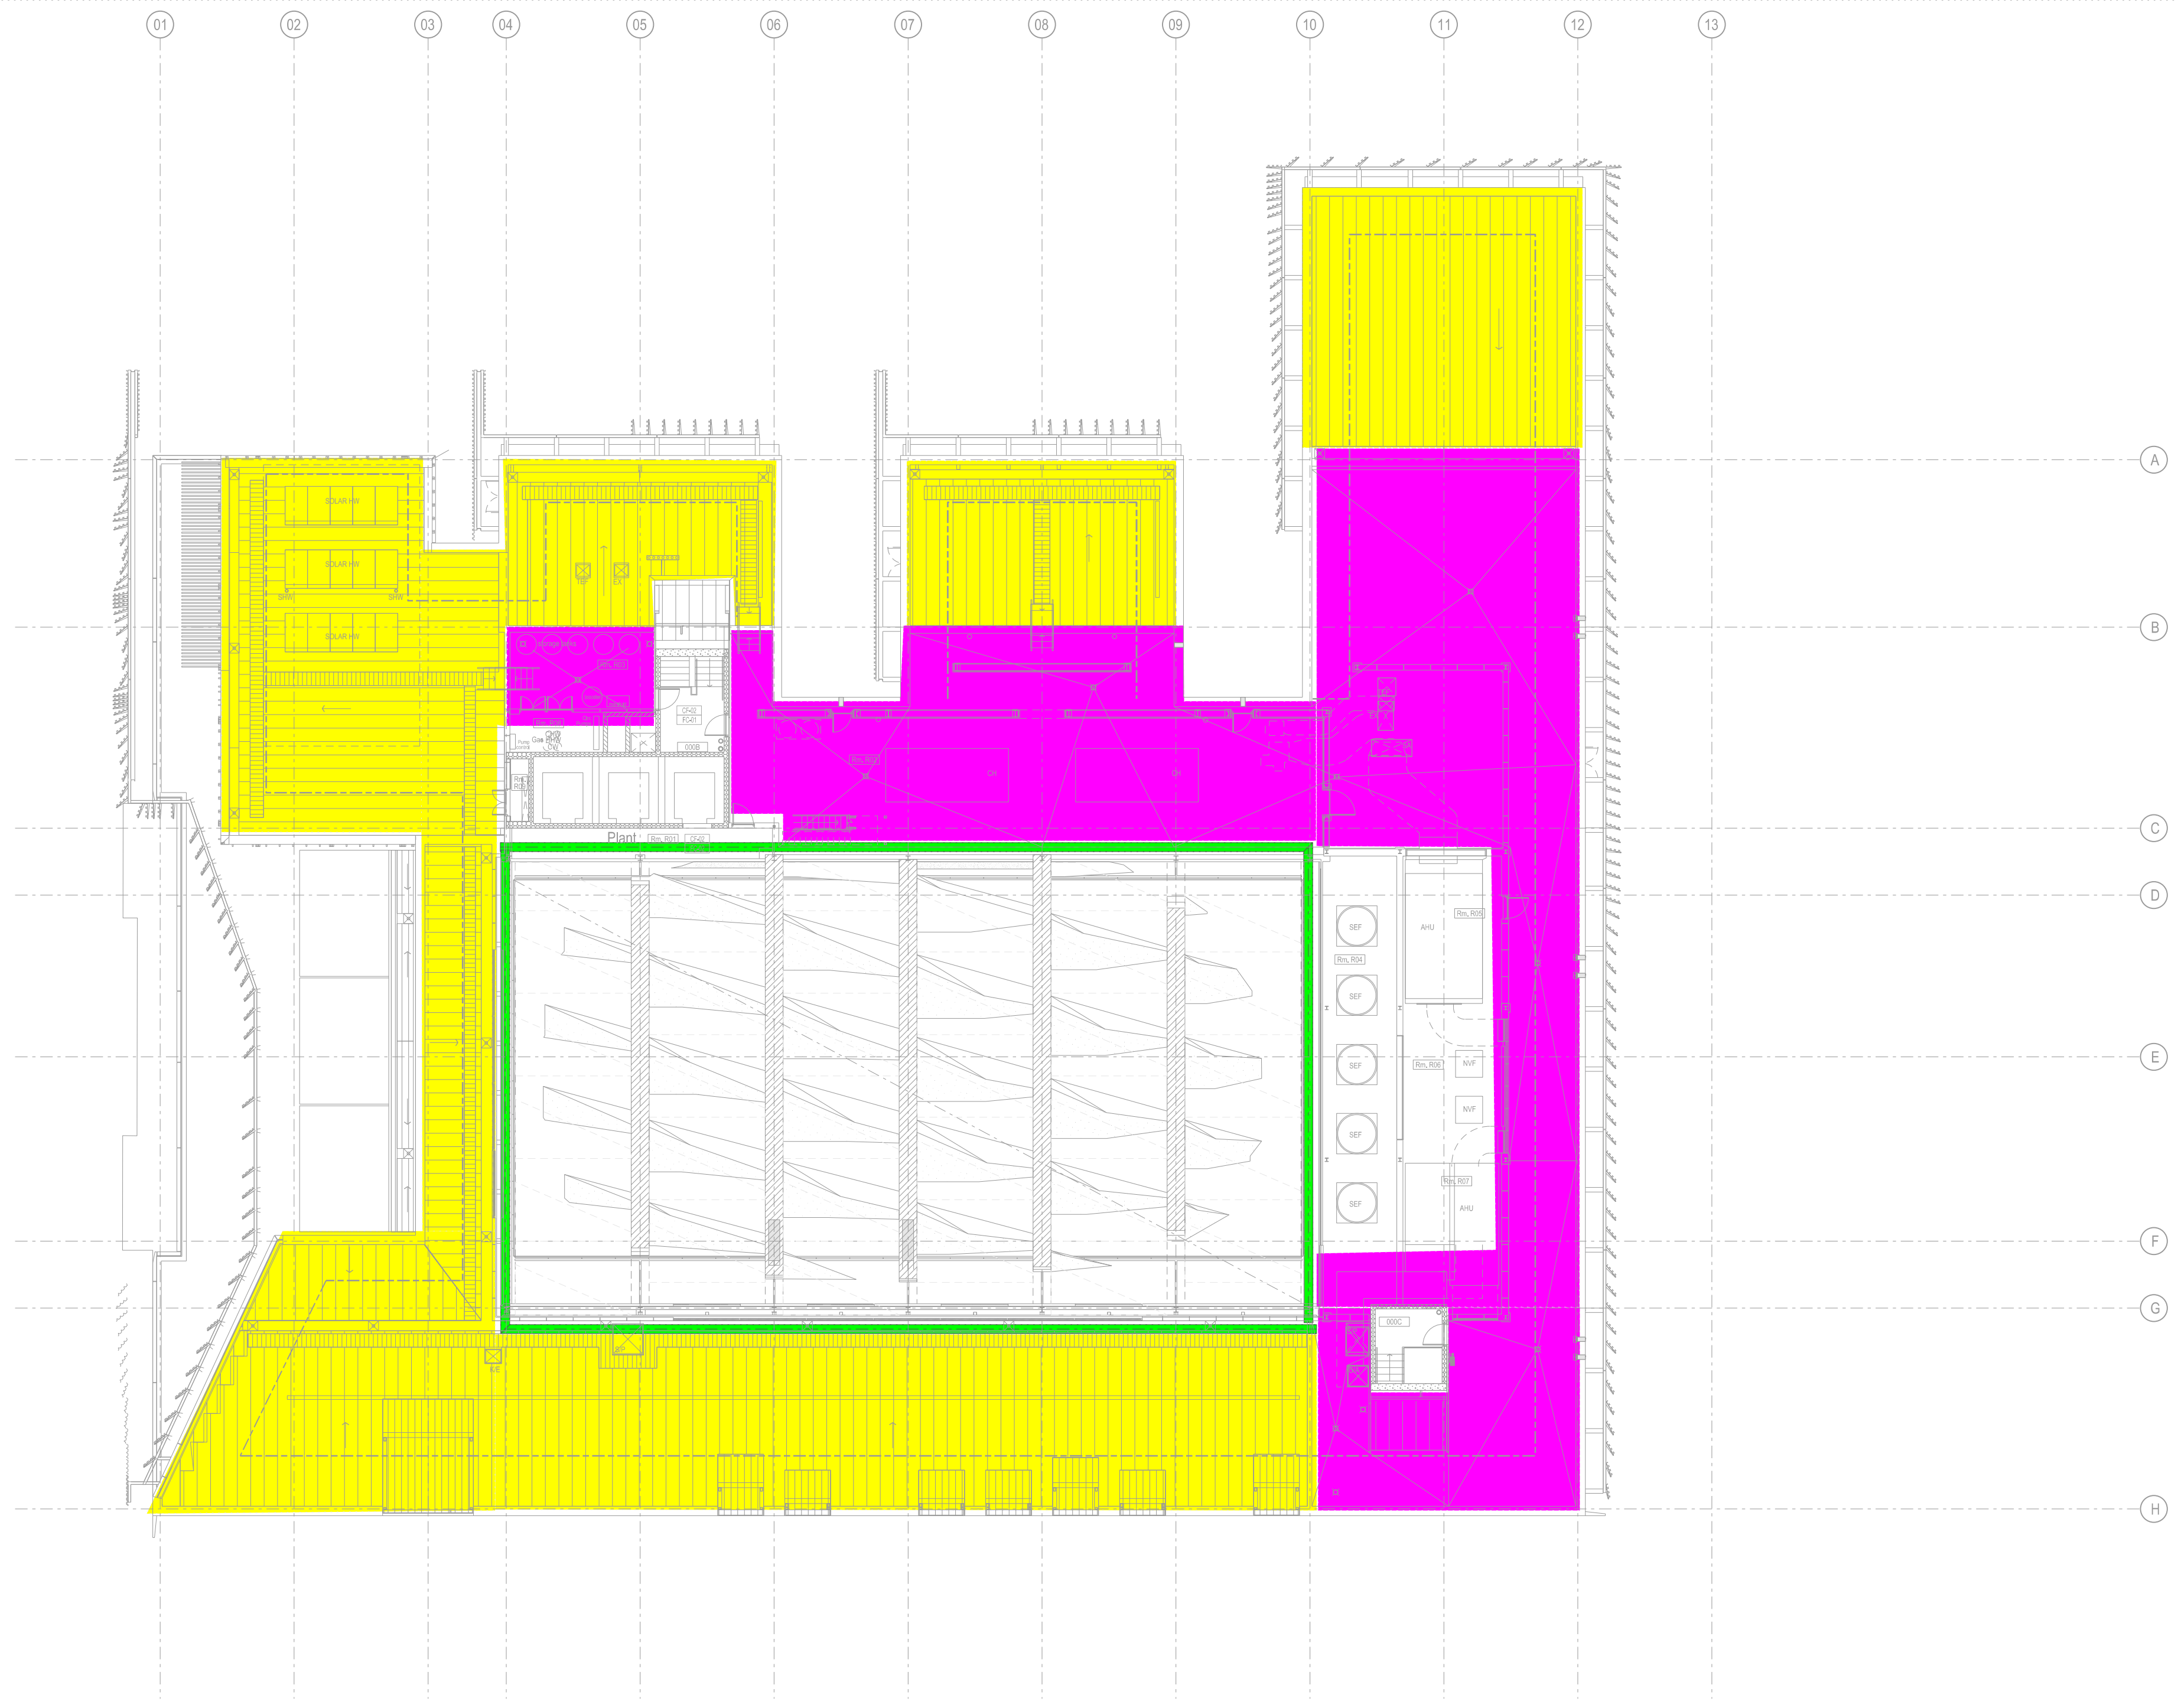

04 LEVEL 05 - SECT. J DIAGRAM  
SCALE 1:200



06 UPPER ROOF - SECT. J DIAGRAM  
SCALE 1:200

A	SG	ISSUE FOR CONSTRUCTION	-	20.09.13
08	SG	100% CD - TENDER ISSUE	-	07.09.12
07	SG	90% CD ISSUE	-	10.08.12
06	SG	75% CD ISSUE	-	13.07.12
05	SG	50% CD ISSUE	-	01.06.12
04	SG	25% CD ISSUE	-	20.04.12
03	SG	FINAL CD ISSUE	-	24.02.12
02	SG	CD UPDATE	-	20.01.12
01	SG	DESIGN DEVELOPMENT ISSUE	-	22.12.11

Rev	Issue	Revision Description	Amd	Date

**NADAAA**  
 NADAAA  
 1320 Washington Street No.2  
 Boston Massachusetts 02119 USA  
 Telephone +1 617 442 6232  
 Facsimile +1 617 442 1417  
 Email nadaaa@nadaaa.com

**John Wardle Architects**  
 25 Rokeby Street, Collingwood, Victoria 3066 Australia  
 Tel: +61 3 8662 0400 www.johnwardlearchitects.com  
 © 2012 John Wardle Architects ABN 83 006 814 268

Client University of Melbourne  
Parkville Campus

Project Faculty of Architecture  
Building and Planning

Title BCA Section J - Zone Diagrams  
L03, L04, L05, Roof

Project No.	0913	Scale	1:200 @ A0 1:400 @ A2
Drawing No.	AR0601	Revision	A

Date: Dec-2011 Drawn: Co-Ord: Check:

FILENAME - \$FILES FOR CONSTRUCTION