

THIS DRAWING IS AN UNCONTROLLED COPY UNLESS STAMPED OTHERWISE

CONTRACTORS SHALL VERIFY JOB DIMENSIONS BEFORE ANY JOB COMMENCES. ALL SHOP DRAWINGS SHALL BE SUBMITTED TO THE SUPERINTENDENT AND MANUFACTURERS SHALL NOT COMMENCE FROM THE RETURN OF DRAWINGS UNLESS DRAWINGS ISSUED BY THE CONSULTANT. DIMENSIONS SHALL TAKE PRECEDENCE OVER SCALES. THIS DRAWING SHALL BE READ IN CONJUNCTION WITH ALL RELEVANT CONTRACT SPECIFICATIONS AND DRAWINGS COPYRIGHT OF THIS DRAWING IS VESTED IN WARDLE.

General Notes

**AECOM Markup
Acoustic Ratings for Partitions**

- Rw 35 [AWT-01] [AWT-02]
- Rw 40 [AWT-03]
- Rw 45 [AWT-04]
- Rw 50 [AWT-05] [AWT-06]
- Rw 55 [AWT-07] [AWT-08]
- Rw 60 [AWT-09]
- Acoustic Rated External Glazed Partition


NOTE: REFER TO AECOM SCHEDULE OF ACOUSTIC PARTITION TYPES

**UMOW LAI / AECOM / Aurecon Markup
Natural Ventilation
Acoustic Transfer Requirements**


- TRANSFER BLINDHEAD - REFER TO AECOM / ULA / MECH ENG FOR DETAILS
- TRANSFER DUCT - REFER TO AECOM / ULA / MECH ENG FOR DETAILS
- TRANSFER DUCT - TYPE 1
- TRANSFER DUCT - TYPE 2
- TRANSFER DUCT - TYPE 3
- REFER TO AECOM / ULA / MECH ENG FOR DETAILS




02 LEVEL GROUND - AREA DIAGRAM
SCALE 1:200

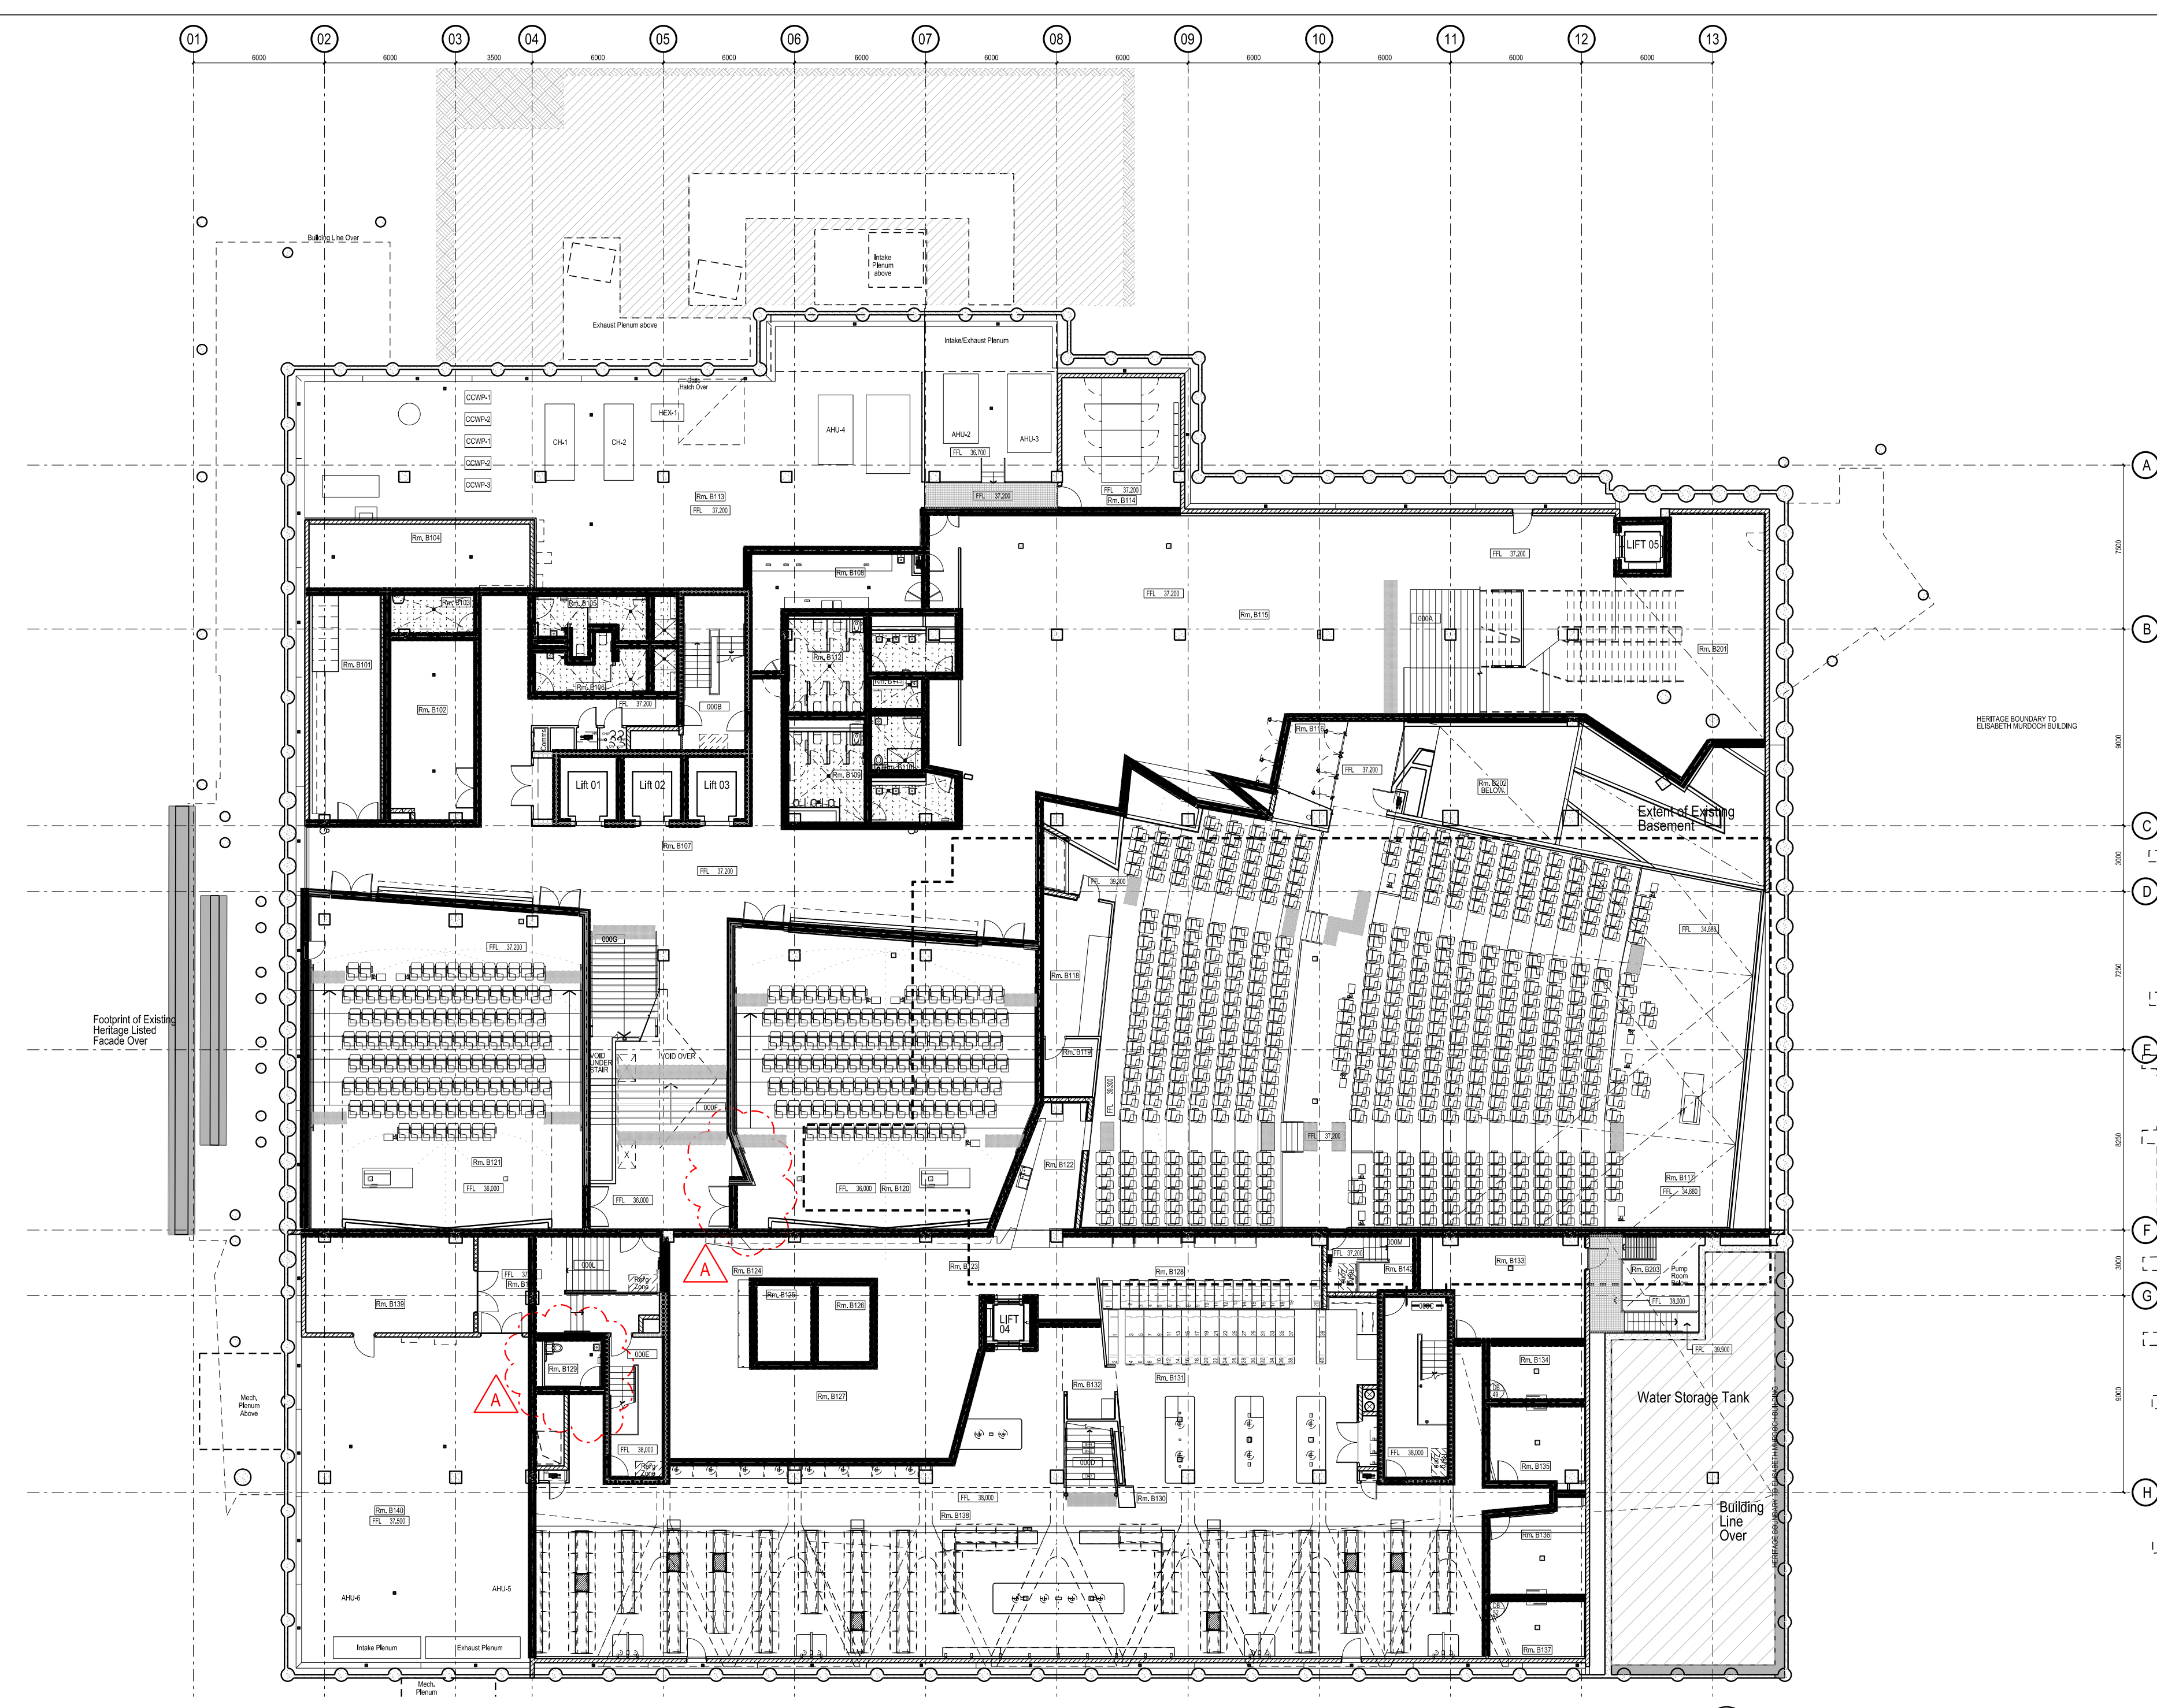

01 LEVEL BASEMENT - AREA DIAGRAM
SCALE 1:200

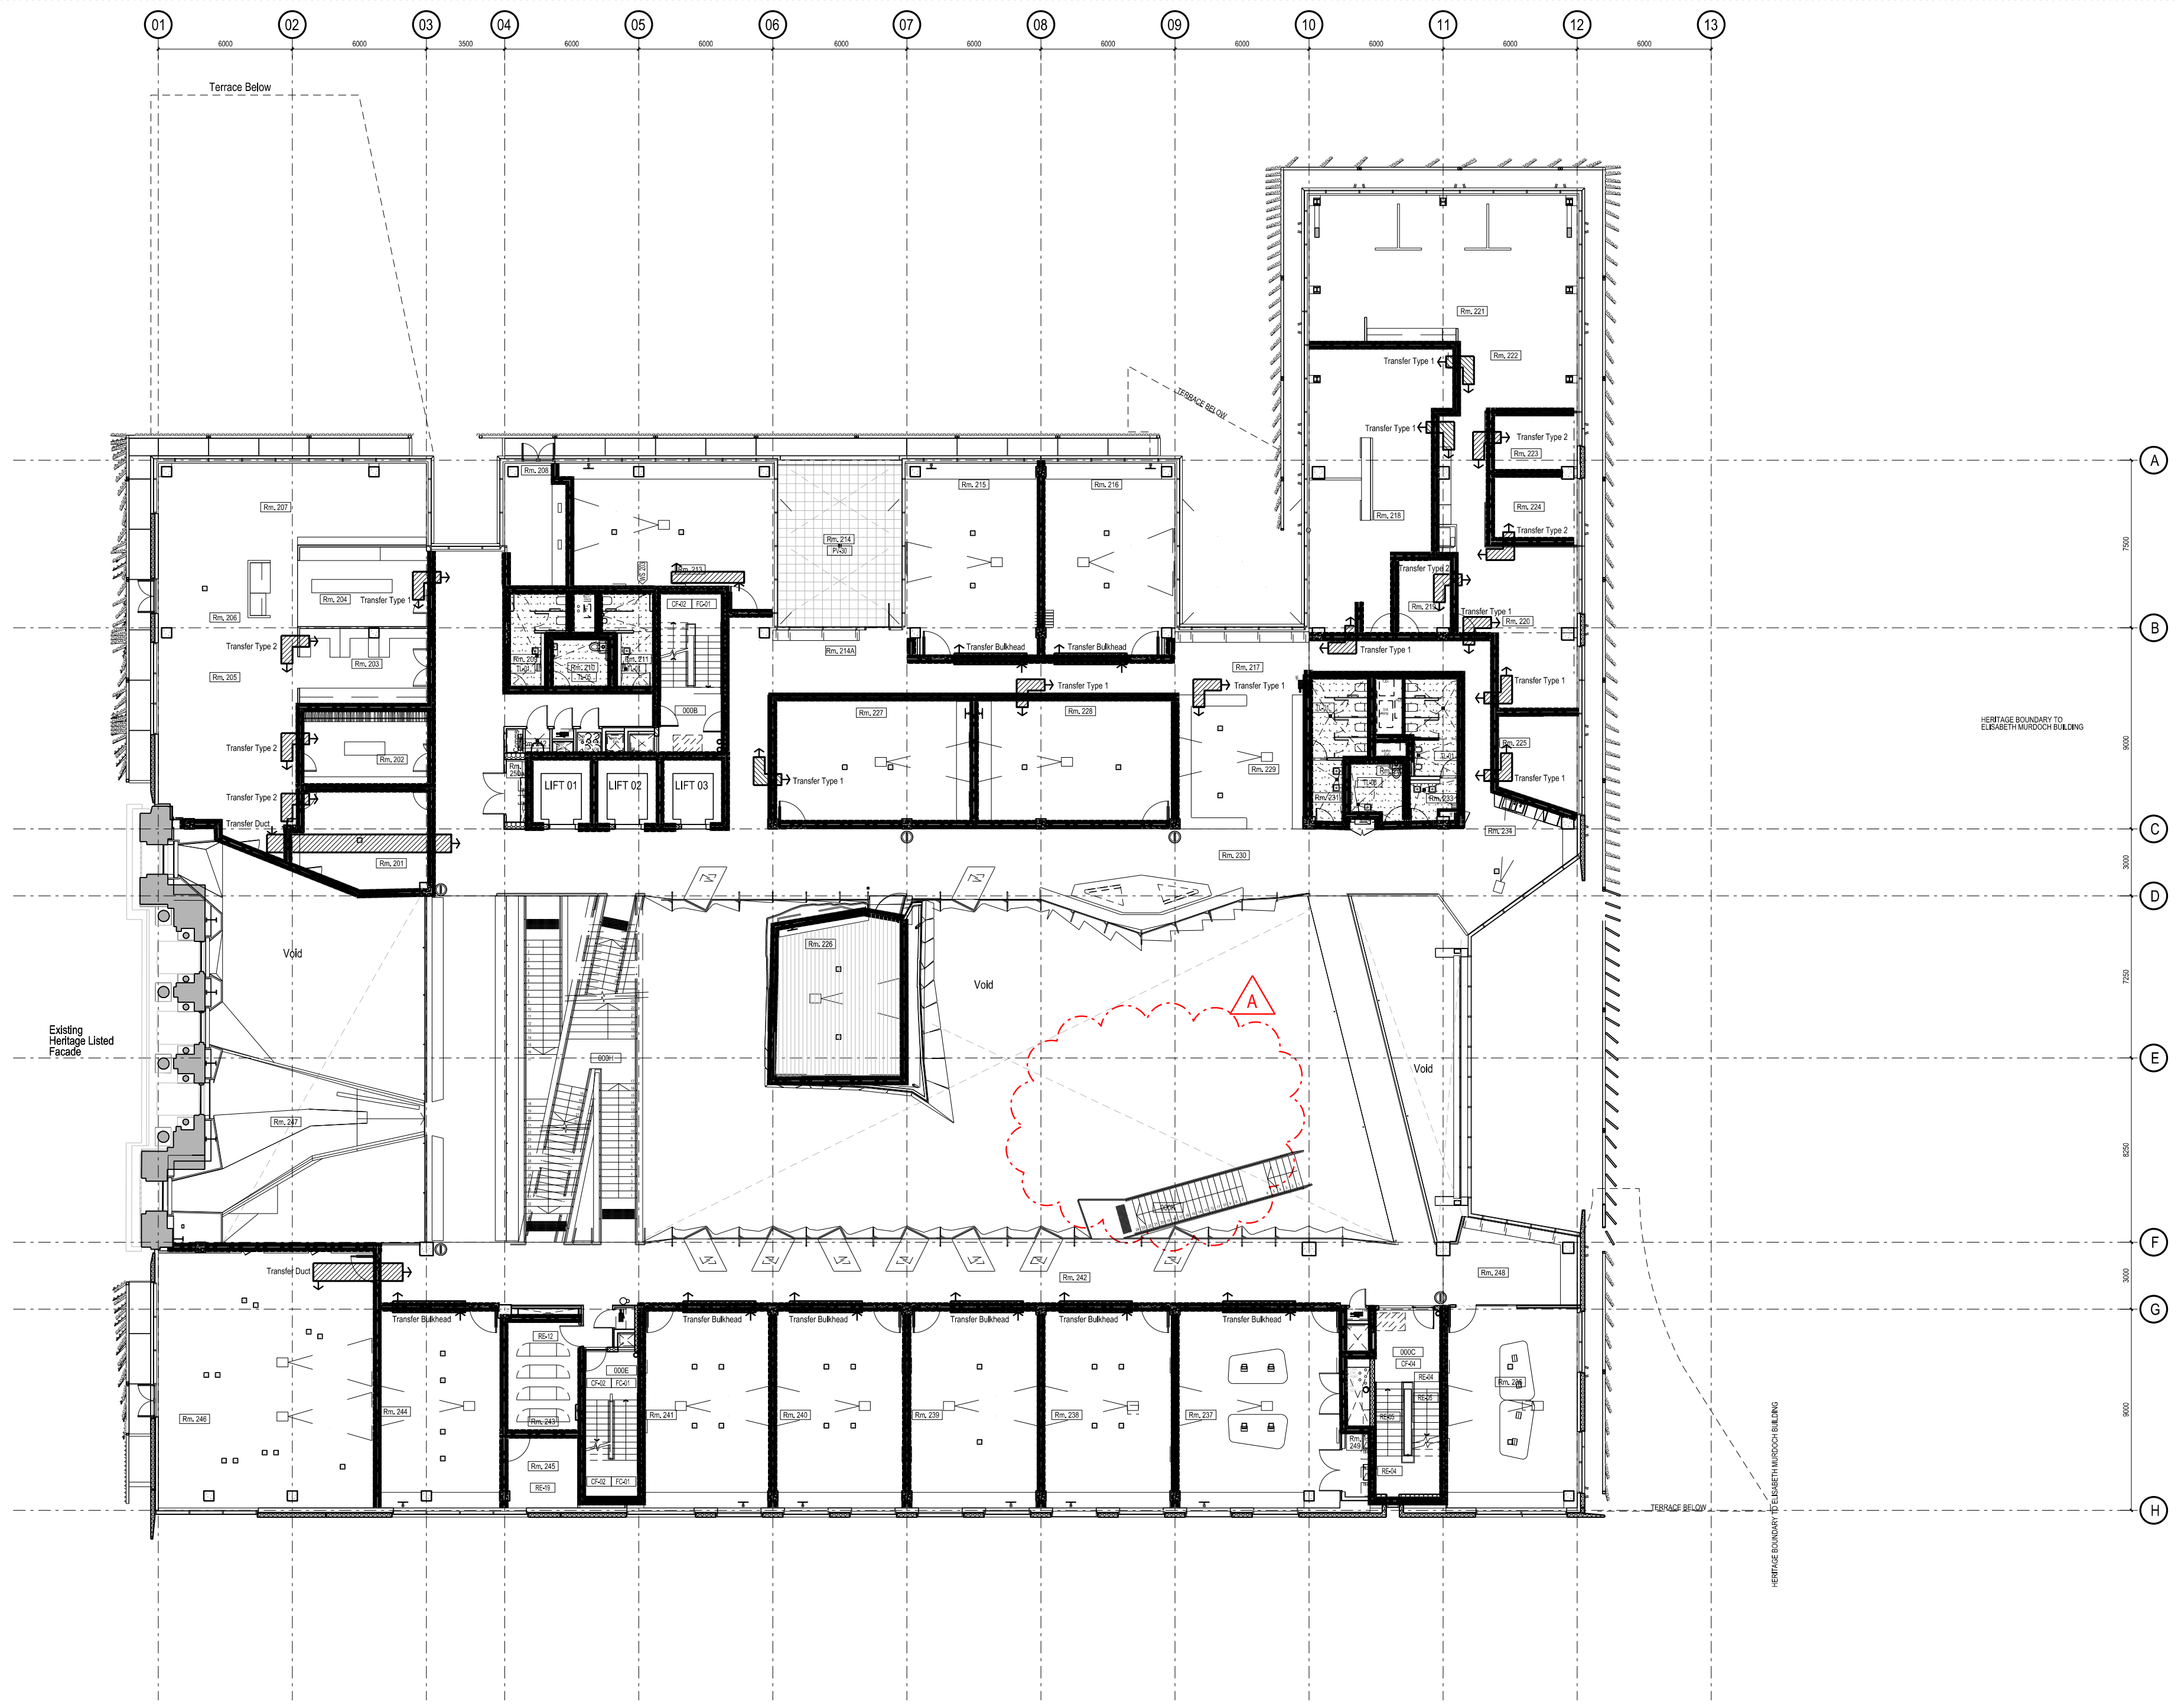

04 LEVEL 02 - AREA DIAGRAM
SCALE 1:200

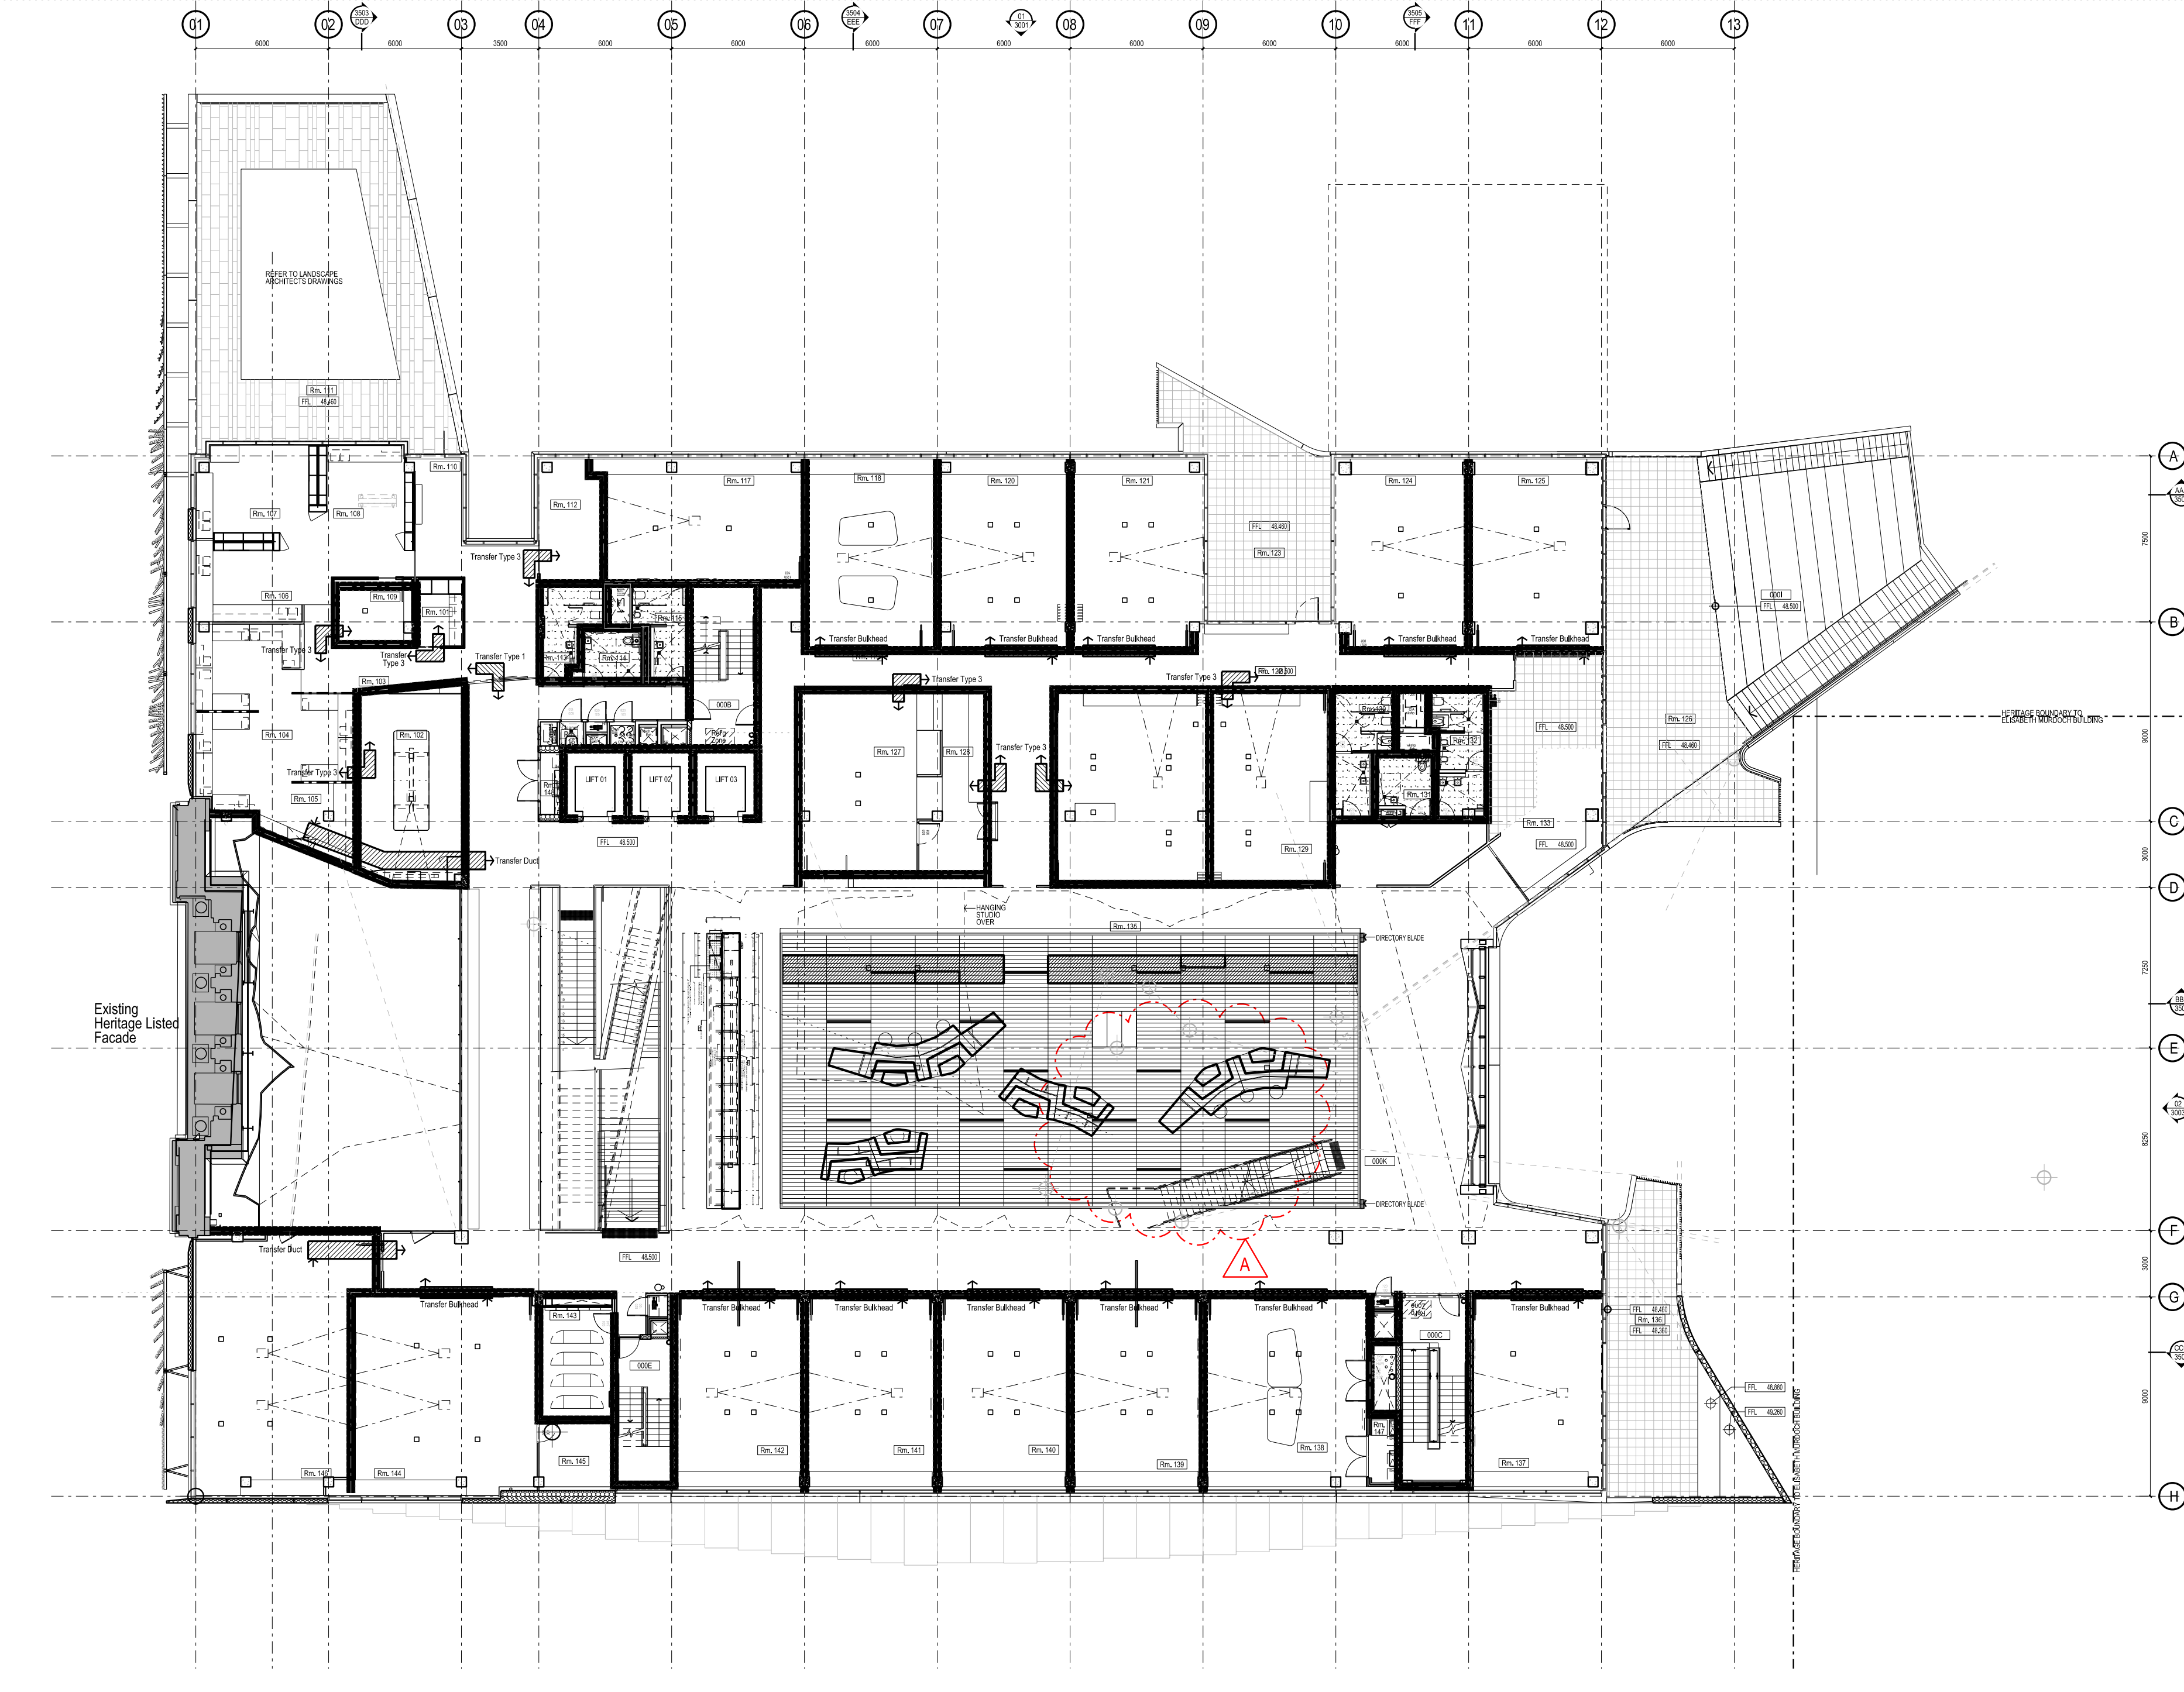

03 LEVEL 01 - AREA DIAGRAM
SCALE 1:200

A	SG	ACOUSTIC WALL ZONE DELETED / UPDATES	21.11.13
09	SG	100% CD - TENDER ISSUE	07.09.12
08	SG	90% CD ISSUE	10.08.12
07	SG	75% CD ISSUE	13.07.12
06	SG	55% CD ISSUE	01.06.12
05	SG	25% CD ISSUE	20.04.12
04	SG	FINAL DD ISSUE	24.02.12
03	SG	DD UPDATE	20.01.12
02	SG	DESIGN DEVELOPMENT ISSUE	22.12.11
01	SG	PRELIMINARY DD	02.11.11

Rev	Issue	Revision Description	And	Date
-----	-------	----------------------	-----	------



NADAAA
 NADAAA
 1320 Washington Street No.2
 Boston Massachusetts 02118 USA
 Telephone +1 817 442 8232
 Facsimile +1 888 442 1417
 Email nadaaa@nadaaa.com

John Wardle Architects
 25 Rokeby Street, Collingwood, Victoria 3066 Australia
 Tel: +61 3 8662 0400 www.johnwardlearchitects.com
 © 2012 John Wardle Architects ABN 83 006 814 268

Client **University of Melbourne
Parkville Campus**
 Project **Faculty of Architecture
Building and Planning**

Title **Acoustic Zone Diagrams
B01, G01, L01, L02**

Project No.	0913	Scale	1:200 @ A0 1:400 @ A2
Drawing No.	AR0610	Revision	A

Date: JM - 2011 Drawn: Co-Ord: Check:

FILENAME - \$FILES
FOR CONSTRUCTION