

CONTRACTORS SHALL VERIFY JOB DIMENSIONS BEFORE ANY JOB COMMENCES. ALL SHOP DRAWINGS SHALL BE SUBMITTED TO THE SUPERINTENDENT AND MANUFACTURERS SHALL NOT COMMENCE FROM THE RETURN OF DIMENSIONS SHOP DRAWINGS ISSUED BY THE CONSULTANT. DIMENSIONS SHALL TAKE PRECEDENCE OVER SCALES. THIS DRAWING SHALL BE READ IN CONJUNCTION WITH ALL RELEVANT CONTRACT SPECIFICATIONS AND DRAWINGS COPYRIGHT OF THIS DRAWING IS VESTED IN WARDLE.

General Notes


AECOM Markup
Acoustic Ratings for Partitions

- Rw 35 [ART-01] [ART-02]
- Rw 40 [ART-03]
- Rw 45 [ART-04]
- Rw 50 [ART-05] [ART-06]
- Rw 55 [ART-07] [ART-08]
- Rw 60 [ART-09]
- Acoustic Rated External Glazed Partition

NOTE: REFER TO AECOM SCHEDULE OF ACUSTIC PARTITION TYPES

UMOW LAI / AECOM / Aurecon Markup
Natural Ventilation / Acoustic Transfer Requirements


- TRANSFER BLINDHEAD - REFER TO AECOM / ULA / MECH ENG FOR DETAILS
- TRANSFER DUCT - REFER TO AECOM / ULA / MECH ENG FOR DETAILS
- TRANSFER DUCT - TYPE 1
- TRANSFER DUCT - TYPE 2
- TRANSFER DUCT - TYPE 3
- REFER TO AECOM / ULA / MECH ENG FOR DETAILS

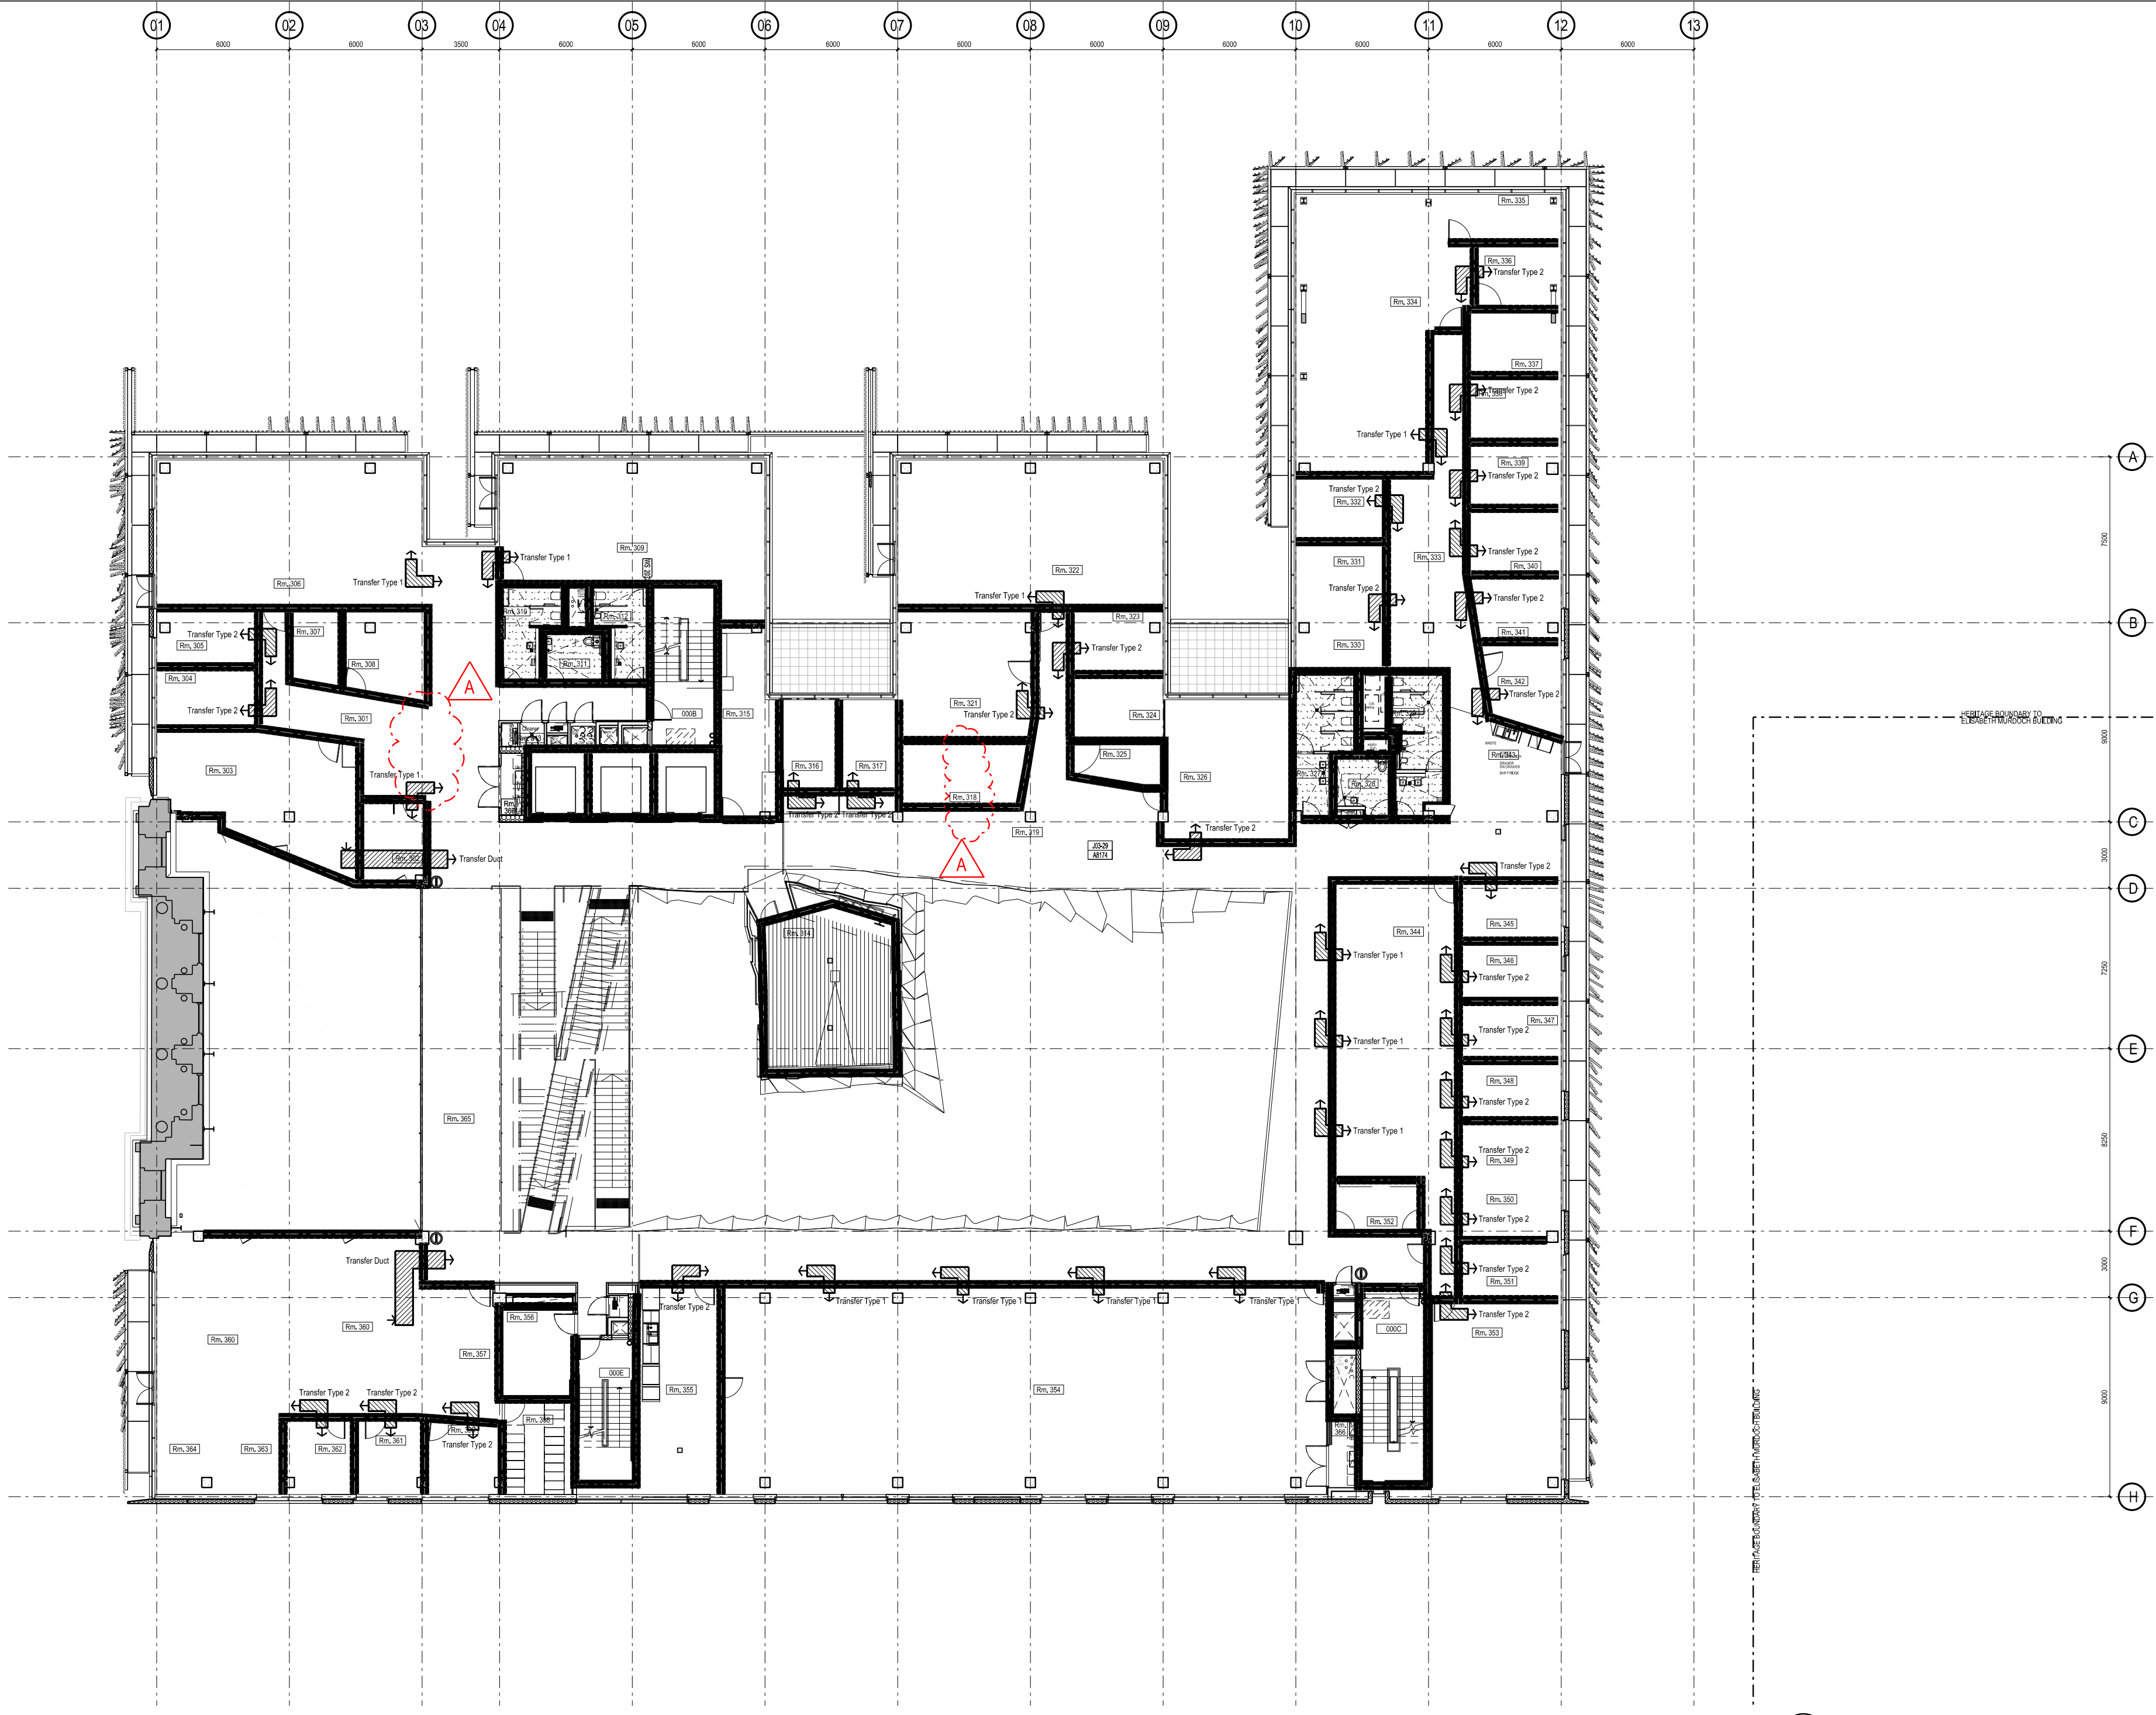

03 LEVEL 03 - AREA DIAGRAM
SCALE 1:200



04 LEVEL 04 - AREA DIAGRAM
SCALE 1:200

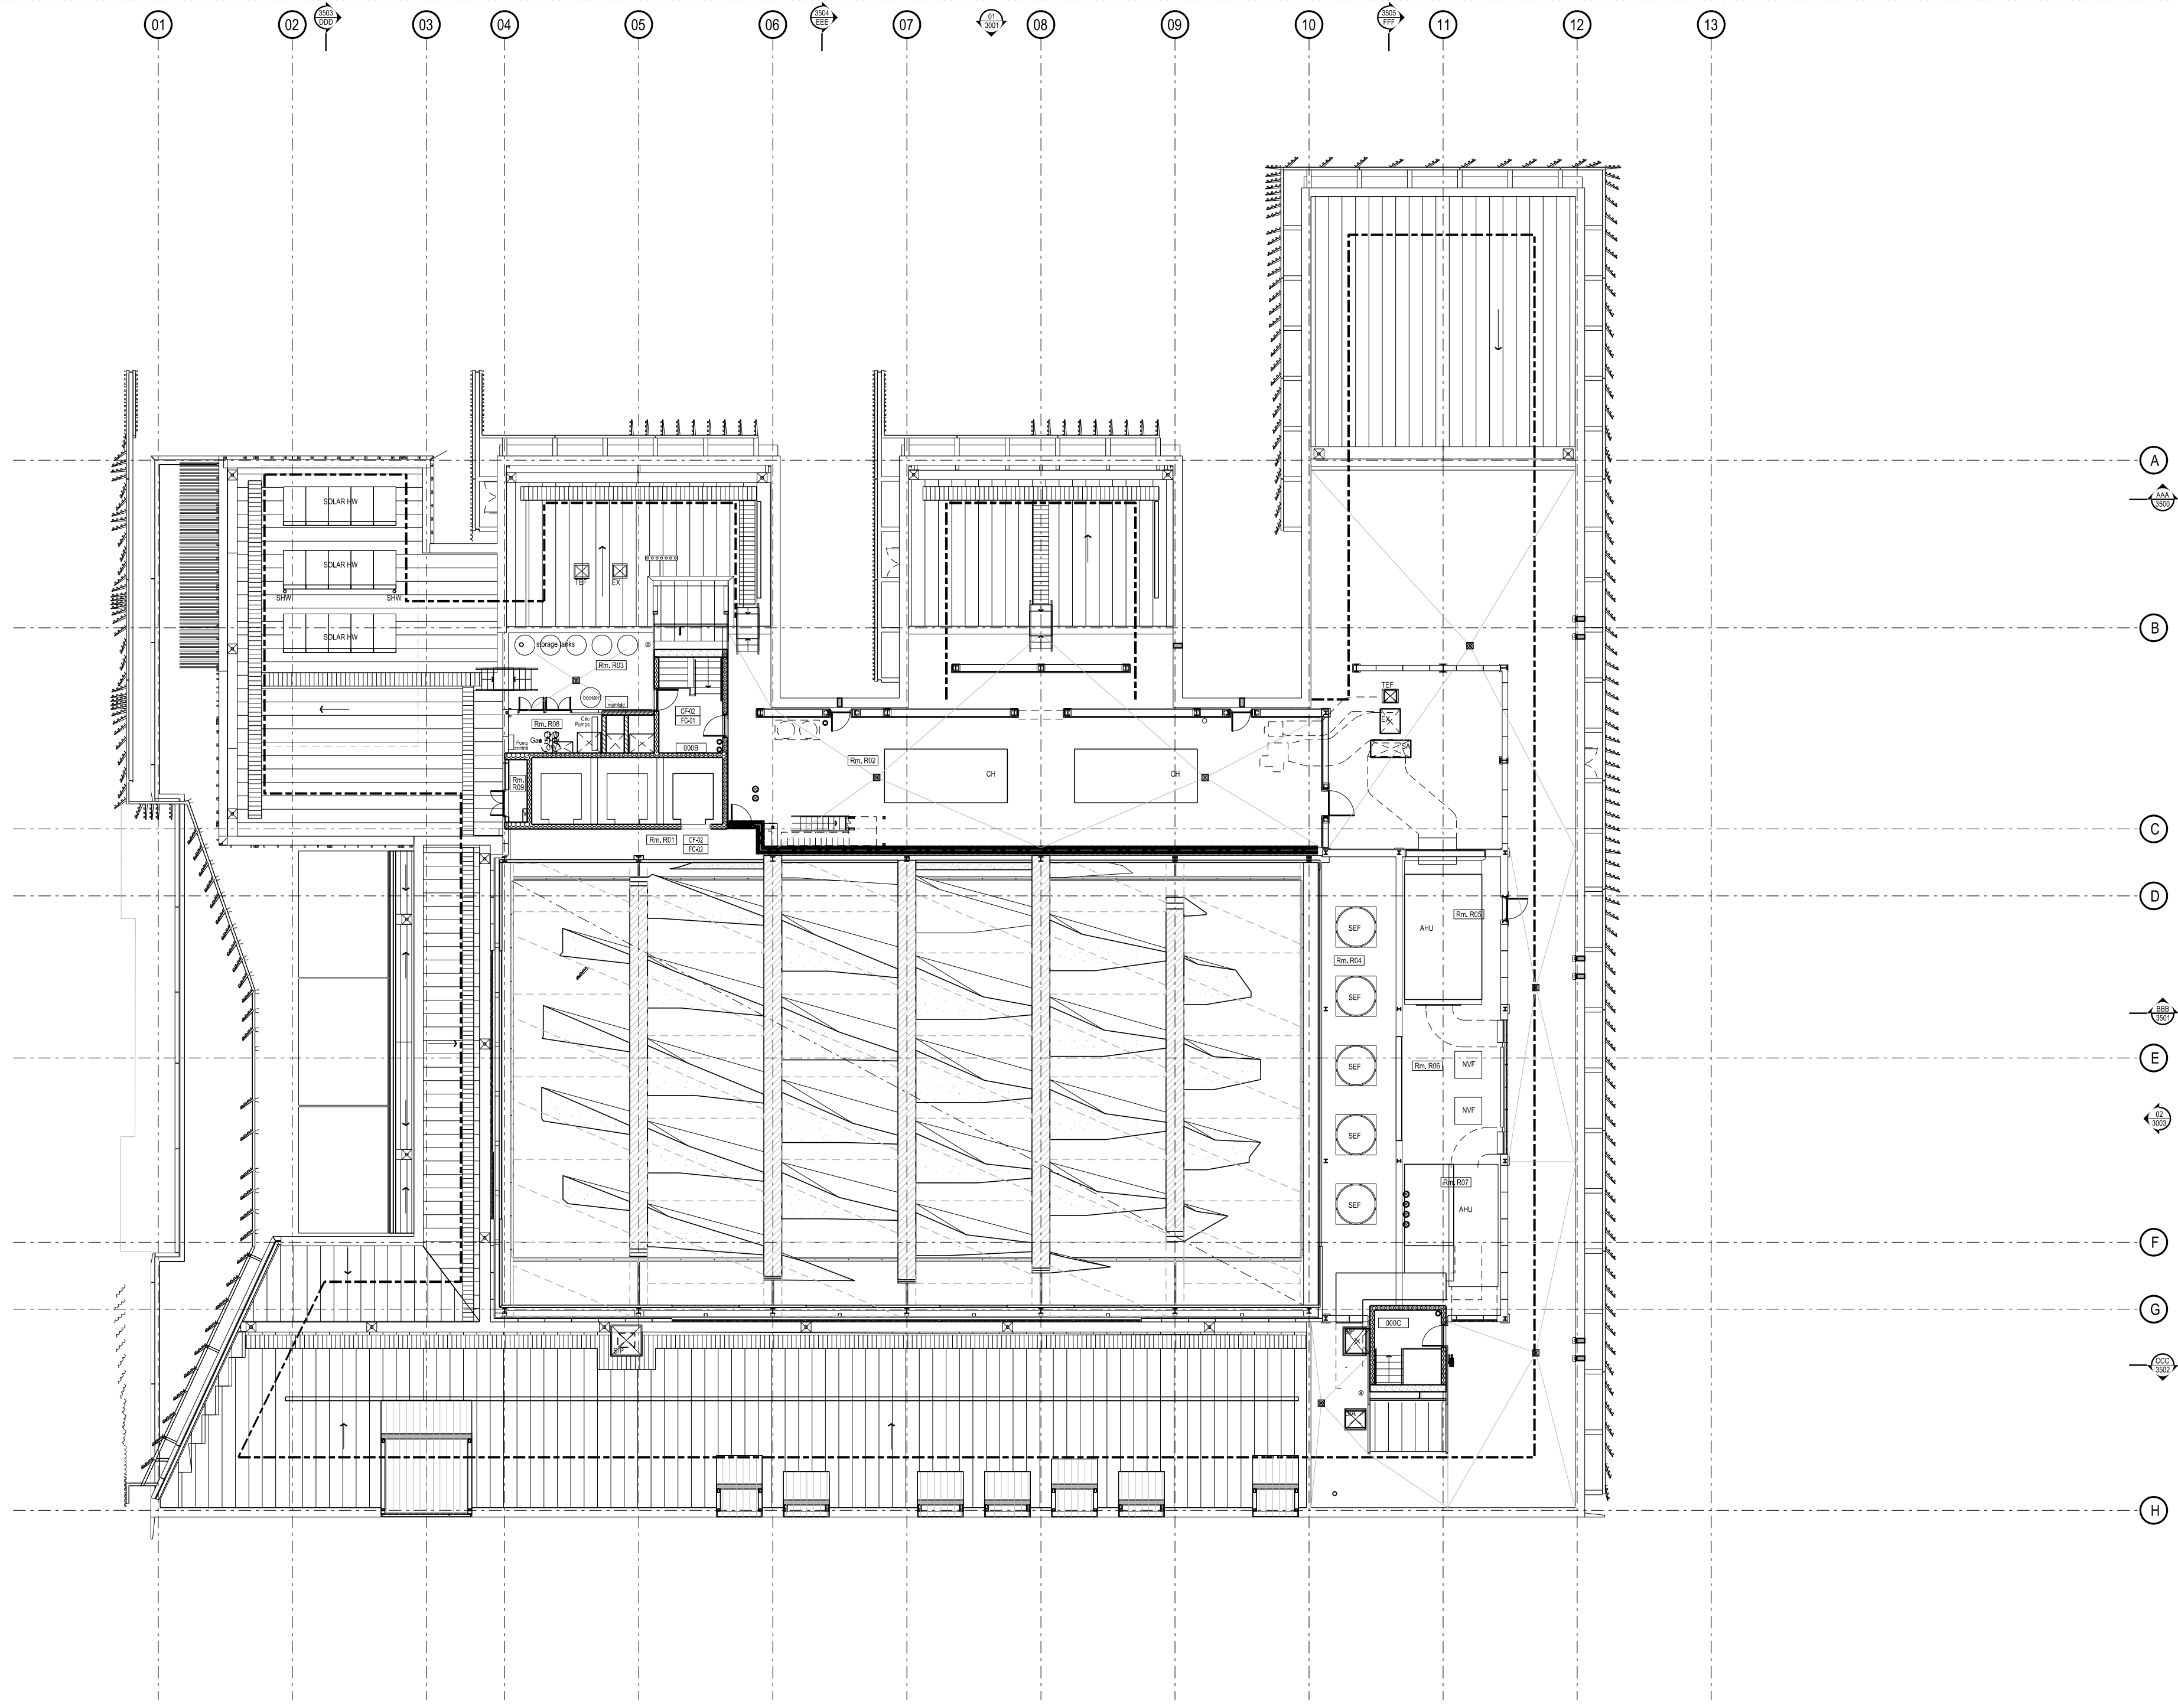

05 LEVEL 05 - AREA DIAGRAM
SCALE 1:200

A	SG	ACOUSTIC WALL ZONE DELETED / UPDATES	-	21.11.13
09	SG	100% CD - TENDER ISSUE	-	07.09.12
08	SG	90% CD ISSUE	-	10.08.12
07	SG	75% CD ISSUE	-	13.07.12
06	SG	55% CD ISSUE	-	01.06.12
05	SG	25% CD ISSUE	-	20.04.12
04	SG	FINAL DD ISSUE	-	24.02.12
03	SG	DD UPDATE	-	20.01.12
02	SG	DESIGN DEVELOPMENT ISSUE	-	22.12.11
01	SG	PRELIMINARY DD	-	02.11.11



NADAAA
 NADAAA
 1920 Washington Street No.2 Boston Massachusetts 02118 USA
 Telephone +1 617 442 8232 Facsimile +1 688 442 1417 Email nadaaa@nadaaa.com

John Wardle Architects
 25 Rokeby Street, Collingwood, Victoria 3066 Australia
 Tel: +61 3 8662 0400 www.johnwardlearchitects.com
 © 2012 John Wardle Architects ABN 83 006 814 268

Client **University of Melbourne Parkville Campus**

Project **Faculty of Architecture Building and Planning**

Title **Acoustic Zone Diagrams L03, L04, L05**

Project No.	0913	Scale	1:200 @ A0 1:400 @ A2
Drawing No.	AR0611	Revision	A

Date: JM - 2011 Drawn: Co-Ord: Chk:

FILENAME - \$FILES

FOR CONSTRUCTION