


THIS DRAWING IS AN UNCONTROLLED COPY UNLESS STAMPED OTHERWISE

CONTRACTORS SHALL VERIFY ALL DIMENSIONS BEFORE ANY WORK COMMENCES. ALL SHOP DRAWINGS SHALL BE SUBMITTED TO THE SUPERINTENDENT AND MANUFACTURER. ALL WORK SHALL COMPLY WITH THE RULES OF PRACTICE AND MANUFACTURE OF THE CONTRACTOR. DIMENSIONS SHALL TAKE PRECEDENCE OVER SCALES. THIS DRAWING IS THE PROPERTY OF NADAAA AND SHALL BE RETURNED TO NADAAA UPON REQUEST. REVISIONS SHALL BE SHOWN BY CIRCLED NUMBERS AND DIMENSIONS SHALL TAKE PRECEDENCE OVER SCALES.

- General Notes & Legend**
- KEY REFERENCE ARCHITECTURAL DRAWING SERIES:**
 FACADE SETOUT AR1502 - AR1507
 PRECAST SETOUT AR1512 - AR1517
 SCREEN SETOUT AR1522 - AR1527
 SCREEN DETAILS AR6550 - AR6554
 PRECAST DETAILS AR6300 - AR6304
- LEGEND:**
- FAxxx FACADE TYPE, REFER FACADE SCHEDULE FC FACADE NOTE
- AWM AWNING WINDOW MANUAL
 - AWA AWNING WINDOW AUTOMATIC
 - ALV ACTIVE LOUIRE - NATURAL VENTILATION WITH DAMPER
 - ALM ACTIVE LOUIRE - MECHANICAL
 - NL NON-ACTIVE LOUIRE
 - FP FIXED PANEL
 - SP SPANDREL PANEL
 - FJ FALSE JOINT - REF. TO PRECAST DETAILS
 - VB VISIBLE BACKPAN
 - UJ MOVEMENT JOINT
 - LS LIGHT SHELF
- FACADE NOTES SPECIFIC:**
 FC.01 PROVIDE NOTCH IN PRECAST FOR STEEL OUTRIGGER/STUB BEAM REF. TO AR6003 & AR6303
 FC.02
 FC.03

FACADE/PRECAST CODE	FRONT FINISH	REAR FINISH
PR-21	HONED	---
FR-08	OFF-FORM	---
PR-08	HONED	ACID WASH
FR-09	OFF-FORM	ACID WASH
FR-10	HONED	HONED

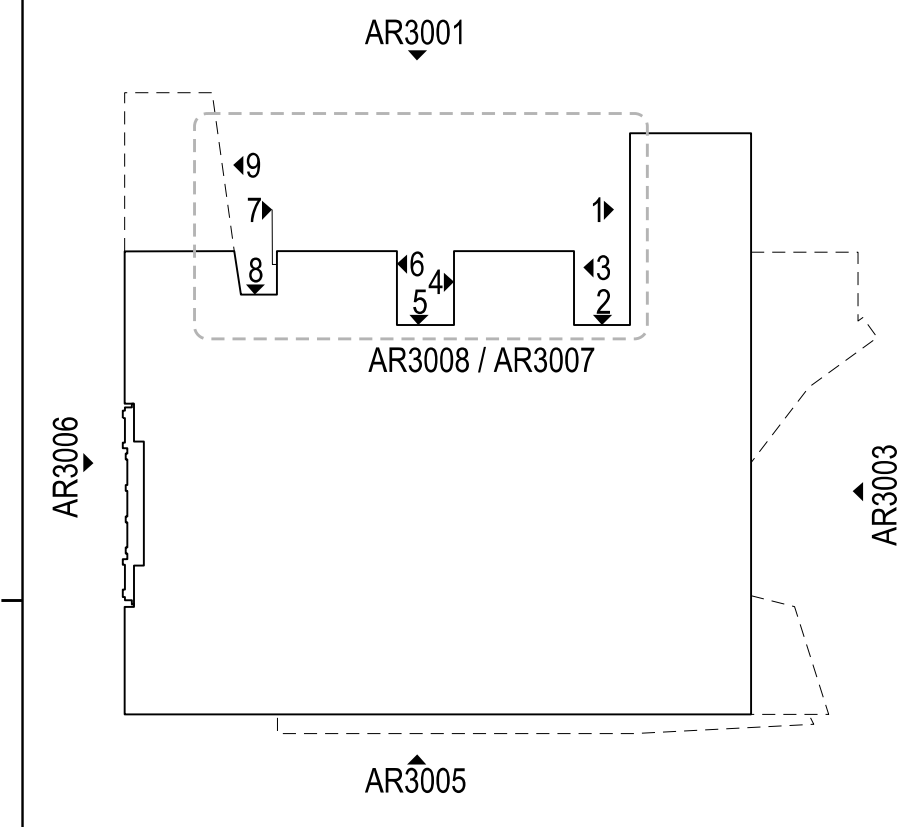

SETS/ISSUES/REVISED

Rev	Issue	Revision Description	Amd	Date
7	SG	ISSUED FOR CONSTRUCTION	-	24.07.13
6	SG	TENDER ISSUE	-	18.04.13
5	SG	VALUE MANAGEMENT ISSUE	-	28.03.13
4	SG	PRECAST REVIEW	-	21.03.13
3	SG	TENDER ADDENDUM 4	-	08.10.12
2	SG	TENDER ADDENDUM 3	-	02.10.12
1	SG	100% CD - TENDER ISSUE	-	07.09.12
0	SG	75% CD ISSUE	-	13.07.12



NADAAA
 NADAAA
 1320 Washington Street No.2 Boston Massachusetts 02118 USA
 Telephone: +1 617 442 8232
 Facsimile: +1 688 442 1417
 Email: nadaaa@nadaaa.com

John Wardle Architects
 25 Rokeby Street, Collingwood, Victoria 3066 Australia
 Tel: +61 3 8662 0400
 www.johnwardlearchitects.com.au
 © 2012 John Wardle Architects ABN 83 006 814 268

Client: University of Melbourne
 Parkville Campus

Project: Faculty of Architecture
 Building and Planning

Title: PRECAST SETOUT PLAN
 LEVEL 01

Project No.	0913	Scale:	1:100 @ A0 1:200 @ A2
Drawing No.	AR1513	Revision	A
Date: May 2011	Drawn	Co-Ord	Check

FILENAME: SFILES
FOR CONSTRUCTION

