
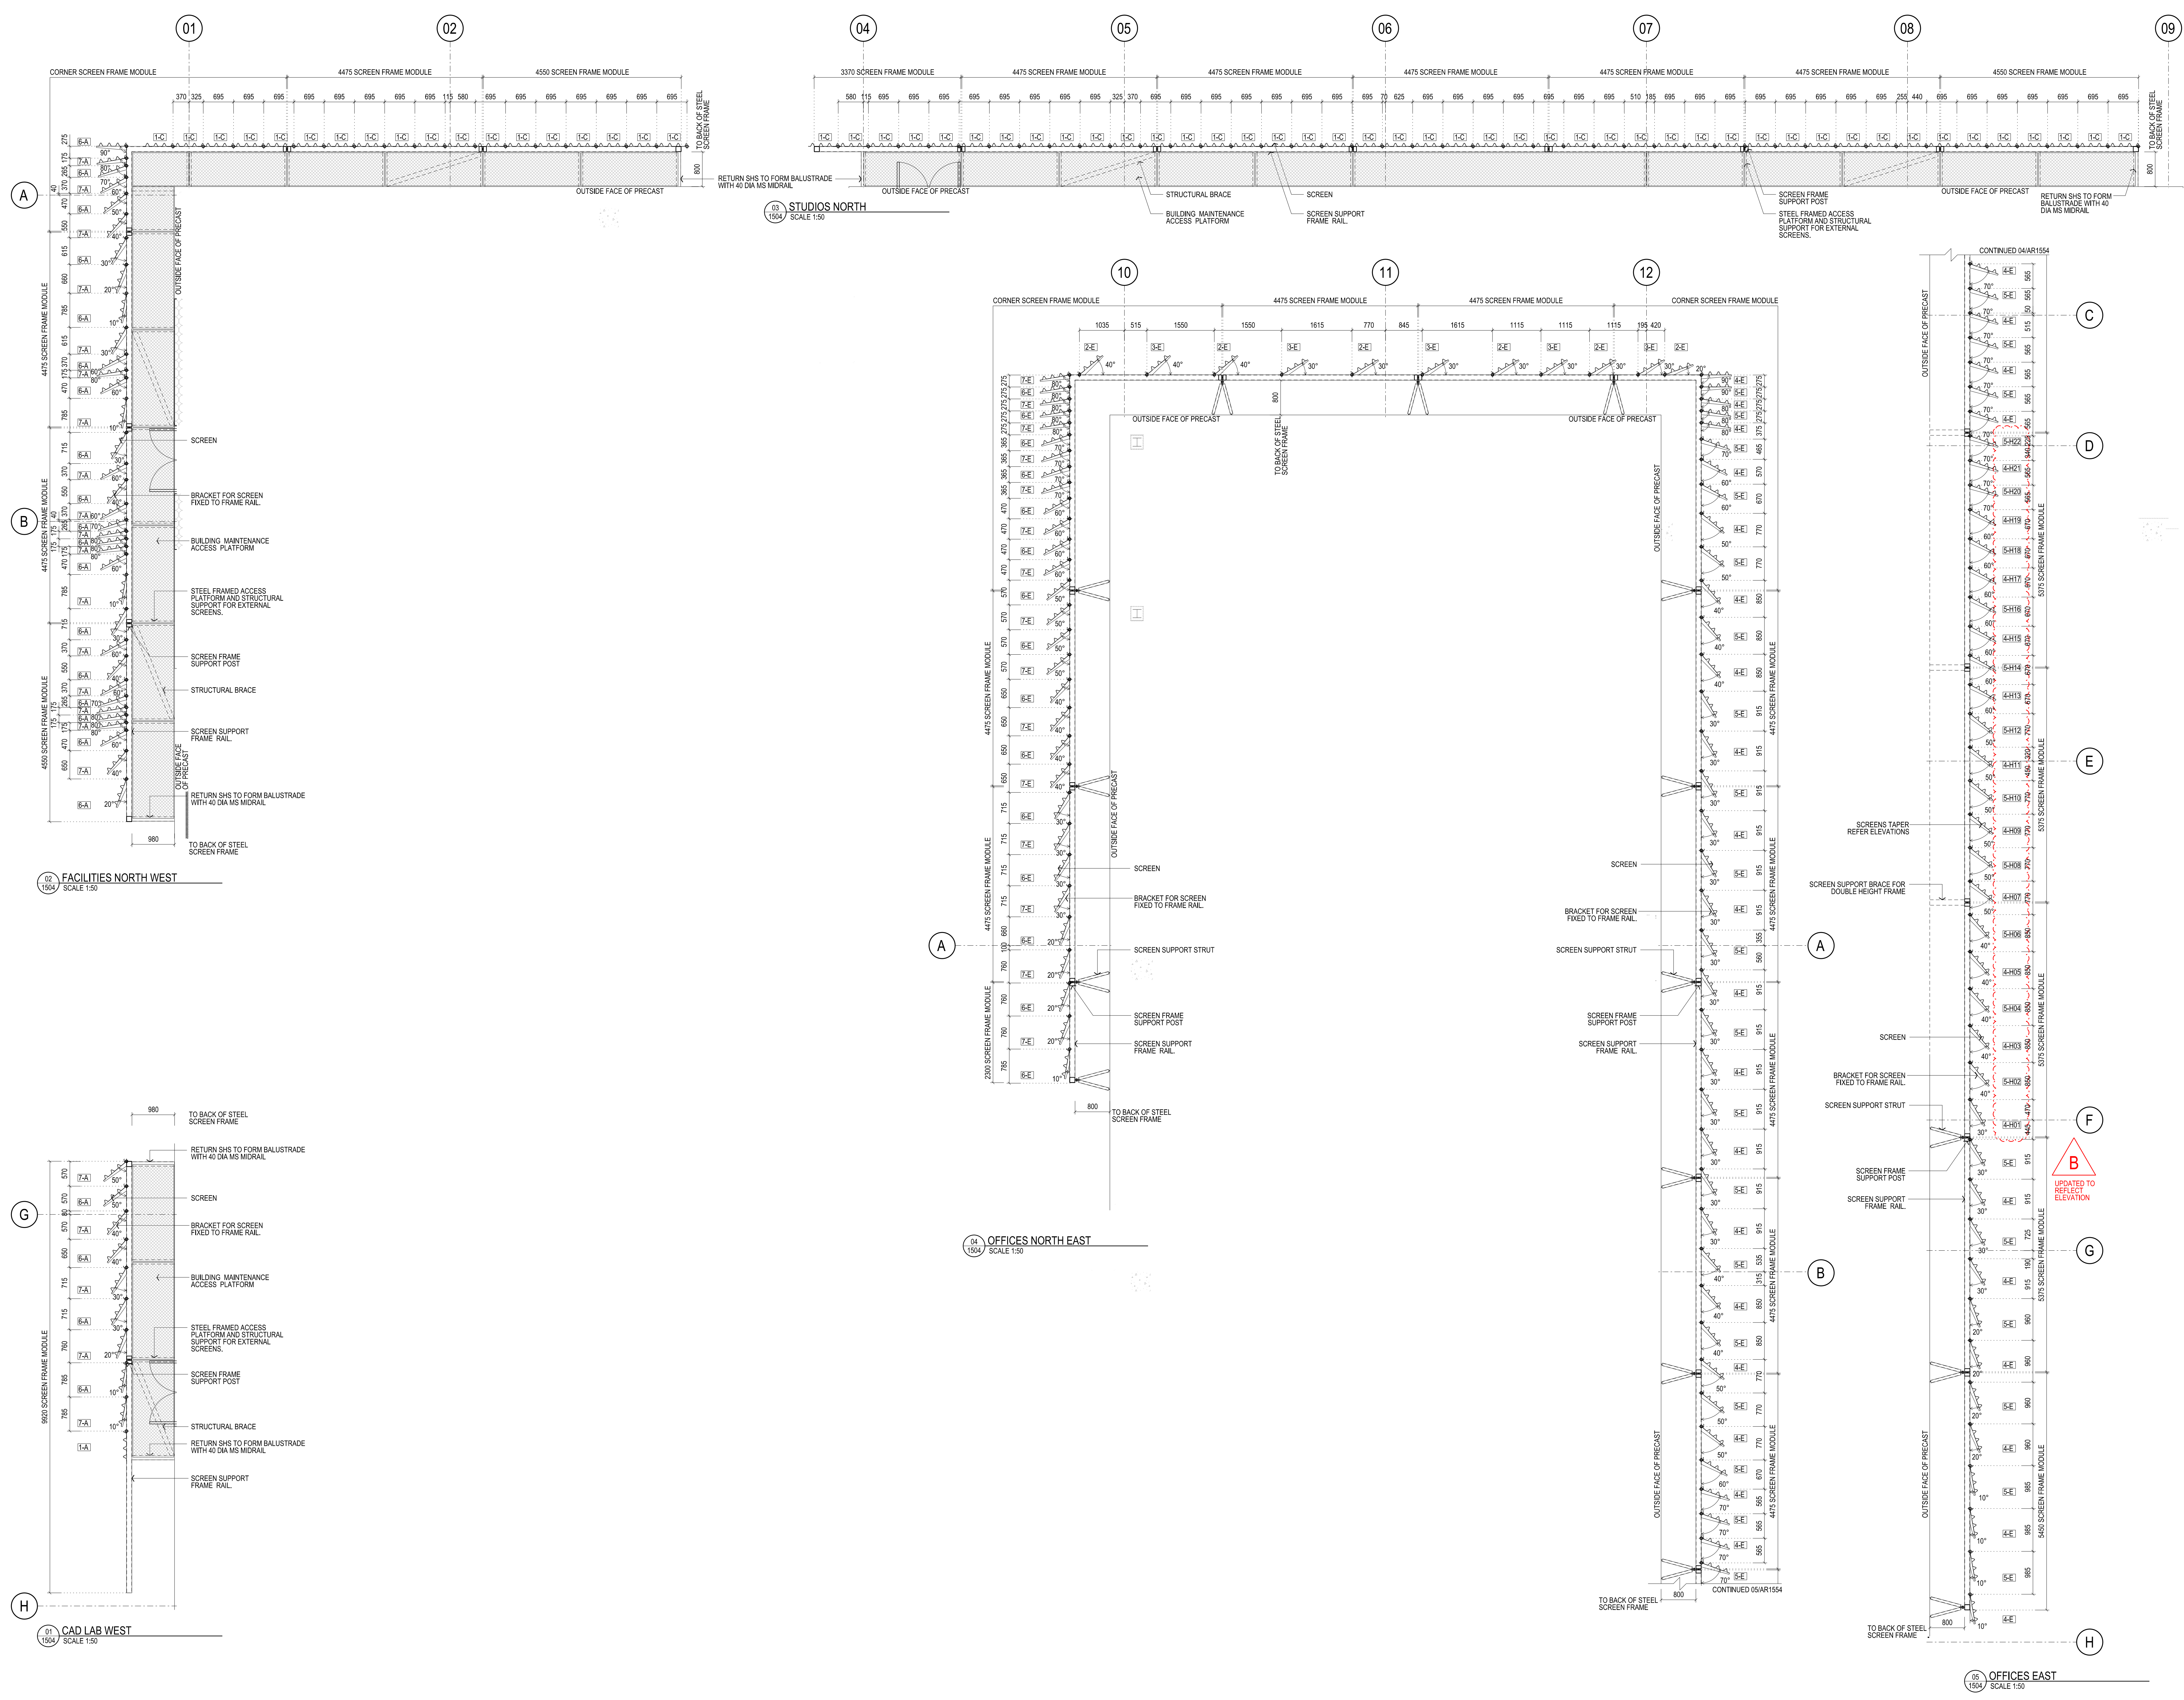


CONTRACTORS SHALL VERIFY JOB DIMENSIONS BEFORE ANY JOB COMMENCES. ALL SHOP DRAWINGS SHALL BE SUBMITTED TO THE SUPERINTENDENT AND MANUFACTURER SHALL NOT COMMENCE FROM THE RETURN OF DRAWINGS SHOWN. BY THE CONSULTANT. DIMENSIONS SHALL TAKE PRECEDENCE OVER SCALES. THIS DRAWING SHALL BE READ IN CONJUNCTION WITH ALL RELEVANT CONTRACT SPECIFICATIONS AND DRAWINGS COPYRIGHT OF THIS DRAWING IS VESTED IN HANDLE.

General Notes

- REFER ARCHITECTURAL DRAWINGS:
- FACADE SETOUT AR1502-AR1507
 - PRECAST SETOUT AR1512-AR1517
 - SCREEN SETOUT AR1552-AR1557
 - SCREEN DETAILS AR8550-AR8554

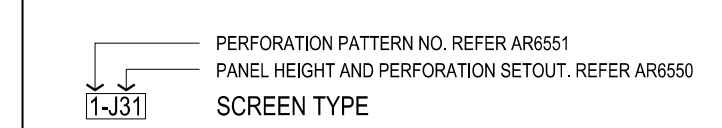

Rev	Issue	Revision Description	And	Date
B	SG	UPDATED SETOUT TYPES	-	13.12.13
A	SG	ISSUED FOR CONSTRUCTION	-	04.08.13
04	SG	VALUE MANAGEMENT ISSUE	-	28.03.13
03	SG	100% CD - TENDER ISSUE	-	07.09.12
02	SG	90% CD ISSUE	-	10.08.12
01	SG	75% CD ISSUE	-	13.07.12



NADAAA
 NADAAA
 1520 Washington Street No.2 Boston Massachusetts 02115 USA
 Telephone +1 617 442 8232 Facsimile +1 617 442 1417 Email nadaaa@nadaaa.com

John Wardle Architects
 25 Rokeby Street, Collingwood, Victoria 3066 Australia
 Tel: +61 3 8662 0400 www.johnwardlearchitects.com
 © 2012 John Wardle Architects ABN 83 006 814 268

Client **University of Melbourne Parkville Campus**
 Project **Faculty of Architecture Building and Planning**
 Title **EXTERNAL SCREEN SETOUT PLAN LEVEL 02**

Project No. **0913** Scale 1:50 @ A0
 Drawing No. **AR1554** Revision **B**

DATE: July 2012 Dwn - Co-Ord - Chk -
 FILENAME - \$FILES

FOR CONSTRUCTION