


THIS DRAWING IS AN UNCONTROLLED COPY UNLESS STAMPED OTHERWISE

CONTRACTORS SHALL VERIFY DIMENSIONS BEFORE ANY JOB COMMENCES. ALL SHOP DRAWINGS SHALL BE SUBMITTED TO THE SUPERINTENDENT AND MANUFACTURERS SHALL NOT COMMENCE FROM THE RETURN OF DRAWINGS UNLESS APPROVED BY THE CONSULTANT. DIMENSIONS SHALL TAKE PRECEDENCE OVER SCALES. THIS DRAWING SHALL BE USED IN CONSTRUCTION WITH ALL RELEVANT CONTRACT SPECIFICATIONS AND DRAWINGS COPYRIGHT OF THIS DRAWING IS VESTED IN HANDLE.

General Notes

- REFER ARCHITECTURAL DRAWINGS:
- FAÇADE SETOUT AR1502-AR1507
 - PRECAST SETOUT AR1512-AR1517
 - SCREEN SETOUT AR1552-AR1557
 - SCREEN DETAILS AR8550-AR8554

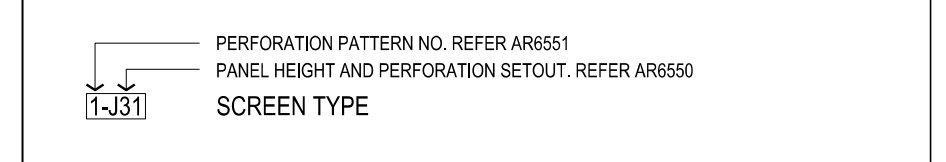

Rev	Issue	Revision Description	And	Date
C	SG	SCREEN TYPE REVISED	-	13.12.13
B	SG	SCREEN SETOUT REVISED TO SUIT	-	28.11.13
A	SG	ISSUED FOR CONSTRUCTION	-	04.09.13
04	SG	VALUE MANAGEMENT ISSUE	-	28.03.13
03	SG	100% CD - TENDER ISSUE	-	07.09.12
02	SG	90% CD ISSUE	-	10.09.12
01	SG	75% CD ISSUE	-	13.07.12

Brookfield MULTIPLEX

NADAAA
 NADAAA
 1320 Washington Street No.2
 Boston Massachusetts 02118 USA
 Telephone +1 817 442 8232
 Facsimile +1 888 442 1417
 Email nadaaa@nadaaa.com

John Wardle Architects
 25 Rokeby Street, Collingwood, Victoria 3066 Australia
 Tel: +61 3 8662 0400 www.johnwardlearchitects.com
 © 2012 John Wardle Architects ABN 83 006 814 268

Client **University of Melbourne Parkville Campus**

Project **Faculty of Architecture Building and Planning**

Title **EXTERNAL SCREEN SETOUT PLAN LEVEL 04**

Project No. **0913** Scale 1:50 @ A0

Drawing No. **AR1556** Revision **C**

Date July 2012 Drawn - Co-Ord - Check -

FILENAME - SFRS

FOR CONSTRUCTION