


THIS DRAWING IS AN UNCONTROLLED COPY UNLESS STAMPED OTHERWISE
 CONTRACTORS SHALL VERIFY DIMENSIONS BEFORE ANY WORK COMMENCES.
 ALL SHOP DRAWINGS SHALL BE SUBMITTED TO THE SUPERINTENDENT AND MANUFACTURER
 SHALL NOT COMMENCE PRIOR TO THE RETURN OF DRAWINGS (SHOP DRAWINGS REVIEWED)
 BY THE CONSULTANT. FIGURED DIMENSIONS SHALL TAKE PRECEDENCE OVER SCALED. THIS
 DRAWING SHOULD BE READ IN CONJUNCTION WITH ALL RELEVANT CONTRACT SPECIFICATIONS
 AND DRAWING COPYRIGHT OF THIS DRAWING IS VESTED IN NADAAA.

- General Notes
1. ALL PANELS ABUTTING PARTITIONS OR STRUCTURE SHALL BE FIELD-VERIFIED FOR FINAL DIMENSIONS.
 2. SEE SHEETS AR7000 AND AR7001 FOR CL-05 CEILING DETAILS.
 3. G.C. TO COORDINATE ALL LIGHT FITTINGS AND LENGTHS W/ MESH CEILING SYSTEM.

WINDOW BLIND LEGEND

- MANUAL ROLLER BLIND
- BC-01 TYPICAL WORKSPACE BLIND
- BC-02 TYPICAL JR FACADE BLIND
- S1 BLIND FOR FACADE TYPES FS-01 & FS-02 ON NORTH, NORTH-EAST & NORTH-WEST ELEVATIONS.
- S2 SAME AS S1 BUT W/ VARIOUS WIDTHS.
- S3 BLIND FOR FACADE TYPE FS-08 ON LEVEL 1 SOUTH.
- S4 SAME AS S3 BUT W/ SHORTER WIDTH.
- S5 BLIND FOR FACADE TYPE FS-05 ON EAST, NORTH-WEST & SOUTH-WEST ELEVATIONS.
- S6 SAME AS S5 BUT W/ SHORTER WIDTH OR AT LOCATION OF ACCESS WINDOW.
- S7 BLIND FOR FACADE TYPE FS-07 ON SOUTH WALL WIDTH VARIES.
- S8 BLIND FOR FACADE TYPE FS-17 ON SOUTH WALL EXCEPT LEVEL 4 CLEARESTORY. WIDTH VARIES.
- S9 BLIND FOR FACADE TYPE FS-17 ON SOUTH WALL LEVEL 4 CLEARESTORY.
- S10 BLIND FOR EXTRA LARGE FACADE TYPE FS-17 ON SOUTH WALL LEVEL 4 CLEARESTORY.
- S11 BLIND FOR FACADE TYPE FS-04 ON EAST ELEVATION WIDTH VARIES.

D	SG	UPDATES AS CLOUDED	-	30.01.14
C	SG	FOR CONSTRUCTION	-	22.01.14
		50mm TOLERANCE		
B	SG	FOR CONSTRUCTION	-	19.11.13
		20mm TOLERANCE		
A	SG	FOR CONSTRUCTION	-	11.10.13
06	SG	FOR TENDER ISSUE	-	17.09.13
06	SS	FOR TENDER ISSUE	-	17.09.13
05	SG	FOR TENDER ISSUE	-	04.09.13
04	SG	FOR INFORMATION ISSUE	-	26.07.13
03	SG	VALUE MANAGEMENT ISSUE	-	28.03.13
02	JC	100% CD - TENDER ISSUE	-	07.09.12
01	JC	90% CD ISSUE	-	10.08.12

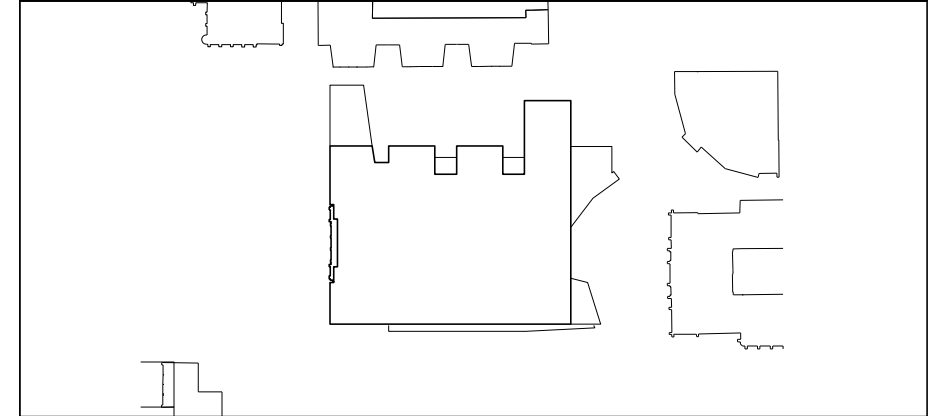

NADAAA
 NADAAA
 1320 Washington Street No.2
 Boston Massachusetts
 02118 USA
 Telephone +1 617 442 8232
 Facsimile +1 609 442 1417
 Email nads@nadaaa.com

John War I Archit cts
 © 2011 John Wardle Architects
 Level 10, 180 Russell Street, Melbourne Victoria 3000 Australia
 Tel : +613 9654 8700 www.johnwardlearchitects.com

Client **University of Melbourne Parkville Campus**

Project **Faculty of Architecture Building and Planning**

Title **RCP - LEVEL 01 SETOUT**

	Project No. 0913	Scale 1:100
	Drawing No. AR2503	Revisor D

Date JAN 2014 Dwn - Co-Ord - Chk -

FILENAME:####

FOR CONSTRUCTION