


THIS DRAWING IS AN UNCONTROLLED COPY UNLESS STAMPED OTHERWISE
 CONTRACTORS SHALL VERIFY DIMENSIONS BEFORE ANY WORK COMMENCES. ALL WORK PROVIDED SHALL BE SUBMITTED TO THE SUPERINTENDENT AND MANUFACTURER SHALL NOT COMMENCE PRIOR TO THE RETURN OF DIMENSIONS (IF APPLICABLE) BEING BY THE CONSULTANT. FIGURED DIMENSIONS SHALL TAKE PRECEDENCE OVER SCALED. THE DRAWING SHOULD BE READ IN CONJUNCTION WITH ALL RELEVANT CONTRACT SPECIFICATIONS AND DRAWINGS COPYRIGHT OF THIS DRAWING IS VESTED IN NADAAA.

- General Notes
1. ALL PANELS ABUTTING PARTITIONS OR STRUCTURE SHALL BE FIELD-VERIFIED FOR FINAL DIMENSIONS.
 2. SEE SHEETS AR7800 AND AR7801 FOR CL-05 CEILING DETAILS.
 3. G.C. TO COORDINATE ALL LIGHT FITTINGS AND LENGTHS W/ MESH CEILING SYSTEM.

WINDOW BLIND LEGEND:

- MANUAL ROLLER BLIND
- BC-01 TYPICAL WORKSPACE BLIND
- BC-02 TYPICAL JR FACADE BLIND
- S1 BLIND FOR FACADE TYPES FS-01 & FS-02 ON NORTH, NORTH-EAST & NORTH-WEST ELEVATIONS.
- S2 SAME AS S1 BUT W/ VARIOUS WIDTHS.
- S3 BLIND FOR FACADE TYPE FS-08 ON LEVEL 1 SOUTH.
- S4 SAME AS S3 BUT W/ SHORTER WIDTH.
- S5 BLIND FOR FACADE TYPE FS-05 ON EAST, NORTH-WEST & SOUTH-WEST ELEVATIONS.
- S6 SAME AS S5 BUT W/ SHORTER WIDTH OR AT LOCATION OF ACCESS WINDOW.
- S7 BLIND FOR FACADE TYPE FS-07 ON SOUTH WALL. WIDTH VARIES.
- S8 BLIND FOR FACADE TYPE FS-11 ON SOUTH WALL, EXCEPT LEVEL 4. CLERESTORY. WIDTH VARIES.
- S9 BLIND FOR FACADE TYPE FS-17 ON SOUTH WALL LEVEL 4. CLERESTORY.
- S10 BLIND FOR EXTRA LARGE FACADE TYPE FS-17 ON SOUTH WALL LEVEL 4. CLERESTORY.
- S11 BLIND FOR FACADE TYPE FS-04 ON EAST ELEVATION. WIDTH VARIES.

Rev	Issue	Revision Description	Amd	Date
D	SG	UPDATES AS CLOUDED		30.01.14
C	SG	FOR CONSTRUCTION		22.01.14
		50mm TOLERANCE		
B	SG	FOR CONSTRUCTION		18.11.13
		20mm TOLERANCE		
A	SG	FOR CONSTRUCTION		11.10.13
05	SG	FOR TENDER ISSUE		04.09.13
04	SG	FOR INFORMATION ISSUE		26.07.13
03	SG	VALUE MANAGEMENT ISSUE		28.03.13
02	JC	100% CD - TENDER ISSUE		07.09.12
01	JC	90% CD ISSUE		10.08.12

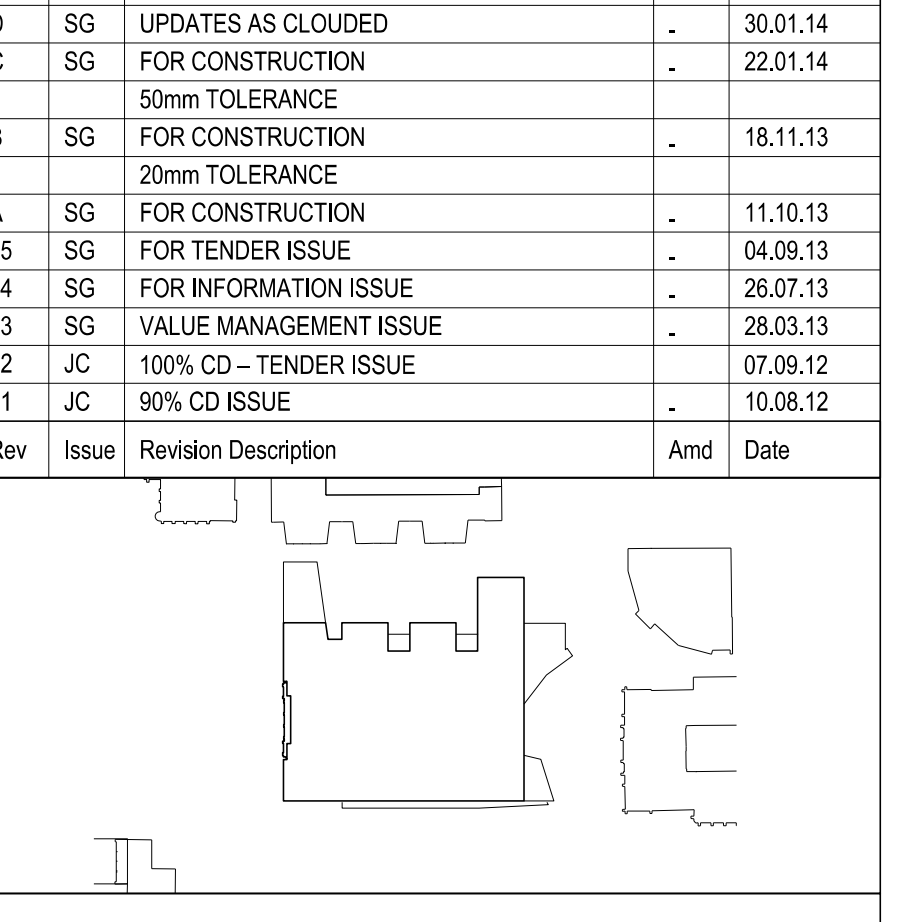

NADAAA
 NADAAA
 1520 Wellington Street No.2
 Boston Massachusetts
 02118 USA
 Telephone: +1 617 442 6232
 Facsimile: +1 617 442 1417
 Email: nadaaa@nadaaa.com

John War I Archit cts
 © 2011 John Wardle Architects
 Level 10, 180 Russell Street, Melbourne Victoria 3000 Australia
 Tel : +613 9654 8700 www.johnwardlearchitects.com

Client **University of Melbourne Parkville Campus**
 Project **Faculty of Architecture Building and Planning**
 Title **RCP - LEVEL 02 SETOUT**

	Project No. 0913	Scale: 1:100
	Drawing No. AR2504	Revision: D
Date: JAN 2014	Drawn: -	Co-Ord: -
FILENAME: #####	Drwn: -	Chk: -

FOR CONSTRUCTION