

THIS DRAWING IS AN UNCONTROLLED COPY UNLESS STAMPED OTHERWISE


CONTRACTORS SHALL VERIFY ALL DIMENSIONS BEFORE ANY WORK COMMENCES. ALL SHOP DRAWINGS SHALL BE SUBMITTED TO THE SUPERINTENDENT AND MANUFACTURERS SHALL NOT COMMENCE WORK UNTIL THE SUPERINTENDENT AND MANUFACTURERS HAVE APPROVED THE SHOP DRAWINGS. THE DRAWING SHALL BE READ IN CONJUNCTION WITH ALL RELEVANT CONTRACT SPECIFICATIONS AND DRAWINGS COPYRIGHT OF THIS DRAWING IS VESTED IN WARDLE.

KEY REFERENCE ARCHITECTURAL DRAWING SERIES:
 FACADE SETOUT AR1502 - AR1507
 PRECAST SETOUT AR1512 - AR1517
 SCREEN SETOUT AR1552 - AR1557
 SCREEN DETAILS AR550 - AR554
 PRECAST DETAILS AR6300 - AR6304

LEGEND:
 [FSX] FACADE TYPE - REFER FACADE SCHEDULE [FC] FACADE NOTE
 AWAW AWNING WINDOW MANUAL
 AWAA AWNING WINDOW AUTOMATIC
 ALV ACTIVE LOUVRE - NATURAL VENTILATION WITH DAMPER
 ALM ACTIVE LOUVRE - MECHANICAL
 NL NON-ACTIVE LOUVRE
 FP FIXED PANEL
 SP SPANDREL PANEL
 FJ FALSE JOINT - REFER TO PRECAST DETAILS
 VB VISIBLE BACKPAN
 MJ MOVEMENT JOINT
 LS LIGHT SHELF

FACADE NOTES SPECIFIC:
 FC.01 PROVIDE NOTCH IN PRECAST FOR STEEL OUTRIGGER/STUB BEAM REFER TO AR6303 & AR6303
 FC.02 -
 FC.03 -

FACADE/PRECAST CODE	FRONT FINISH	REAR FINISH
PR.01	HONED	---
PR.06	OFF-FORM	---
PR.08	HONED	ACID WASH
PR.09	OFF-FORM	ACID WASH
PR.10	HONED	HONED

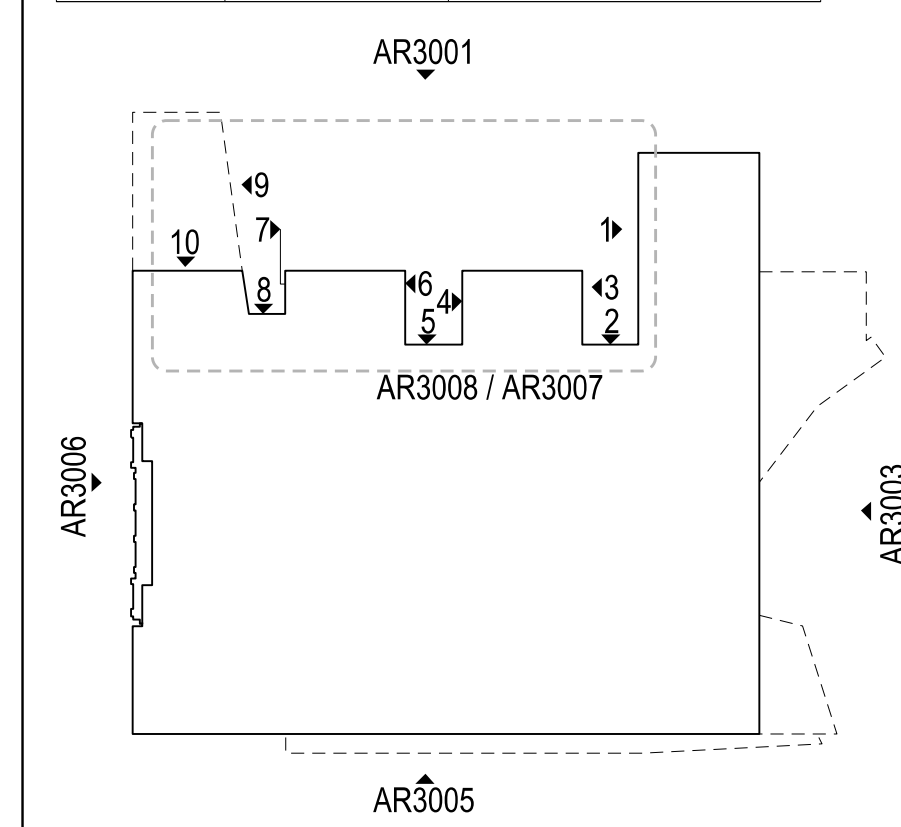

Rev	Issue	Revision Description	And	Date
D	SG	FACADE AMENDED L01 1m GRIDS 1 & 3.		05.12.13
C	SG	WINDOW TAGS ADDED		18.11.13
B	SG	OVERLAYS AND REFS ADDED		09.10.13
		FACADE TAGS ADDED:		
		NW TERRACE FACADE TYPE AMENDED		
		EXTENT OF AWNING WINDOWS UPDATED:		
A	SG	ISSUED FOR CONSTRUCTION		16.09.13
15	SG	VALUE MANAGEMENT UPDATE		12.04.13
14	SG	VALUE MANAGEMENT UPDATE		28.03.13
13	SG	PRECAST REVIEW		21.03.13
12	SG	TENDER ADDENDUM 4		08.10.12
11	SG	TENDER ADDENDUM 3		02.10.12
10	SG	100% CD - TENDER ISSUE		07.09.12
09	SG	90% CD ISSUE		10.08.12
08	SG	75% CD ISSUE		13.07.12
07	SG	50% CD ISSUE		08.06.12
06	SG	25% CD ISSUE		20.04.12
05	JC	FINLL DD ISSUE		24.02.12
04	JC	DESIGN DEVELOPMENT ISSUE		20.01.12
03	JC	DESIGN DEVELOPMENT ISSUE		22.12.11
02	JC	PRELIMINARY DD		02.11.11
01	JC	PRELIMINARY DD		07.10.11



NADAAA
 NADAAA
 1520 Washington Street No.2 Boston Massachusetts 02118 USA
 Telephone +1 617 442 8232 Facsimile +1 858 442 1417 Email nadaaa@nadaaa.com

John Wardle Architects
 25 Rokeby Street, Collingwood, Victoria 3066 Australia
 Tel: +61 3 8662 0400 www.johnwardlearchitects.com
 © 2012 John Wardle Architects ABN 63 006 814 268

Client **University of Melbourne Parkville Campus**

Project **Faculty of Architecture Building and Planning**

Title **ELEVATIONS NORTH WITHOUT SCREEN**

Project No.	0913	Scale	1:100 @ A0 1:200 @ A2
Drawing No.	AR3001	Revision	D

Date May 2011 Drawn - Co-Ord - Check -

FILENAME - SFILES

FOR CONSTRUCTION

