

THIS DRAWING IS AN UNCONTROLLED COPY UNLESS STAMPED OTHERWISE

CONTRACTORS SHALL VERIFY ALL DIMENSIONS BEFORE ANY WORK COMMENCES. ALL SHOP DRAWINGS SHALL BE SUBMITTED TO THE SUPERINTENDENT AND MANUFACTURER SHALL NOT COMMENCE WORK UNTIL THE RETURN OF APPROVED SHOP DRAWINGS IS RECEIVED. BY THE CONSULTANT FOUR-DIMENSIONAL SHALL TAKE PRECEDENCE OVER SCALED. THIS DRAWING SHOULD BE READ IN CONJUNCTION WITH ALL RELEVANT CONTRACT SPECIFICATIONS AND DRAWINGS COPYRIGHT OF THIS DRAWING IS VESTED IN WARDLE.

General Notes


KEY REFERENCE ARCHITECTURAL DRAWING SERIES:
 FACADE SETOUT AR1502 - AR1507
 PRECAST SETOUT AR1512 - AR1517
 SCREEN SETOUT AR1552 - AR1557
 SCREEN DETAILS AR8550 - AR8554
 PRECAST DETAILS AR8300 - AR8304

LEGEND:

FSXX FACADE TYPE, REFER FACADE SCHEDULE
 AWAW AWNING WINDOW MANUAL
 AWAA AWNING WINDOW AUTOMATIC
 ALV ACTIVE LOUVRE - NATURAL VENTILATION WITH DAMPER
 ALM ACTIVE LOUVRE - MECHANICAL
 NL NON-ACTIVE LOUVRE
 FP FIXED PANEL
 SP SPANDREL PANEL
 FJ FALSE JOINT - REFER TO PRECAST DETAILS
 VB VISIBLE BACKPAN
 MJ MOVEMENT JOINT
 LS LIGHT SHELF

FACADE NOTES SPECIFIC:
 FC.01 PROVIDE NOTCH IN PRECAST FOR STEEL OUTRIGGER/STUB BEAM REFER TO AR8003 & AR8303
 FC.02 -
 FC.03 -

FACADE/PRECAST CODE	FRONT FINISH	REAR FINISH
PR.01	HONED	---
PR.06	OFF-FORM	---
PR.08	HONED	ACID WASH
PR.09	OFF-FORM	ACID WASH
PR.10	HONED	HONED

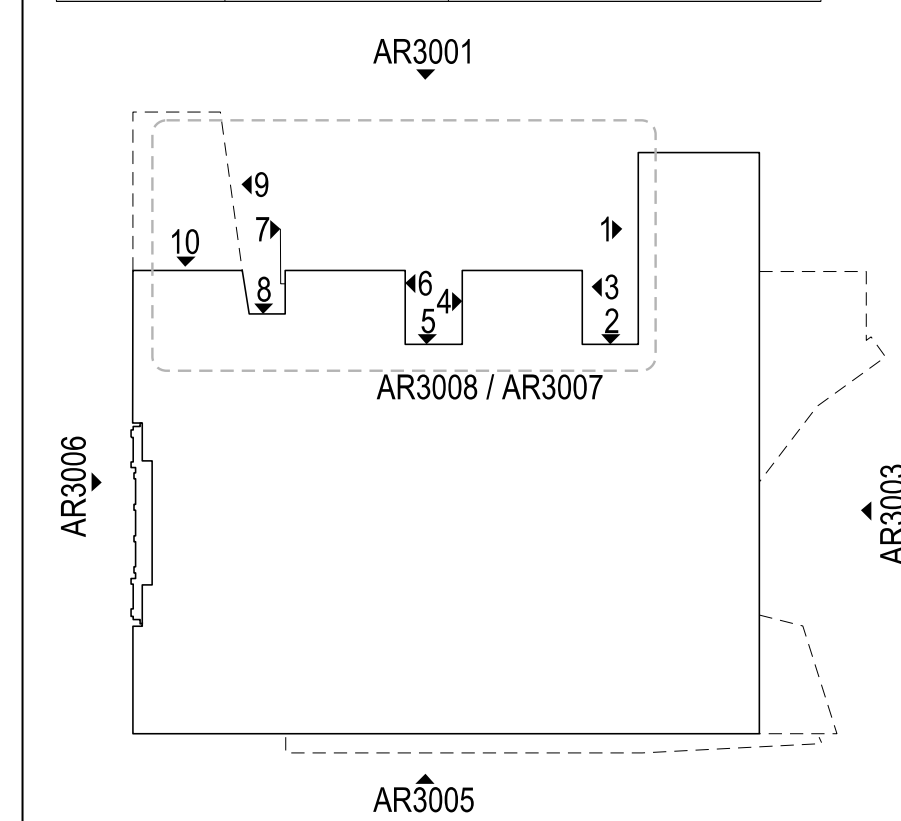

Rev	Issue	Revision Description	And	Date
D	SG	PR PANEL BREAKUP TO SUIT CONTR. GROUND FLOOR FACADE AMENDED.	-	22.01.14.
C	SG	WINDOW TAGS ADDED	-	18.11.13.
B	SG	O/PLOWS AND REFS ADDED	-	08.10.13.
A	SG	FACADE TAGS ADDED	-	08.10.13.
		EXTENT OF AWNING AMENDED:		
	SG	ISSUED FOR CONSTRUCTION	-	16.09.13.
	SG	PRECAST PANEL BREAKS REV. TO SUIT INSTALL	-	10.07.13.
	SG	FACADE TAGS ADDED	-	12.04.13.
	SG	VALUE MANAGEMENT UPDATE	-	28.03.13.
	SG	VALUE MANAGEMENT UPDATE	-	28.03.13.
	SG	PRECAST REVIEW	-	21.03.13.
	SG	TENDER ADDENDUM 4	-	08.10.12.
	SG	TENDER ADDENDUM 3	-	02.10.12.
	SG	100% CD - TENDER ISSUE	-	07.09.12.
	SG	90% CD ISSUE	-	10.08.12.
	SG	75% CD ISSUE	-	13.06.12.
	SG	50% CD ISSUE	-	08.06.12.
	SG	25% CD ISSUE	-	20.04.12.
	JC	FINAL DD ISSUE	-	24.02.12.
	JC	DESIGN DEVELOPMENT ISSUE	-	20.01.12.
	JC	DESIGN DEVELOPMENT ISSUE	-	22.12.11.
	JC	PRELIMINARY DD	-	02.11.11.
	JC	PRELIMINARY DD	-	07.10.11.



NADAAA

NADAAA
 1520 Washington Street No.2
 Boston Massachusetts 02118 USA

Telephone +1 817 442 8232
 Facsimile +1 888 442 1417
 Email nadaaa@nadaaa.com

John Wardle Architects

25 Rokeby Street, Collingwood, Victoria 3066 Australia
 Tel : +61 3 8662 0400 www.johnwardlearchitects.com
 © 2014 John Wardle Architects ABN 83 006 814 268

Client **University of Melbourne Parkville Campus**

Project **Faculty of Architecture Building and Planning**

Title **ELEVATIONS EAST WITHOUT SCREEN**

Project No.	0913	Scale	1:100 @ A0 1:200 @ A2
Drawing No.	AR3003	Revision	D

Date May 2011 Dwn - Co-Ord - Chk -

FILENAME - \$FILES

FOR CONSTRUCTION

