

THIS DRAWING IS AN UNCONTROLLED COPY UNLESS STAMPED OTHERWISE


CONTRACTORS SHALL VERIFY DIMENSIONS BEFORE ANY WORK COMMENCES. ALL SHOP DRAWINGS SHALL BE SUBMITTED TO THE SUPERINTENDENT AND MANUFACTURERS SHALL NOT COMMENCE WORK UNTIL THE SUPERINTENDENT HAS APPROVED SHOP DRAWINGS. THE DRAWING SHALL BE READ IN CONJUNCTION WITH ALL RELEVANT CONTRACT SPECIFICATIONS AND DRAWINGS COPYRIGHT OF THIS DRAWING IS VESTED IN WARDLE.

General Notes
KEY REFERENCE ARCHITECTURAL DRAWING SERIES:
FACADE SET OUT AR1502 - AR1507
PRECAST SET OUT AR1512 - AR1517
SCREEN SET OUT AR1552 - AR1557
SCREEN DETAILS AR550 - AR554
PRECAST DETAILS AR6300 - AR6304

LEGEND:
[FSXX] FACADE TYPE. REFER FACADE SCHEDULE [FC] FACADE NOTE
[AWM] AWNING WINDOW MANUAL
[AWA] AWNING WINDOW AUTOMATIC
[ALV] ACTIVE LOUVRE - NATURAL VENTILATION WITH DAMPER
[ALM] ACTIVE LOUVRE - MECHANICAL
[NL] NON-ACTIVE LOUVRE
[SP] SPANDREL PANEL
[FJ] FALSE JOINT - REFER TO PRECAST DETAILS
[VB] VISIBLE BACKPAN
[MJ] MOVEMENT JOINT
[LS] LIGHT SHELF

FACADE NOTES SPECIFIC:
FC.01 PROVIDE NOTCH IN PRECAST FOR STEEL OUTRIGGER/STUB BEAM REF. TO AR6303 & AR6303
FC.02
FC.03

FACADE/PRECAST CODE	FRONT FINISH	REAR FINISH
PR-01	HONED	---
PR-06	OFF-FORM	---
PR-08	HONED	ACID WASH
PR-09	OFF-FORM	ACID WASH
PR-10	HONED	HONED

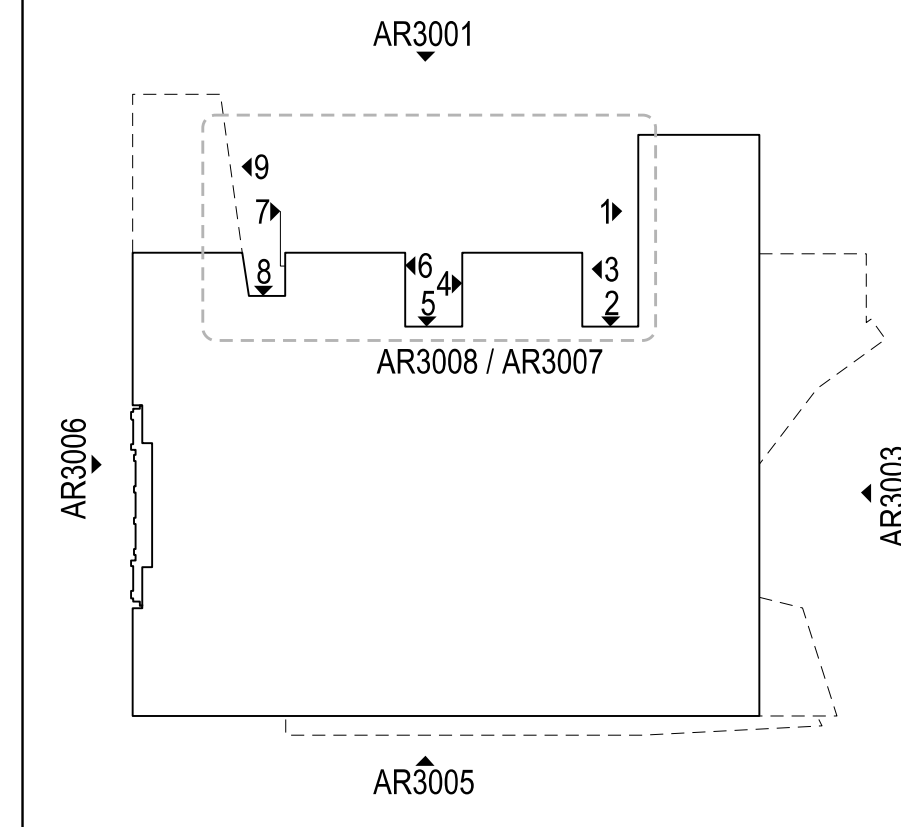

Rev	Issue	Revision Description	Amd	Date
D	SG	PRECAST/GLAZING CORNER AMENDED TO SUIT	-	18.11.13
C	SG	CALLOUTS AMENDED	-	11.11.13
B	SG	GLAZING TYPE AMENDED	-	30.09.13
A	SG	EXTENT OF AWNING WINDOWS AMENDED	-	16.09.13
A	SG	ISSUED FOR CONSTRUCTION	-	16.09.13
16	SG	PRECAST UPDATED TO SUIT TENDER COMMENT	-	01.05.13
15	SG	PANEL JOINTS TO SUIT MOVEMENT REQ'S	-	12.04.13
14	SG	VALUE MANAGEMENT UPDATE	-	28.03.13
13	SG	VALUE MANAGEMENT UPDATE	-	21.03.13
12	SG	PRECAST REVIEW	-	21.03.13
11	SG	TENDER ADDENDUM 4	-	08.10.12
10	SG	TENDER ADDENDUM 2	-	02.10.12
09	SG	100% CD - TENDER ISSUE	-	07.09.12
08	SG	90% CD ISSUE	-	10.08.12
07	SG	75% CD ISSUE	-	13.07.12
06	SG	50% CD ISSUE	-	08.06.12
05	SG	25% CD ISSUE	-	20.04.12
04	JC	FINAL DO ISSUE	-	24.02.12
03	JC	DESIGN DEVELOPMENT ISSUE	-	20.01.12
02	JC	DESIGN DEVELOPMENT ISSUE	-	22.12.11
01	JC	PRELIMINARY DD	-	07.10.11



NADAAA
NADAAA
1520 Washington Street No.2 Boston Massachusetts 02118 USA
Telephone +1 617 442 8232 Facsimile +1 688 442 1417 Email nadaaa@nadaaa.com

John Wardle Architects
25 Rokeby Street, Collingwood, Victoria 3066 Australia
Tel: +61 3 8662 0400 www.johnwardlearchitects.com
© 2012 John Wardle Architects ABN 83 006 814 268

Client University of Melbourne
Parkville Campus

Project Faculty of Architecture
Building and Planning

Title ELEVATIONS
SOUTH ELEVATION

Project No.	0913	Scale	1:100 @ A0 1:200 @ A2
Drawing No.	AR3005	Revision	D

Date: May 2011 Drawn: Co-Ord: Check:

FILENAME - SFILES
FOR CONSTRUCTION

