

THIS DRAWING IS AN UNCONTROLLED COPY UNLESS STAMPED OTHERWISE


CONTRACTORS SHALL VERIFY JOB DIMENSIONS BEFORE ANY JOB COMMENCES. ALL SHOP DRAWINGS SHALL BE SUBMITTED TO THE SUPERINTENDENT AND MANUFACTURER FOR APPROVAL PRIOR TO THE RETURN OF DIMENSIONS. SHOP DRAWINGS SHOULD BE BY THE CONSULTANT. DIMENSIONS SHALL TAKE PRECEDENCE OVER SCALES. THIS DRAWING SHOULD BE READ IN CONJUNCTION WITH ALL RELEVANT CONTRACT SPECIFICATIONS AND DRAWINGS COPYRIGHT OF THIS DRAWING IS VESTED IN NADAAA.

General Notes  
**KEY REFERENCE ARCHITECTURAL DRAWING SERIES:**  
 FACADE SETOUT AR1502 - AR1507  
 SCREEN SETOUT AR1512 - AR1517  
 SCREEN SETOUT AR1552 - AR1557  
 SCREEN DETAILS AR5500 - AR5554  
 PRECAST DETAILS AR8300 - AR8304

**LEGEND:**  
 [FSXX] FACADE TYPE, REFER FACADE SCHEDULE [FC] FACADE NOTE  
 [AWM] AWNING WINDOW MANUAL  
 [AWA] AWNING WINDOW AUTOMATIC  
 [ALV] ACTIVE LOUVRE - NATURAL VENTILATION WITH DAMPER  
 [ALM] ACTIVE LOUVRE - MECHANICAL  
 [NL] NON-ACTIVE LOUVRE  
 [FP] FIXED PANEL  
 [SP] SPANDREL PANEL  
 [FJ] FALSE JOINT - REF. TO PRECAST DETAILS  
 [VB] VISIBLE BACKPAN  
 [MJ] MOVEMENT JOINT  
 [LS] LIGHT SHELF

**FACADE NOTES SPECIFIC:**  
 FC.01 PROVIDE NOTCH IN PRECAST FOR STEEL OUTRIGGER/STUB BEAM  
 REF. TO AR8303 & AR8303  
 FC.02  
 FC.03

FACADE/PRECAST CODE	FRONT FINISH	REAR FINISH
PR.01	HONED	---
PR.06	OFF-FORM	---
PR.08	HONED	ACID WASH
PR.09	OFF-FORM	ACID WASH
PR.10	HONED	HONED

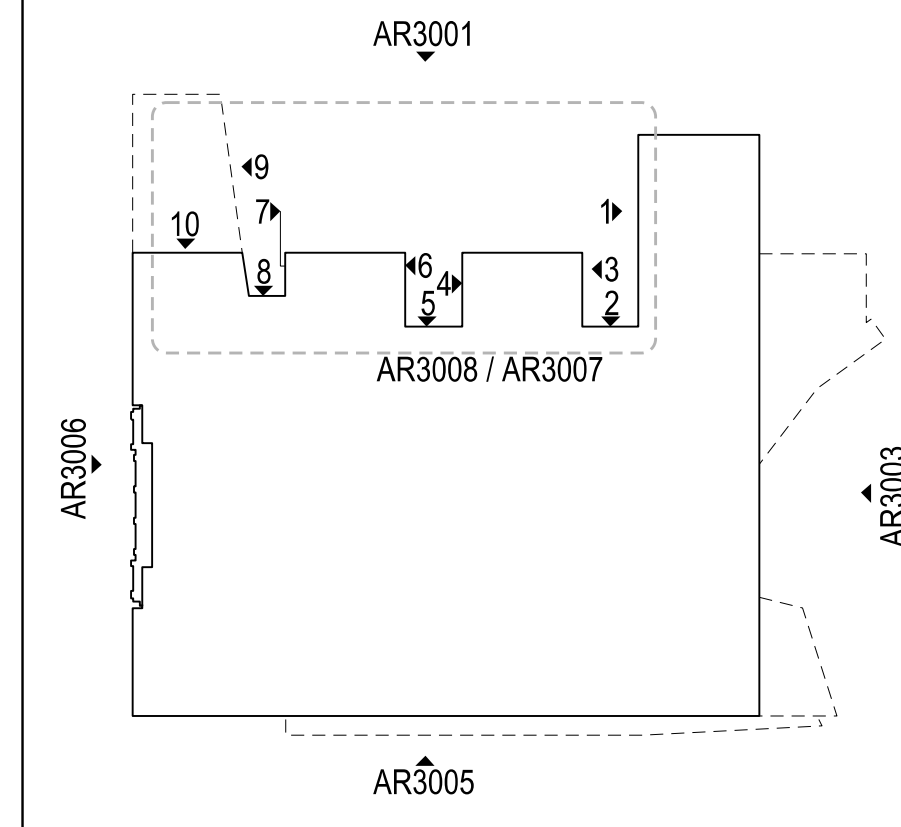

Rev	Issue	Revision Description	And	Date
D	SG	JOINTS ADDED TO PLANT ROOM CLADDING	-	24.01.14
C	SG	GROUND FLOOR ENTRY BTN GRIDS B/C	-	22.11.13
B	SG	O/FLOWS AND REFS ADDED	-	08.10.13
		EXTENT OF AWNING WINDOWS AMENDED		
		SETOUT DIMS ADDED		
		PRECAST PANEL BREAKS REV. TO SUIT INSTALL		
A	SG	PRECAST PANEL NOTCHES ADDED	-	16.09.13
16	SG	VALUE MANAGEMENT UPDATE	-	12.04.13
15	SG	VALUE MANAGEMENT ISSUE	-	28.03.13
14	SG	PRECAST REVIEW	-	21.03.13
13	SG	TENDER ADDENDUM 5	-	15.10.12
12	SG	TENDER ADDENDUM 4	-	08.10.12
11	SG	TENDER ADDENDUM 3	-	02.10.12
10	SG	100% CD - TENDER ISSUE	-	07.09.12
09	SG	90% CD ISSUE	-	10.08.12
08	SG	75% CD ISSUE	-	13.07.12
07	SG	50% CD ISSUE	-	08.06.12
06	SG	25% CD ISSUE	-	20.04.12
05	JC	FINAL DD ISSUE	-	24.02.12
04	JC	DESIGN DEVELOPMENT ISSUE	-	20.01.12
03	JC	DESIGN DEVELOPMENT ISSUE	-	22.12.11
02	JC	PRELIMINARY DD	-	02.11.11
01	JC	PRELIMINARY DD	-	07.10.11



**NADAAA**  
 NADAAA  
 1520 Washington Street No.2 Boston Massachusetts 02118 USA  
 Telephone +1 617 442 8232 Facsimile +1 688 442 1417 Email nadaaa@nadaaa.com

**John Wardle Architects**  
 25 Rokeby Street, Collingwood, Victoria 3066 Australia  
 Tel : +61 3 8662 0400 www.johnwardlearchitects.com  
 © 2014 John Wardle Architects ABN 83 006 814 268

Client **University of Melbourne Parkville Campus**

Project **Faculty of Architecture Building and Planning**

Title **ELEVATIONS WEST ELEVATION WITHOUT SCREEN**

Project No.	<b>0913</b>	Scale	1:100 @ A0 1:200 @ A2
Drawing No.	<b>AR3006</b>	Revision	<b>D</b>

Date: May 2011 Drawn: Co-Ord: Check:

FILENAME - \$FILES  
**FOR CONSTRUCTION**

