
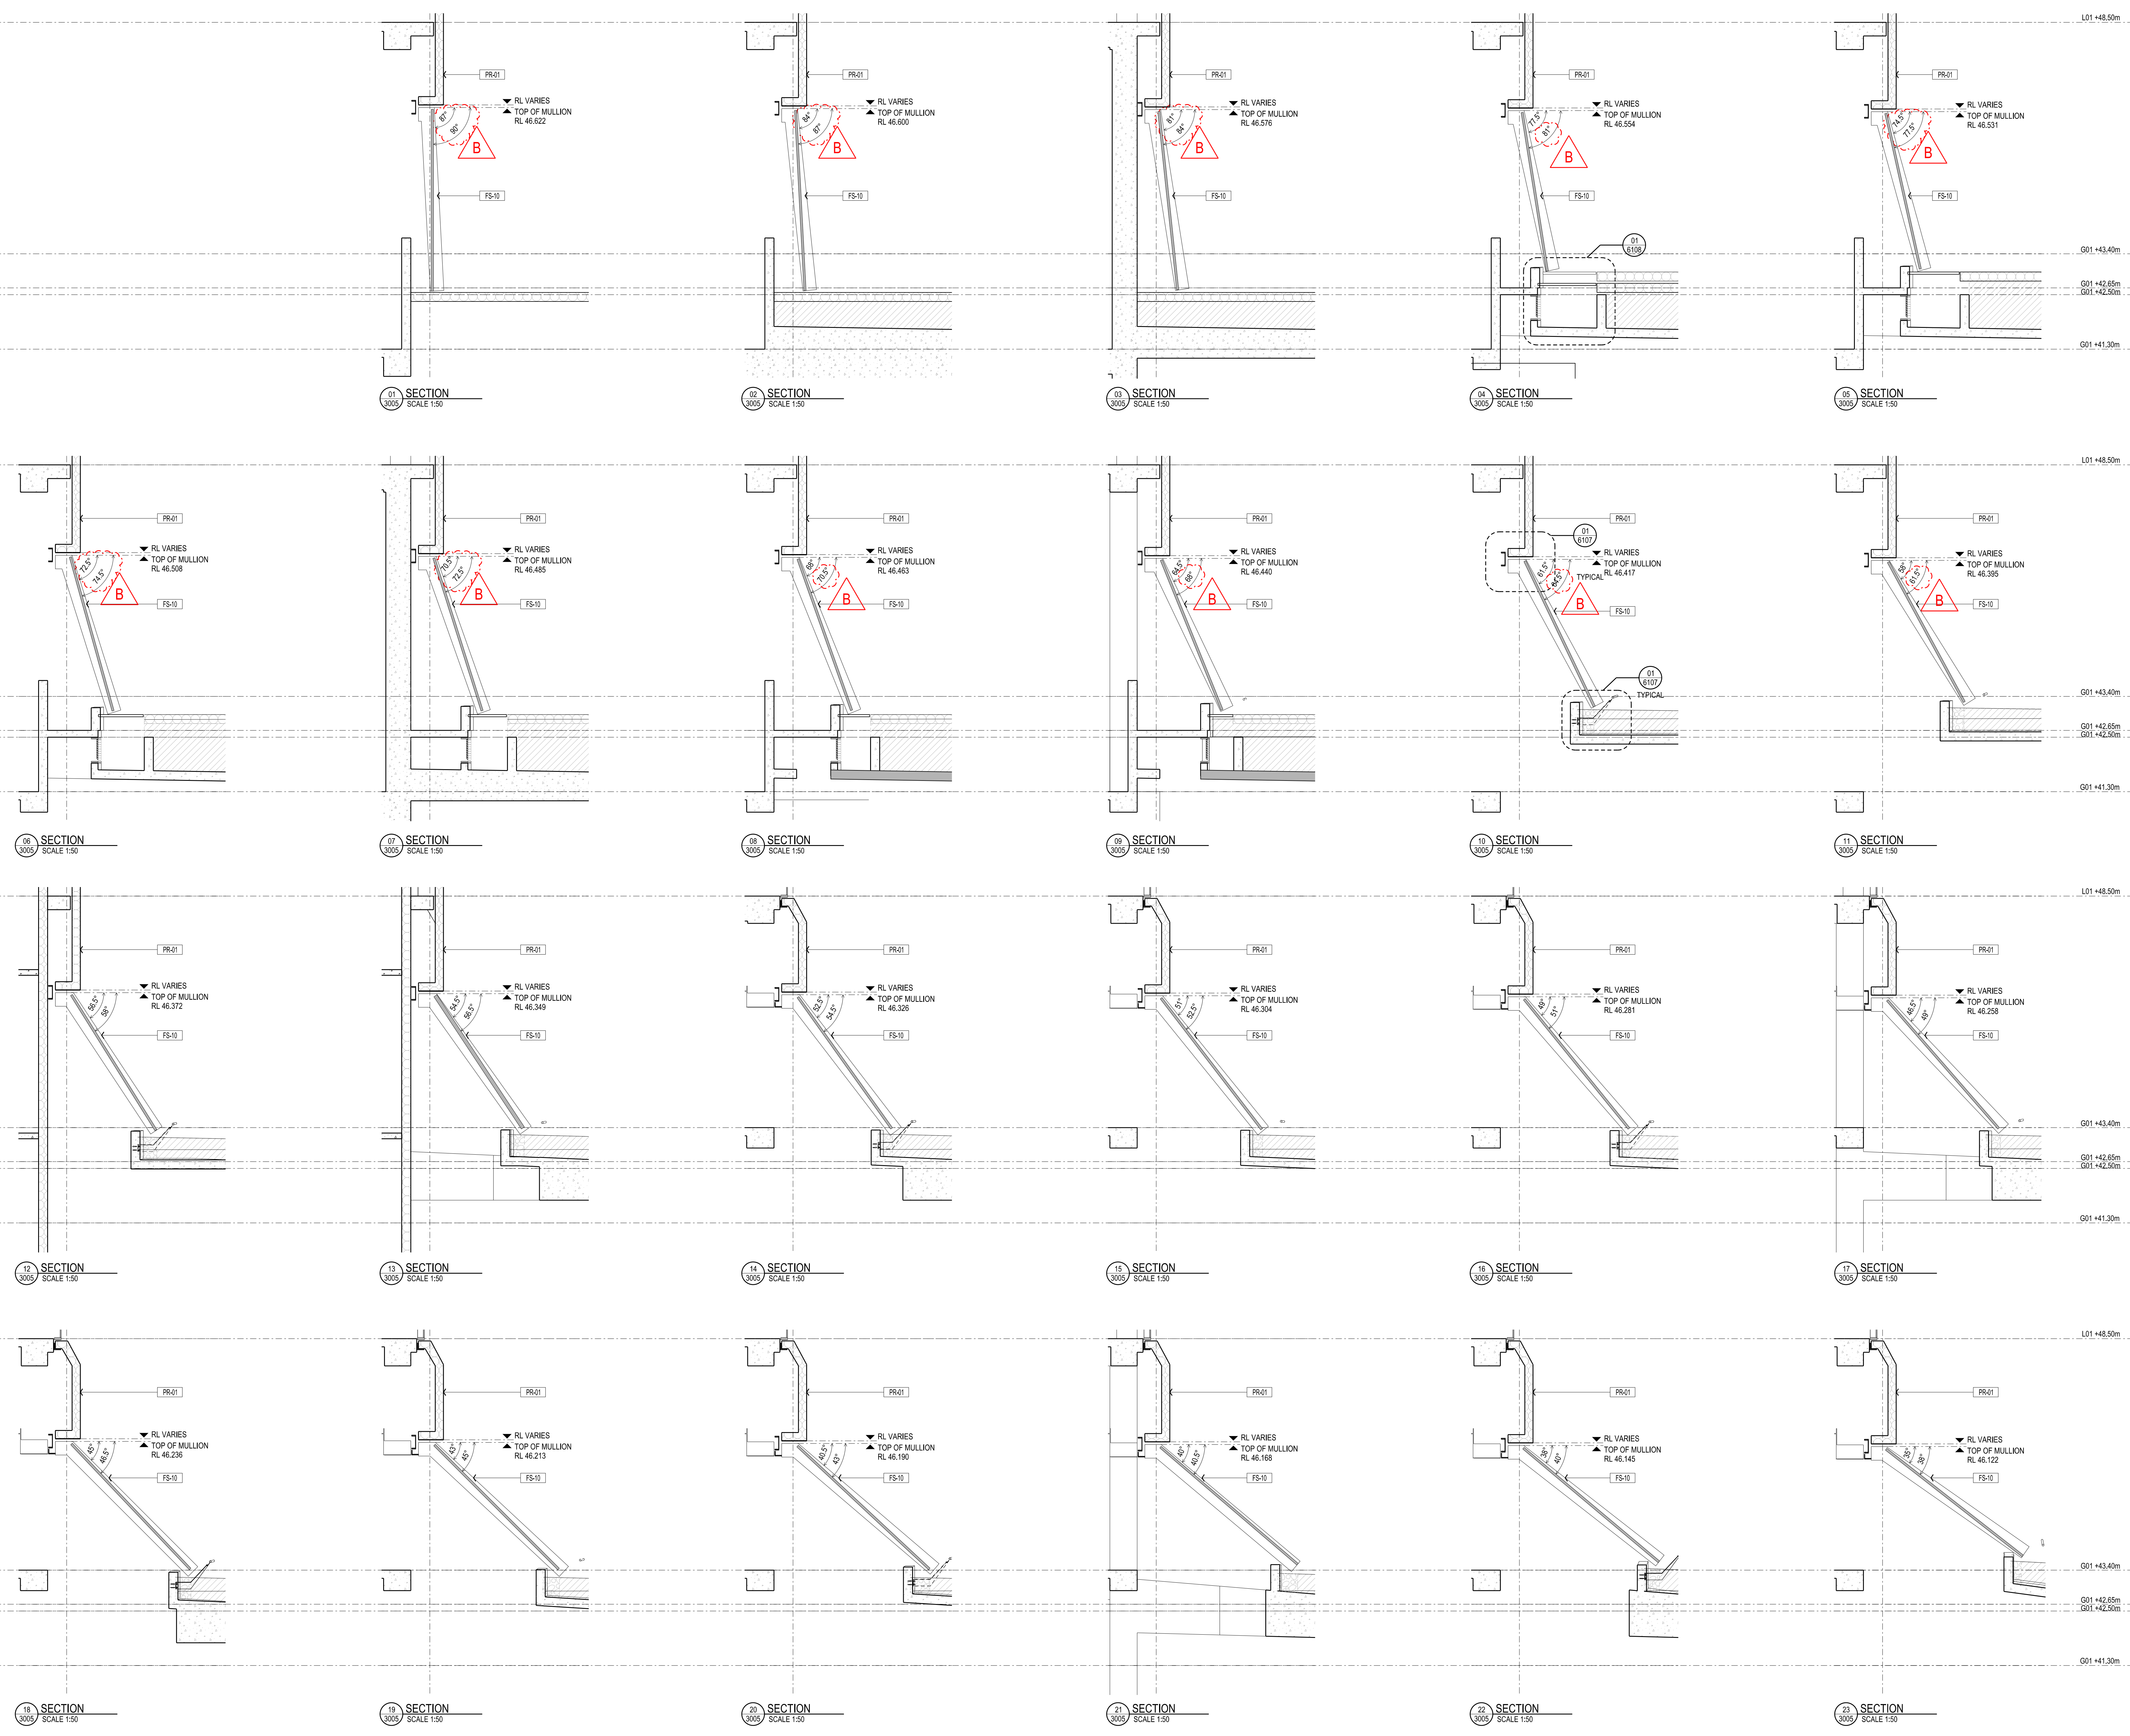


THIS DRAWING IS AN UNCONTROLLED COPY UNLESS STAMPED OTHERWISE

CONTRACTORS SHALL VERIFY JOB DIMENSIONS BEFORE ANY JOB COMMENCES. ALL SHOP DRAWINGS SHALL BE SUBMITTED TO THE SUPERINTENDENT AND MANUFACTURER SHALL NOT COMMENCE PRIOR TO THE RETURN OF DIMENSIONED SHOP DRAWINGS REVIEWED BY THE CONSULTANT. FIGURED DIMENSIONS SHALL TAKE PRECEDENCE OVER SCALES. THIS DRAWING SHOULD BE READ IN CONJUNCTION WITH ALL RELEVANT CONTRACT SPECIFICATIONS AND DRAWINGS COPYRIGHT OF THIS DRAWING IS VESTED IN WARDLE.

General Notes

REFER ARCHITECTURAL DRAWINGS:
 FACADE SETOUT AR1502-AR1507
 PRECAST SETOUT AR1512-AR1517
 SCREEN SETOUT AR1552-AR1557
 SCREEN DETAILS AR8550-AR8554

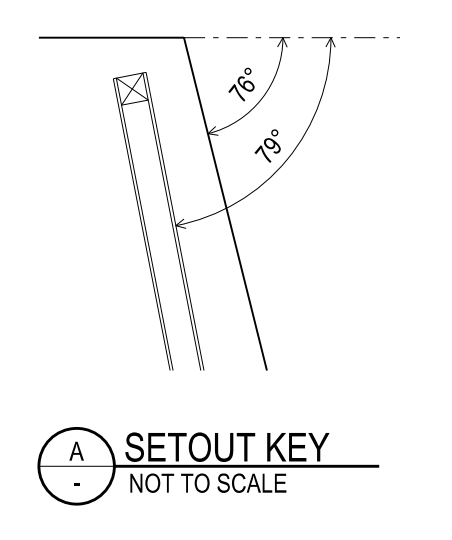

Rev	Issue	Revision Description	Amd	Date
B	SG	ANGLES REV. TO SUIT UPSTAND		11.11.13
A	SG	ISSUE FOR CONSTRUCTION		10.10.13
04	SG	100% CD - TENDER ISSUE		07.09.12
03	SG	90% CD ISSUE		10.08.12
02	SG	75% CD ISSUE		13.07.12
01	SG	55% CD ISSUE		08.06.12



NADAAA
 NADAAA
 1520 Washington Street No.2
 Boston Massachusetts 02118 USA
 Telephone +1 617 442 8232
 Facsimile +1 617 442 1417
 Email nad@nadaaa.com

John Wardle Architects
 25 Rokeby Street, Collingwood, Victoria 3066 Australia
 Tel: +61 3 8662 0400 www.johnwardlearchitects.com
 © 2012 John Wardle Architects ABN 83 006 814 268

Client **University of Melbourne Parkville Campus**
 Project **Faculty of Architecture Building and Planning**
 Title **SOUTH FACADE SECTIONS FS-10 - GROUND LEVEL**

Project No. **0913** Scale 1:50 @ A0
 Drawing No. **AR3551** Revision **B**
 Date Sept 2011 Dwn - Co-Ord - Chk -

FILENAME - \$FILES
FOR CONSTRUCTION