



CONTRACTORS SHALL VERIFY DIMENSIONS BEFORE ANY WORK COMMENCES. ALL SHOP DRAWINGS SHALL BE SUBMITTED TO THE SUPERINTENDENT AND MANUFACTURERS SHALL NOT COMMENCE FROM THE RETURN OF DIMENSIONS SHOP DRAWINGS ISSUED BY THE CONSULTANT. FIGURED DIMENSIONS SHALL TAKE PRECEDENCE OVER SCALED. THIS DRAWING SHOULD BE READ IN CONJUNCTION WITH ALL RELEVANT CONTRACT SPECIFICATIONS AND DRAWINGS COPYRIGHT OF THIS DRAWING IS VESTED IN WARDLE.


General Notes

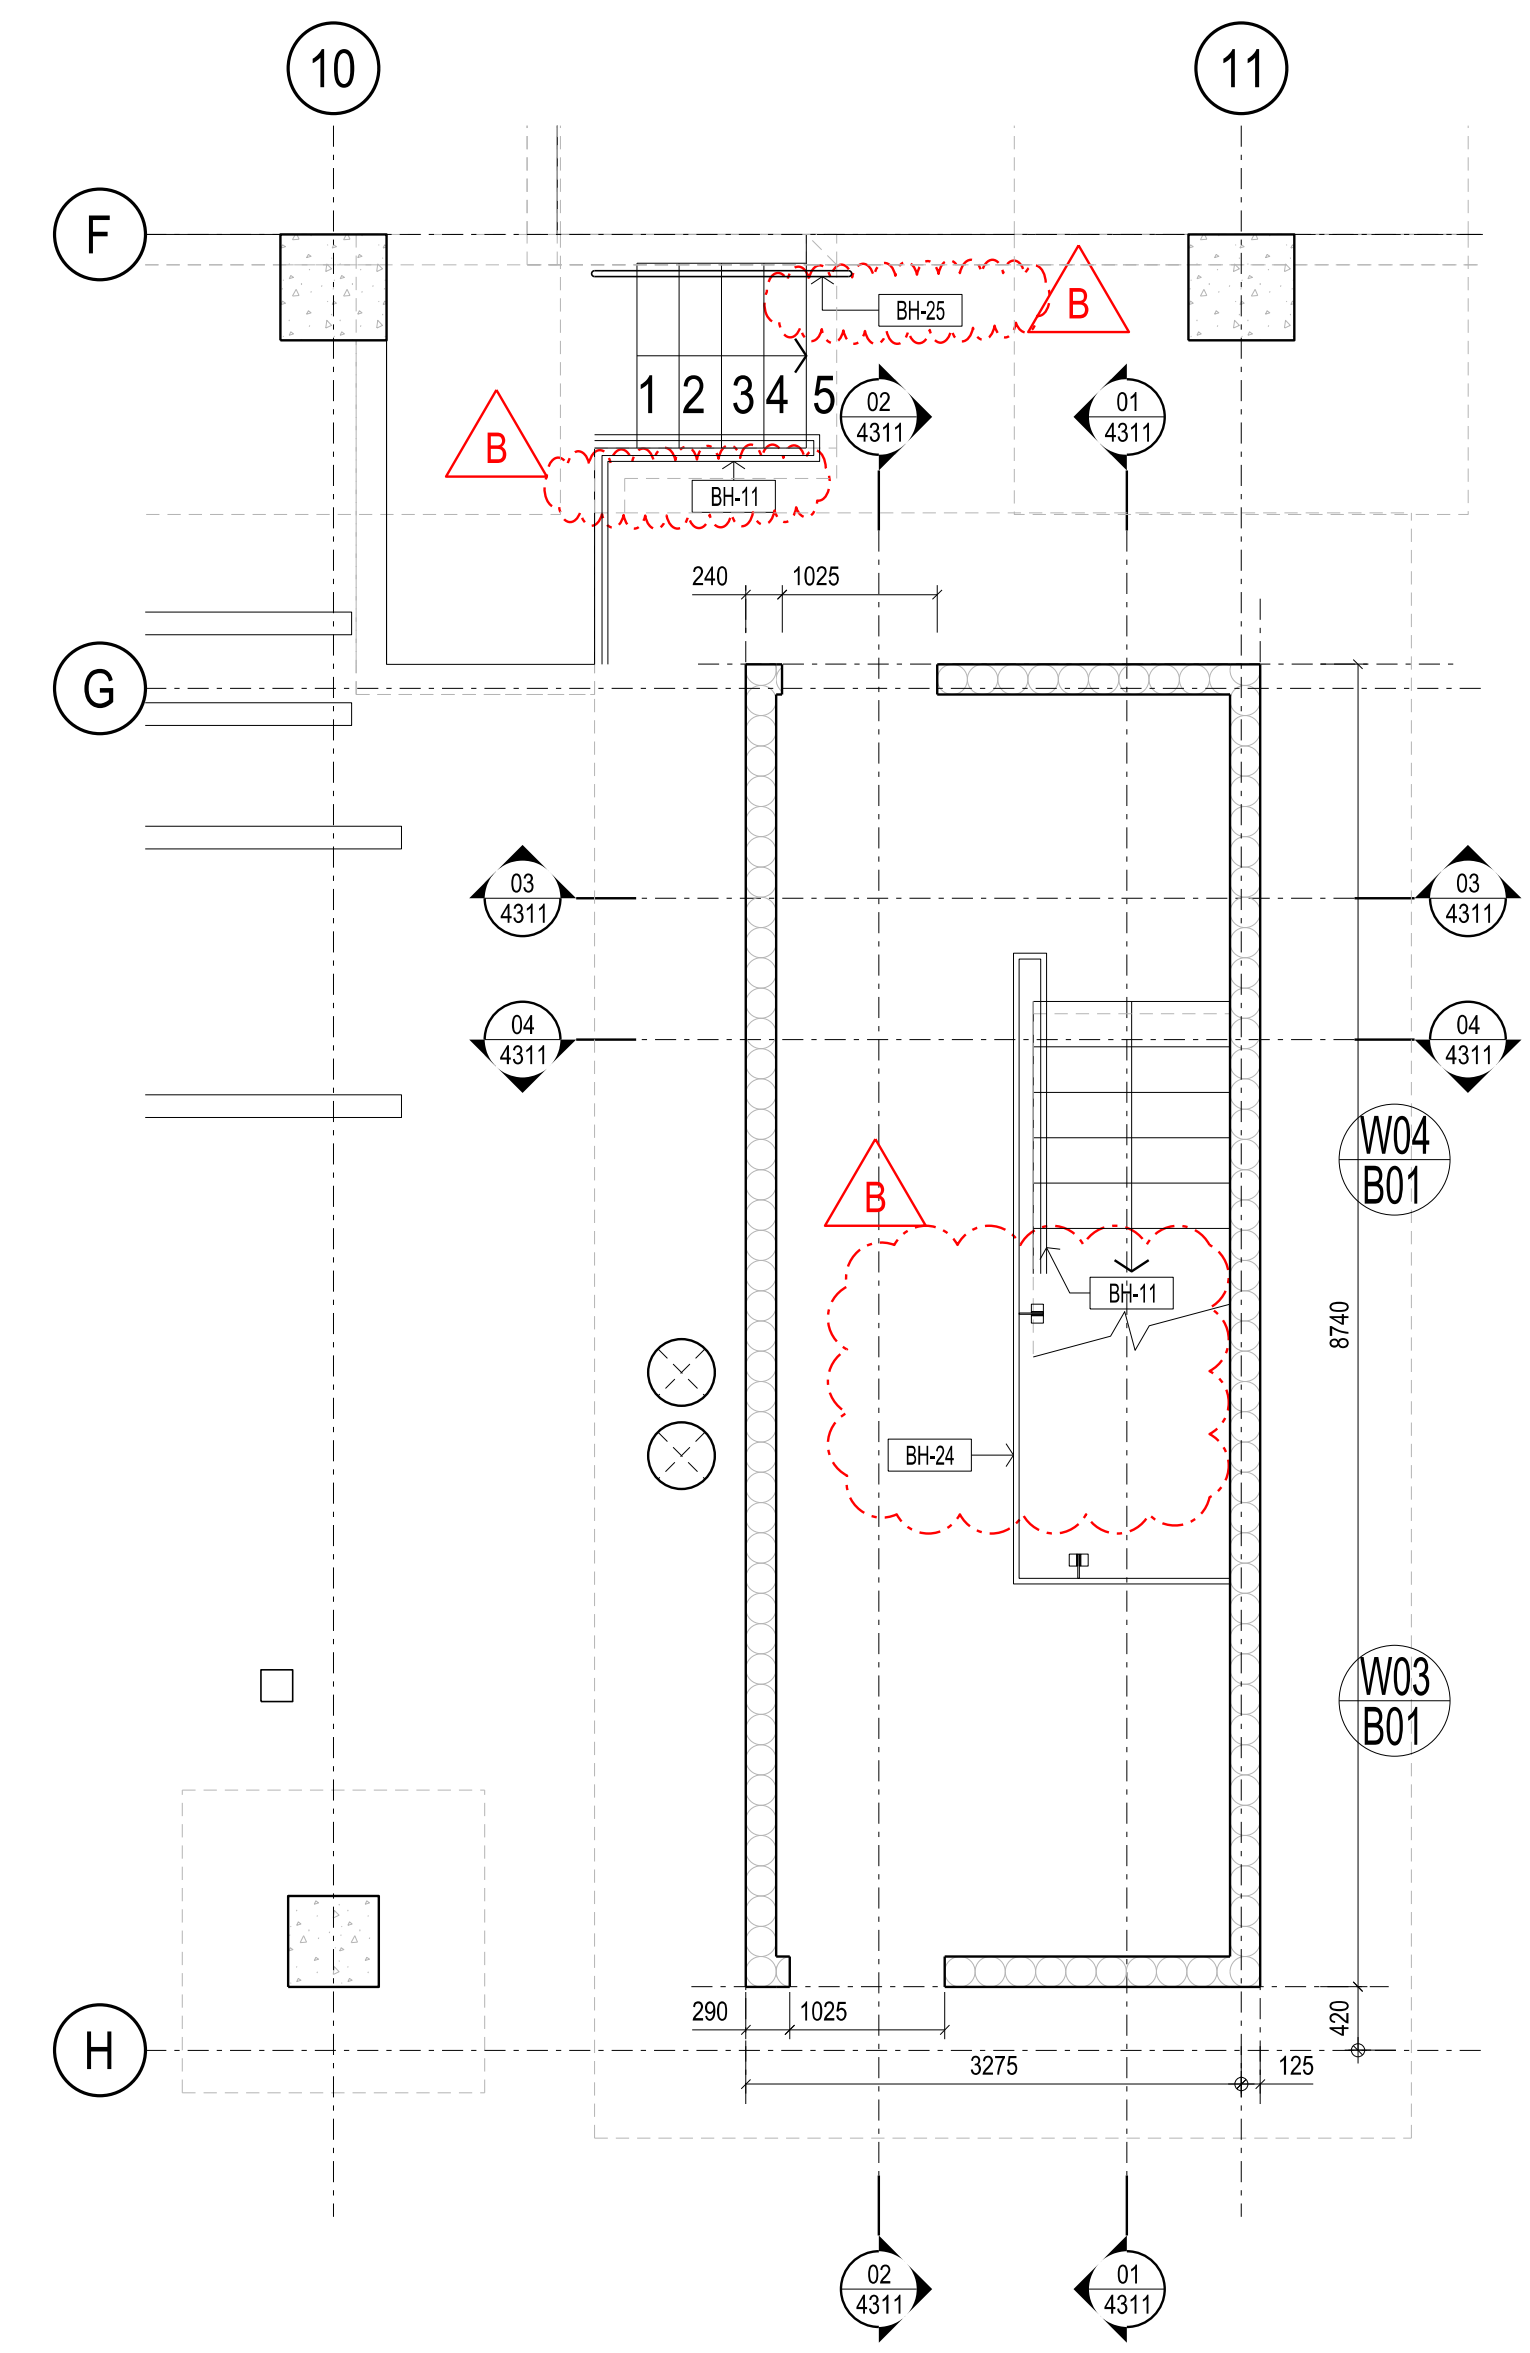


1 LEVEL BASEMENT - CORE 3 PLAN  
SCALE 1:50

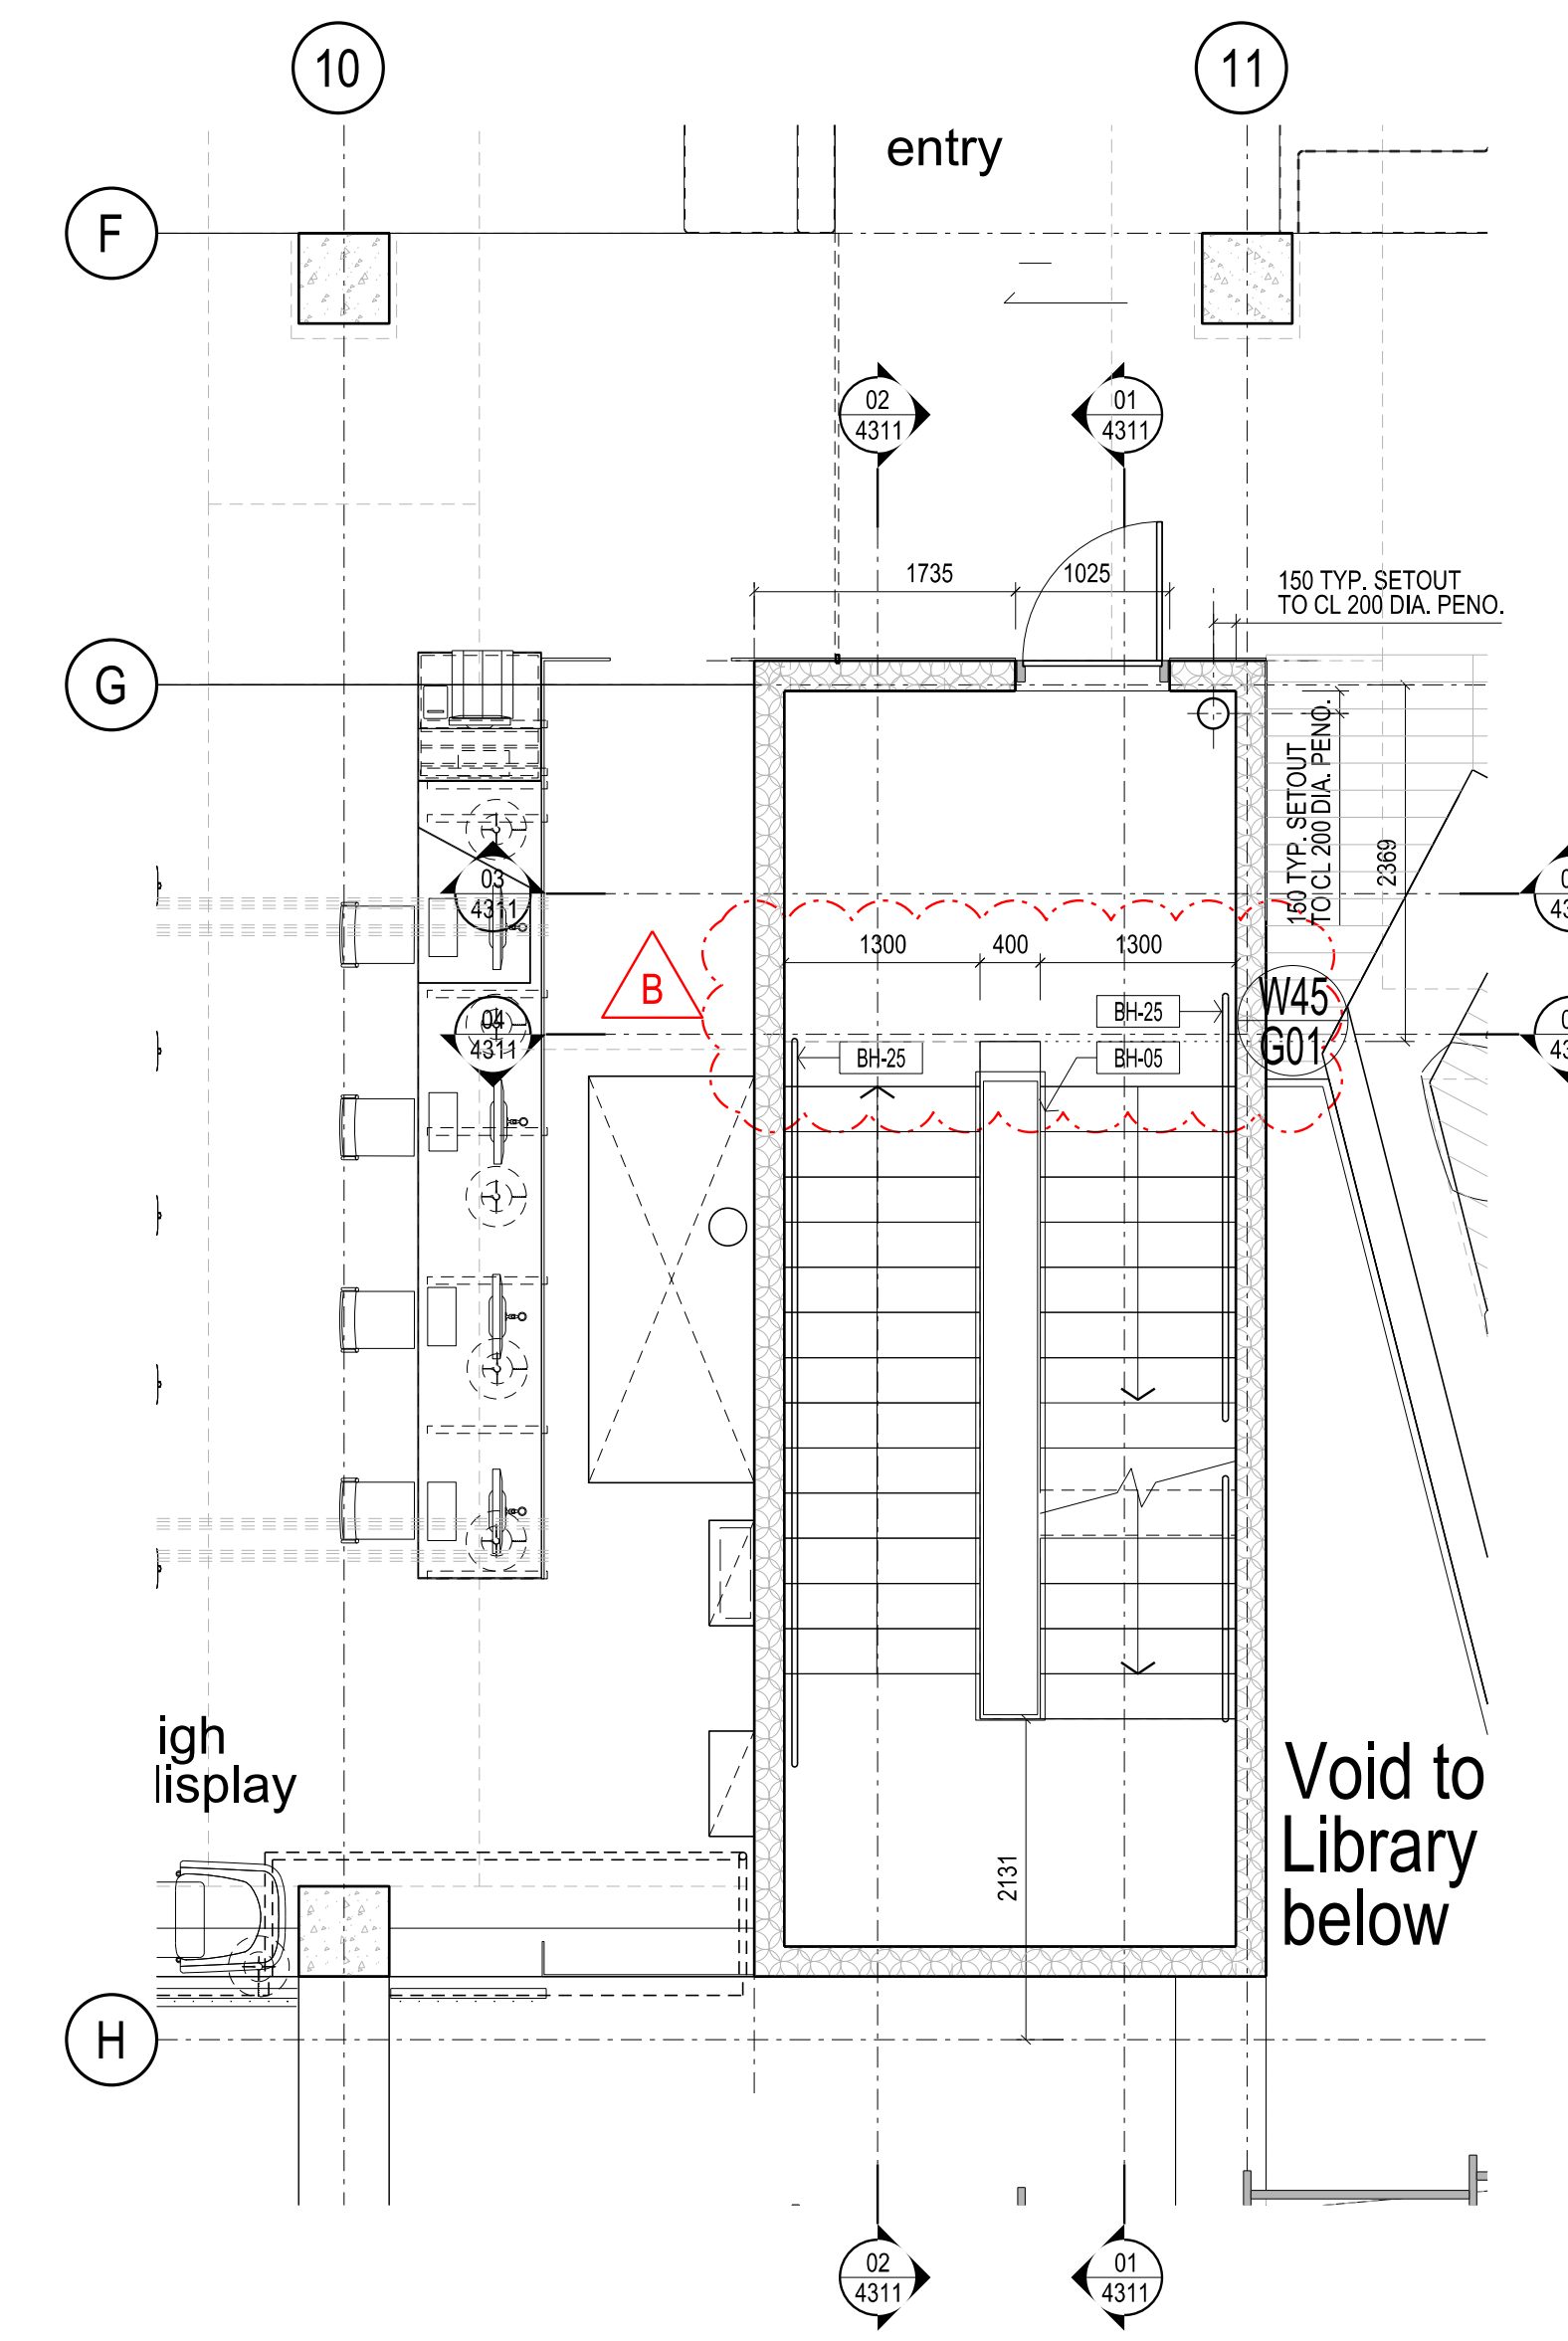


2 LEVEL GROUND - CORE 3 PLAN  
SCALE 1:50

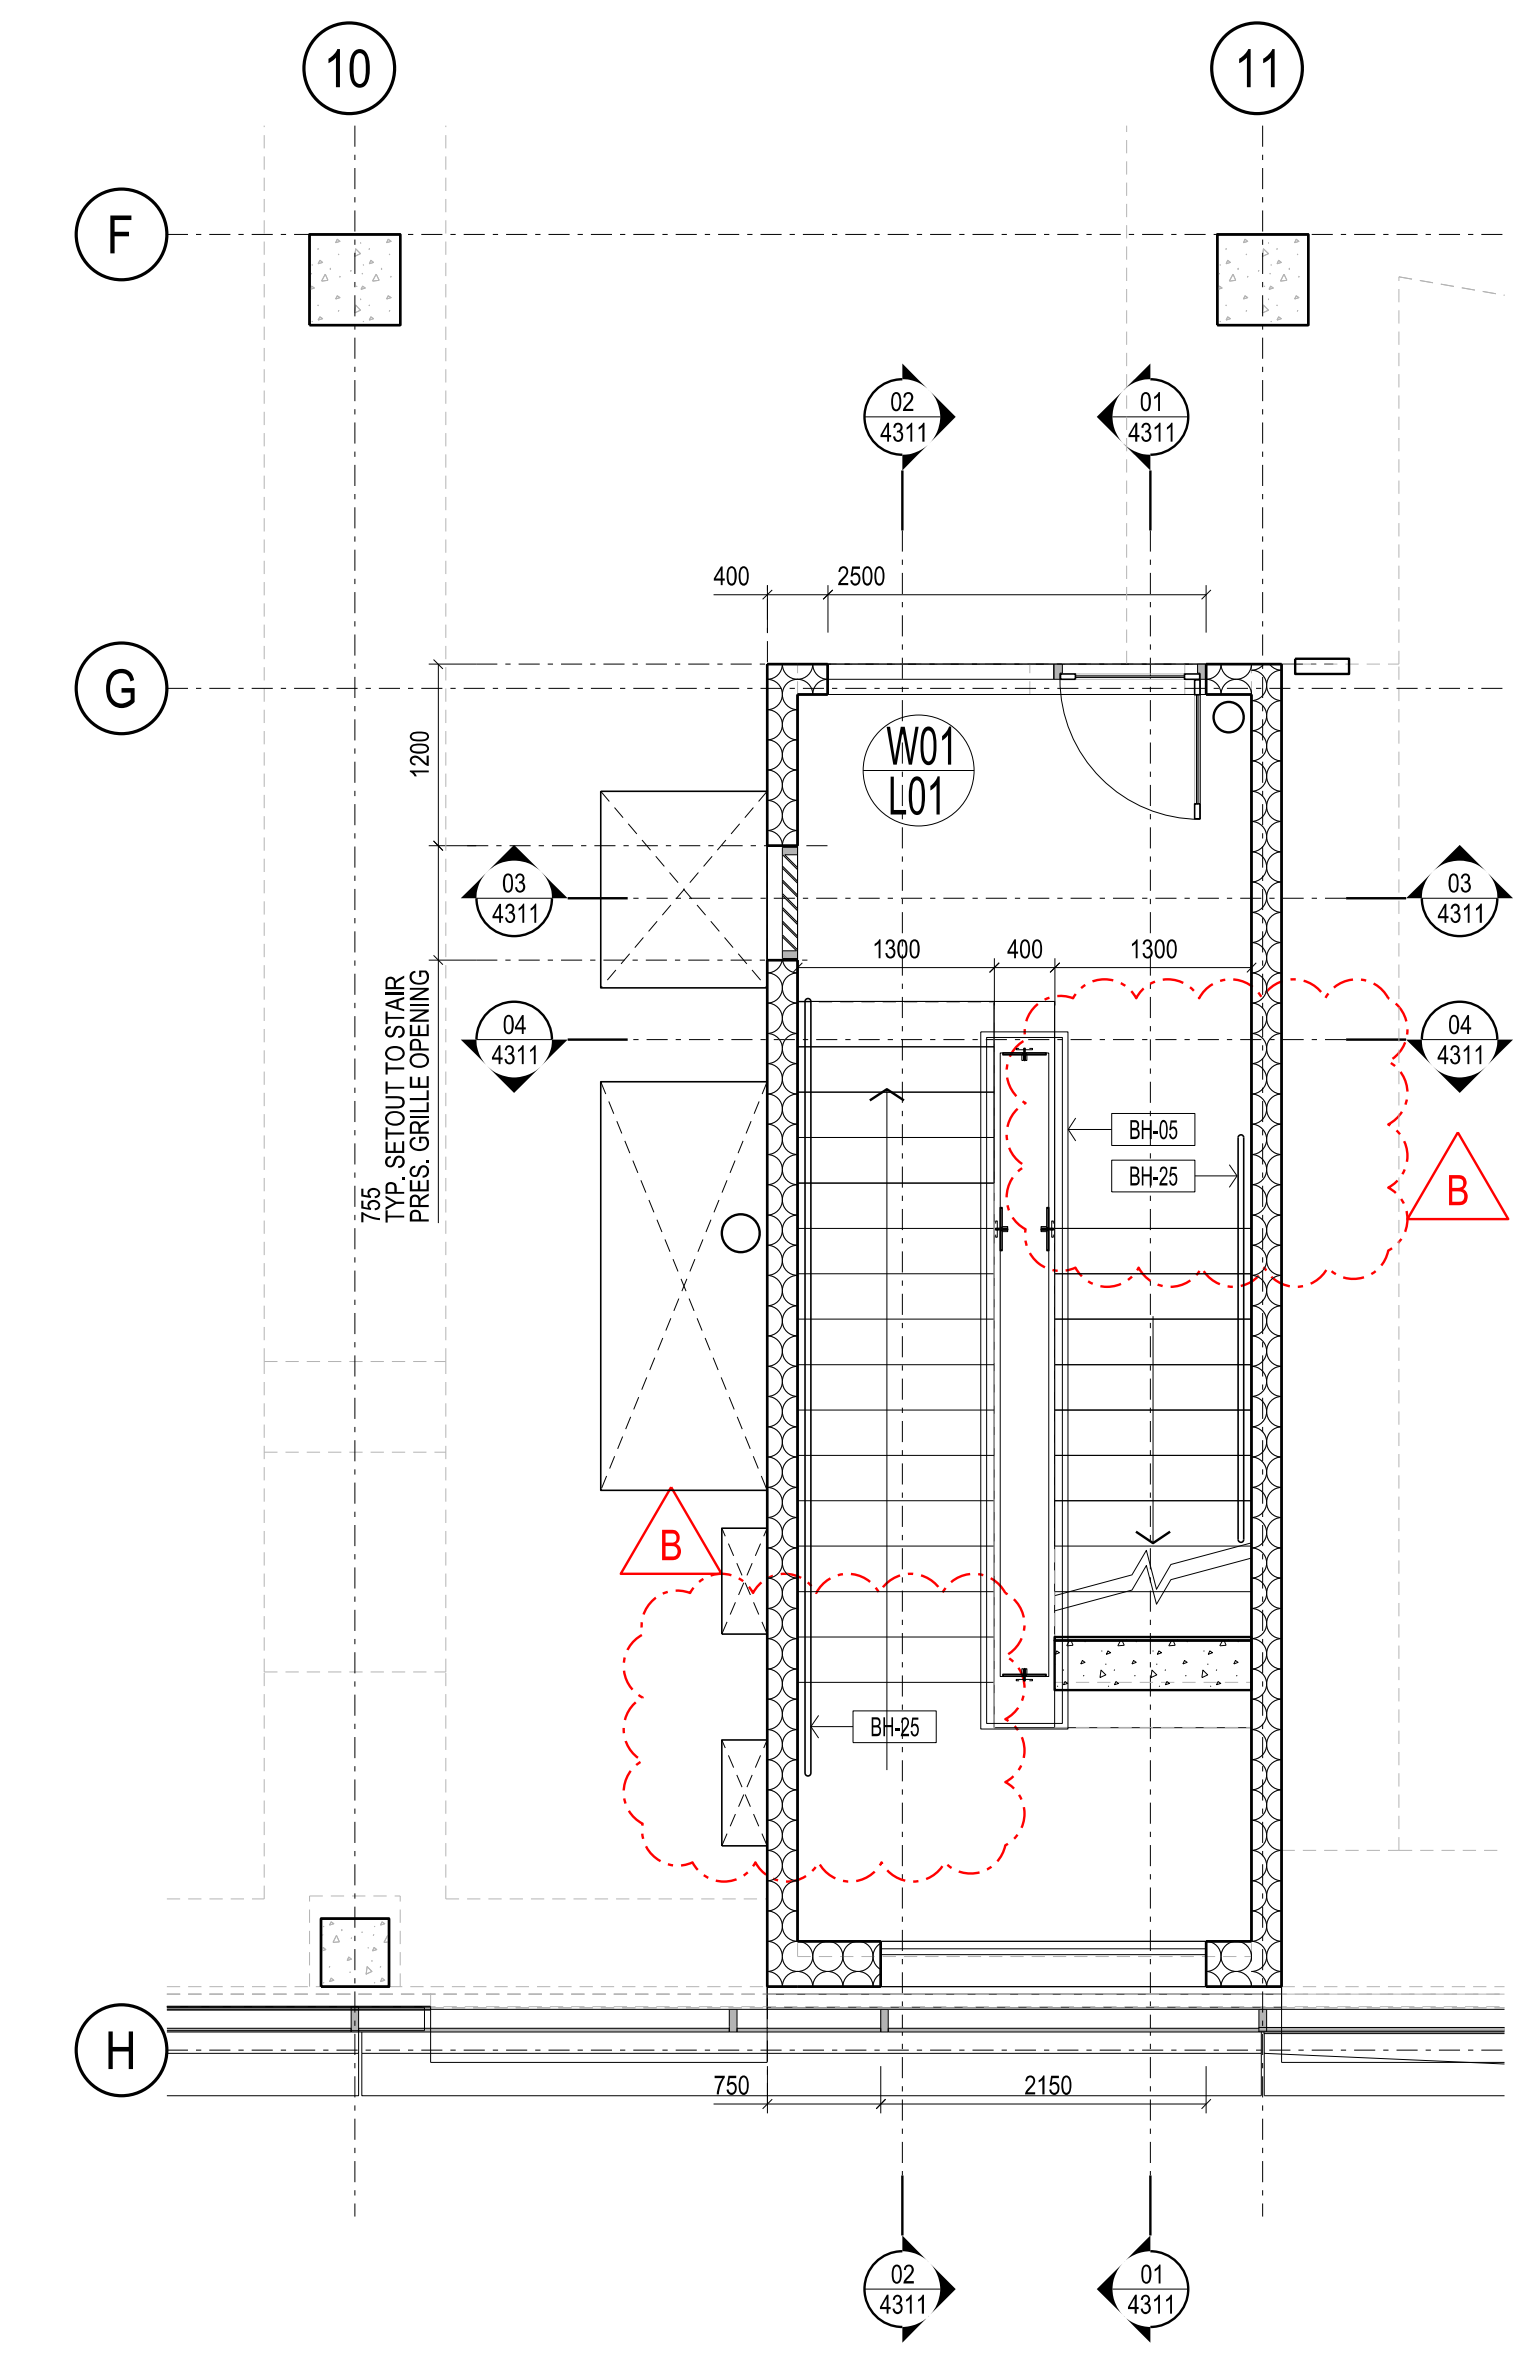


3 LEVEL 1 - CORE 3 PLAN  
SCALE 1:50

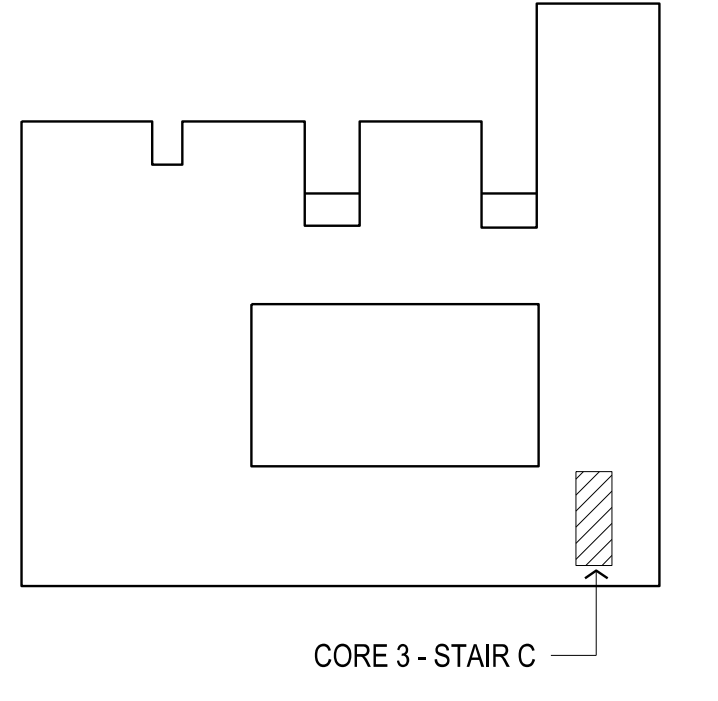


CORE 3 - STAIR C

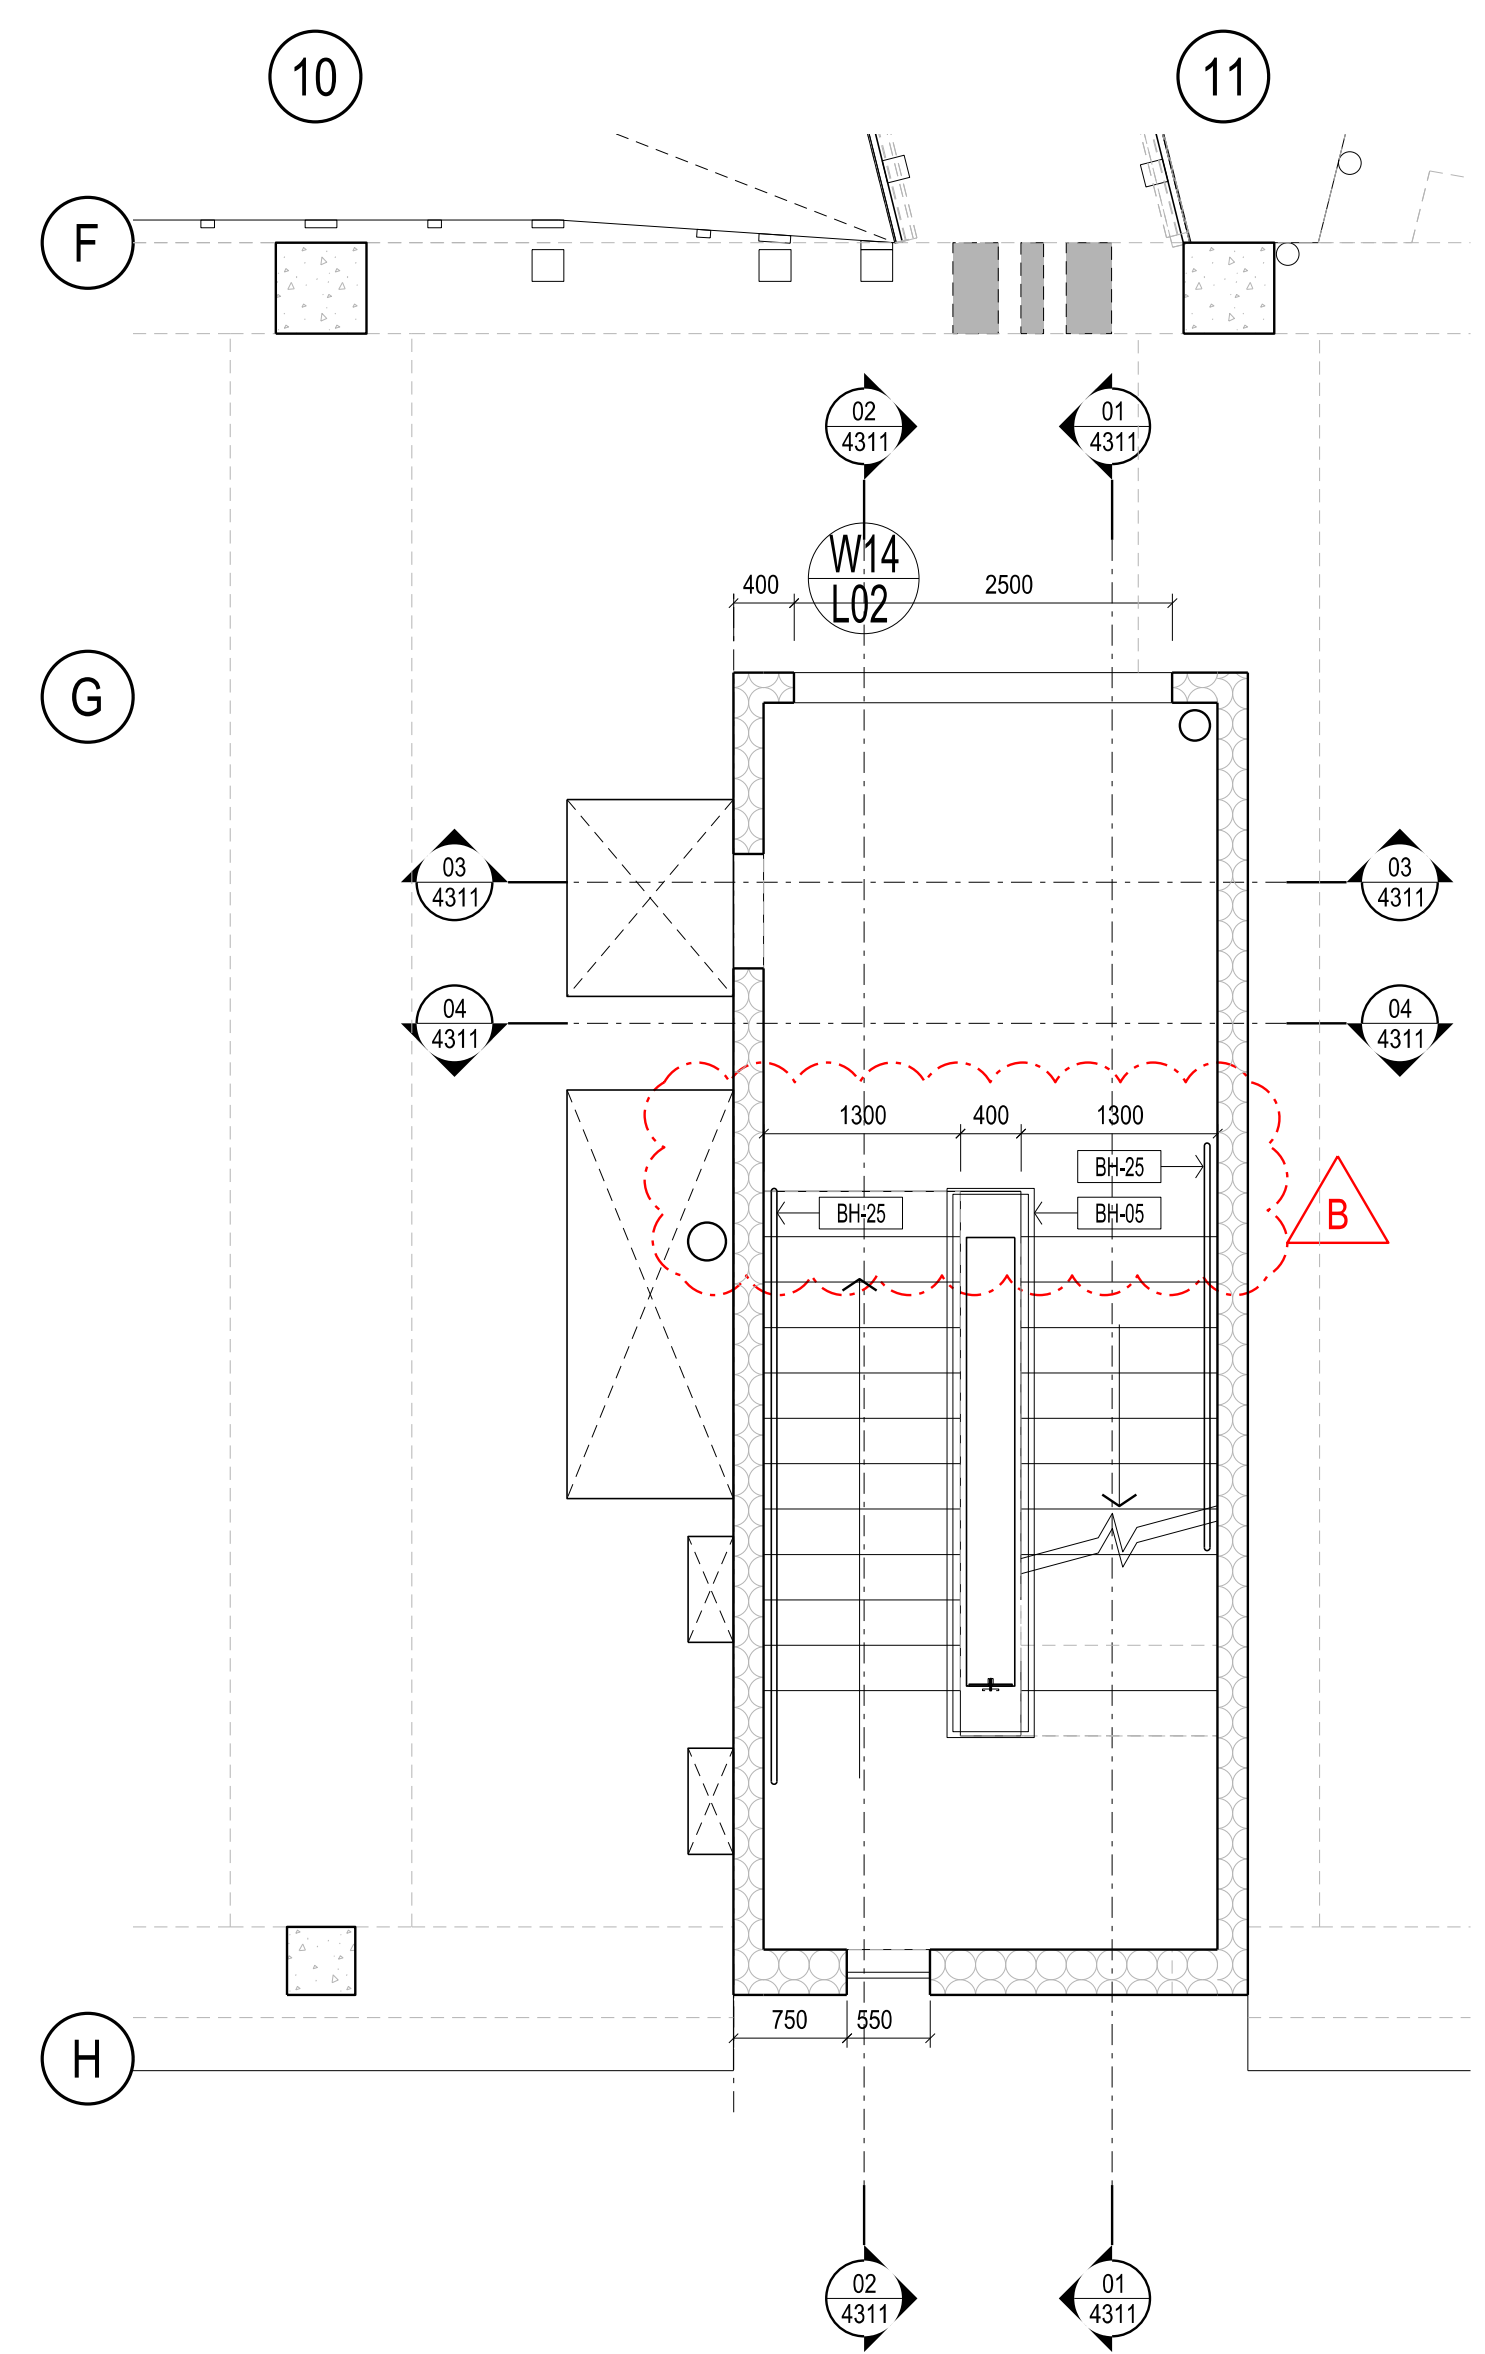


4 LEVEL 2 - CORE 3 PLAN  
SCALE 1:50

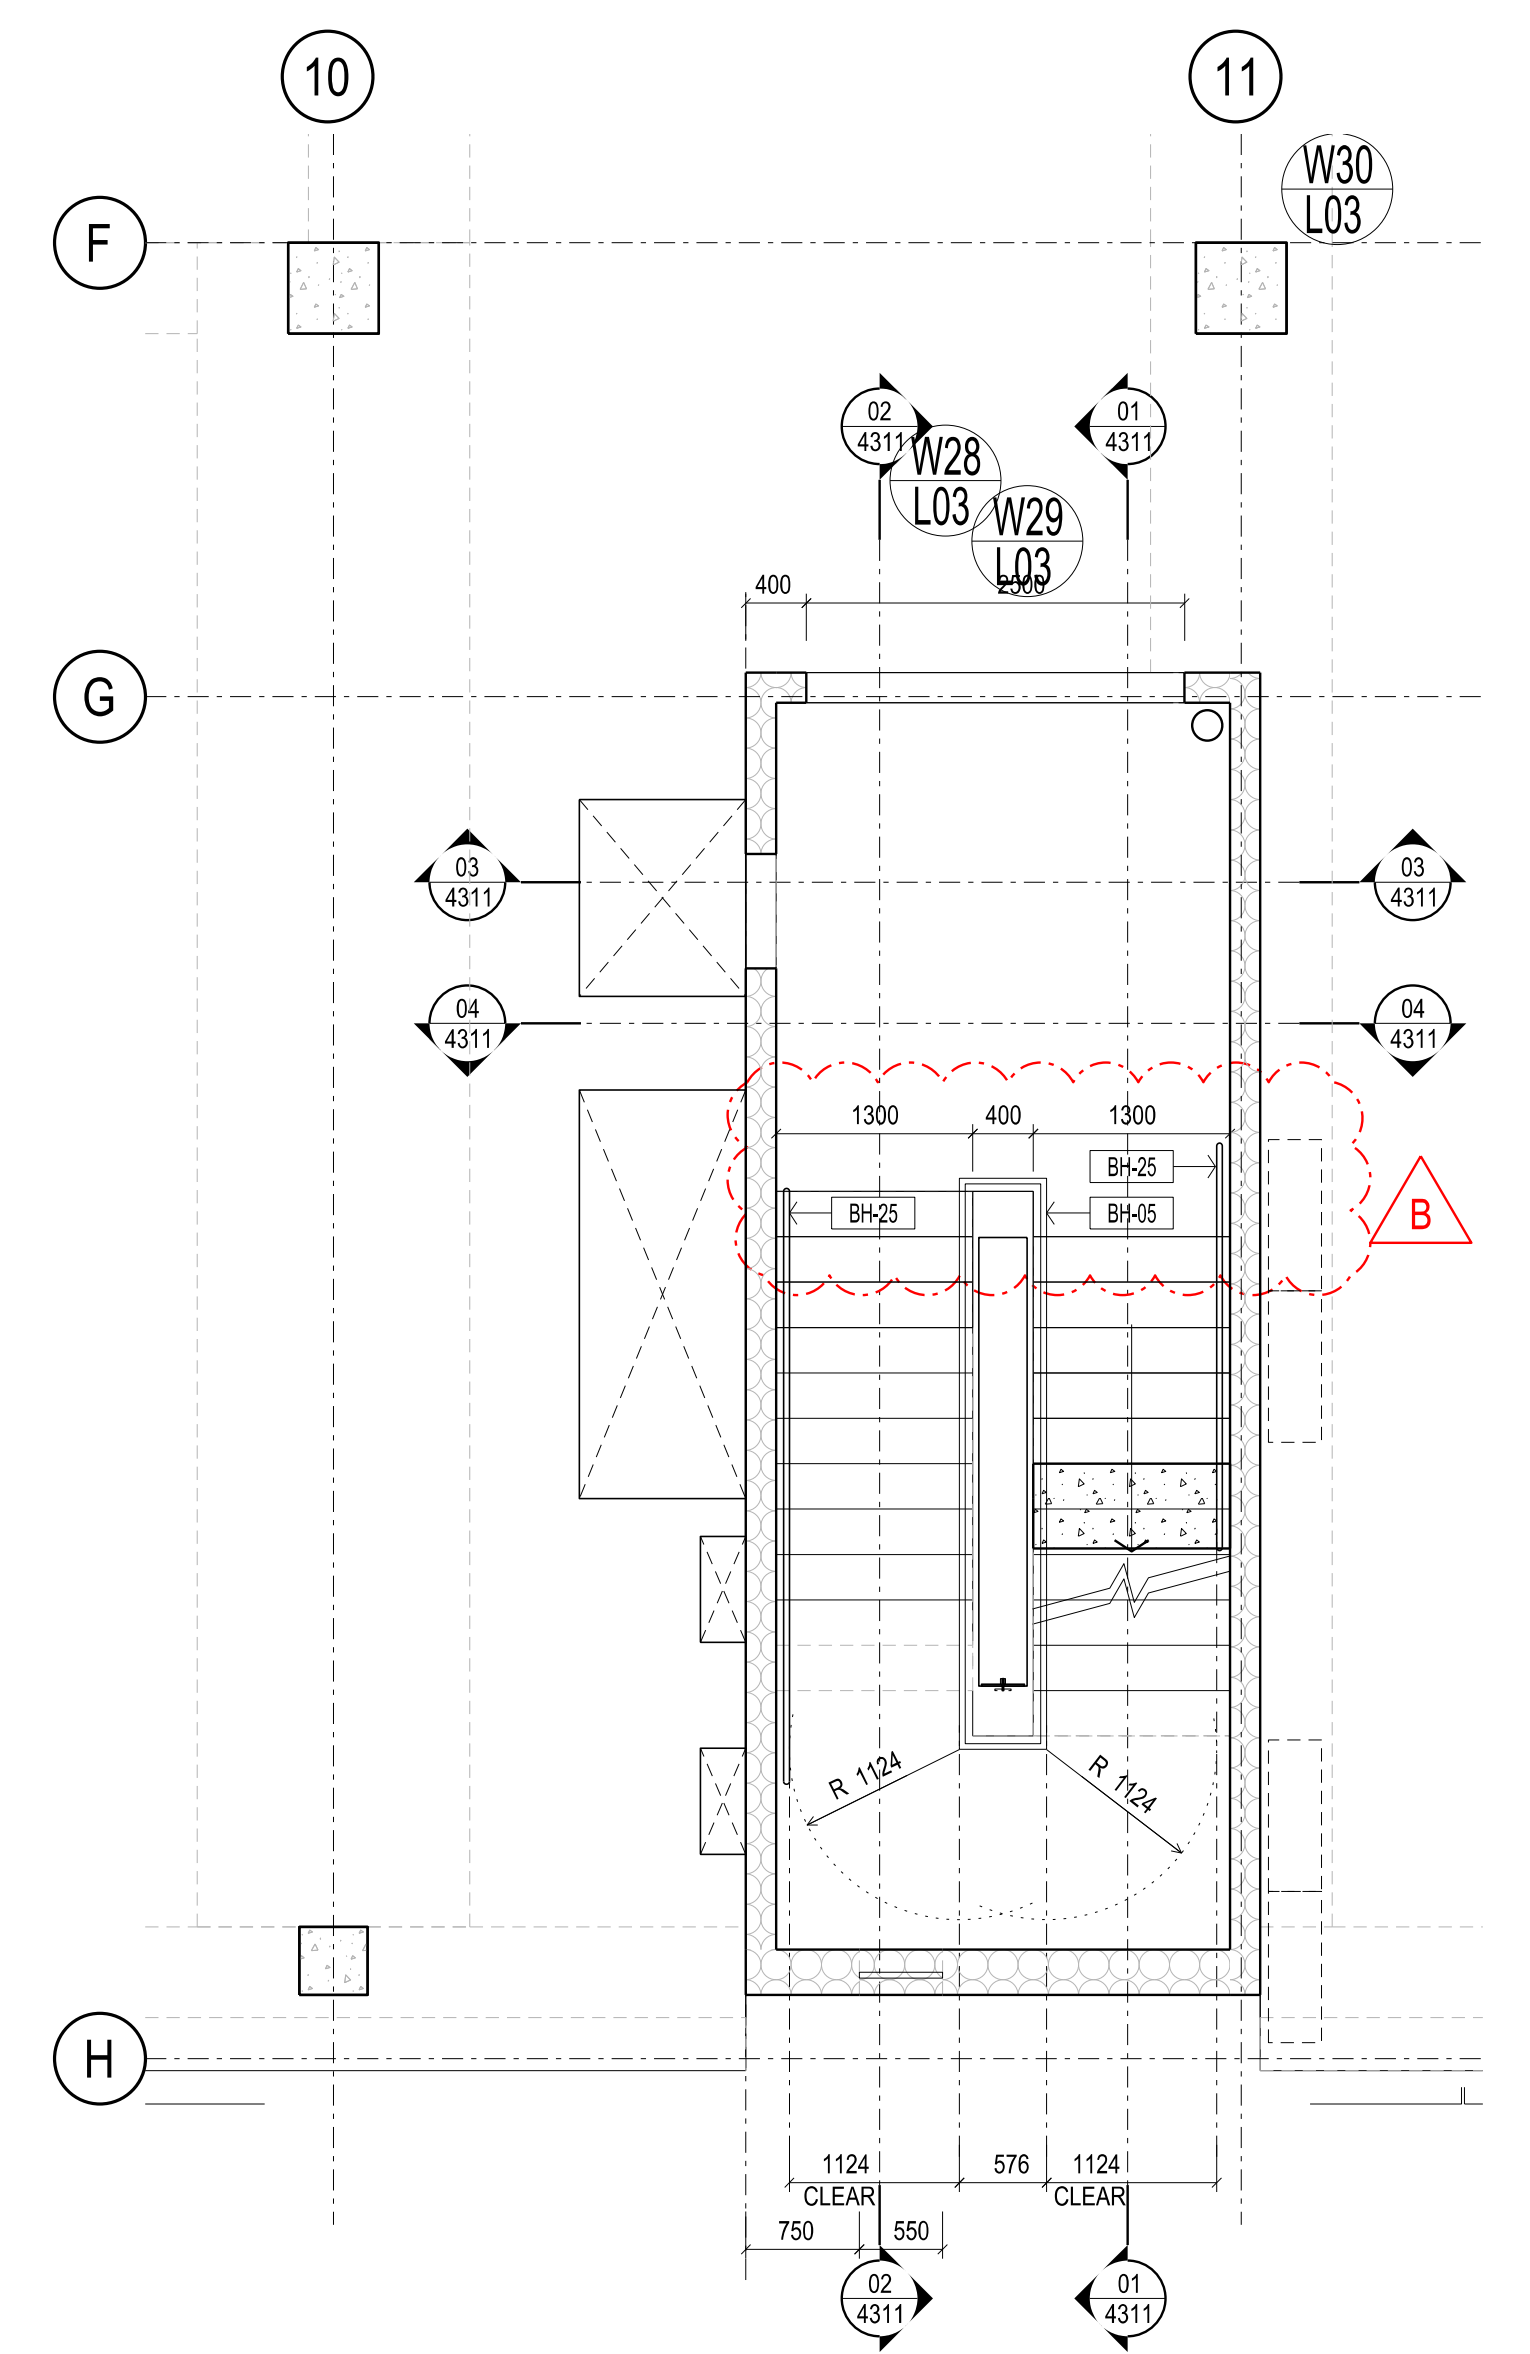

5 LEVEL 3 - CORE 3 PLAN  
SCALE 1:50 (TYP. CLEARANCES BETWEEN HANDRAILS)

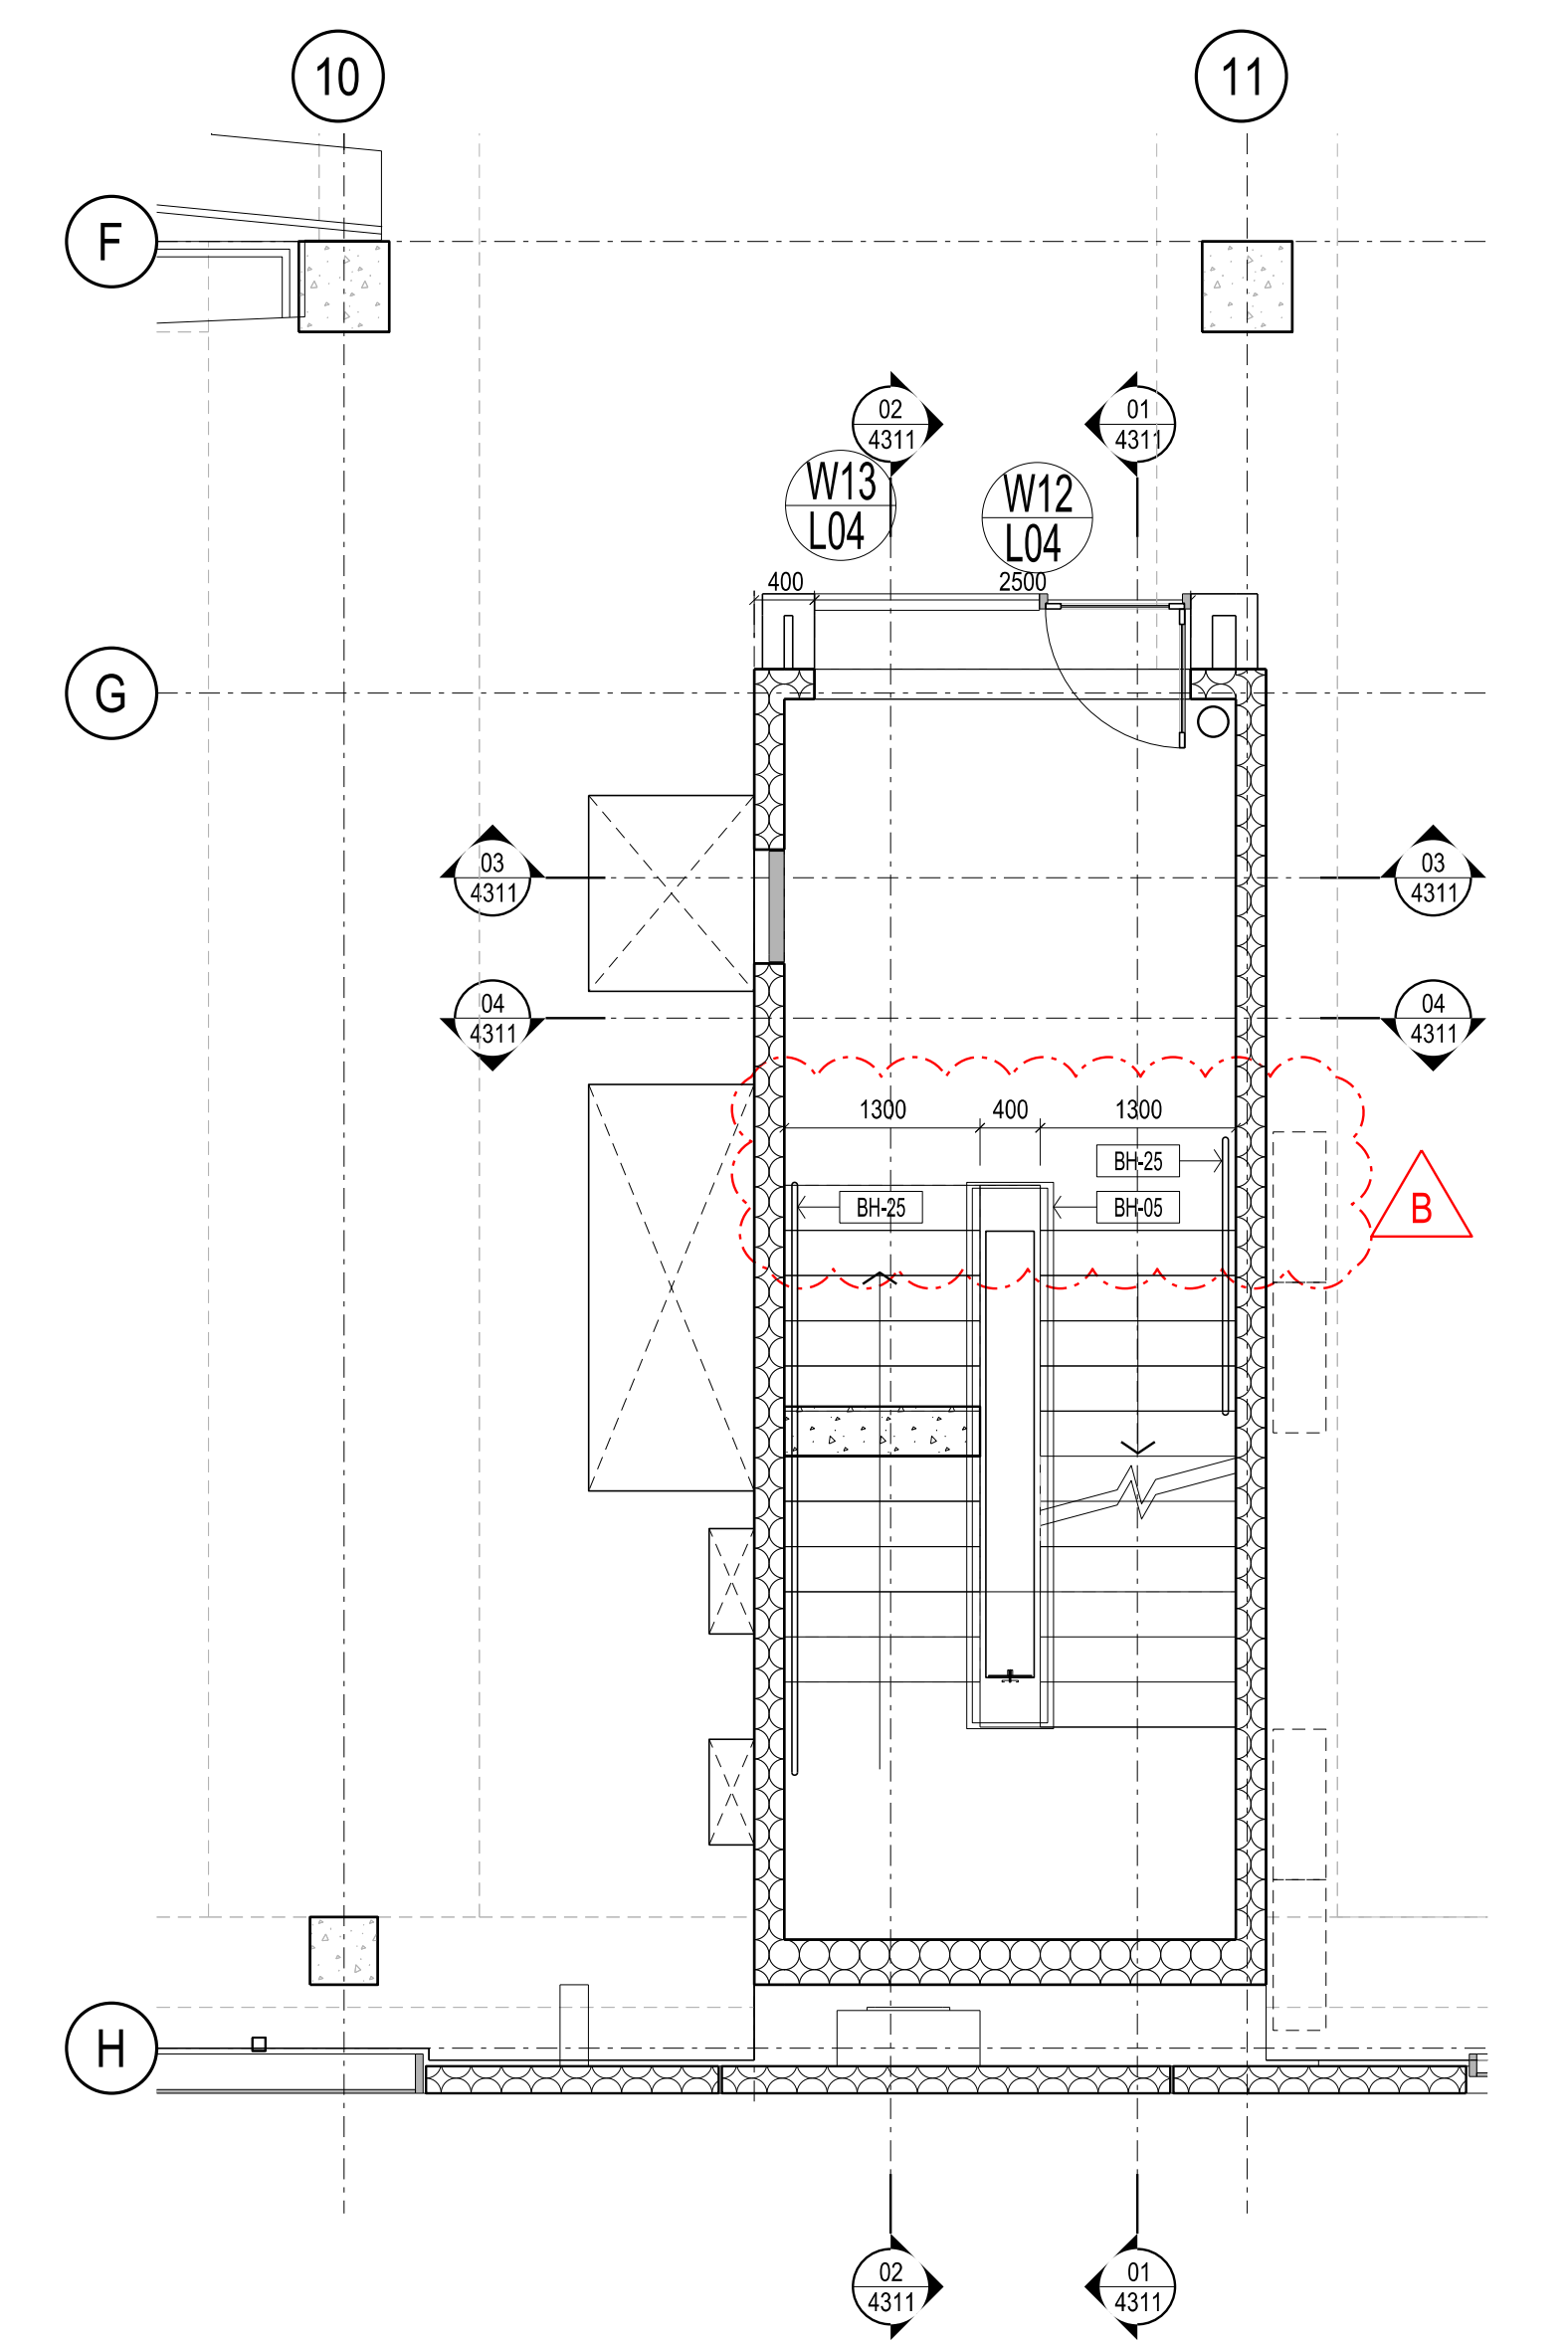

6 LEVEL 4 - CORE 3 PLAN  
SCALE 1:50

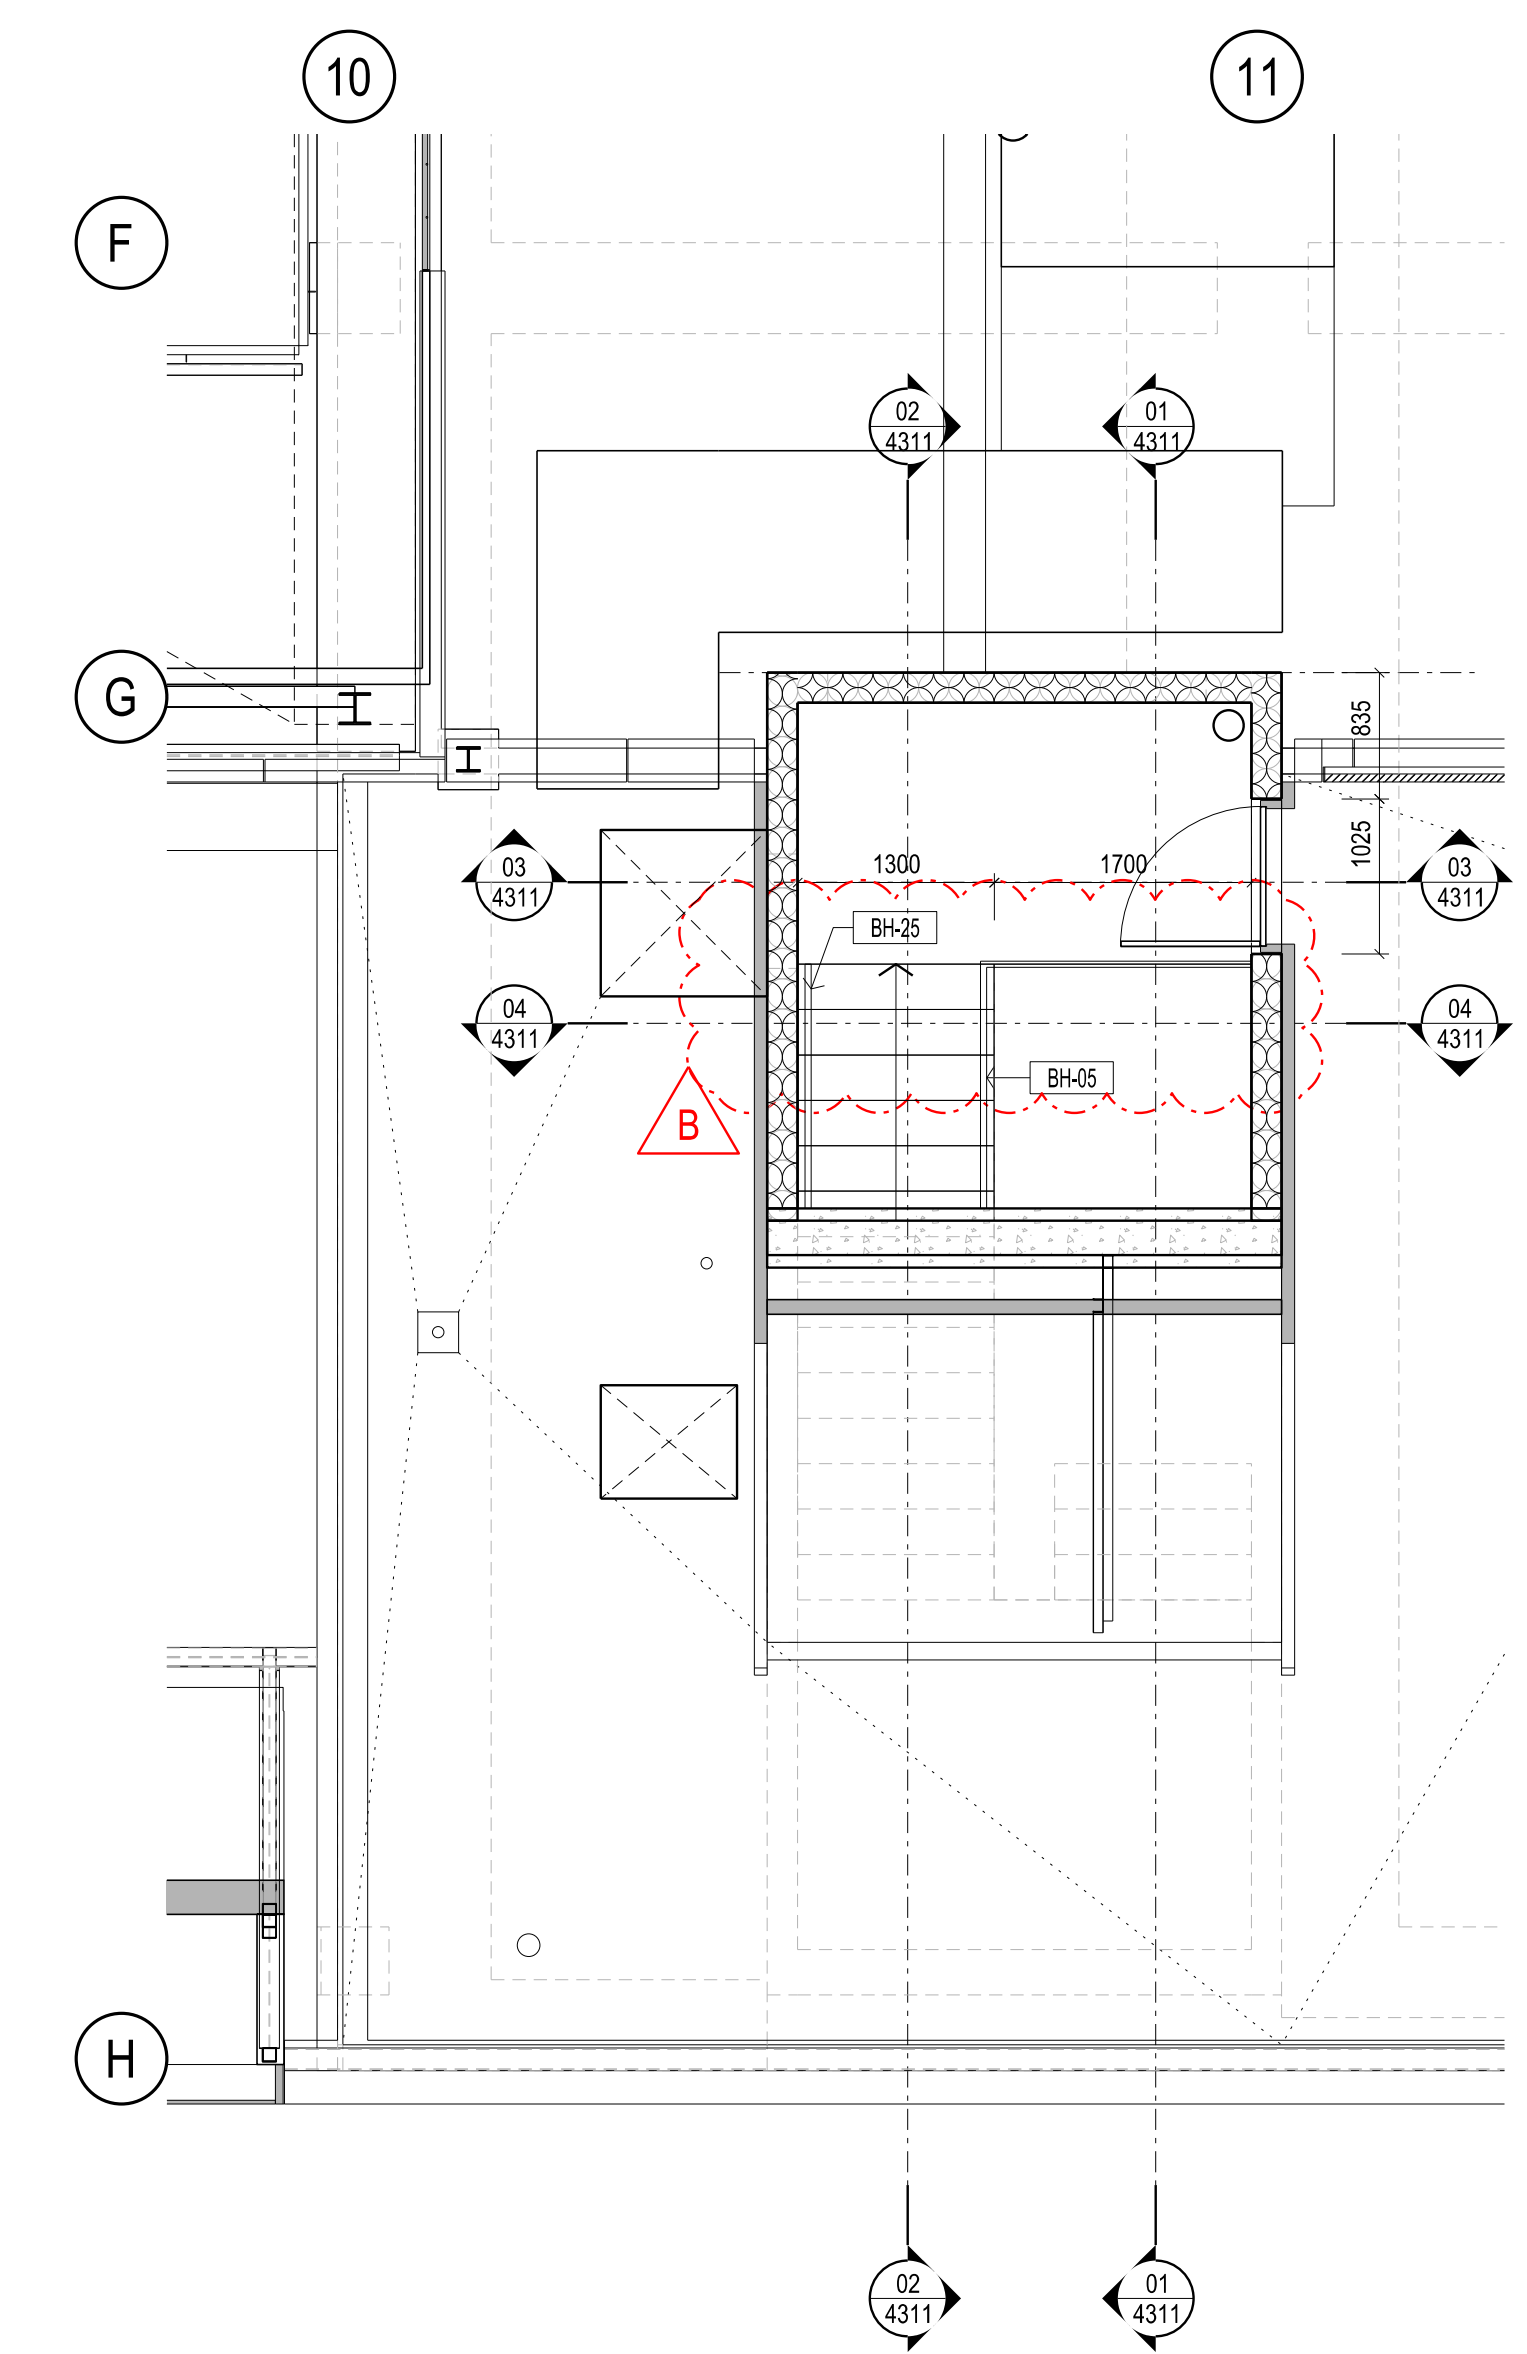

7 LEVEL 5 - CORE 3 PLAN  
SCALE 1:50

Rev	Issue	Revision Description	And	Date
B	SG	BALUSTRADE TAGS ADDED	KW	29.01.14
A	SG	SETOUT DIMENSIONS ADDED		26.09.13
10	SG	ISSUES FOR CONSTRUCTION		24.05.13
	SG	BUILDING PERMIT UPDATE		24.05.13
	SG	SERVICES PENO SETOUT CLARIFIED		
	SG	SETOUT DIMENSIONS CLARIFIED		
	SG	CLEARANCES ADDED		
	SG	SETOUT DIMENSIONS CLARIFIED		
09	SG	VALUE MANAGEMENT ISSUE		28.03.13
08	SG	100% CD - TENDER ISSUE		07.09.12
07	SG	90% CD ISSUE		10.09.12
06	SG	75% CD ISSUE		13.07.12
05	SG	50% CD ISSUE		01.06.12
04	SG	25% CD ISSUE		20.04.12
03	SG	FINAL DD ISSUE		24.02.12
02	SG	DD UPDATE		20.01.12
01	SG	PRELIMINARY DD		02.11.11



**NADAAA**  
 NADAAA  
 1520 Washington Street No.2 Boston Massachusetts 02118 USA  
 Telephone +1 617 442 8232 Facsimile +1 688 442 1417 Email nadaaa@nadaaa.com

**John Wardle Architects**  
 25 Rokeby Street, Collingwood, Victoria 3066 Australia  
 Tel: +61 3 8662 0400 www.johnwardlearchitects.com  
 © 2014 John Wardle Architects ABN 83 006 814 268

Client **University of Melbourne Parkville Campus**  
 Project **Faculty of Architecture Building and Planning**

Title **CONCRETE CORE CORE 3 - PLANS**

Project No.	<b>0913</b>	Scale	1:100 @ A0 1:200 @ A2
Drawing No.	<b>AR4310</b>	Revision	<b>B</b>

Date: Oct 2011 Drawn: Co-Ord: Check:

FILENAME - \$FILES  
**FOR CONSTRUCTION**