


CONTRACTORS SHALL VERIFY JOB DIMENSIONS BEFORE ANY JOB COMMENCES. ALL SHOP DRAWINGS SHALL BE SUBMITTED TO THE SUPERINTENDENT AND MANUFACTURERS SHALL NOT COMMENCE FROM THE RETURN OF DRAWINGS SHOWN BY THE CONSULTANT FIGURED DIMENSIONS SHALL TAKE PRECEDENCE OVER SCALED. THIS DRAWING SHALL BE USED IN CONSTRUCTION WITH ALL RELEVANT CONTRACT SPECIFICATIONS AND DRAWINGS COPYRIGHT OF THIS DRAWING IS VESTED IN WARDLE

General Notes



Rev	Issue	Revision Description	Amd	Date
A	SG	ISSUED FOR CONSTRUCTION	-	10.01.14
06	SG	VALUE MANAGEMENT ISSUE	-	28.03.13
05	SG	100% CD - TENDER ISSUE	-	07.03.12
04	SG	90% CD ISSUE	-	10.08.12
03	SG	75% CD ISSUE	-	13.07.12
02	SG	50% CD ISSUE	-	01.06.12
01	SG	25% CD ISSUE	-	20.04.12

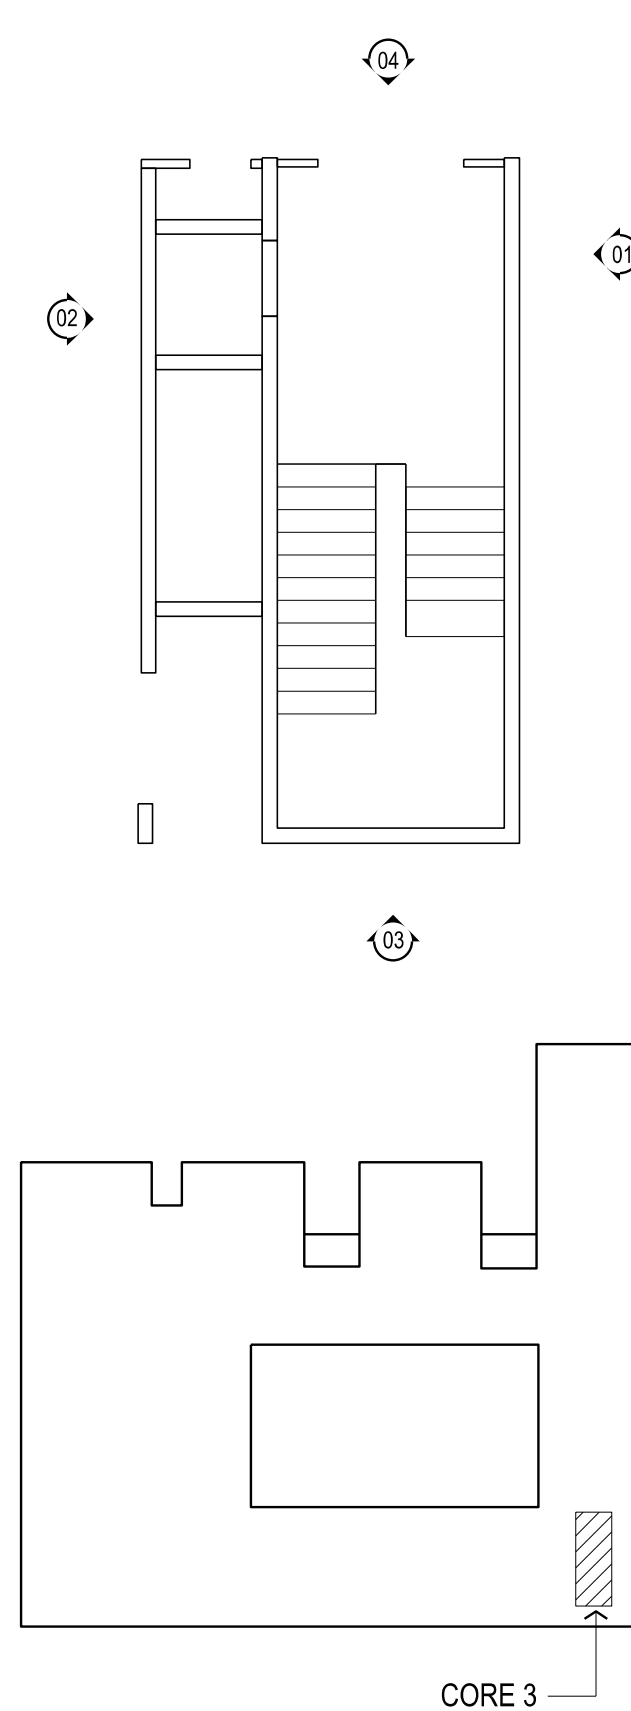


NADAAA
 NADAAA
 1920 Washington Street No.2 Boston Massachusetts 02118 USA
 Telephone +1 617 442 2332 Facsimile +1 688 442 1417 Email nadaaa@nadaaa.com

John Wardle Architects
 25 Rokeby Street, Collingwood, Victoria 3066 Australia
 Tel: +61 3 8662 0400 www.johnwardlearchitects.com
 © 2012 John Wardle Architects ABN 83 006 814 268


Client **University of Melbourne Parkville Campus**
 Project **Faculty of Architecture Building and Planning**
 Title **CONCRETE CORE CORE 3 - ELEVATIONS**

Project No.	0913	Scale	1:50 @ A0 1:25 @ A2
Drawing No.	AR4312	Revision	A
Date	Oct 2011	Dwn	-
Co-Ord	-	Chk	-


FILENAME - SFILES
FOR CONSTRUCTION

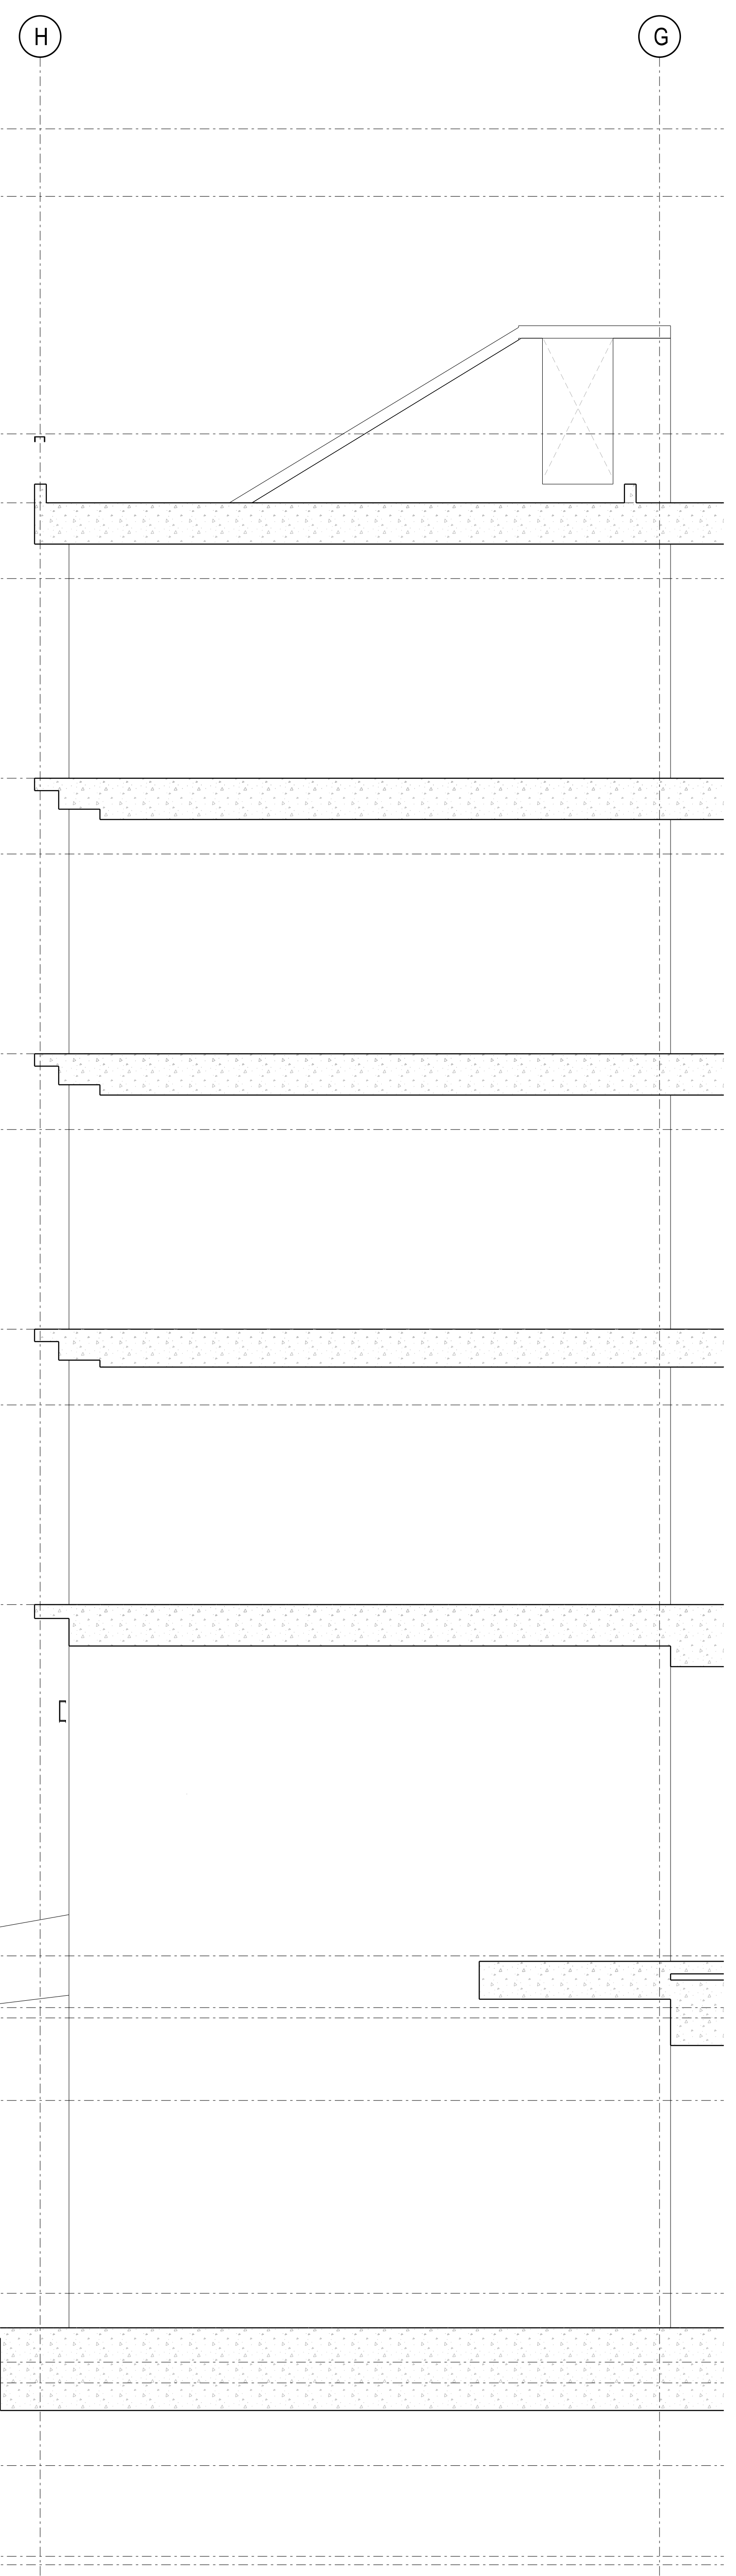


1 CORE 3 - SECTION E-11-02
 SCALE 1:50

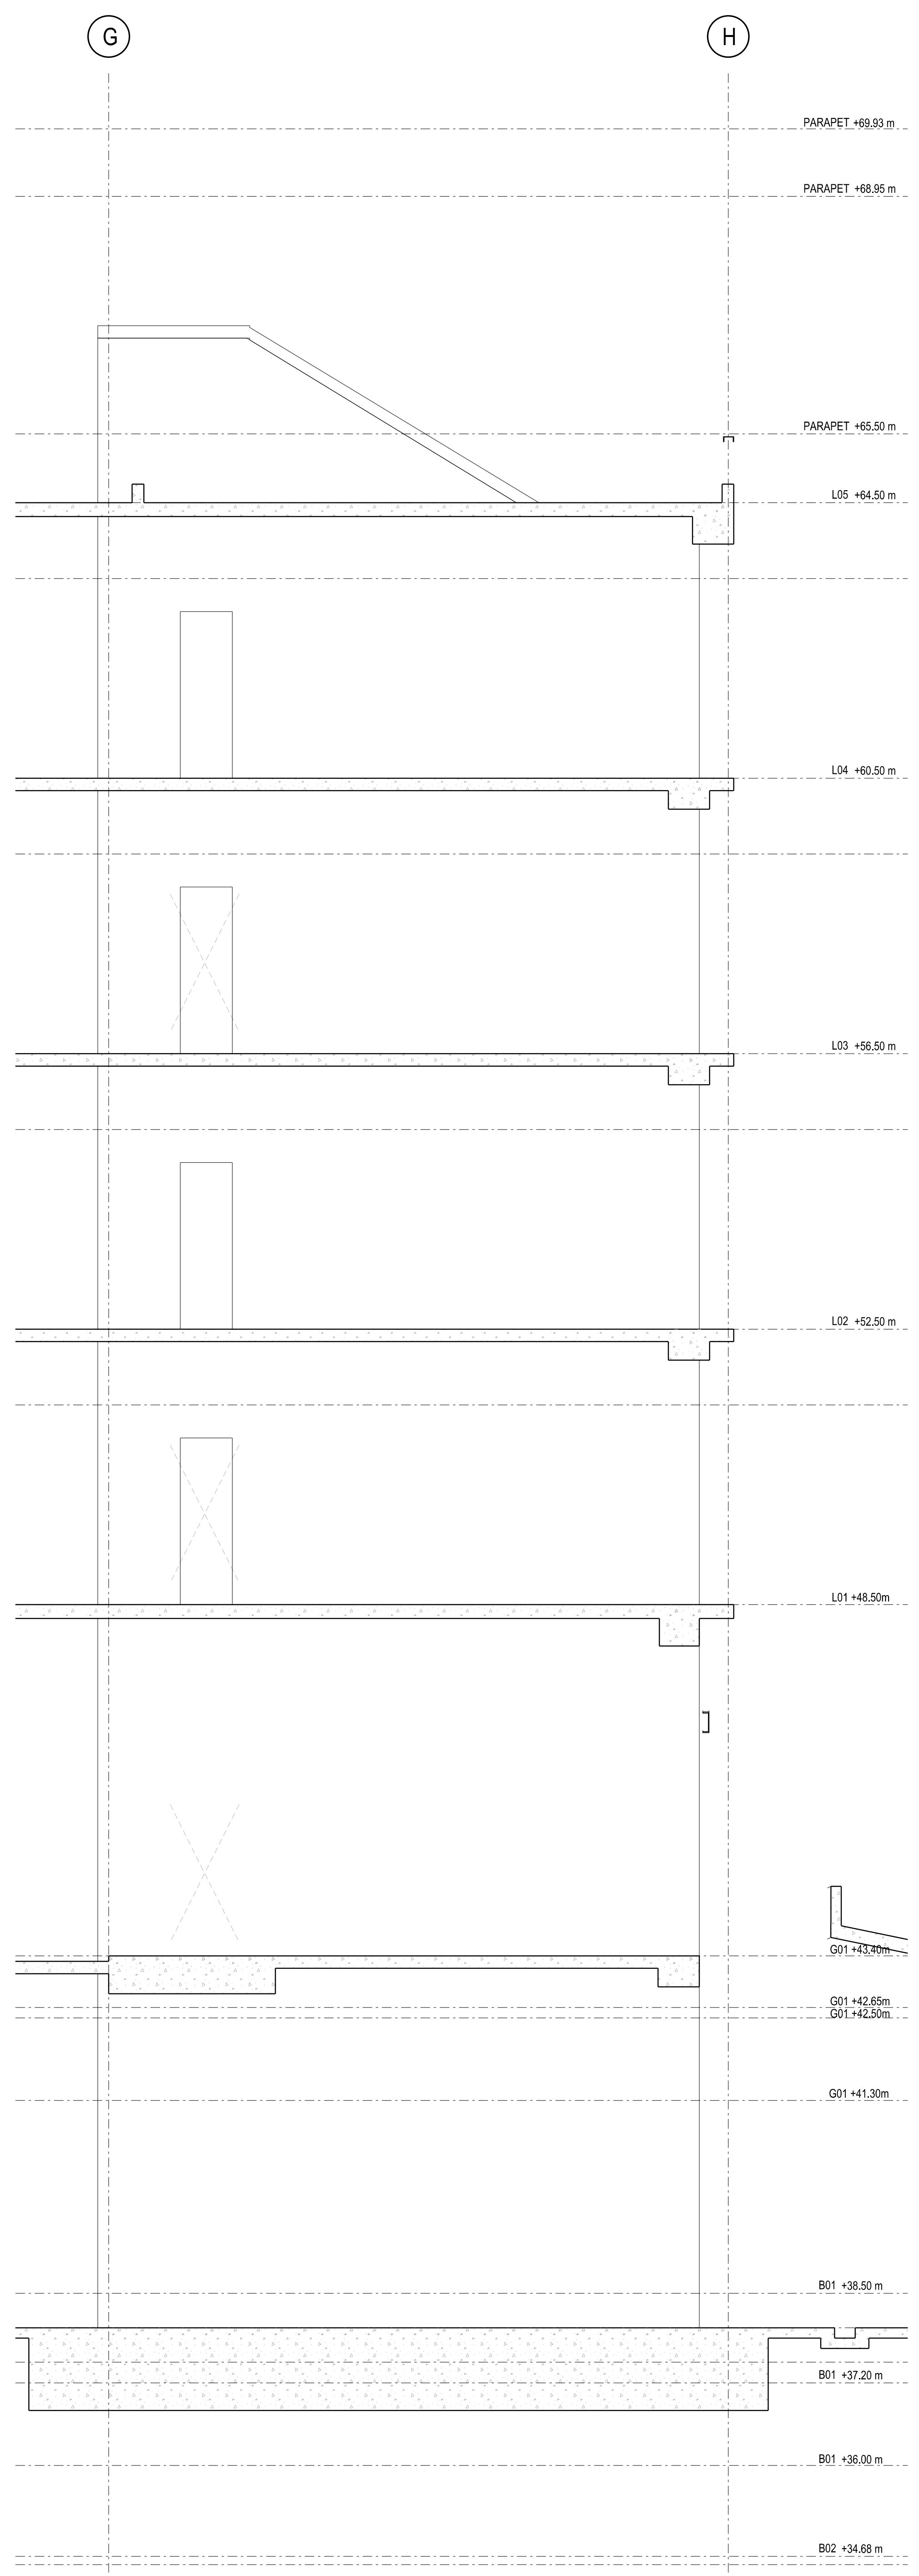

2 CORE 3 - SECTION W-11-02
 SCALE 1:50

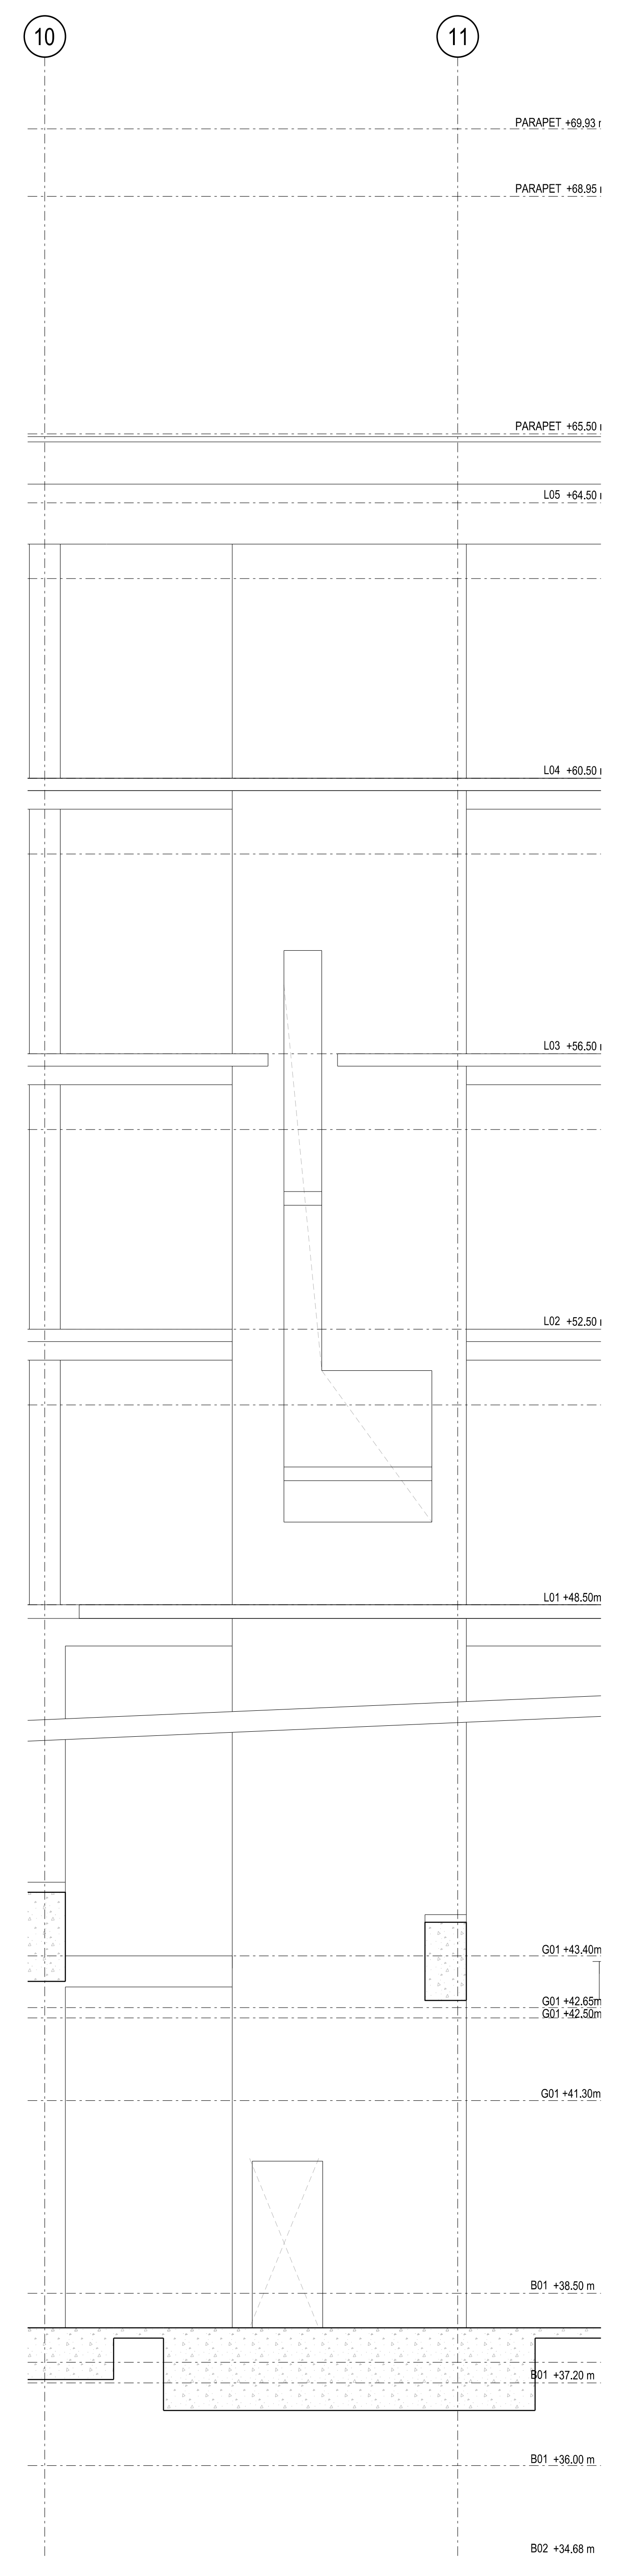

3 CORE 3 - SECTION S-H-01
 SCALE 1:50

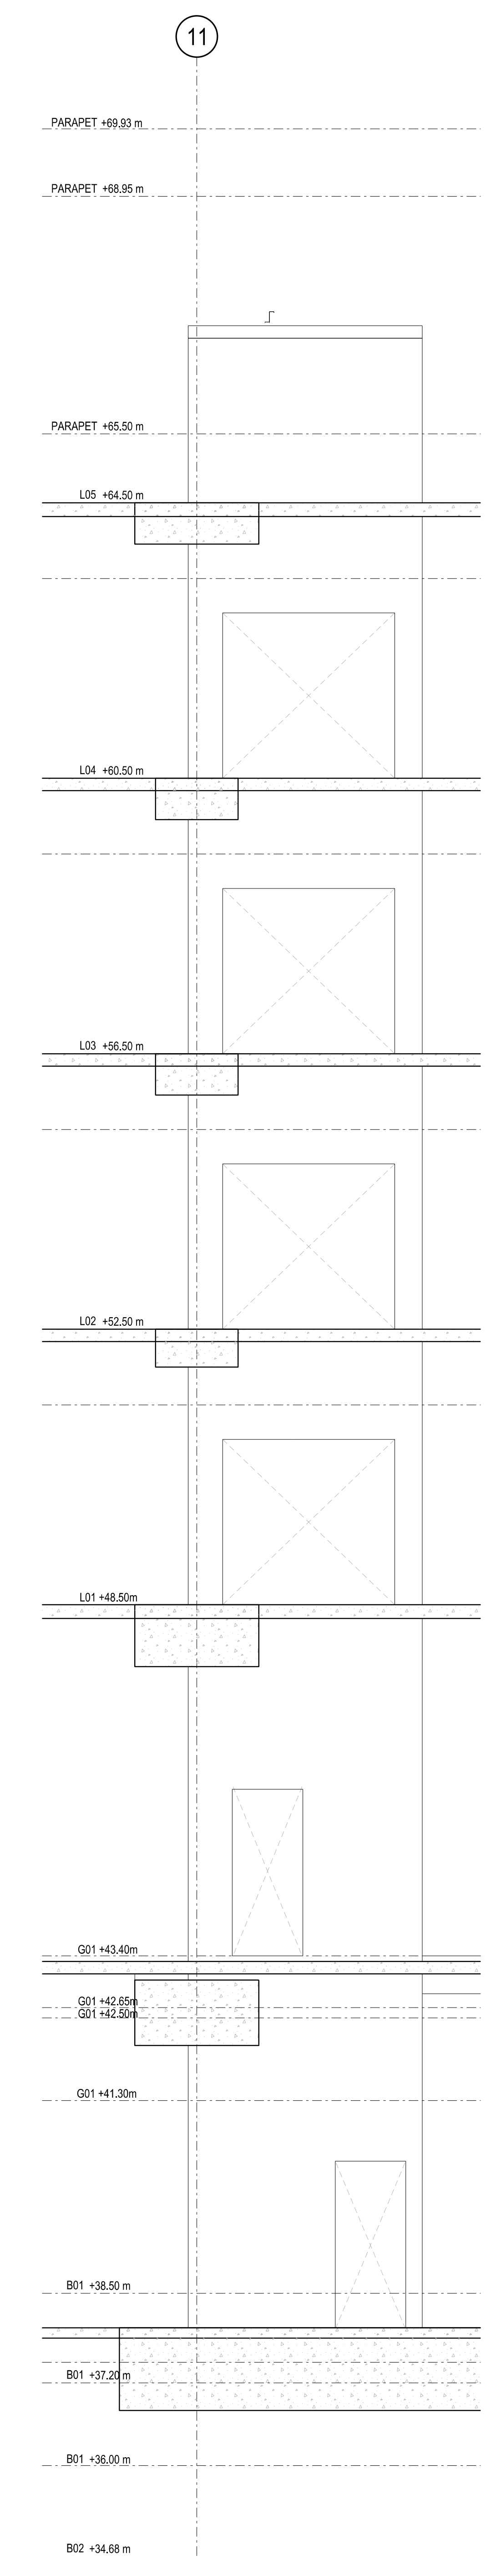

4 CORE 3 - SECTION N-G-03
 SCALE 1:50