



CONTRACTORS SHALL VERIFY JOB DIMENSIONS BEFORE ANY JOB COMMENCES. ALL SHOP DRAWINGS SHALL BE SUBMITTED TO THE SUPERINTENDENT AND MANUFACTURER SHALL NOT COMMENCE FROM THE RETURN OF DIMENSIONS SHOP DRAWINGS REVIEWED BY THE CONSULTANT. FIGURED DIMENSIONS SHALL TAKE PRECEDENCE OVER SCALES. THIS DRAWING SHALL BE READ IN CONJUNCTION WITH ALL RELEVANT CONTRACT SPECIFICATIONS AND DRAWINGS COPYRIGHT OF THIS DRAWING IS VESTED IN HANDLE.


General Notes

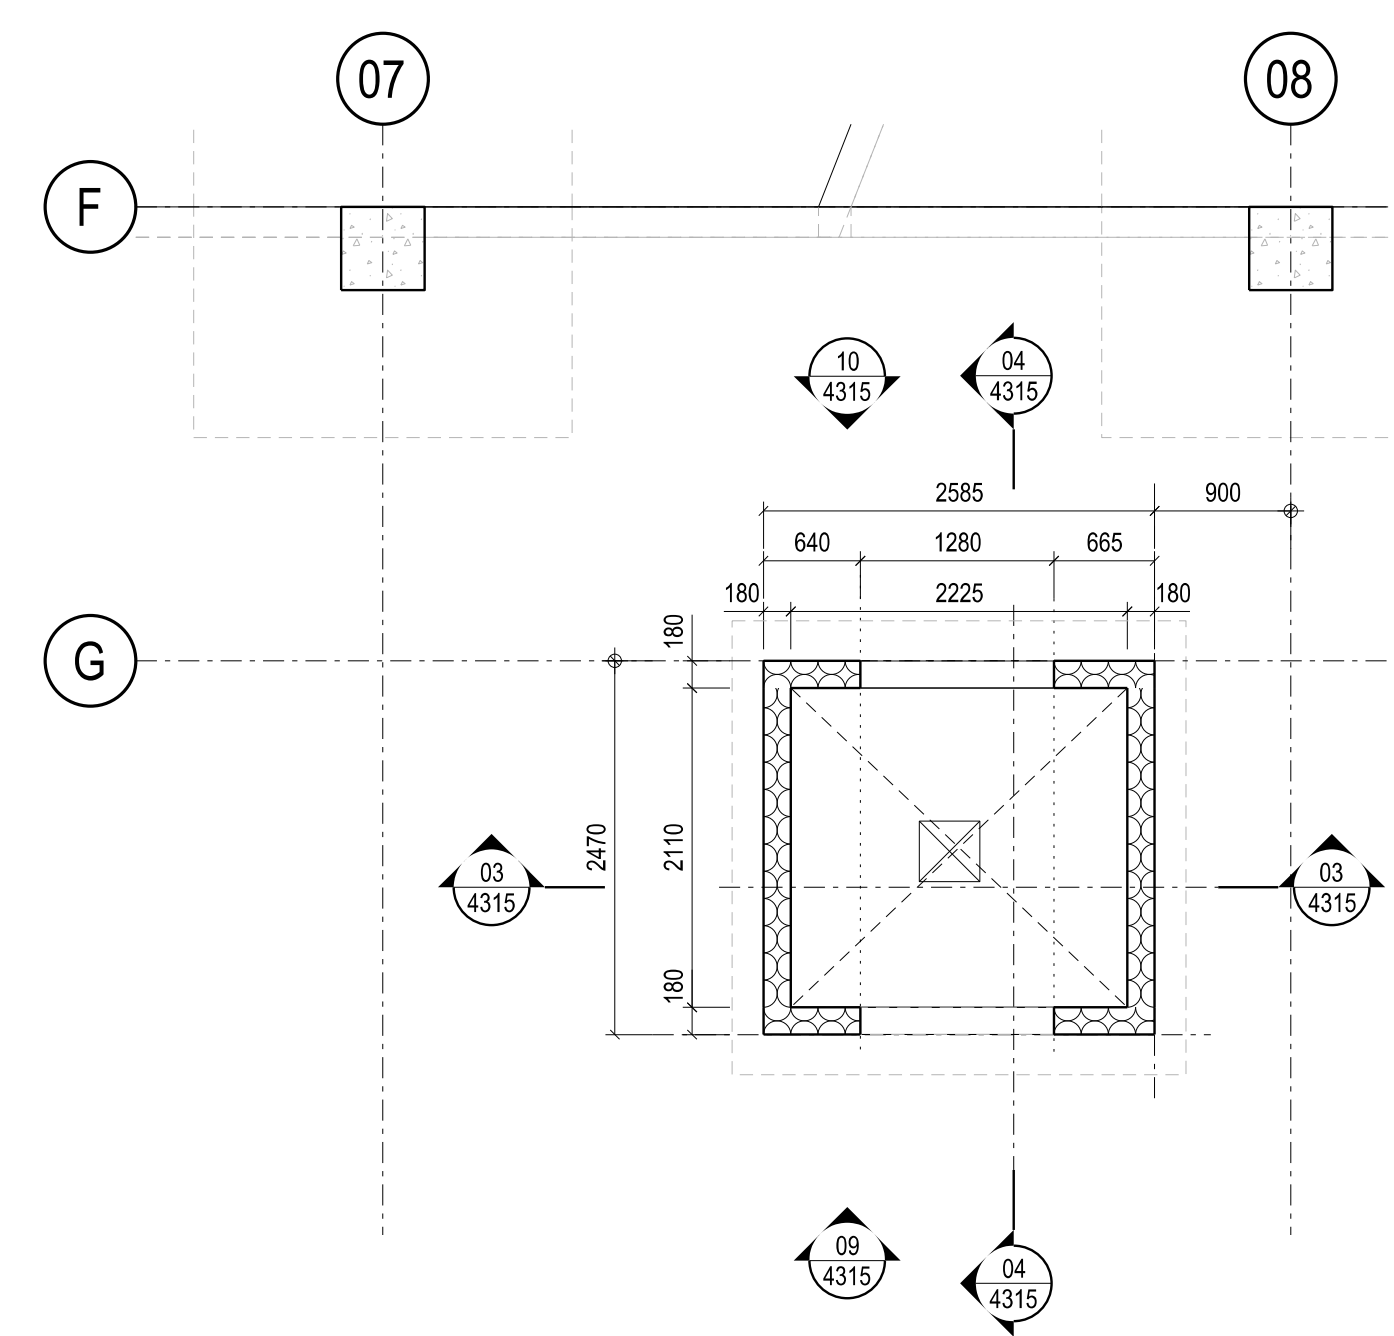


1 LIFT 4 CORE 5 PLAN - LEVEL B01 SCALE 1:50

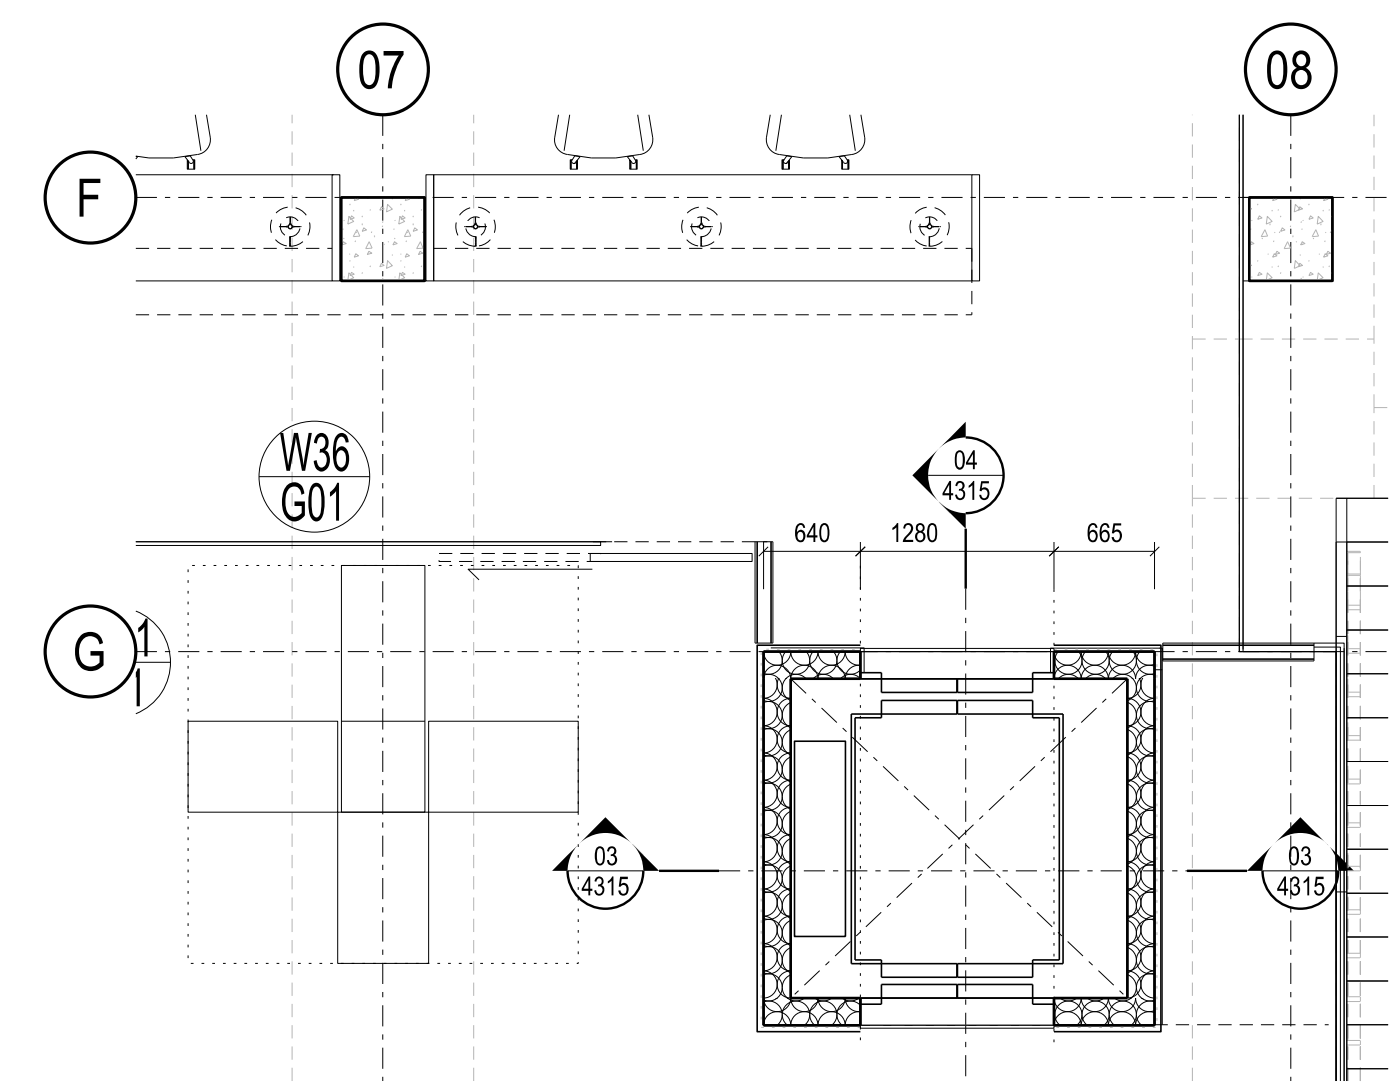


2 LIFT 4 CORE 5 PLAN - LEVEL G01 SCALE 1:50

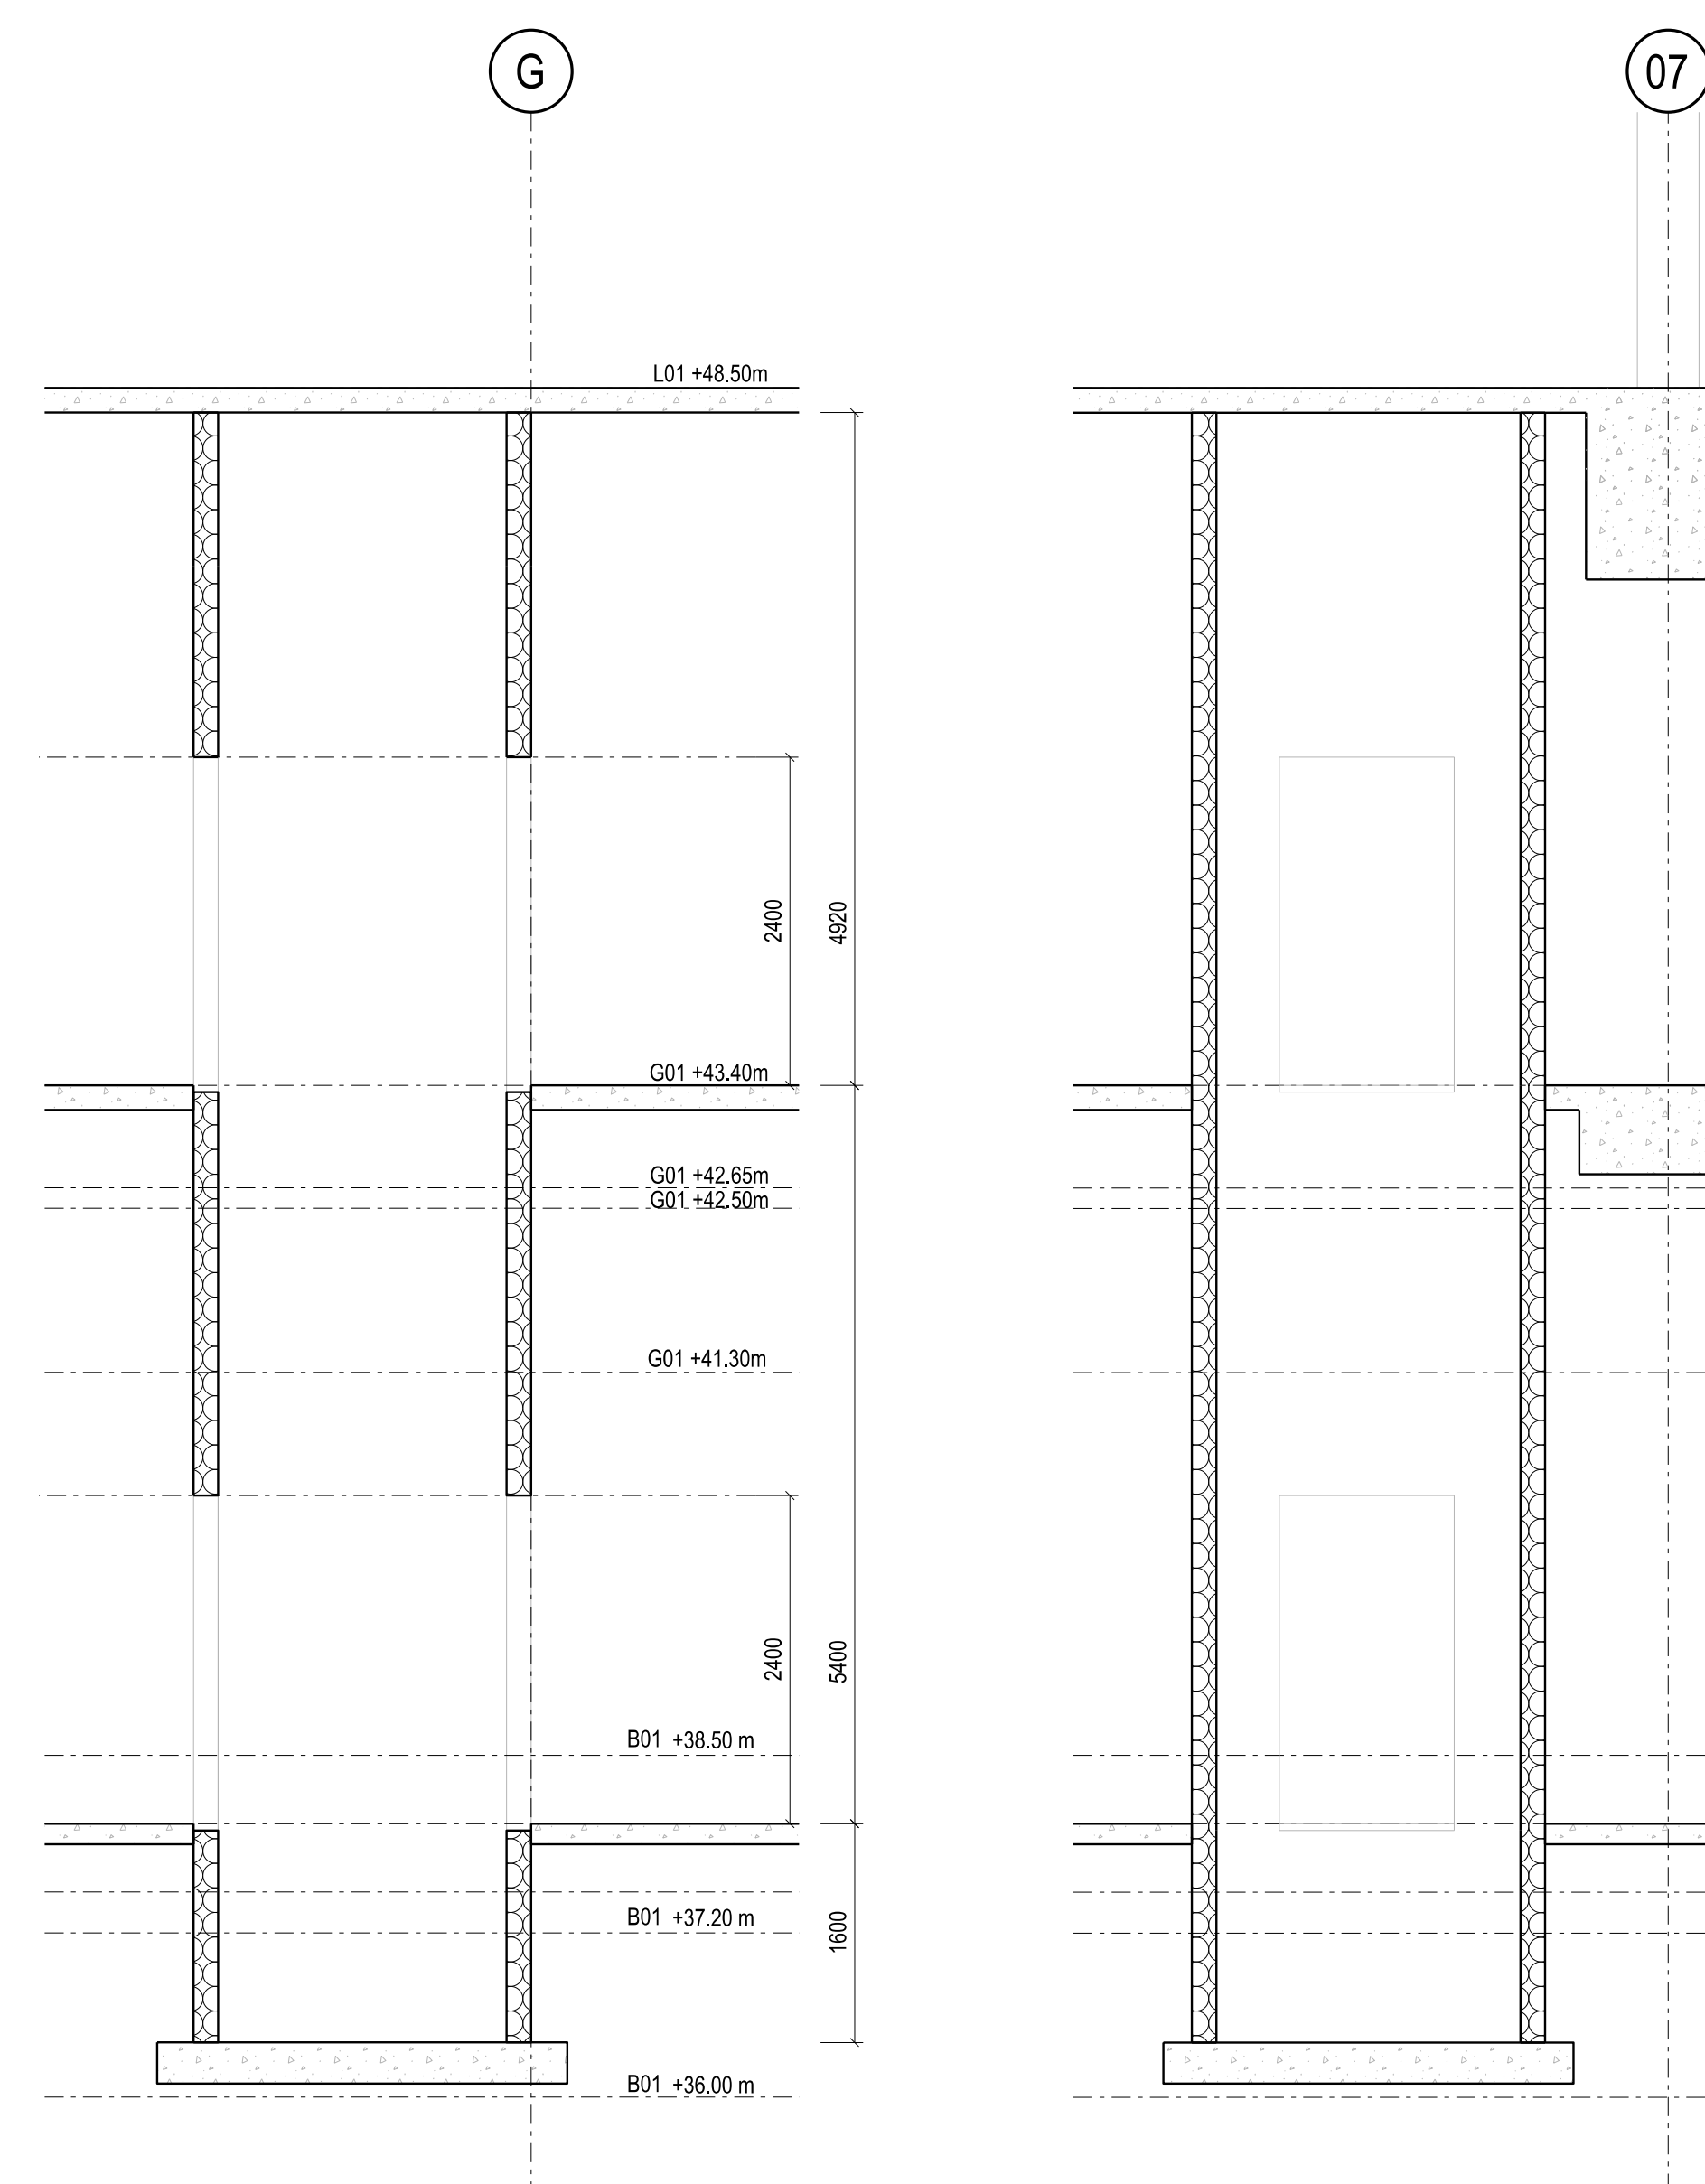


3 LIFT 4 CORE 5 SECTION - E-07-01 SCALE 1:50

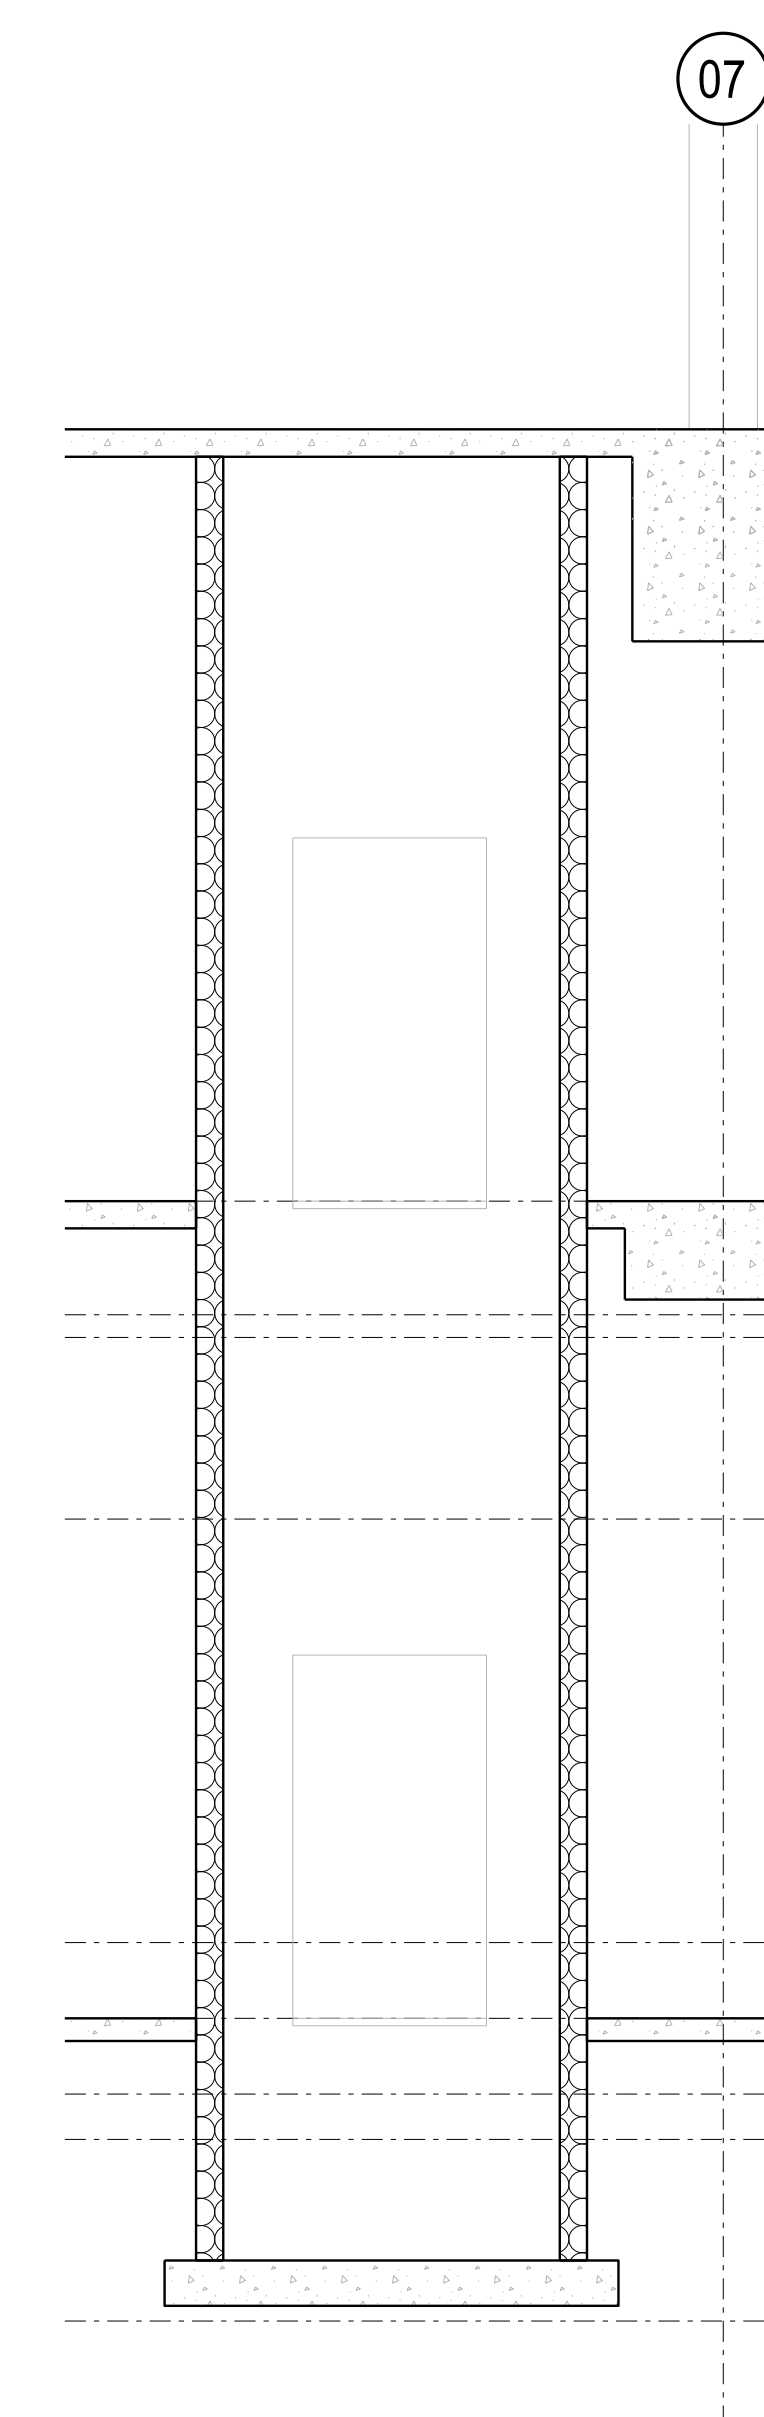


4 LIFT 4 CORE 5 SECTION - S-G-03 SCALE 1:50

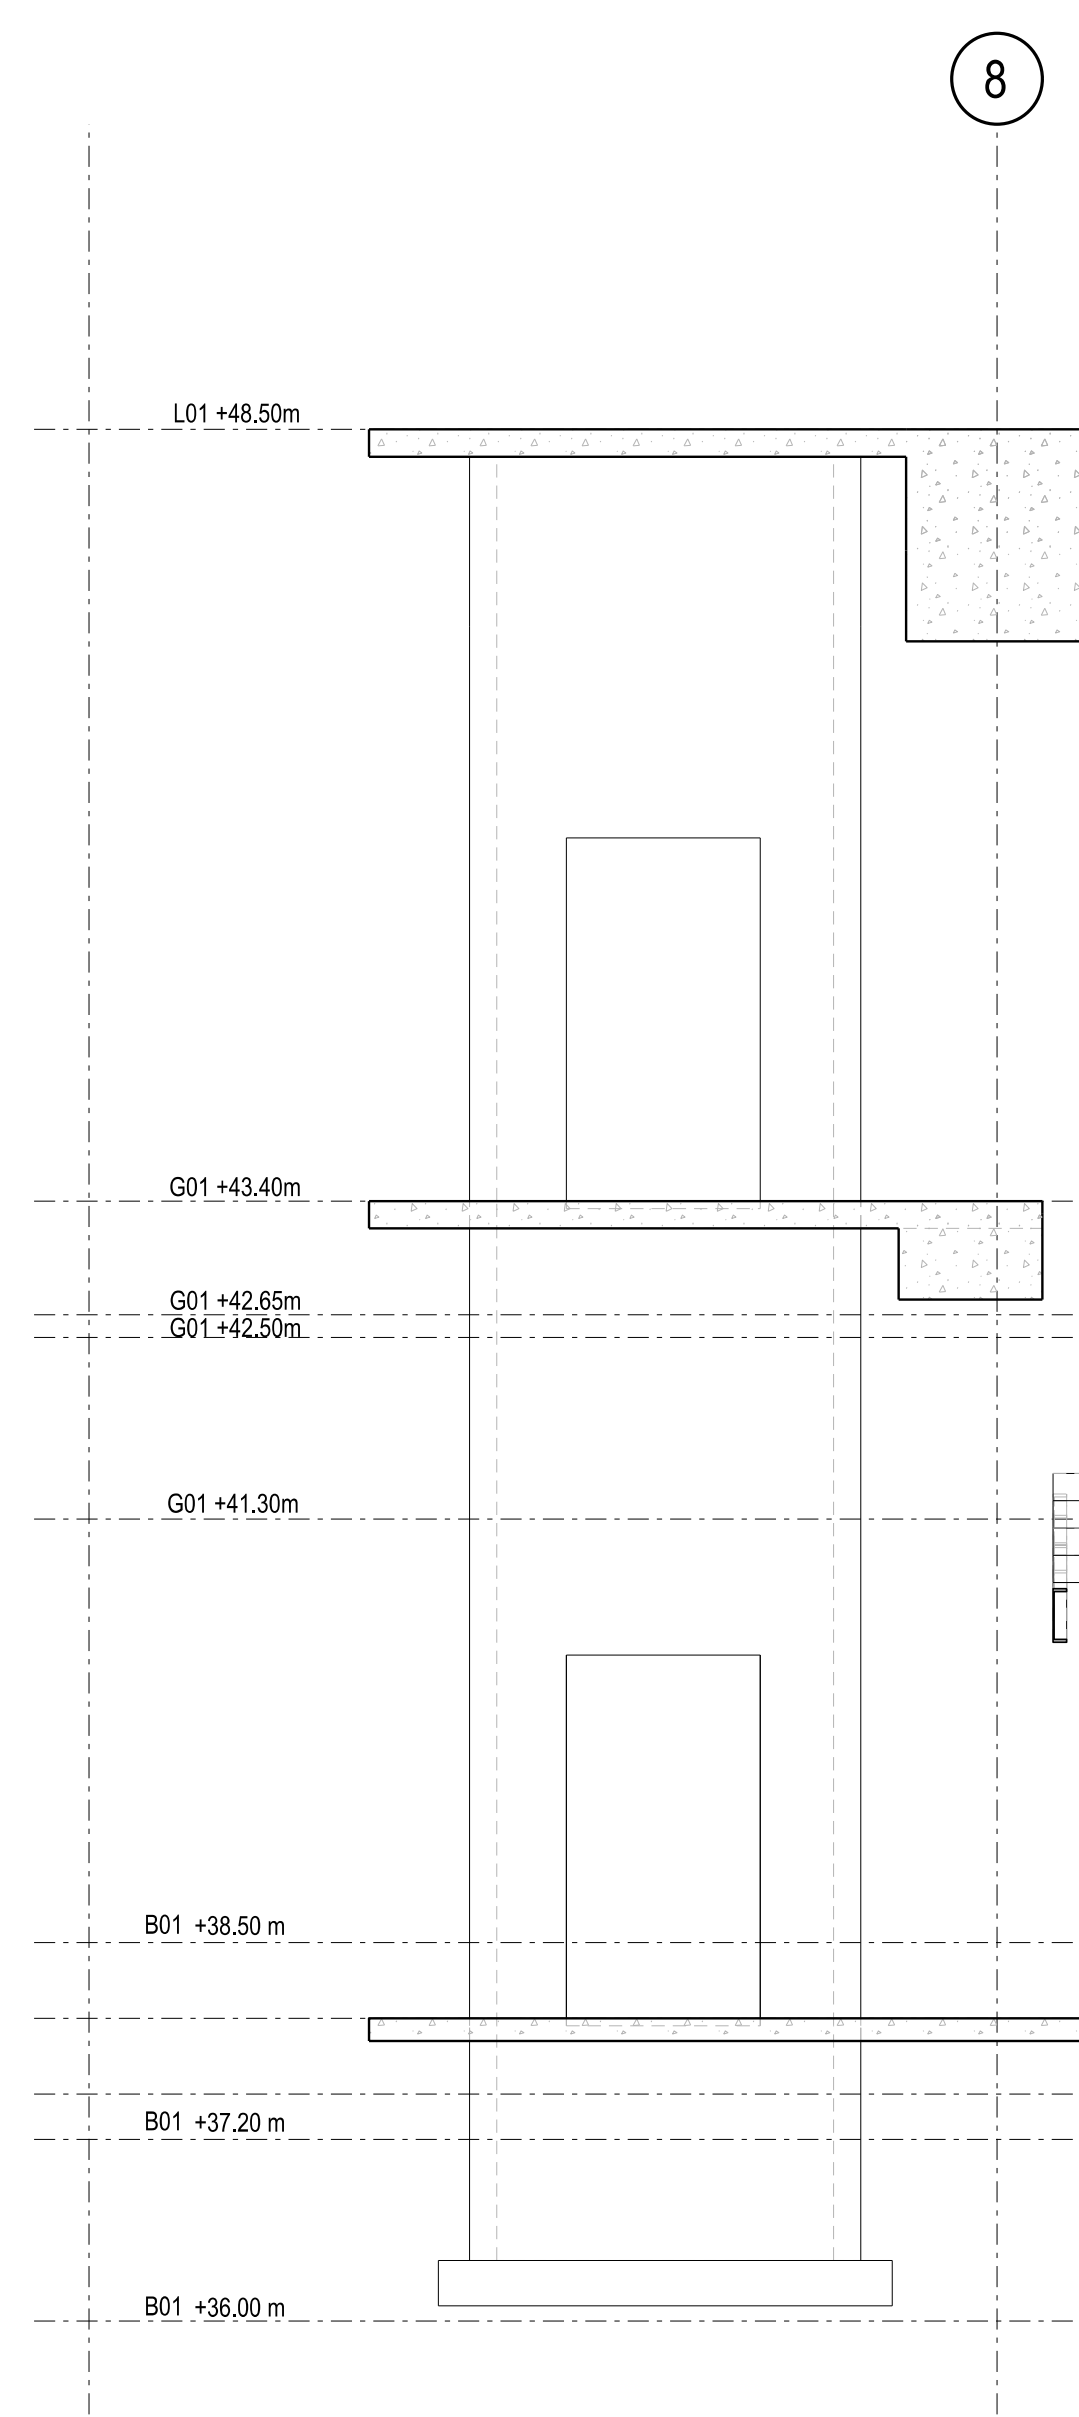


9 LIFT 4 CORE 5 ELEV. - S-G-04 SCALE 1:50

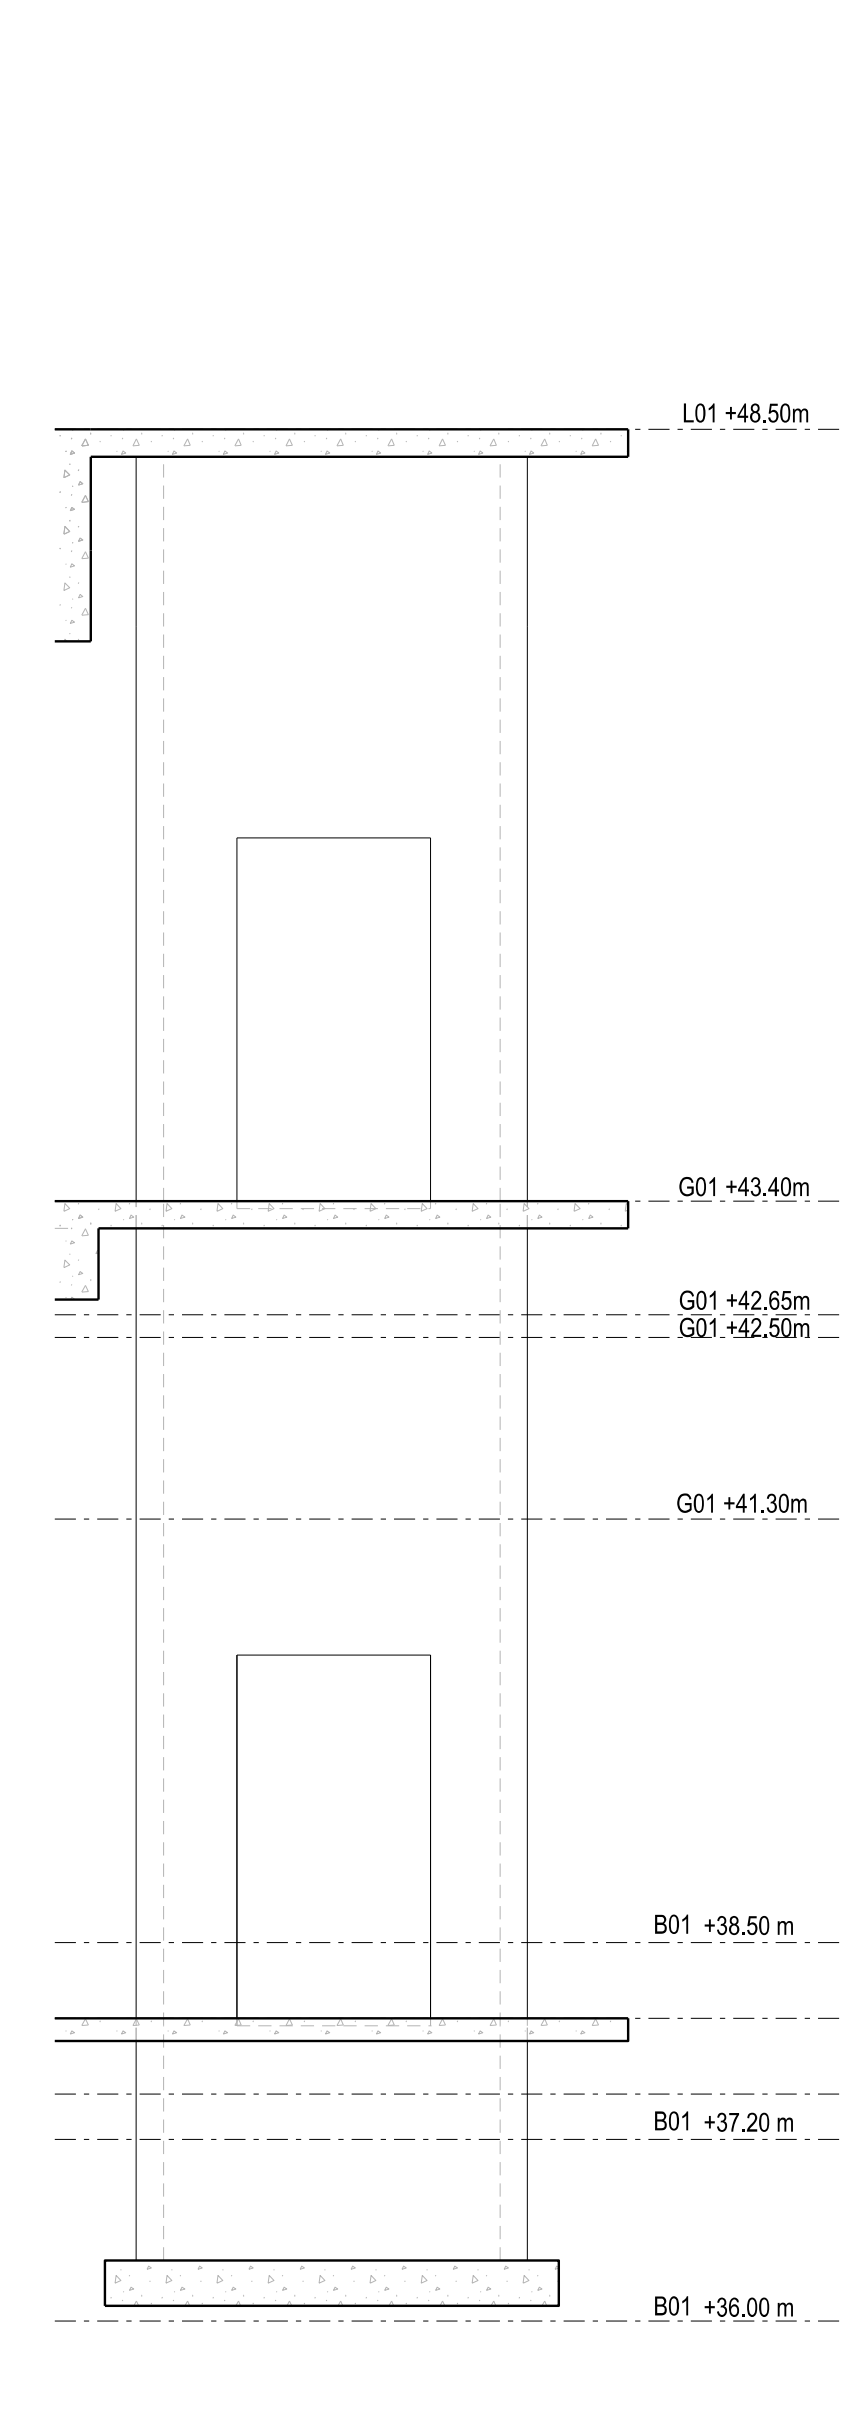


10 LIFT 4 CORE 5 ELEV. - N-G-05 SCALE 1:50

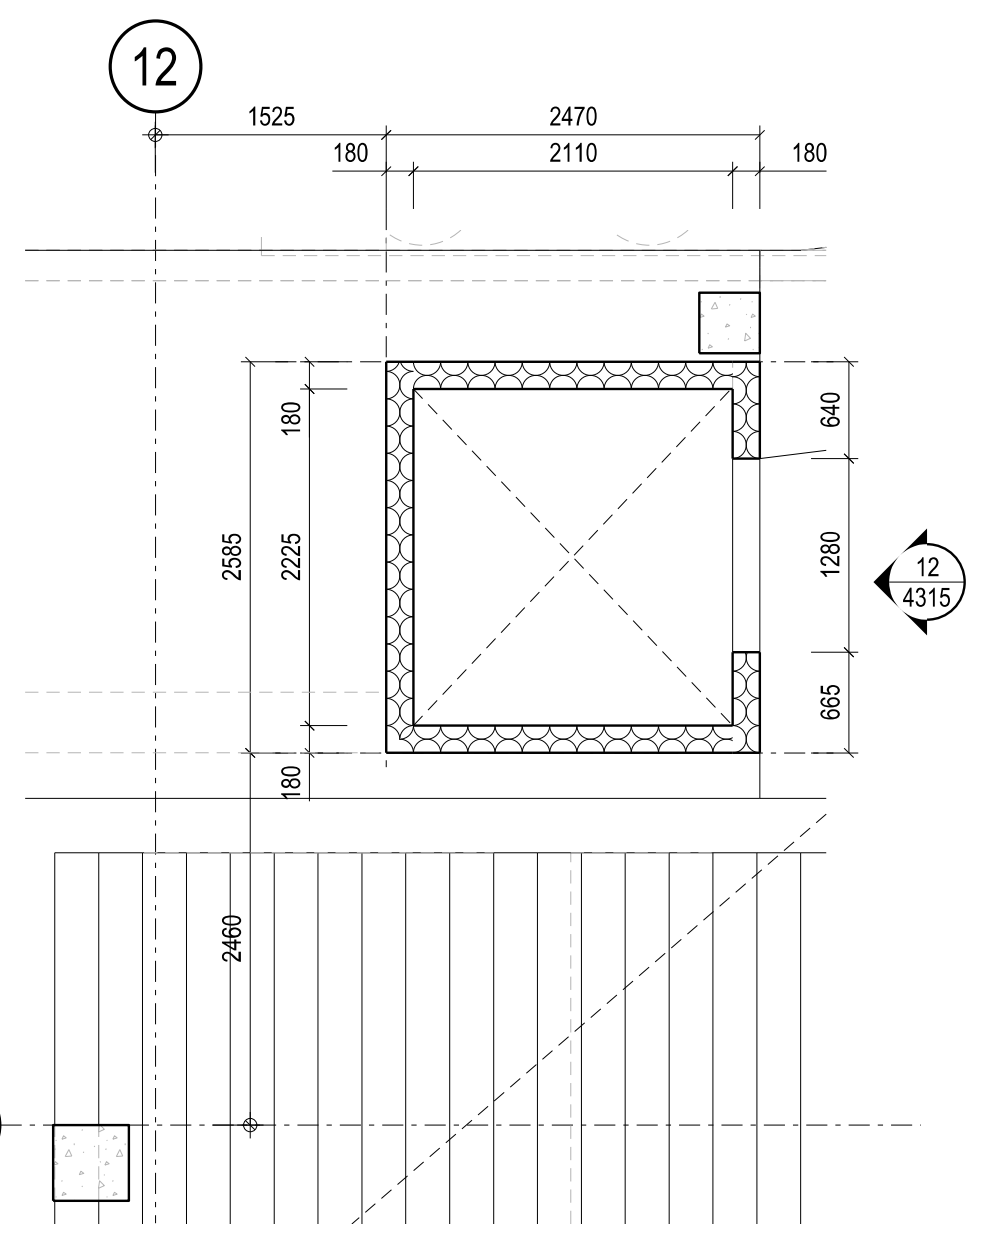


5 LIFT 5 CORE 6 PLAN - GROUND LEVEL SCALE 1:50

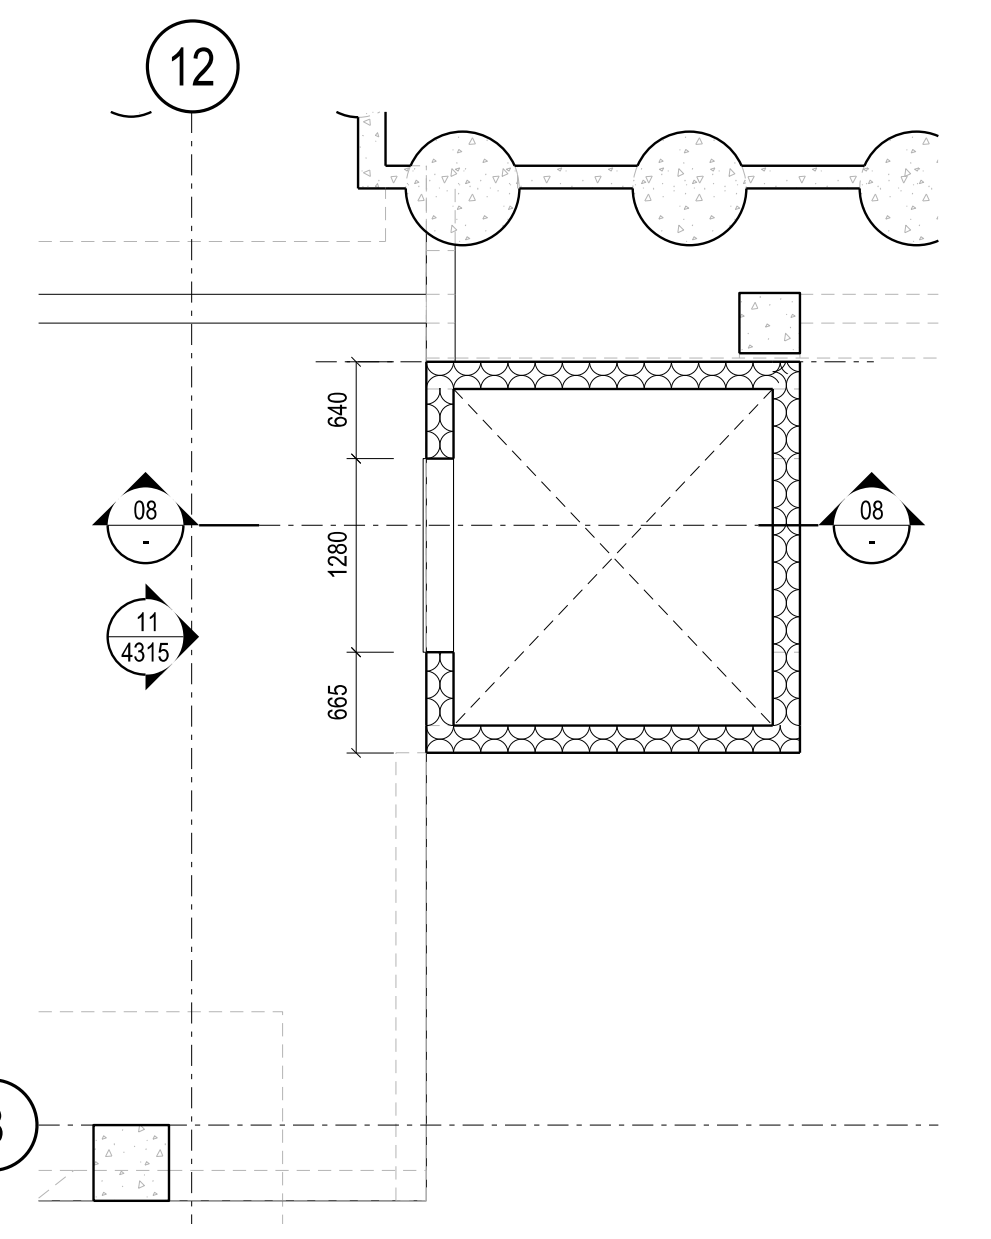


6 LIFT 5 CORE 6 PLAN - LEVEL B01 SCALE 1:50

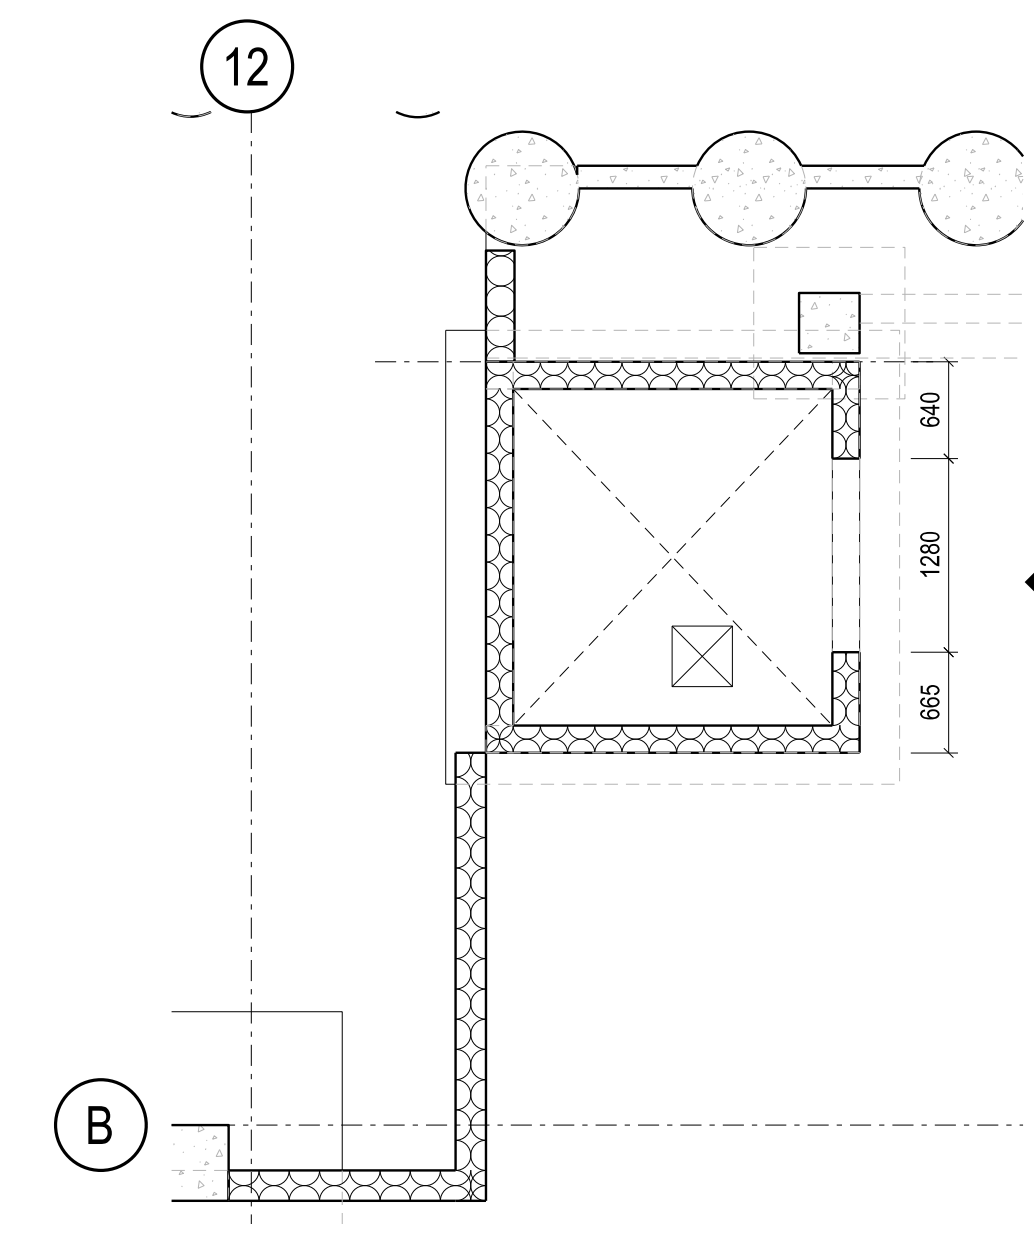


7 LIFT 5 CORE 6 PLAN - LEVEL B02 SCALE 1:50

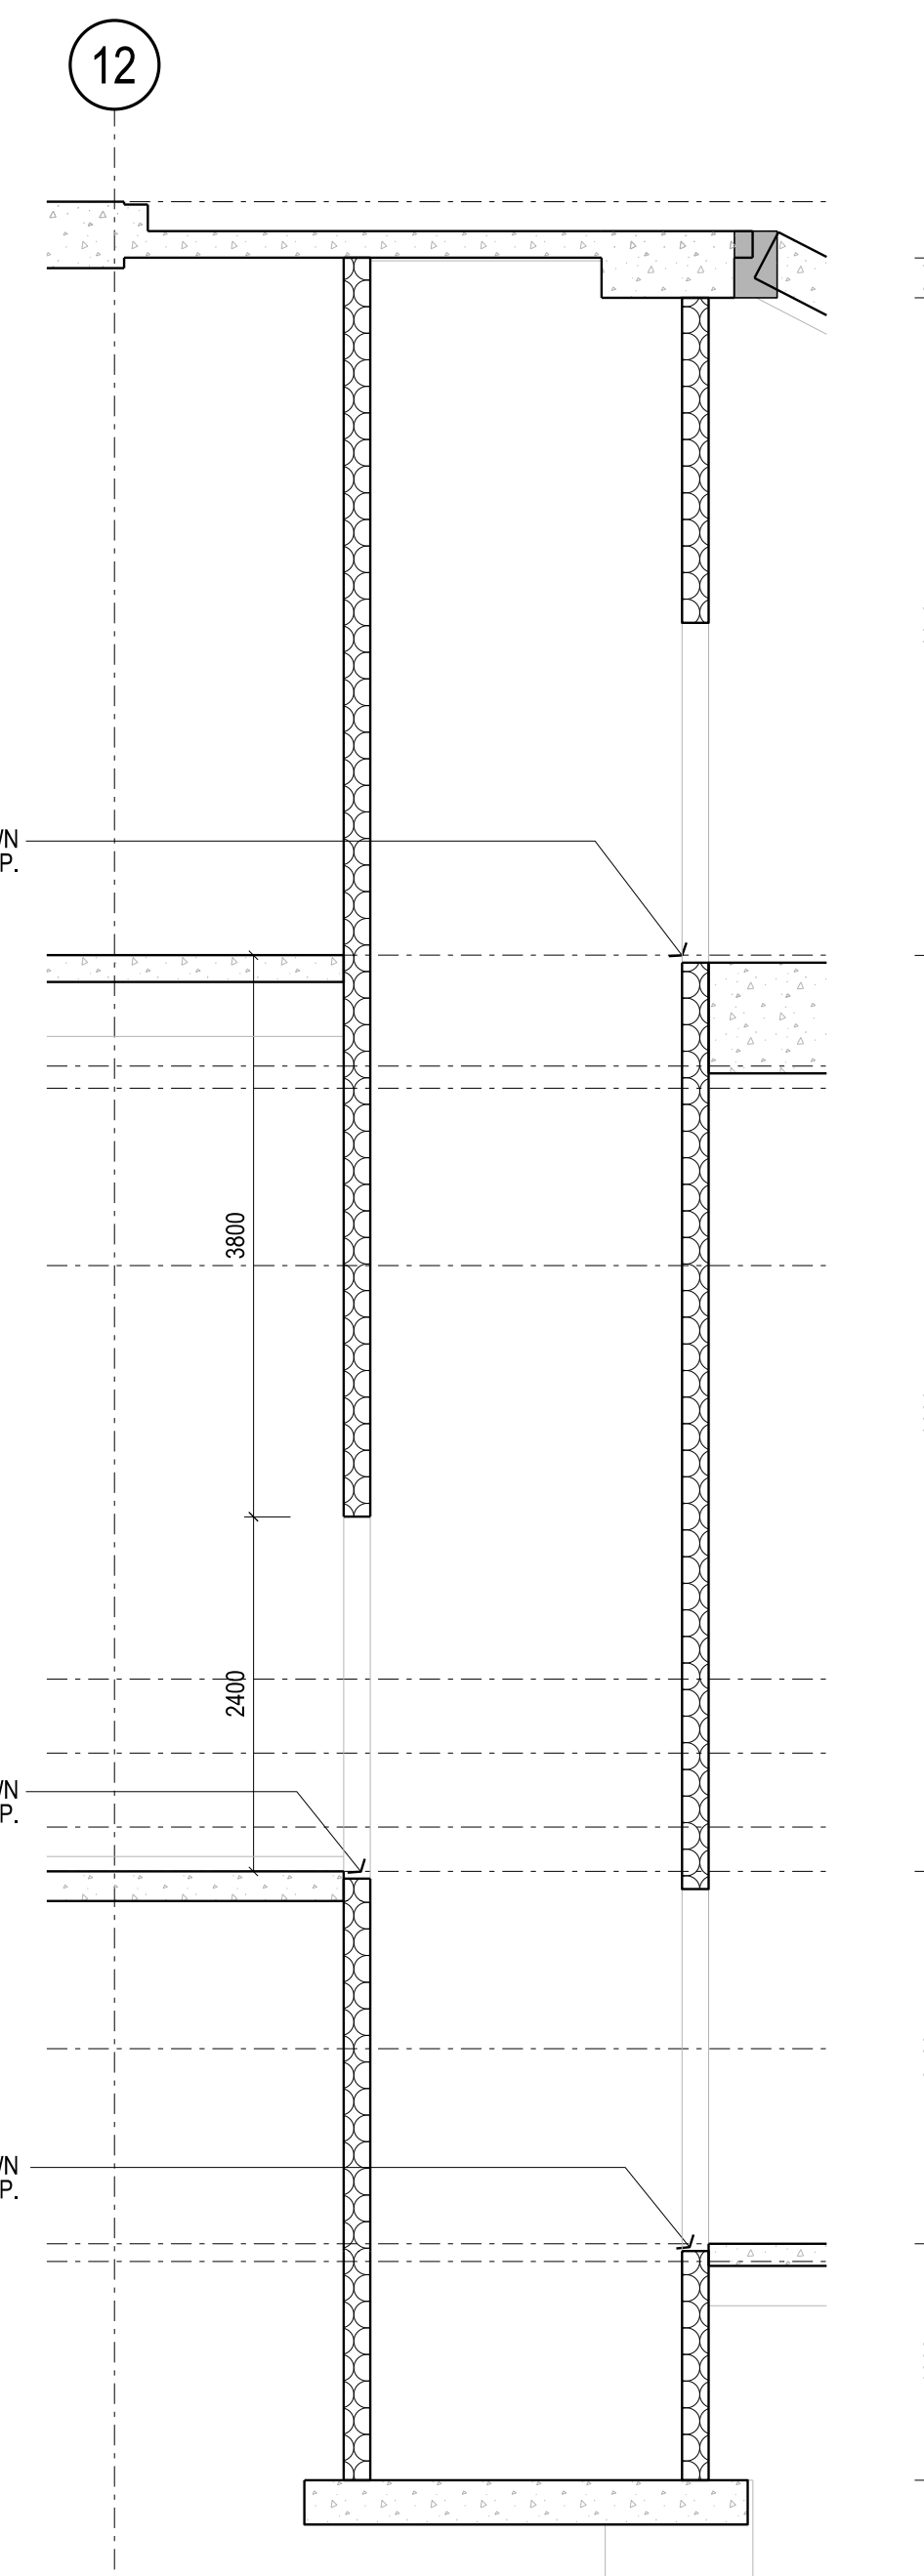


8 LIFT 5 CORE 6 SECTION - S-B-01 SCALE 1:50

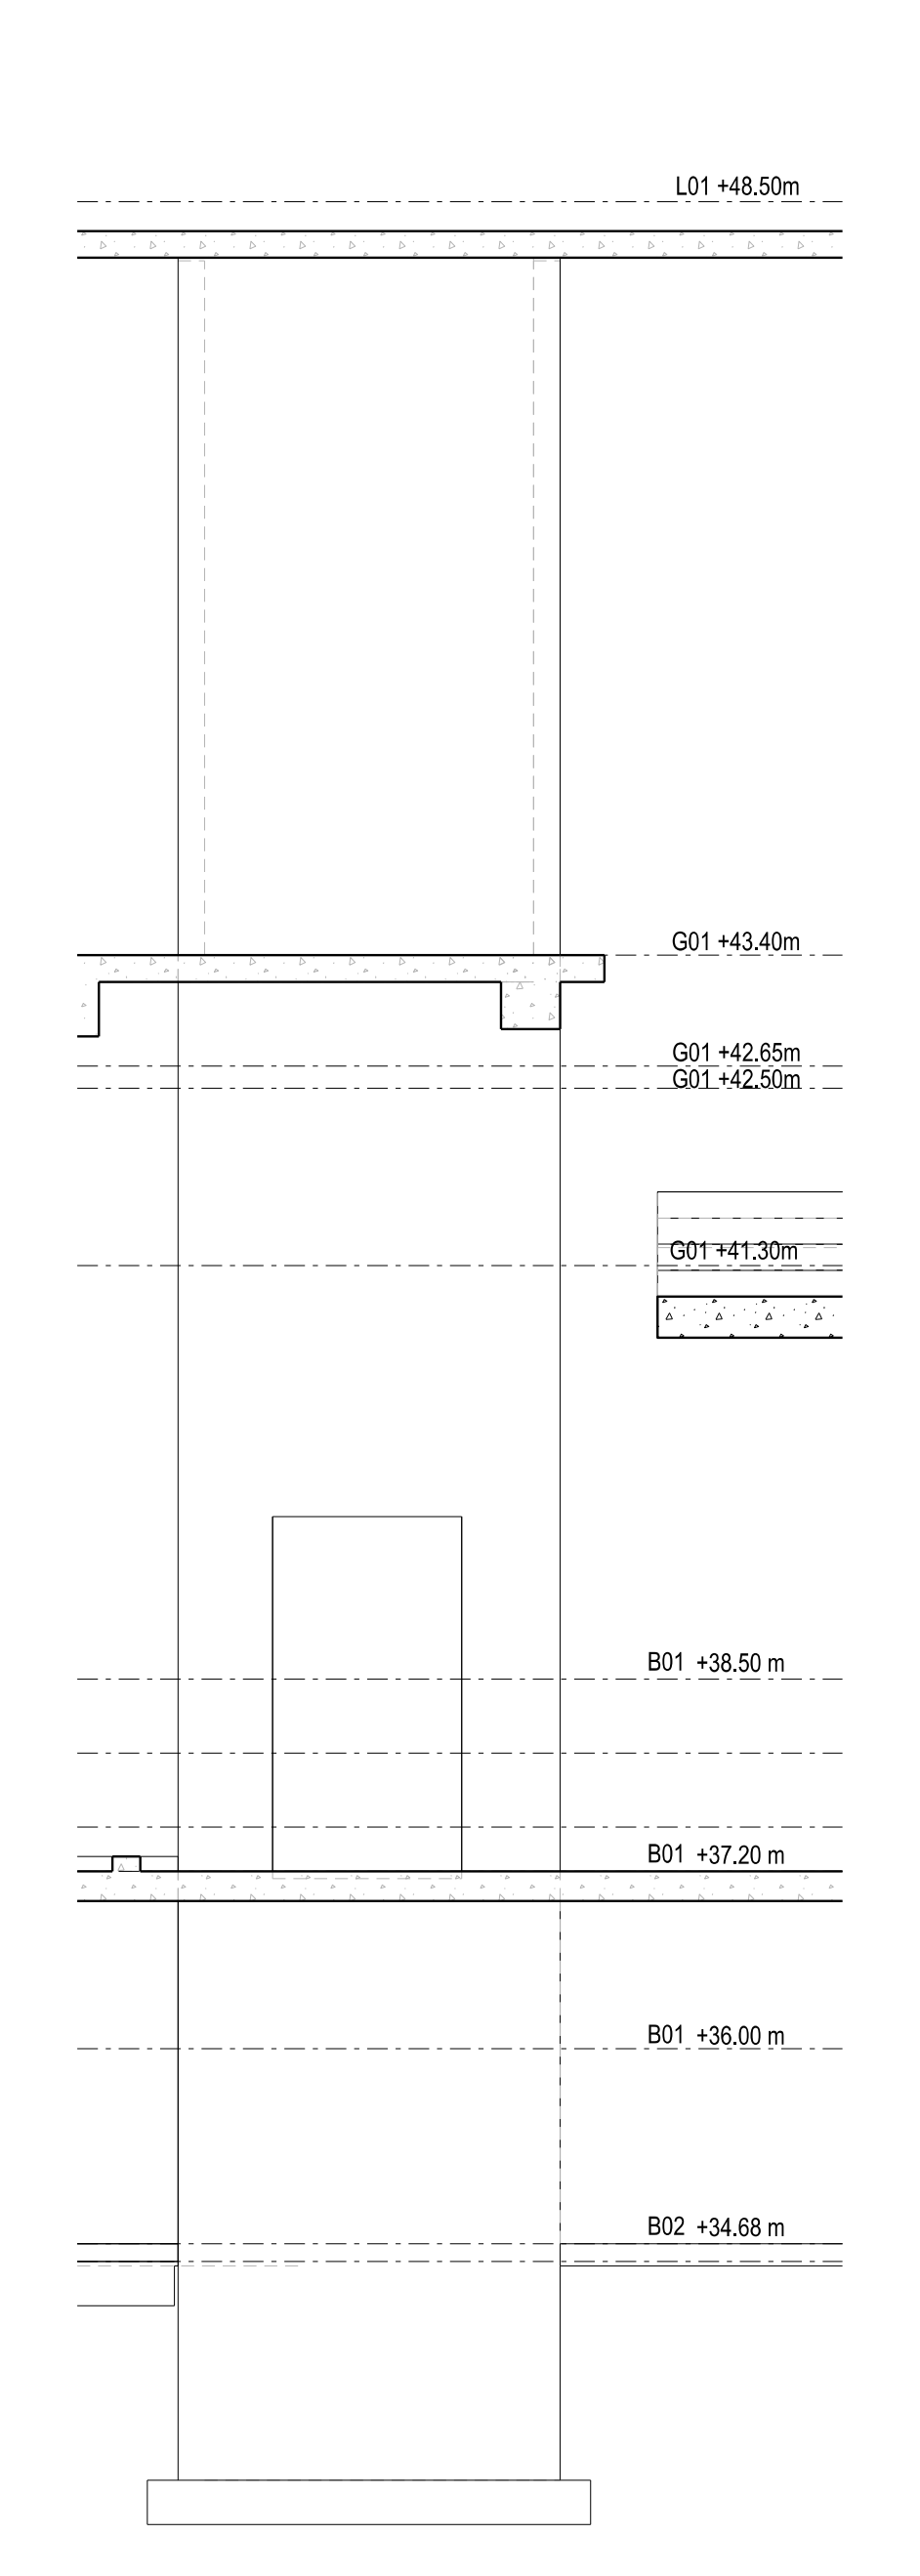

11 LIFT 5 CORE 6 ELEV. - W-12-01 SCALE 1:50

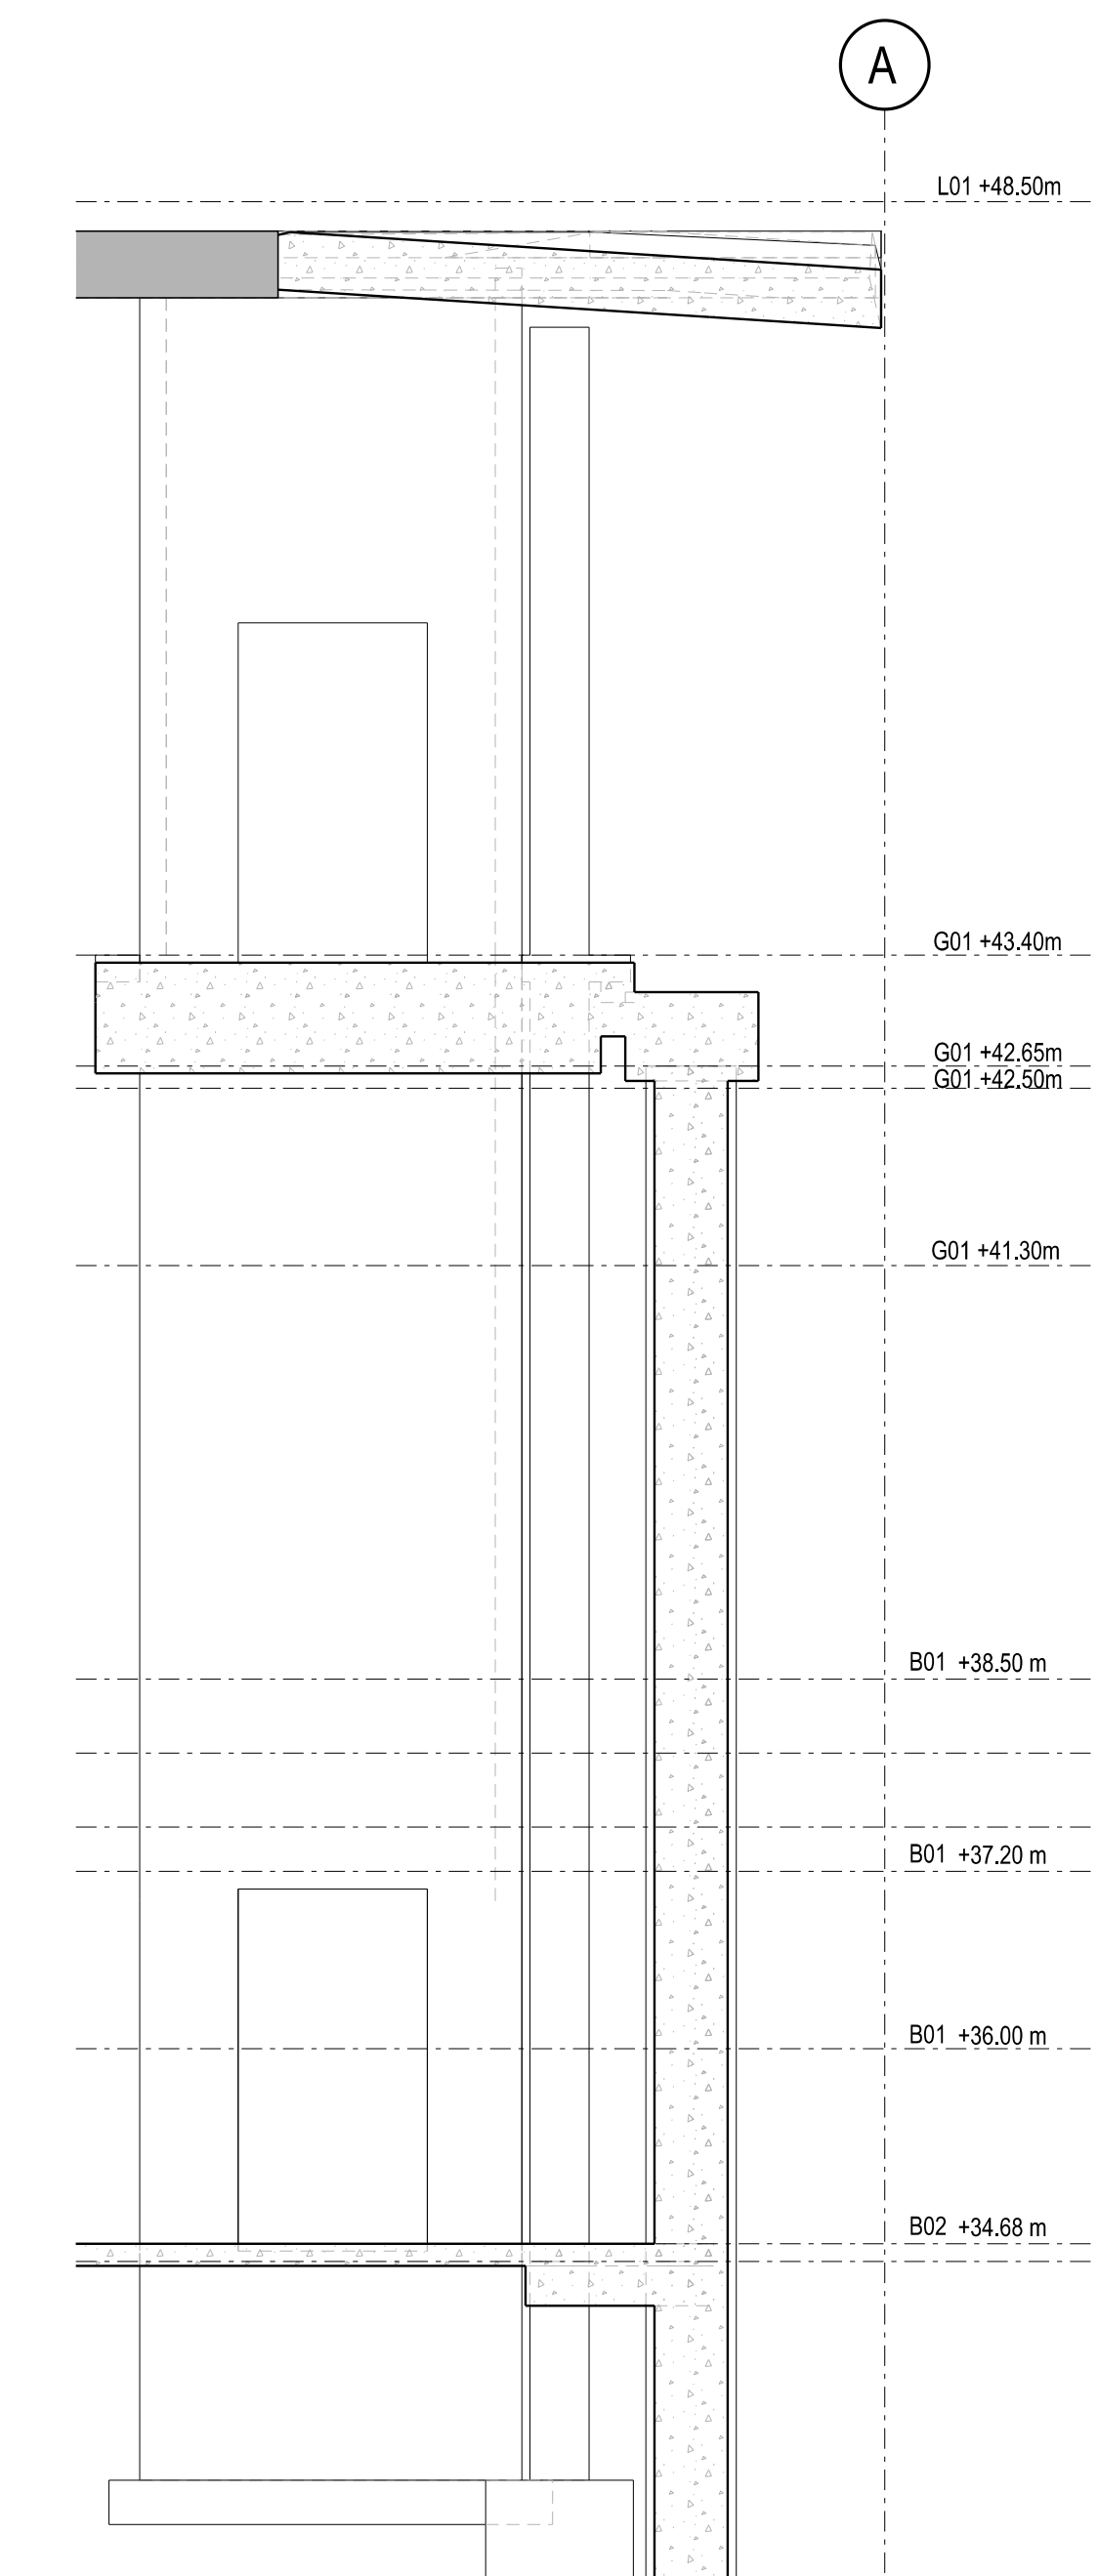

12 LIFT 5 CORE 6 ELEV. - E-12-01 SCALE 1:50

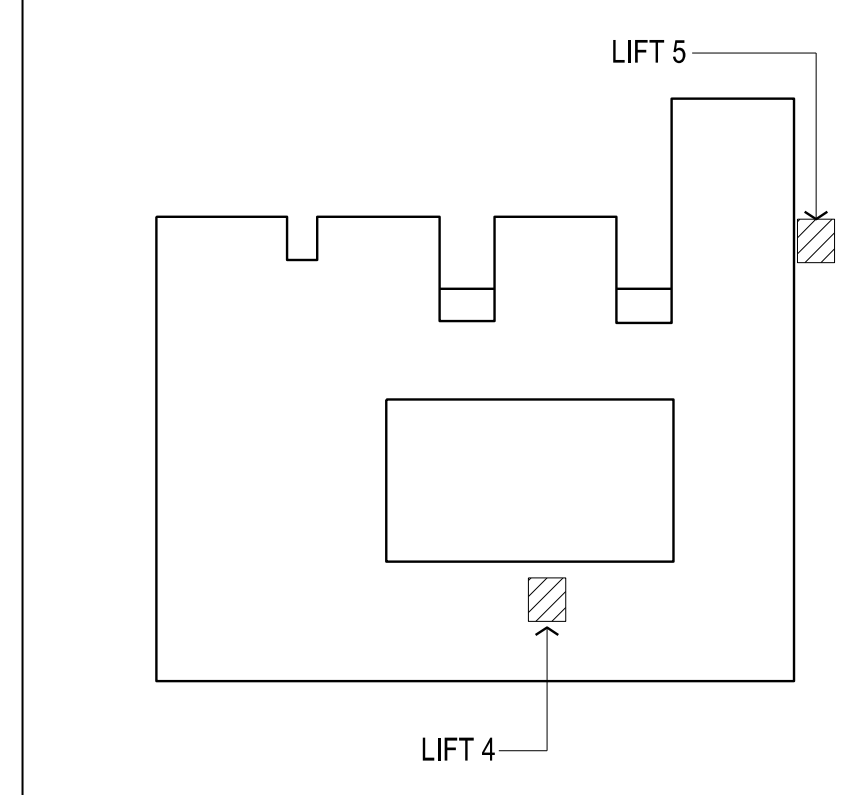

Rev	Issue	Revision Description	Amd	Date
A	SG	ISSUED FOR CONSTRUCTION		10.01.14
11	SG	GENERAL DRAWING UPDATE		31.05.13
10	SG	SETOUT DIMENSIONS CLARIFIED		18.04.13
09	SG	VALUE MANAGEMENT ISSUE		28.03.13
08	SG	100% CD - TENDER ISSUE		07.09.12
07	SG	90% CD ISSUE		10.09.12
06	SG	75% CD ISSUE		13.07.12
05	SG	50% CD ISSUE		01.06.12
04	SG	25% CD ISSUE		20.04.12
03	SG	FINAL DD ISSUE		24.02.12
02	SG	DD UPDATE		20.01.12
01	SG	PRELIMINARY DD		02.11.11



NADAAA
 NADAAA
 1520 Washington Street No.2 Boston Massachusetts 02118 USA
 Telephone +1 617 442 8232 Facsimile +1 688 442 1417 Email noda@nadaaa.com

John Wardle Architects
 25 Rokeby Street, Collingwood, Victoria 3066 Australia
 Tel: +61 3 8662 0400 www.johnwardlearchitects.com
 © 2012 John Wardle Architects ABN 83 006 814 268

Client **University of Melbourne Parkville Campus**

Project **Faculty of Architecture Building and Planning**

Title **CONCRETE CORE CORE 5 & 6- PLANS, SECT'S, ELEV'S**

Project No.	0913	Scale	1:50 @ A0 1:100 @ A2
Drawing No.	AR4315	Revision	A

Date: Oct 2011 Drawn - Co-Ord - Check -

FILENAME - SFILES

FOR CONSTRUCTION