



THIS DRAWING IS AN UNCONTROLLED COPY UNLESS STAMPED OTHERWISE  
 CONTRACTORS SHALL VERIFY JOB DIMENSIONS BEFORE ANY JOB COMMENCES. ALL SHOP DRAWINGS SHALL BE SUBMITTED TO THE SUPERINTENDENT AND MANUFACTURE SHALL NOT COMMENCE PRIOR TO THE RETURN OF EXAMINED SHOP DRAWINGS ISSUED BY THE CONSULTANT. FIGURED DIMENSIONS SHALL TAKE PRECEDENCE OVER SCALED. THIS DRAWING SHOULD BE READ IN CONJUNCTION WITH ALL RELEVANT CONTRACT SPECIFICATIONS AND DRAWING COPYRIGHT OF THIS DRAWING IS VESTED IN NADAAA


General Notes

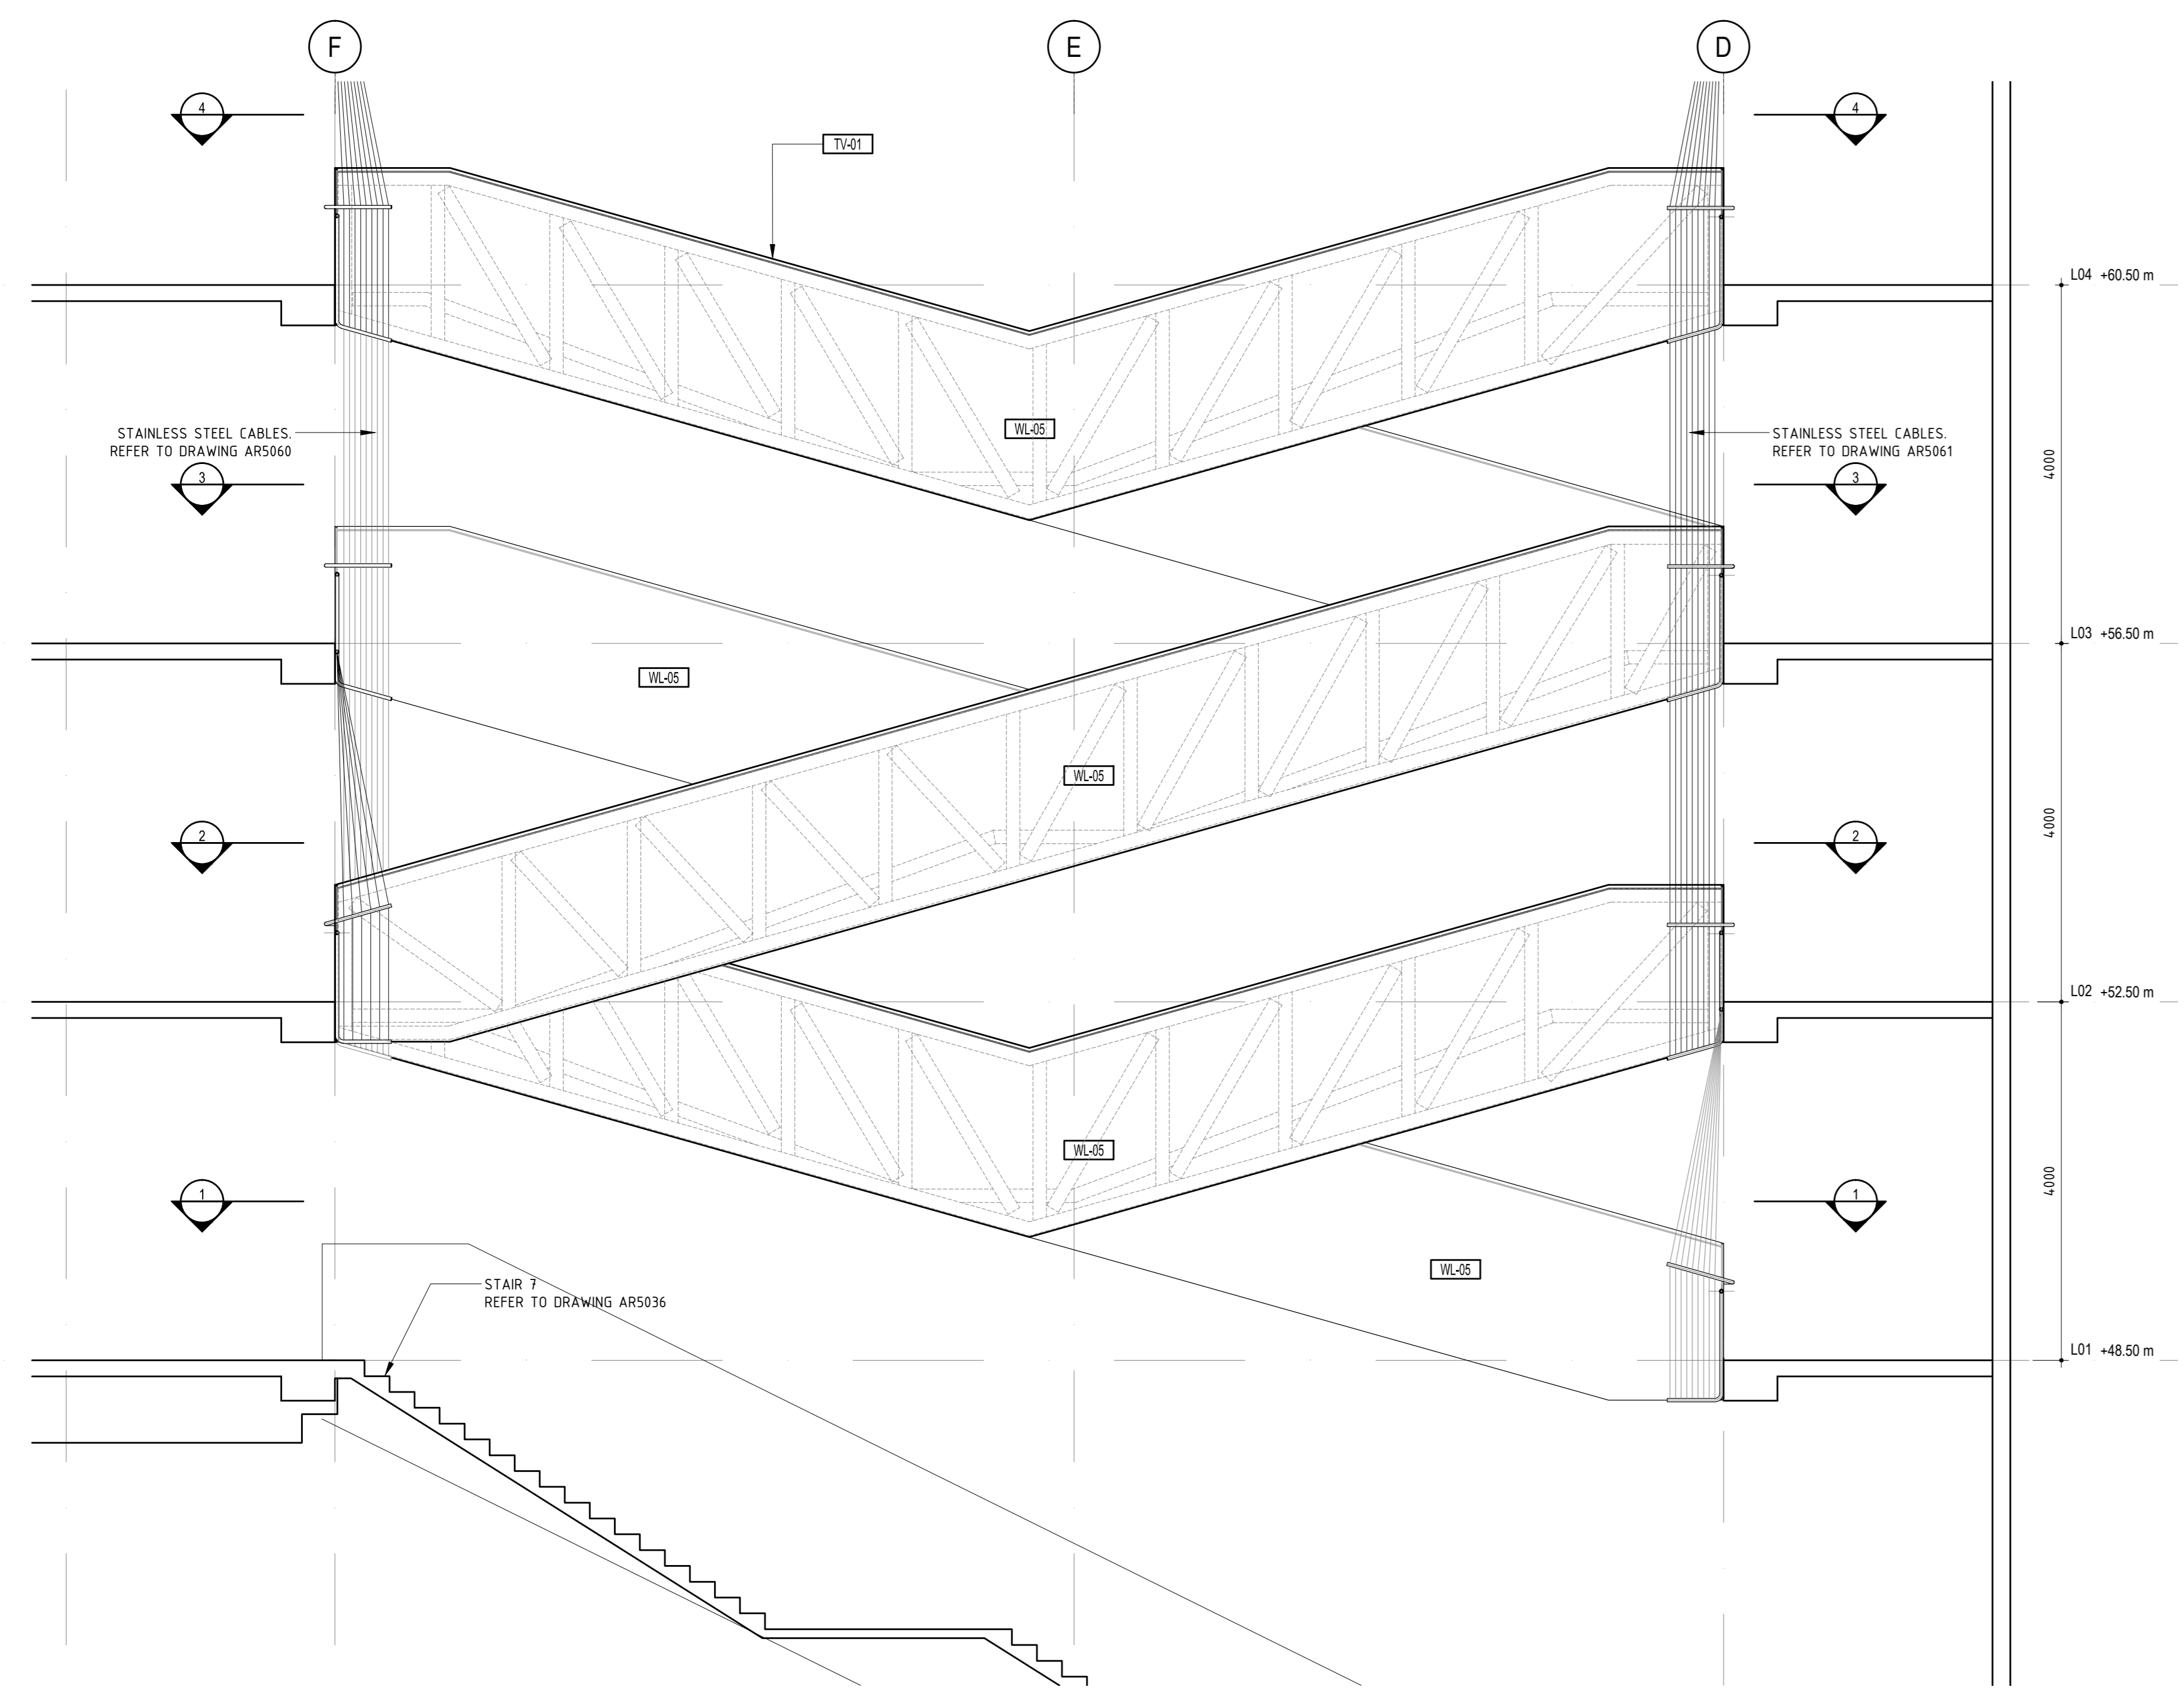


06 000H STAIR EAST ELEVATION  
SCALE: 1:50

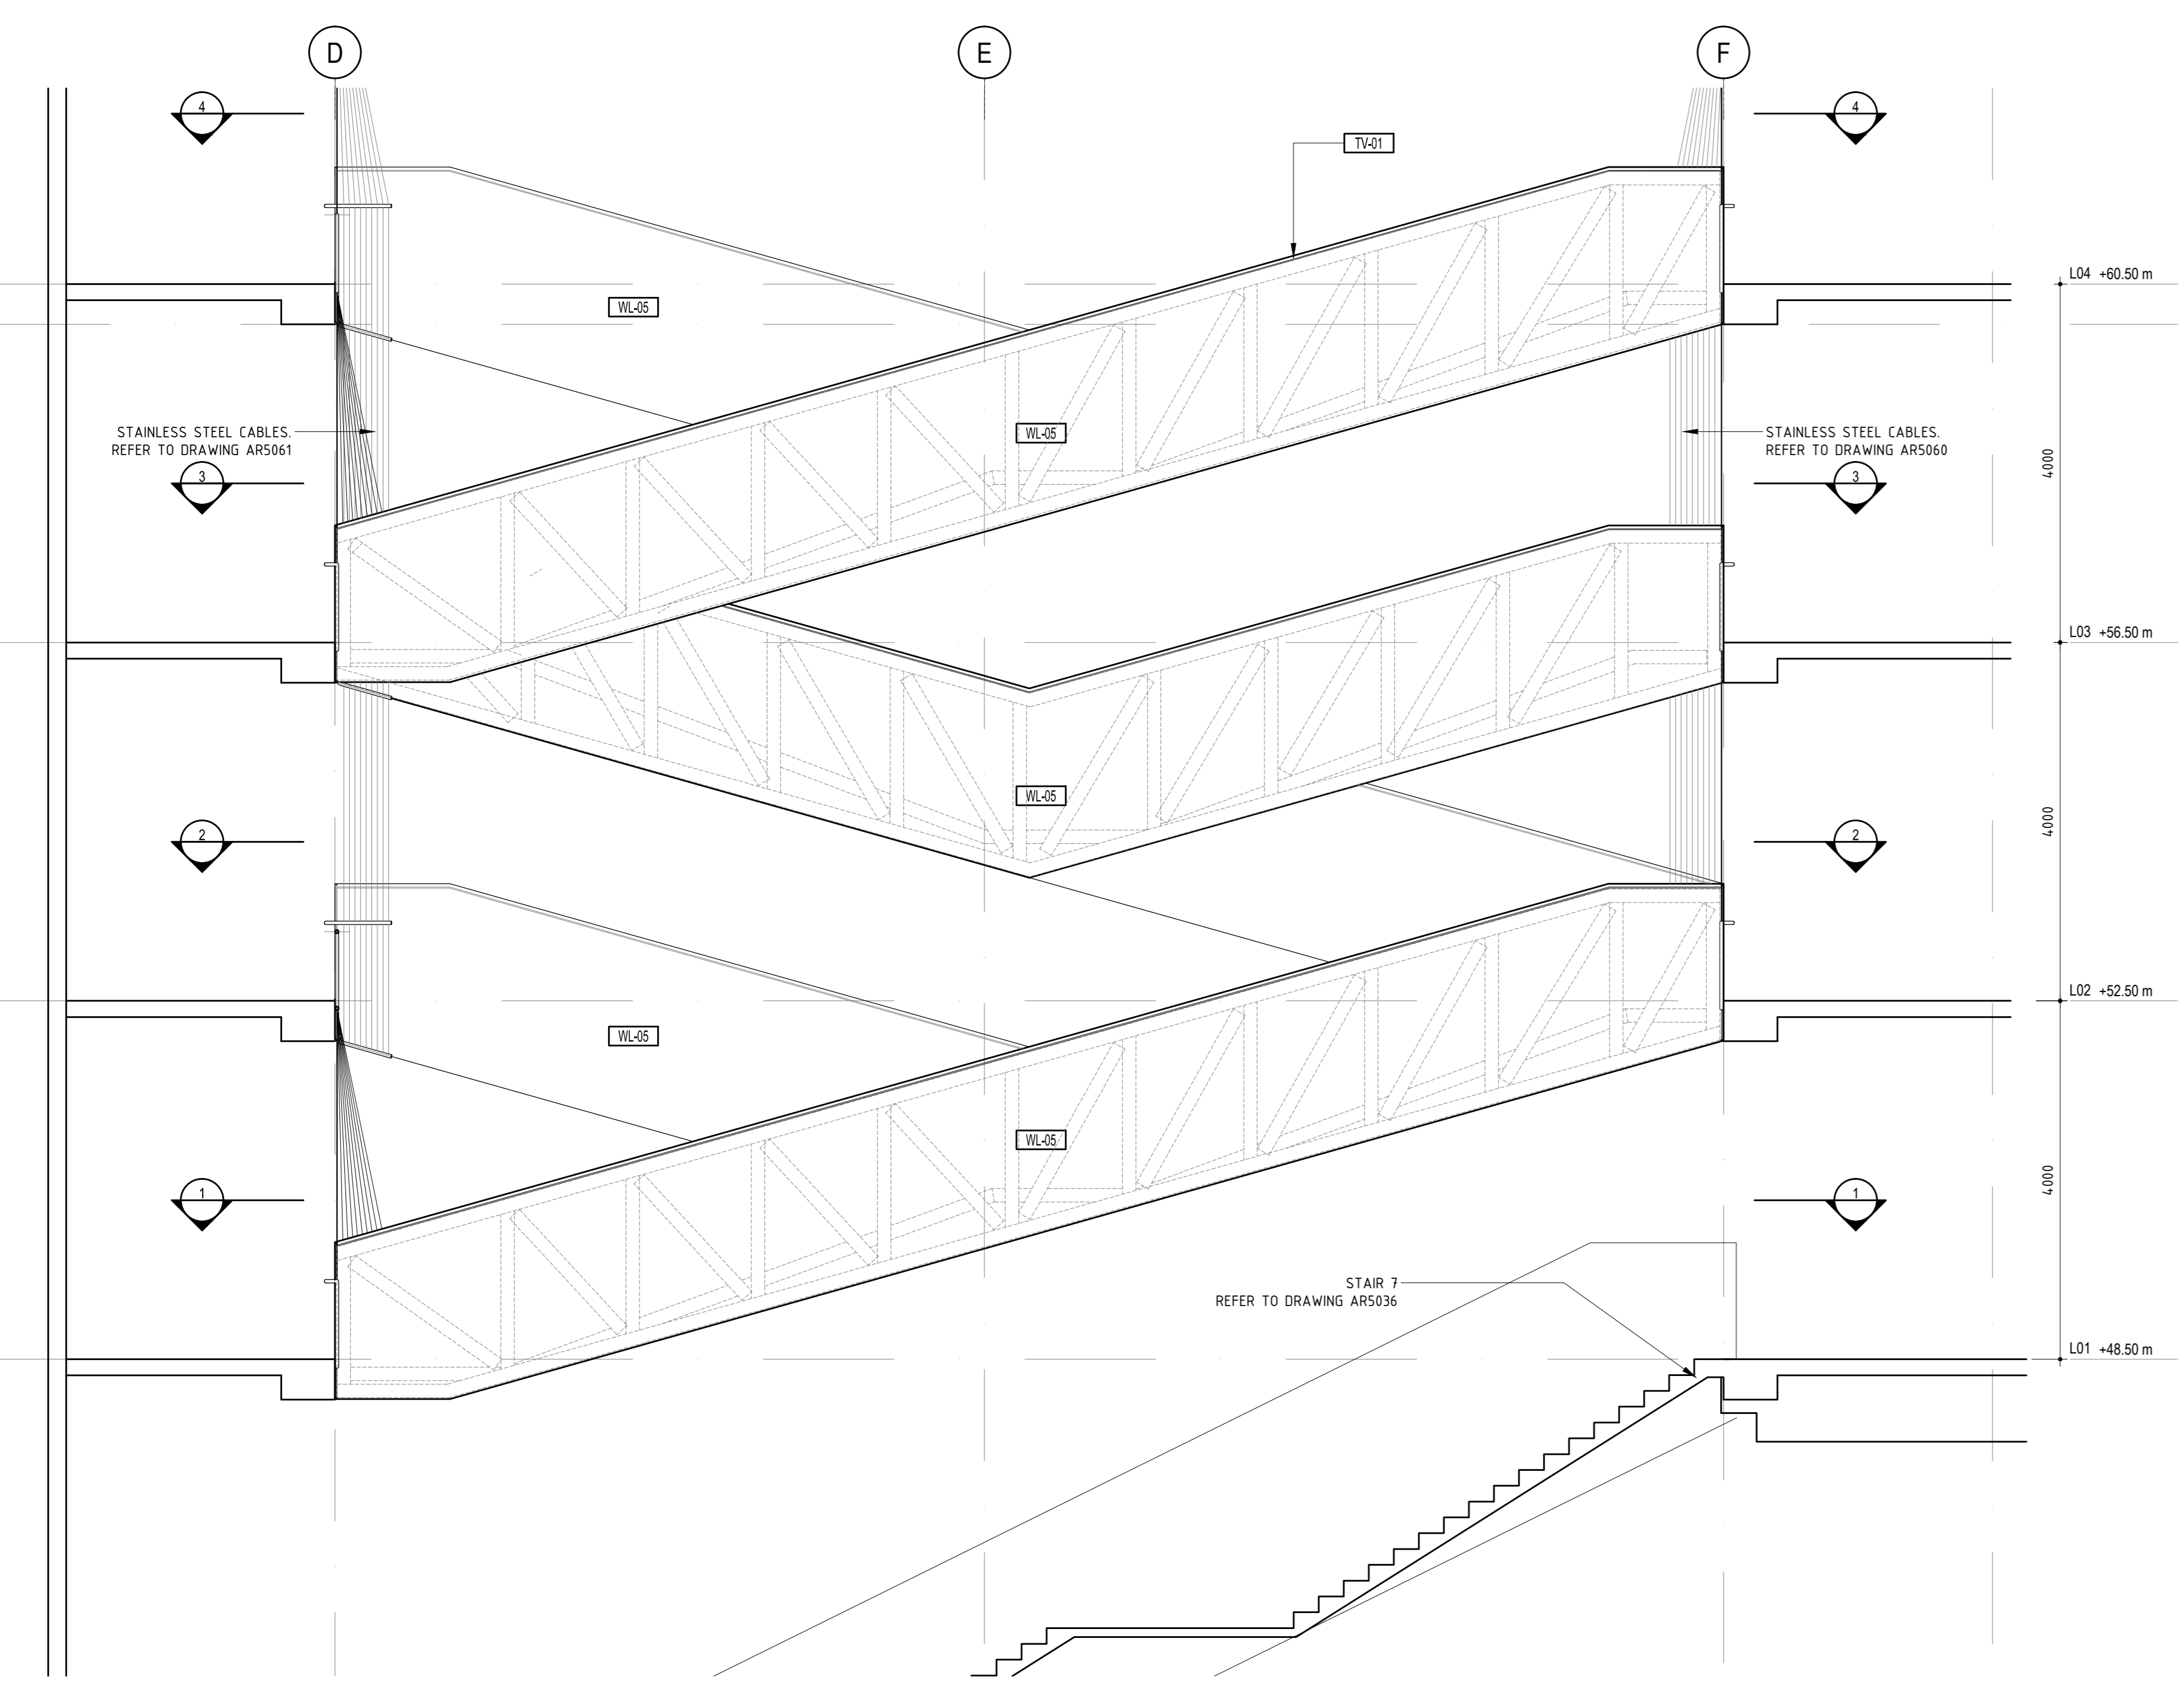


05 000H STAIR WEST ELEVATION  
SCALE: 1:50

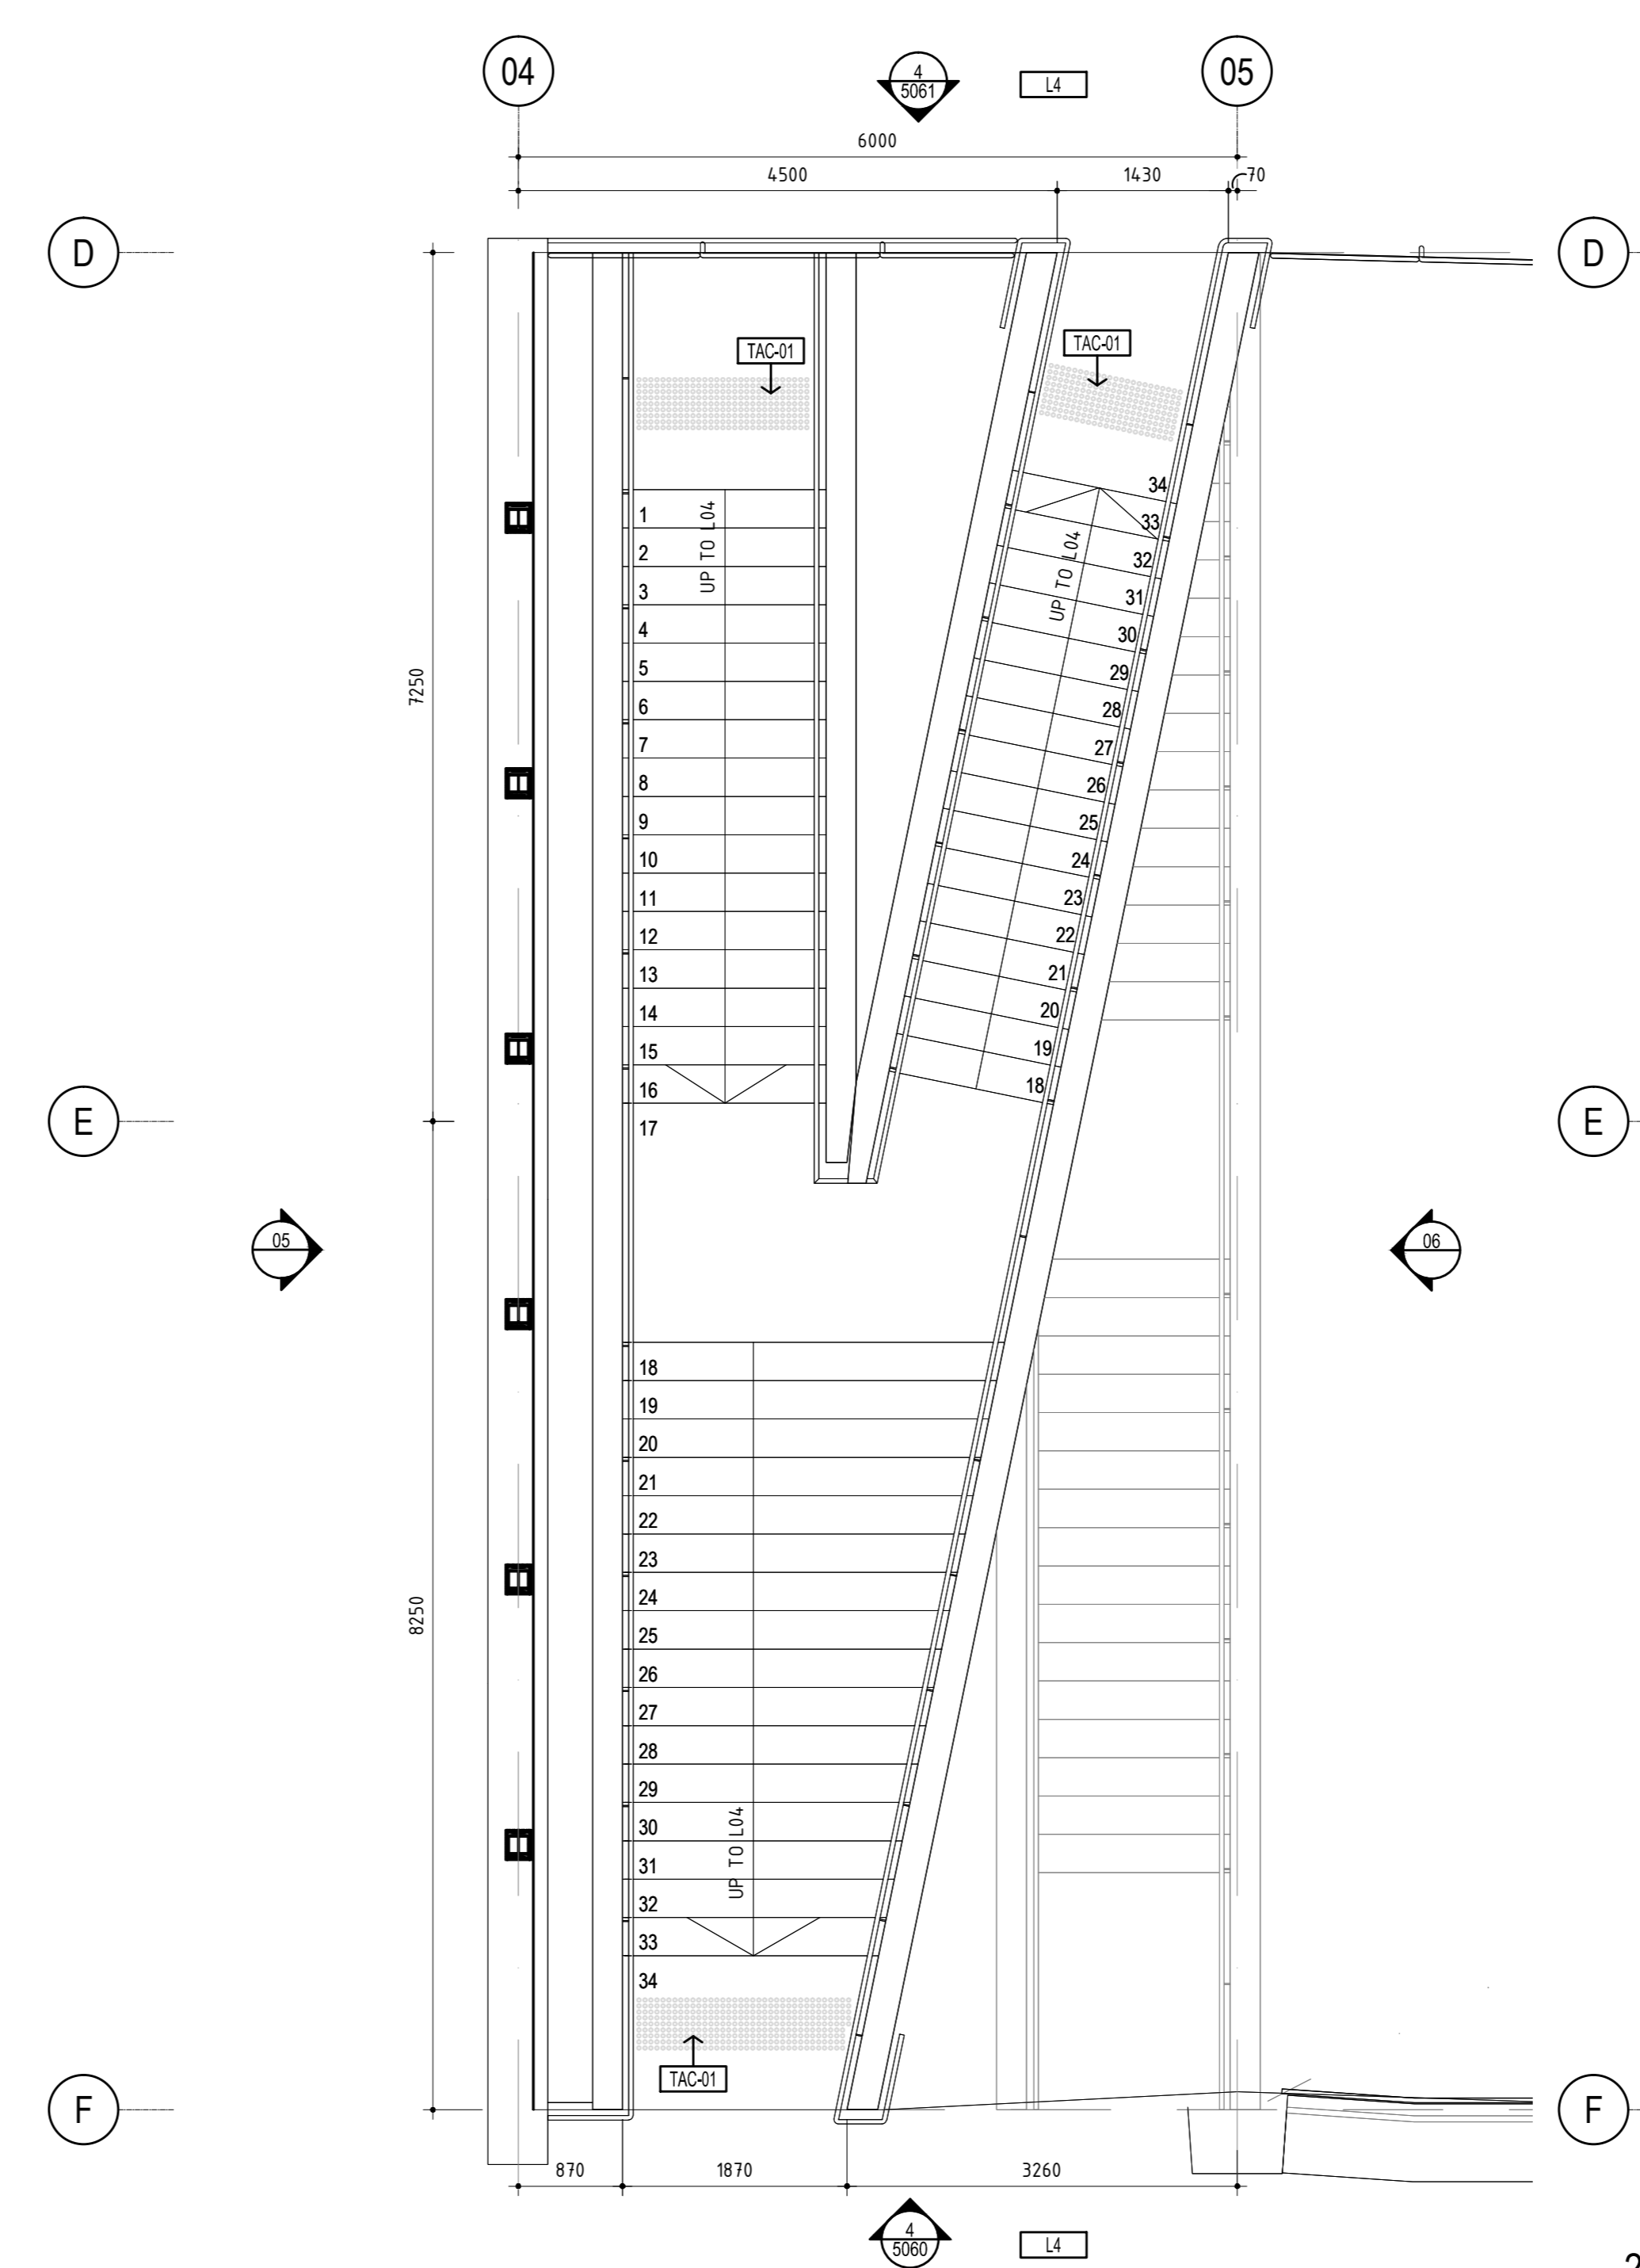


04 PARTIAL LEVEL 4 PLAN @ 000H STAIR  
SCALE: 1:50

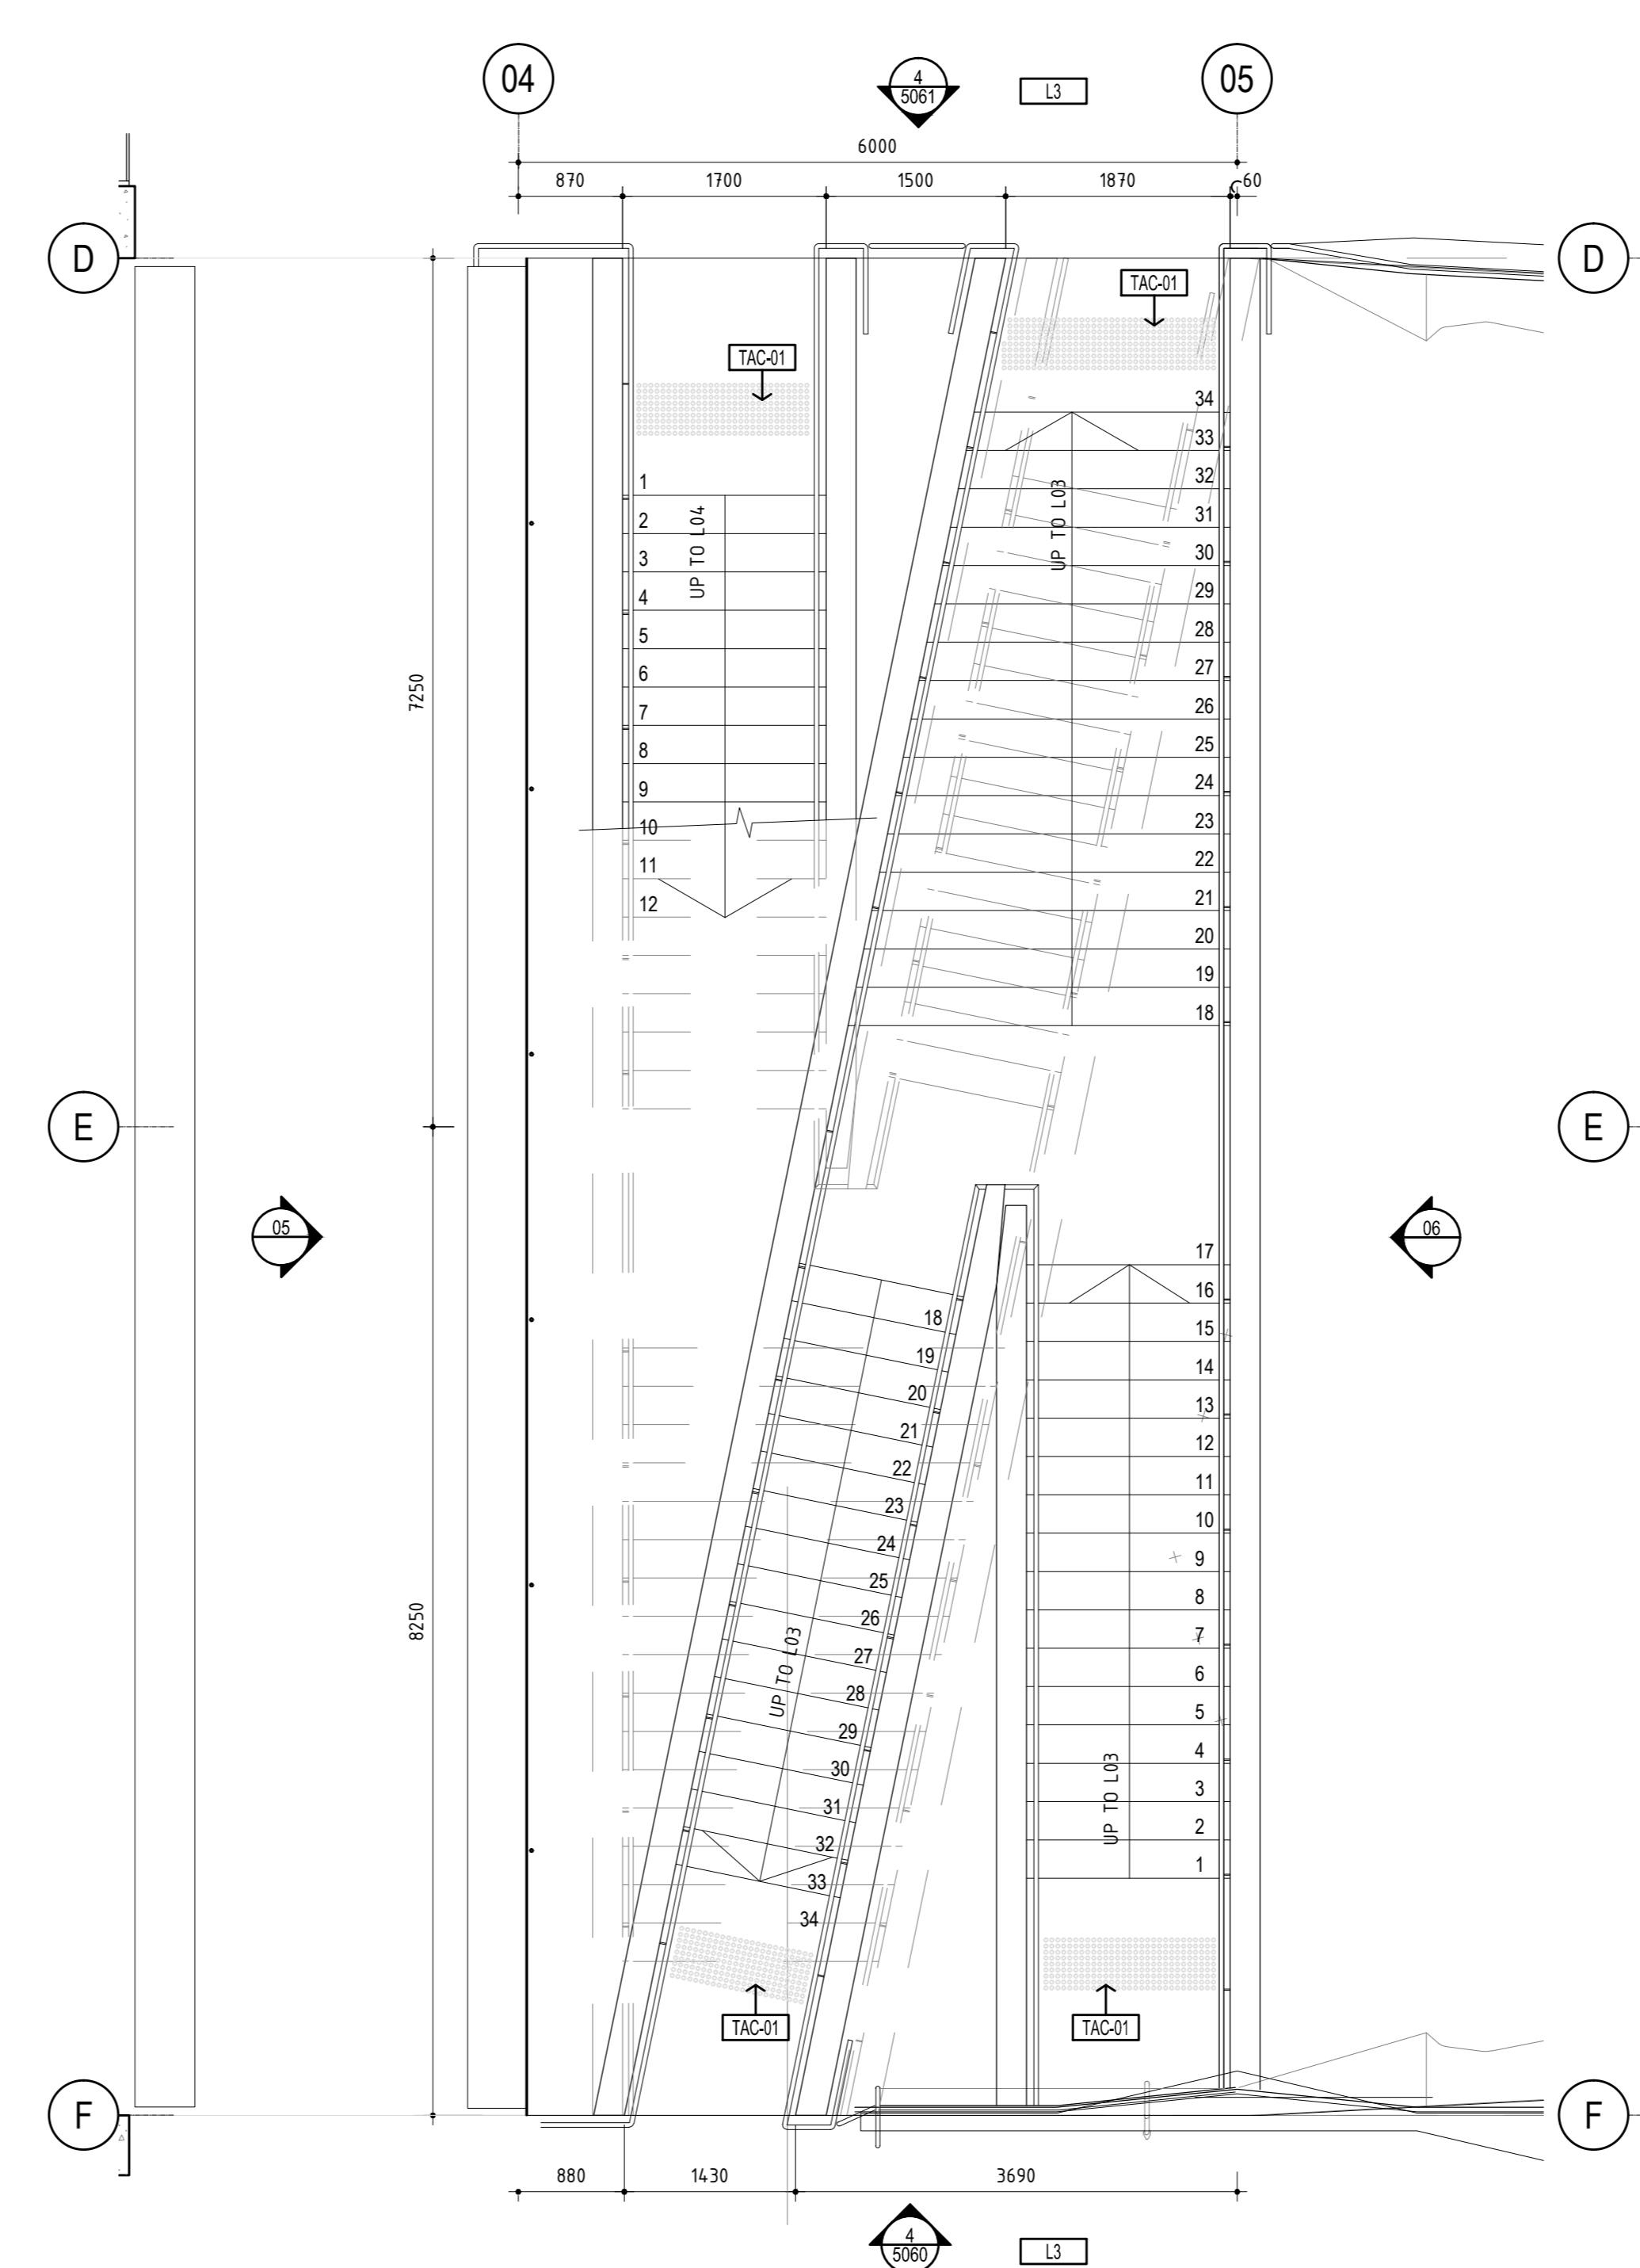

03 PARTIAL LEVEL 3 PLAN @ 000H STAIR  
SCALE: 1:50

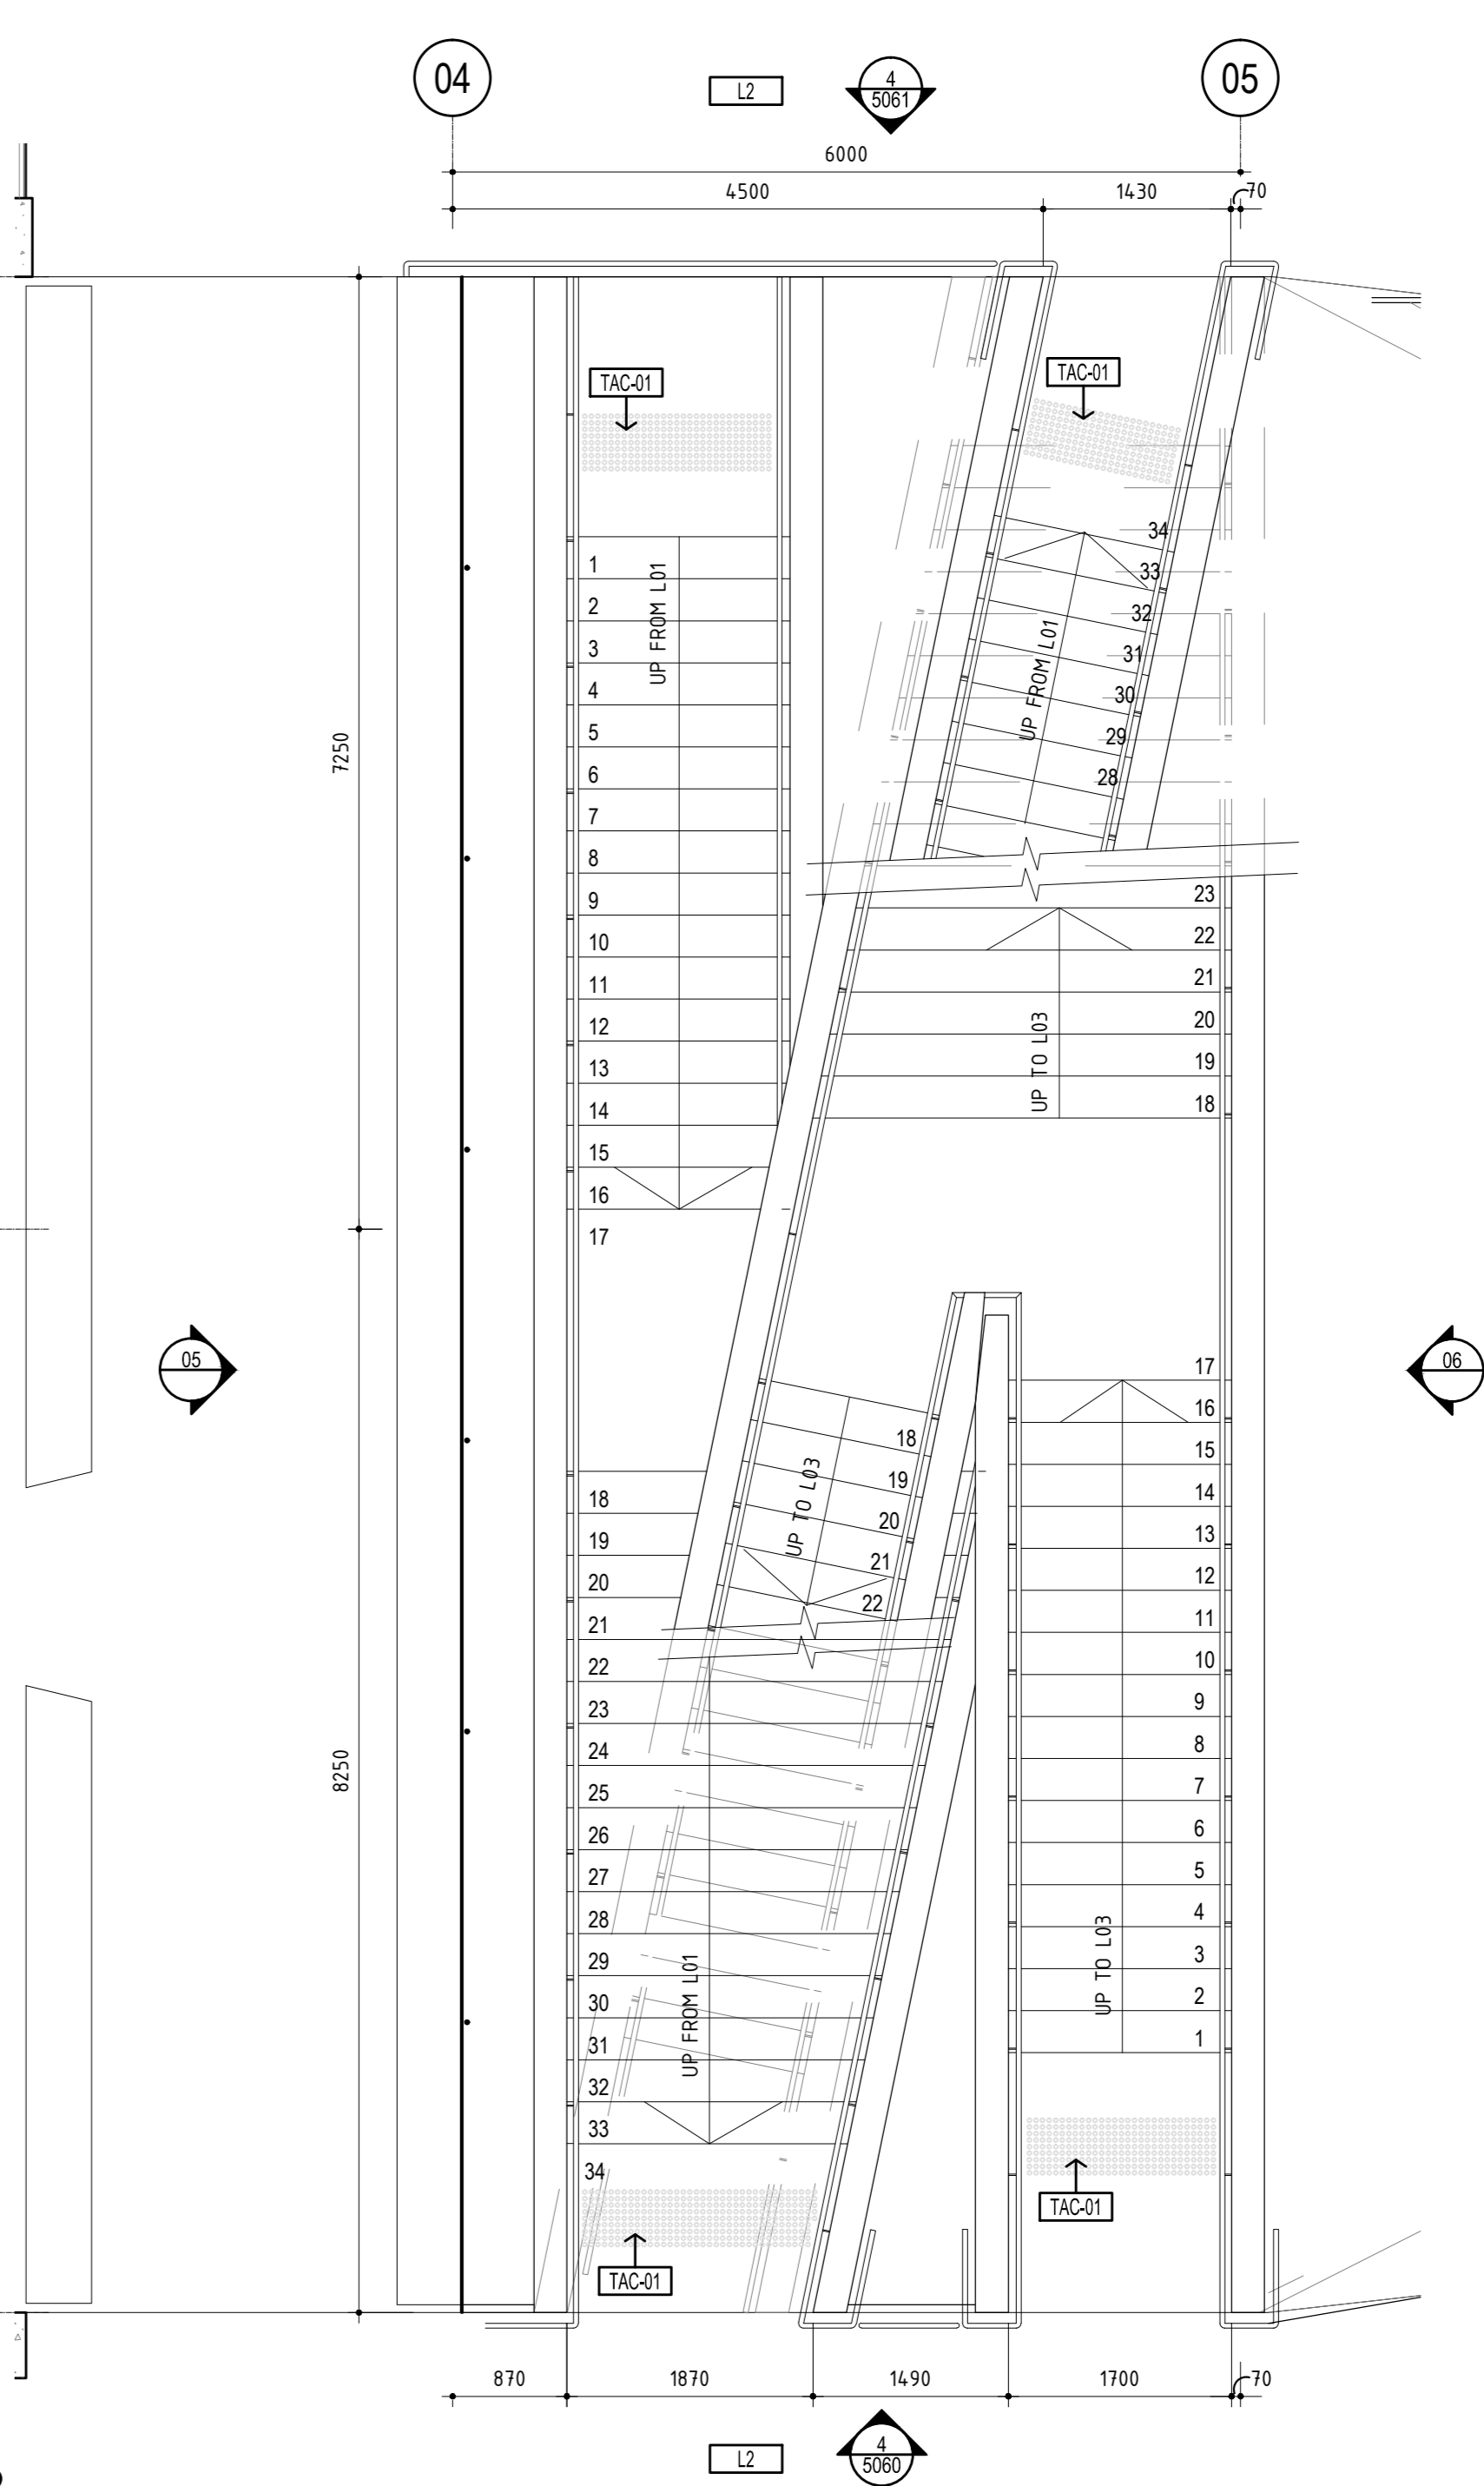


02 PARTIAL LEVEL 2 PLAN @ 000H STAIR  
SCALE: 1:50

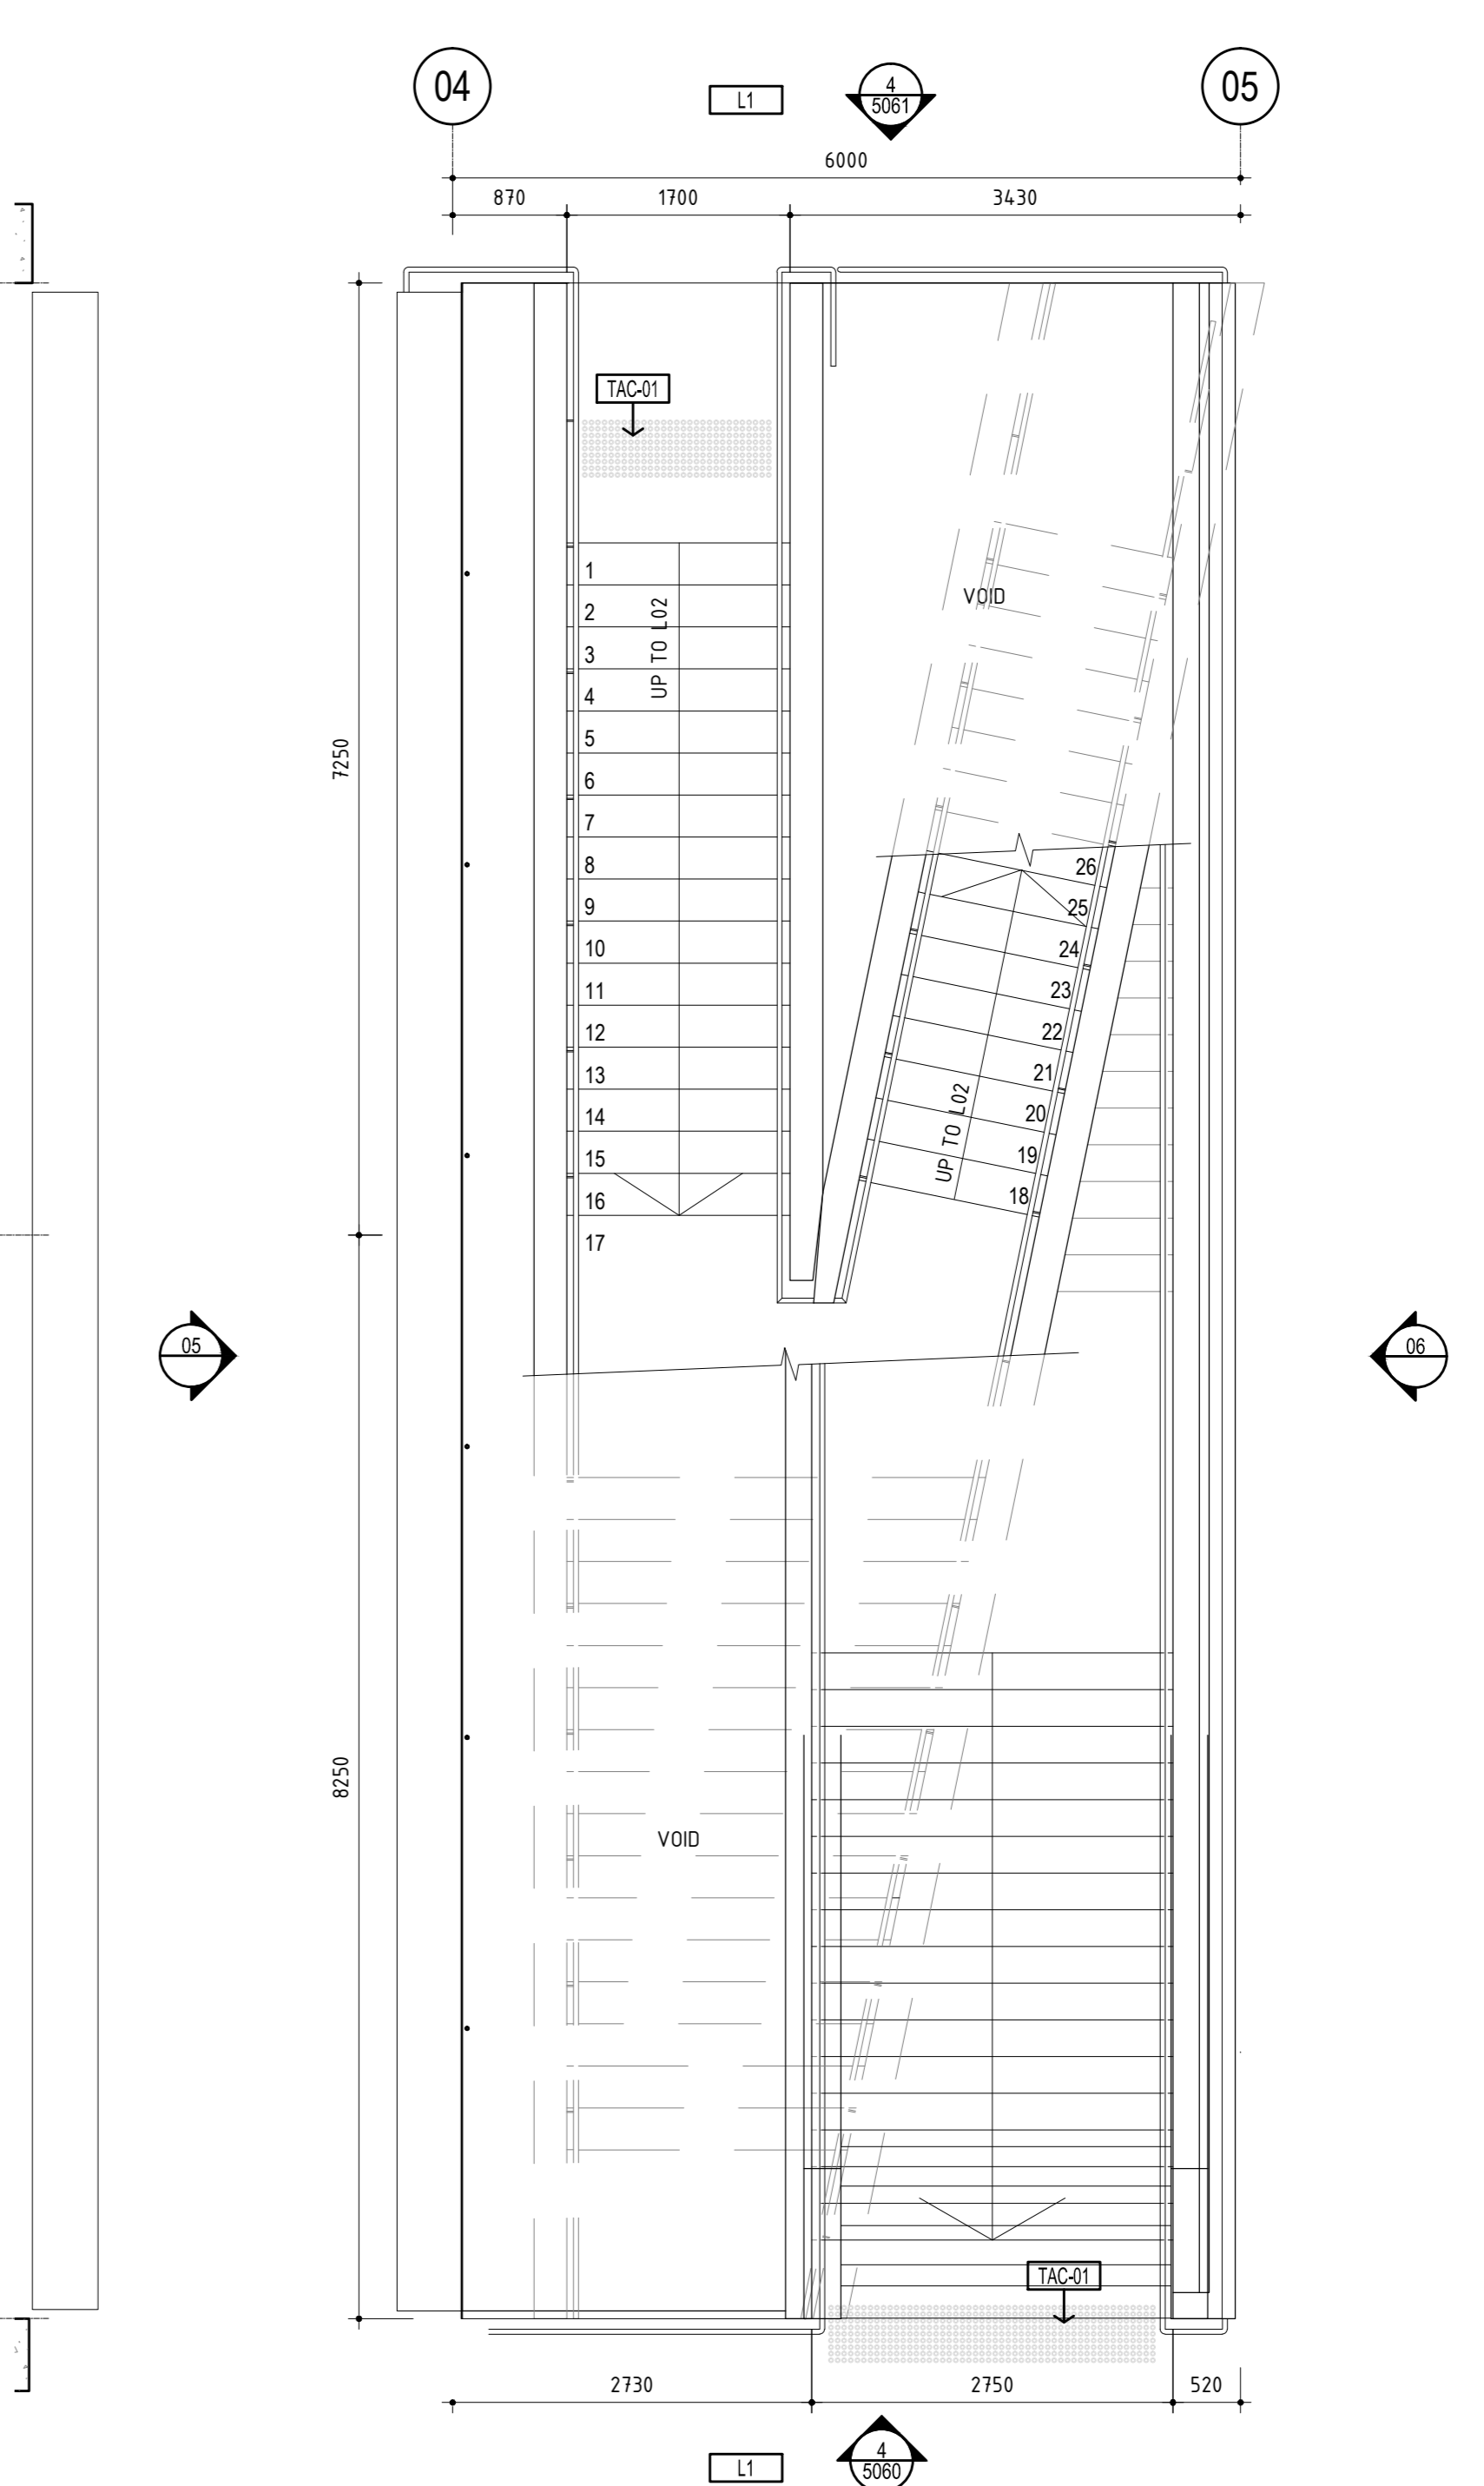

01 PARTIAL LEVEL 1 PLAN @ 000H STAIR  
SCALE: 1:50

Rev	Issue	Revision Description	And	Date
A	SG	CONSTRUCTION ISSUE	-	12.24.13
06	JC	100% CD - TENDER ISSUE	-	07.09.12
05	JC	90% CD ISSUE	-	10.08.12
04	JC	75% CD ISSUE	-	13.07.12
03	JC	50% CD ISSUE	-	01.06.12
02	JC	FINAL 3D ISSUE	-	24.02.12
01	JC	DESIGN DEVELOPMENT ISSUE	-	20.01.12

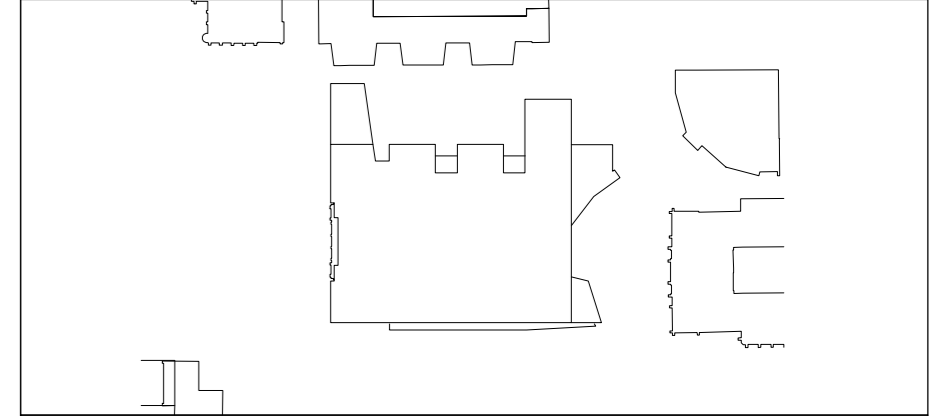

**NADAAA**  
 NADAAA  
 1500 Washington  
 Street No 2  
 Boston  
 Massachusetts  
 02118 USA  
 Telephone  
 +1 617 442 6232  
 Facsimile  
 +1 608 442 1417  
 Email  
 nad@nadaaa.com

**John Wardle Architects**  
 © 2011 John Wardle Architects  
 Level 10, 180 Russell Street, Melbourne Victoria 3000 Australia  
 Tel +613 9654 8700 www.johnwardlearchitects.com

Client **University of Melbourne  
Parkville Campus**  
 Project **Faculty of Architecture  
Building and Planning**  
 Title **000H STAIR  
PLANS AND ELEVATION**

Project No.	<b>0913</b>	Scale	1:50
Drawing No.	<b>AR5003</b>	Revision	<b>A</b>
Date	DEC 2013	Dwn	-
Co-Ord	-	Check	-

FOR CONSTRUCTION