



THIS DRAWING IS AN UNCONTROLLED COPY UNLESS STAMPED OTHERWISE

CONTRACTORS SHALL VERIFY JOB DIMENSIONS BEFORE ANY JOB COMMENCES. ALL SHOP DRAWINGS SHALL BE SUBMITTED TO THE SUPERINTENDENT AND MANUFACTURE SHALL NOT COMMENCE PRIOR TO THE RETURN OF EXAMINED SHOP DRAWINGS ISSUED BY THE CONSULTANT. FIGURED DIMENSIONS SHALL TAKE PRECEDENCE OVER SCALED. THIS DRAWING SHOULD BE READ IN CONJUNCTION WITH ALL RELEVANT CONTRACT SPECIFICATIONS AND DRAWINGS COPYRIGHT OF THIS DRAWING IS VESTED IN WARDLE

General Notes

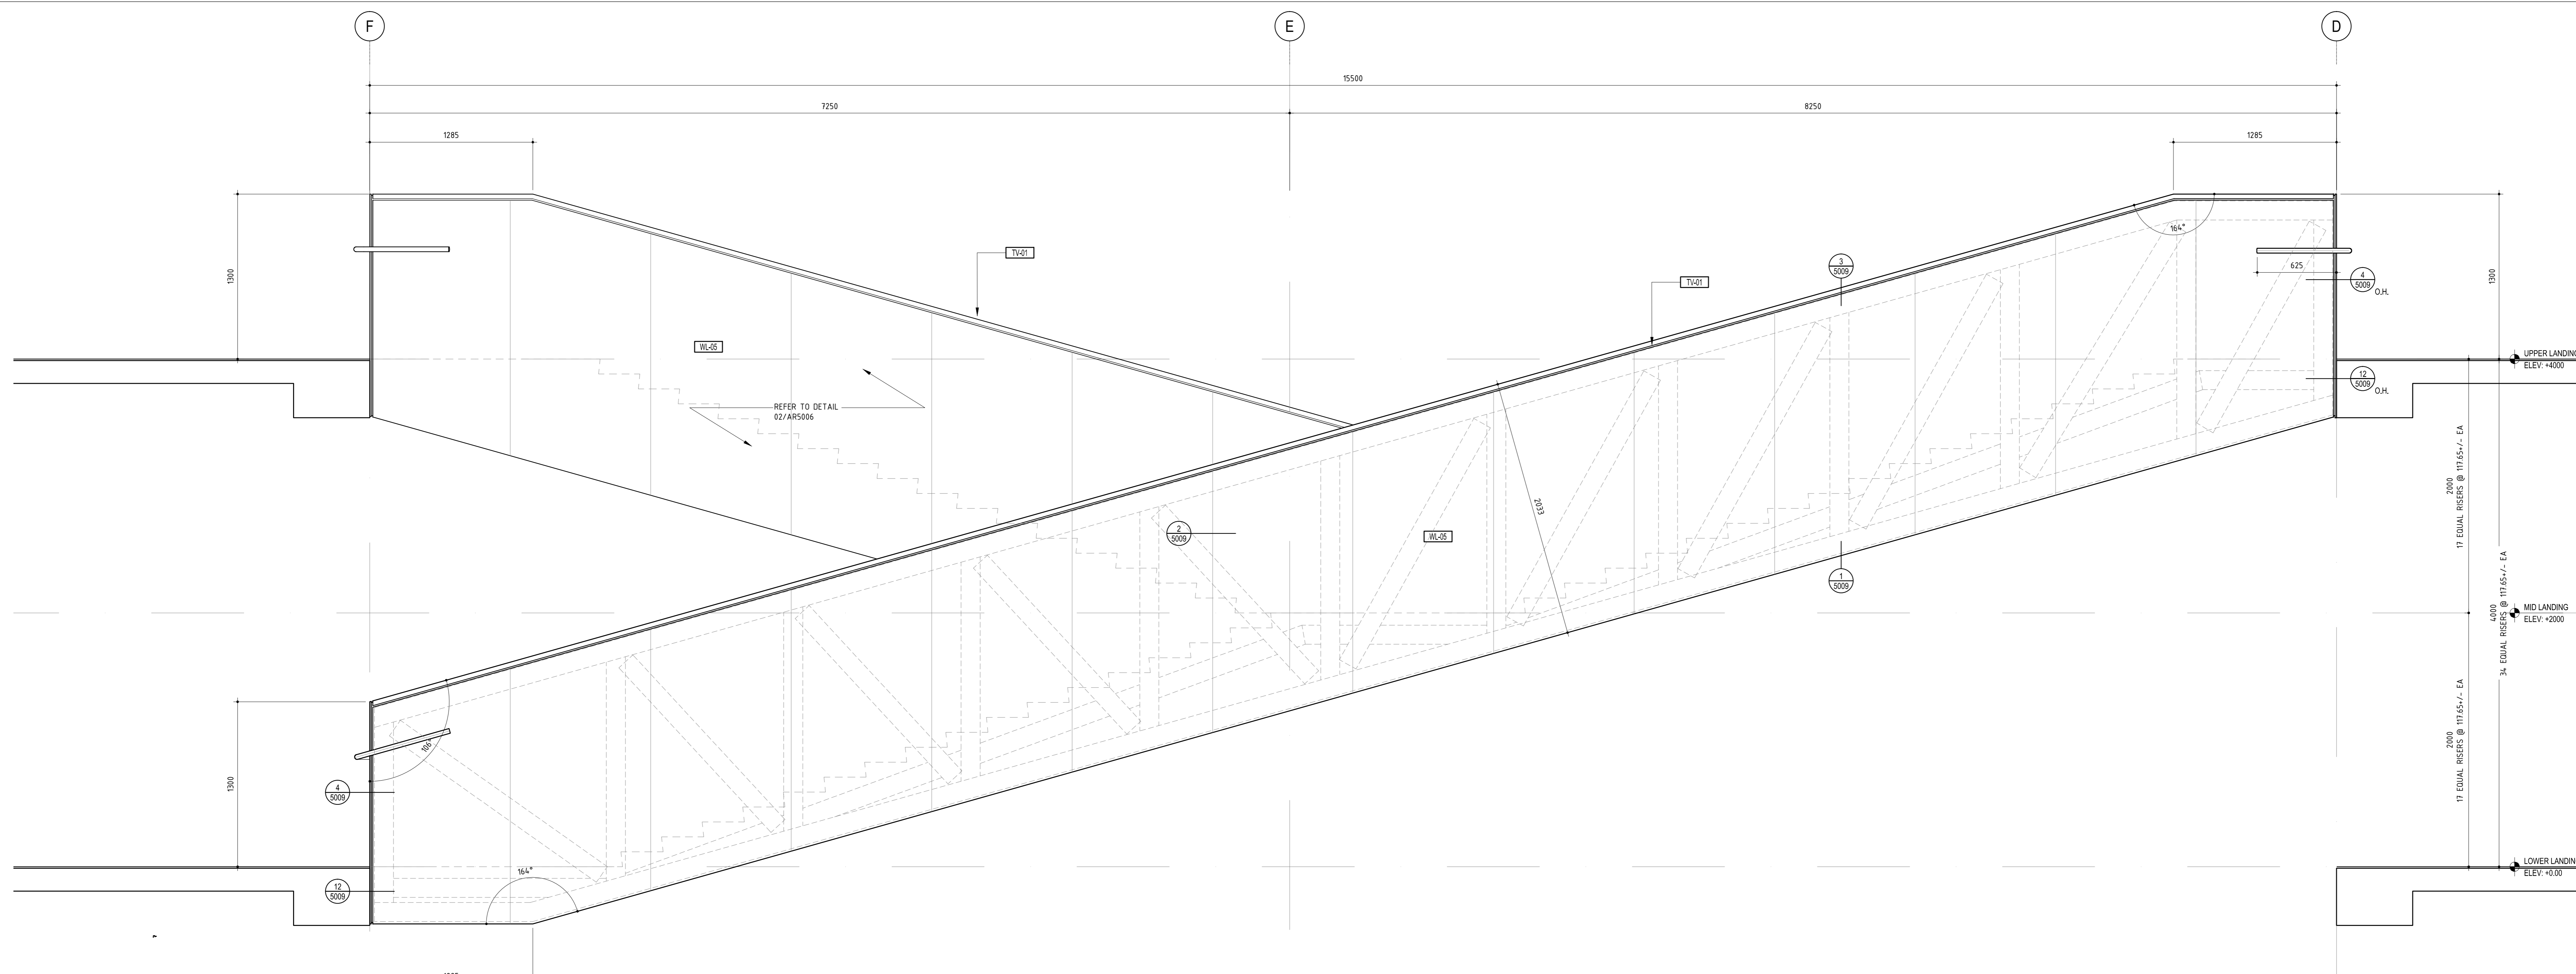


02 ENLARGED 000H STAIR WEST ELEVATION
SCALE 1:20

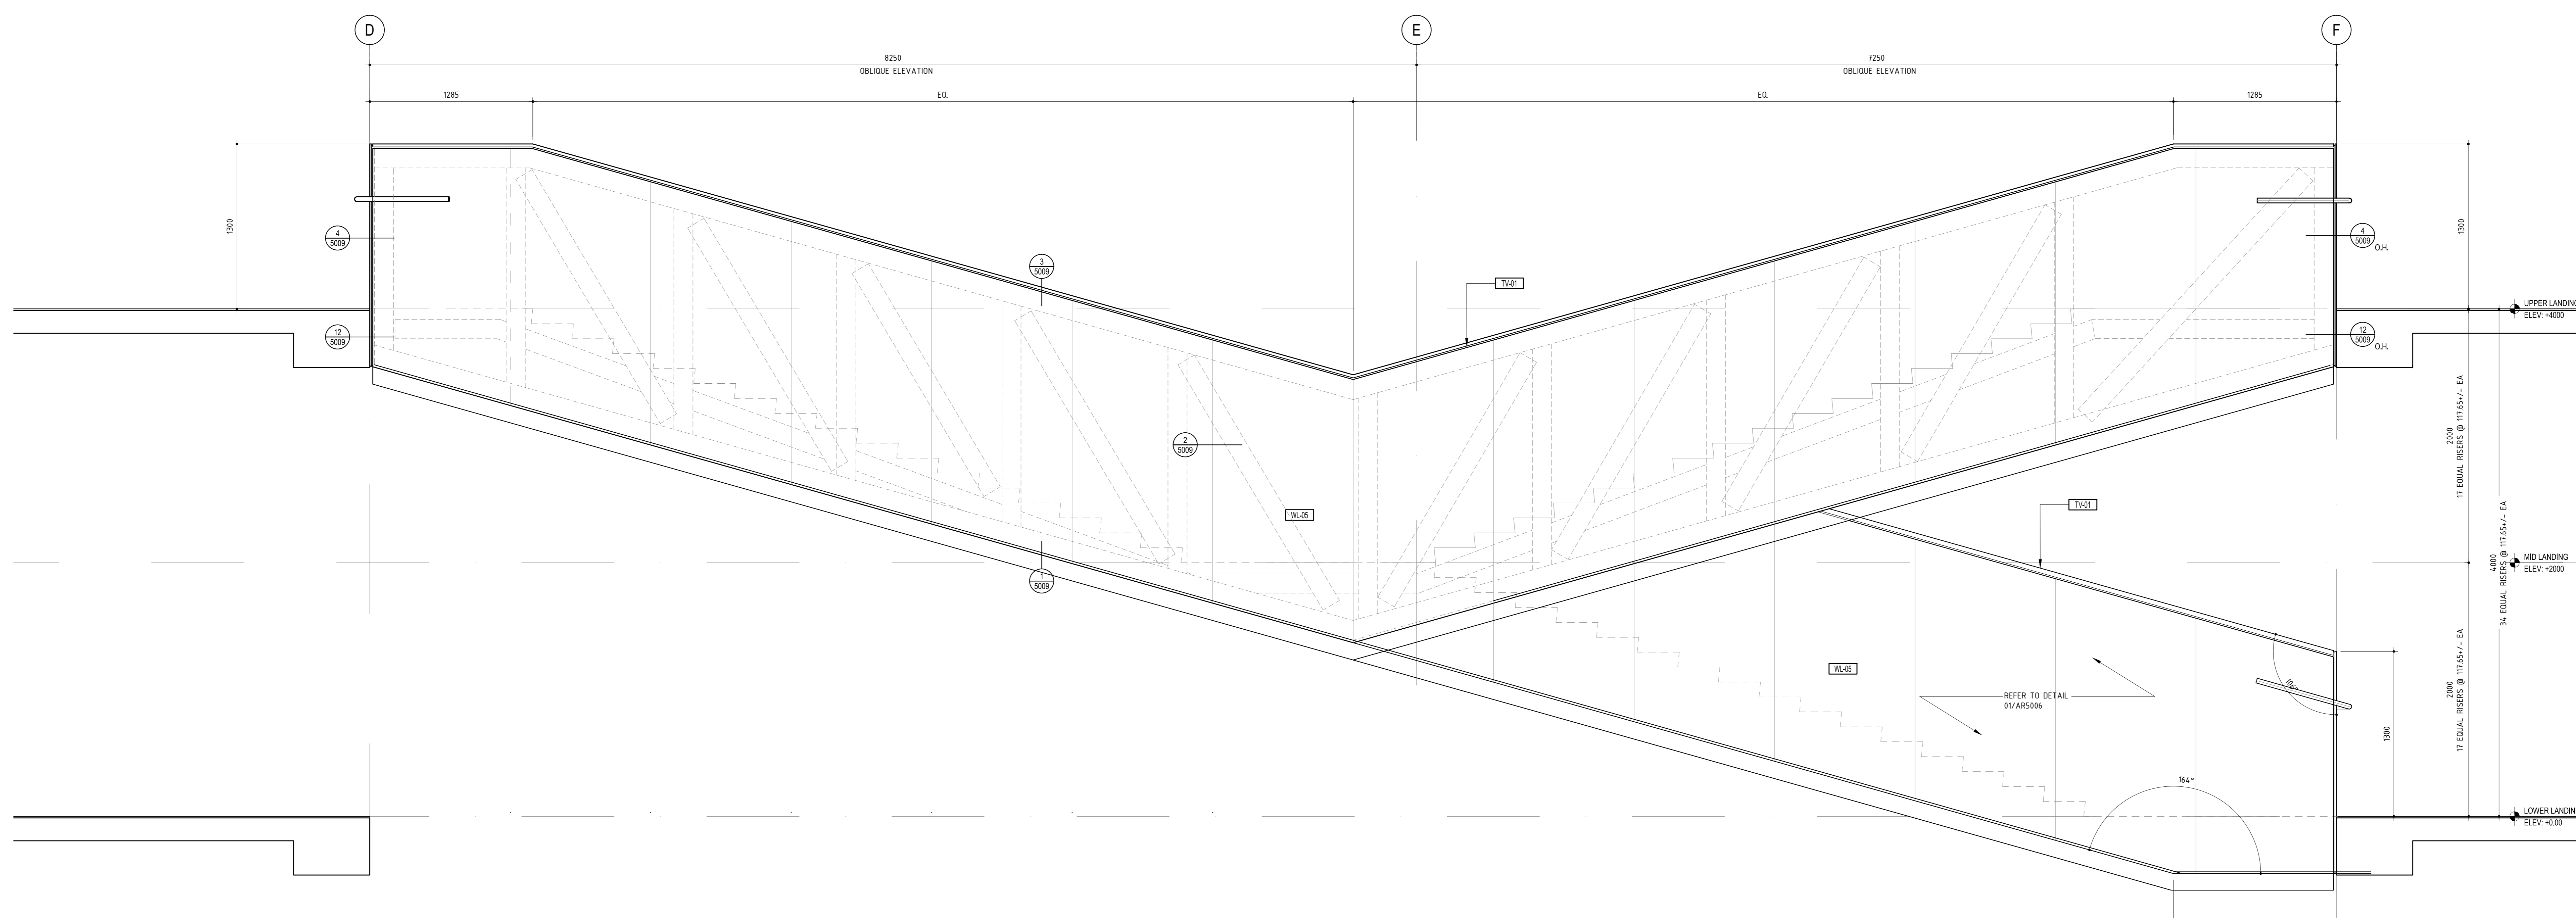

01 ENLARGED 000H STAIR EAST ELEVATION
SCALE 1:20

Rev	Issue	Revision Description	And	Date
A	SG	CONSTRUCTION ISSUE	-	12.24.13
06	JC	100% CD - TENDER ISSUE	-	07.09.12
05	JC	90% CD ISSUE	-	10.08.12
04	JC	75% CD ISSUE	-	13.07.12
03	JC	50% CD ISSUE	-	01.06.12
02	JC	FINAL 3D ISSUE	-	24.02.12
01	JC	DESIGN DEVELOPMENT ISSUE	-	20.01.12

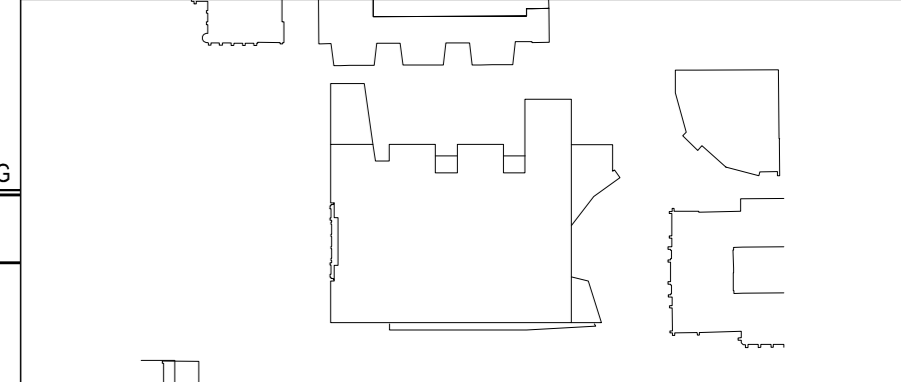

NADAAA
 NADAAA Telephone: +1 817 442 6232
 1900 Washington Street No 2 Facsimile: +1 888 442 1417
 Boston Massachusetts Email: nado@nadaaa.com
 02119 USA

John Wardle Architects
 © 2011 John Wardle Architects
 Level 10, 180 Russell Street, Melbourne Victoria 3000 Australia
 Tel : +613 9654 8700 www.johnwardlearchitects.com

Client: University of Melbourne
 Parkville Campus

Project: Faculty of Architecture
 Building and Planning

Title: 000H STAIR
 ENLARGED ELEVATIONS

Project No.	0913	Scale	1:20
Drawing No.	AR5005	Revision	A
Date	DEC 2013	Drawn	-
		Co-Ord	-
		Check	-

FILENAME: #####
FOR CONSTRUCTION