



THIS DRAWING IS AN UNCONTROLLED COPY UNLESS STAMPED OTHERWISE

CONTRACTORS SHALL VERIFY JOB DIMENSIONS BEFORE ANY JOB COMMENCES. ALL SHOP DRAWINGS SHALL BE SUBMITTED TO THE SUPERINTENDENT AND MANUFACTURE SHALL NOT COMMENCE PRIOR TO THE RETURN OF UNAMENDED SHOP DRAWINGS ISSUED BY THE CONSULTANT. FIGURED DIMENSIONS SHALL TAKE PRECEDENCE OVER SCALED. THIS DRAWING SHOULD BE READ IN CONJUNCTION WITH ALL RELEVANT CONTRACT SPECIFICATIONS AND DRAWINGS COPYRIGHT OF THIS DRAWING IS VESTED IN WARDLE

General Notes

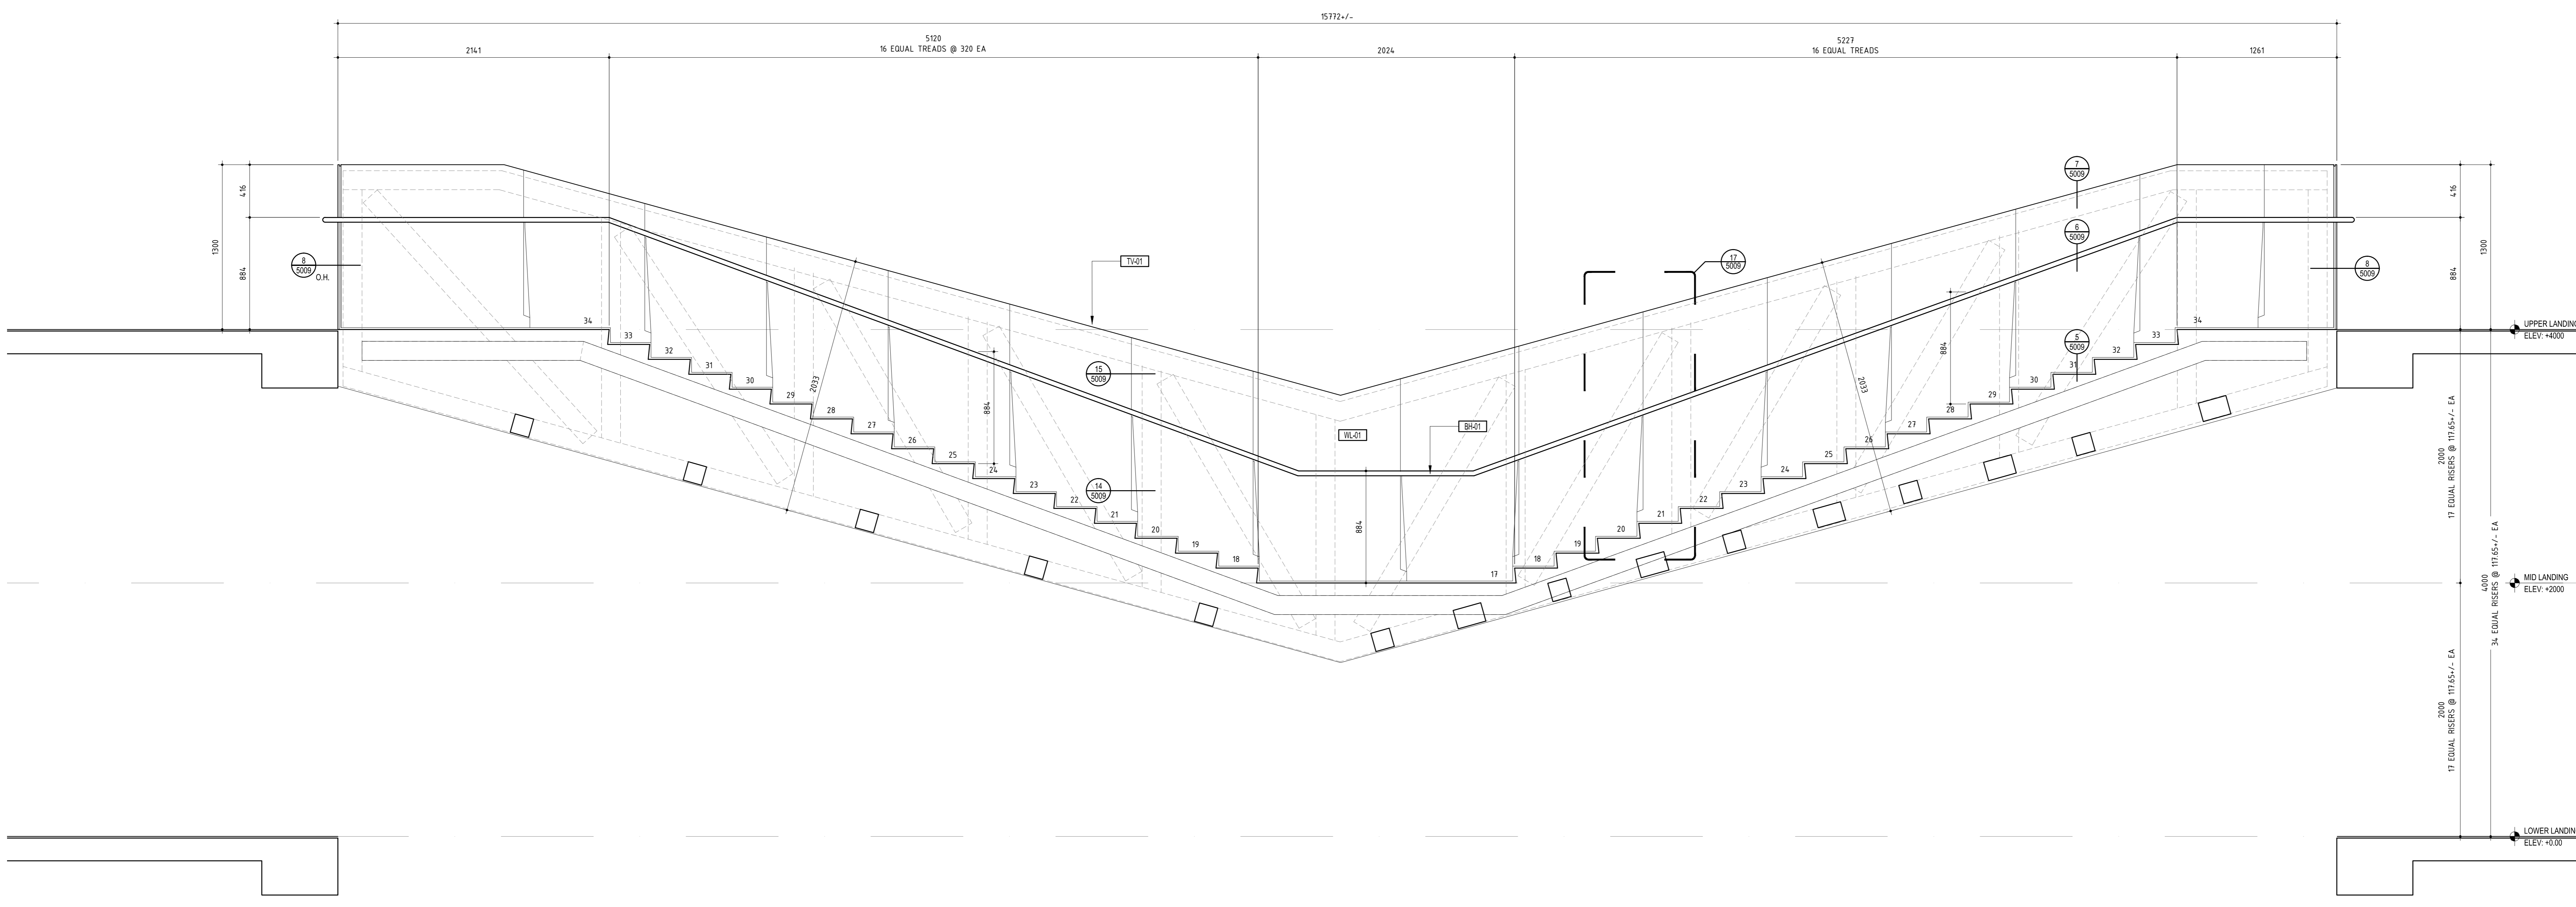


02 LONGITUDINAL SECTION/ELEVATION OF 000H STAIR  
SCALE 1:20

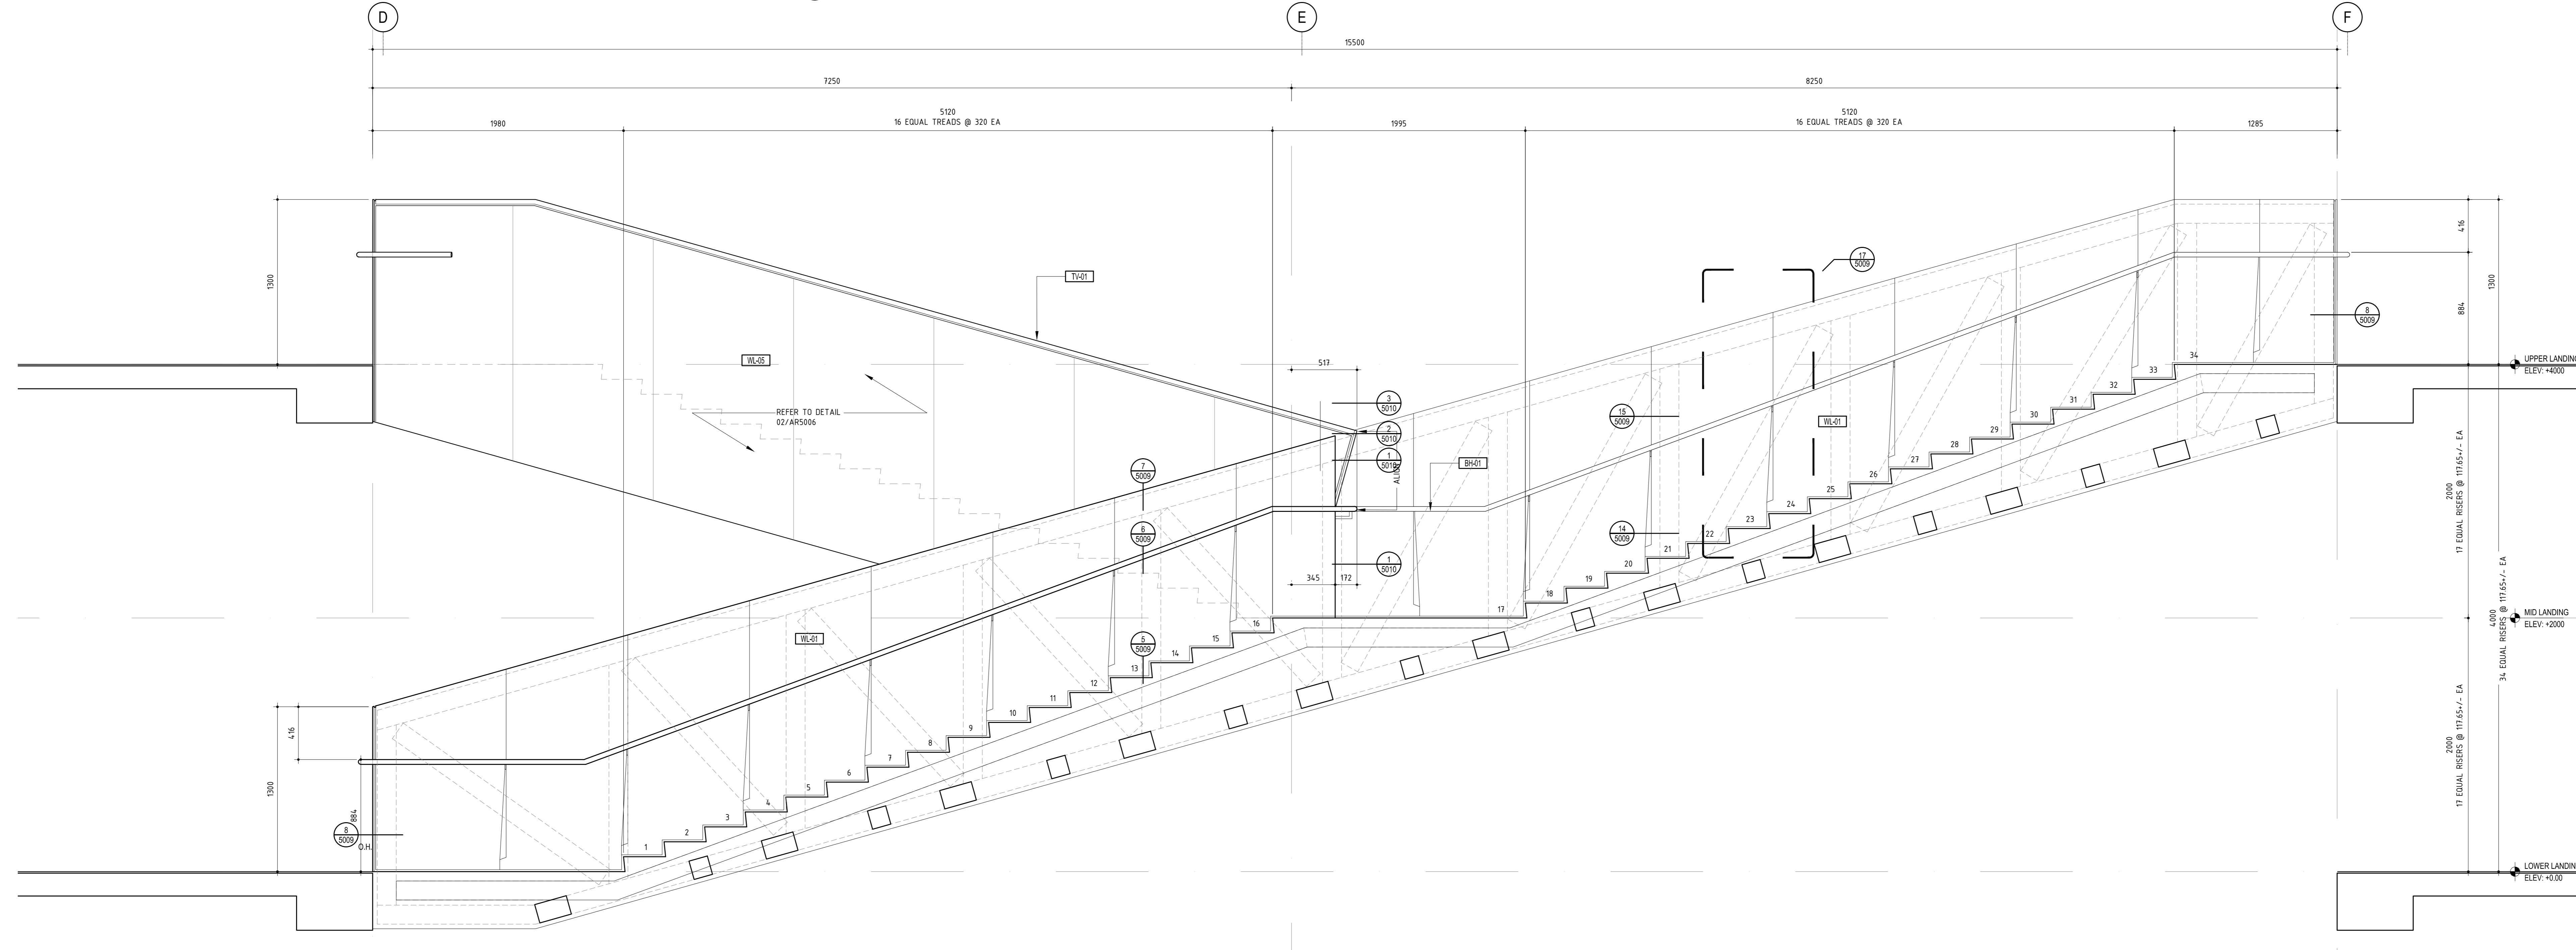

01 LONGITUDINAL SECTION/ELEVATION OF 000H STAIR  
SCALE 1:20

Rev	Issue	Revision Description	And	Date
A	SG	CONSTRUCTION ISSUE	-	12.24.13
04	JC	100% CD - TENDER ISSUE	-	07.09.12
03	JC	90% CD ISSUE	-	10.08.12
02	JC	75% CD ISSUE	-	13.07.12
01	JC	50% CD ISSUE	-	01.06.12

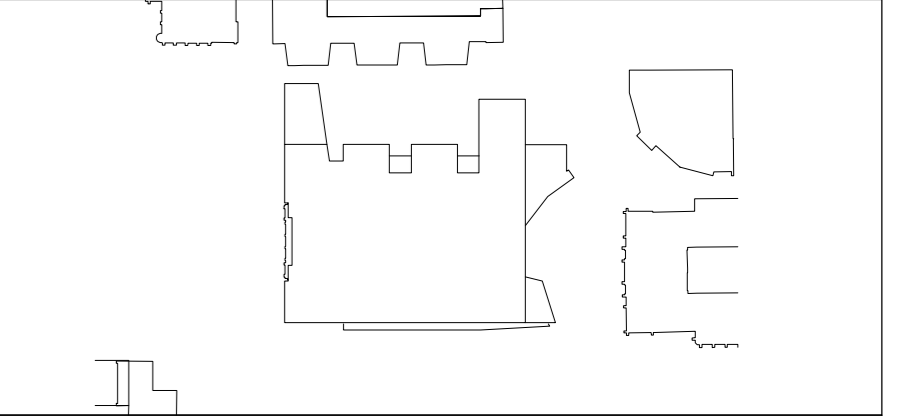

**NADAAA**  
 Telephone: +1 617 442 6232  
 Street No 2  
 Boston  
 Massachusetts  
 02118 USA  
 Facsimile: +1 688 442 1417  
 Email: nadaa@nadaaa.com

**John Wardle Architects**  
 © 2011 John Wardle Architects  
 Level 10, 180 Russell Street, Melbourne Victoria 3000 Australia  
 Tel: +613 9654 8700 www.johnwardlearchitects.com

Client: University of Melbourne  
 Parkville Campus  
 Project: Faculty of Architecture  
 Building and Planning  
 Title: 000H STAIR  
 ENLARGED LONGITUDINAL SECTIONS

Project No.	0913	Scale	1:20
Drawing No.	AR5008	Revision	A
Date	DEC 2013	Dwn	-
Co-Ord	-	Chk	-

FILENAME: #####

**FOR CONSTRUCTION**