



CONTRACTORS SHALL VERIFY DIMENSIONS BEFORE ANY JOB COMMENCES. ALL SHOP DRAWINGS SHALL BE SUBMITTED TO THE SUPERINTENDENT AND MANUFACTURERS SHALL NOT COMMENCE PRIOR TO THE RETURN OF APPROVED SHOP DRAWINGS ISSUED BY THE CONSULTANT. DIMENSIONS SHALL TAKE PRECEDENCE OVER SCALES. THIS DRAWING SHALL BE READ IN CONJUNCTION WITH ALL RELEVANT CONTRACT SPECIFICATIONS AND DRAWINGS COPYRIGHT OF THIS DRAWING IS VESTED IN HANDLE.


General Notes

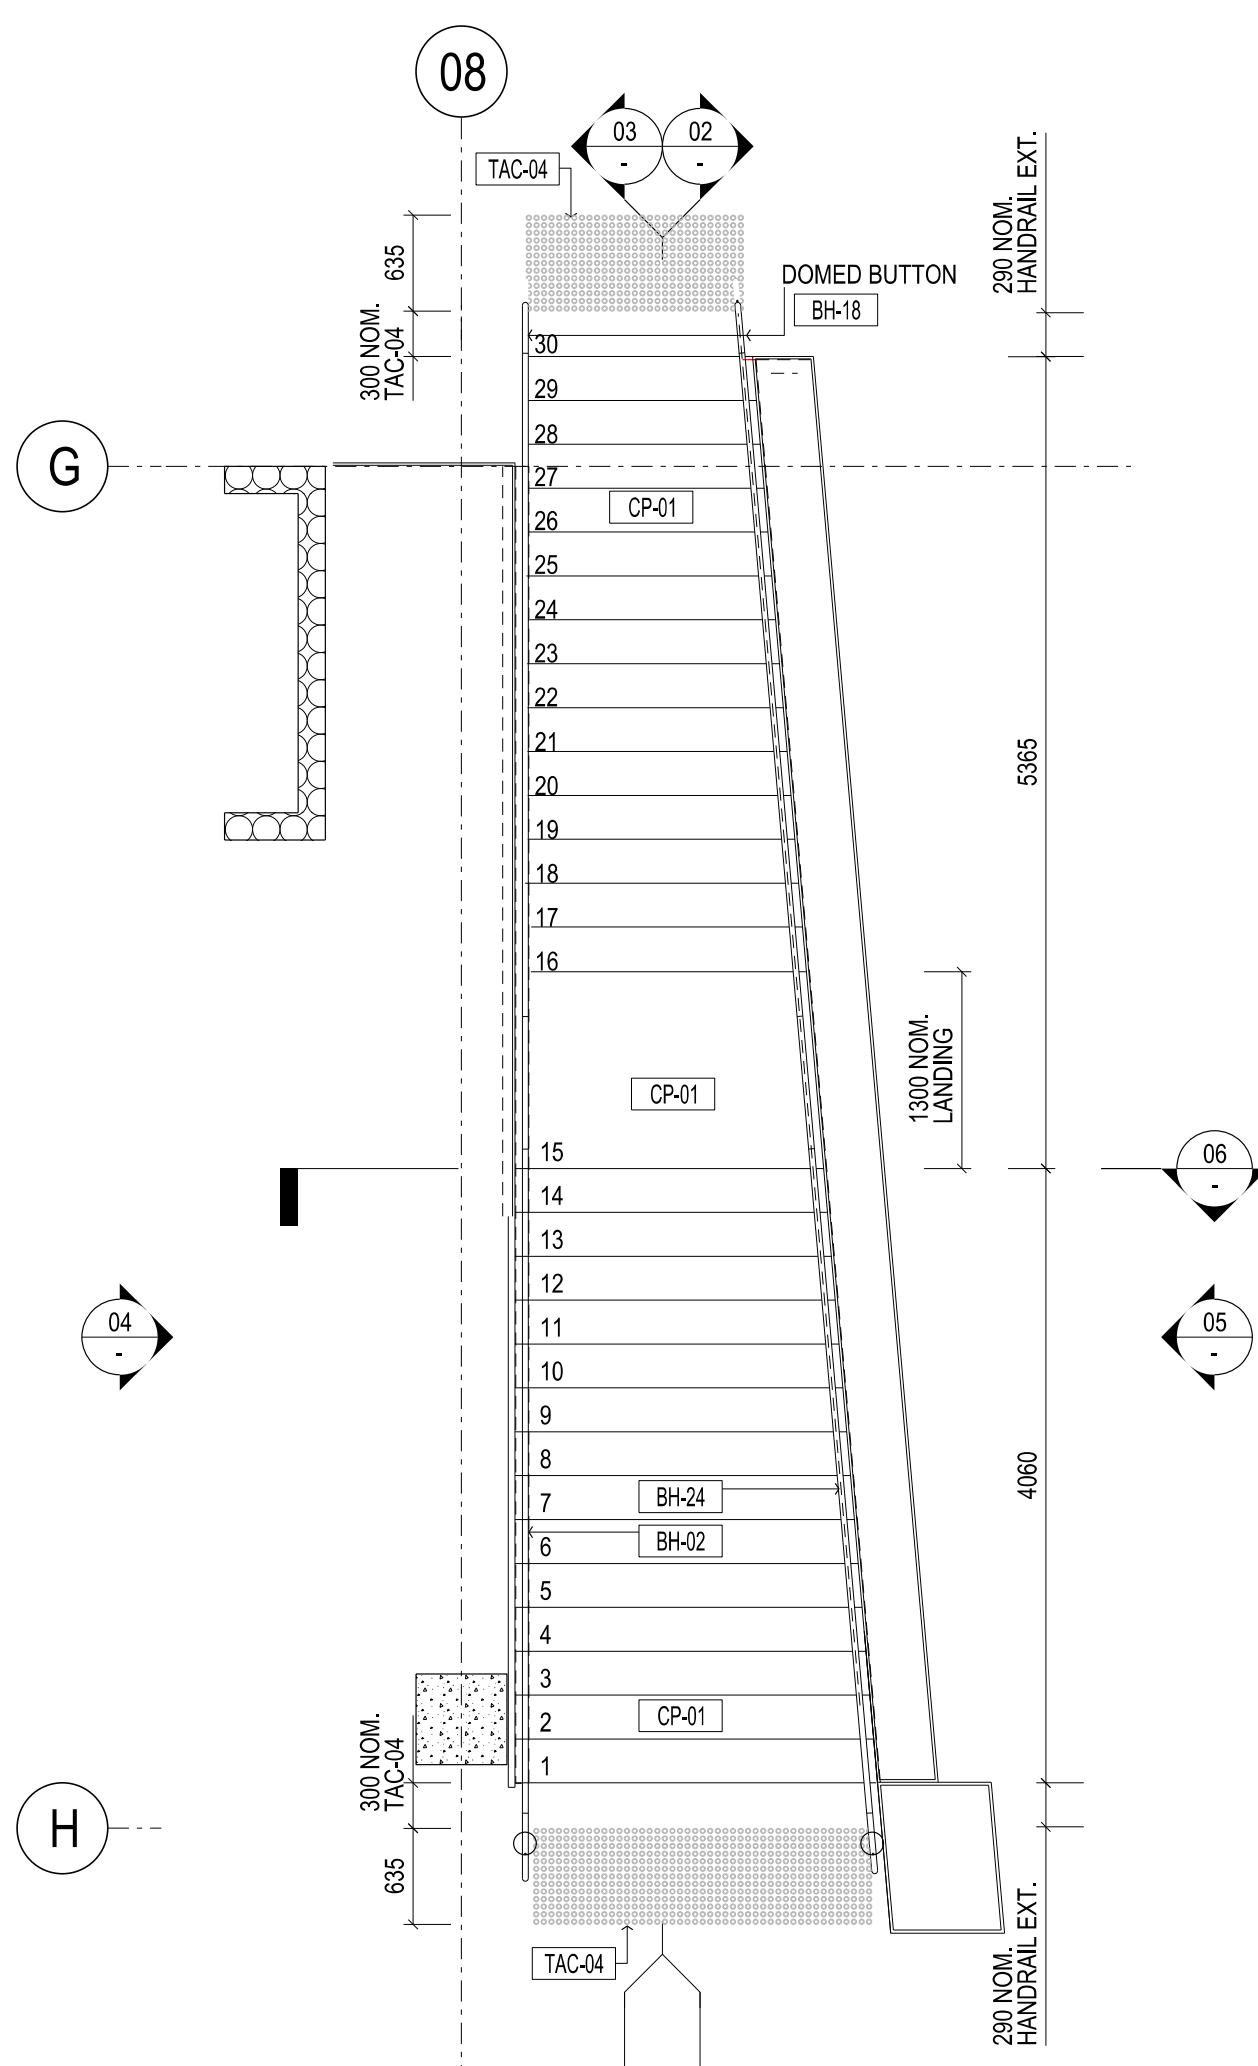


01 STAIR 000D - PLAN
SCALE 1:50

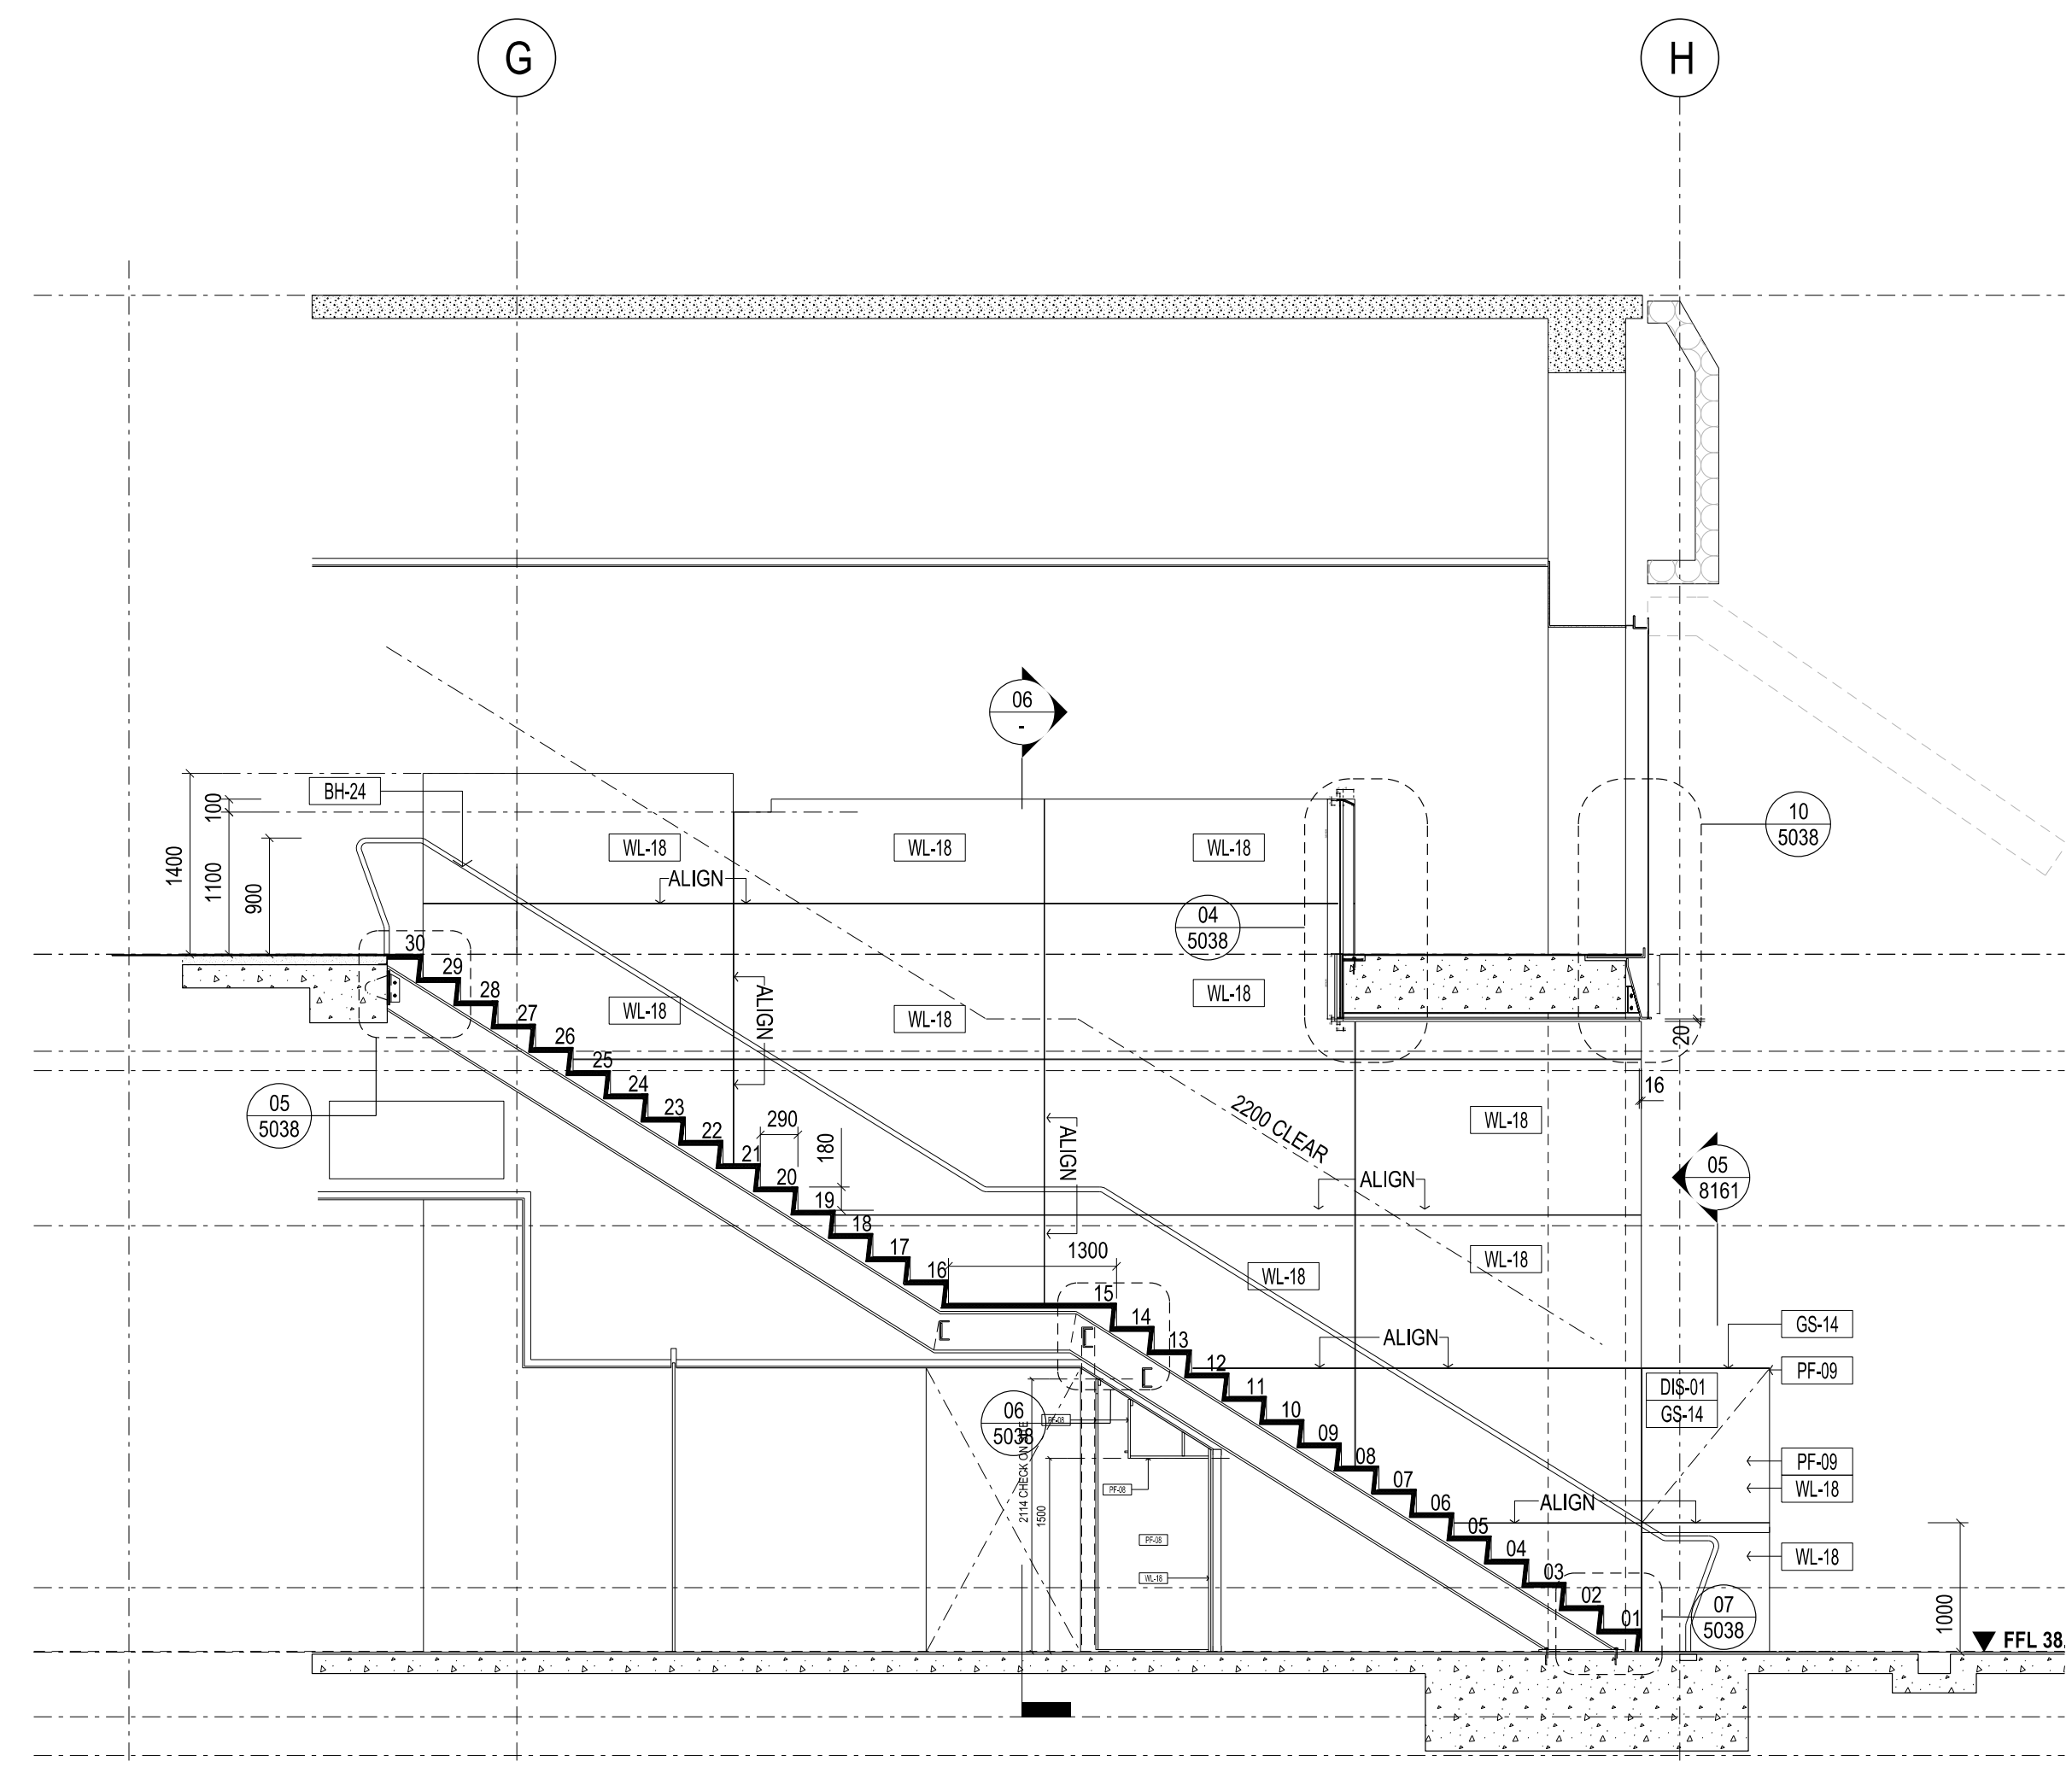


02 STAIR 000D - SECTION
SCALE 1:50

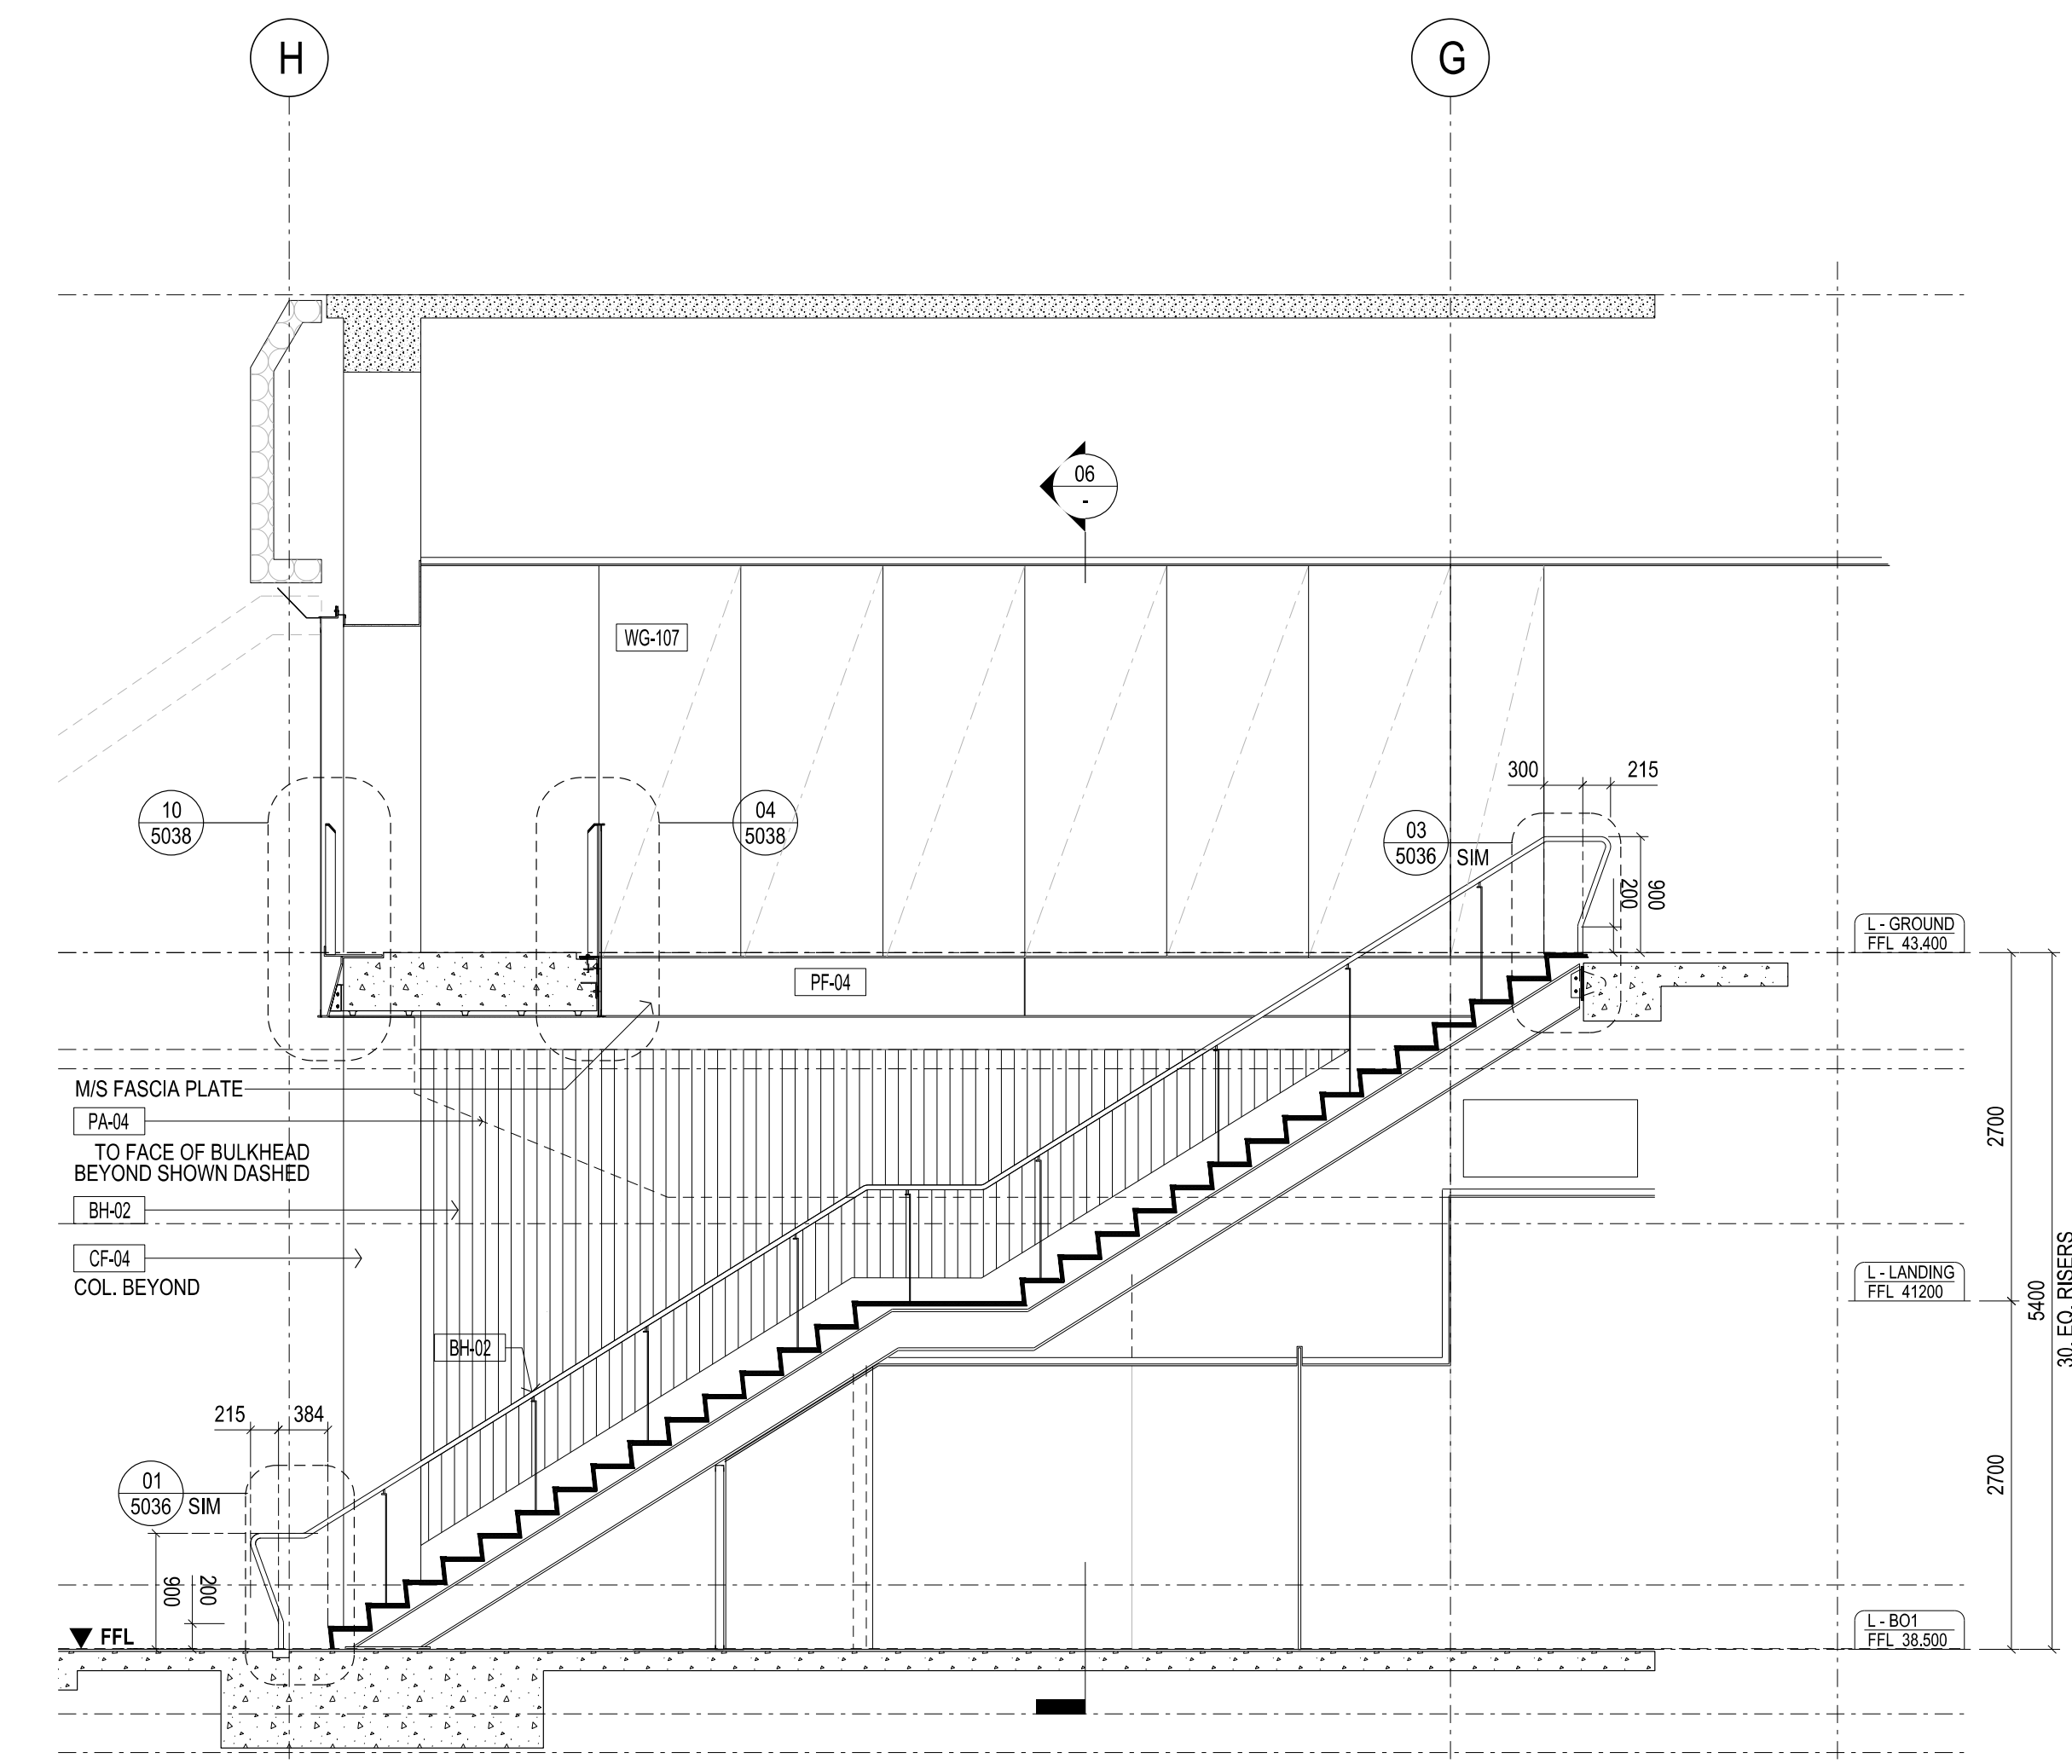


03 STAIR 000D - SECTION
SCALE 1:50

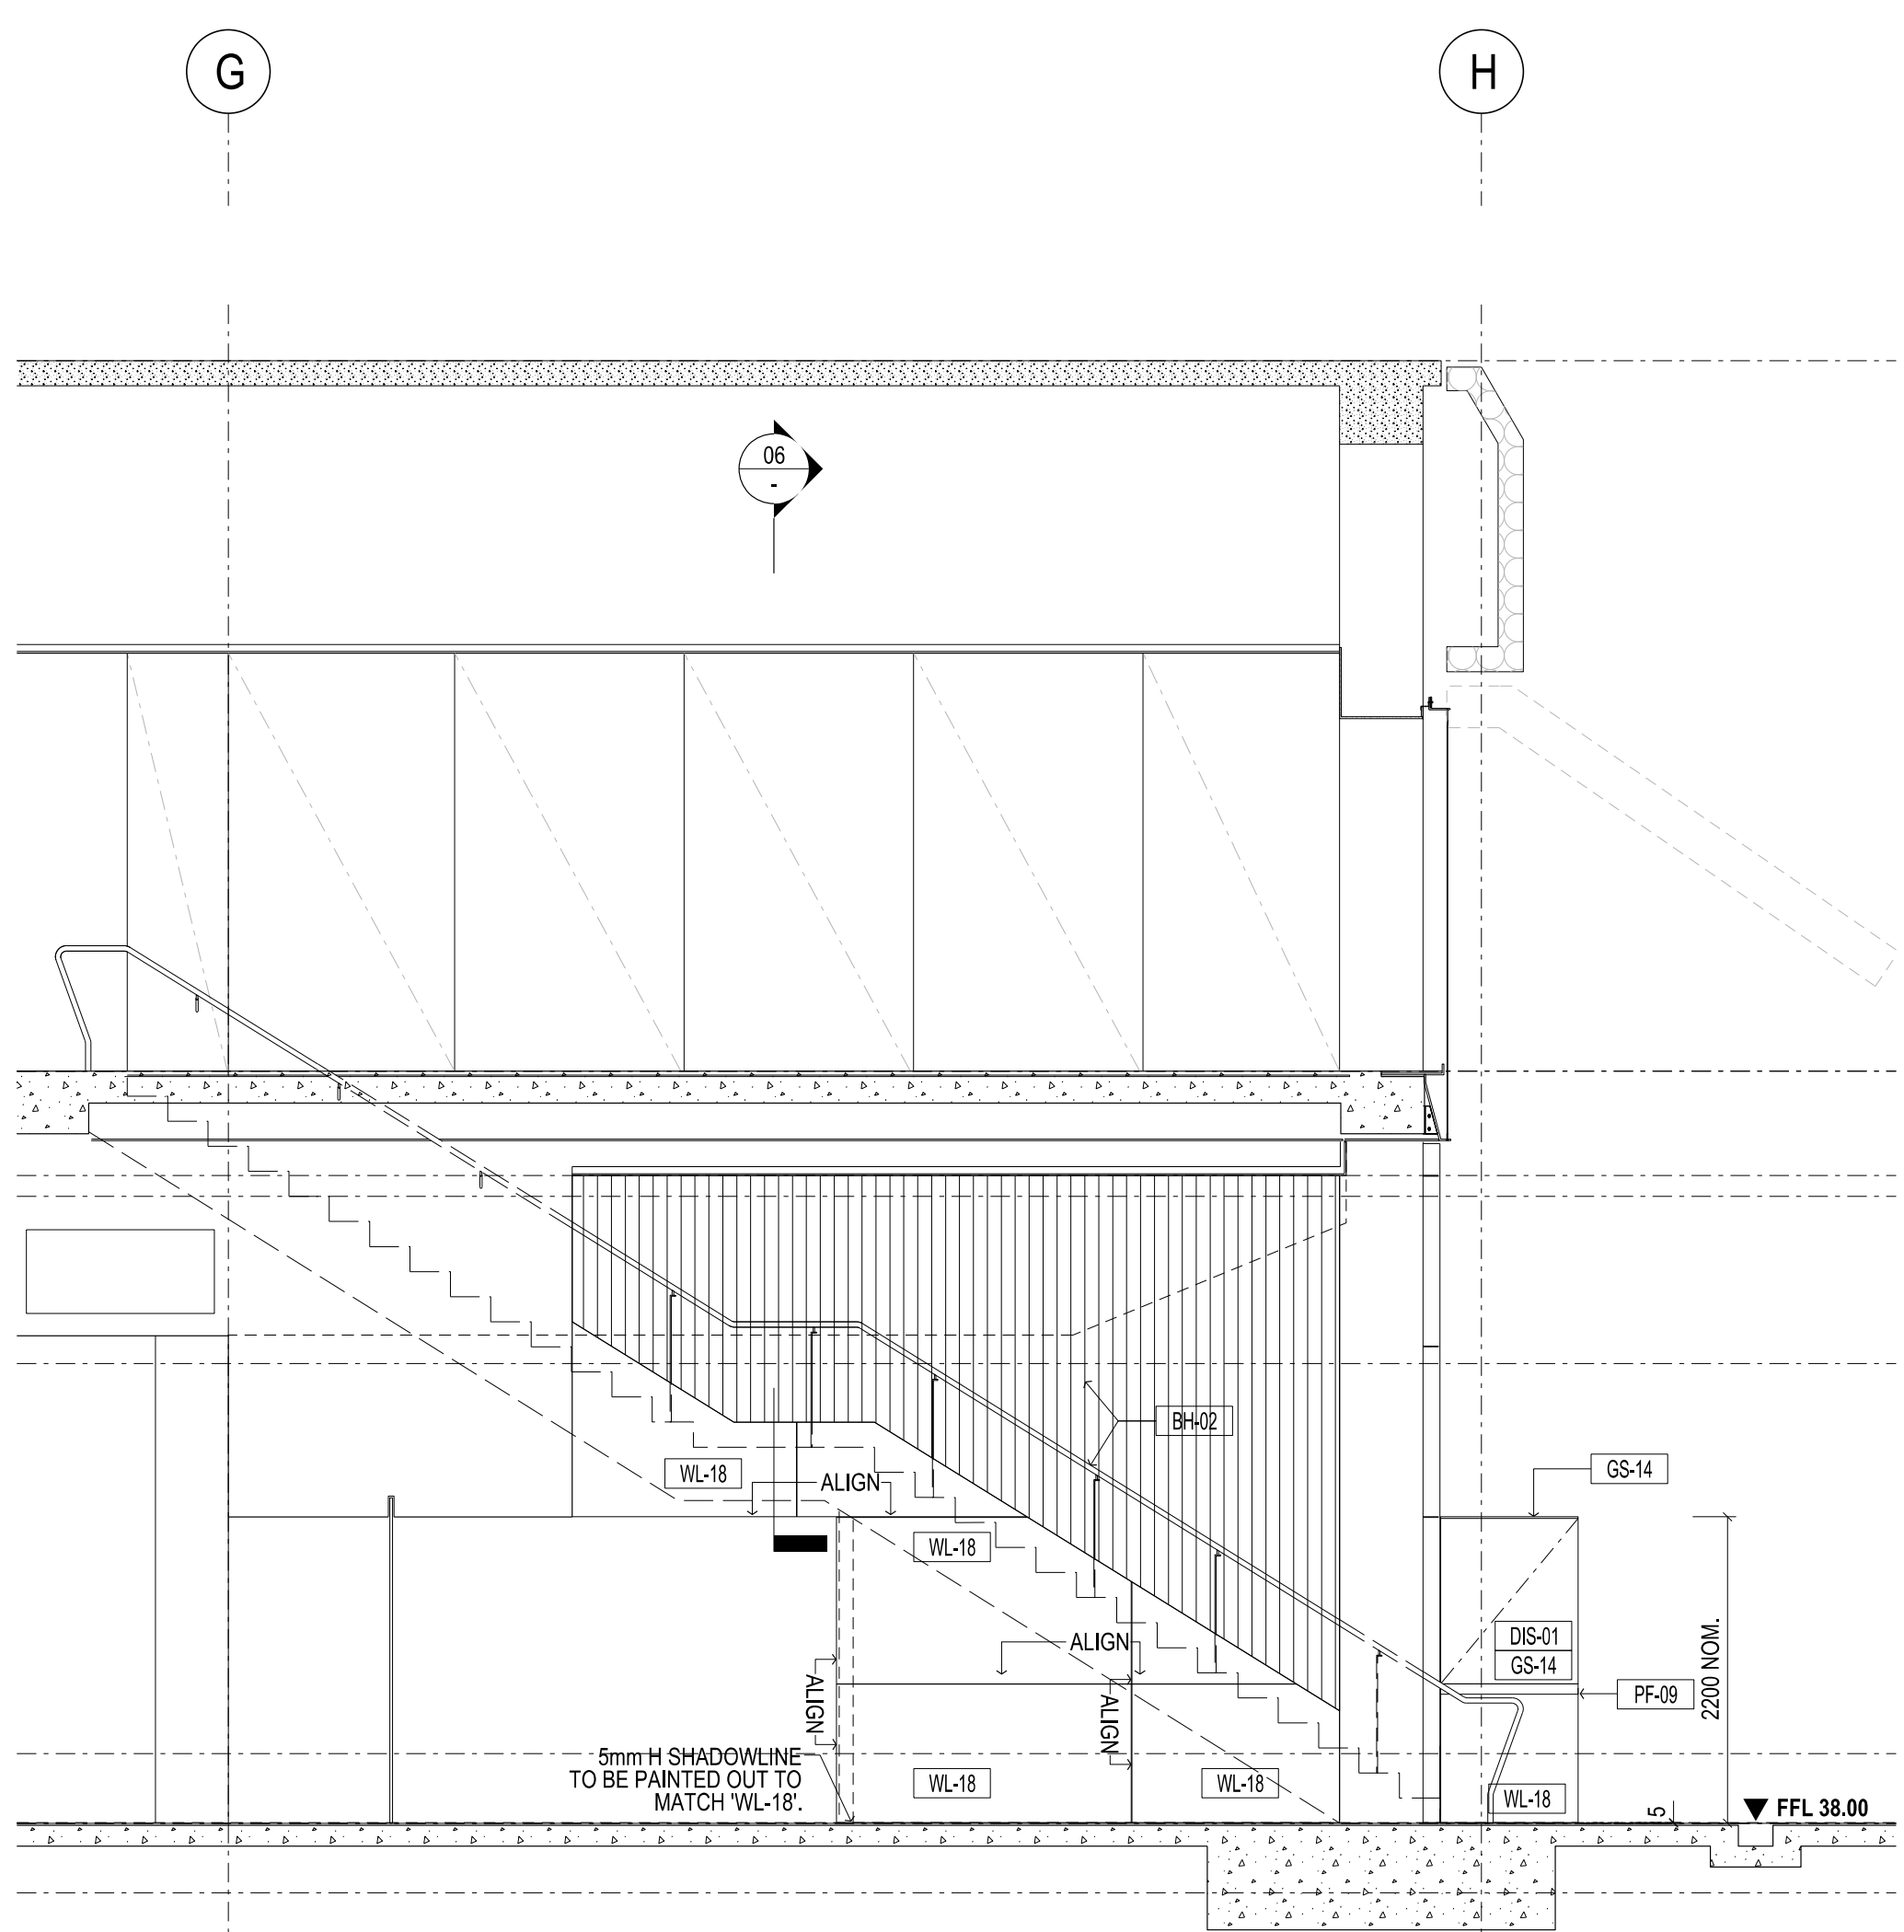

04 STAIR 000D - ELEVATION
SCALE 1:50

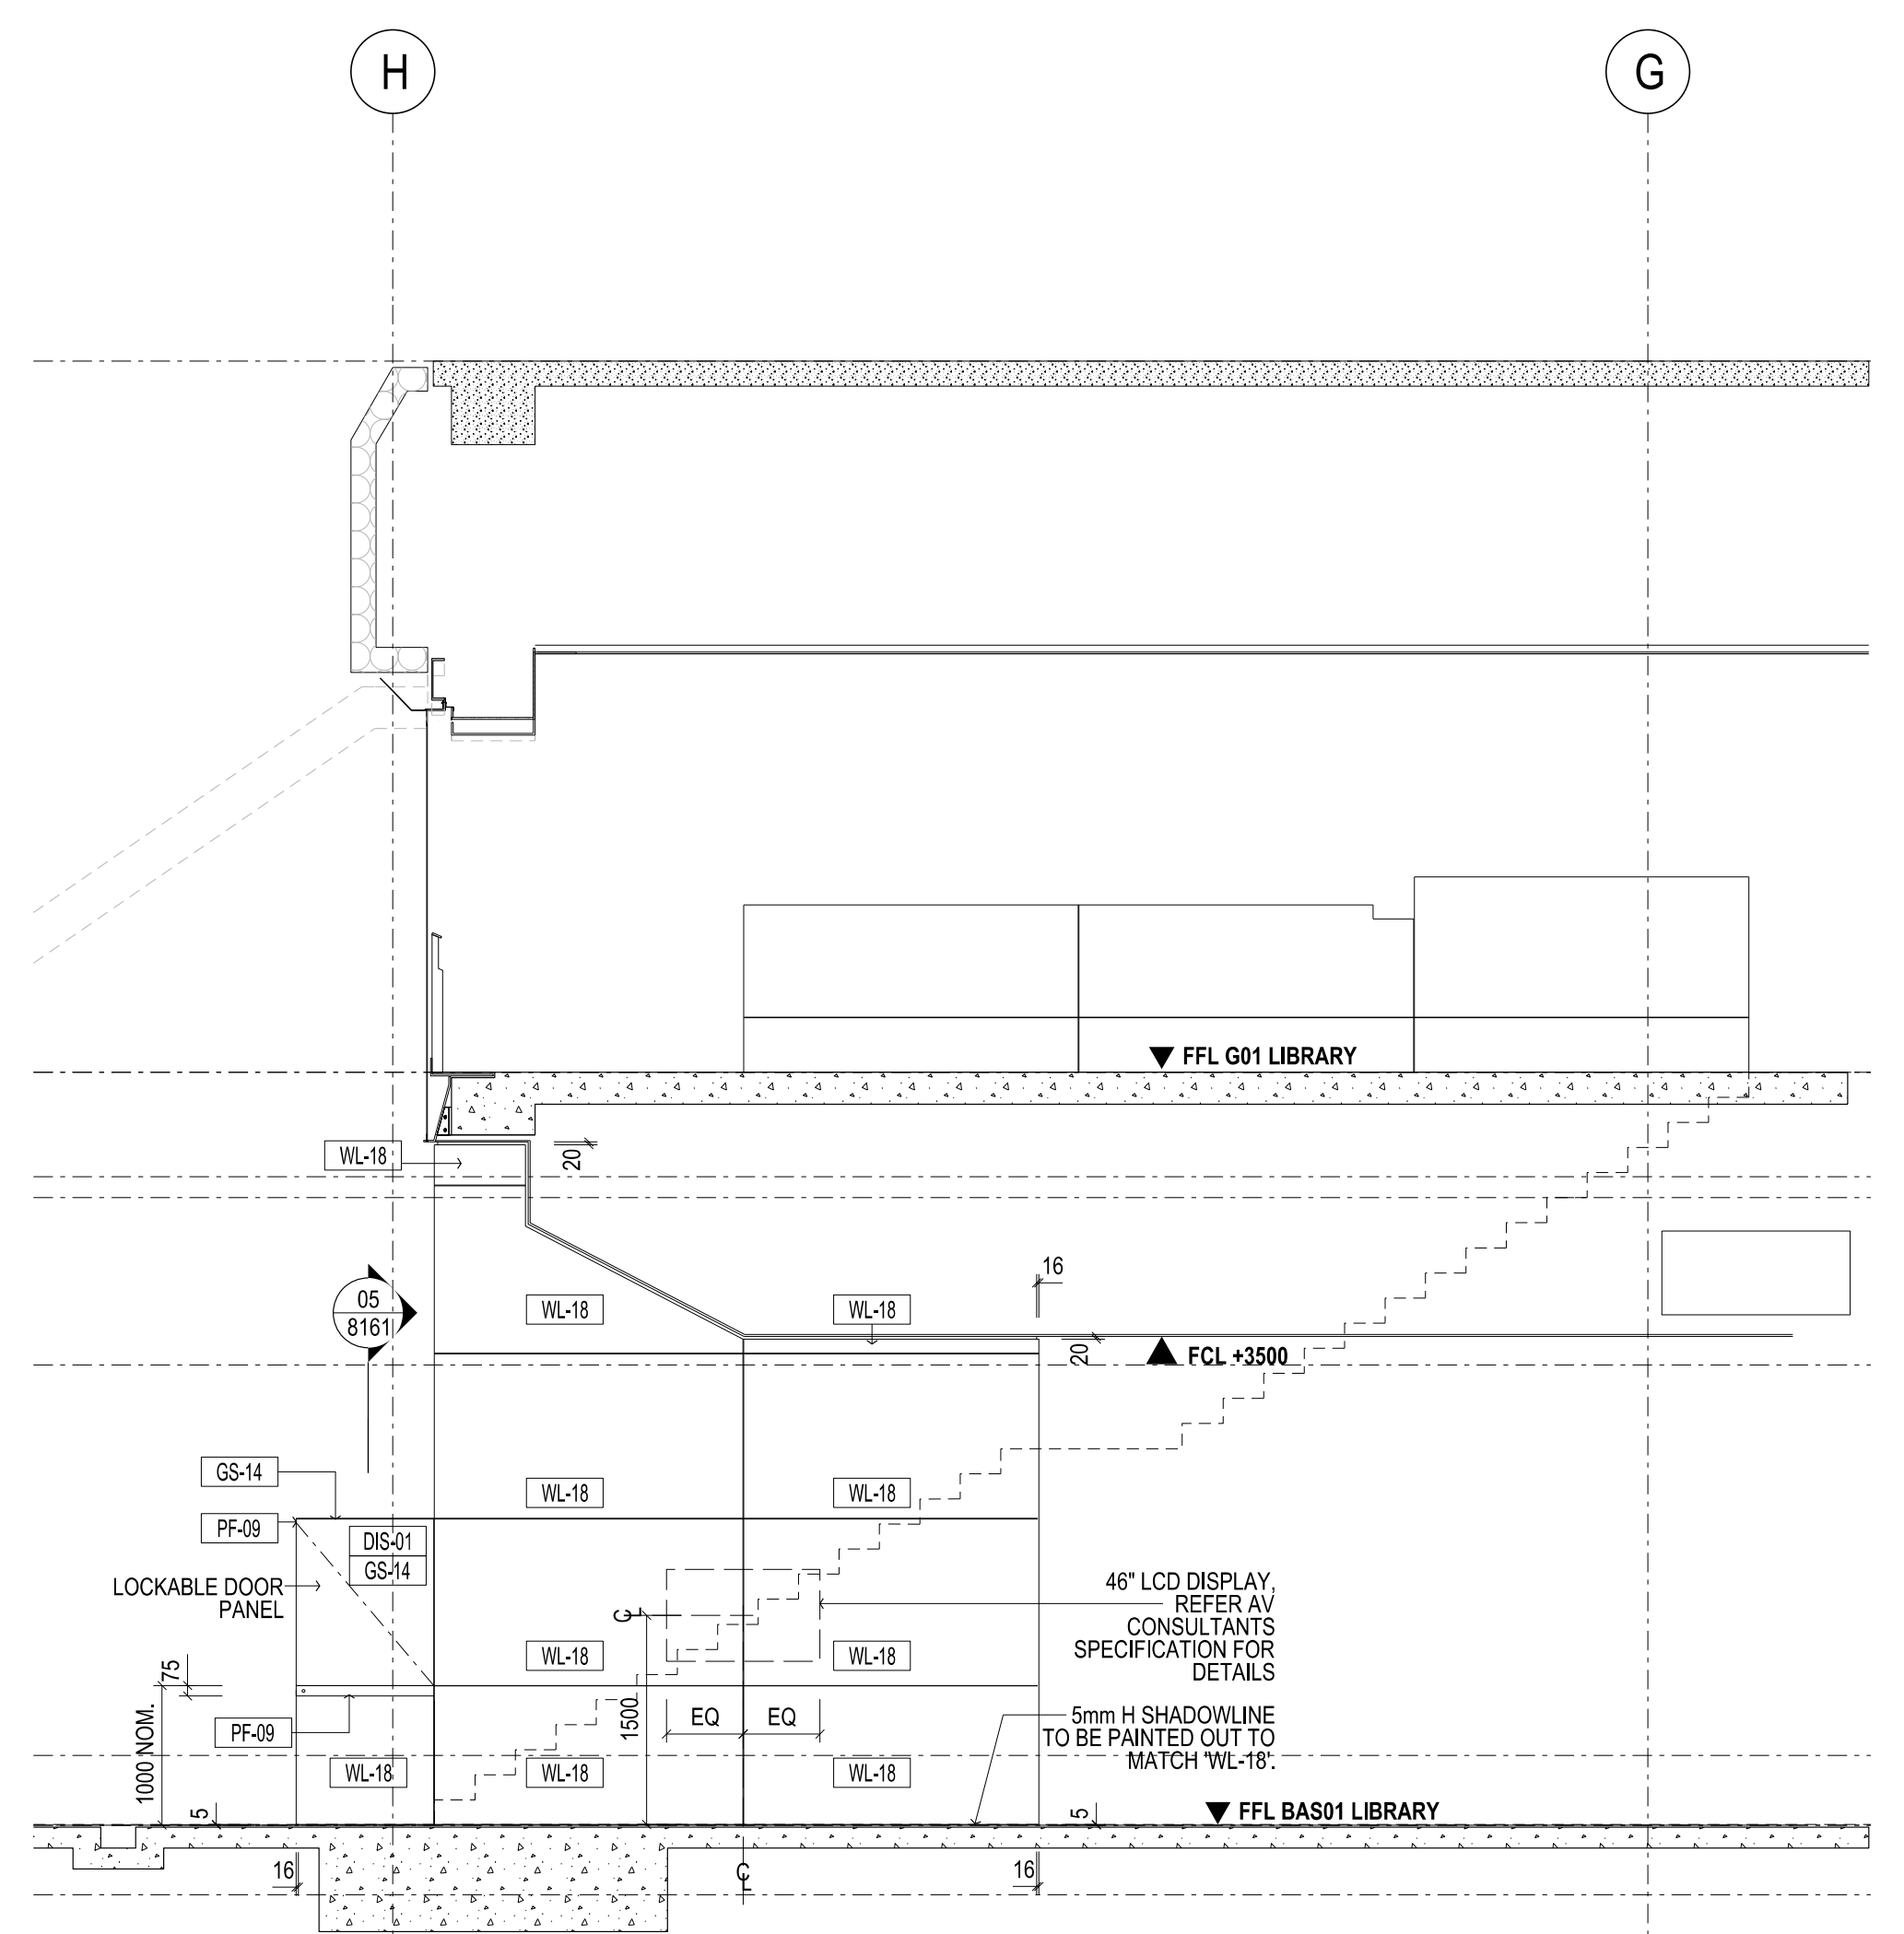

05 STAIR 000D - ELEVATION
SCALE 1:50

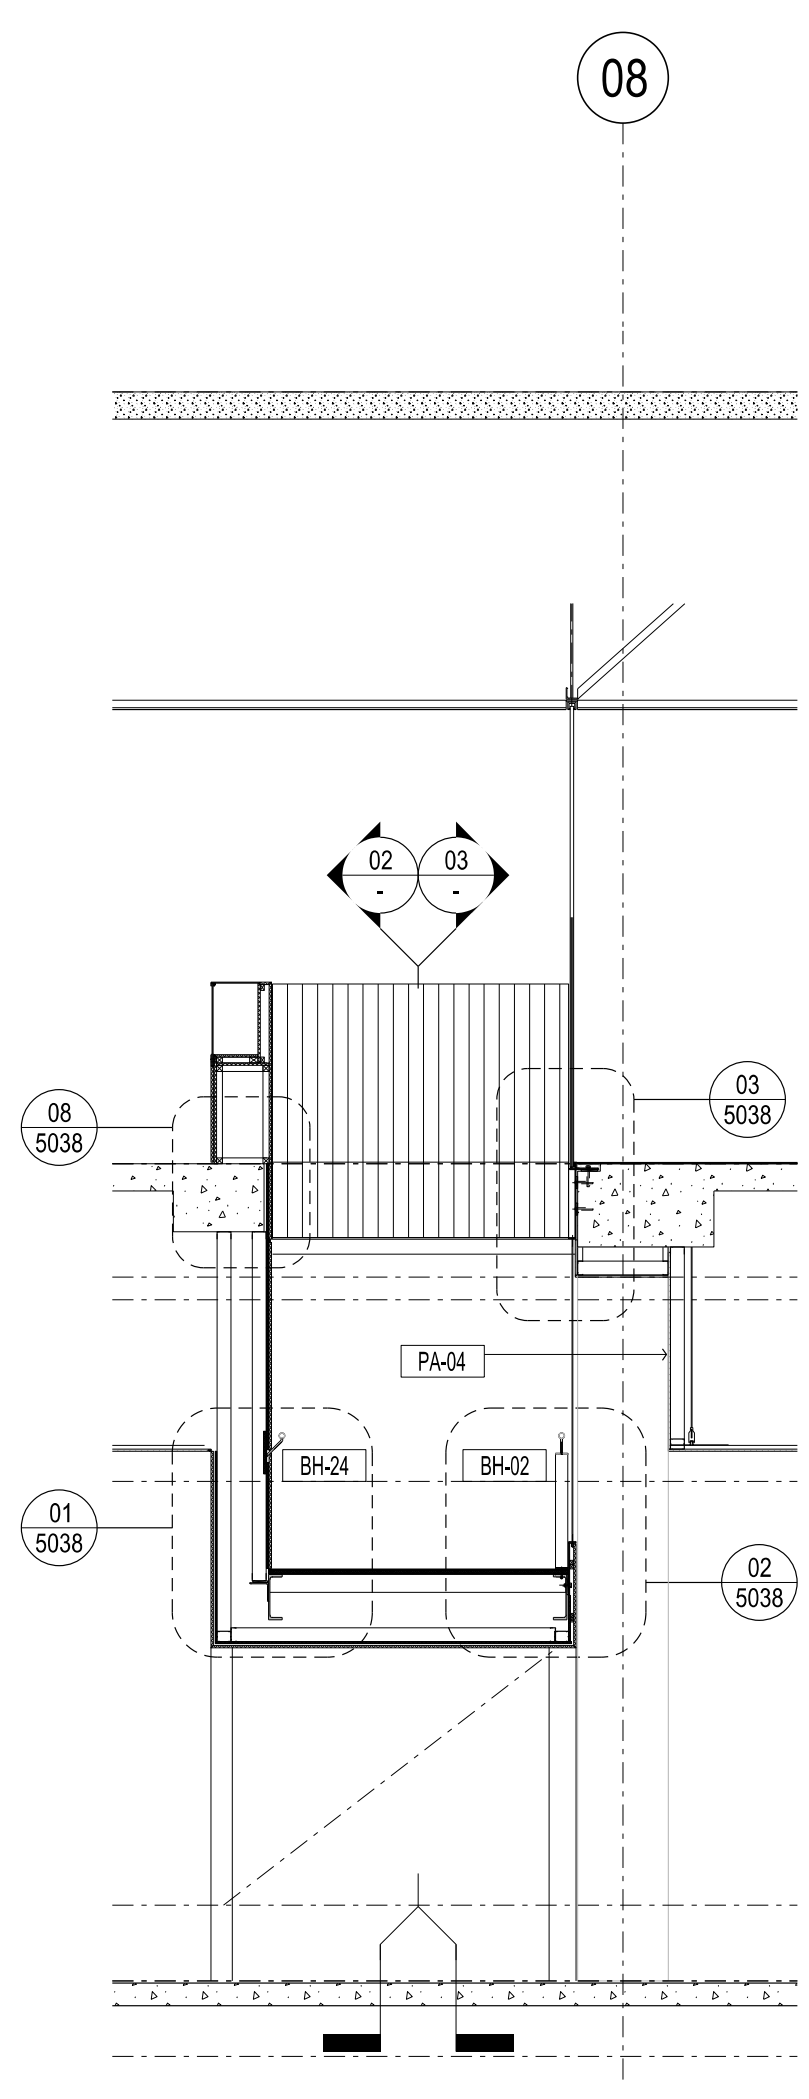

06 STAIR 000D - SECTION
SCALE 1:50

Rev	Issue	Revision Description	And	Date
A	SG	BALUSTRADE UPDATES AS CLOUDED	-	27.09.13
		BH CLARIFICATIONS		
05	SG	LCD SCREEN SETOUT ADDED REVISED TO SUIT NEW FFL - PCN 025	-	11.08.13
04	SG	VALUE MANAGEMENT ISSUE	-	28.03.13
03	SG	100% CD - TENDER ISSUE	-	07.09.12
02	SG	90% CD ISSUE	-	10.08.12
01	SG	75% CD ISSUE	-	13.07.12



NADAAA
 NADAAA
 1920 Washington Street No.2 Boston Massachusetts 02118 USA
 Telephone +1 617 442 8232 Facsimile +1 688 442 1417 Email nad@nadaaa.com

John Wardle Architects
 25 Rokeby Street, Collingwood, Victoria 3066 Australia
 Tel : +61 3 8662 0400 www.johnwardlearchitects.com
 © 2012 John Wardle Architects ABN 83 006 814 268

Client **University of Melbourne Parkville Campus**

Project **Faculty of Architecture Building and Planning**

Title **STAIR DETAILS STAIR 000D**

Project No.	0913	Scale	1:50 @ A0 1:100 @ A2
Drawing No.	AR5033	Revision	A

Date: July 2012 Dwn - Co-Ord - Chk -

FILENAME - \$FILES
FOR CONSTRUCTION