

CONTRACTORS SHALL VERIFY JOB DIMENSIONS BEFORE ANY JOB COMMENCES. ALL SHOP DRAWINGS SHALL BE SUBMITTED TO THE SUPERINTENDENT AND MANUFACTURER SHALL NOT COMMENCE FROM THE RETURN OF DIMENSIONS SHOP DRAWINGS ISSUED BY THE CONSULTANT. FIGURED DIMENSIONS SHALL TAKE PRECEDENCE OVER SCALED. THIS DRAWING SHOULD BE READ IN CONJUNCTION WITH ALL RELEVANT CONTRACT SPECIFICATIONS AND DRAWINGS COPYRIGHT OF THIS DRAWING IS VESTED IN WARDLE.

General Notes

D	SG	BALUSTRADE UPDATES AS CLOUDED	KW	28.01.14
C	SG	UPDATES AS CLOUDED	-	17.01.14
B	SG	ADDITIONAL SETOUT INFO AS CLOUDED	-	04.11.13
A	SG	BALUSTRADE UPDATES AS CLOUDED	-	27.09.13
05	SG	ADDITIONAL SETOUT DIMENSIONS ADDED REV. TO SUIT ADDITIONAL DWG. SHEETS	-	01.08.13
04	SG	VALUE MANAGEMENT ISSUE	-	28.03.13
03	SG	100% CD - TENDER ISSUE	-	07.09.12
02	SG	90% CD ISSUE	-	10.05.12
01	SG	75% CD ISSUE	-	13.07.12
Rev	Issue	Revision Description	And	Date



NADAAA
 NADAAA
 1520 Washington Street No.2 Boston Massachusetts 02118 USA
 Telephone +1 817 442 8232 Facsimile +1 888 442 1417 Email nad@nadaaa.com


John Wardle Architects
 25 Rokeby Street, Collingwood, Victoria 3066 Australia
 Tel: +61 3 8662 0400 www.johnwardlearchitects.com
 © 2014 John Wardle Architects ABN 83 006 814 268

Client **University of Melbourne Parkville Campus**
 Project **Faculty of Architecture Building and Planning**


Title **STAIR DETAILS STAIR 000G, 000F & 000H**

Project No. **0913** Scale 1:50 @ A0
 Drawing No. **AR5034** Revision **D**
 Date July 2012 Dwn - Co-Ord - Chk -


FILENAME - SFILES
FOR CONSTRUCTION

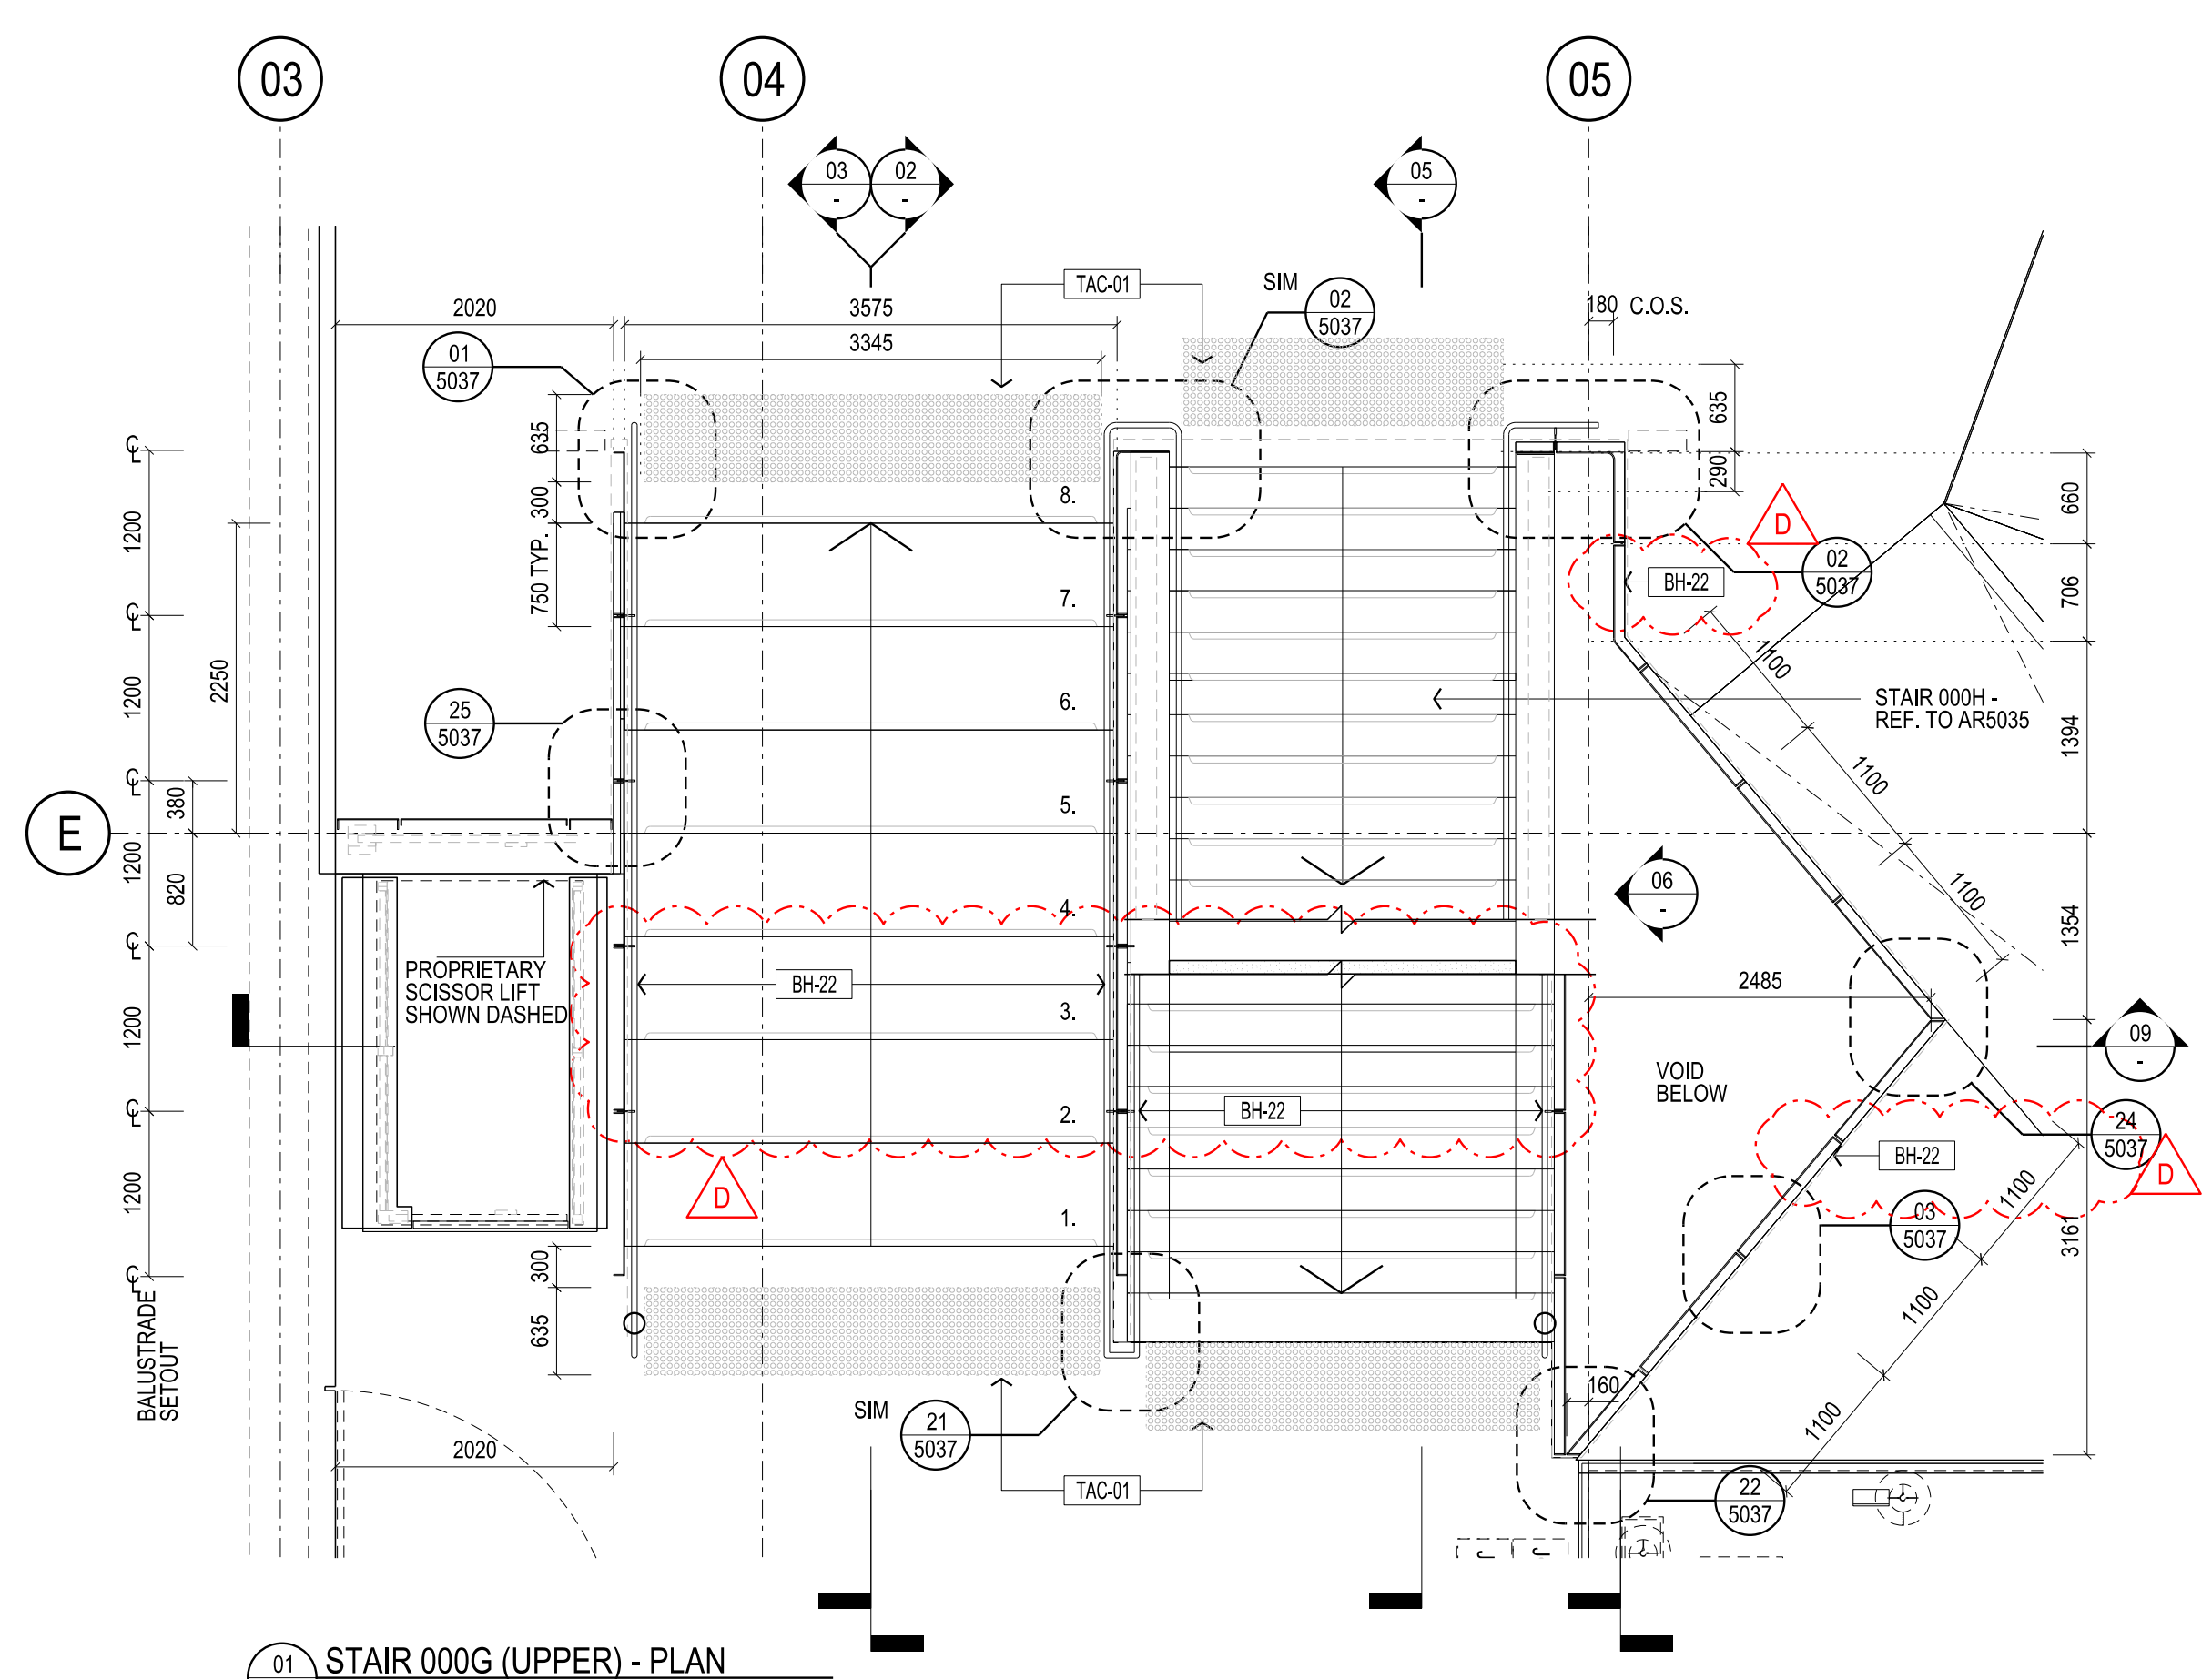


03 STAIR 000G (UPPER) - PLAN
SCALE 1:50

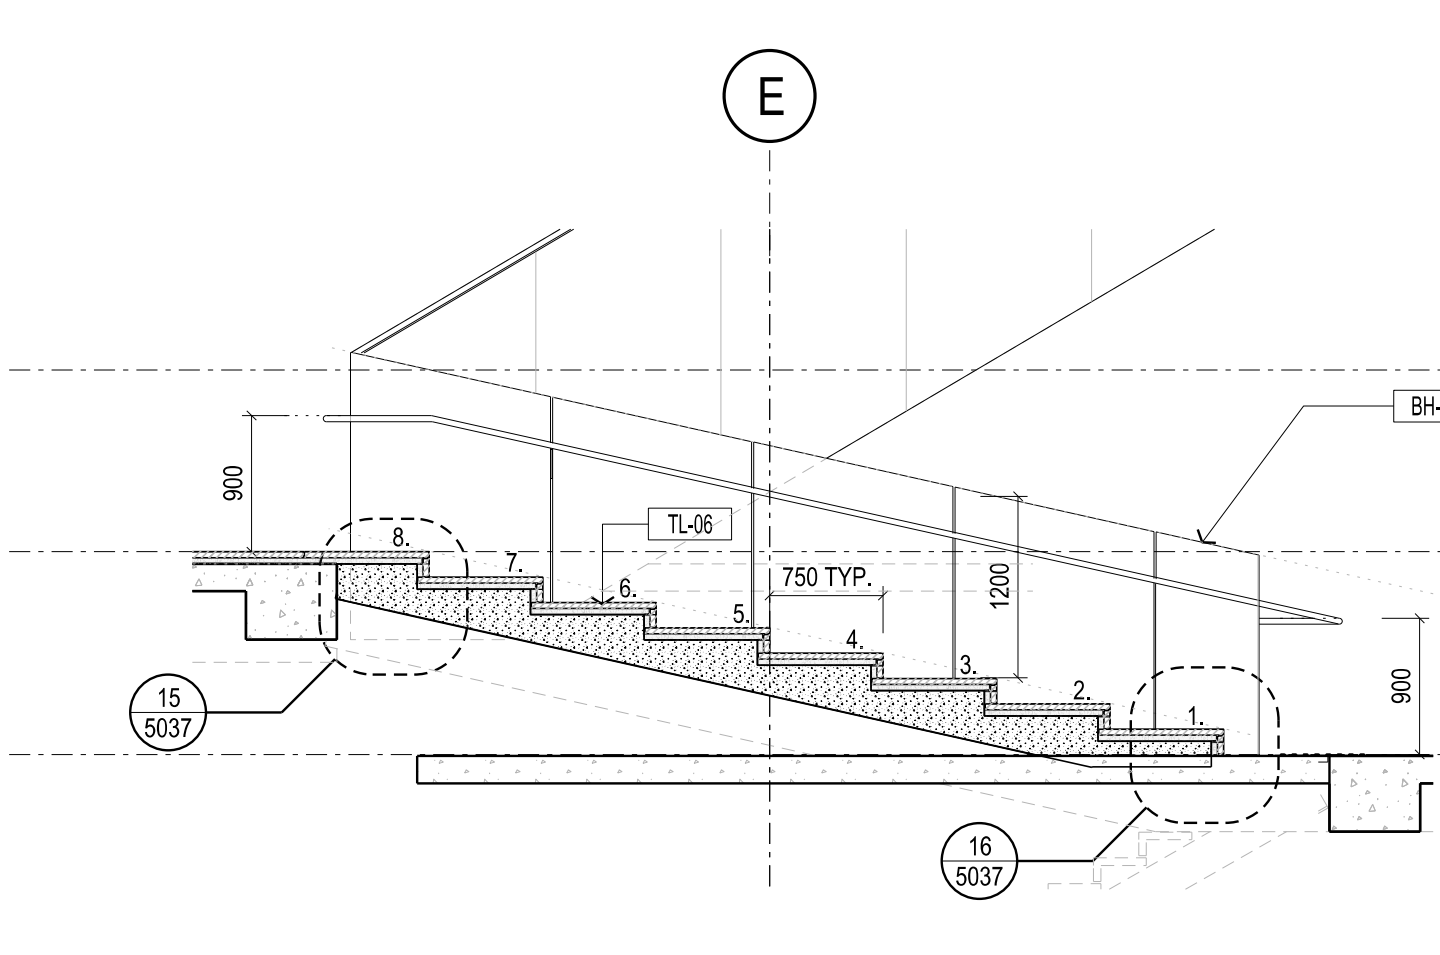


02 STAIR 000G (UPPER) - SECTION
SCALE 1:50

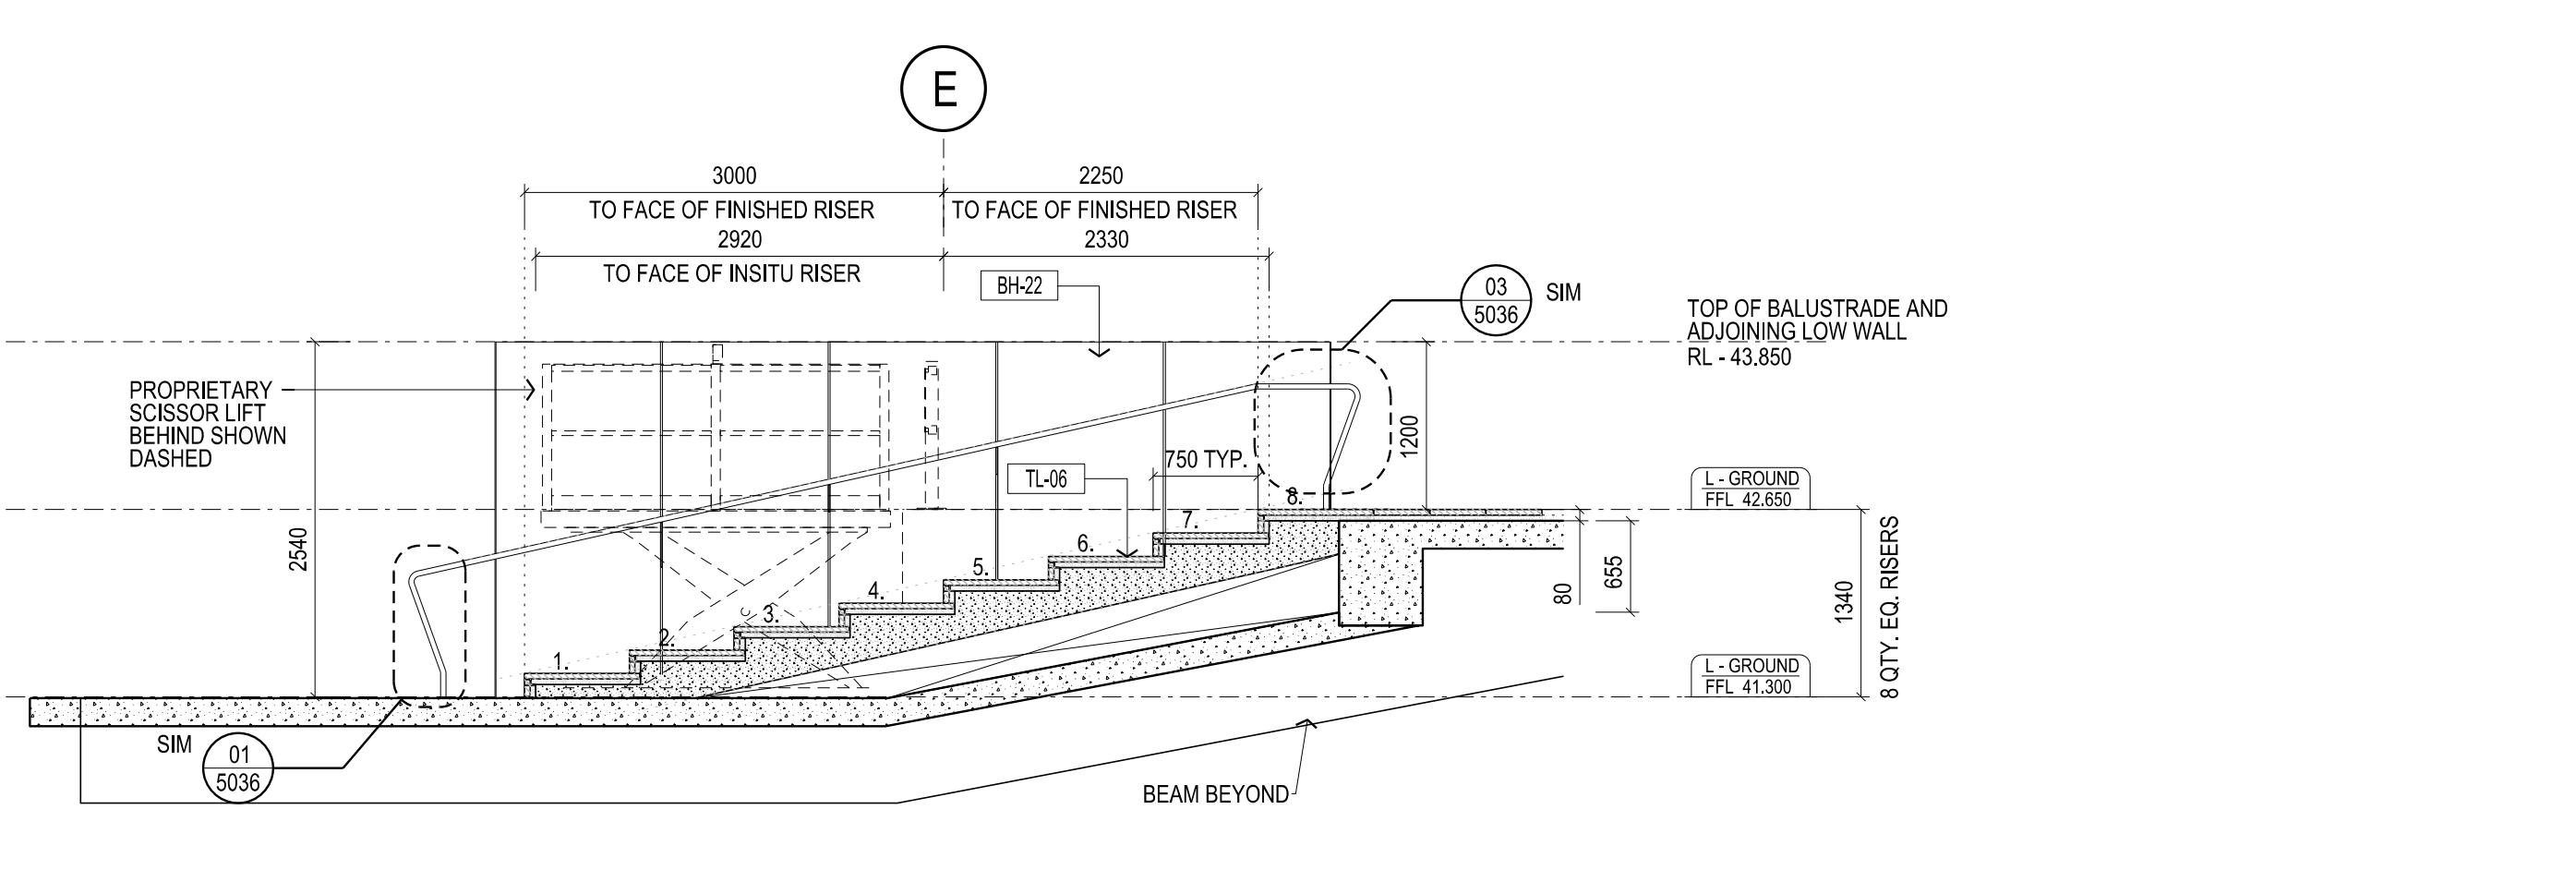


01 STAIR 000G (UPPER) - SECTION
SCALE 1:50

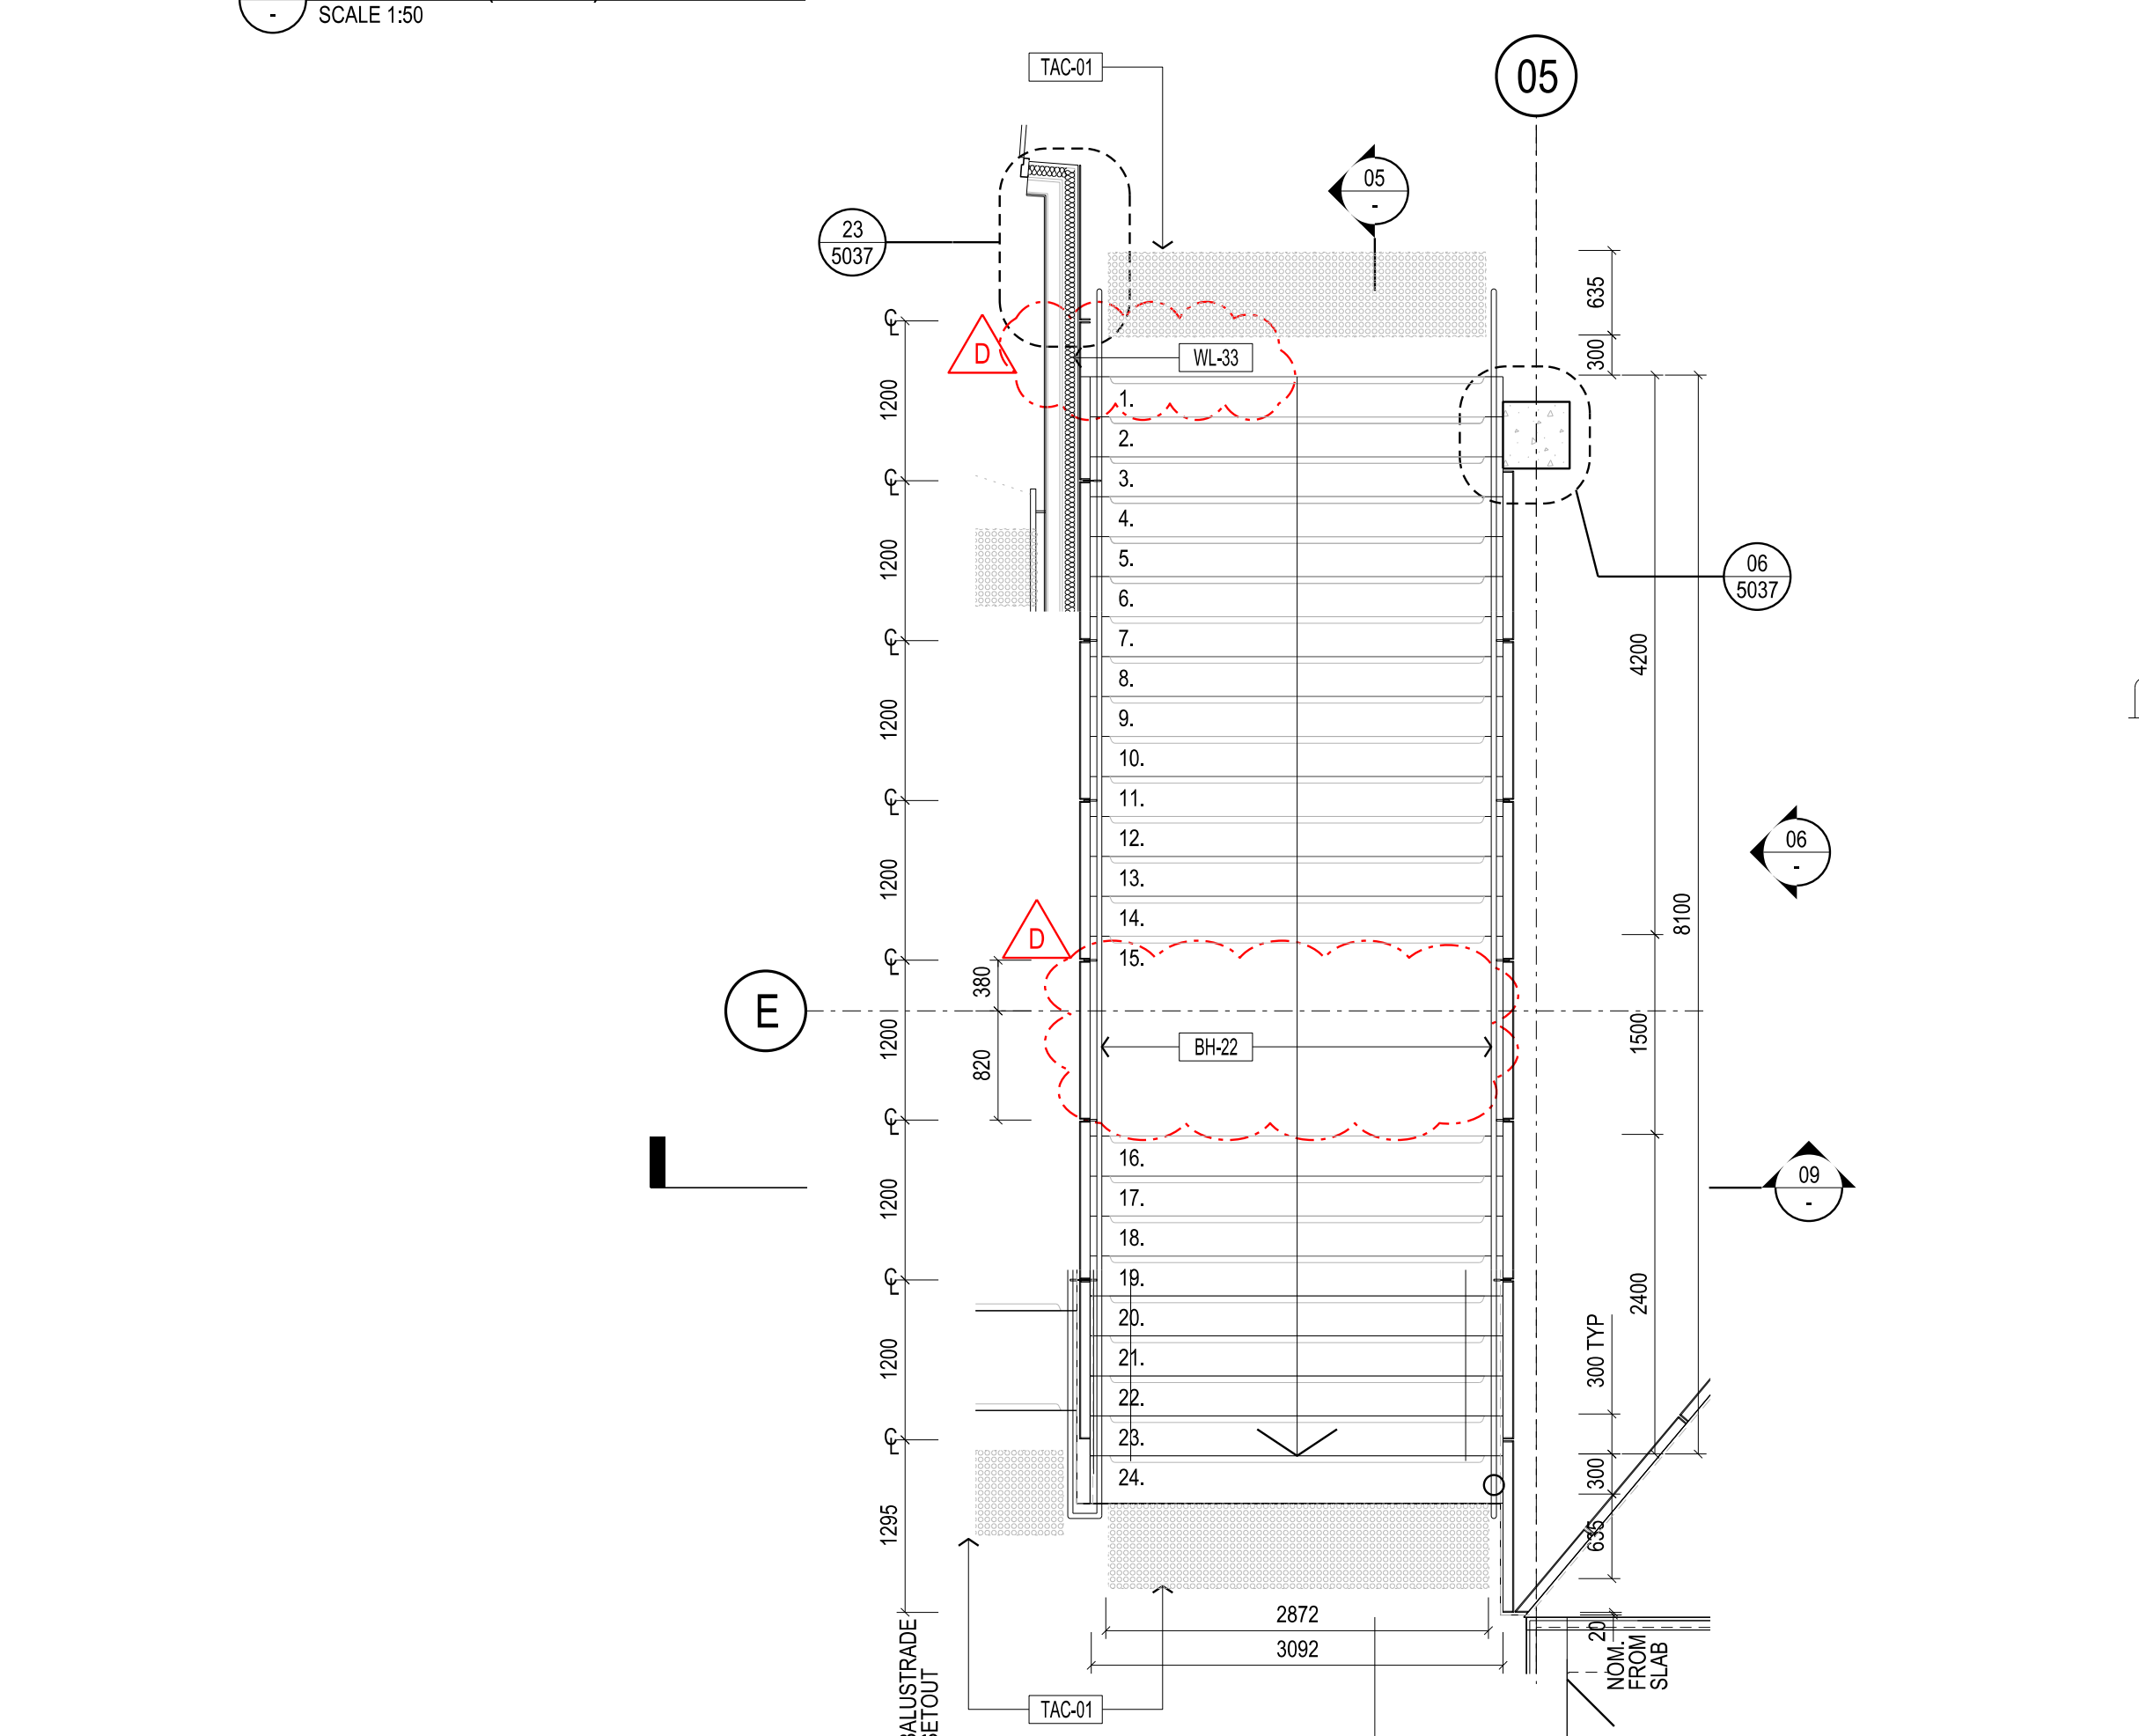


04 STAIR 000G (LOWER) - PLAN
SCALE 1:50

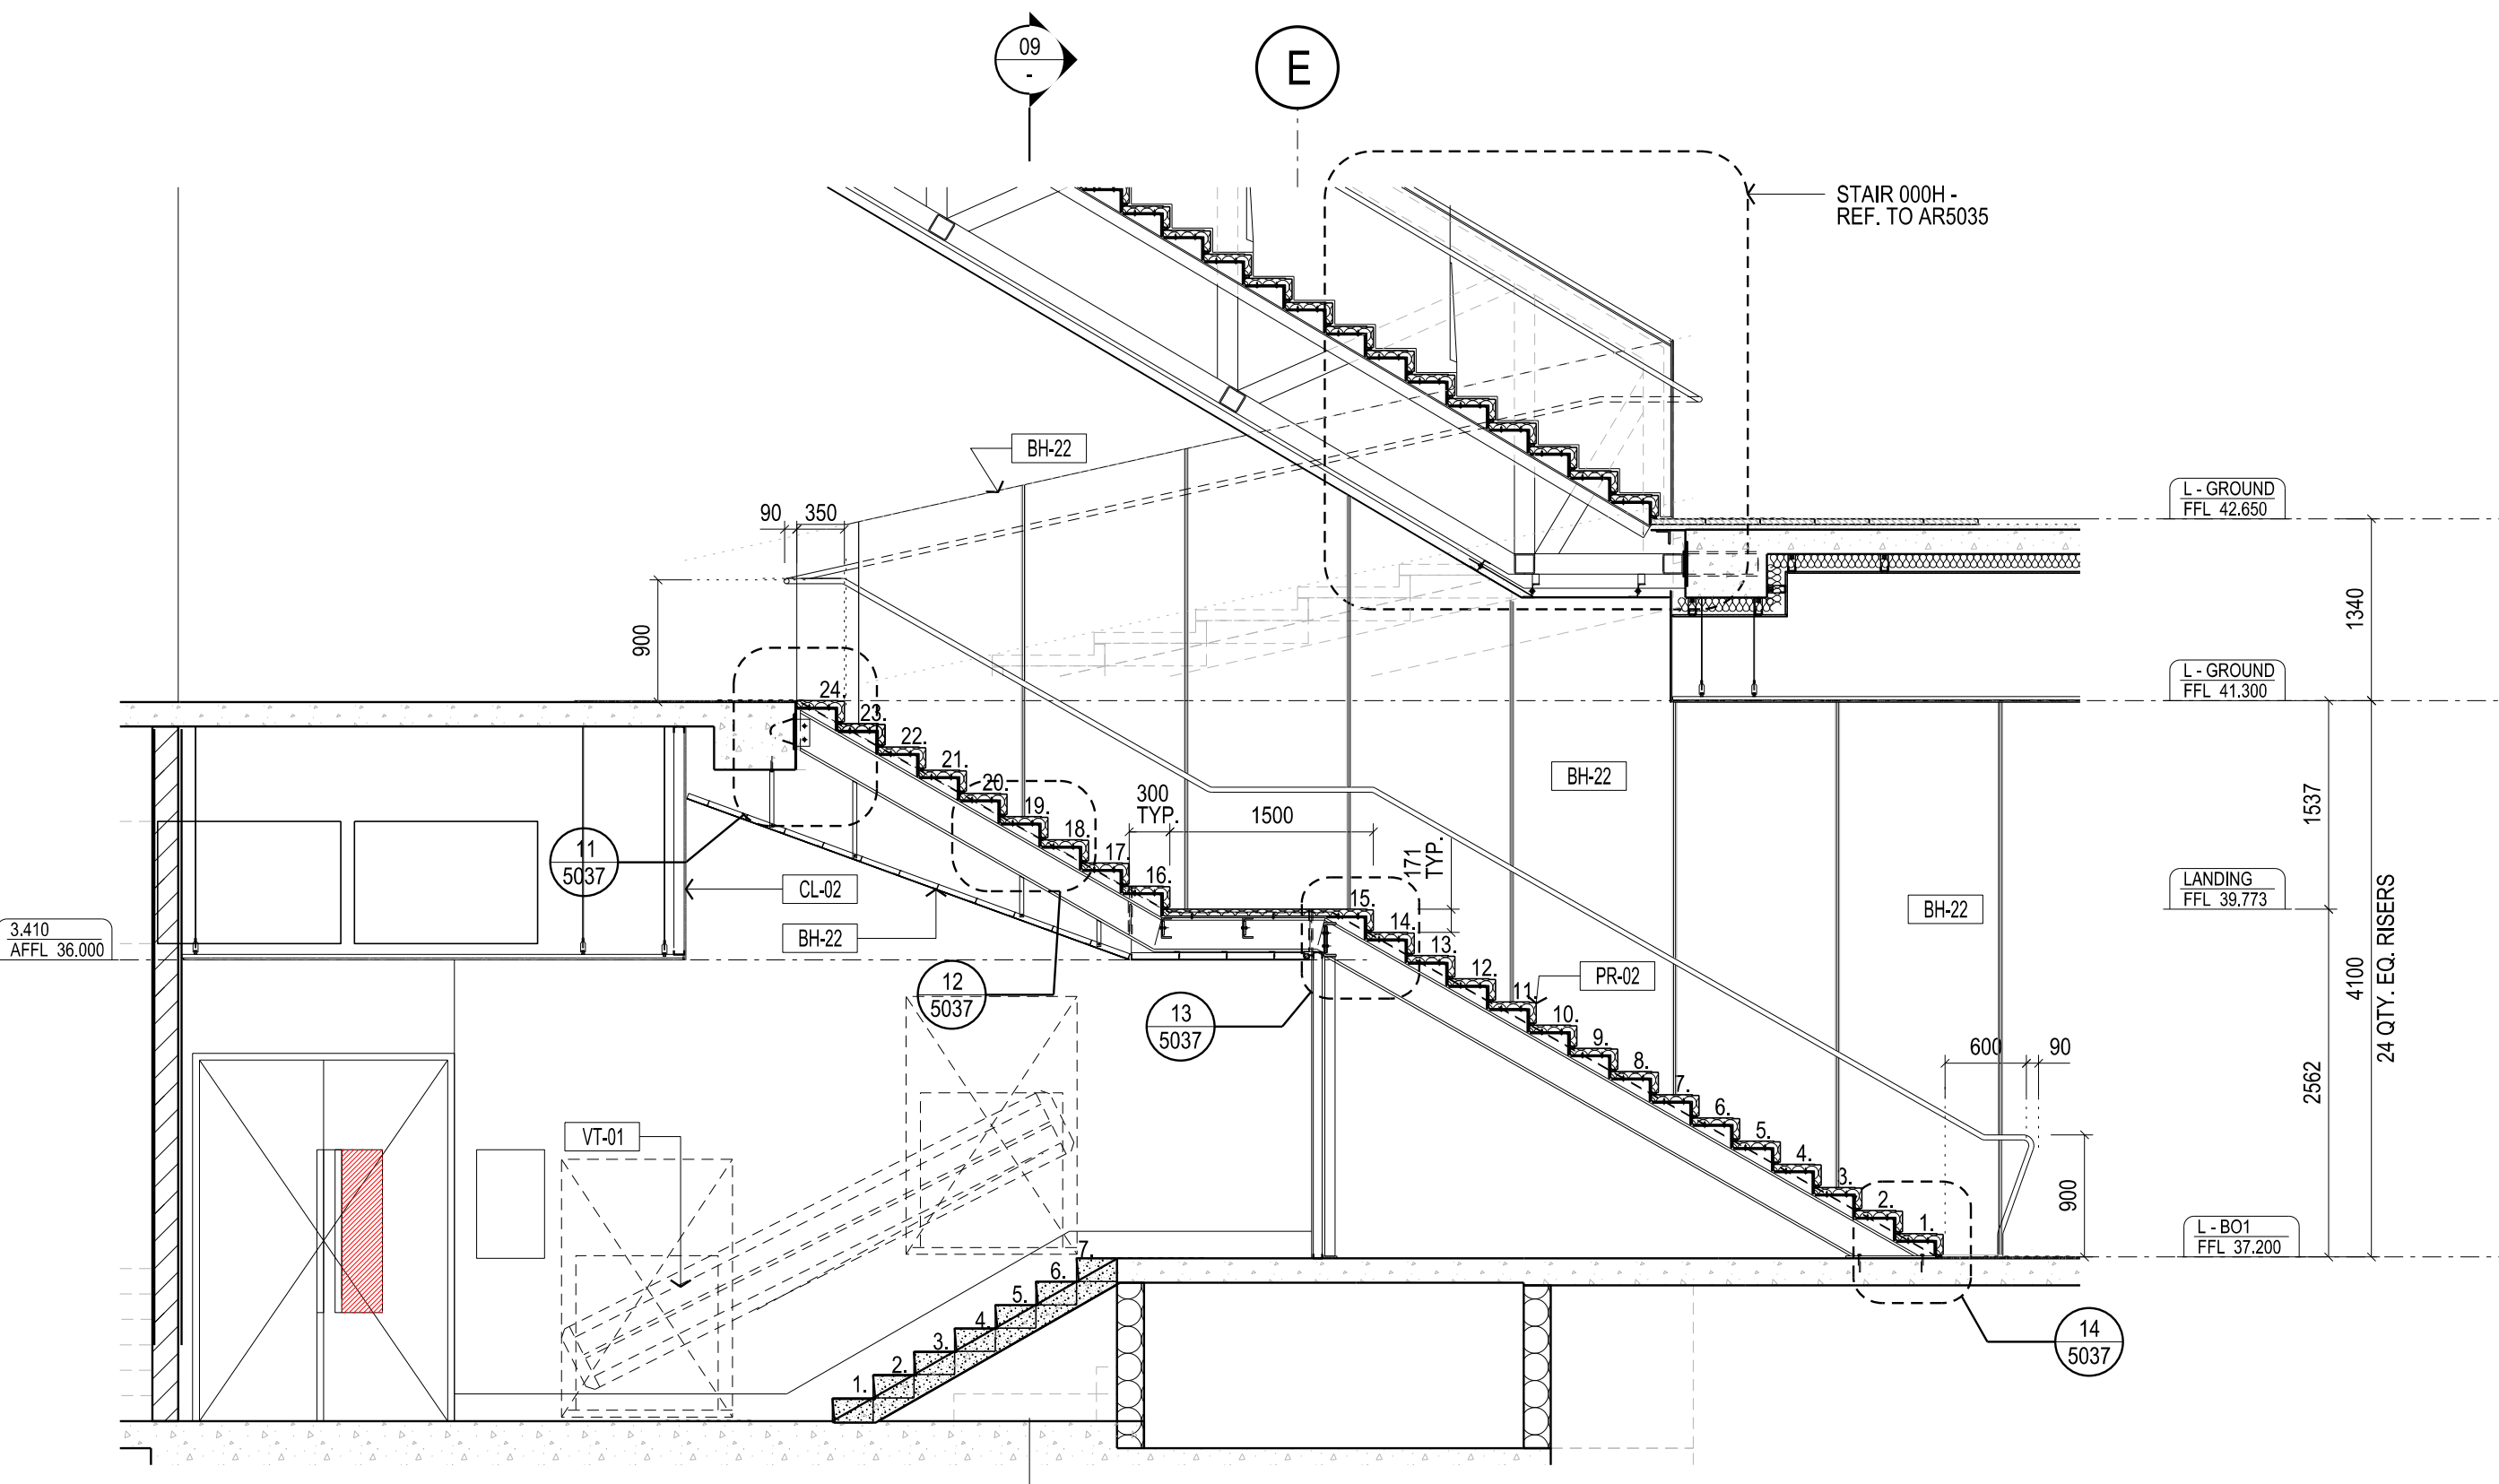


05 STAIR 000G & 000F - SECTION
SCALE 1:50

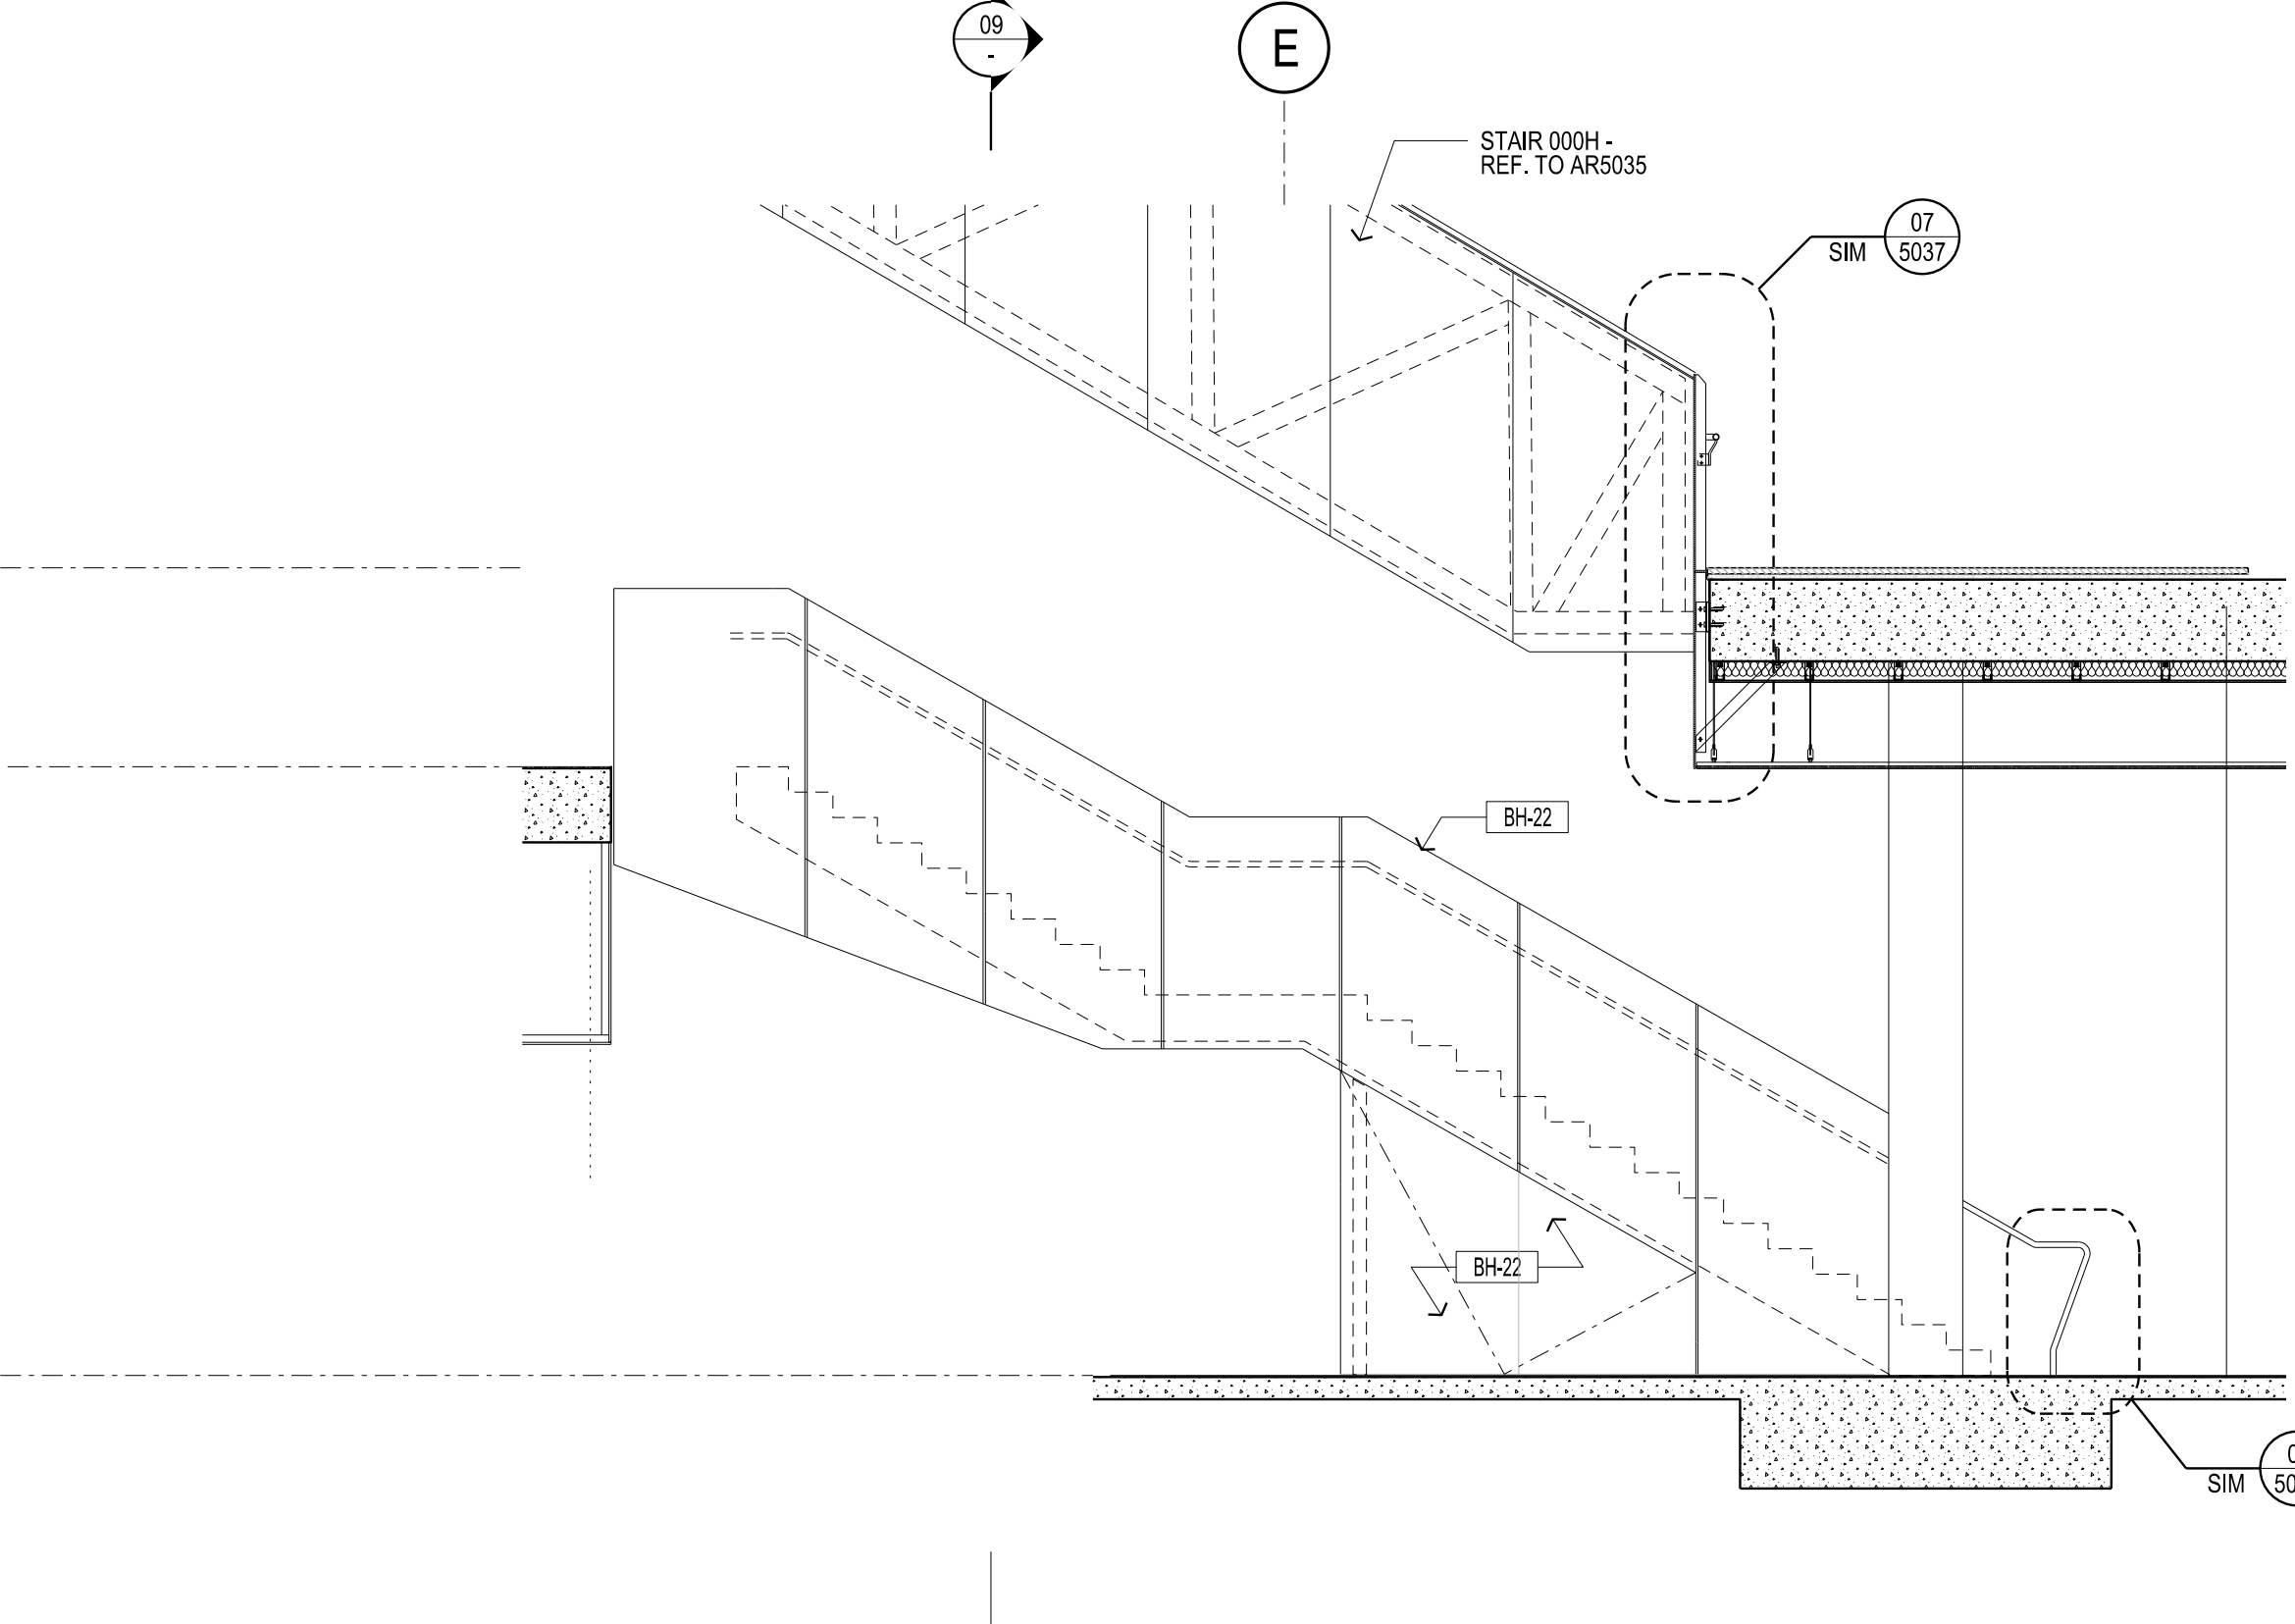


06 STAIR 000G & 000F - SECTION / ELEVATION
SCALE 1:50

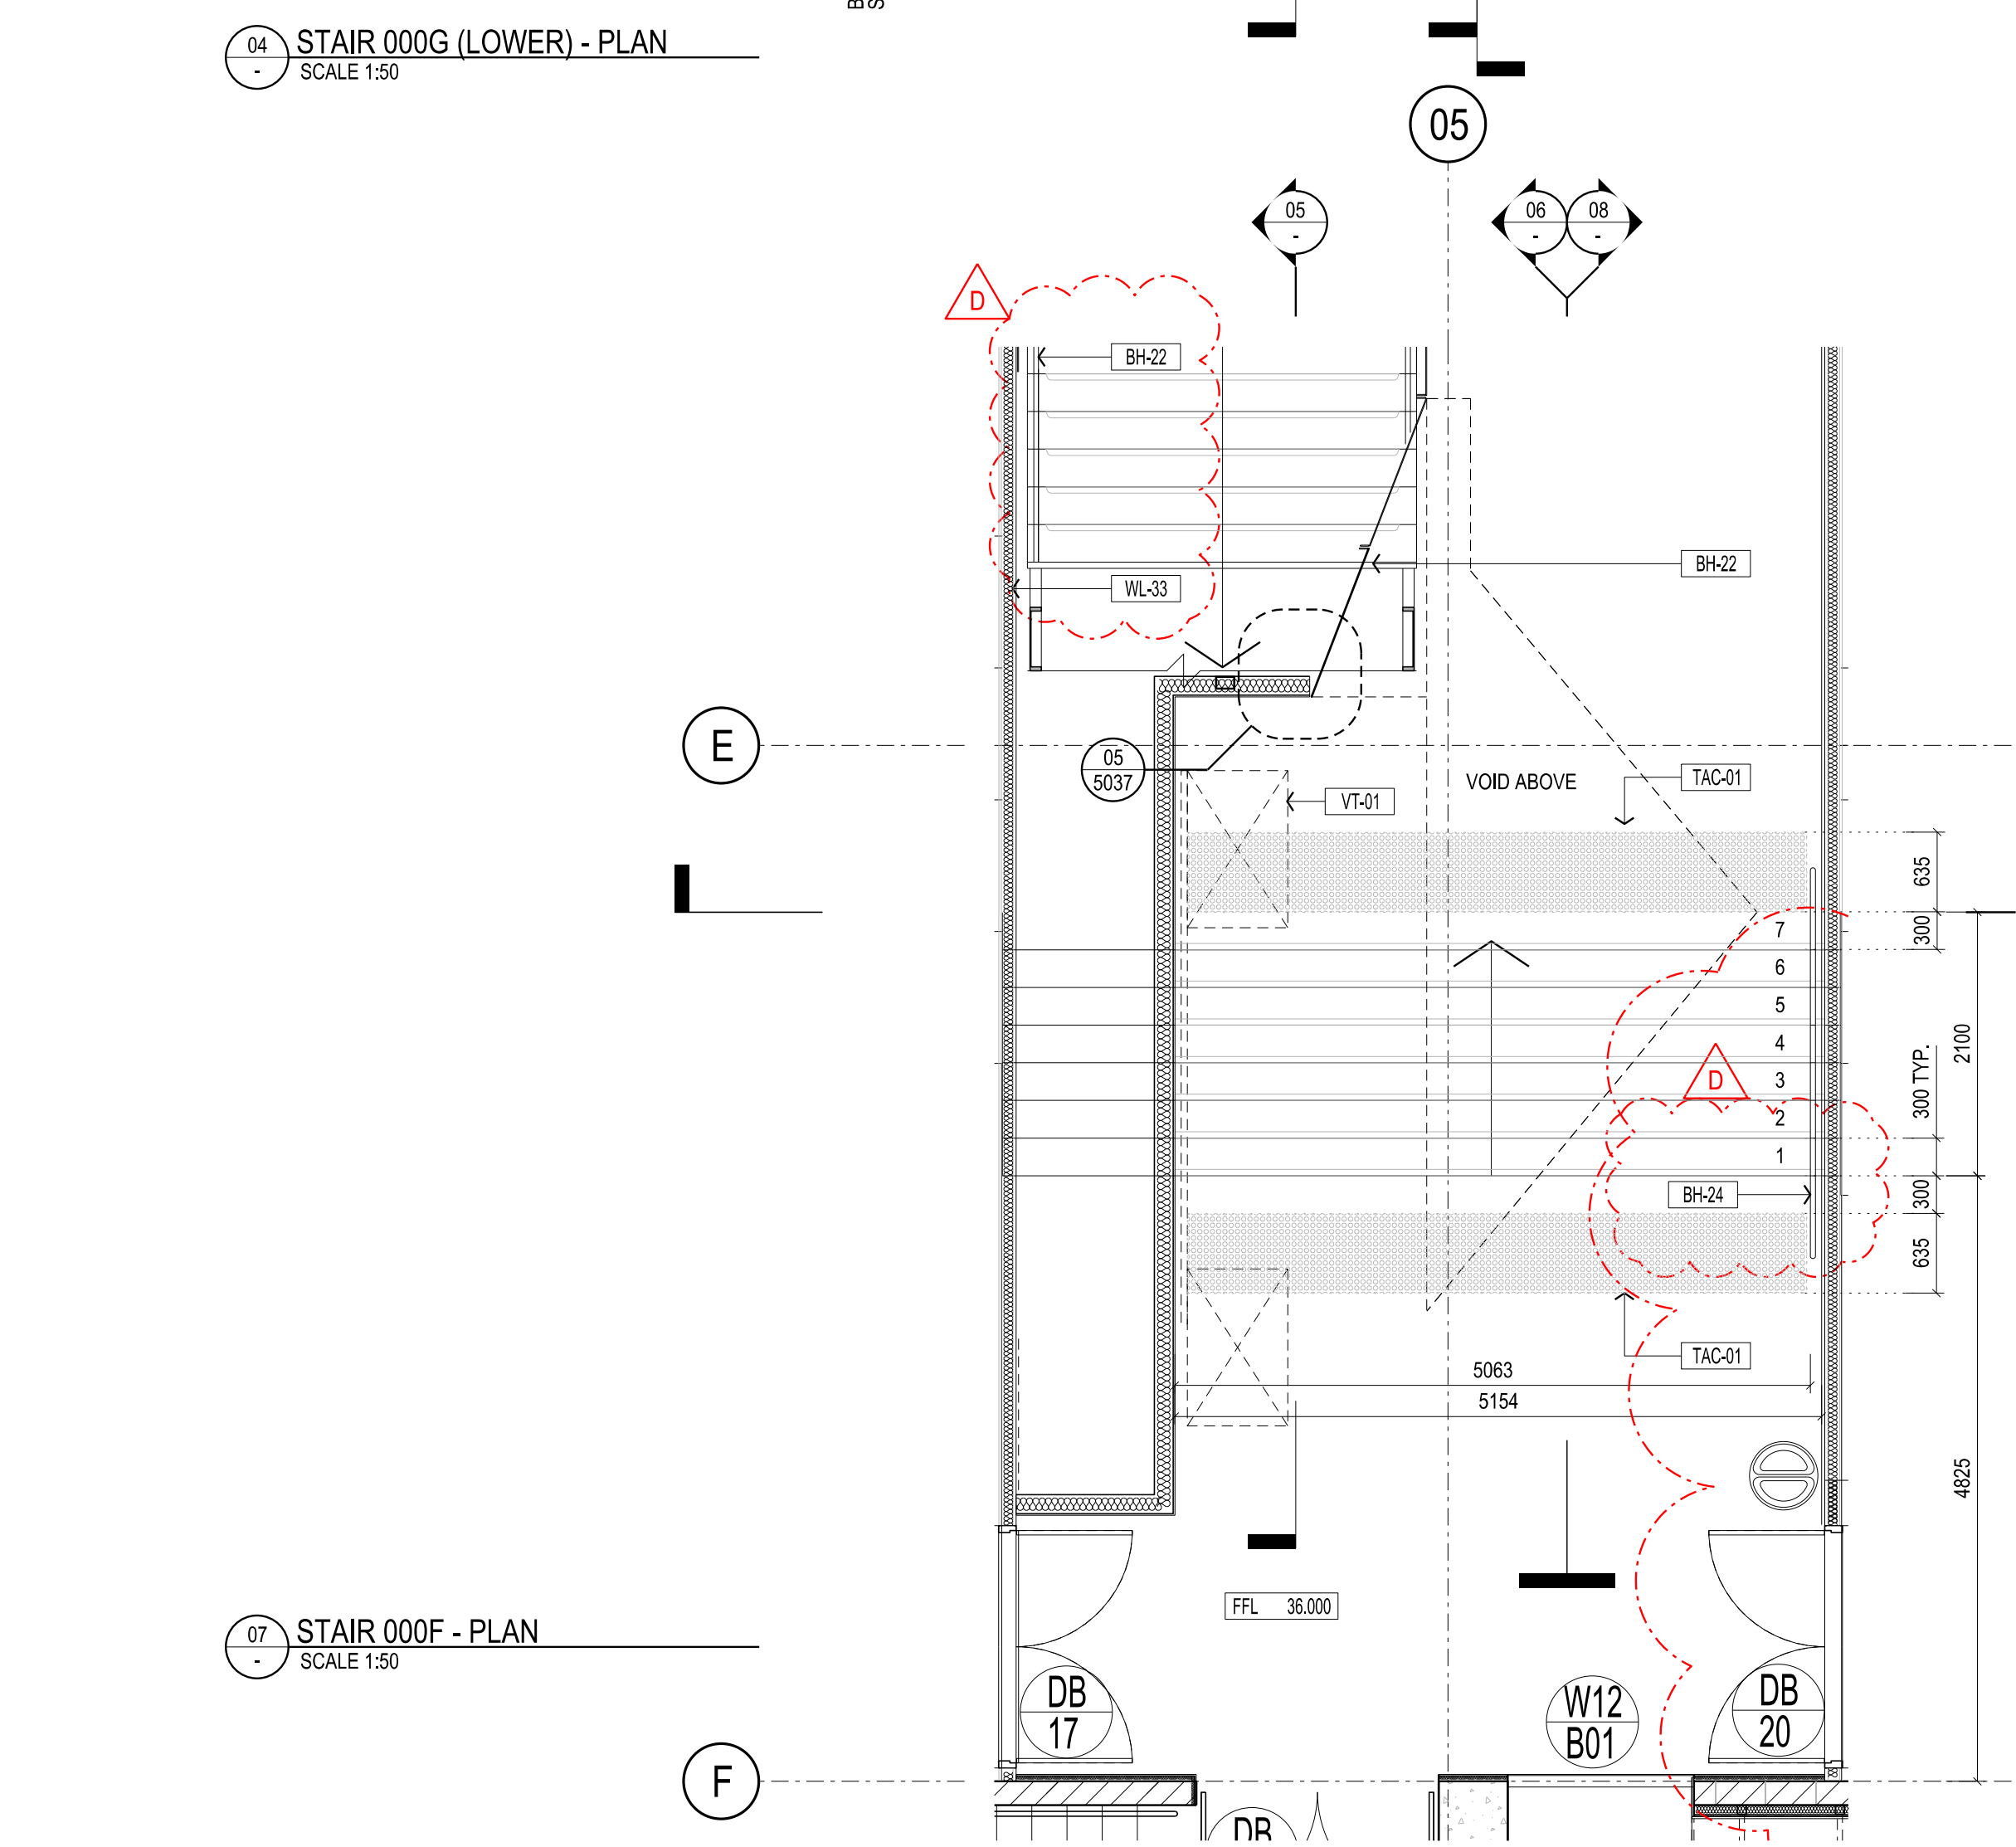

07 STAIR 000F - PLAN
SCALE 1:50

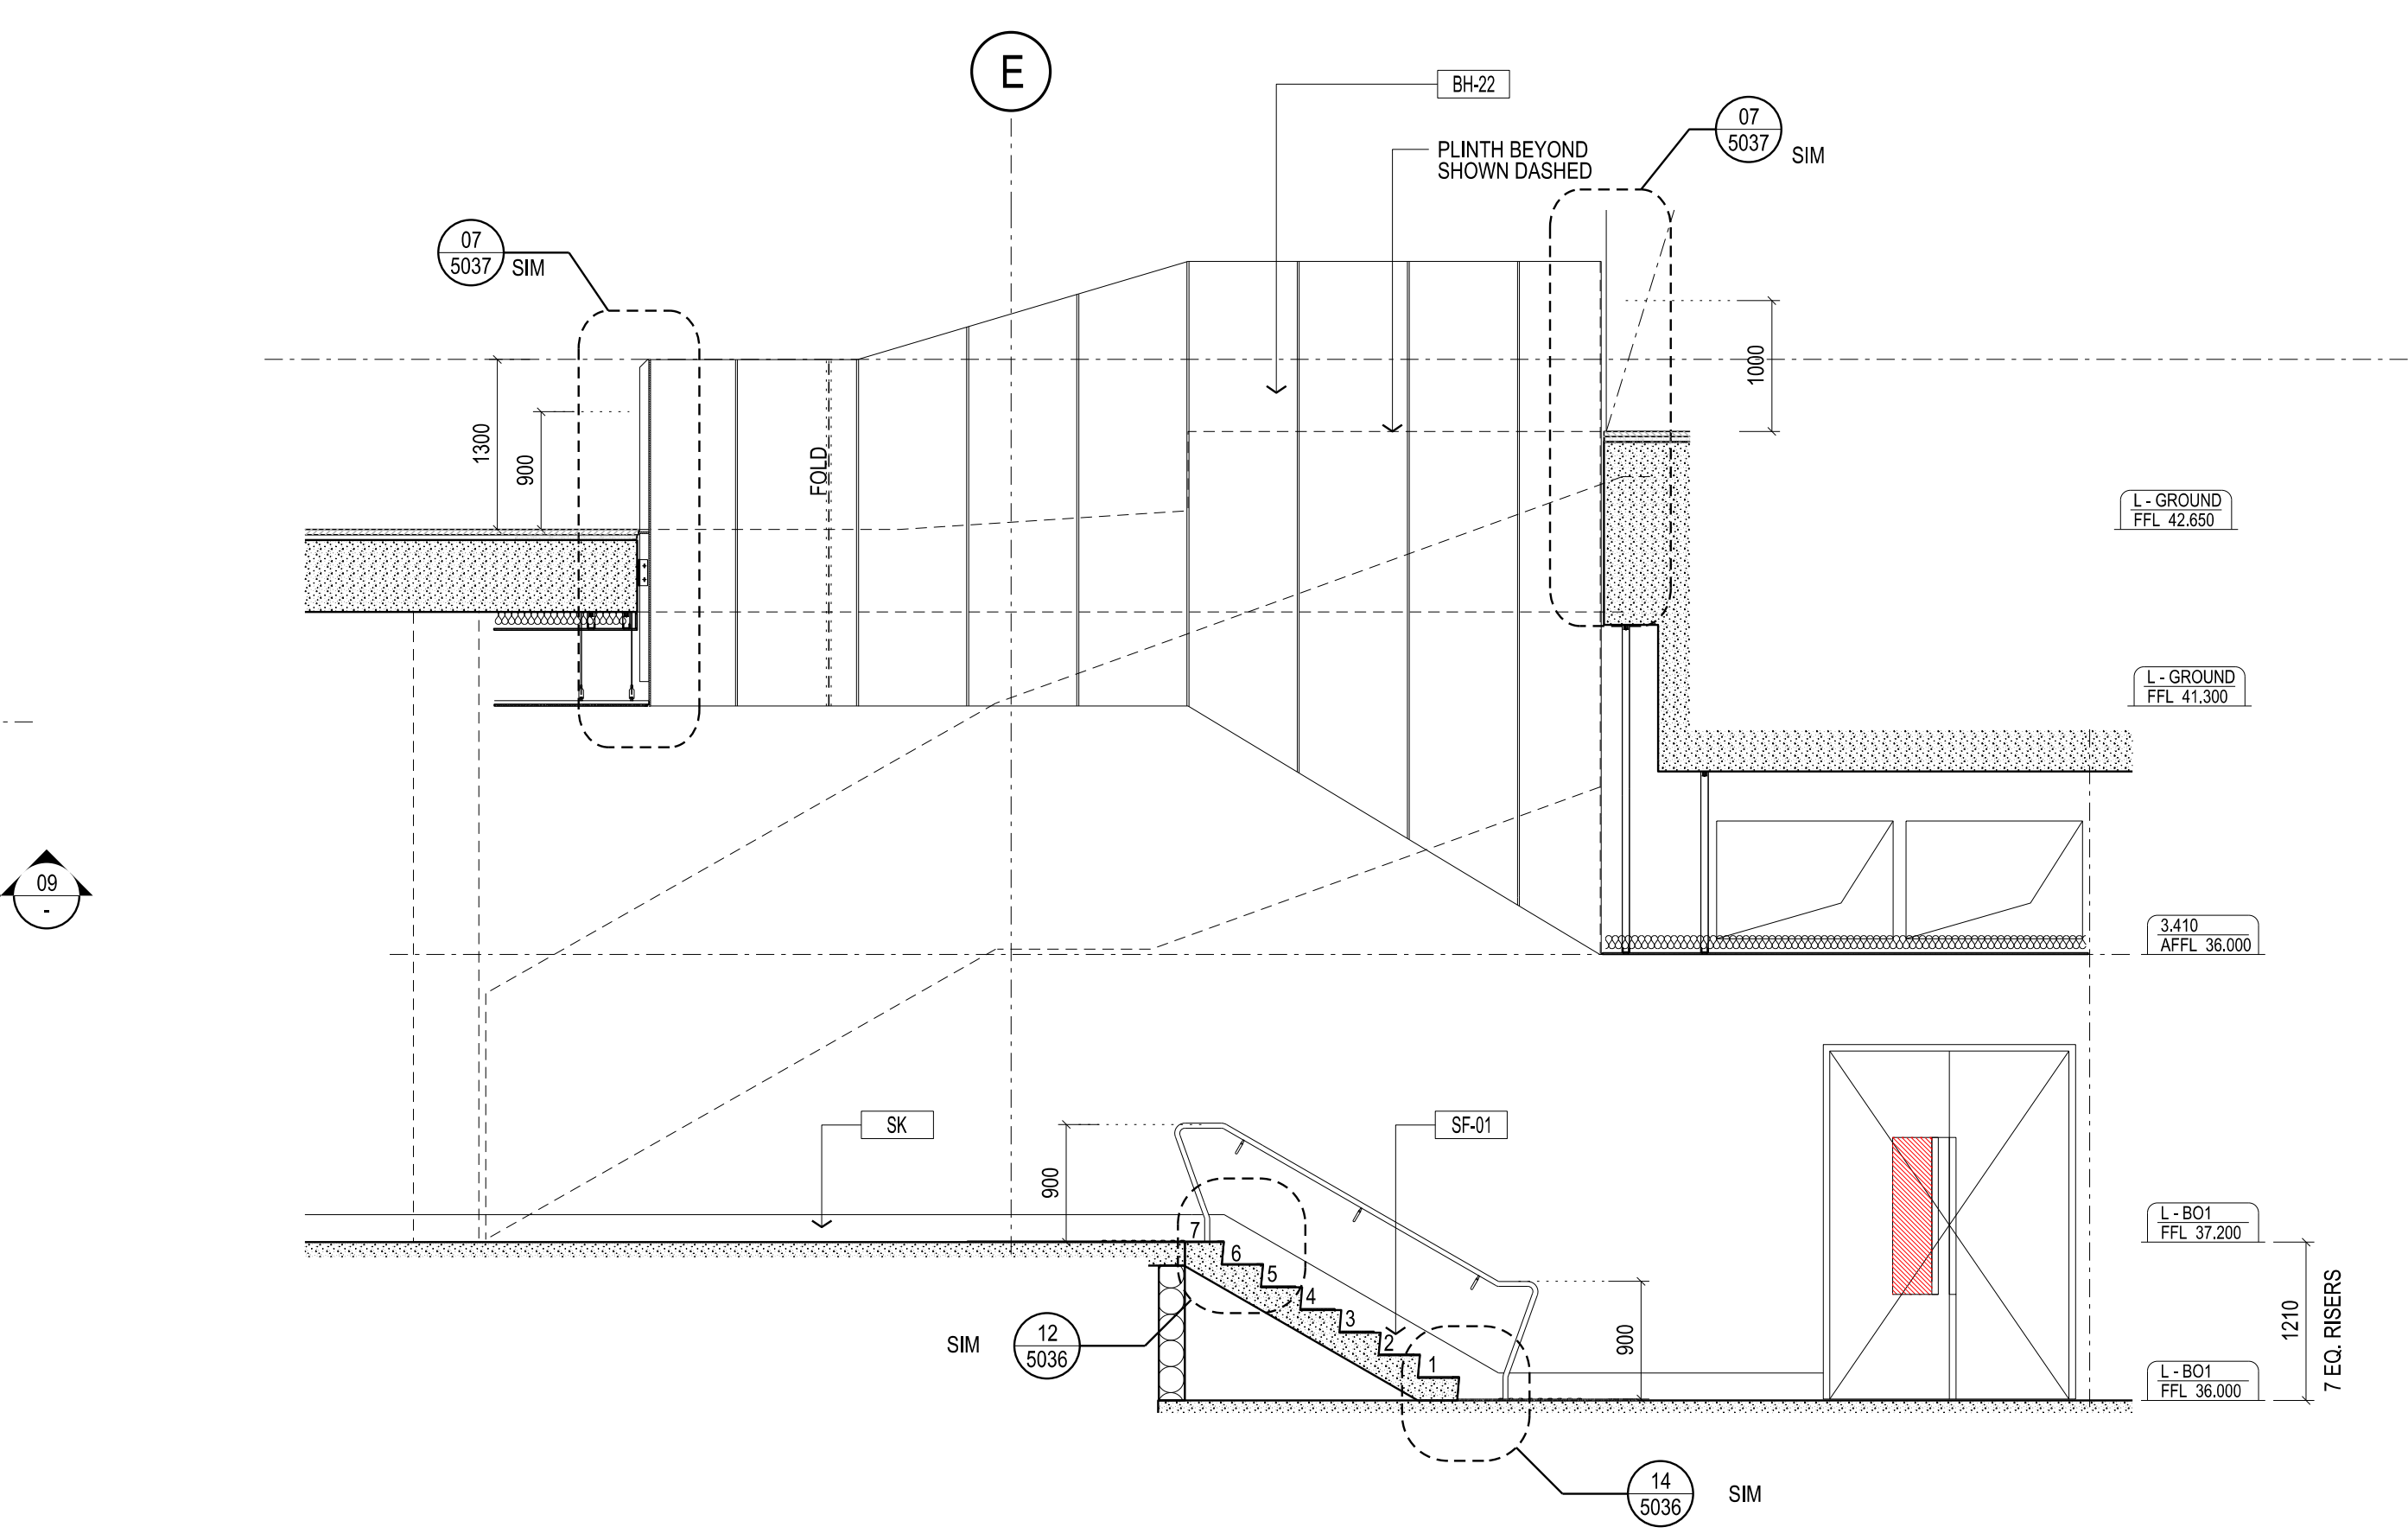

08 STAIR 000F - SECTION
SCALE 1:50

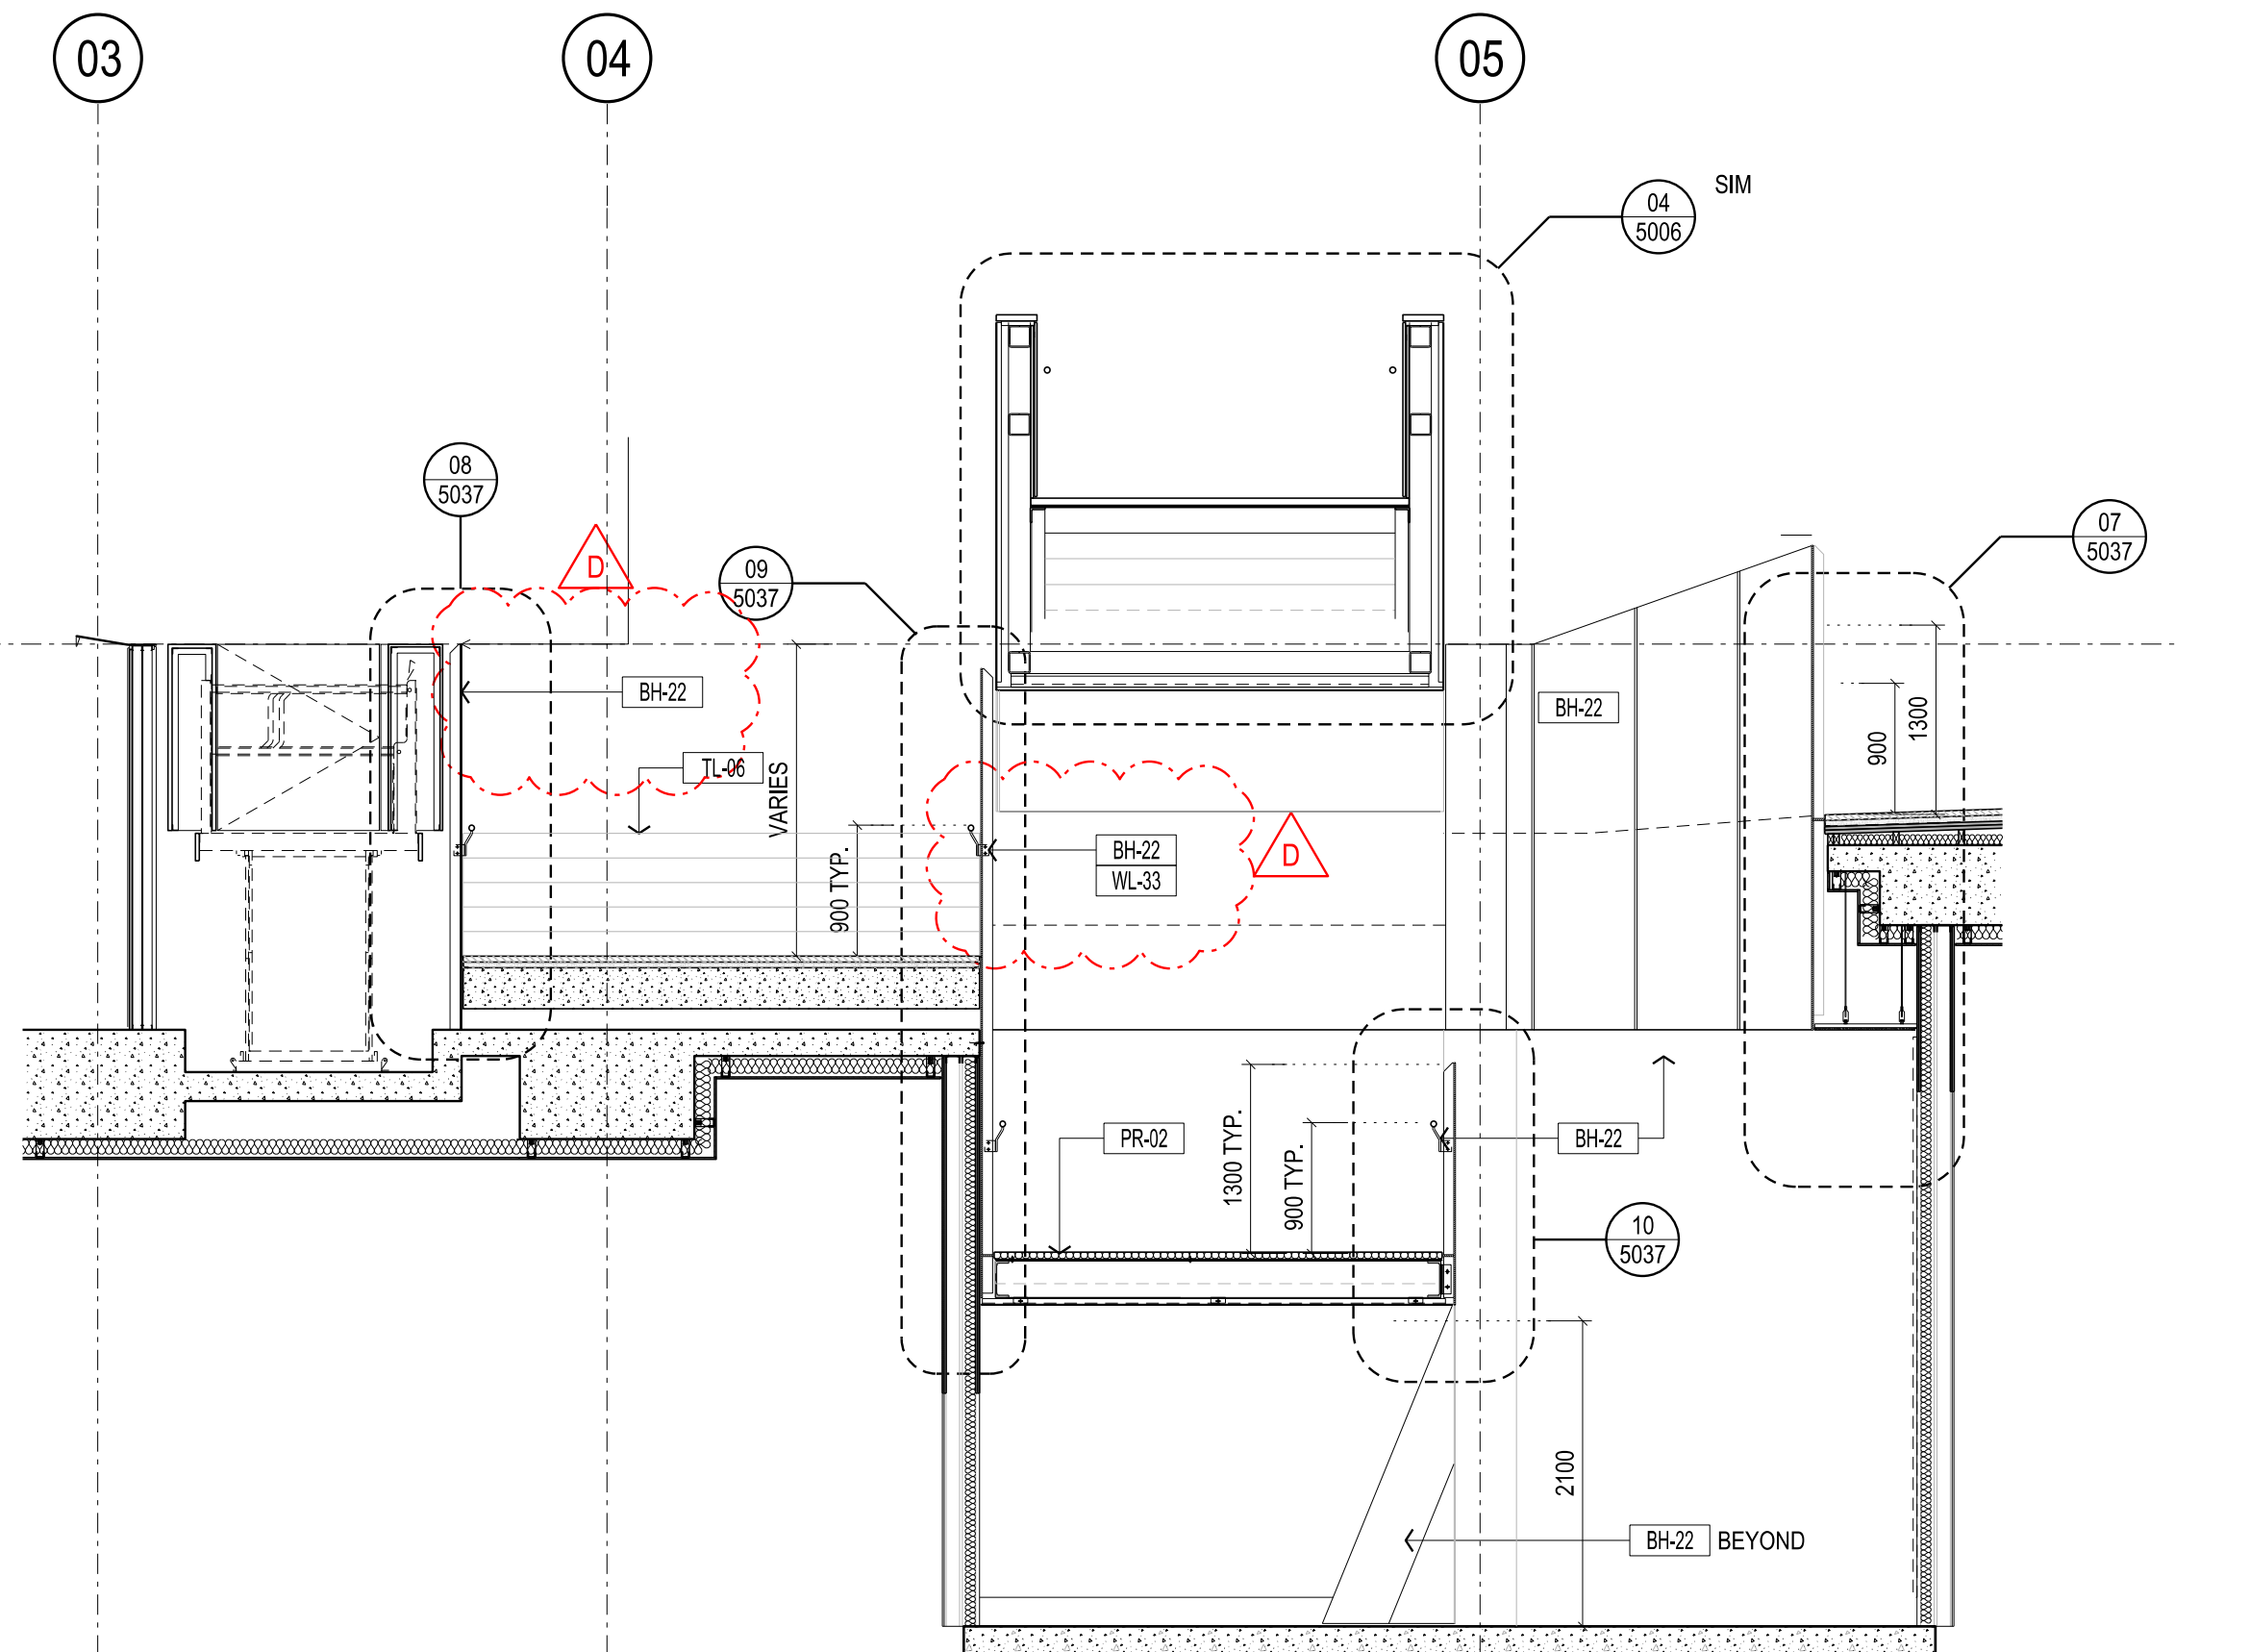

09 STAIR 000G, 000H & 000F - SECTION
SCALE 1:50