



CONTRACTORS SHALL VERIFY JOB DIMENSIONS BEFORE ANY JOB COMMENCES. ALL SHOP DRAWINGS SHALL BE SUBMITTED TO THE SUPERINTENDENT AND MANUFACTURE SHALL NOT COMMENCE PRIOR TO THE RETURN OF DIMENSIONED SHOP DRAWINGS SIGNED BY THE CONSULTANT. FIGURED DIMENSIONS SHALL TAKE PRECEDENCE OVER SCALED. THIS DRAWING SHOULD BE READ IN CONJUNCTION WITH ALL RELEVANT CONTRACT SPECIFICATIONS AND DRAWINGS COPYRIGHT OF THIS DRAWING IS VESTED IN WARDLE

General Notes

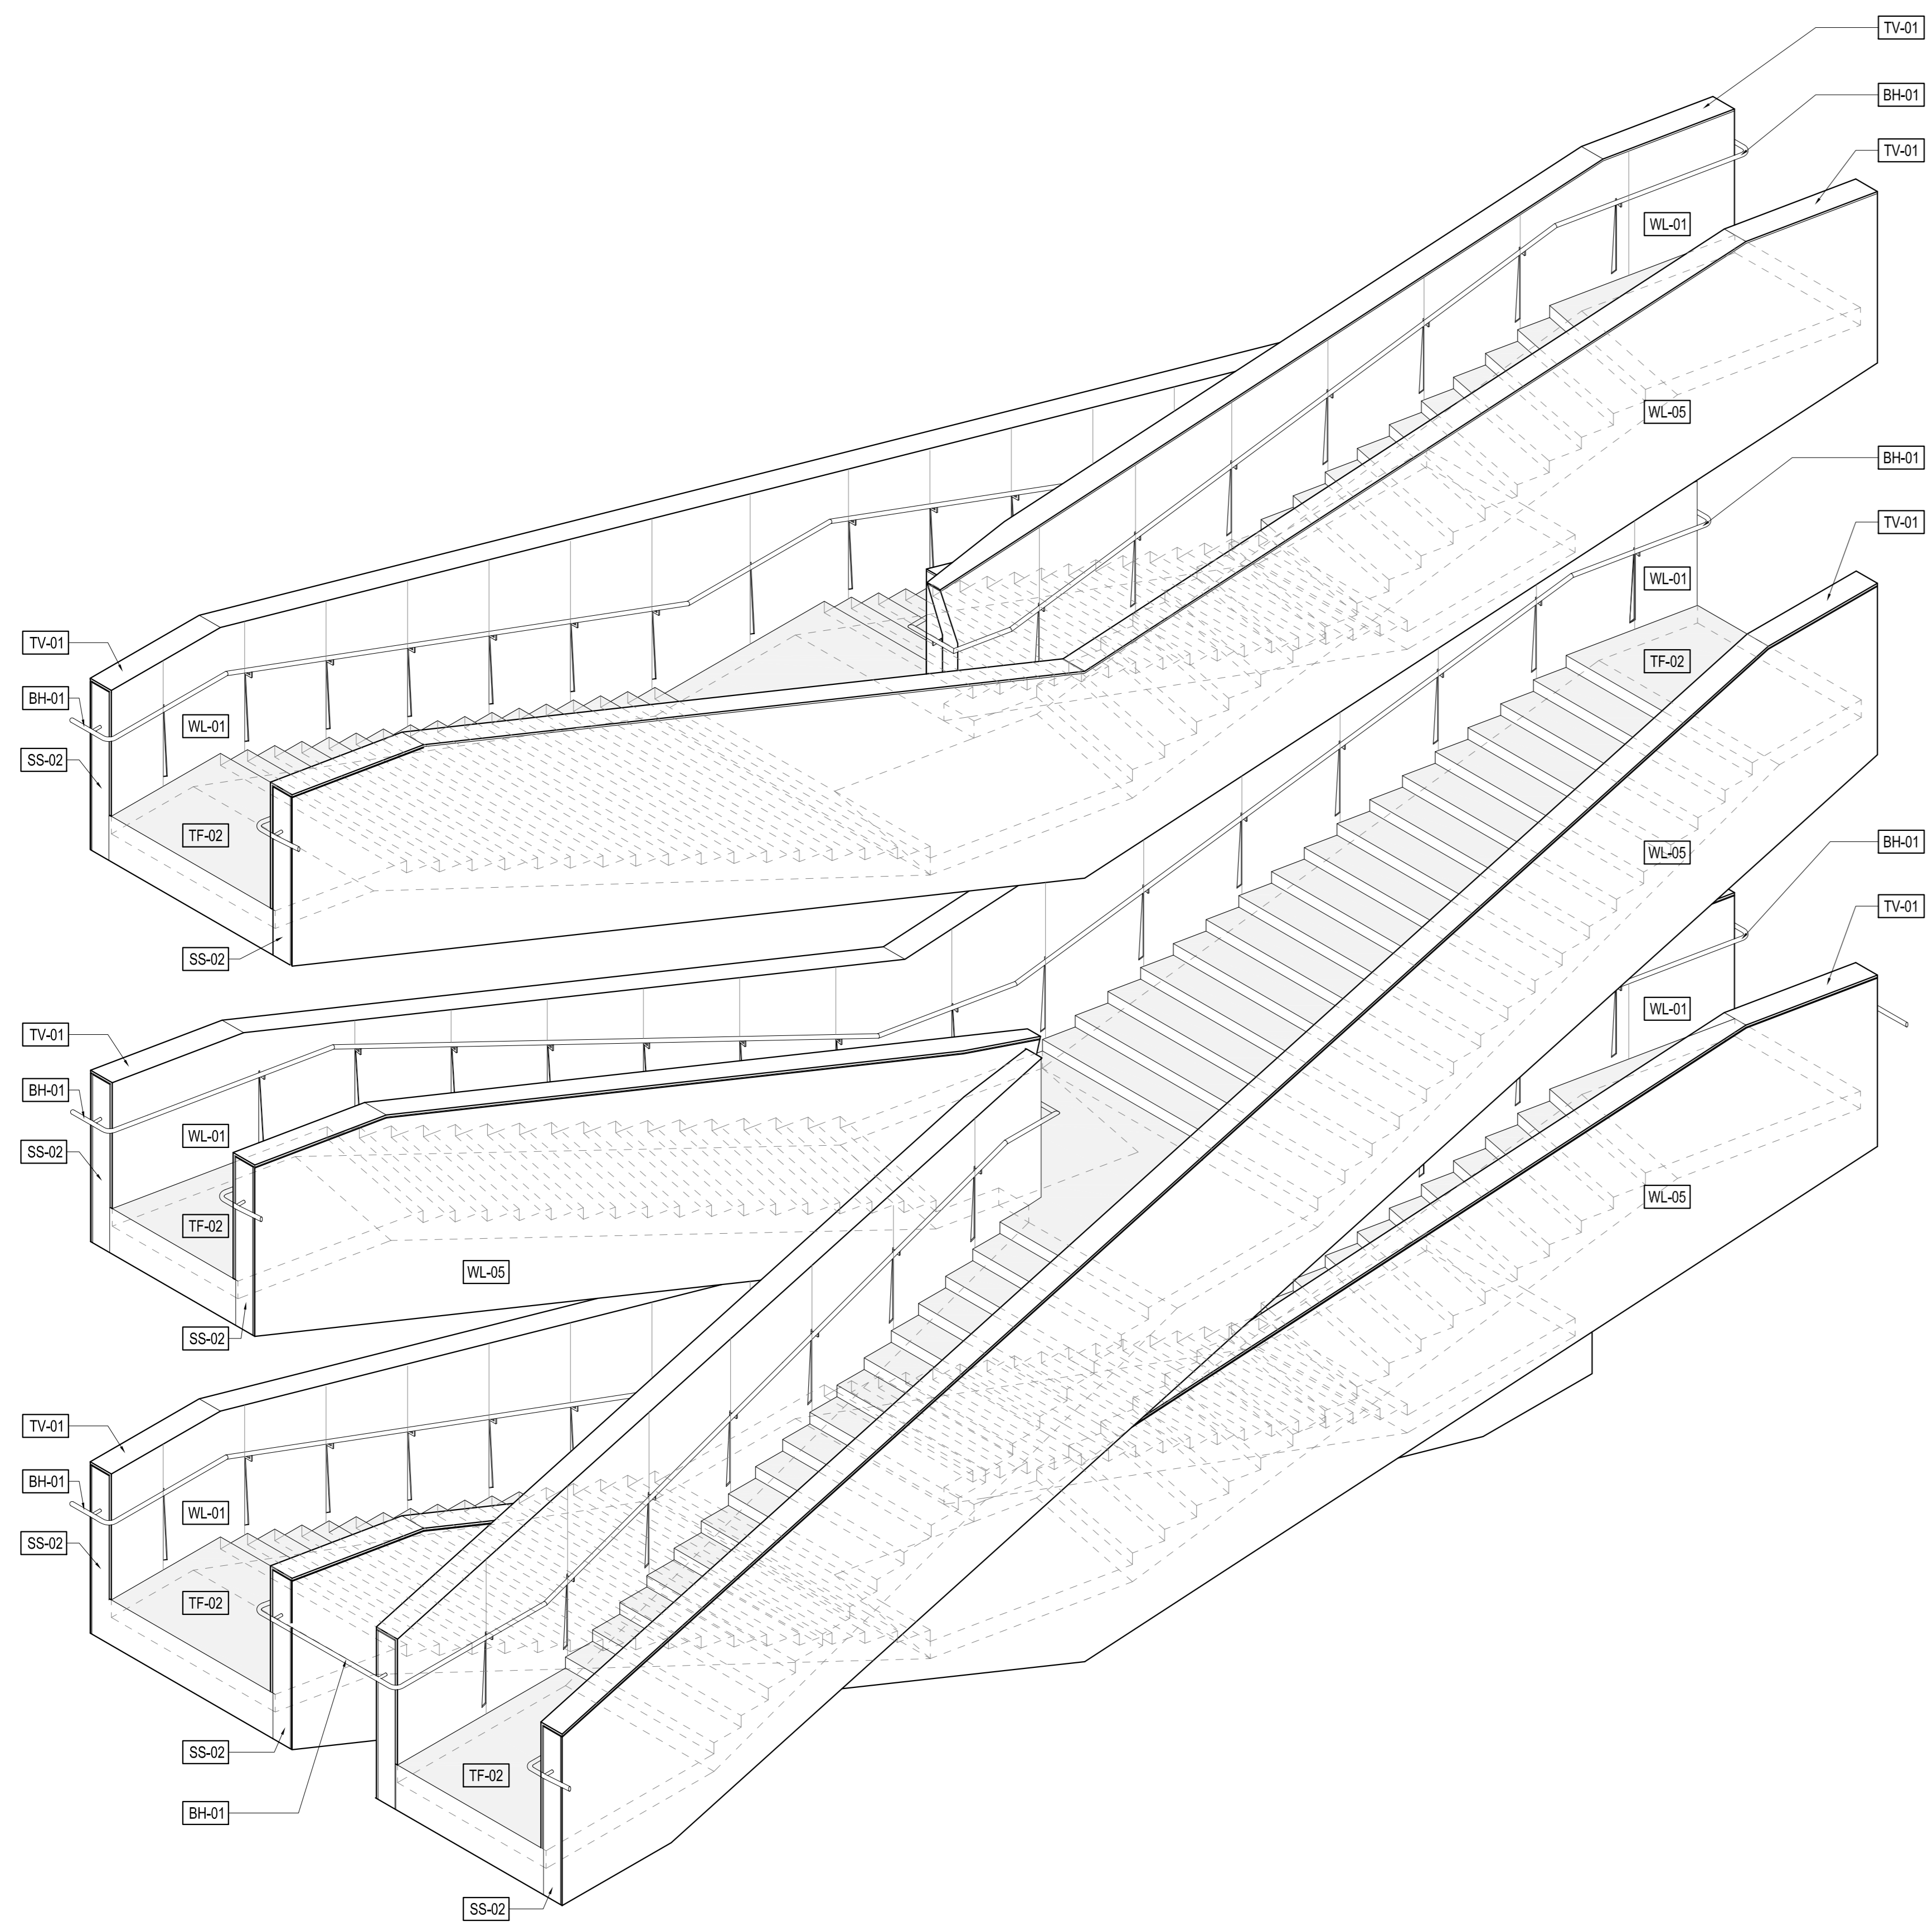


01 AXONOMETRIC DIAGRAM OF 000H STAIR  
N.T.S.

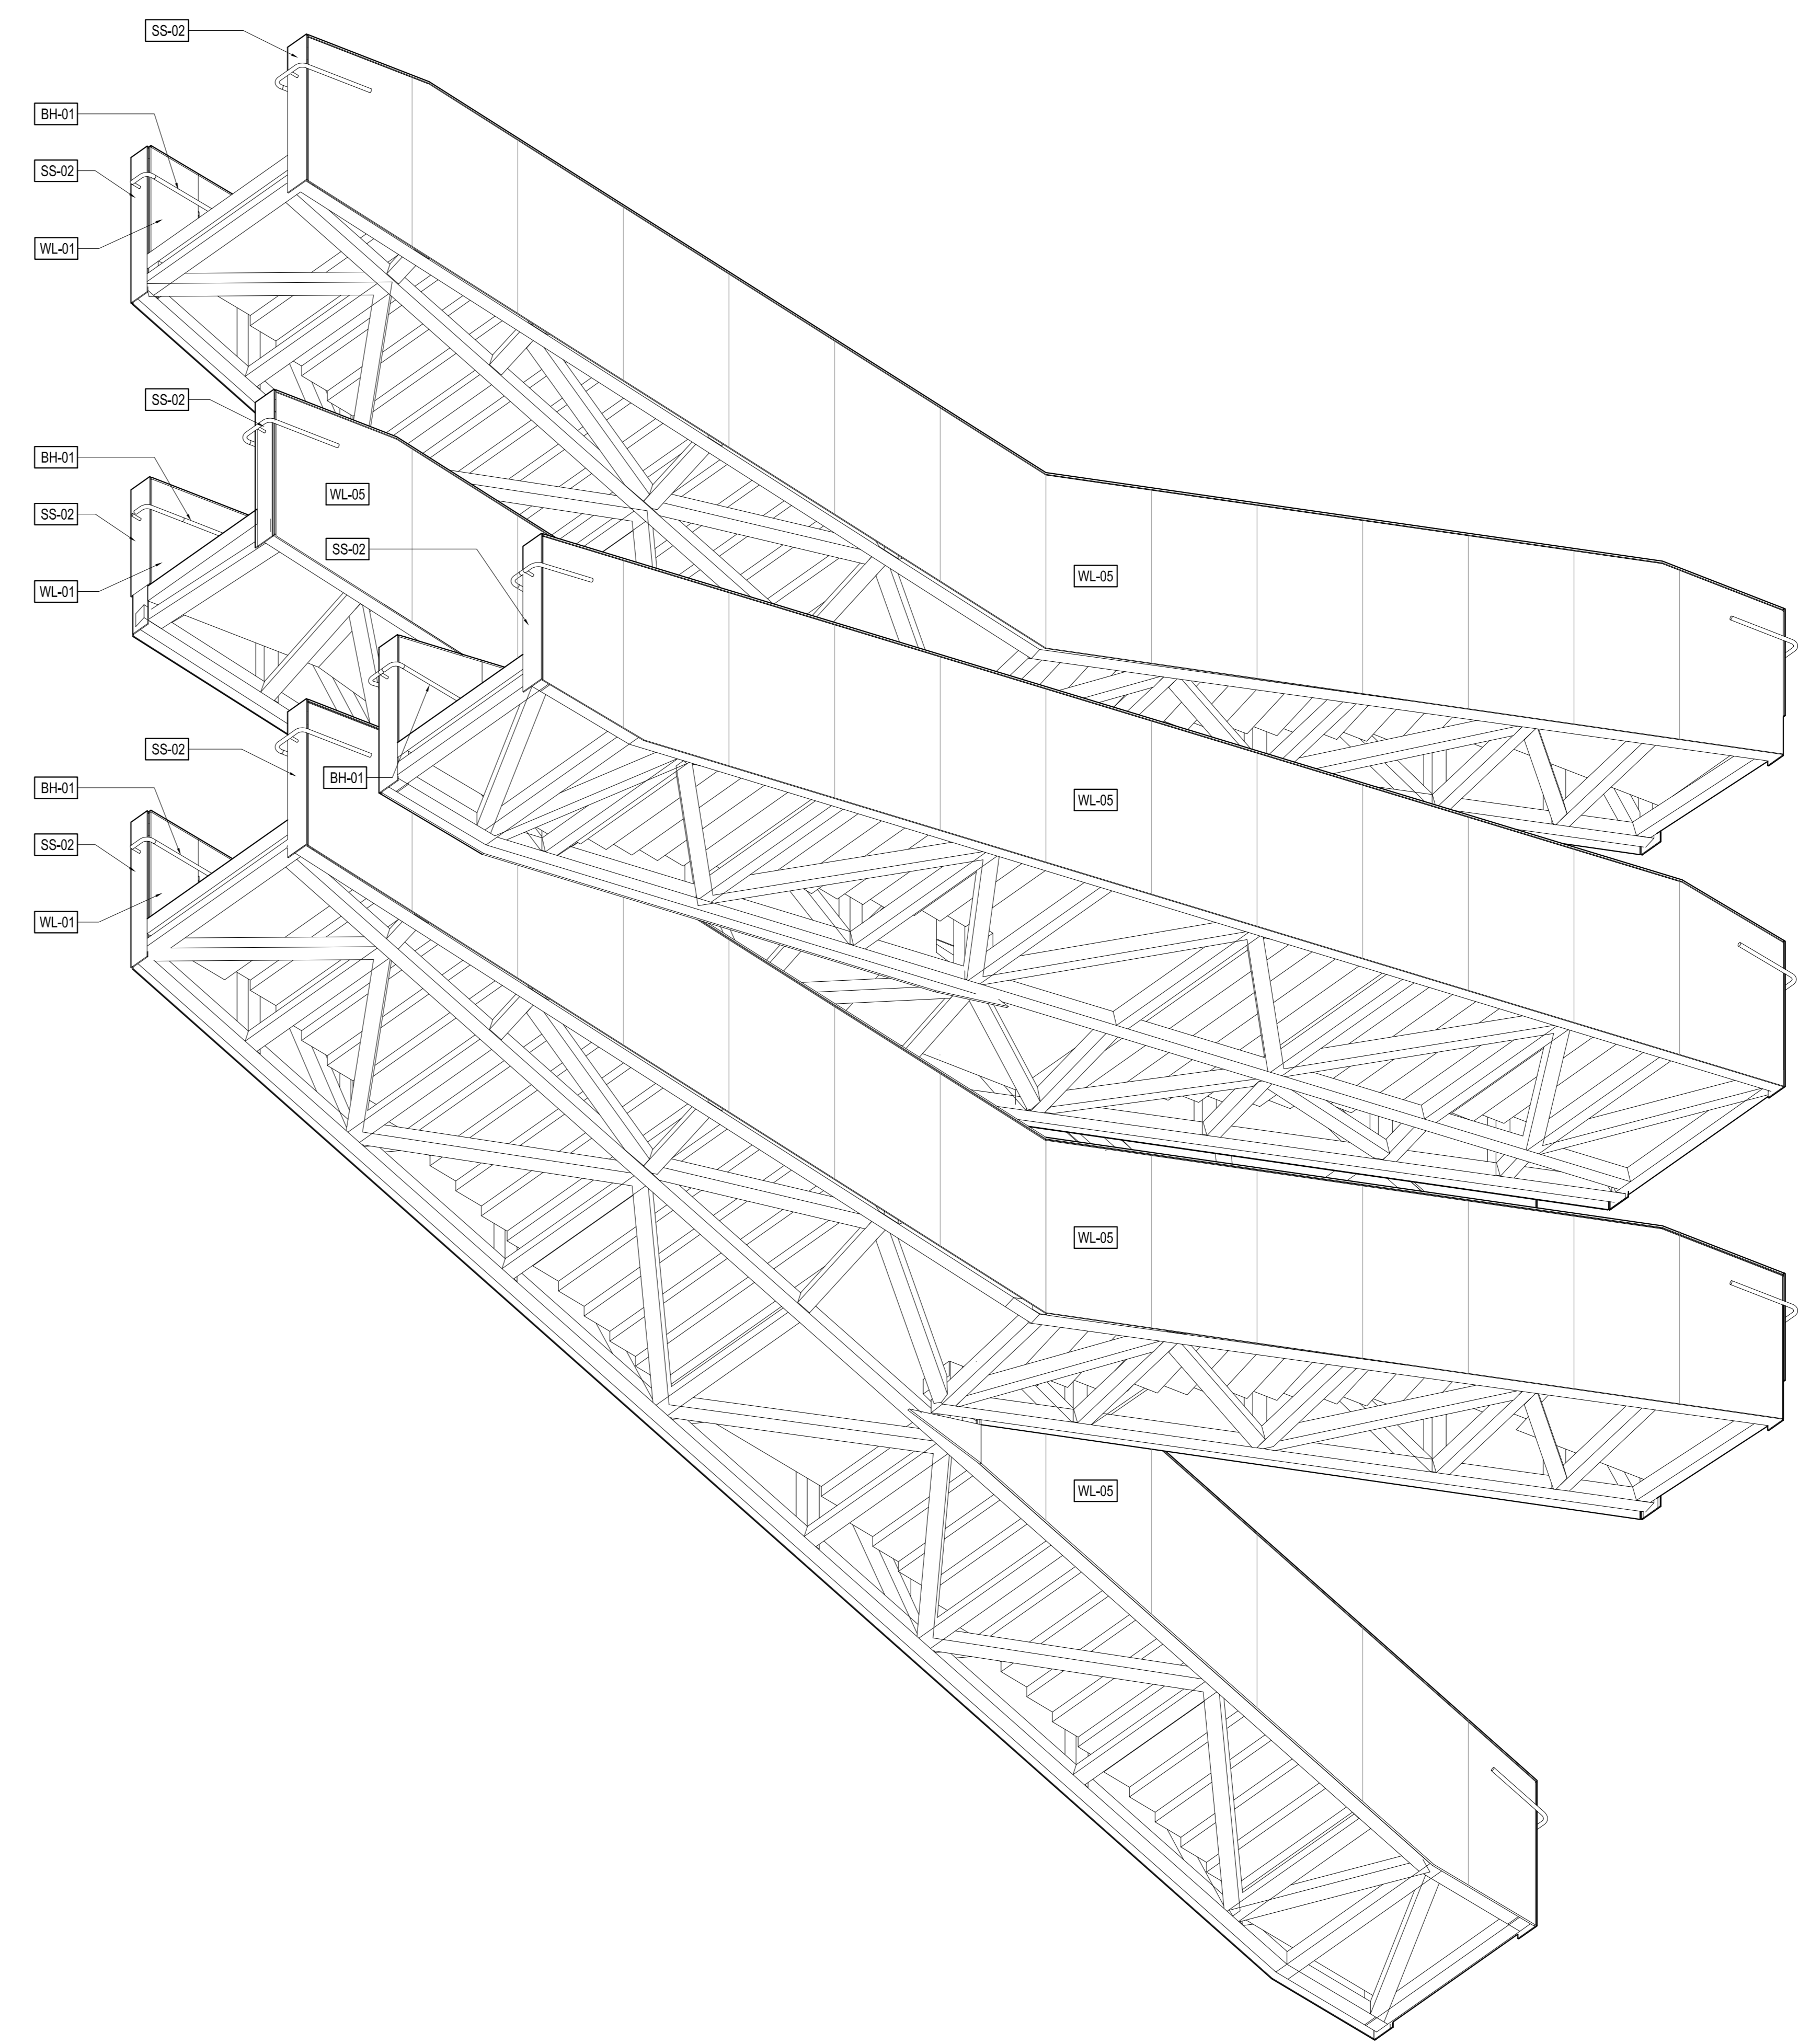

02 WORM'S EYE DIAGRAM OF 000H STAIR  
N.T.S.

A	SG	CONSTRUCTION ISSUE	01.06.14
07	JC	100% CD - TENDER ISSUE	07.09.12
06	JC	90% CD ISSUE	10.05.12
05	JC	75% CD ISSUE	13.07.12
04	JC	50% CD ISSUE	01.06.12
03	JC	FINAL DD ISSUE	24.02.12
02	JC	DESIGN DEVELOPMENT ISSUE	20.01.12
01	JC	DESIGN DEVELOPMENT ISSUE	22.12.11

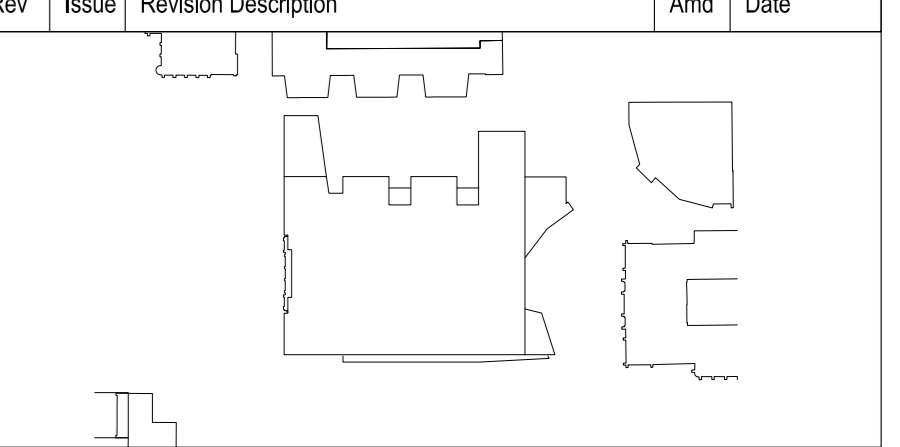

NADAAA

NADAAA  
1302 Washington Street No.2  
Boston  
Massachusetts  
02118 USA

Telephone  
+1 617 442 0232  
Facsimile  
+1 608 462 1417  
Email  
nadaa@nadaaa.com

**John Wardle Architects**

© 2011 John Wardle Architects  
Level 10, 180 Russell Street, Melbourne Victoria 3000 Australia  
Tel : +613 9654 8700 www.johnwardlearchitects.com

Client **University of Melbourne  
Parkville Campus**

Project **Faculty of Architecture  
Building and Planning**

Title **3D VIEWS  
000H STAIR**

Project No.	<b>0913</b>	Scale	N.T.S.
Drawing No.	<b>AR5102</b>	Revision	<b>A</b>

Date JAN 2014 Dwnn - Co-Ord - Chk -

FILENAME - #####

**FOR CONSTRUCTION**