


01 AXONOMETRIC DIA GRAM OF JOSEPH REED FACADE

WORM'S EYE DIAGRAM OF JOSEPH REED FACADE N.T.S.

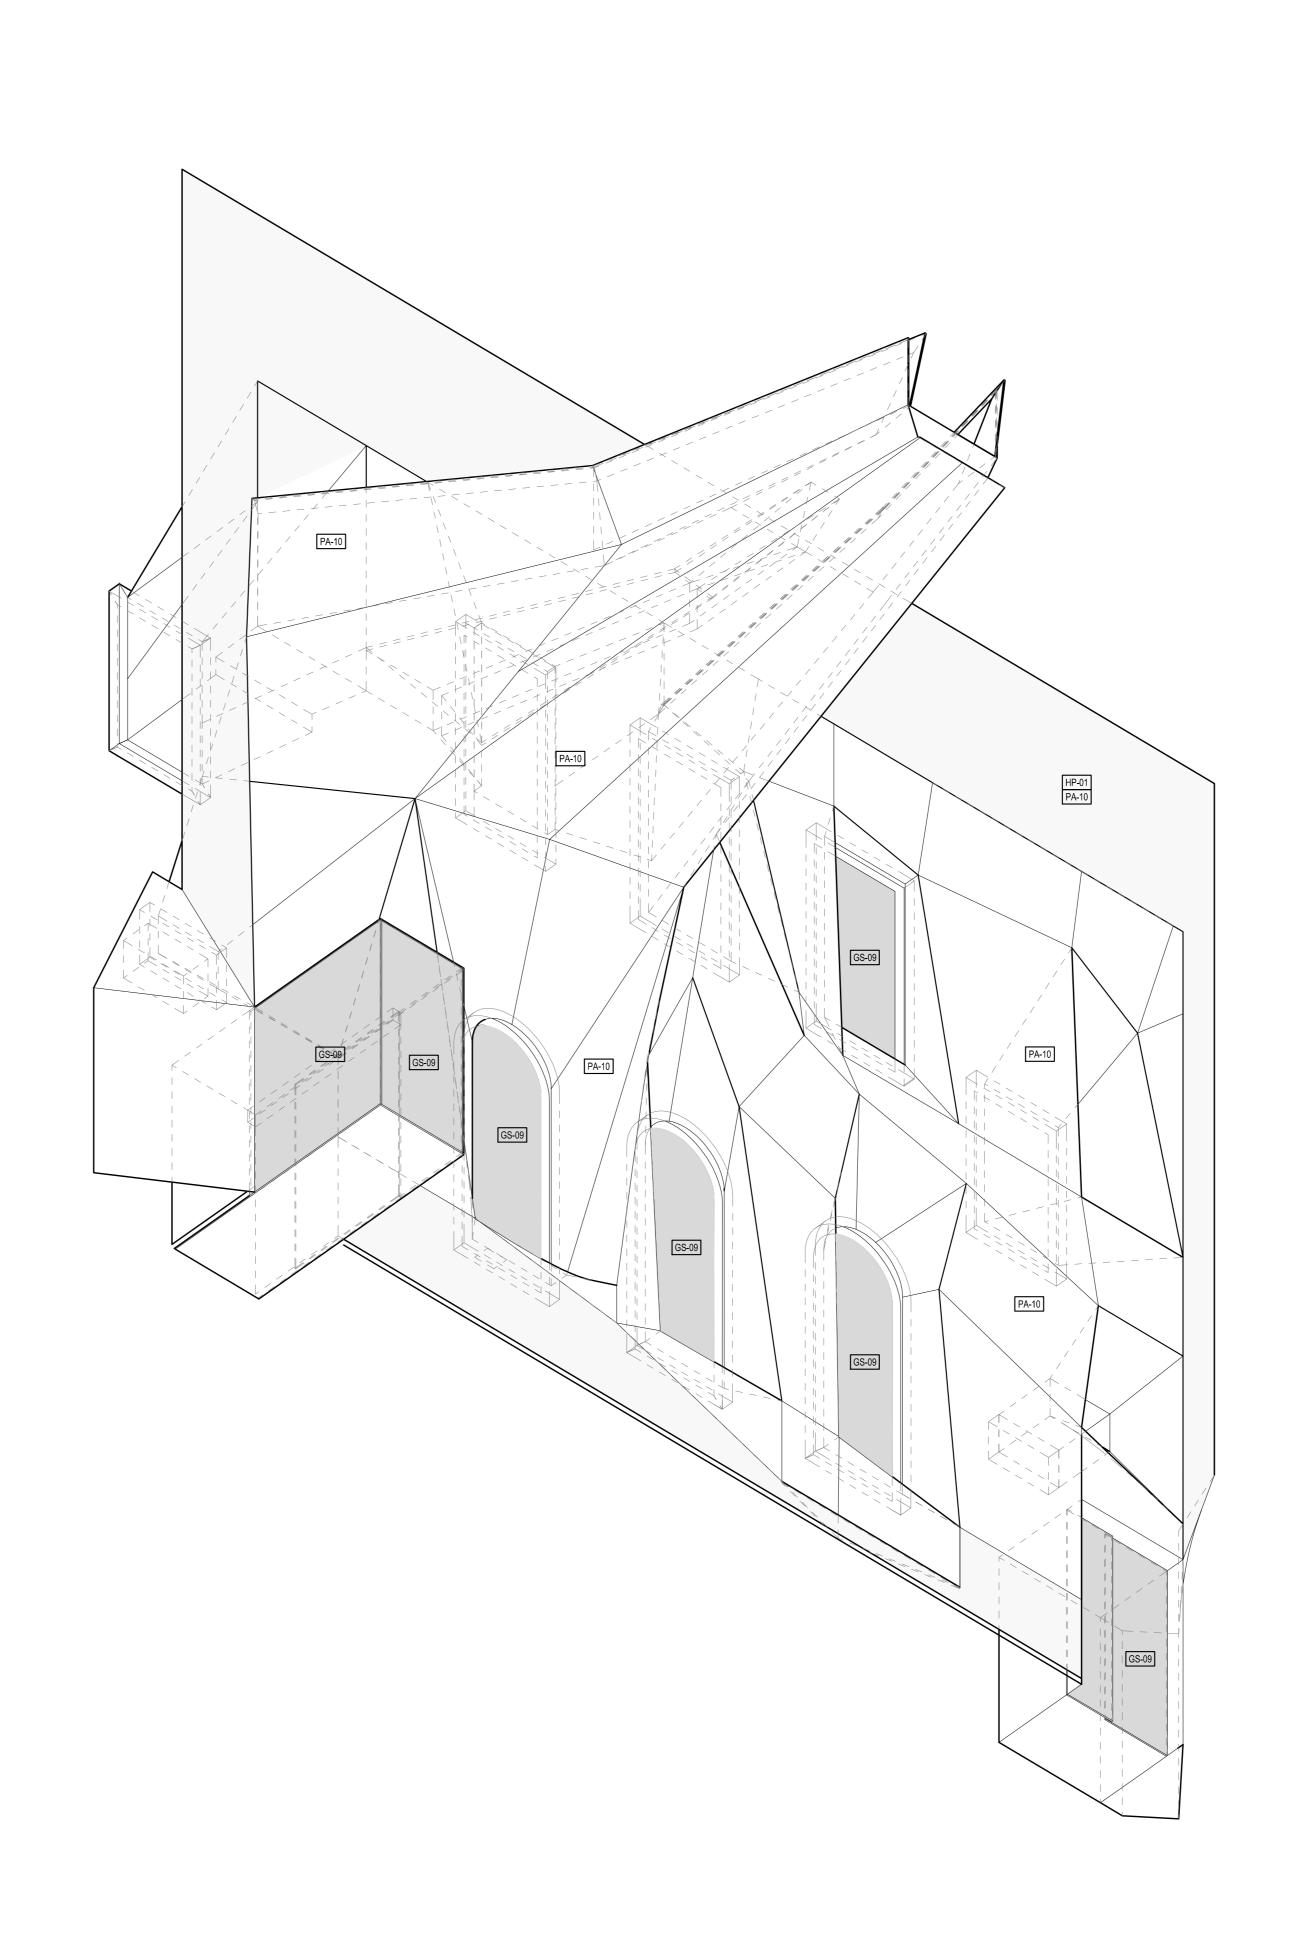

CONTRACTORS SHALL VERIFY JOB DIMENSIONS BEFORE ANY JOB COMMENCES.
ALL SHOP DRAWINGS SHALL BE SUBMITTED TO THE SUPERINTENDENT AND MANUFACTURE
SHALL NOT COMMENCE PRIOR TO THE RETURN OF UNAMENDED SHOP DRAWINGS SIGNED
BY THE CONSULTANT. FIGURED DIMENSIONS SHALL TAKE PRECEDENCE OVER SCALED. THIS
DRAWING SHOULD BE READ IN CONJUNCTION WITH ALL RELEVANT CONTRACT, SPECIFICATIONS
AND DRAWINGS COPYRIGHT OF THIS DRAWING IS VESTED IN WARDLE General Notes 01.06.14 07.09.12 10.08.12 13.07.12 01.06.12 24.02.12 20.01.12 - 22.12.11 Amd Date A SG CONSTRUCTION ISSUE

07 JC 100% CD – TENDER ISSUE

06 JC 90% CD ISSUE

05 JC 75% CD ISSUE

04 JC 50% CD ISSUE

03 JC FINAL DD ISSUE

02 JC DESIGN DEVELOPMENT ISSUE

01 JC DESIGN DEVELOPMENT ISSUE Rev Issue Revision Description NADAAA 1920 Washington Street No.2 Boston Massachusetts 02118 USA Telephone +1 617 442 6232 Facsimile +1 888 442 1417 Email nada@nadaaa.com WAY John Wardle Architects © 2011 John Wardle Architects Level 10, 180 Russell Street, Melbourne Victoria 3000 Australia Tel: +613 9654 8700 www.johnwardlearchitects.com University of Melbourne
Parkville Campus Faculty of Architecture
Building and Planning Title 3D VIEWS JOSEPH REED FACADE AR5103 Date JAN 2014 Drwn FILENAME - #### FOR CONSTRUCTION

THIS DRAWING IS AN UNCONTROLLED COPY UNLESS STAMPED OTHERWISE