



CONTRACTORS SHALL VERIFY JOB DIMENSIONS BEFORE ANY JOB COMMENCES. ALL SHOP DRAWINGS SHALL BE SUBMITTED TO THE SUPERINTENDENT AND MANUFACTURE SHALL NOT COMMENCE FROM THE RETURN OF DRAWINGS UNLESS DRAWINGS ISSUED BY THE CONSULTANT. DIMENSIONS SHALL TAKE PRECEDENCE OVER SCALED THIS DRAWING SHOULD BE READ IN CONJUNCTION WITH ALL RELEVANT CONTRACT SPECIFICATIONS AND DRAWING COPYRIGHT OF THIS DRAWING IS VESTED IN WARDLE


General Notes
SEE DRAWINGS 5159 TO 5144 FOR PANELING PERFORMANCE DETAILS

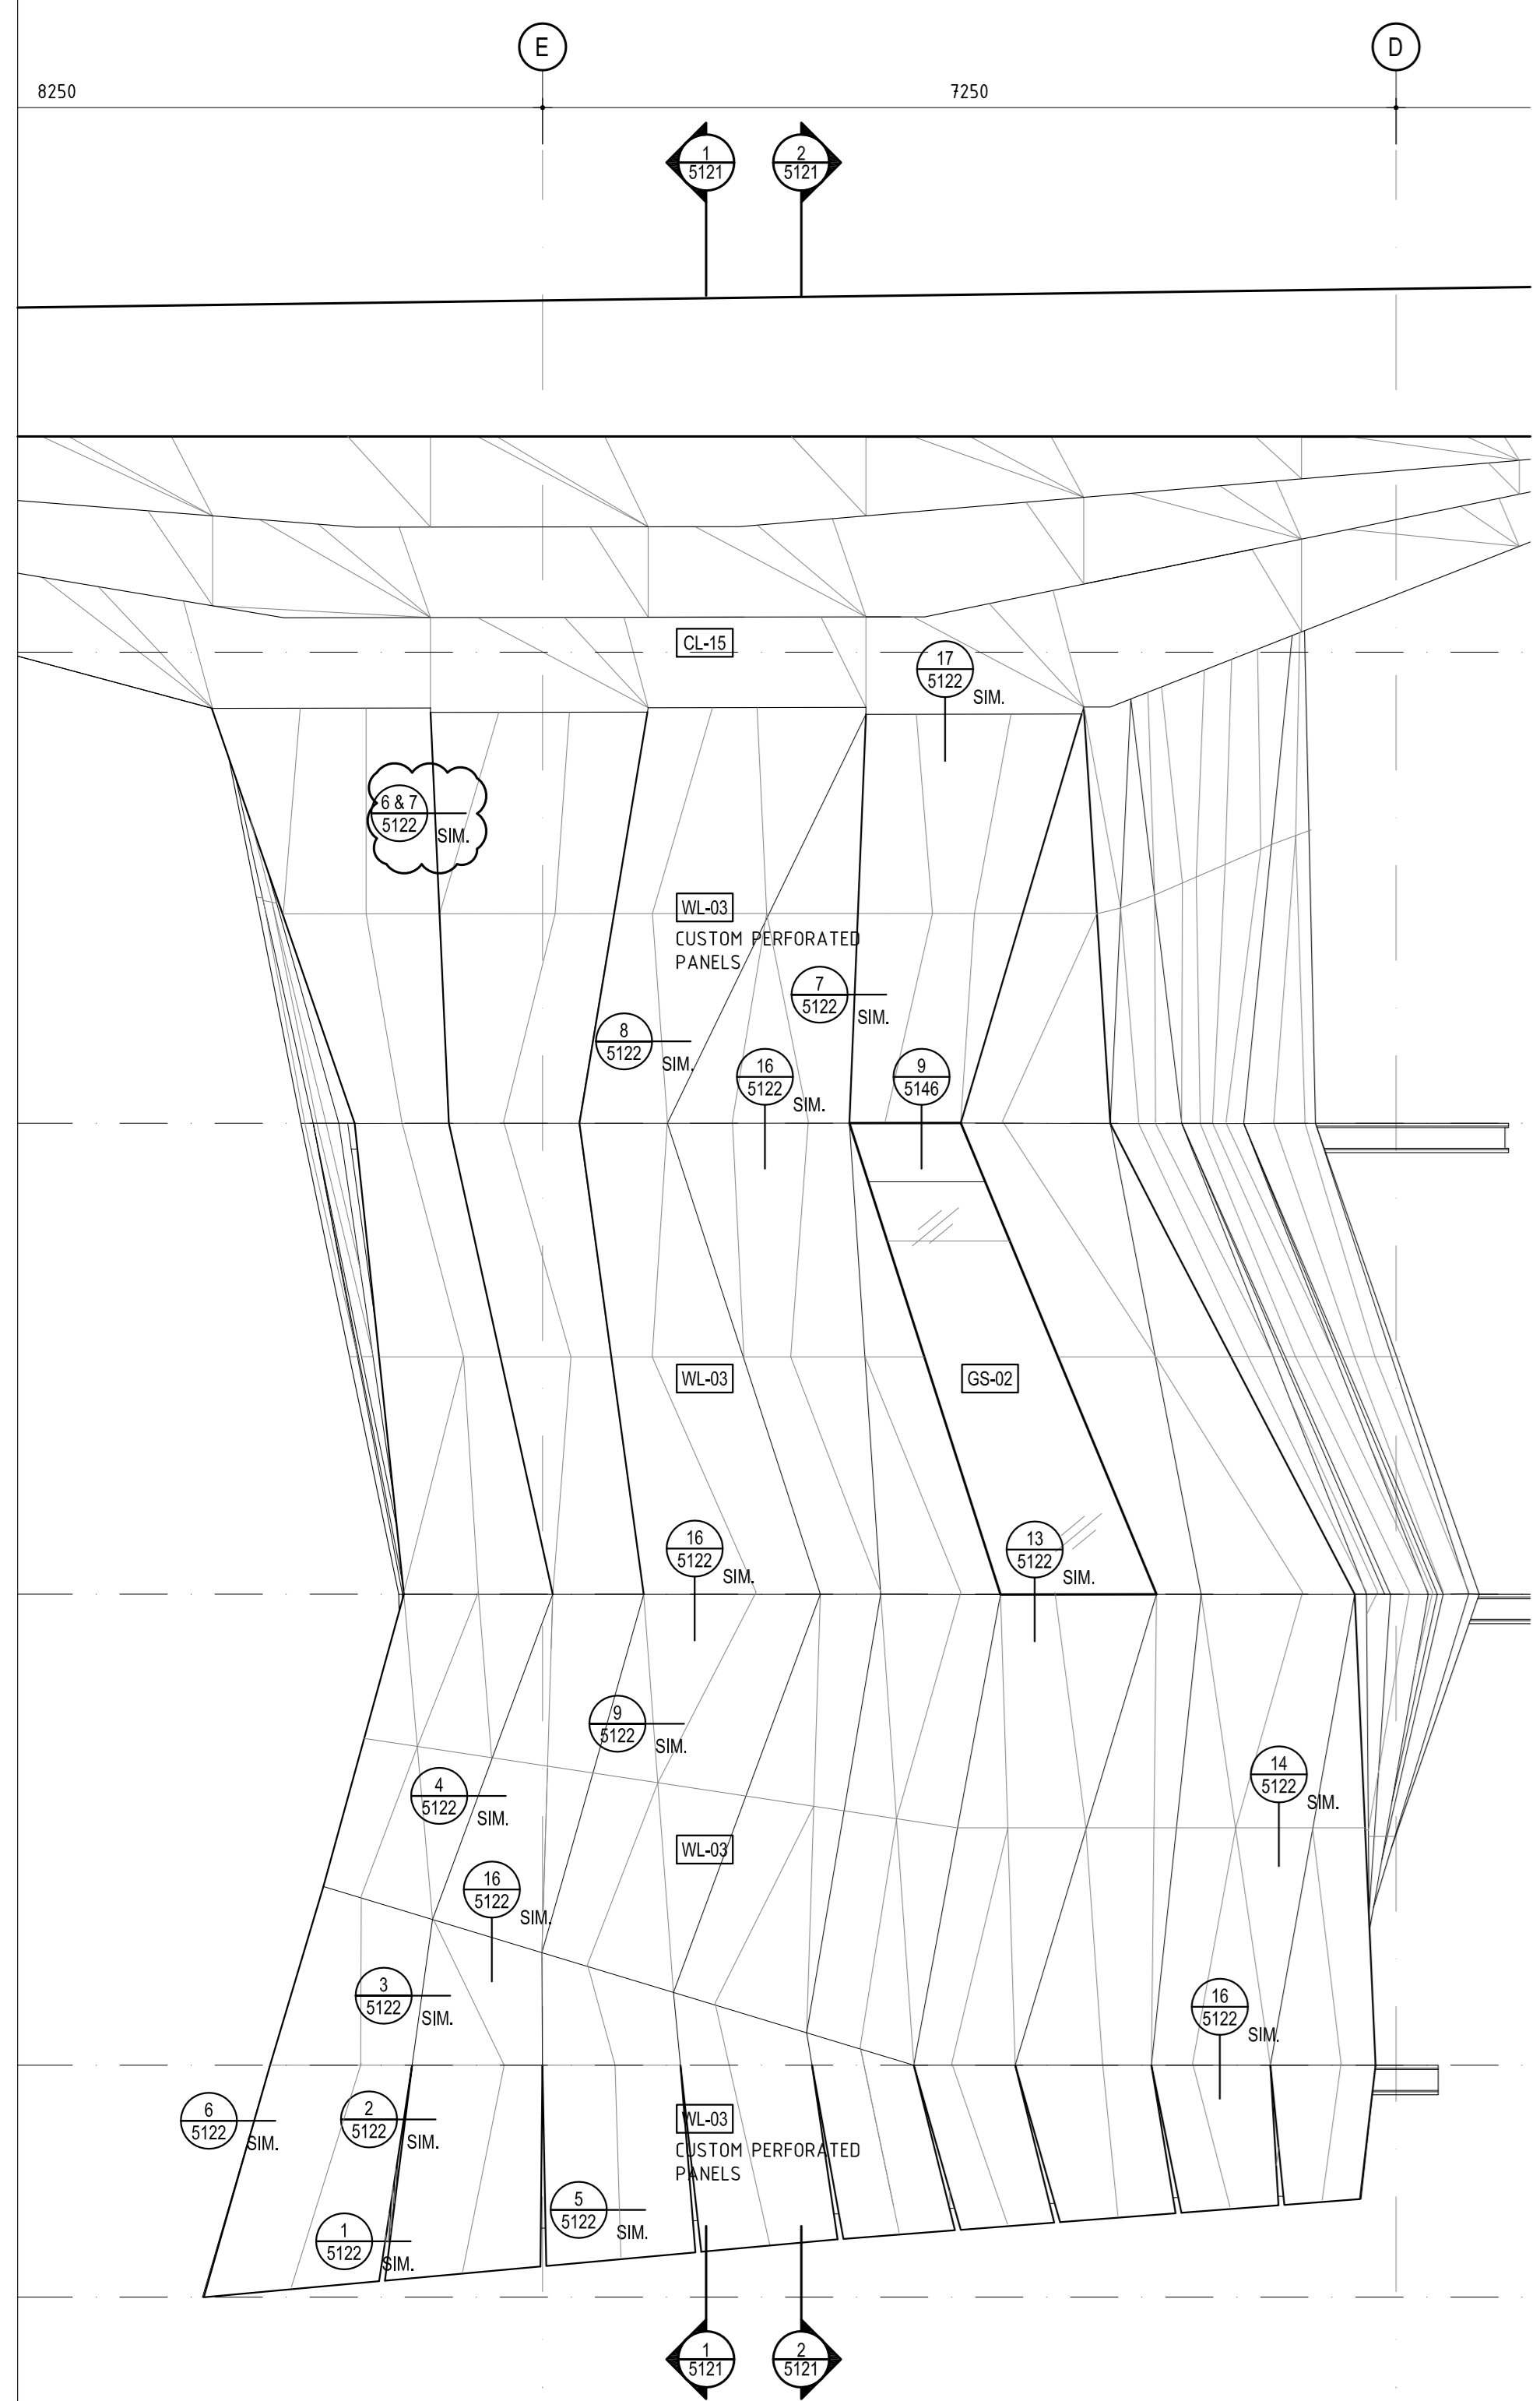


08 HANGING STUDIO FACADE - EAST ELEVATION
SCALE 1:50

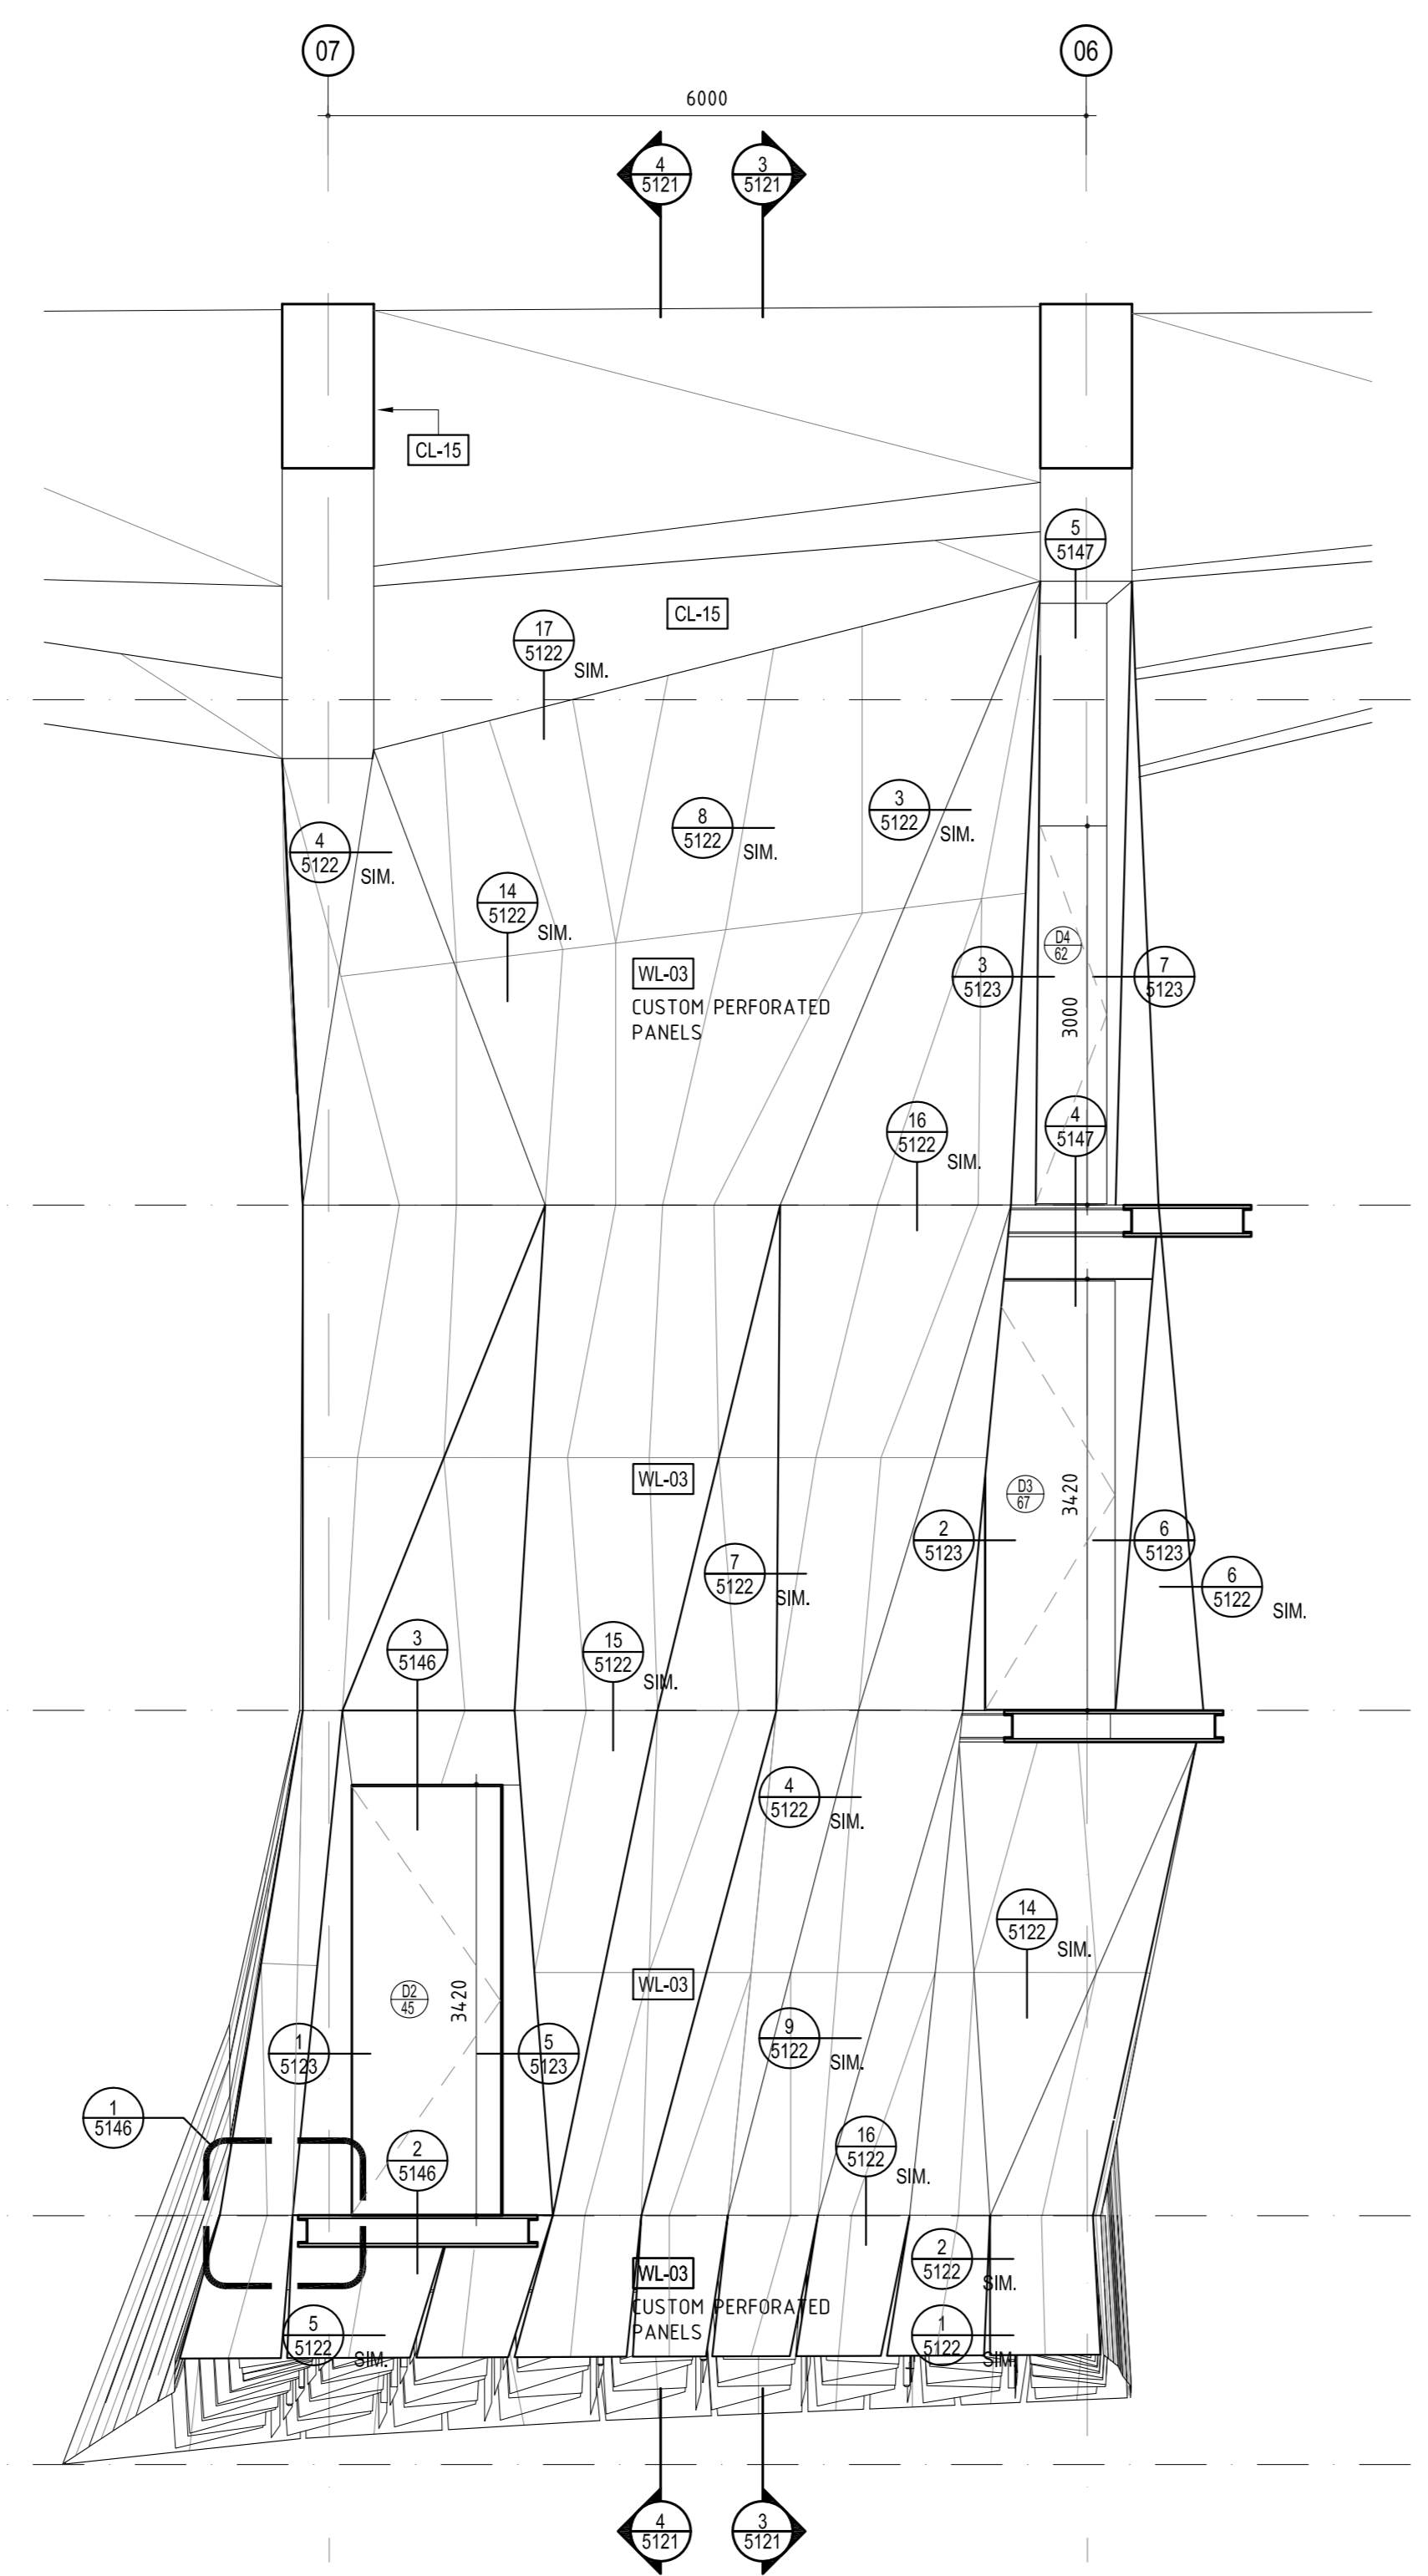


07 HANGING STUDIO FACADE - NORTH ELEVATION
SCALE 1:50

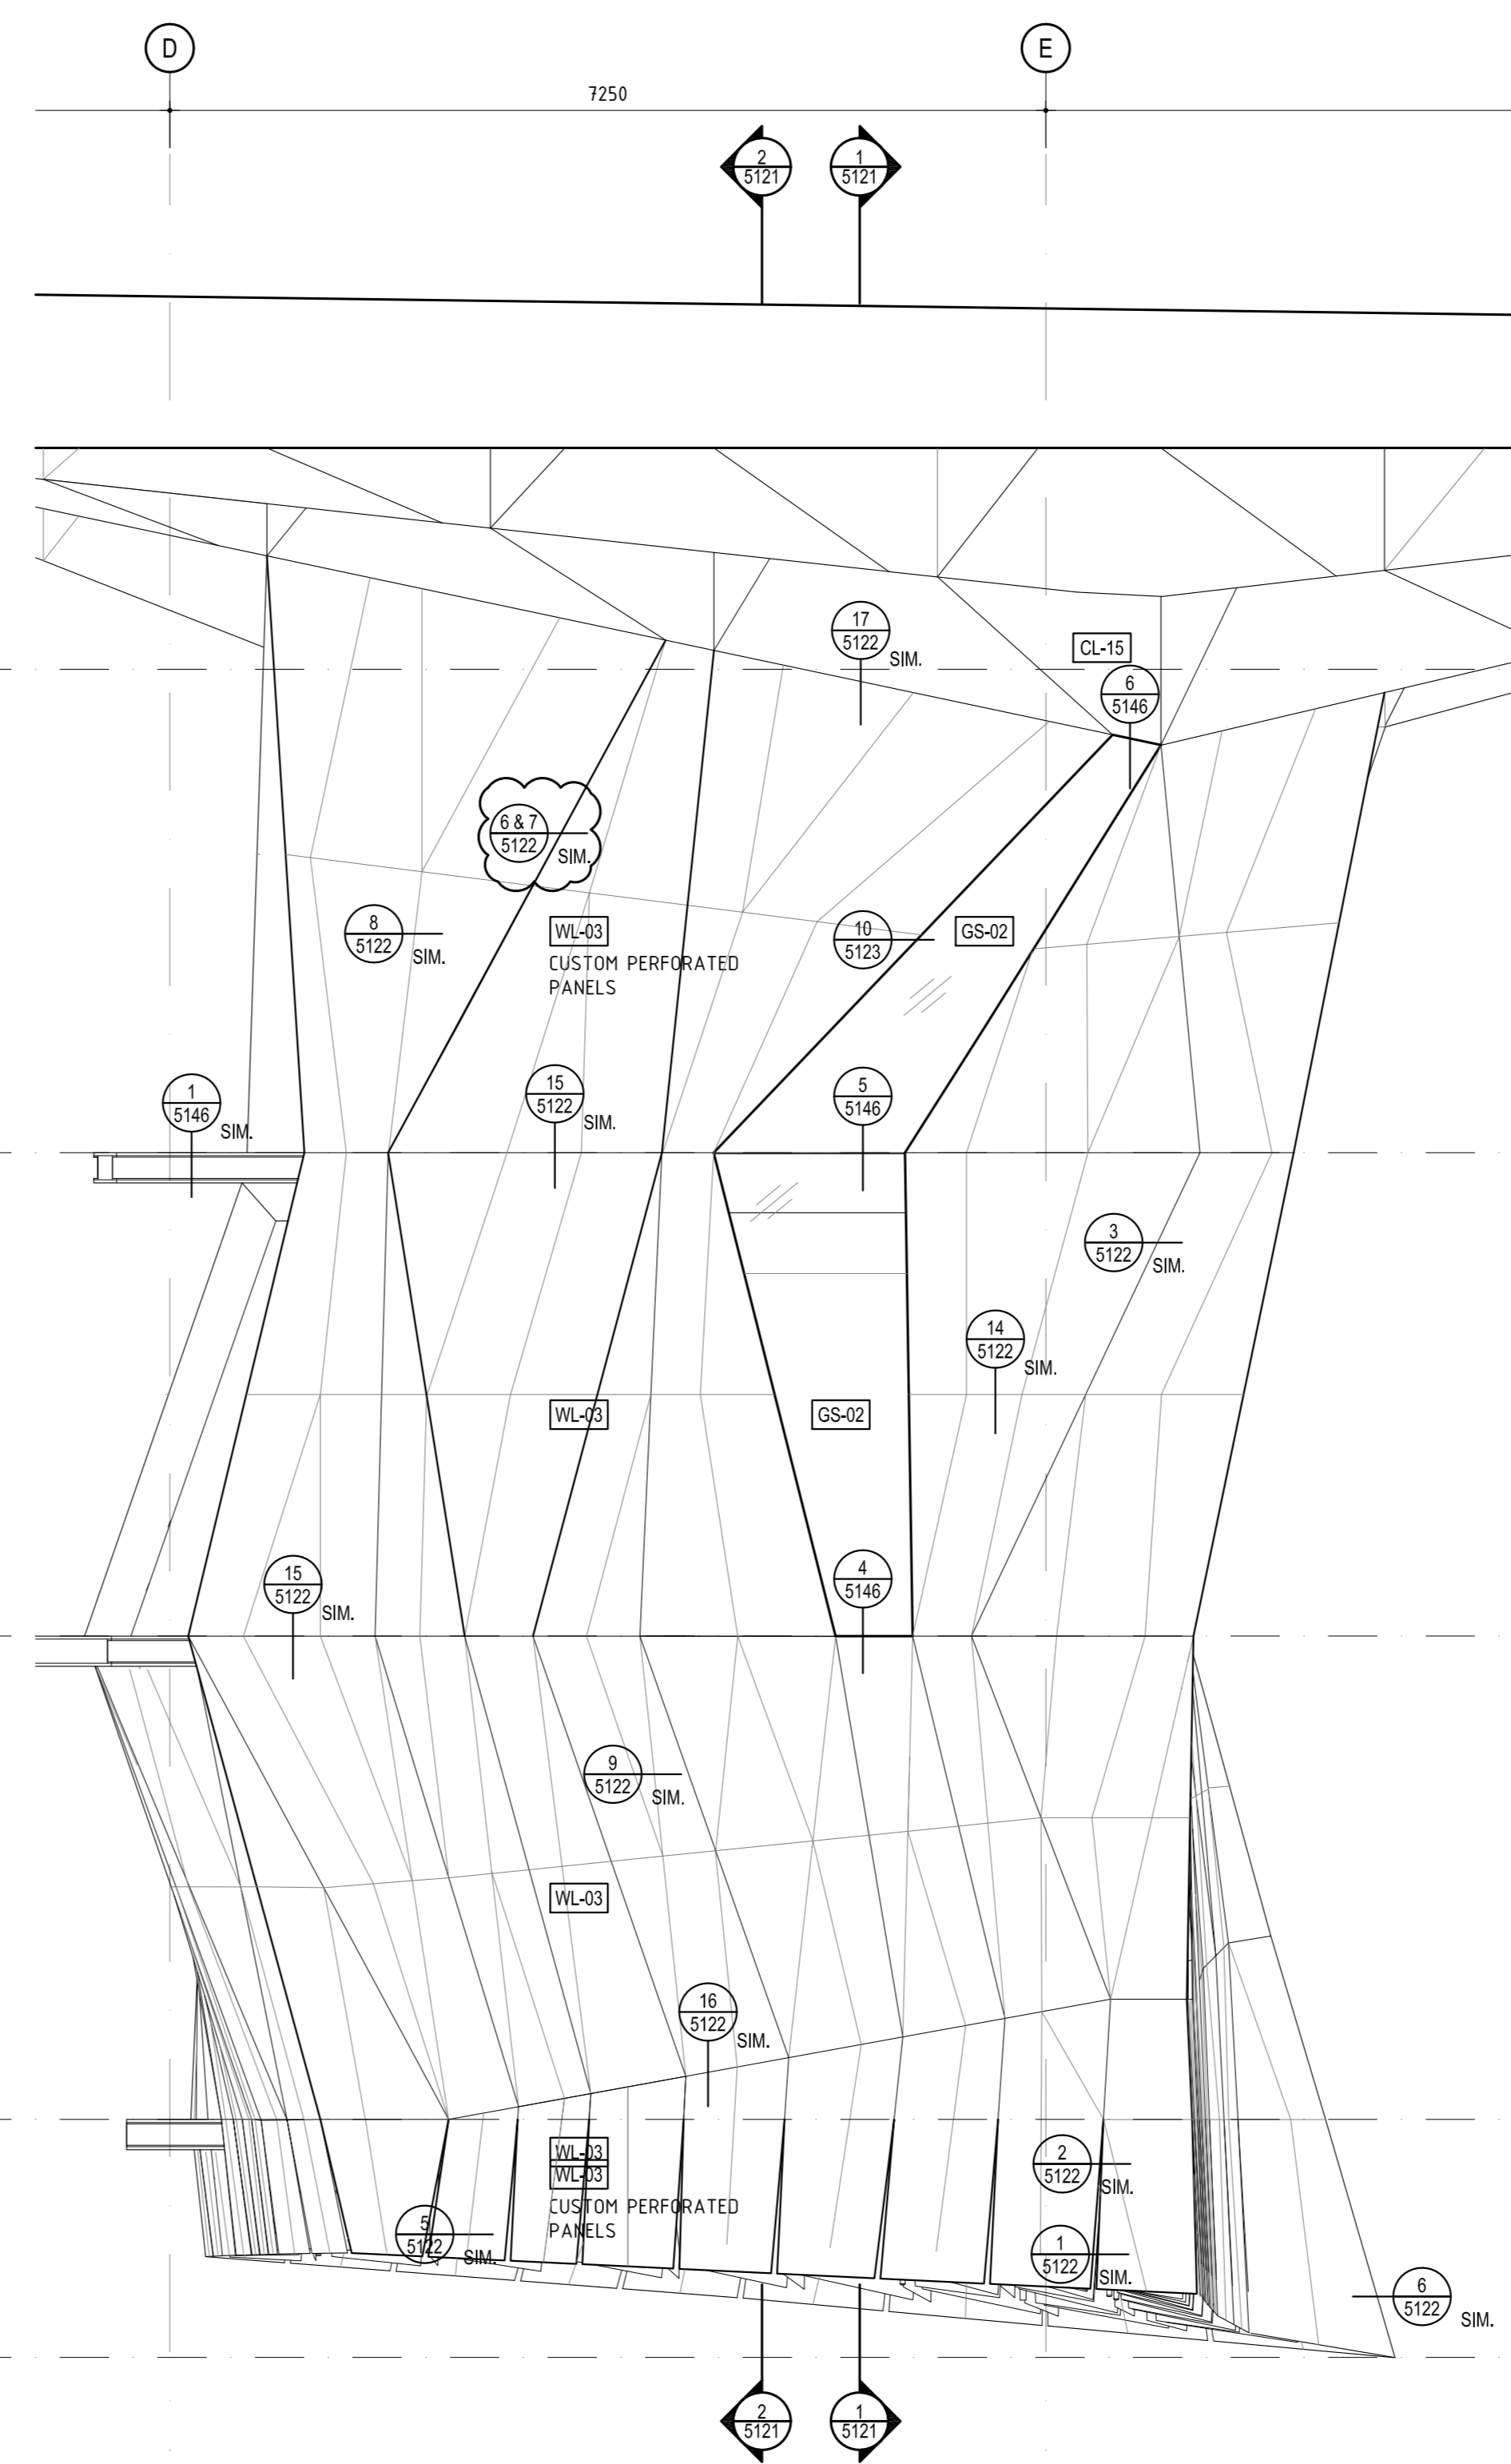


06 HANGING STUDIO FACADE - WEST ELEVATION
SCALE 1:50

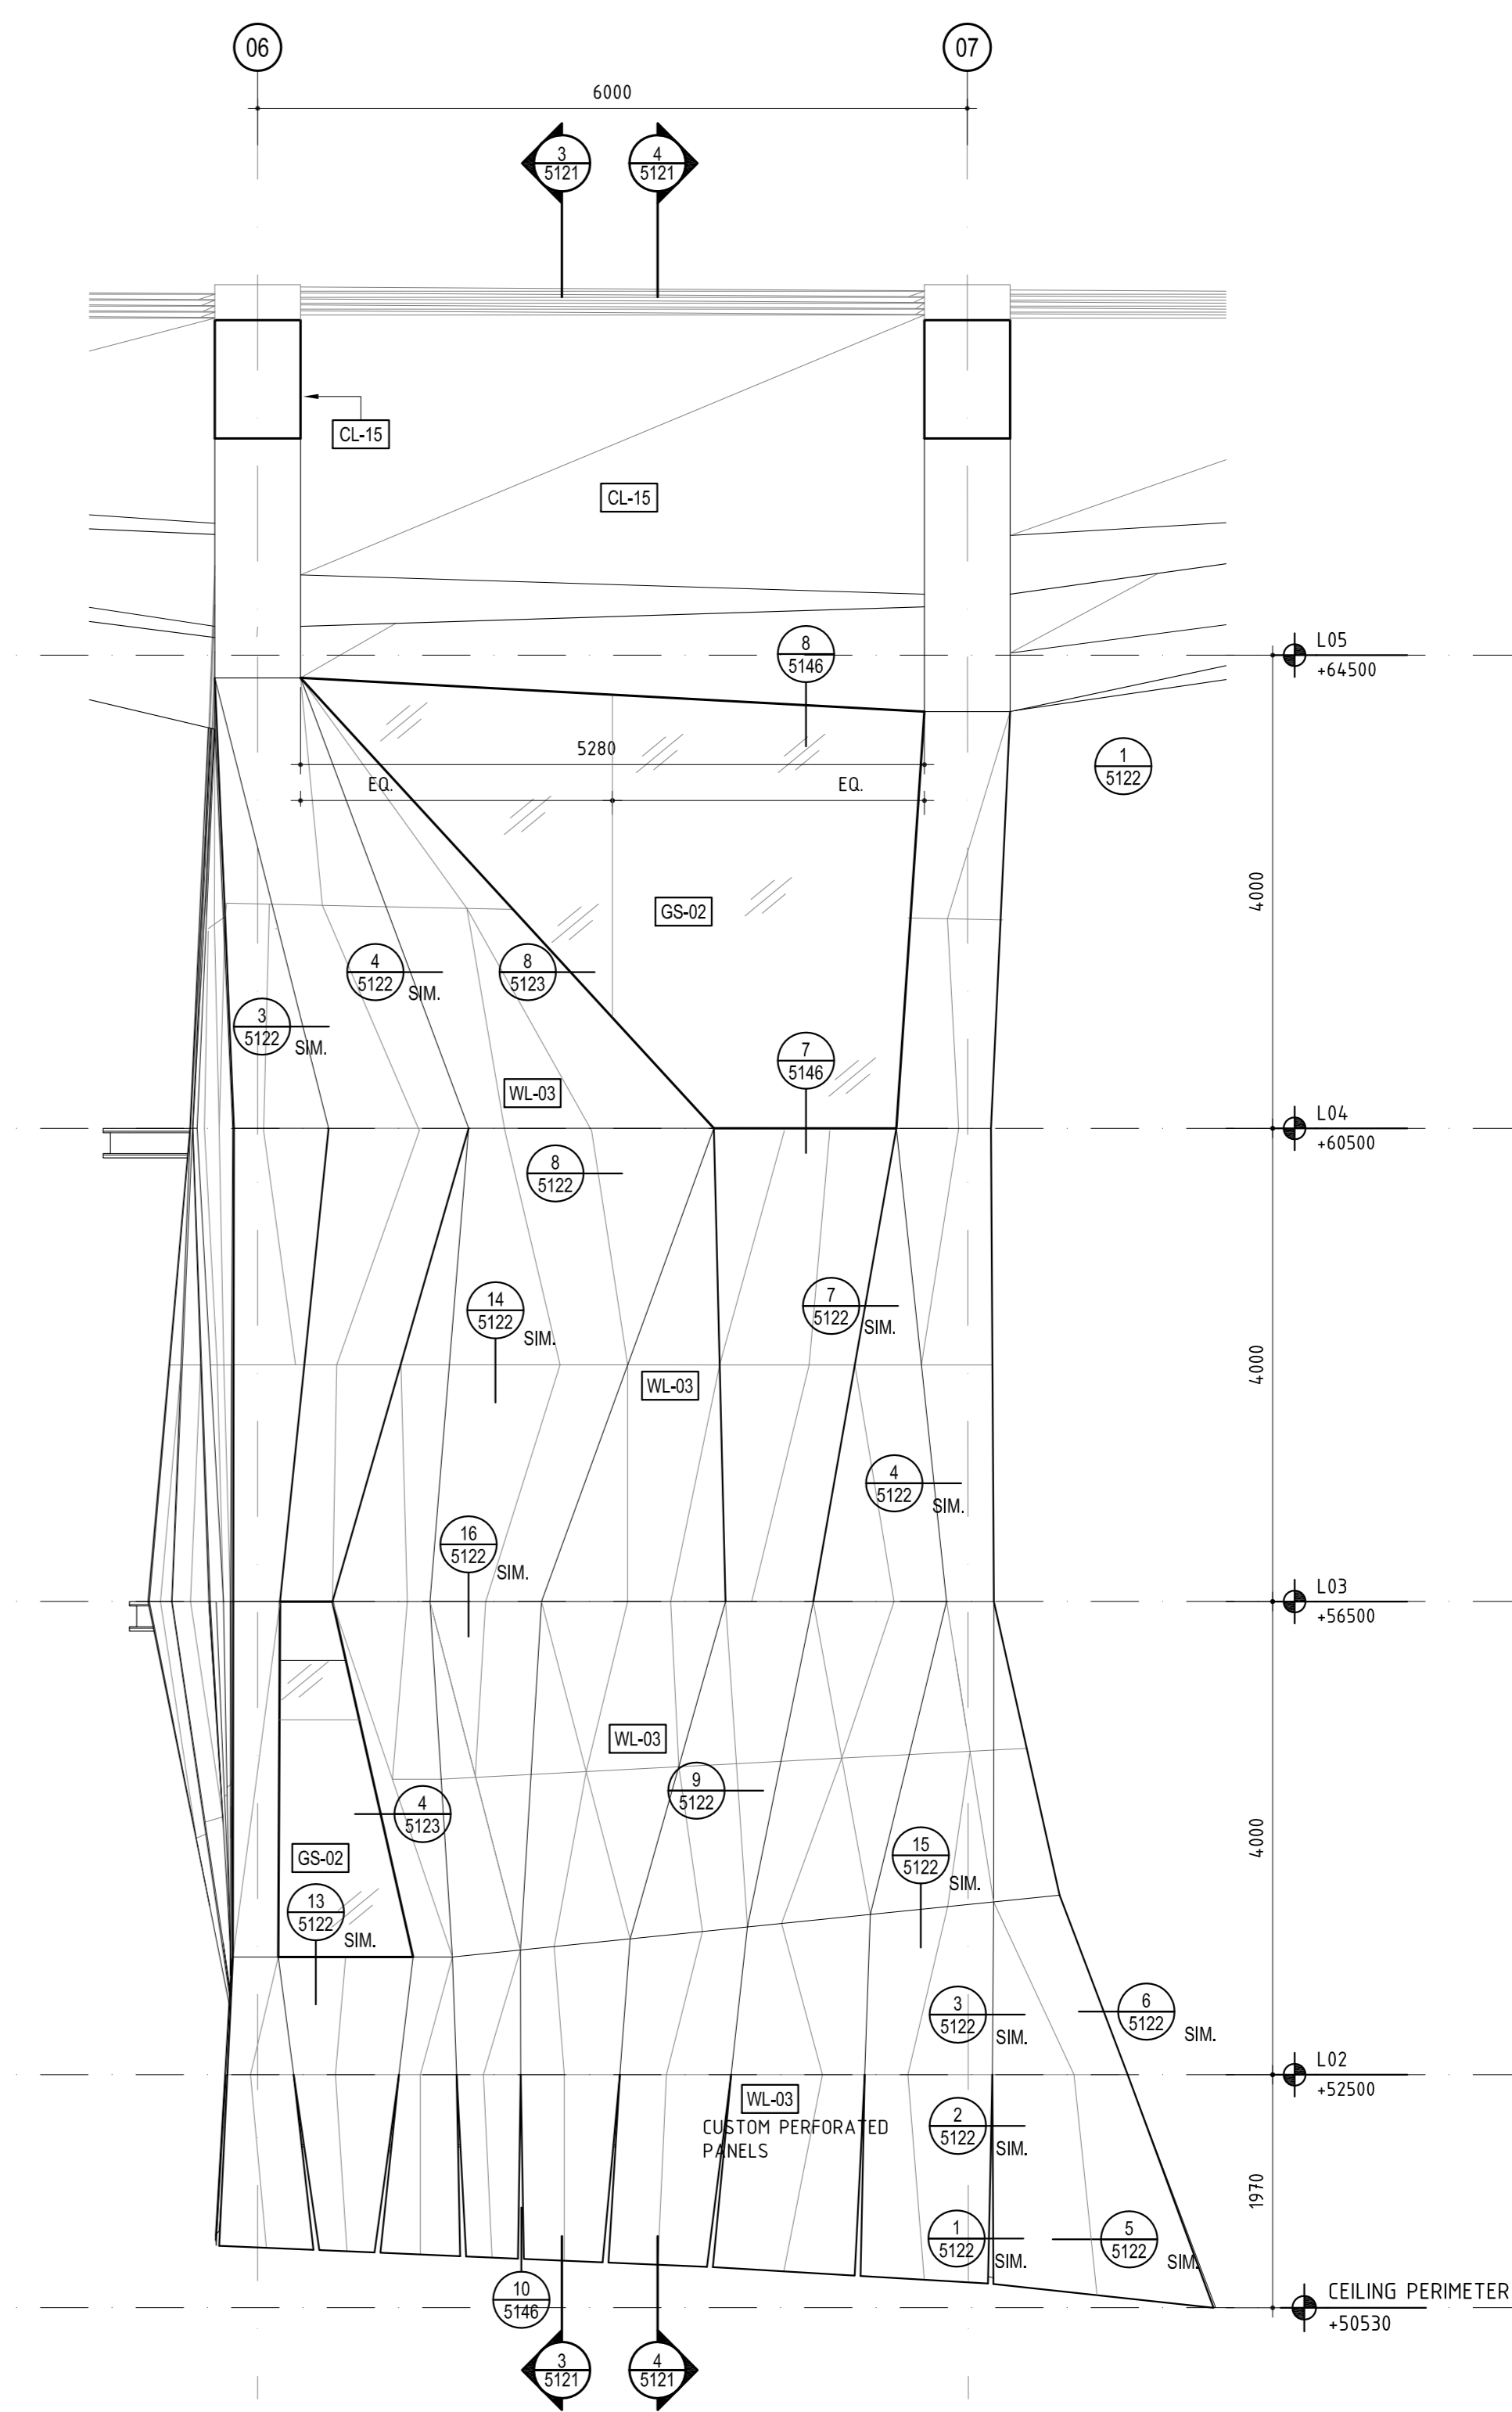


05 HANGING STUDIO FACADE - SOUTH ELEVATION
SCALE 1:50

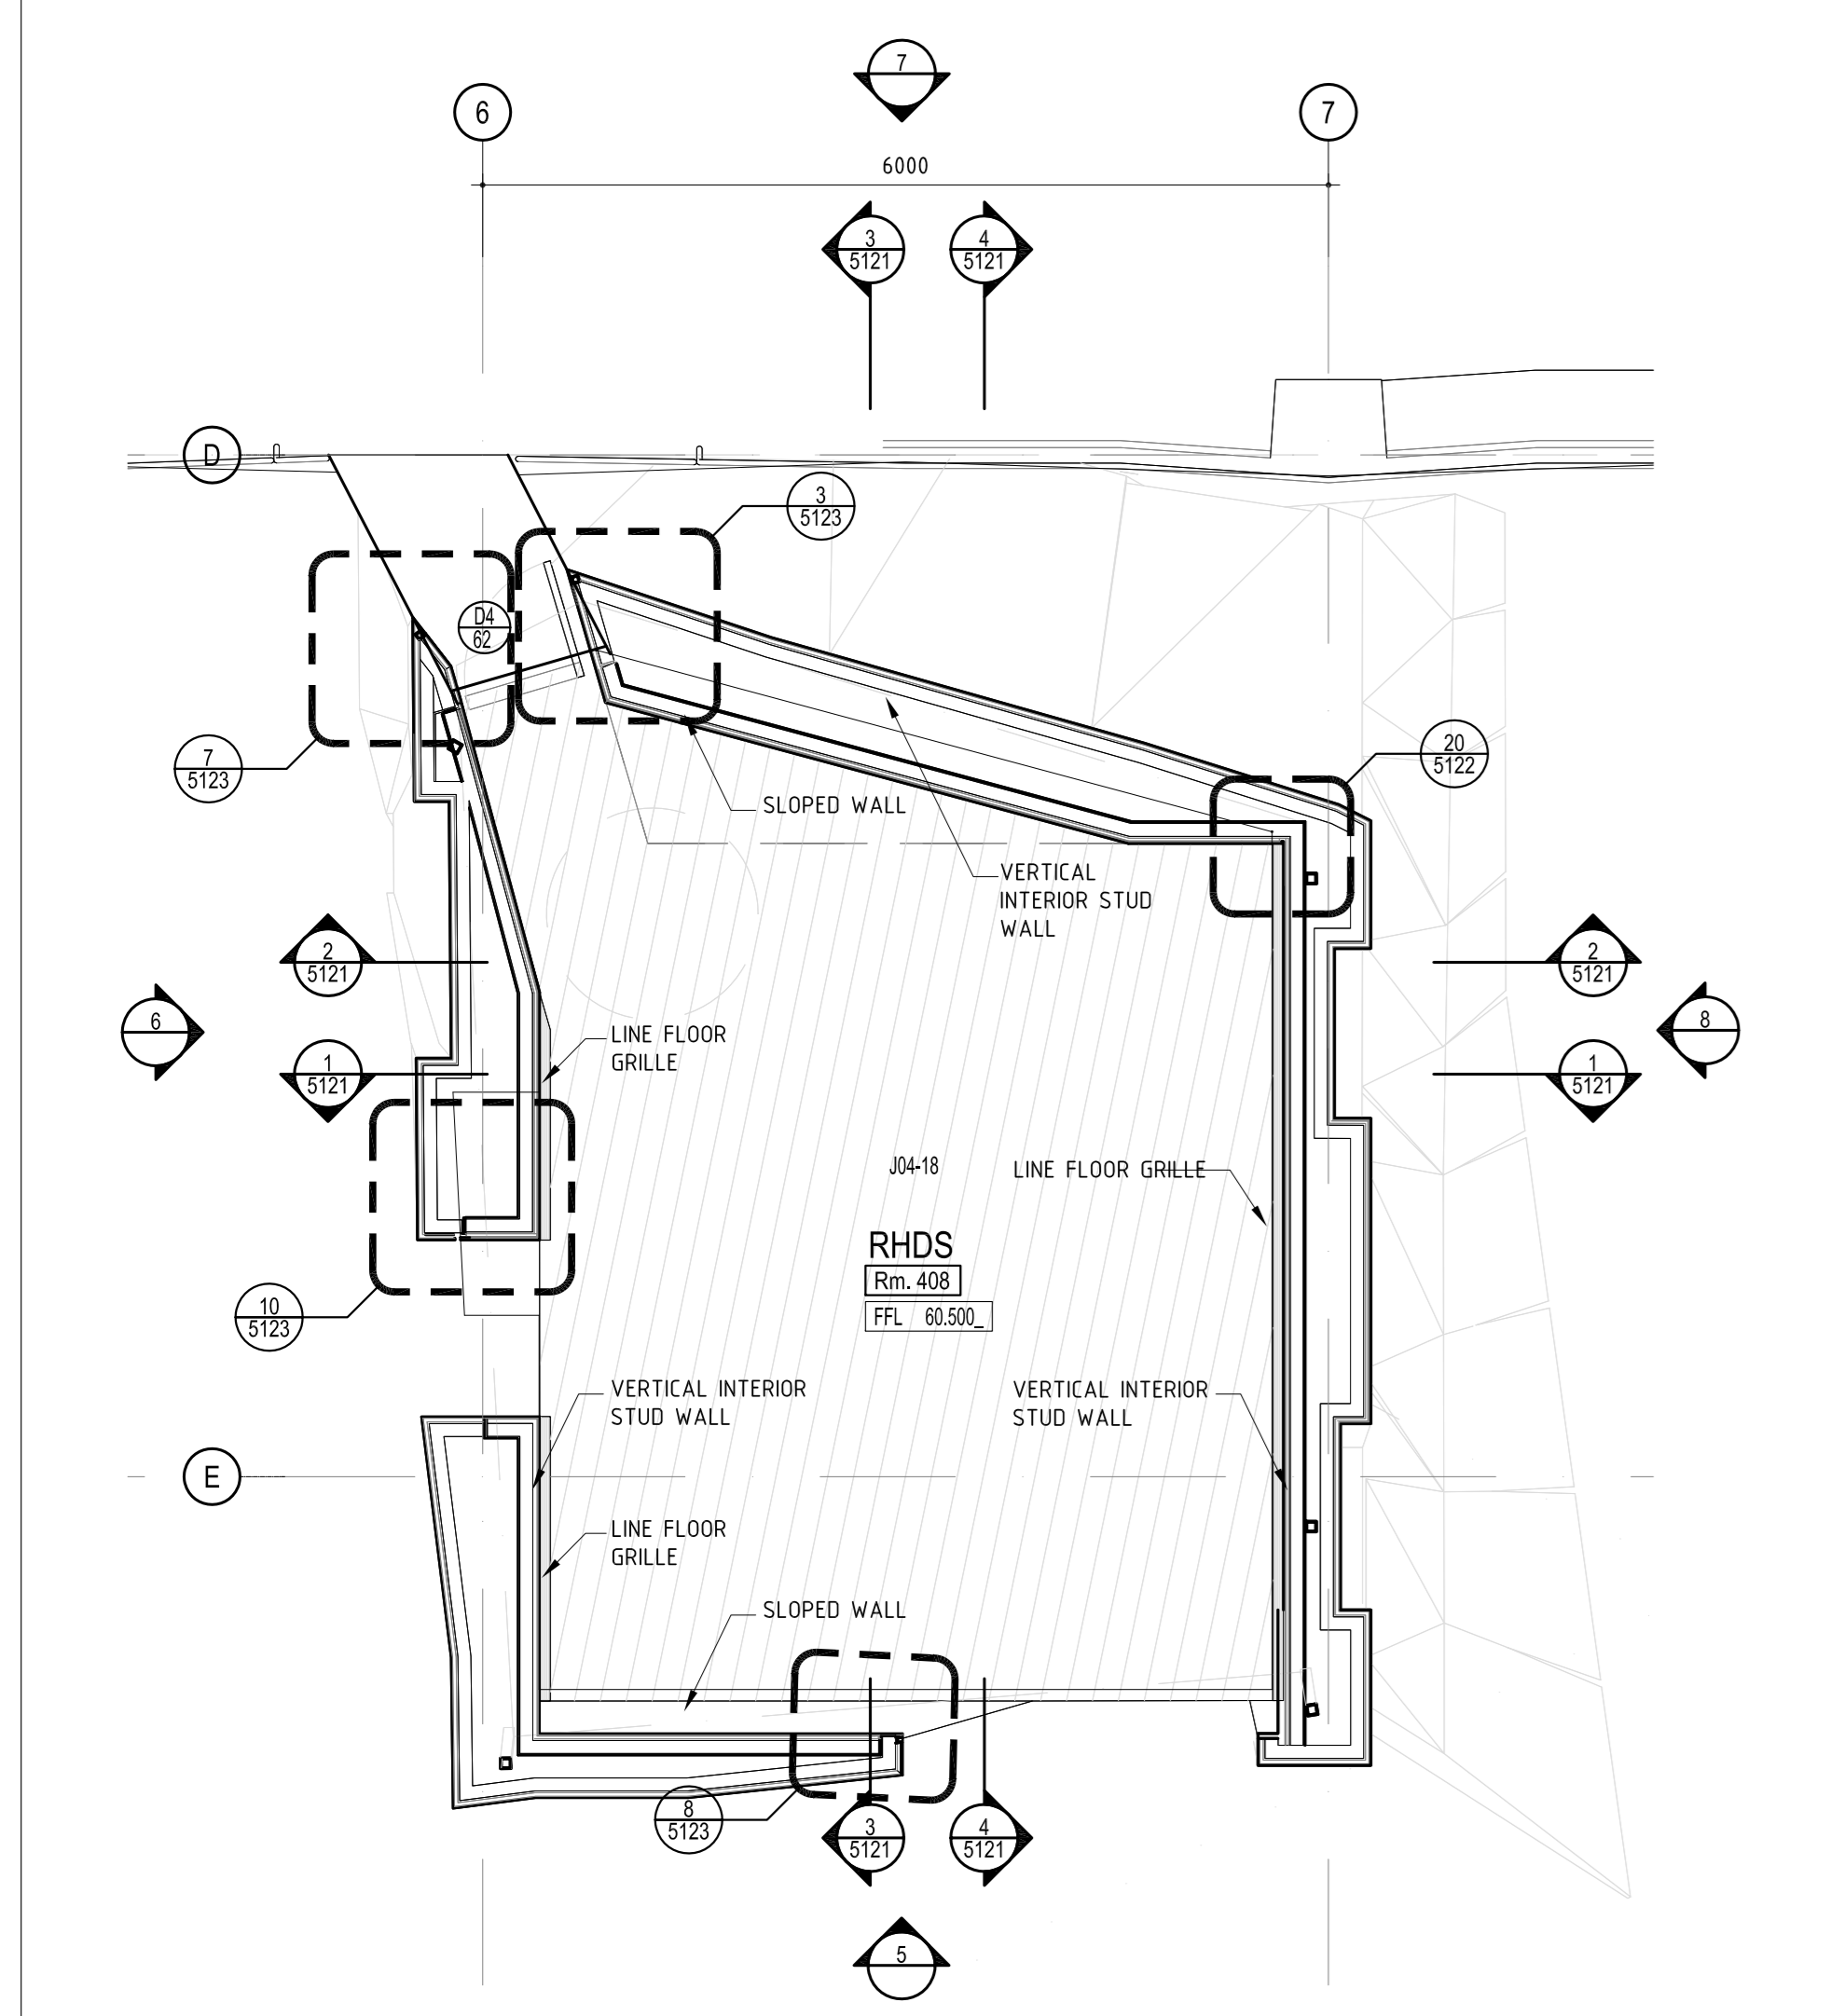


04 HANGING STUDIO - L04 FLOOR PLAN
SCALE 1:50

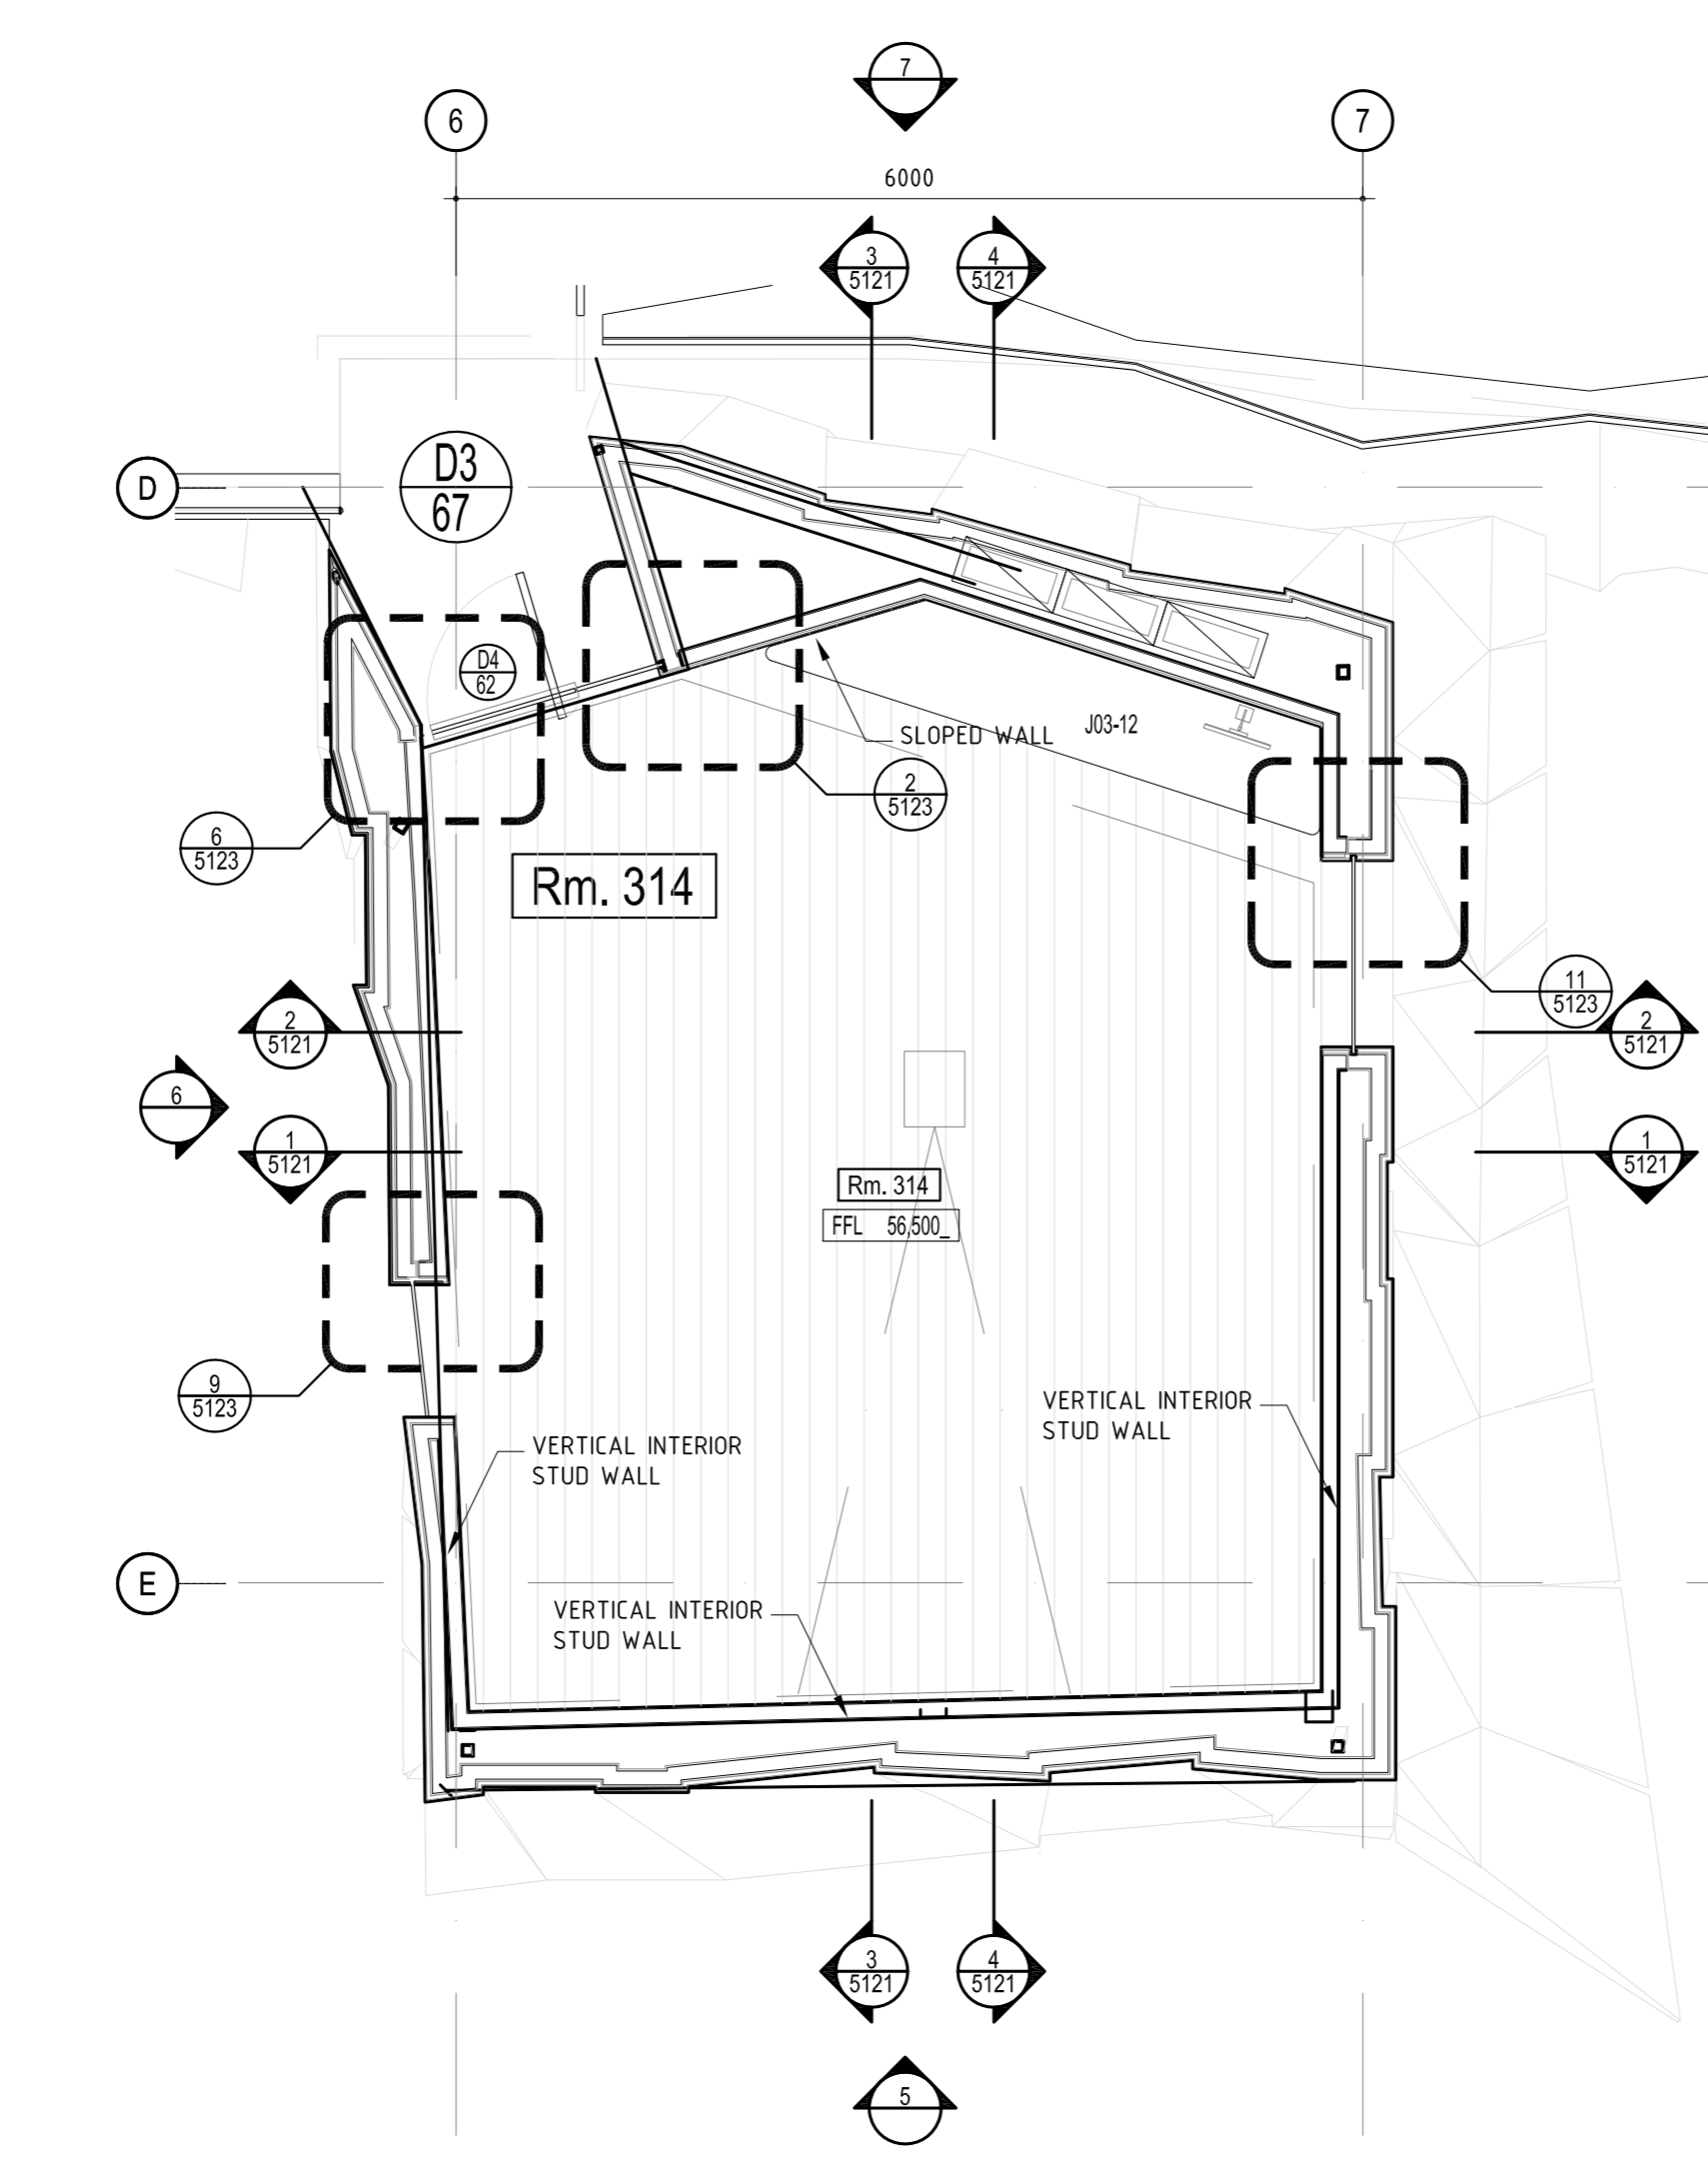

03 HANGING STUDIO - L03 FLOOR PLAN
SCALE 1:50

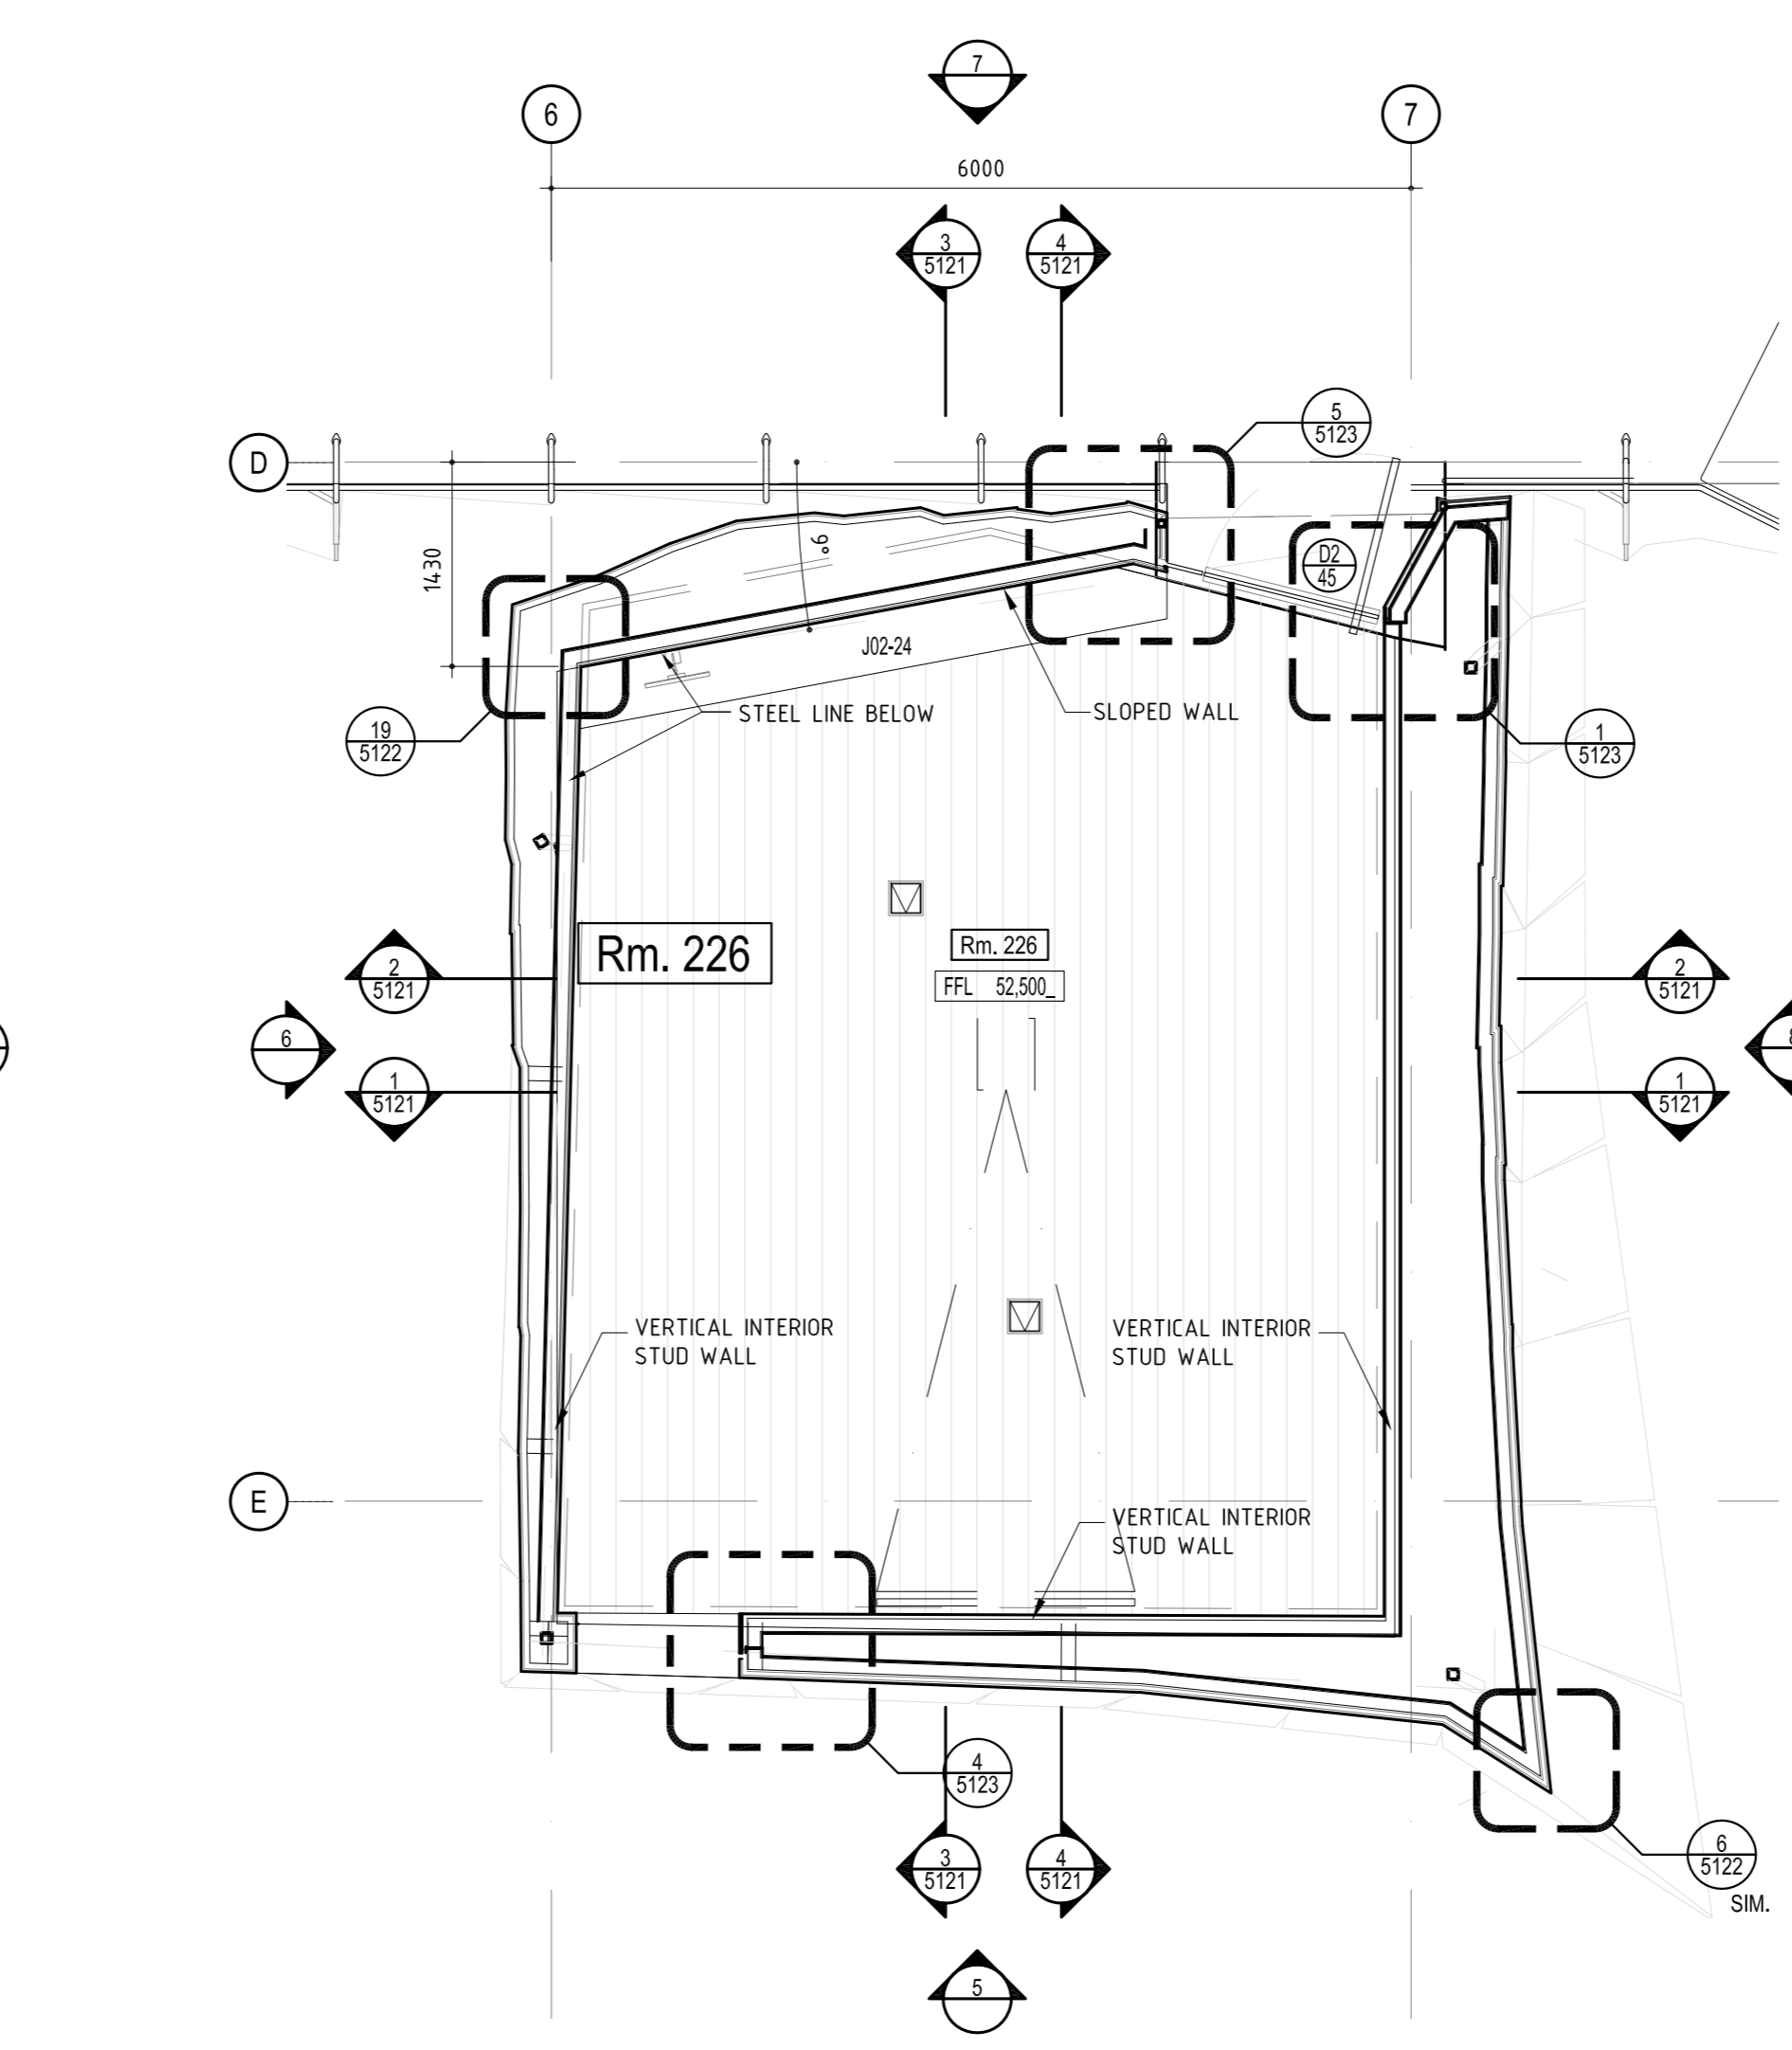


02 HANGING STUDIO - L02 FLOOR PLAN
SCALE 1:50

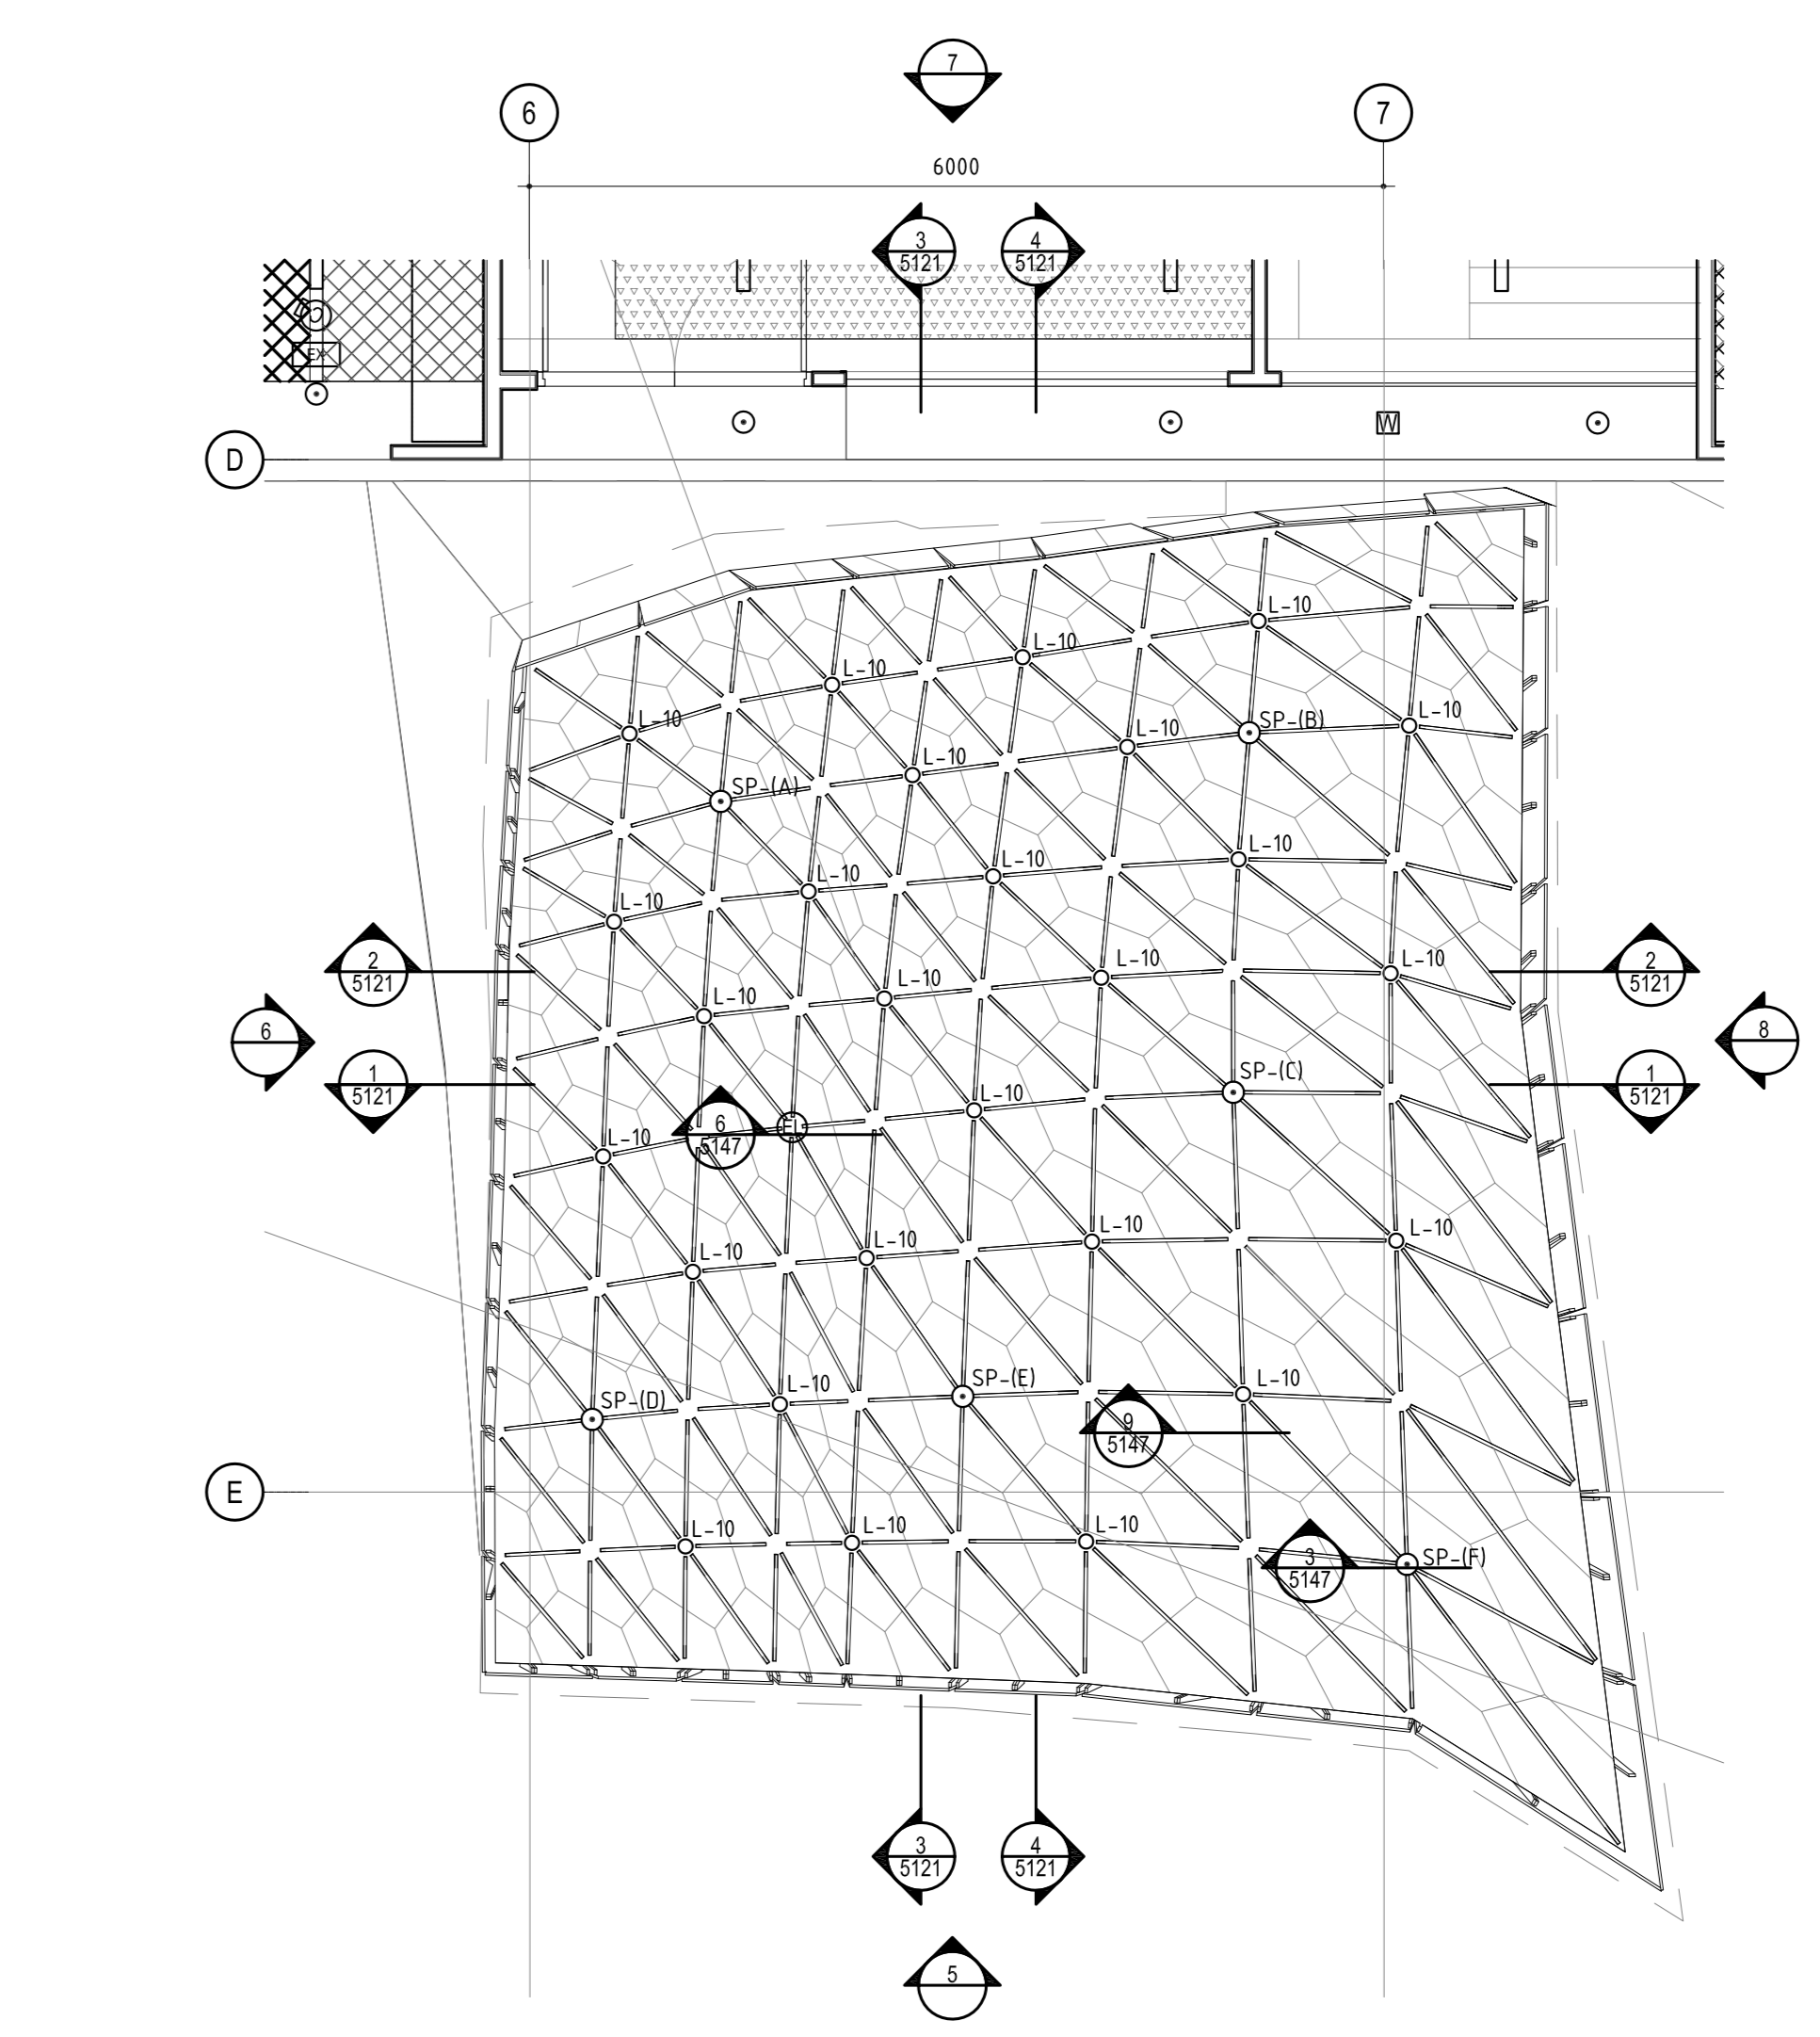

01 HANGING STUDIO - L01 RCP
SCALE 1:50

LEGEND TO L01 RCP
 L-10 LIGHT FIXTURE - 26 NOS. OF 250MM ALUMINUM TUBE
 E EMERGENCY LIGHT - 1 NOS. OF 250MM ALUMINUM TUBE
 SP - 365MM ALUMINUM TUBE
 SP-A - 365MM ALUMINUM TUBE
 SP-B - 250MM ALUMINUM TUBE
 SP-C - 250MM ALUMINUM TUBE
 SP-D - 325MM ALUMINUM TUBE
 SP-E - 250MM ALUMINUM TUBE
 SP-F - 365MM ALUMINUM TUBE

Rev	Issue	Revision Description	And	Date
A	SG	CONSTRUCTION ISSUE	-	6.01.14
09	SG	TENDER ISSUE	-	21.08.13
08	JC	100% CD - TENDER ISSUE	-	07.08.12
07	JC	90% CD ISSUE	-	10.08.12
06	JC	75% CD ISSUE	-	13.07.12
05	JC	50% CD ISSUE	-	01.06.12
GENERAL FINISHES AND ELEVATIONS UPDATED				
04	JC	25% CD ISSUE	-	20.04.12
03	JC	FINAL DD ISSUE	-	24.02.12
02	JC	DESIGN DEVELOPMENT ISSUE	-	20.01.12
01	JC	DESIGN DEVELOPMENT ISSUE	-	22.12.11

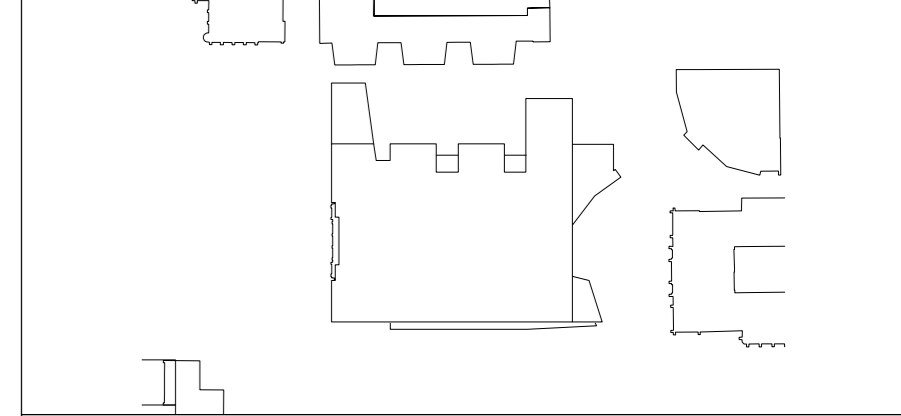

NADAAA
 Telephone: +1 617 442 8232
 1920 Washington Street No.2
 Boston, Massachusetts 02118 USA
 Facsimile: +1 688 442 1417
 Email: nada@nadaaa.com

John Wardle Architects
 © 2011 John Wardle Architects
 Level 10, 180 Russell Street, Melbourne Victoria 3000 Australia
 Tel: +613 9654 8700 www.johnwardlearchitects.com

Client: University of Melbourne Parkville Campus
 Project: Faculty of Architecture Building and Planning
 Title: HANGING STUDIO PLANS & ELEVATIONS

Project No.	0913	Scale	1:50
Drawing No.	AR5120	Revision	A
Date	JAN 2014	Drawn	-
Co-Ord	-	Check	-

FOR CONSTRUCTION