

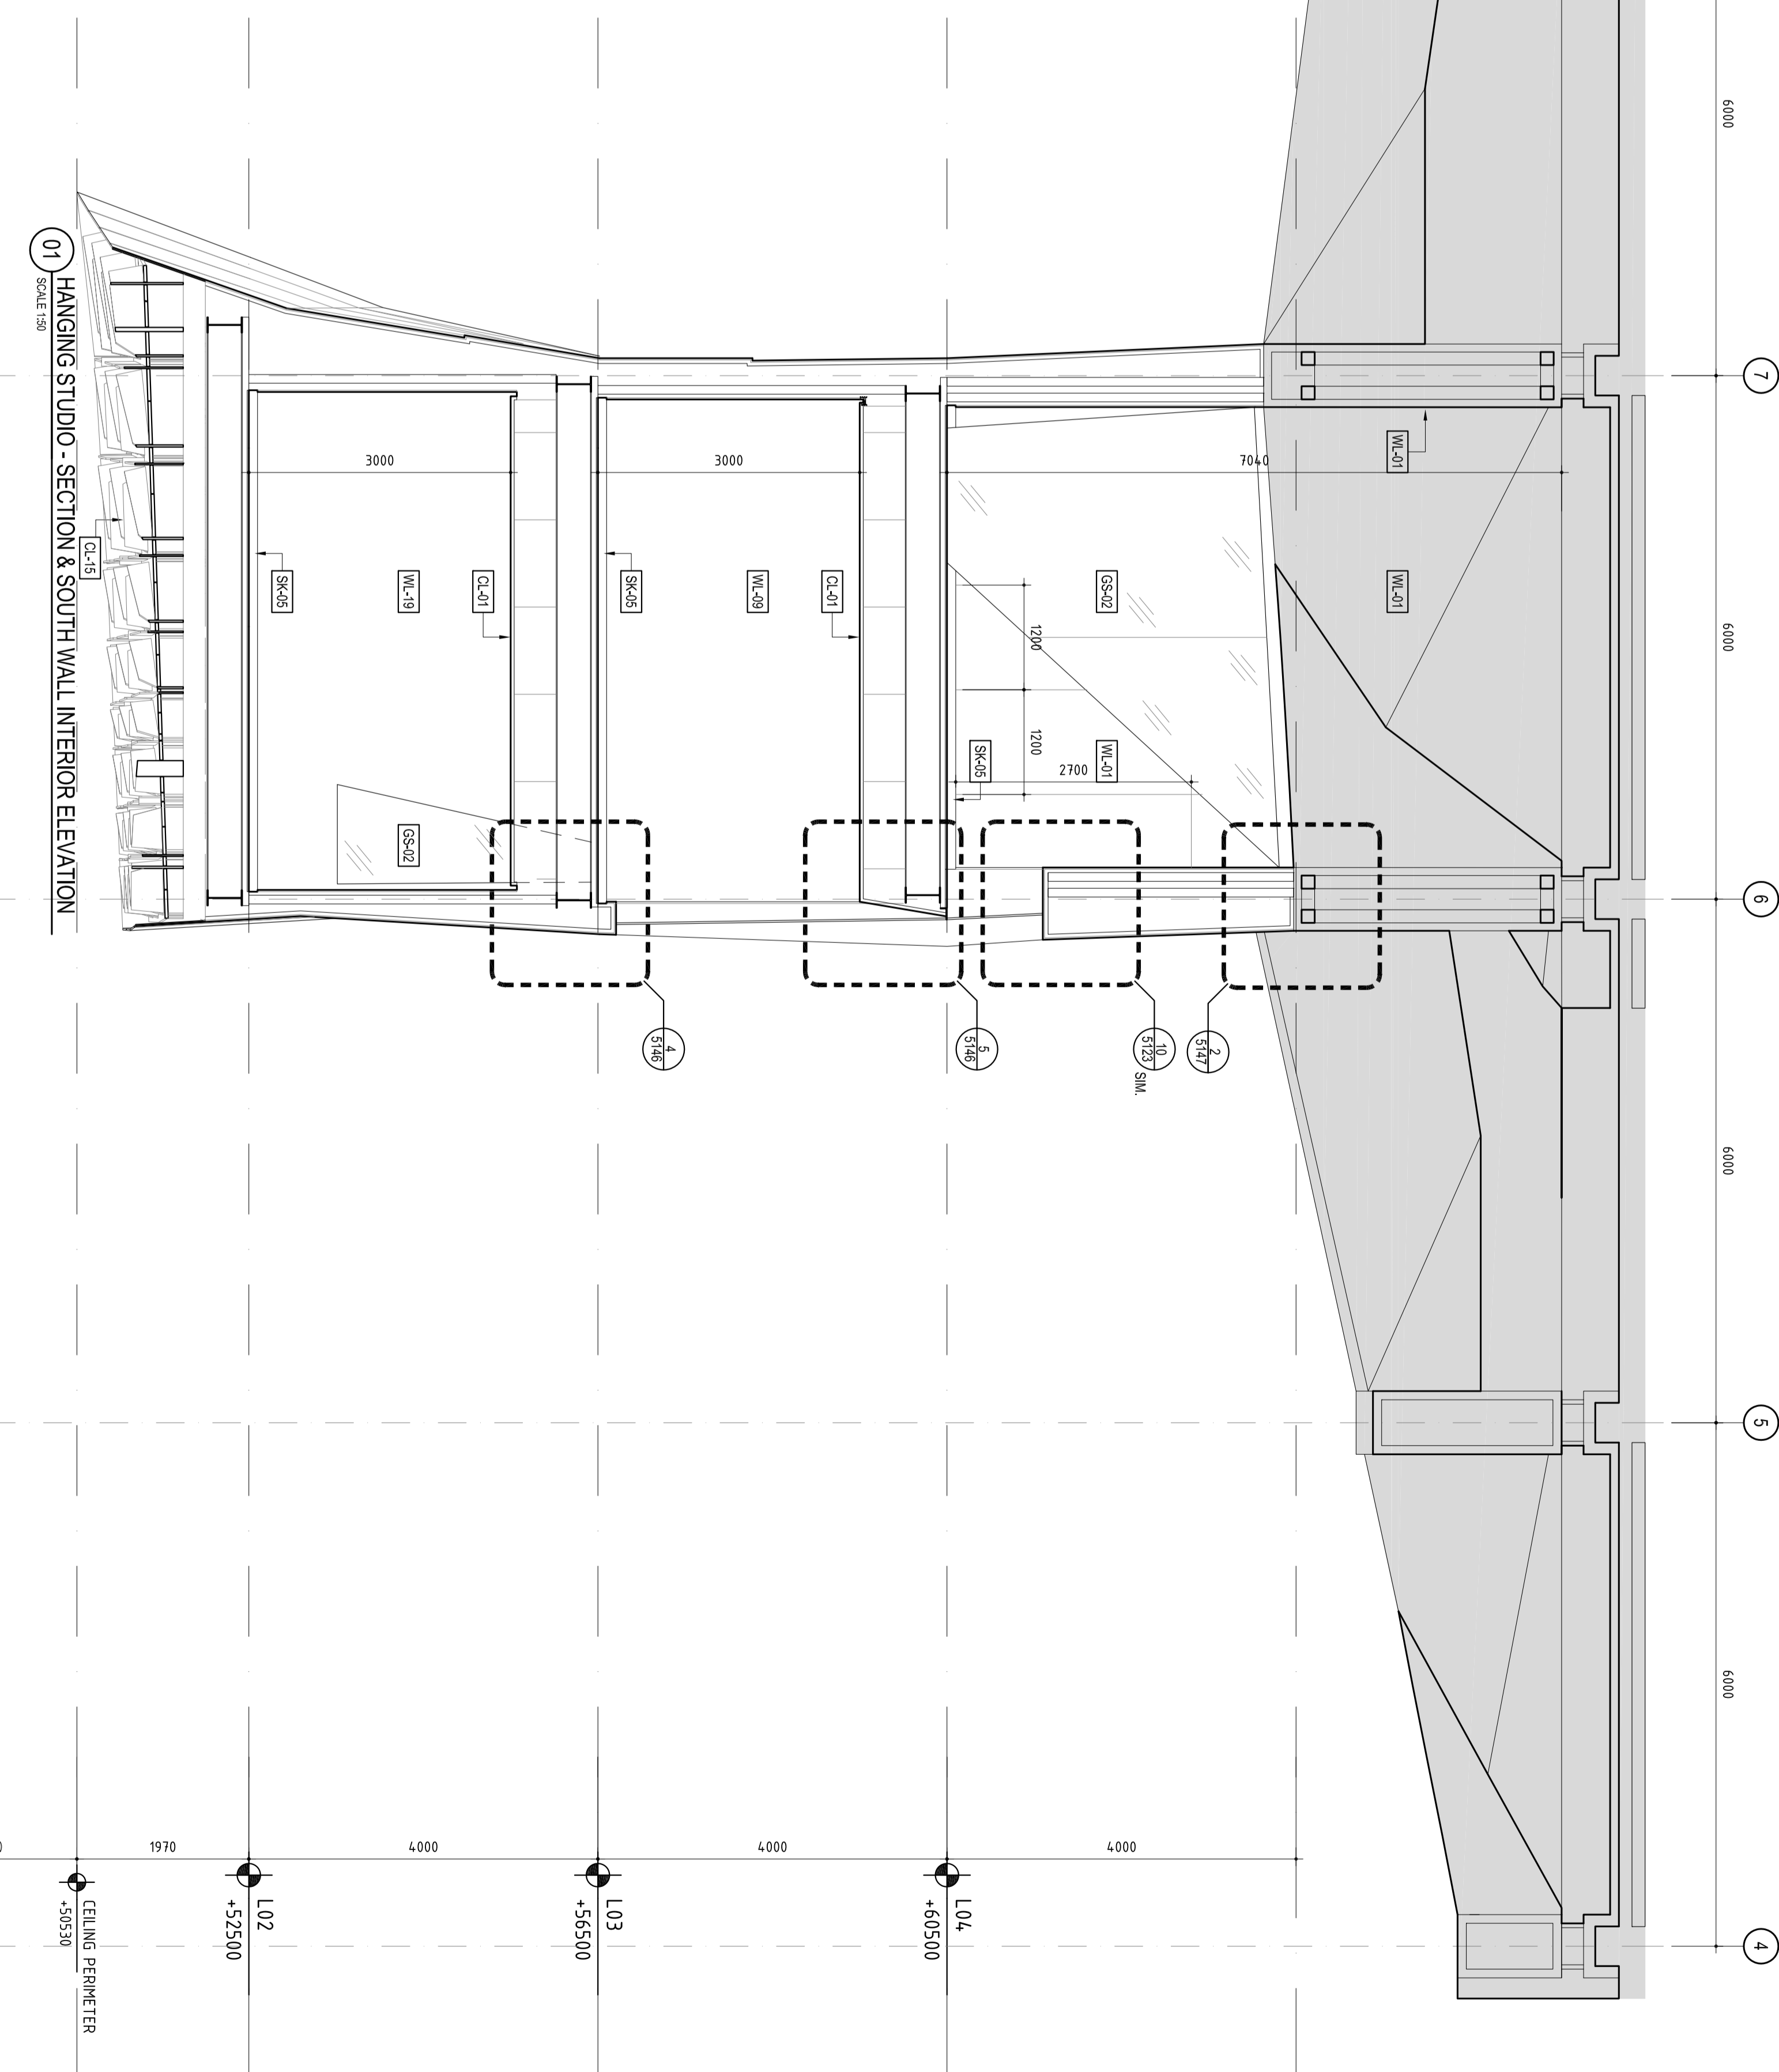
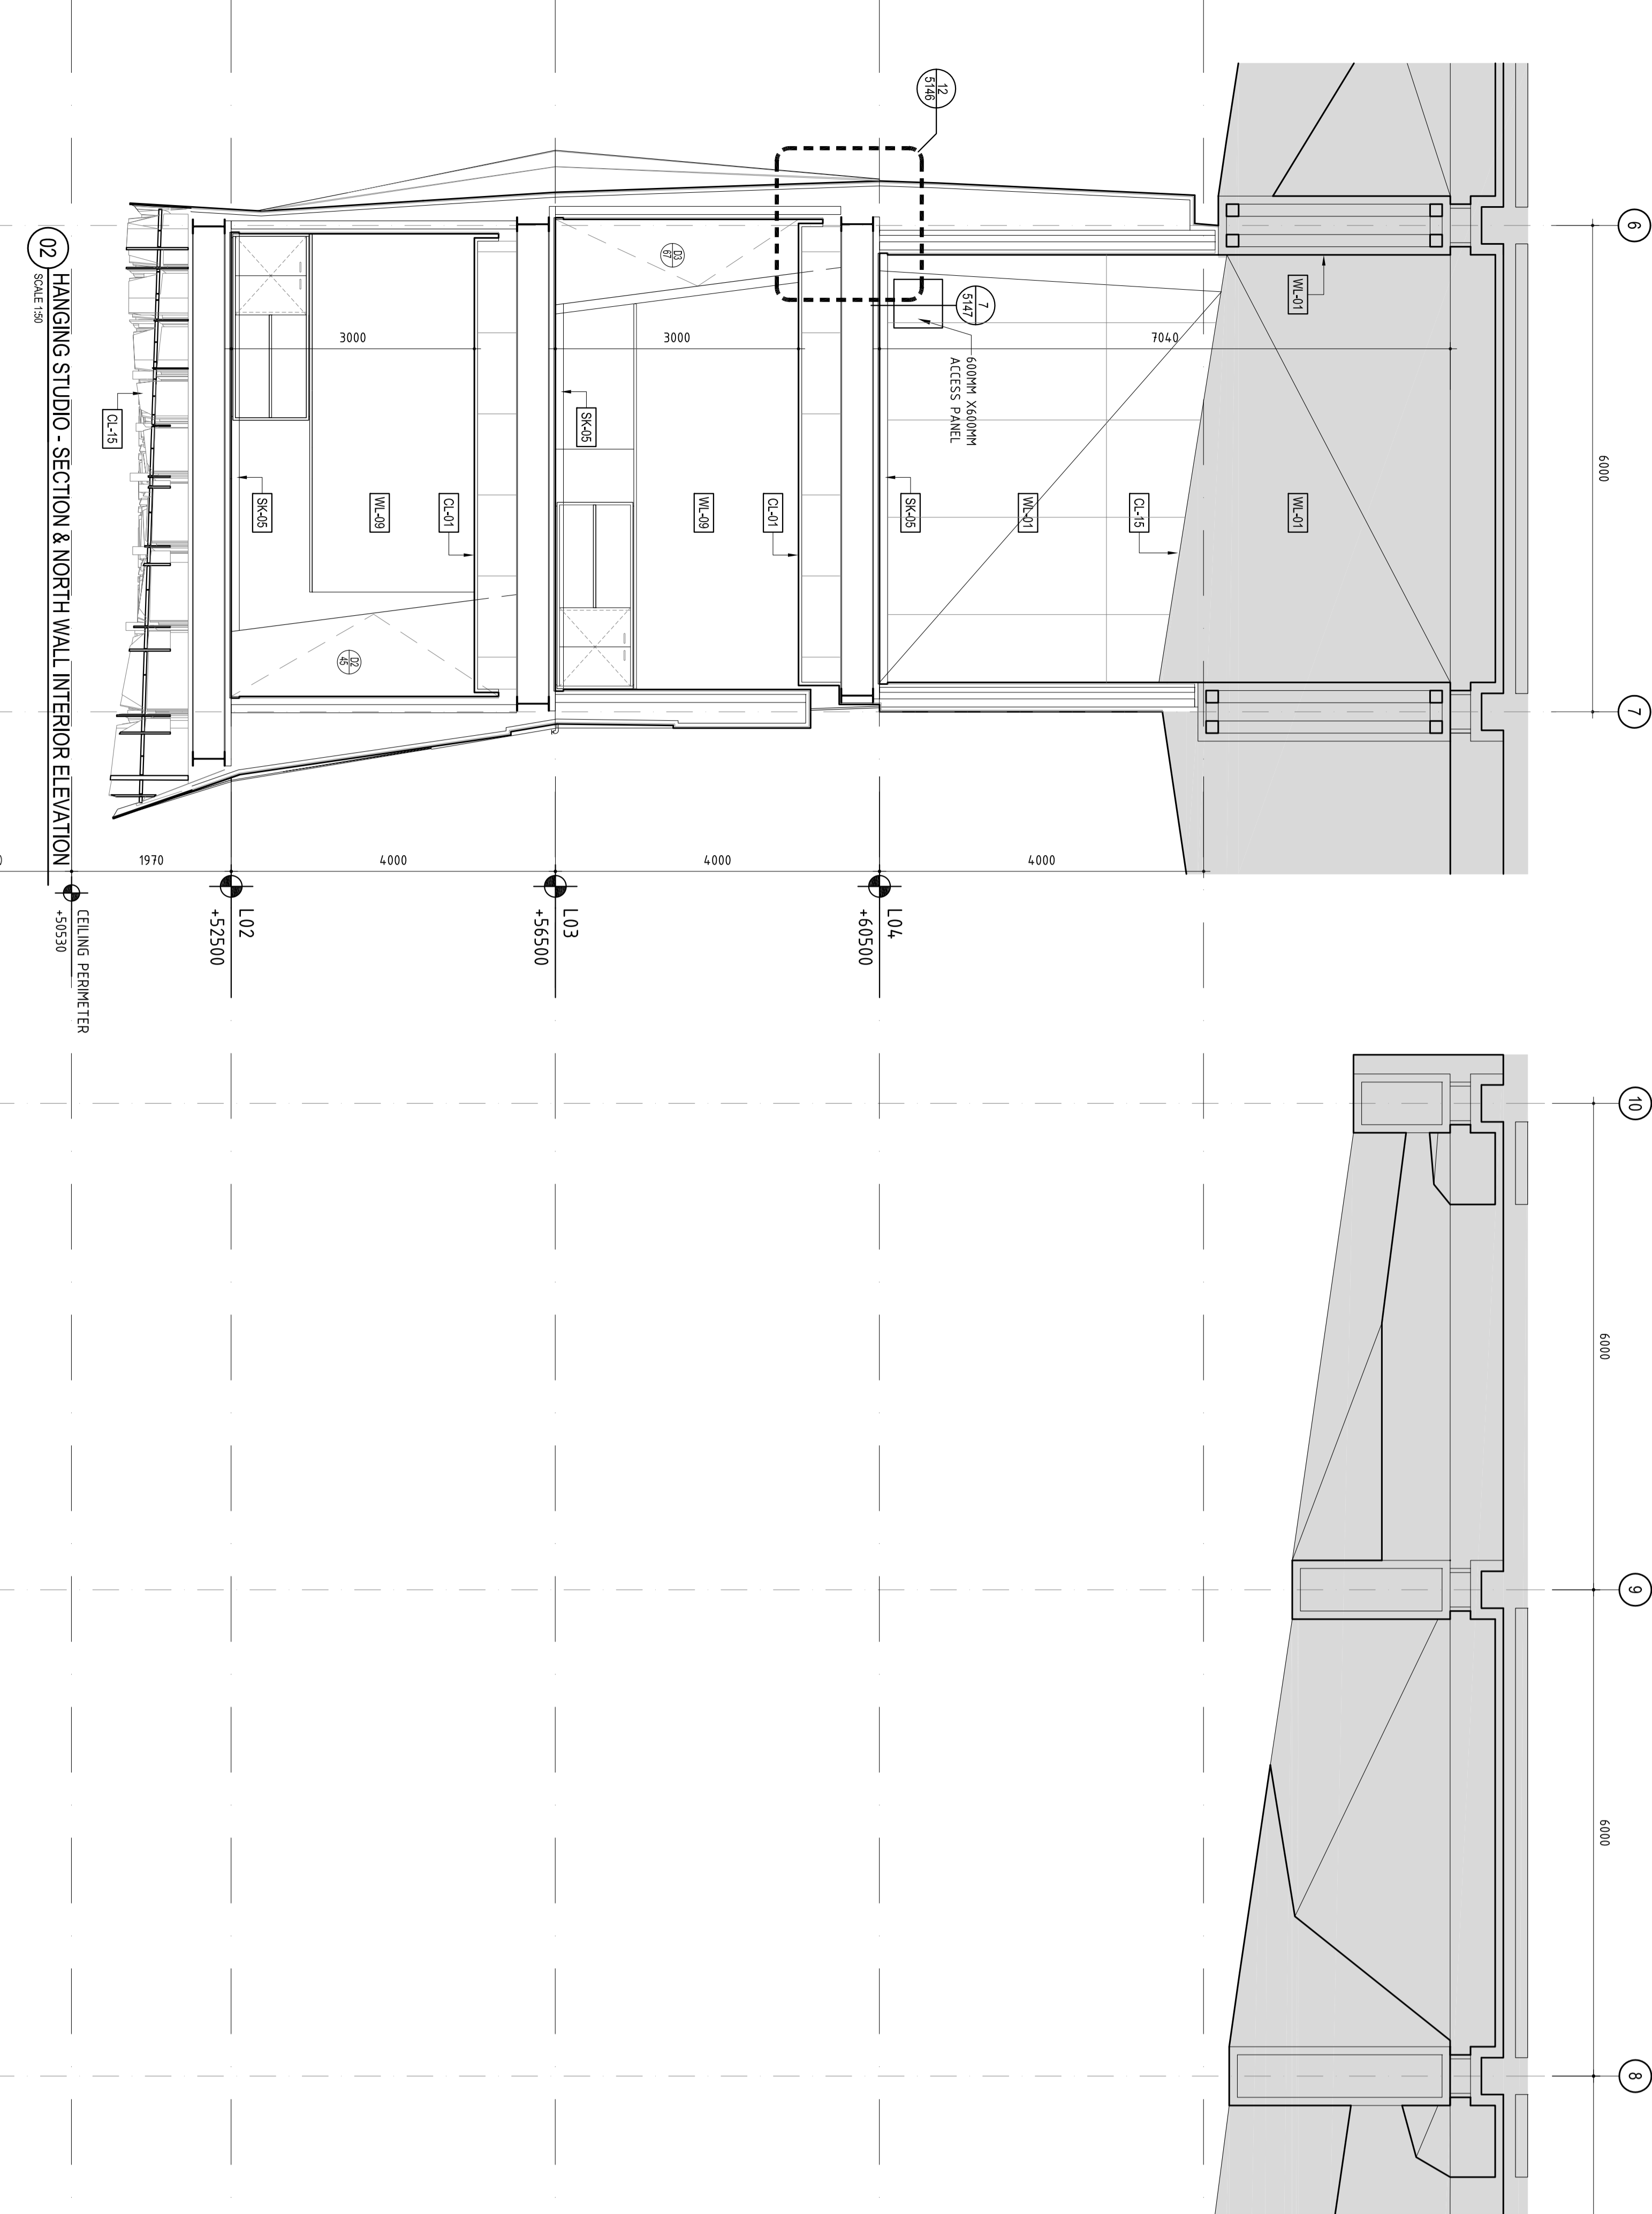
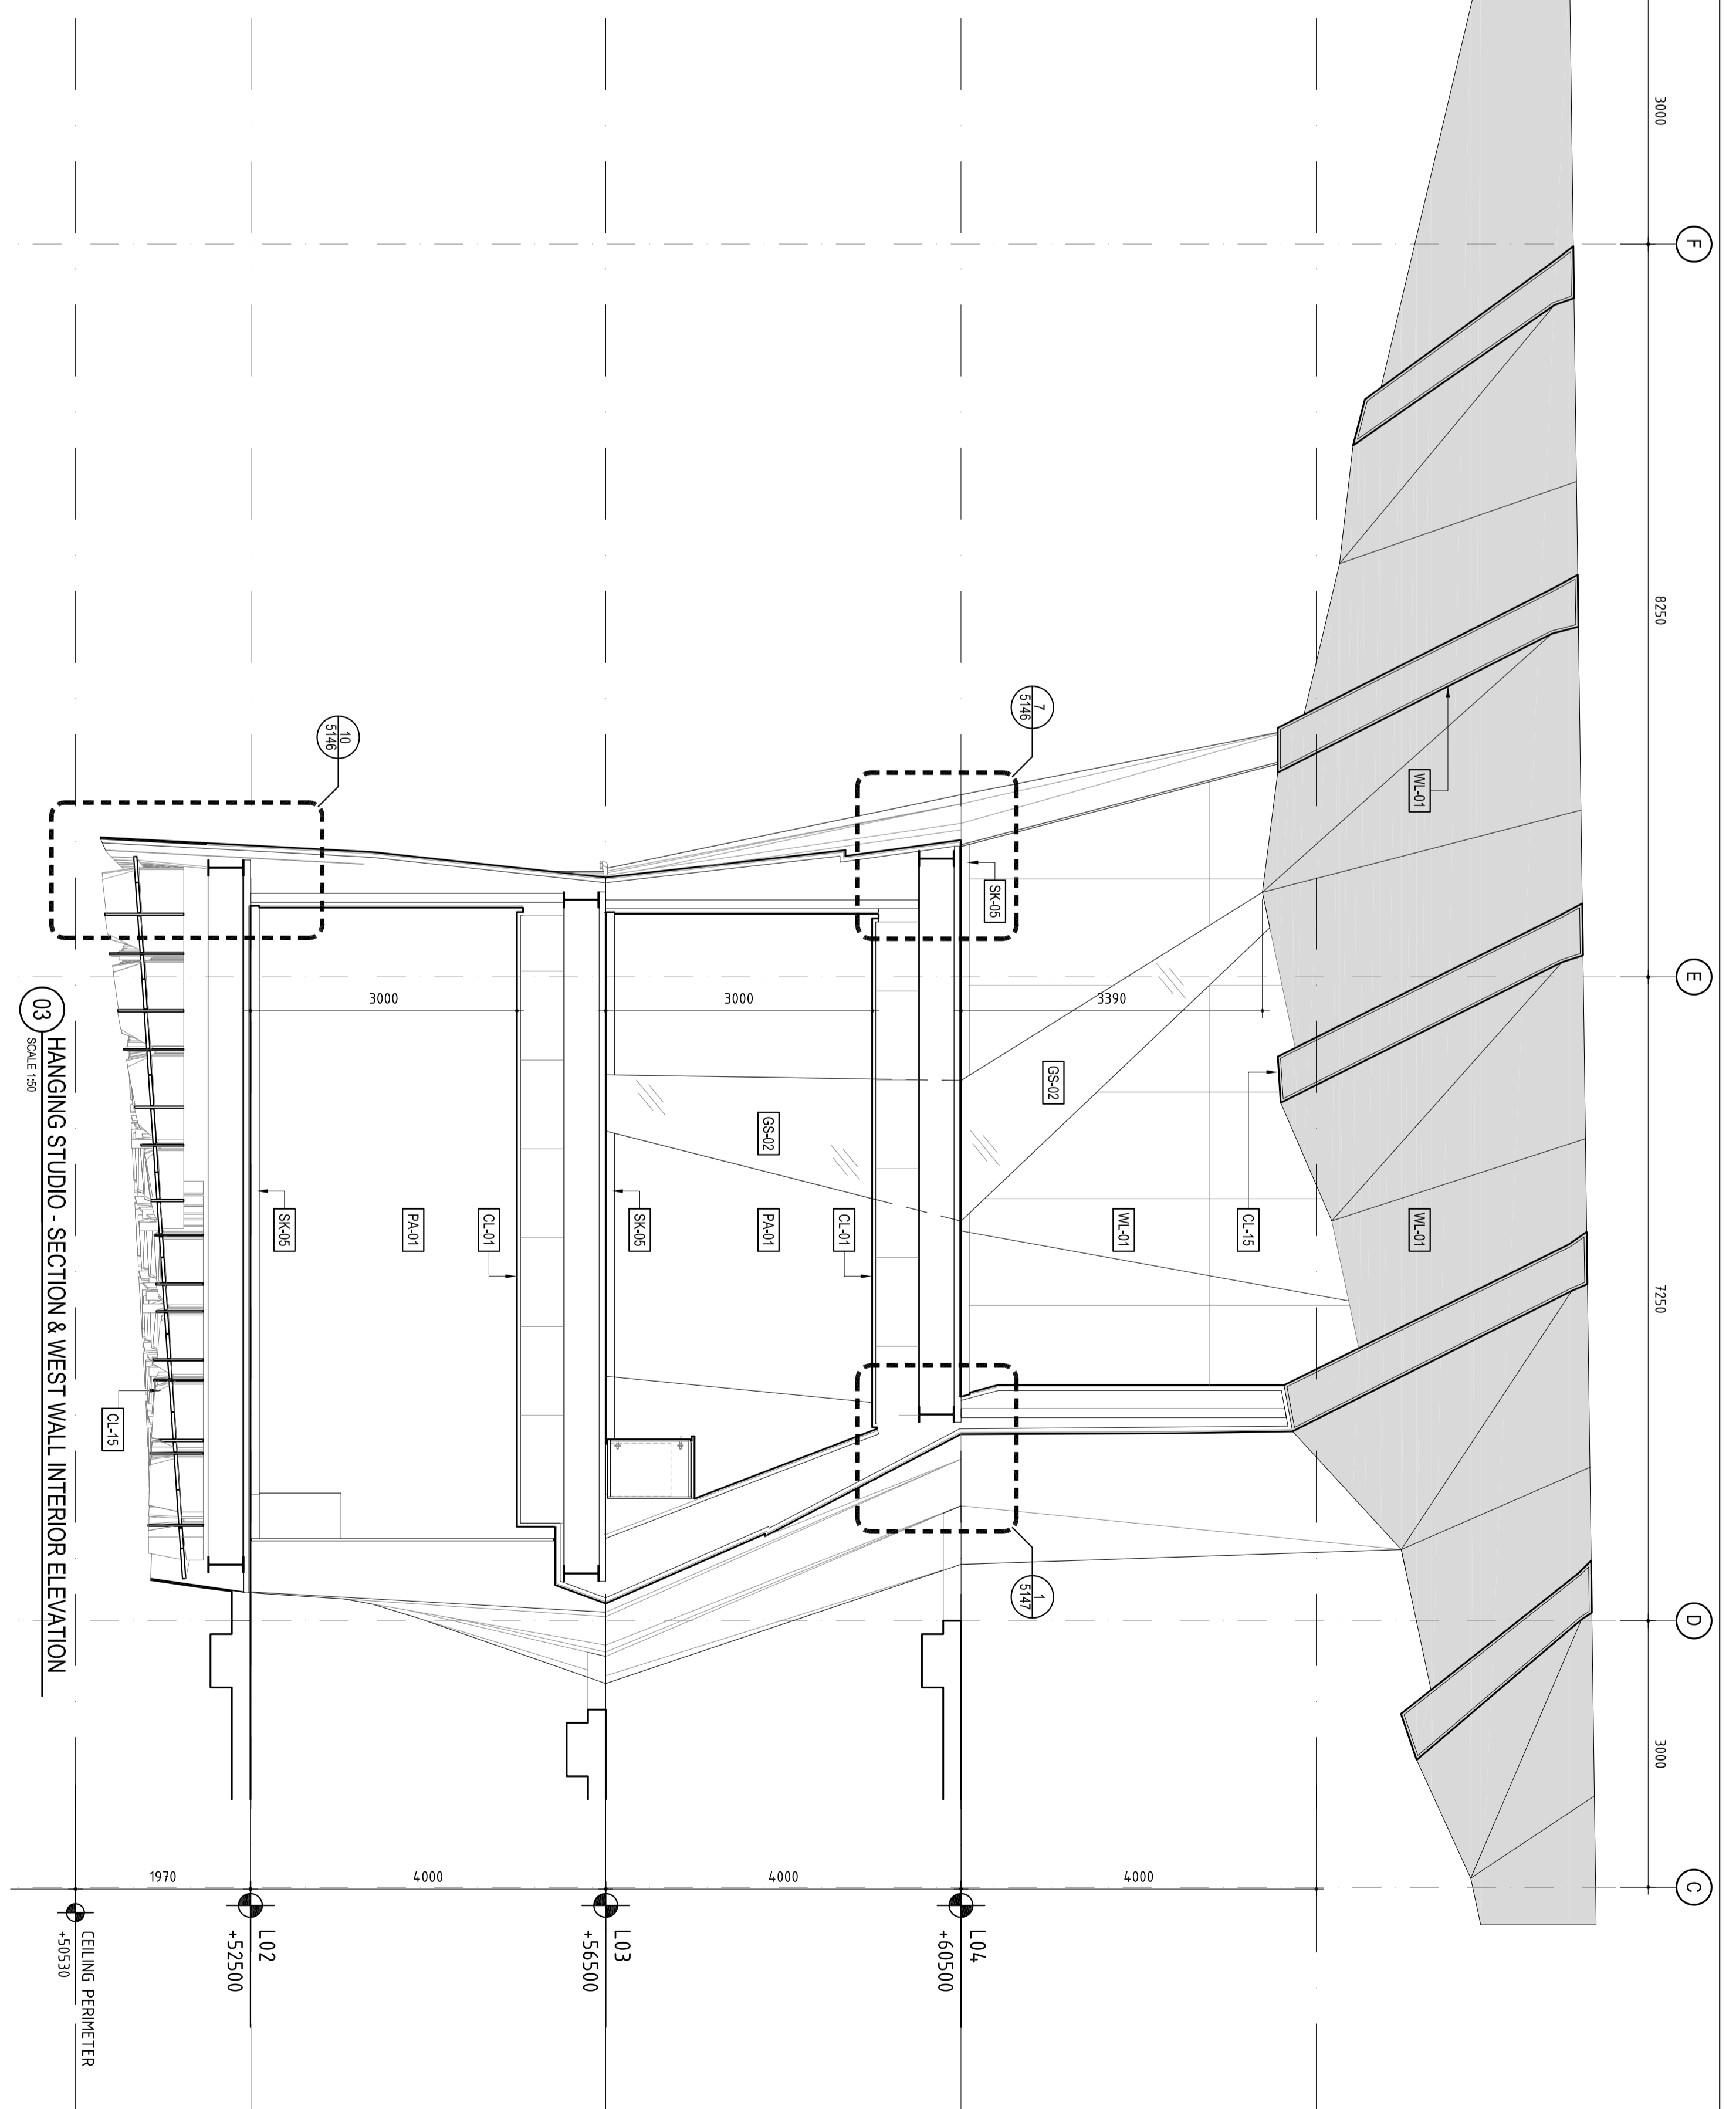


THIS DRAWING IS AN UNCONTROLLED COPY UNLESS STAMPED OTHERWISE.  
 CONTRACTOR SHALL VERIFY DIMENSIONS BEFORE ANY COMMENCEMENT OF WORK.  
 ALL DIMENSIONS SHALL BE TAKEN FROM THE FACE UNLESS OTHERWISE SPECIFIED.  
 THE CONTRACTOR SHALL BE RESPONSIBLE FOR OBTAINING ALL NECESSARY PERMITS AND APPROVALS.  
 THE CONTRACTOR SHALL BE RESPONSIBLE FOR OBTAINING ALL NECESSARY PERMITS AND APPROVALS.  
 AND OBTAINING CONSENT OF THE SHOWN IN VERTICAL PLANE.

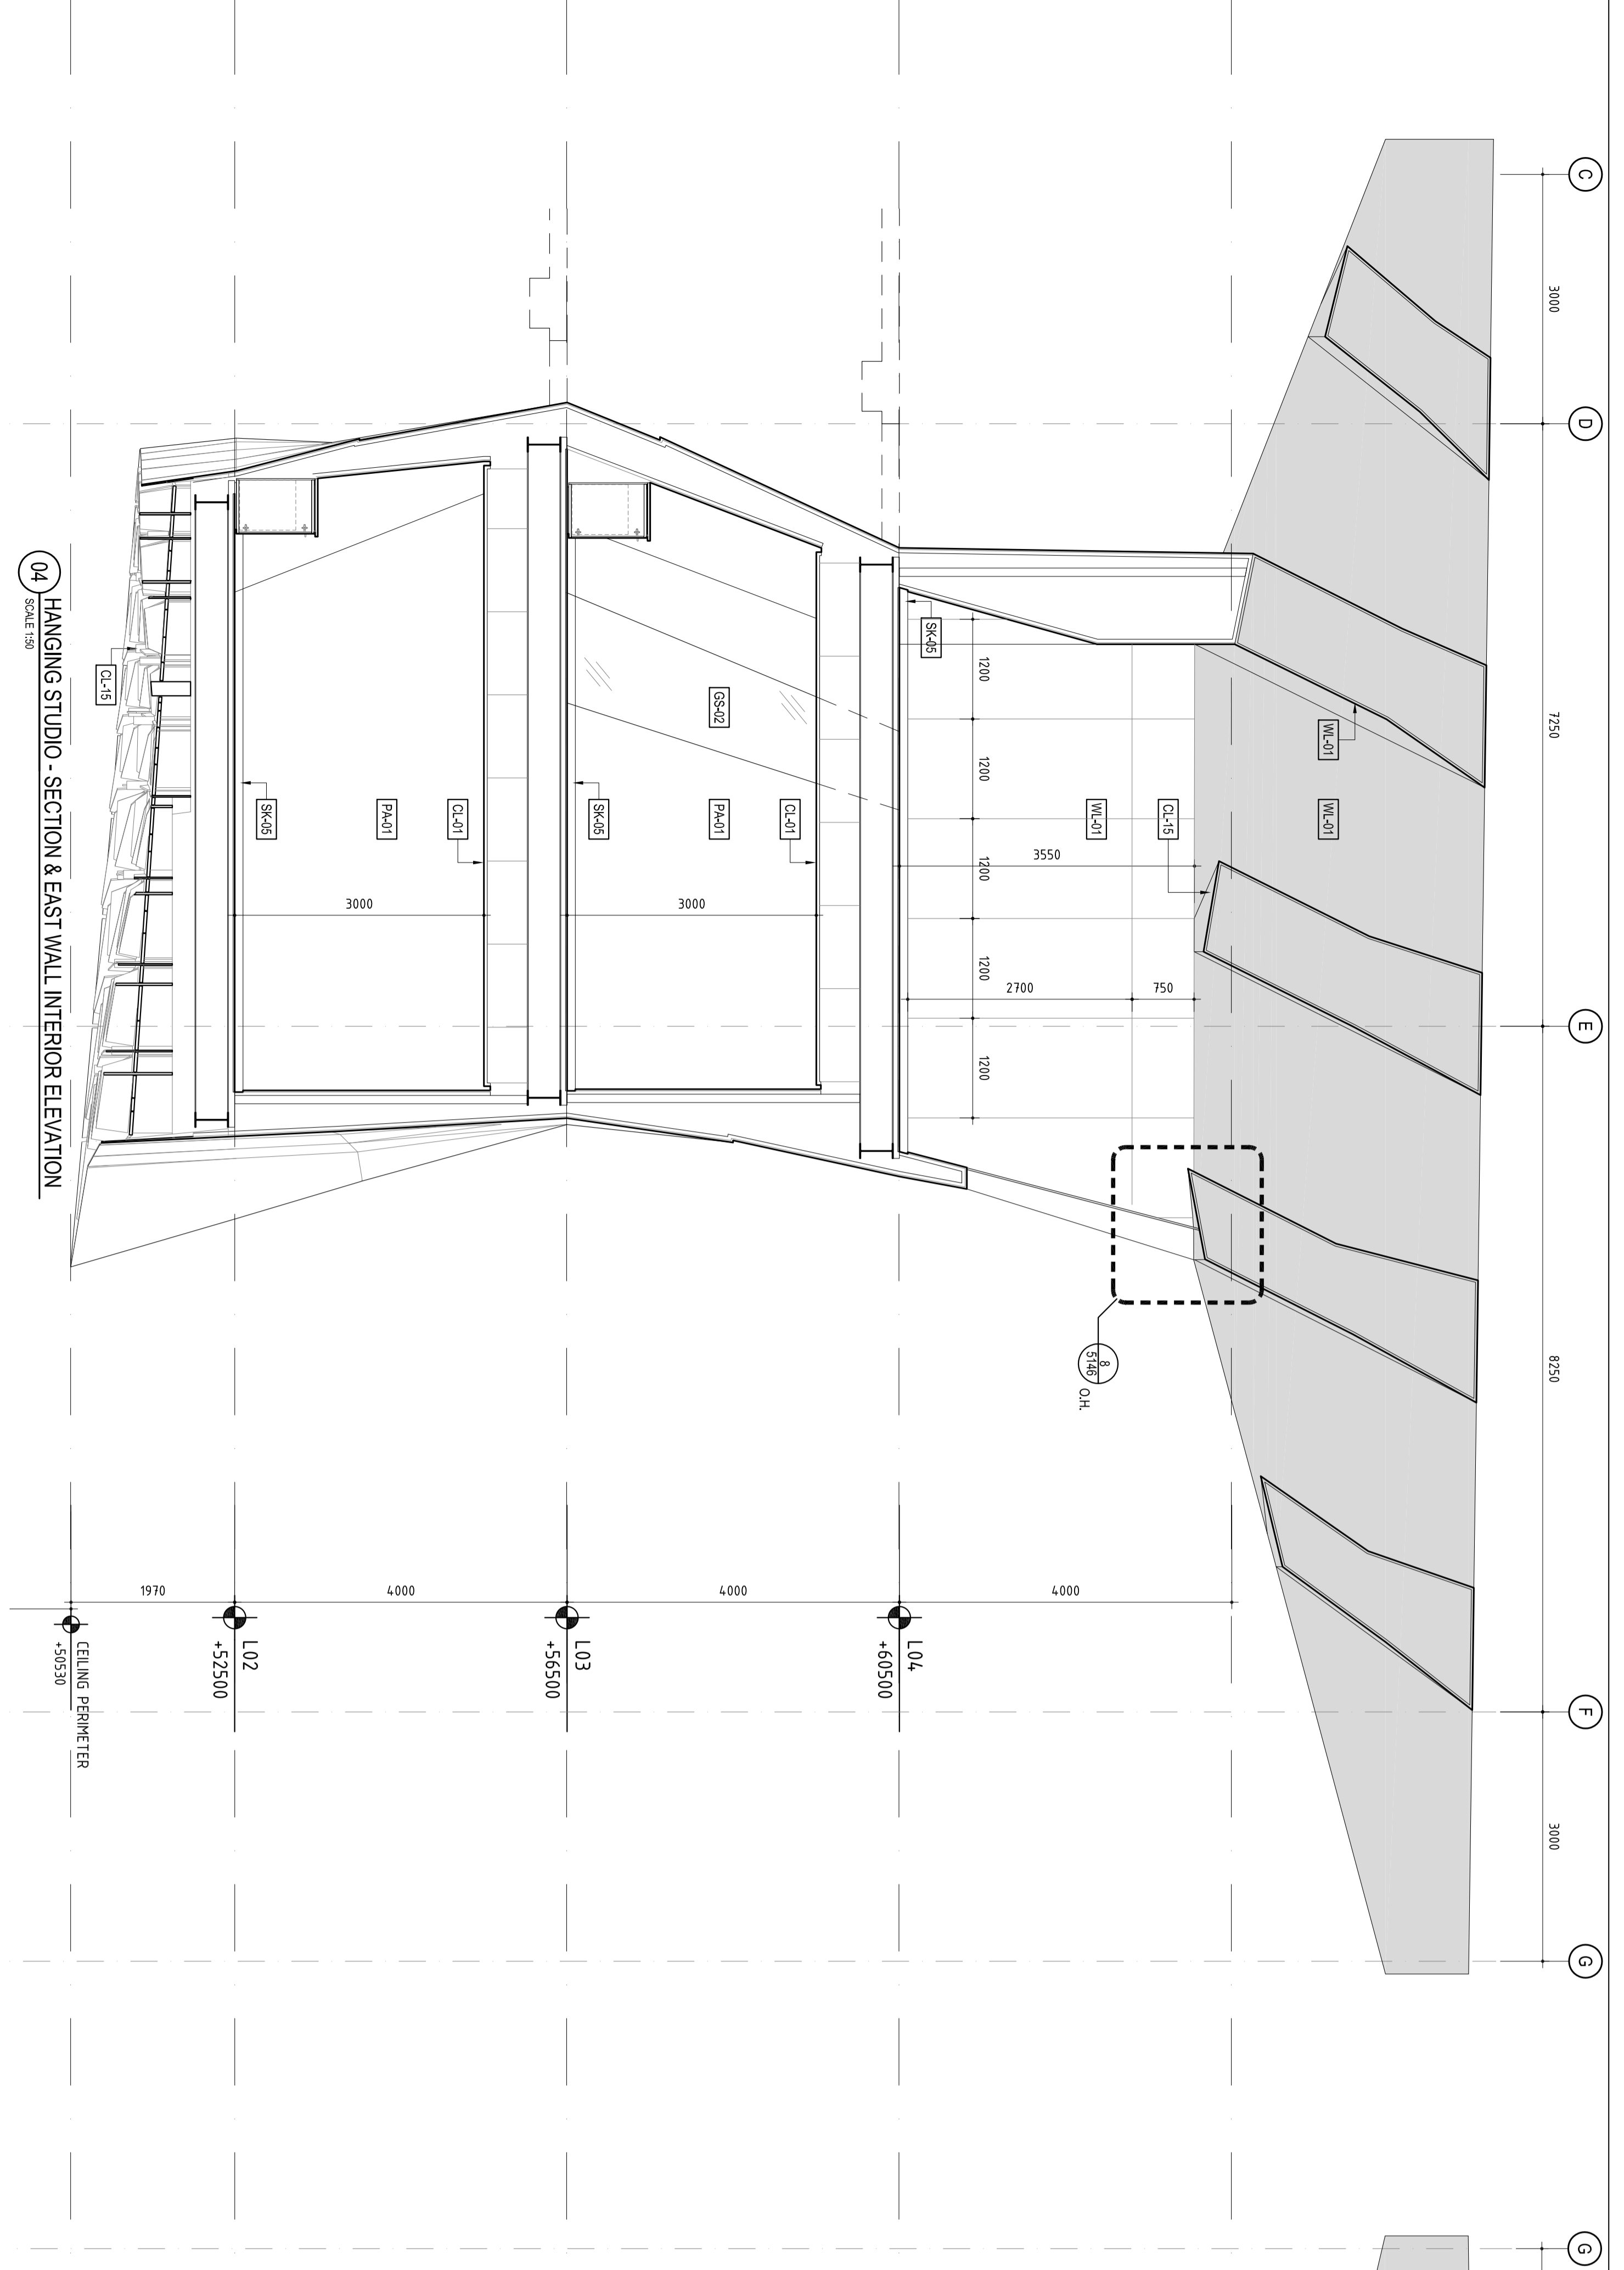

Rev	Issue	Revision Description	And	Date
1	1	CONSTRUCTION ISSUE		10/11/14
2	2	TENDER ISSUE		27/08/13
3	3	VALUE MANAGEMENT ISSUE		26/03/13
4	4	TENDER ISSUE		07/08/12
5	5	100% CD - TENDER ISSUE		10/08/12
6	6	90% CD ISSUE		17/08/12
7	7	50% CD ISSUE		07/08/12
8	8	25% CD ISSUE		26/03/12
9	9	FINAL CD ISSUE		26/03/12
10	10	PERMANENT ELEMENT ISSUE		20/01/12
11	11	PERMANENT ELEMENT ISSUE		20/01/12
12	12	PERMANENT ELEMENT ISSUE		20/01/12

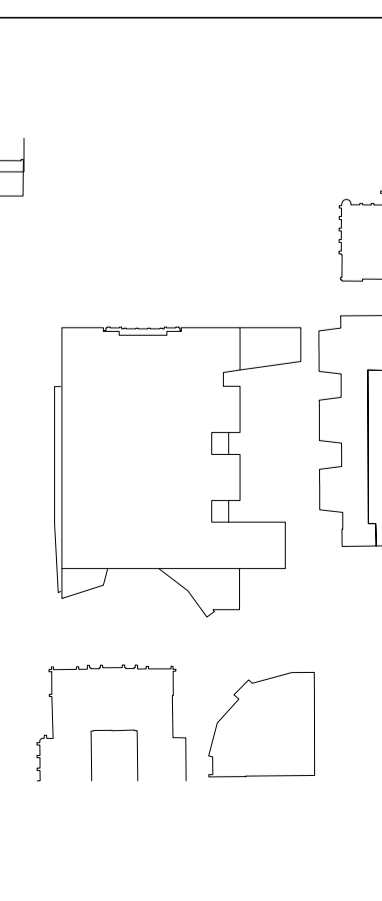

**NADAAA**  
 NADAAA  
 140/144  
 150/150  
 160/160  
 170/170  
 1000/1000

**John Wardle Architects**  
 140/144  
 150/150  
 160/160  
 170/170  
 1000/1000

**University of Melbourne**  
 Parkville Campus  
 Faculty of Architecture  
 Building and Planning  
 THE HANGING STUDIO  
 SECTIONS

Project No. **0913** Scale 1:50  
 Drawing No. **AR5121** Rev. **A**  
 Date: JAN 2014  
 Drawn: [Signature] Checked: [Signature]  
**FOR CONSTRUCTION**