


THIS DRAWING IS AN UNCONTROLLED COPY UNLESS STAMPED OTHERWISE  
 CONTRACTORS SHALL VERIFY JOB DIMENSIONS BEFORE ANY JOB COMMENCES.  
 ALL UNDERSIGNED CONTRACTORS AGREE THAT NO WORK ON THE PROJECT OR STRUCTURE  
 SHALL NOT COMMENCE PRIOR TO THE RETURN OF UNAMENDED SHOP DRAWINGS SIGNED  
 BY THE CONTRACTANT AND APPROVED BY THE ARCHITECT. THIS DRAWING IS THE PROPERTY OF  
 NADAAN. THIS DRAWING IS THE PROPERTY OF JOHN WARDLE ARCHITECTS PTY LTD. THIS DRAWING IS  
 PRINTED FOR INTERNAL USE ONLY. THIS DRAWING IS THE PROPERTY OF JOHN WARDLE ARCHITECTS PTY LTD.

- General Notes  
 1. PERFORATIONS OCCUR IN FOUR SIZES:  
     ○ = DIAMETER OF 10mm  
     ○ = DIAMETER OF 15mm  
     ○ = DIAMETER OF 20mm  
     ○ = DIAMETER OF 25mm  
 2. ALL DIGITAL ARTWORK FILES WILL BE PROVIDED BY ARCHITECT.  
 3. CONTRACTORS TO REFER TO RELATED ARCHITECTURAL SPECIFICATION  
 SECTIONS FOR 3D MODEL INTEGRATION REQUIREMENTS.  
 4. NO VENEER AT EDGE UNLESS OTHERWISE NOTED

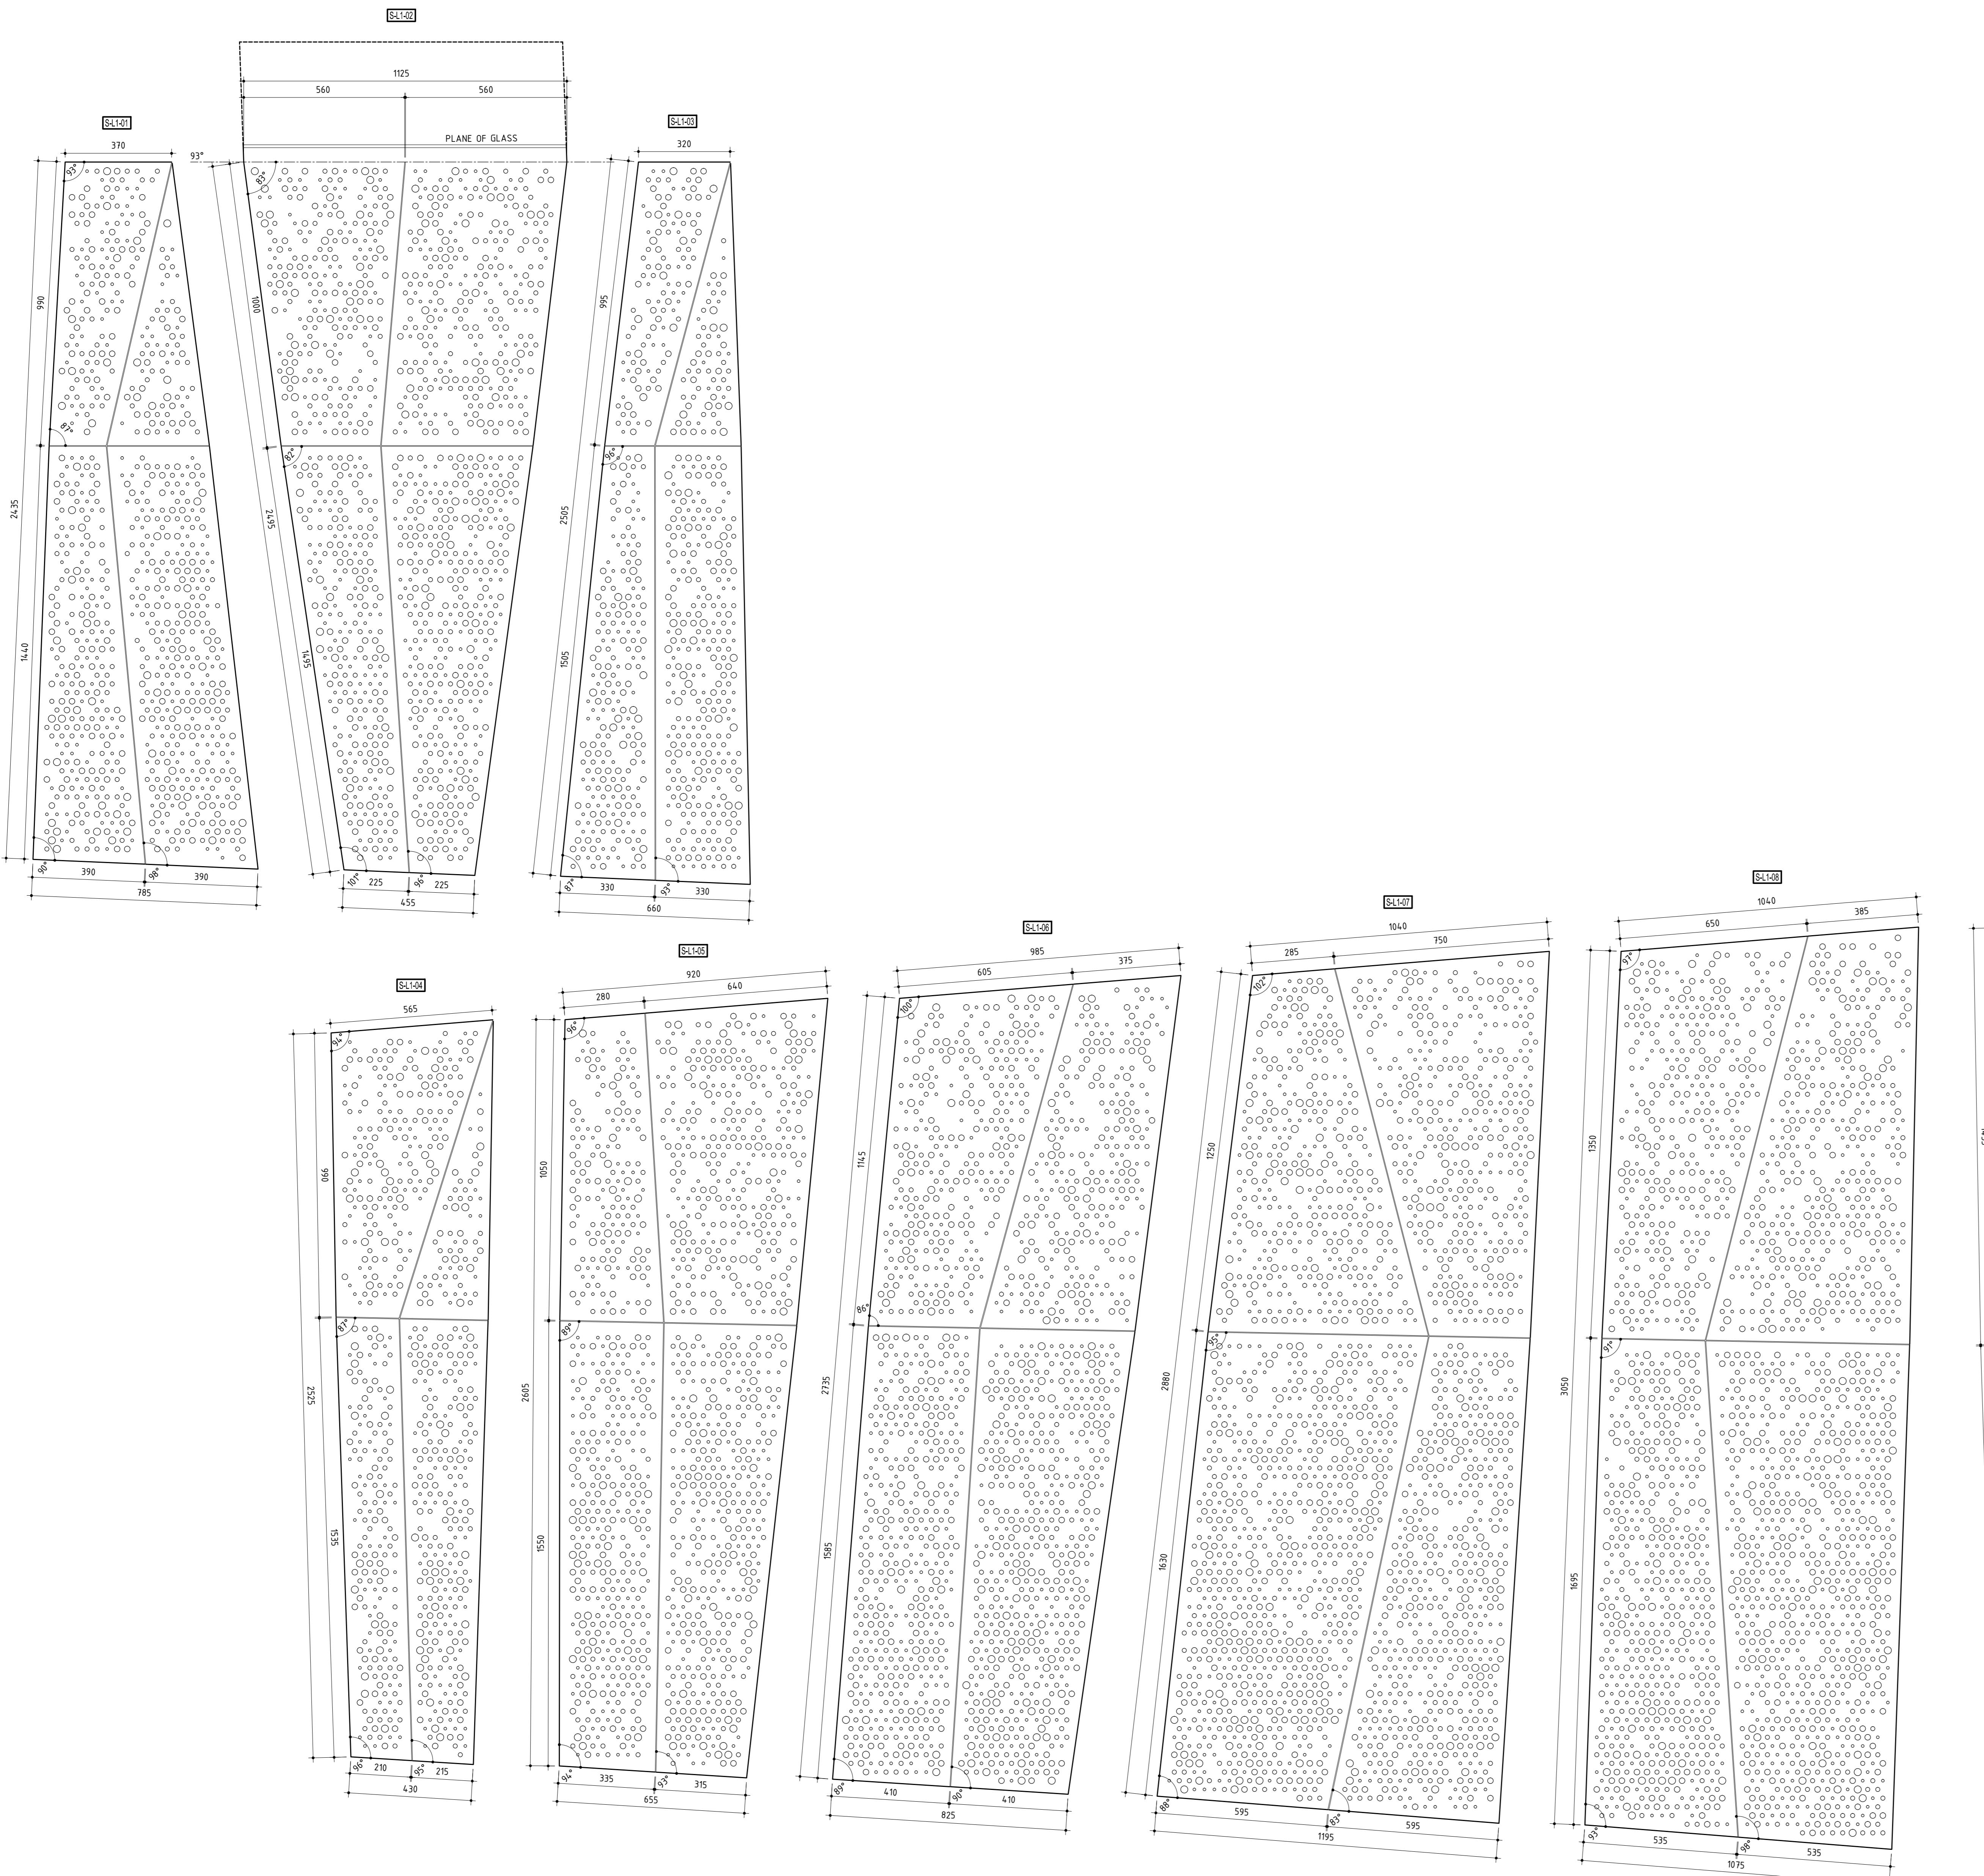

01 UNFOLDED PANELS: S-L1-00 THROUGH S-L1-08

Project No.	0913	Scale 1:10 @ A0
Drawing No.	AR5136	1:20 @ A2
Revision	A	
Date JAN 2014	Drwn -	Co-Ord -
FILENAME - ####	Chck -	

**John Wardle Architects**

© 2011 John Wardle Architects  
 Level 10, 180 Russell Street, Melbourne Victoria 3000 Australia  
 Tel: +61 3 9654 8700 [www.johnwardlearchitects.com](http://www.johnwardlearchitects.com)

Client  
 University of Melbourne  
 Parkville Campus

Project  
 Faculty of Architecture  
 Building and Planning


Title HANGING STUDIO  
 UNFOLDED PANELS

Project No. 0913 Scale 1:10 @ A0  
 Drawing No. AR5136 Revision A

Date JAN 2014 Drwn - Co-Ord - Chck -  
 FILENAME - ####

FOR CONSTRUCTION

SOUTH FACE: PANELS S-L1-01 THROUGH S-L1-09

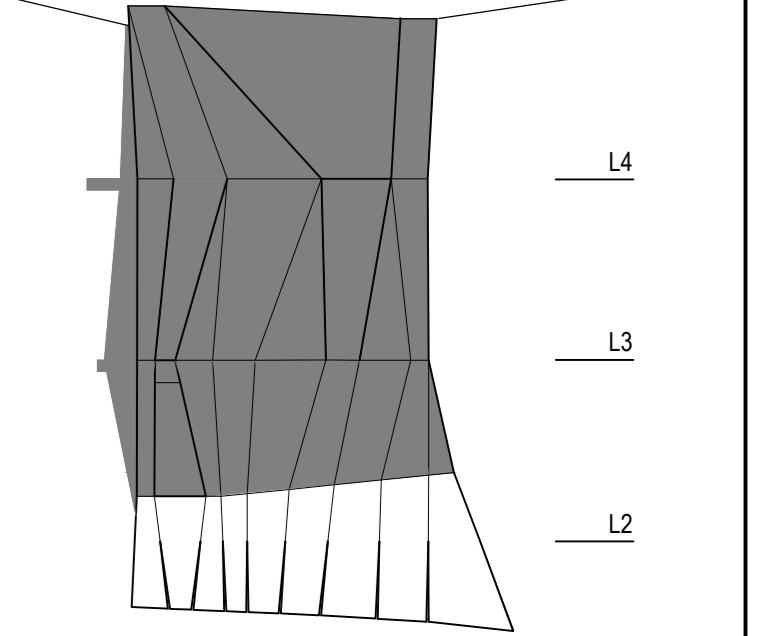

A	SG	CONSTRUCTION ISSUE	-	06.01.14
04	JC	100% CD - TENDER ISSUE	-	07.09.12
03	JC	90% CD ISSUE	-	10.09.12
02	JC	75% CD ISSUE	-	13.09.12
01	JC	50% CD ISSUE	-	01.08.12
Rev	Issue	Revision Description	Amend	Date

NADAAN  
 1020 Washington  
 Street No 2  
 Boston  
 Massachusetts  
 02118 USA  
 Telephone  
 +1 617 442 6232  
 Facsimile  
 +1 617 442 1417  
 Email  
 nada@nadaan.com

John Wardle  
 Architects