



THIS DRAWING IS AN UNCONTROLLED COPY UNLESS STAMPED OTHERWISE

CONTRACTORS SHALL VERIFY ALL DIMENSIONS BEFORE ANY JOB COMMENCES. ALL SHOP DRAWINGS SHALL BE SUBMITTED TO THE SUPERVISOR AND MANUFACTURE SHALL NOT COMMENCE PRIOR TO THE RETURN OF UNANIMATED SHOP DRAWINGS SIGNED BY THE CONSULTANT. DIMENSIONS SHALL TAKE PRECEDENCE OVER SCALES. THIS DRAWING SHALL BE READ IN CONJUNCTION WITH ALL RELEVANT CONTRACT SPECIFICATIONS AND DRAWINGS COPYRIGHT OF THE DRAWING IS TESTED IN WARE.


General Notes

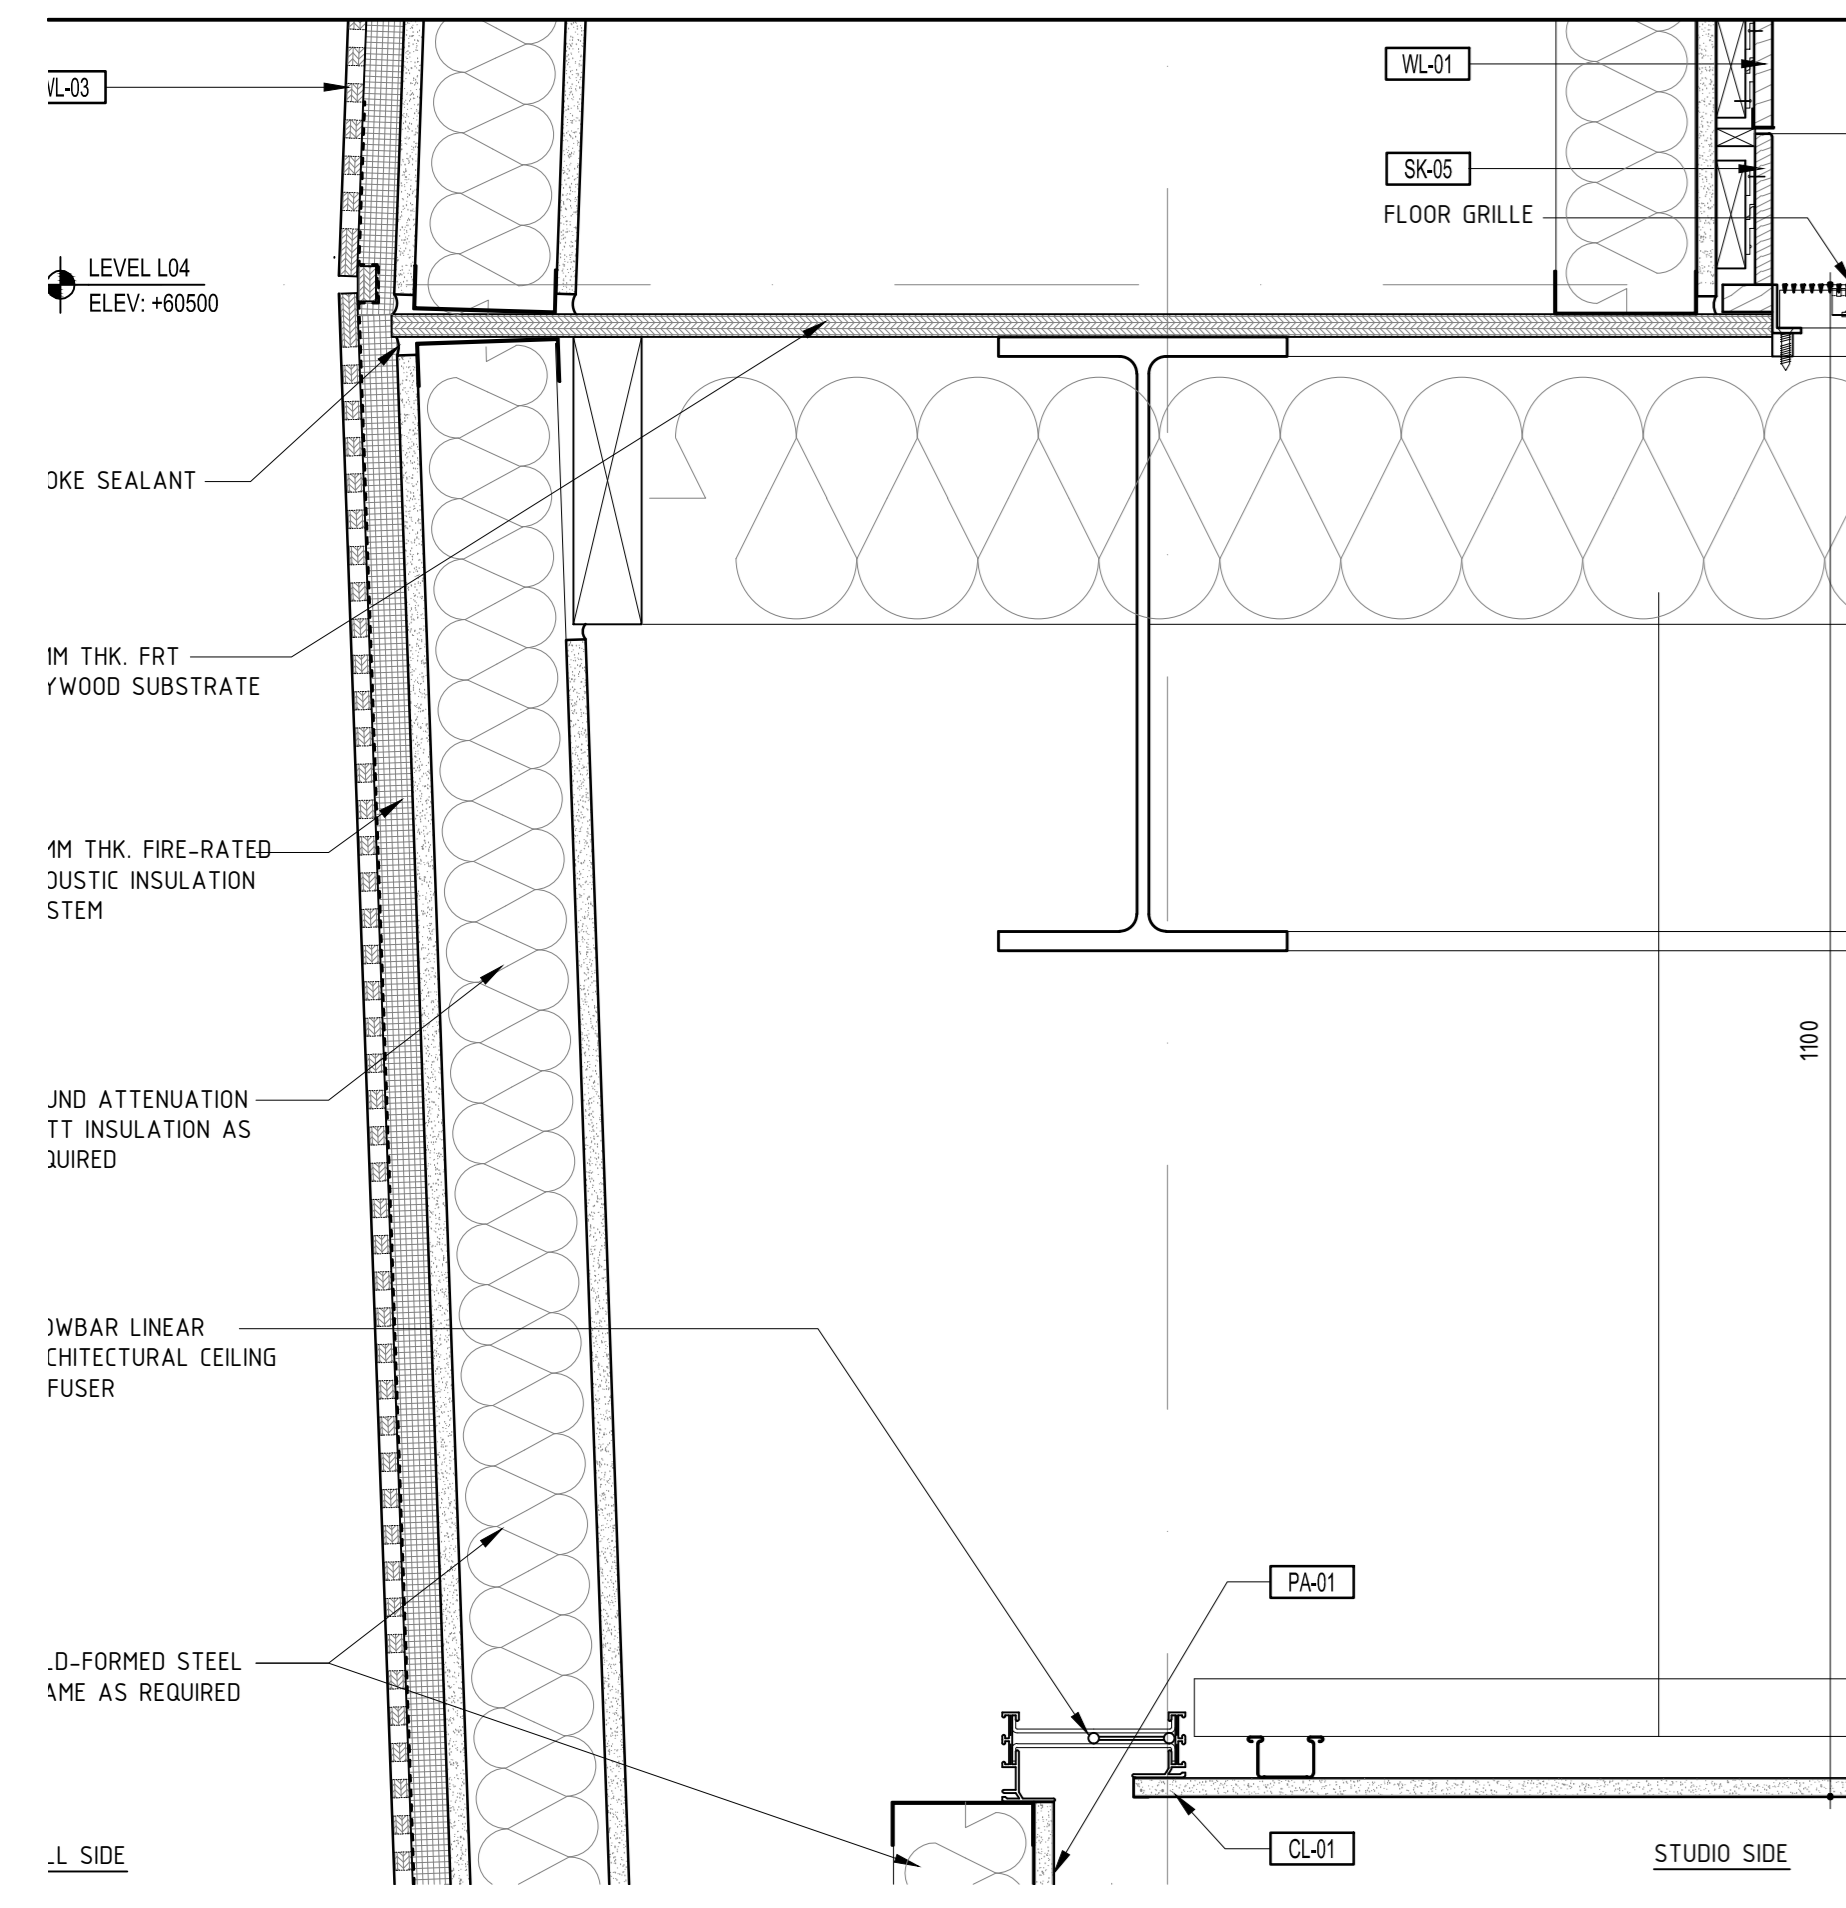


12 SECTION DETAIL - SLAB EDGE  
SCALE: 1:5

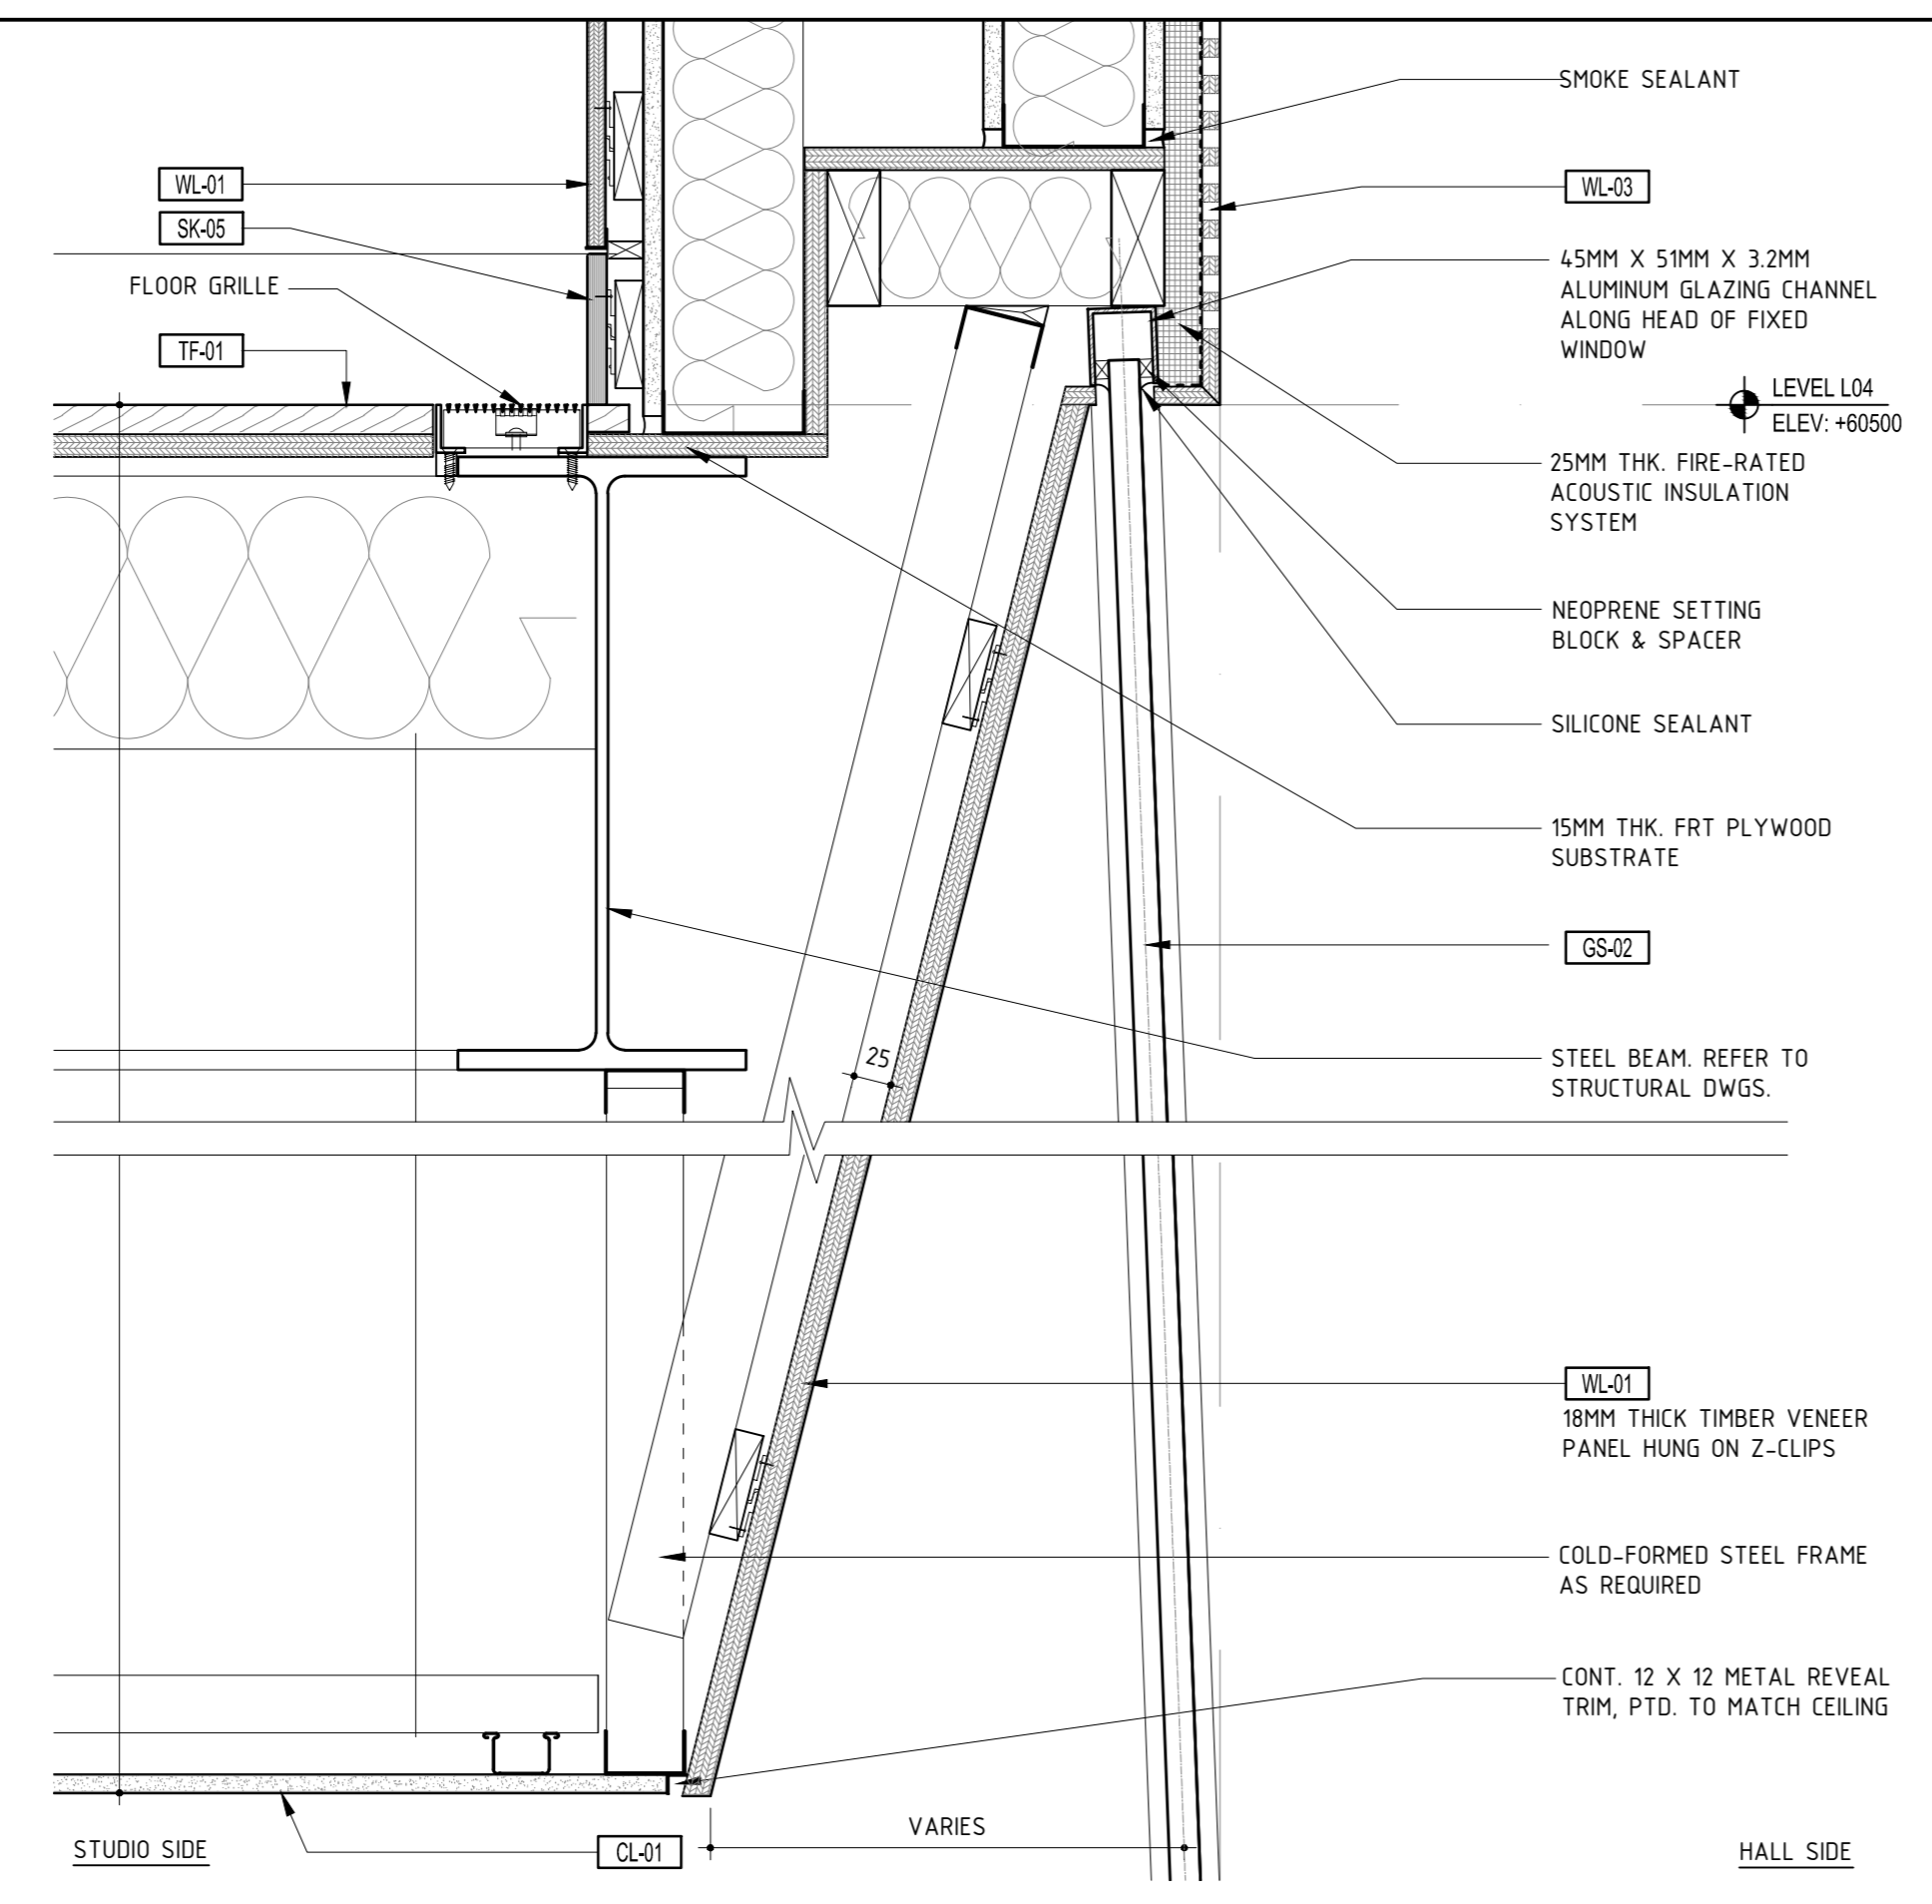


09 SECTION DETAIL - LEVEL 4 @ HEAD OF LEVEL 3 EAST WINDOW  
SCALE: 1:1

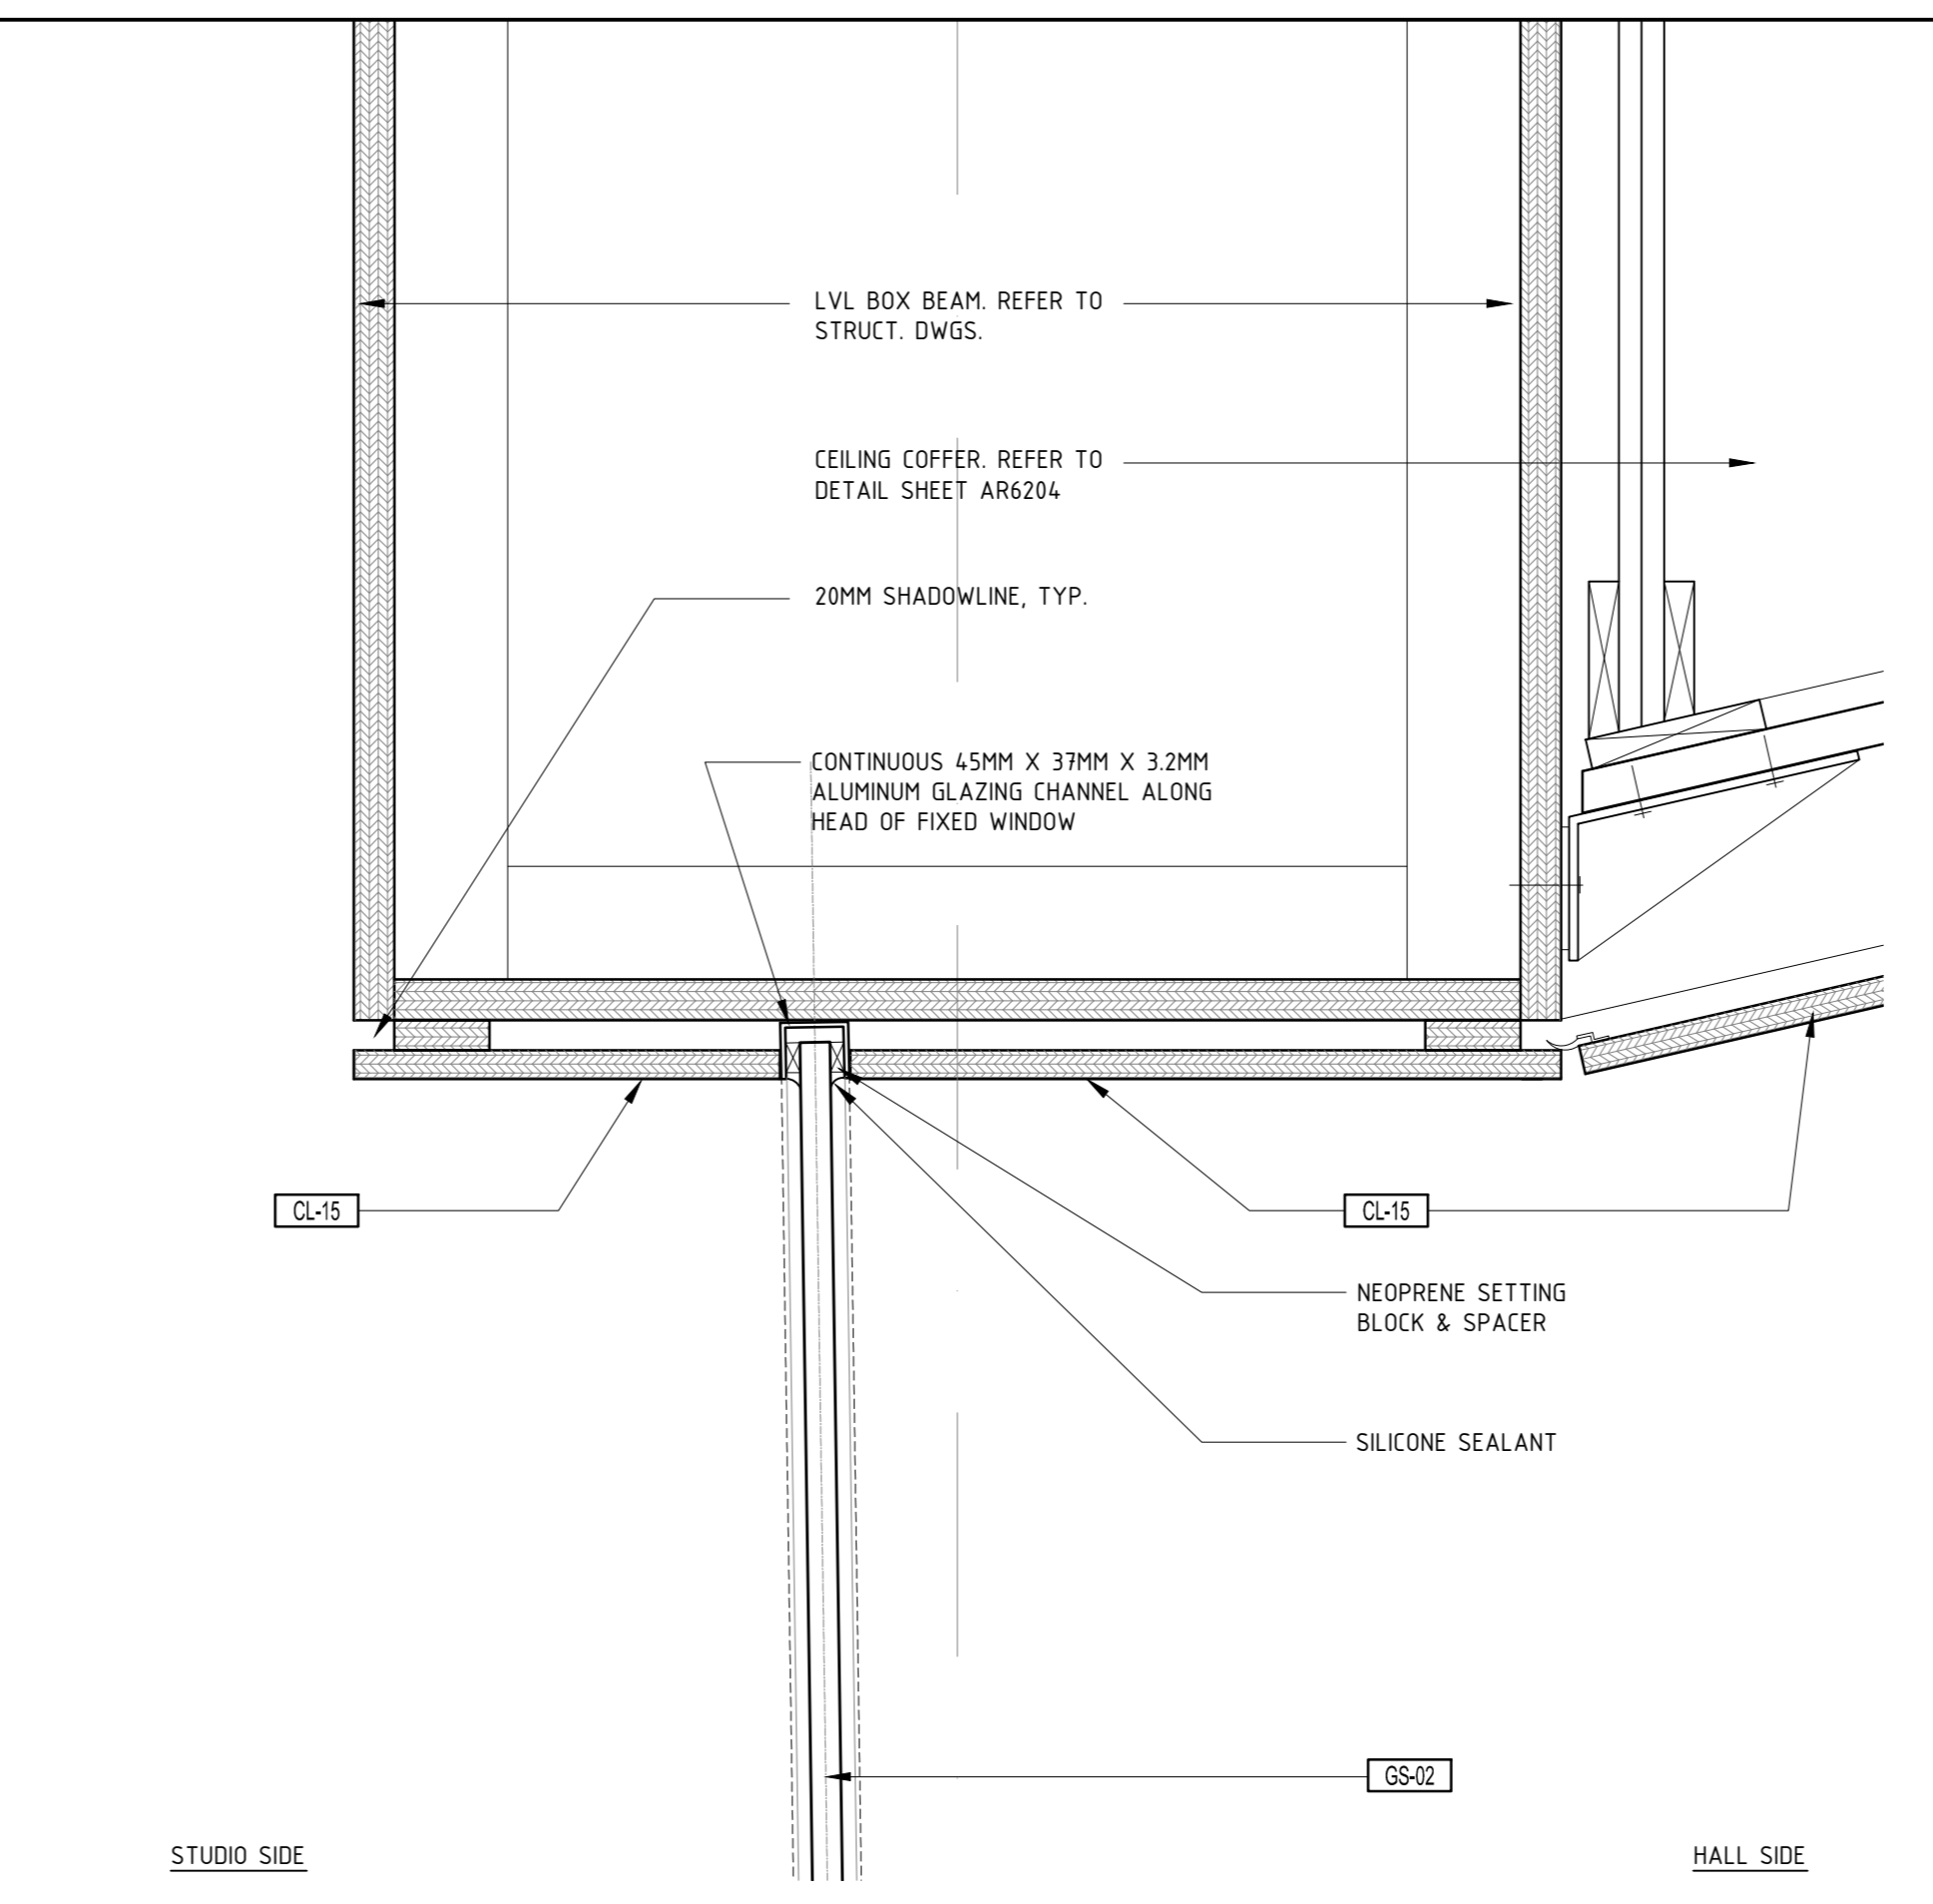


06 SECTION DETAIL - LEVEL 4 WEST WINDOW HEAD  
SCALE: 1:5

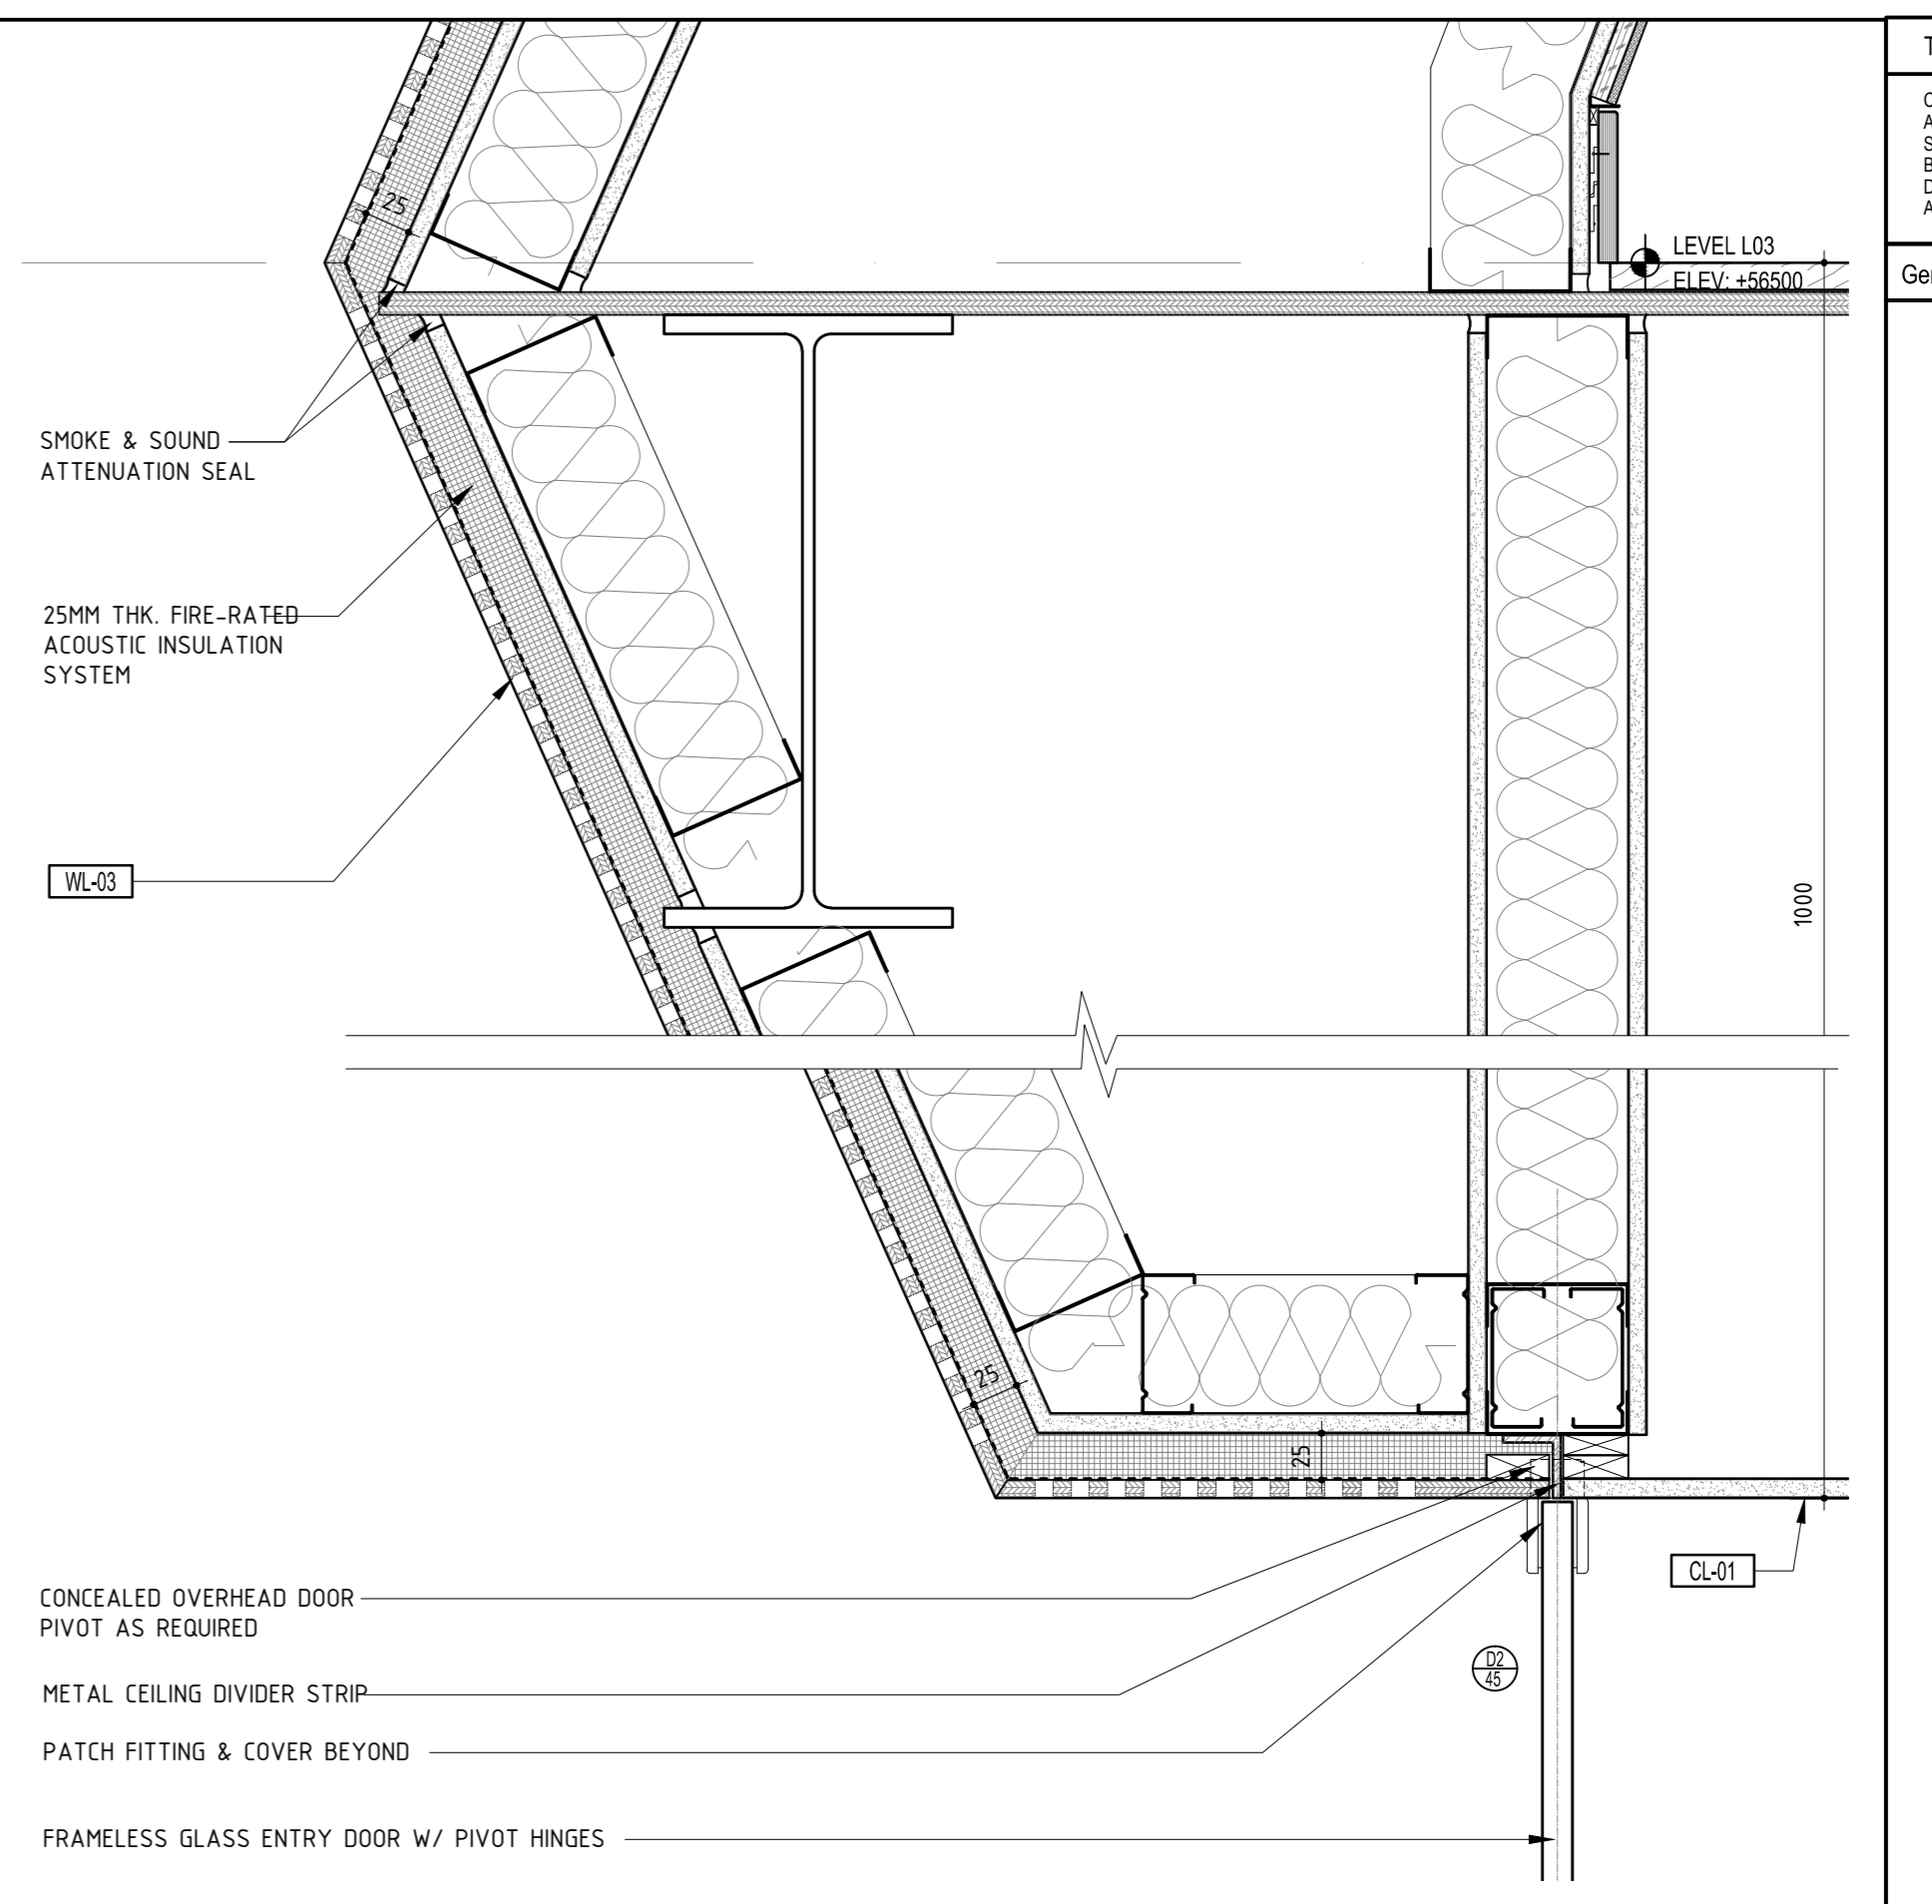


03 SECTION DETAIL - LEVEL 2 ENTRY DOOR HEAD  
SCALE: 1:5

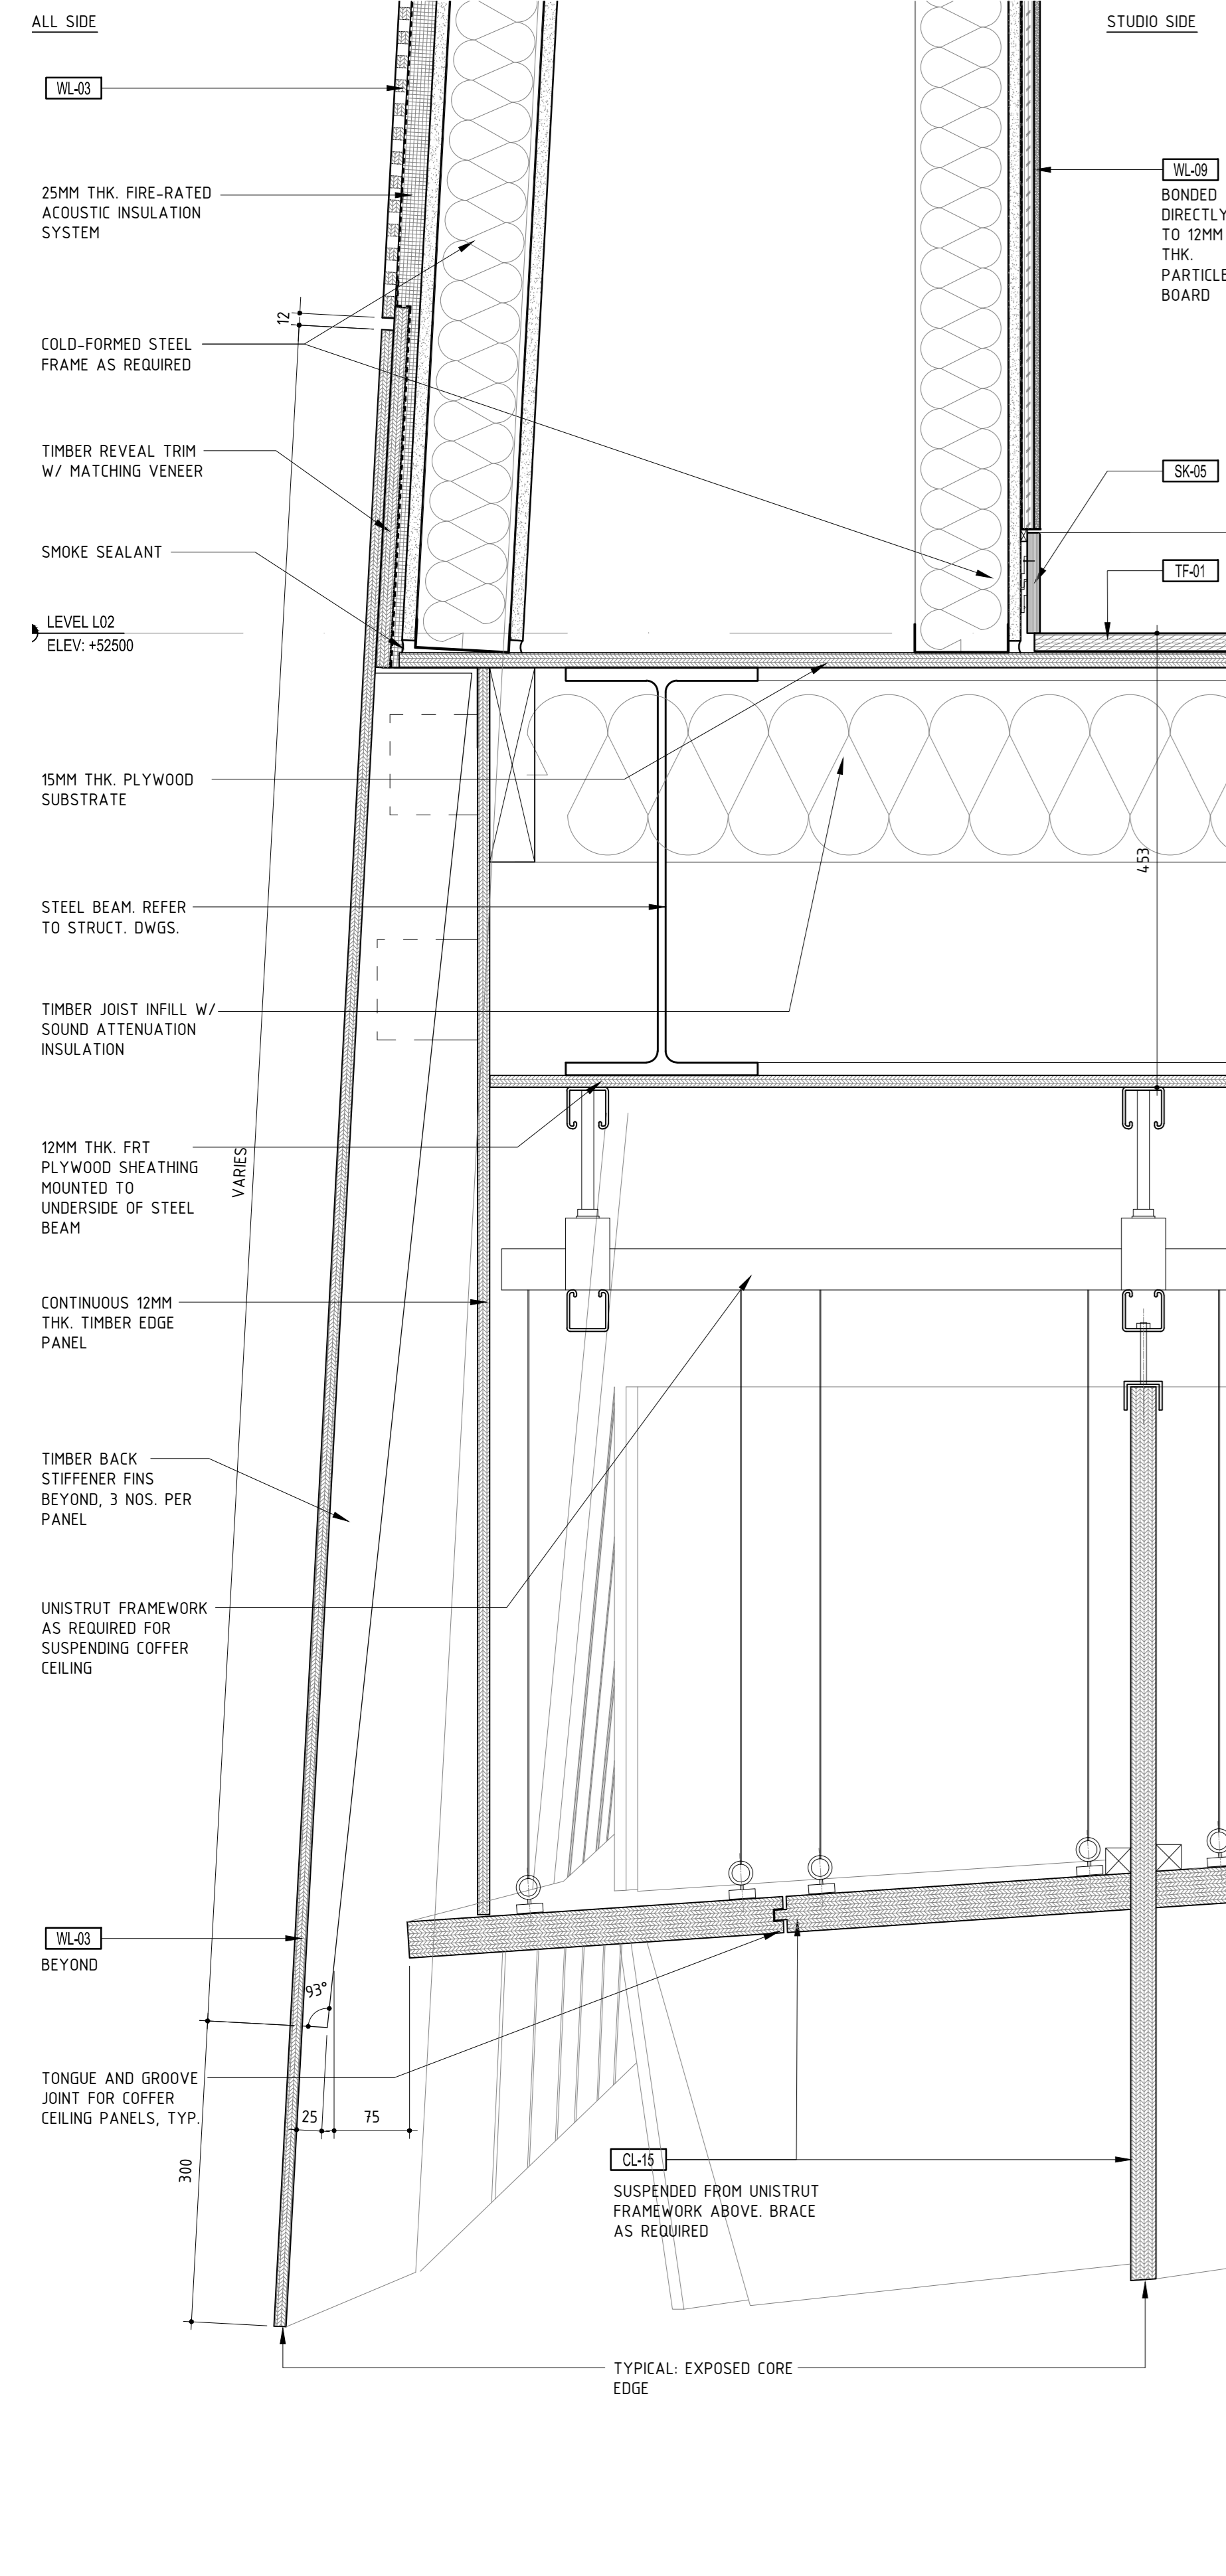


10 SECTION DETAIL - WALL BASE  
SCALE: 1:5

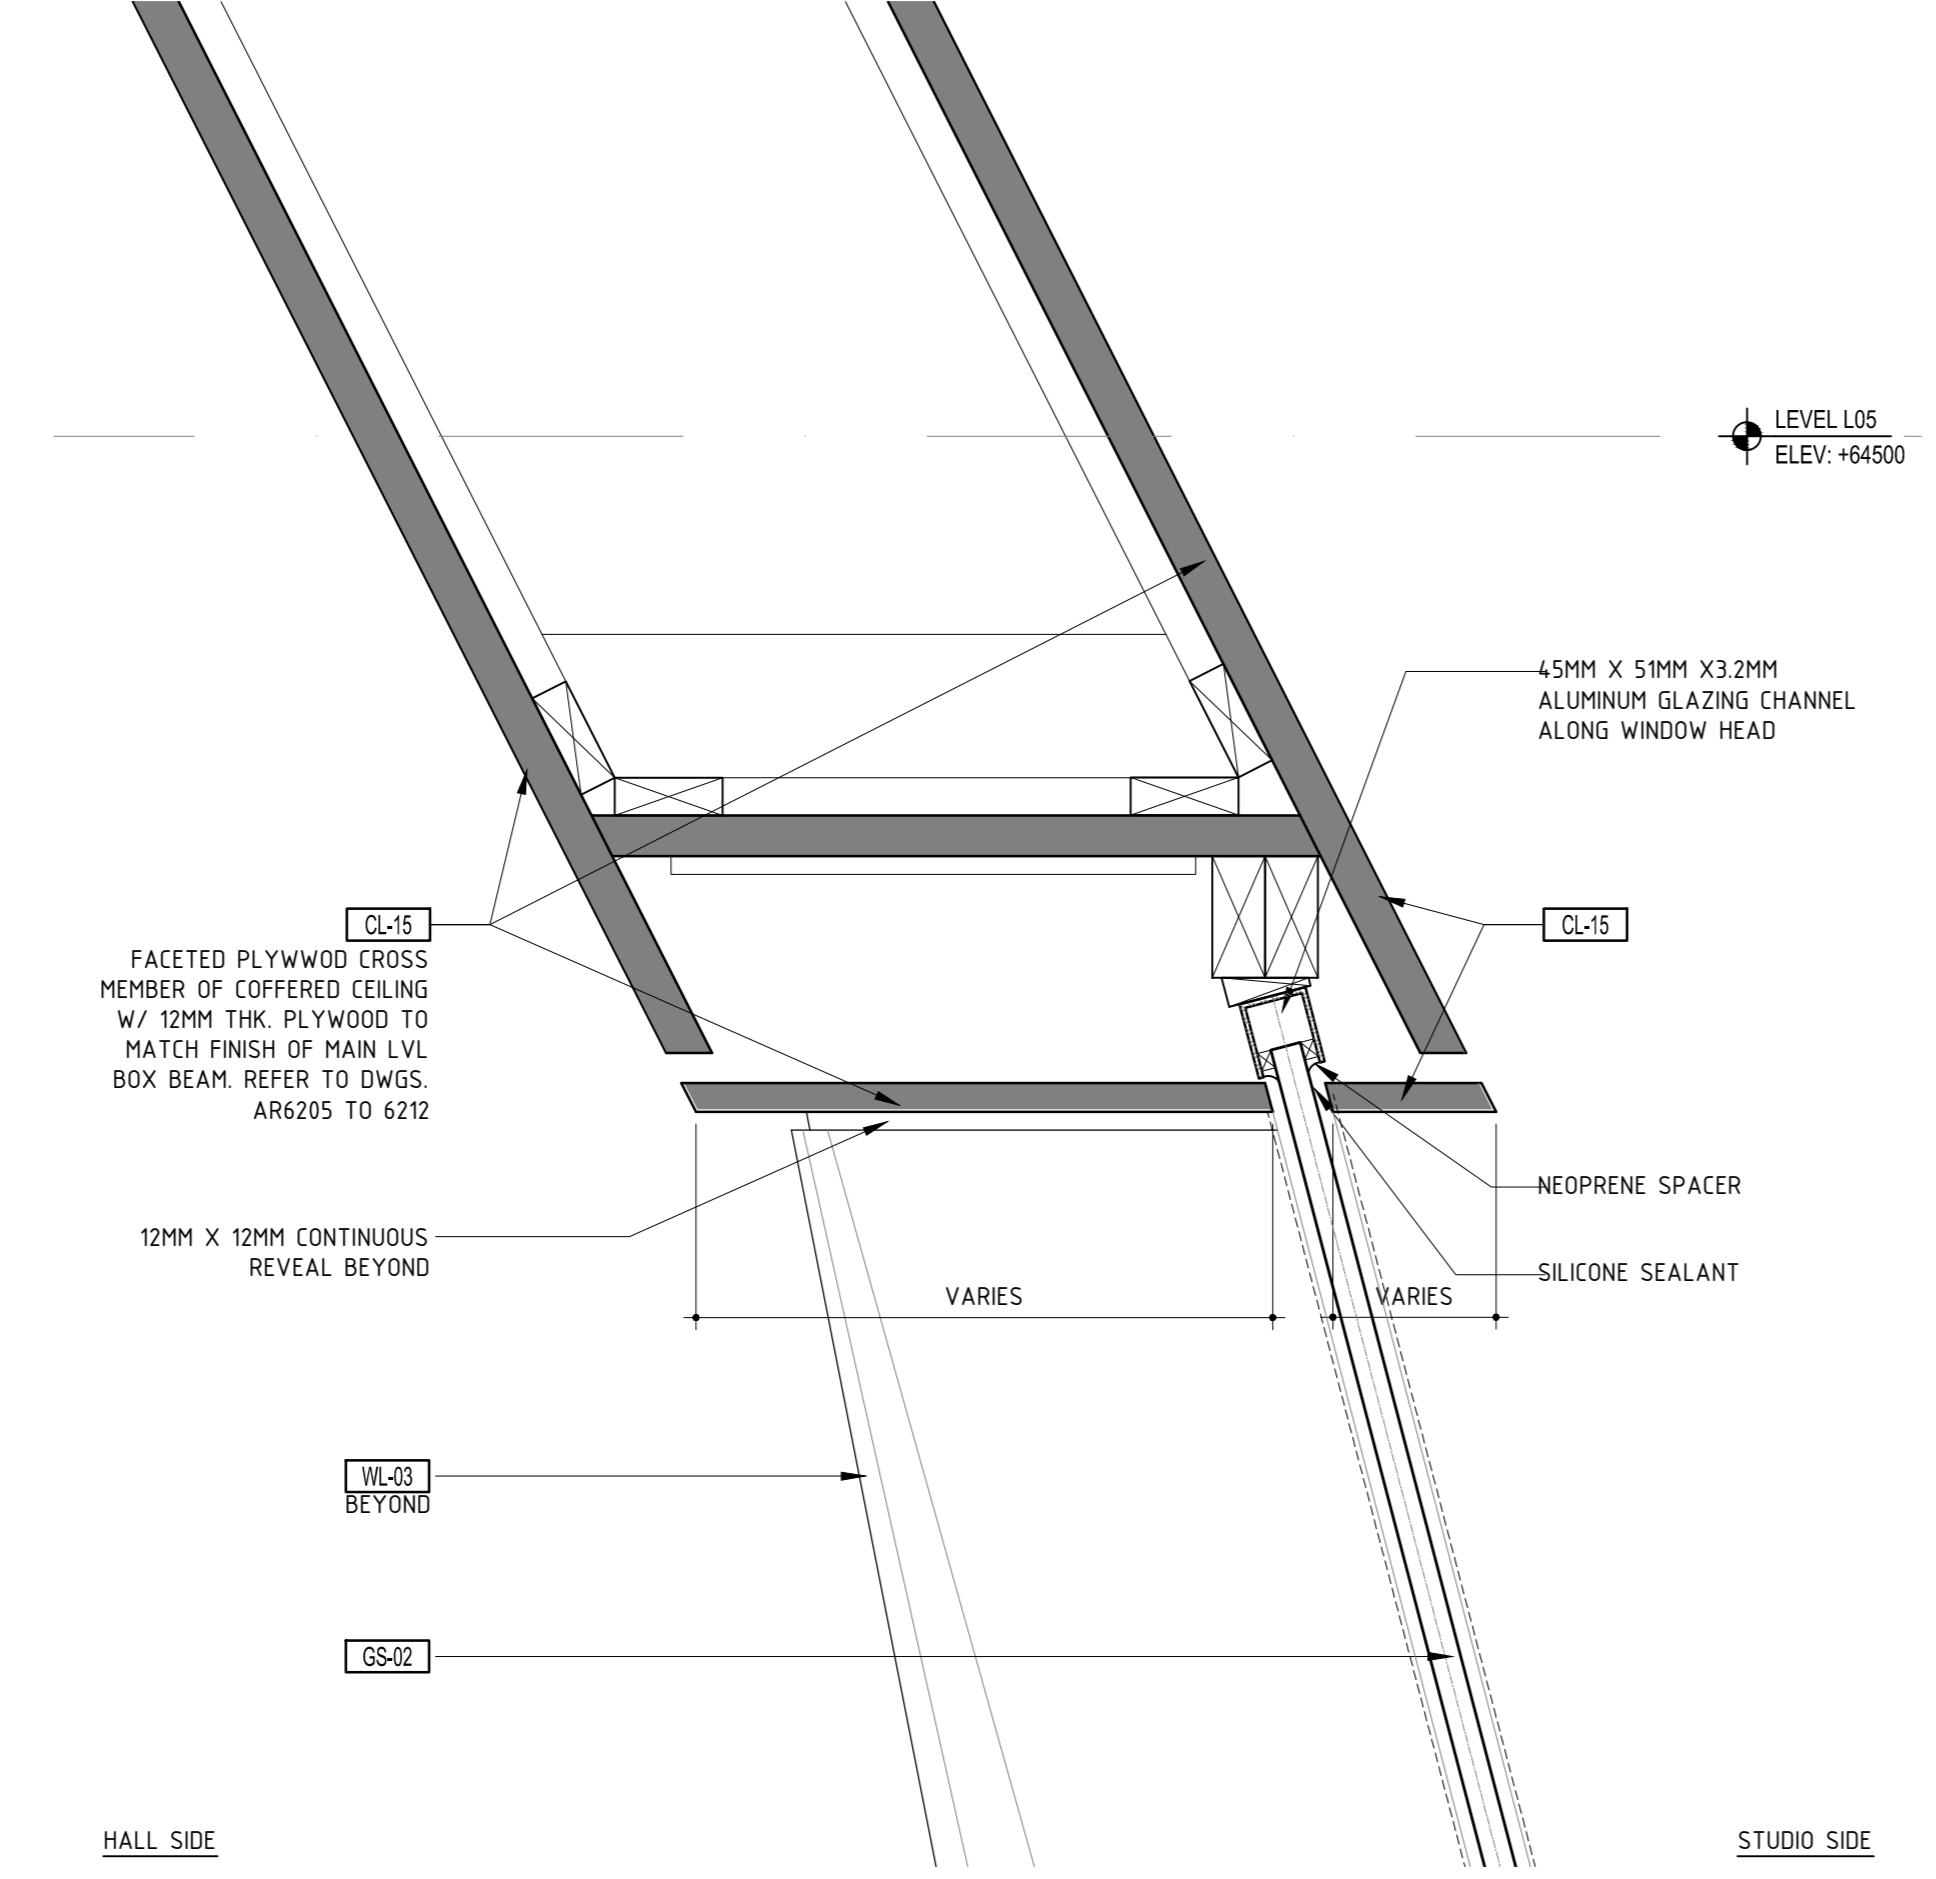


08 SECTION DETAIL - LEVEL 4 SOUTH WINDOW HEAD @ COFFERED CEILING  
SCALE: 1:5

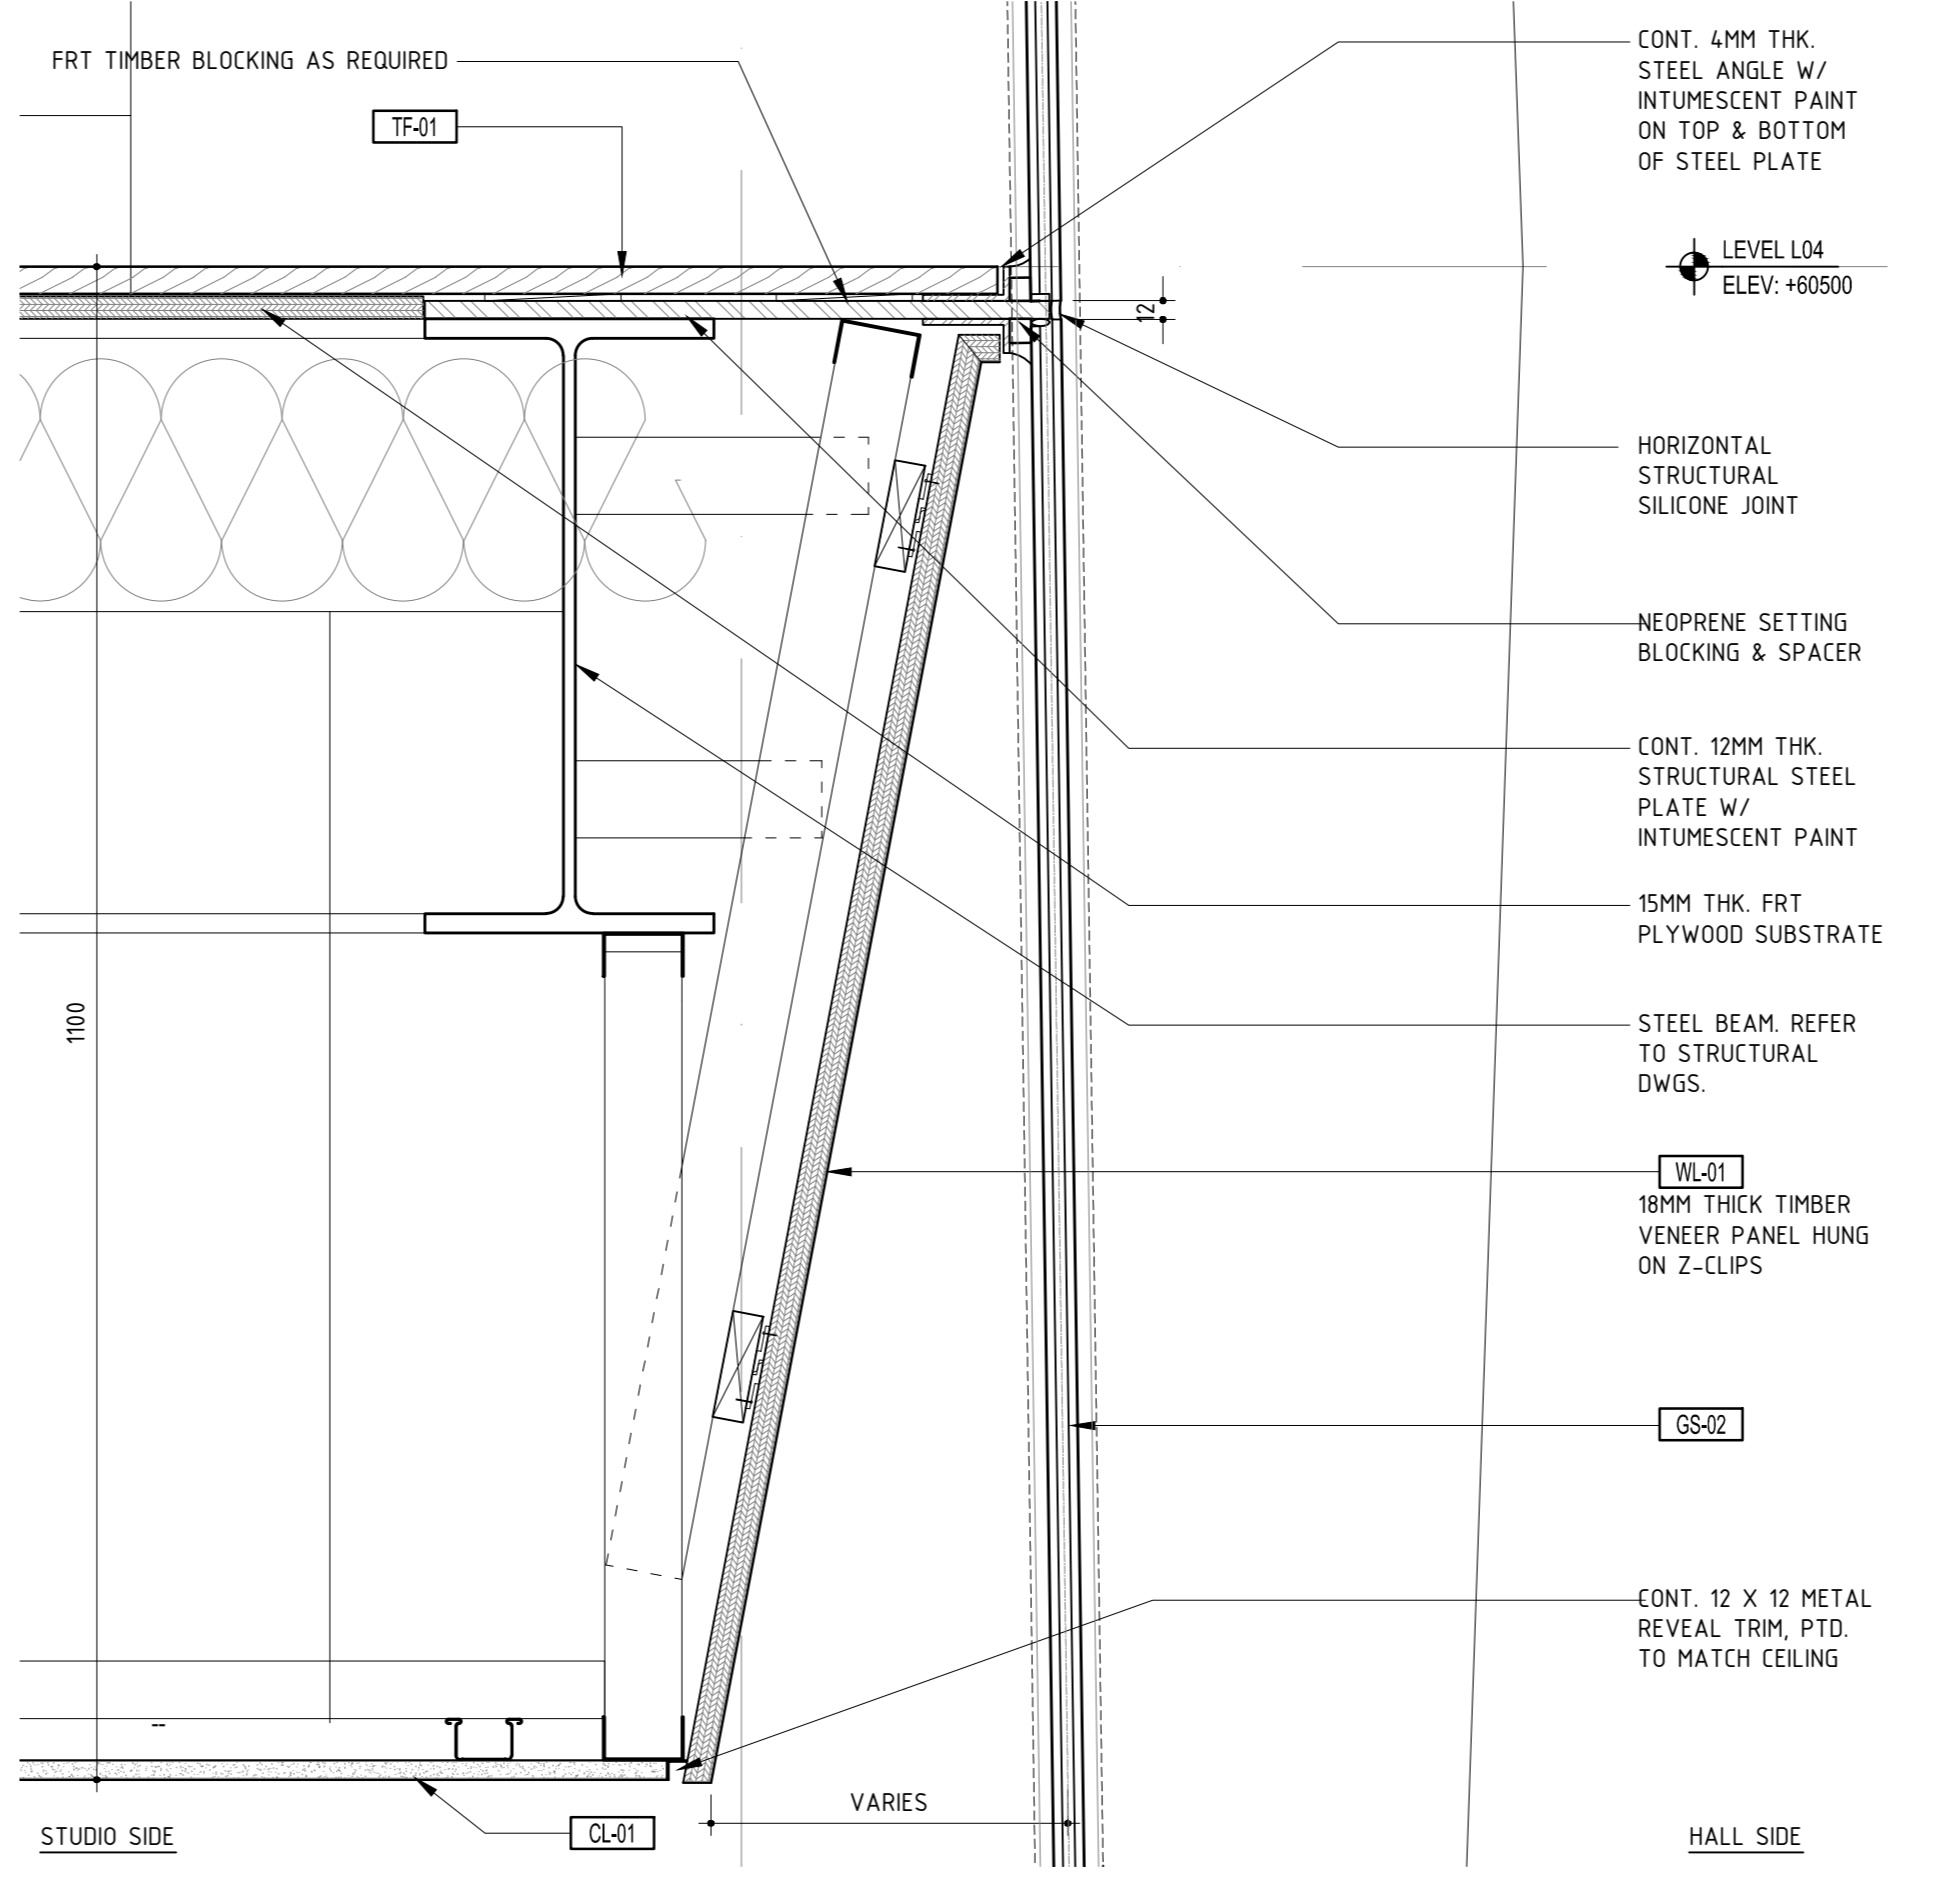


05 SECTION DETAIL - LEVEL 3 WEST WINDOW TRANSOM  
SCALE: 1:5

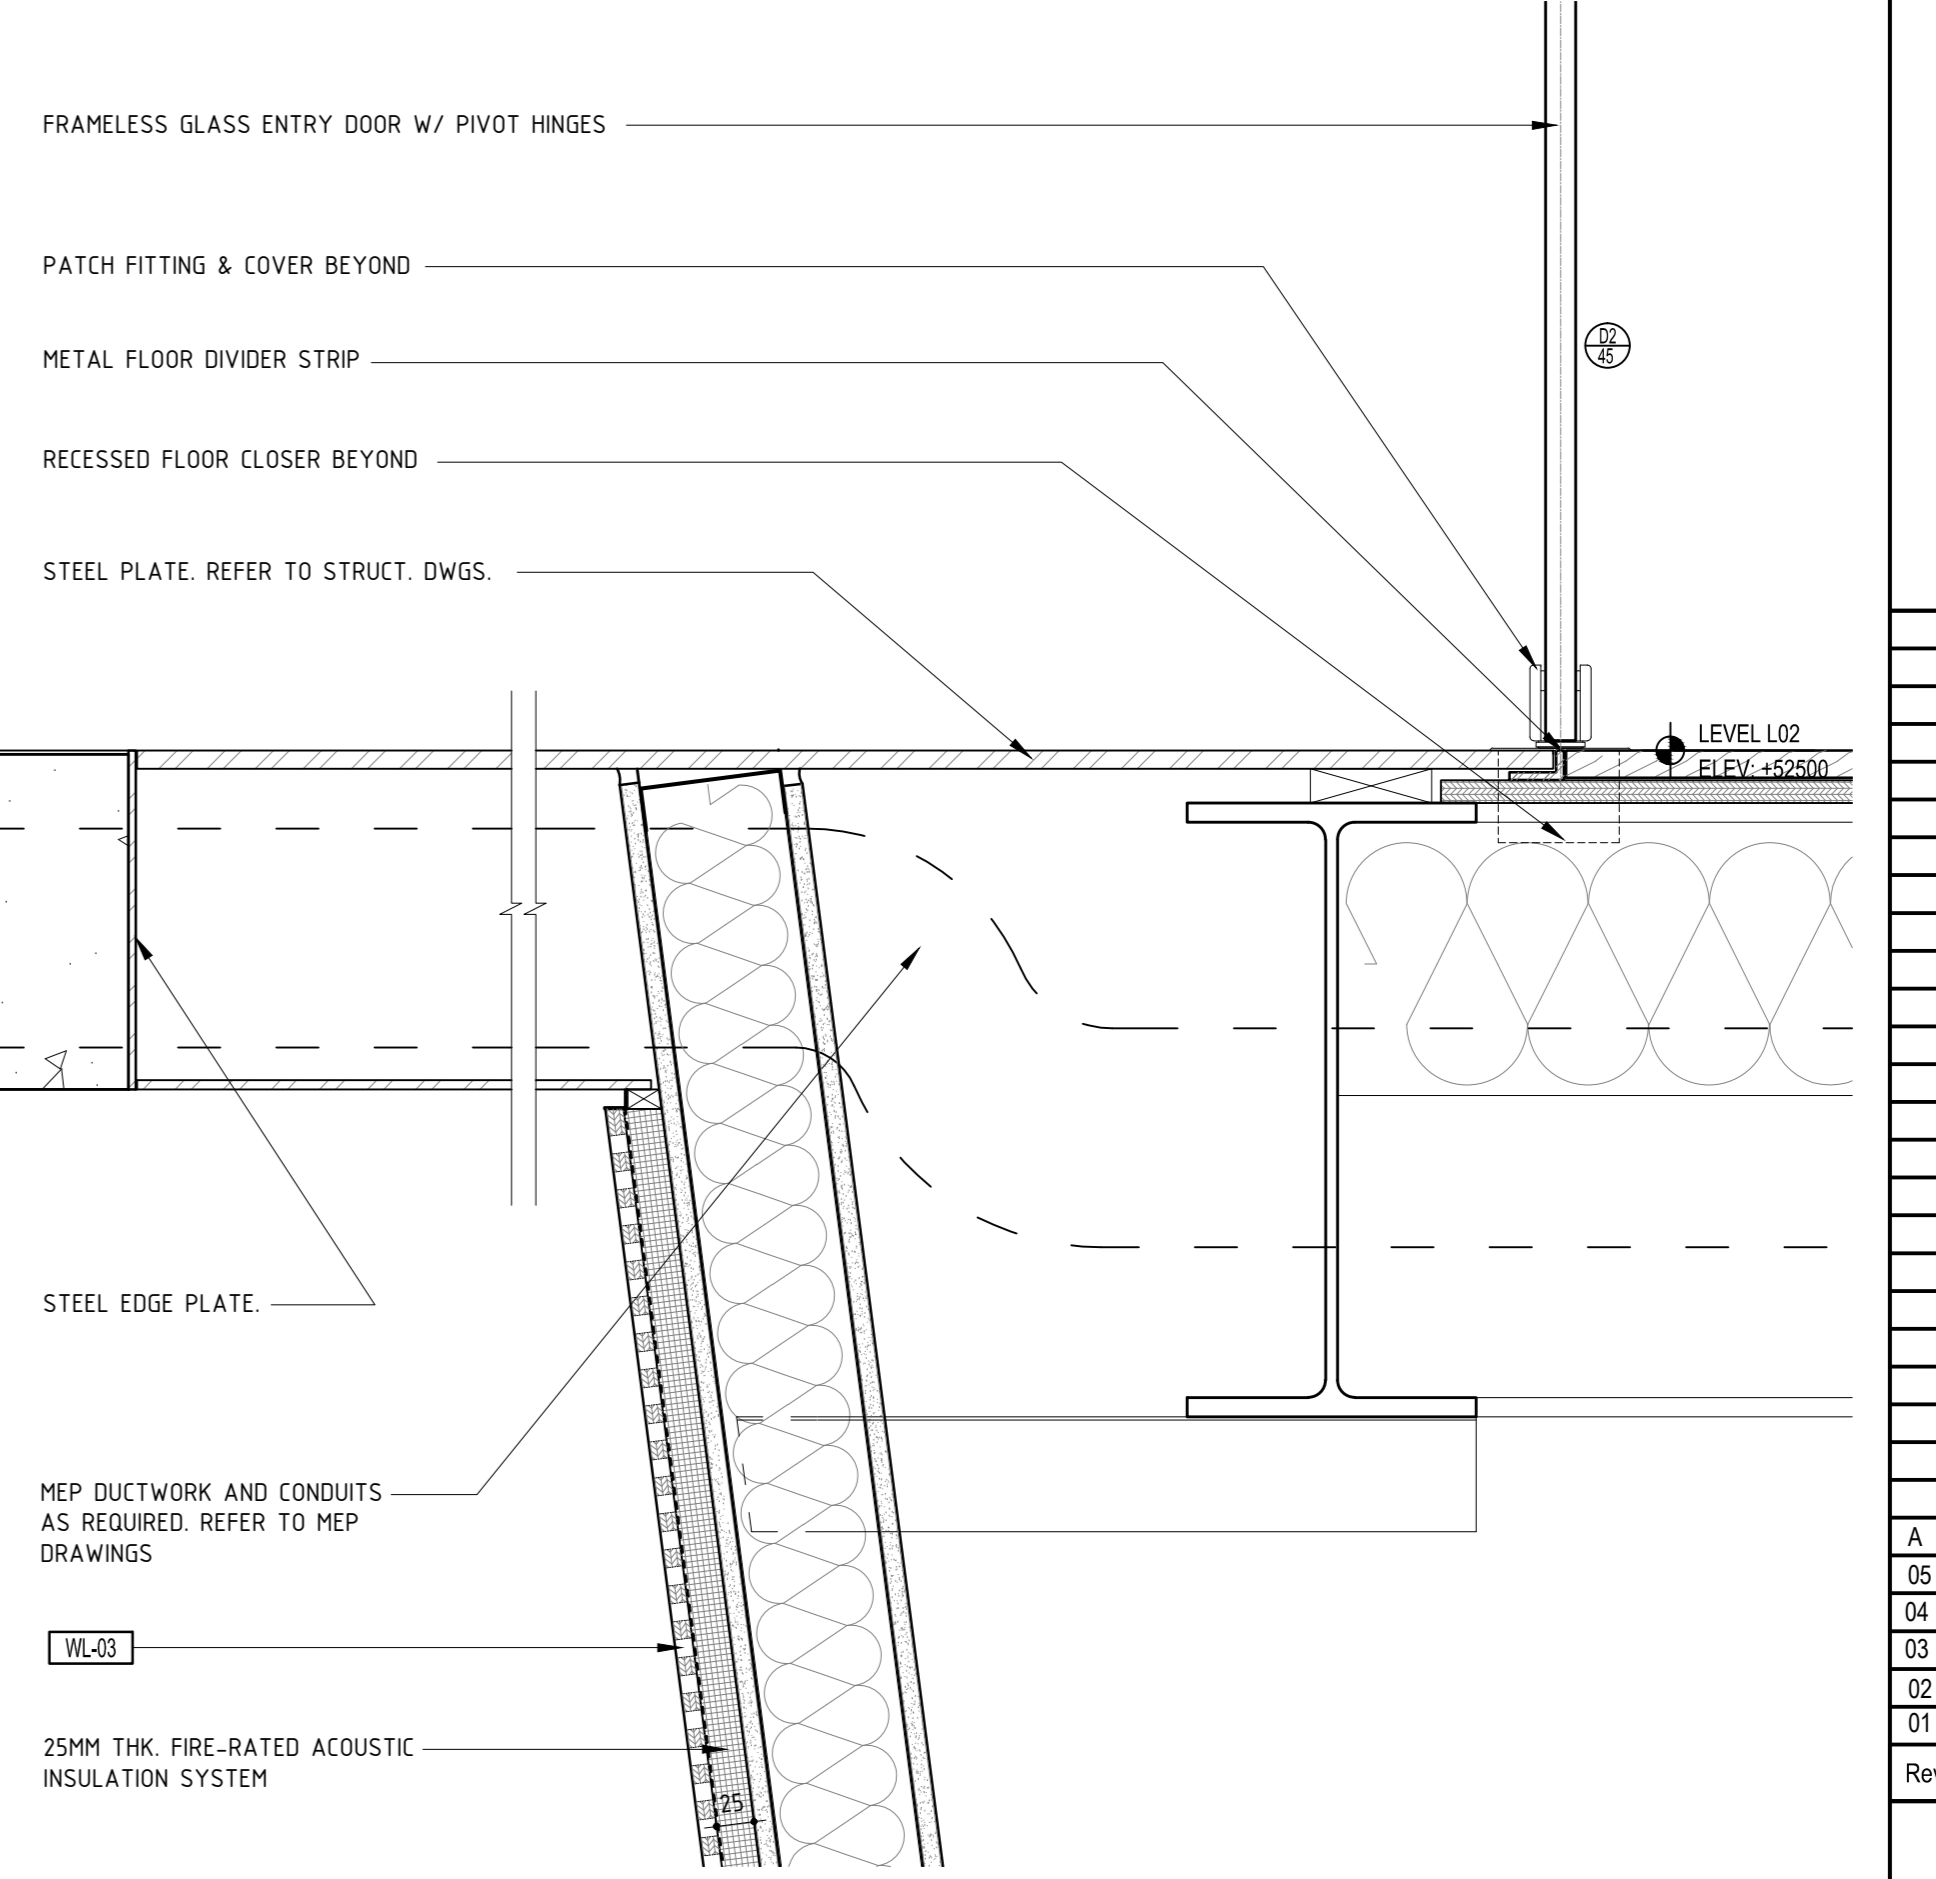


02 SECTION DETAIL - LEVEL 2 ENTRY DOOR SILL @ CONNECTOR  
SCALE: 1:5

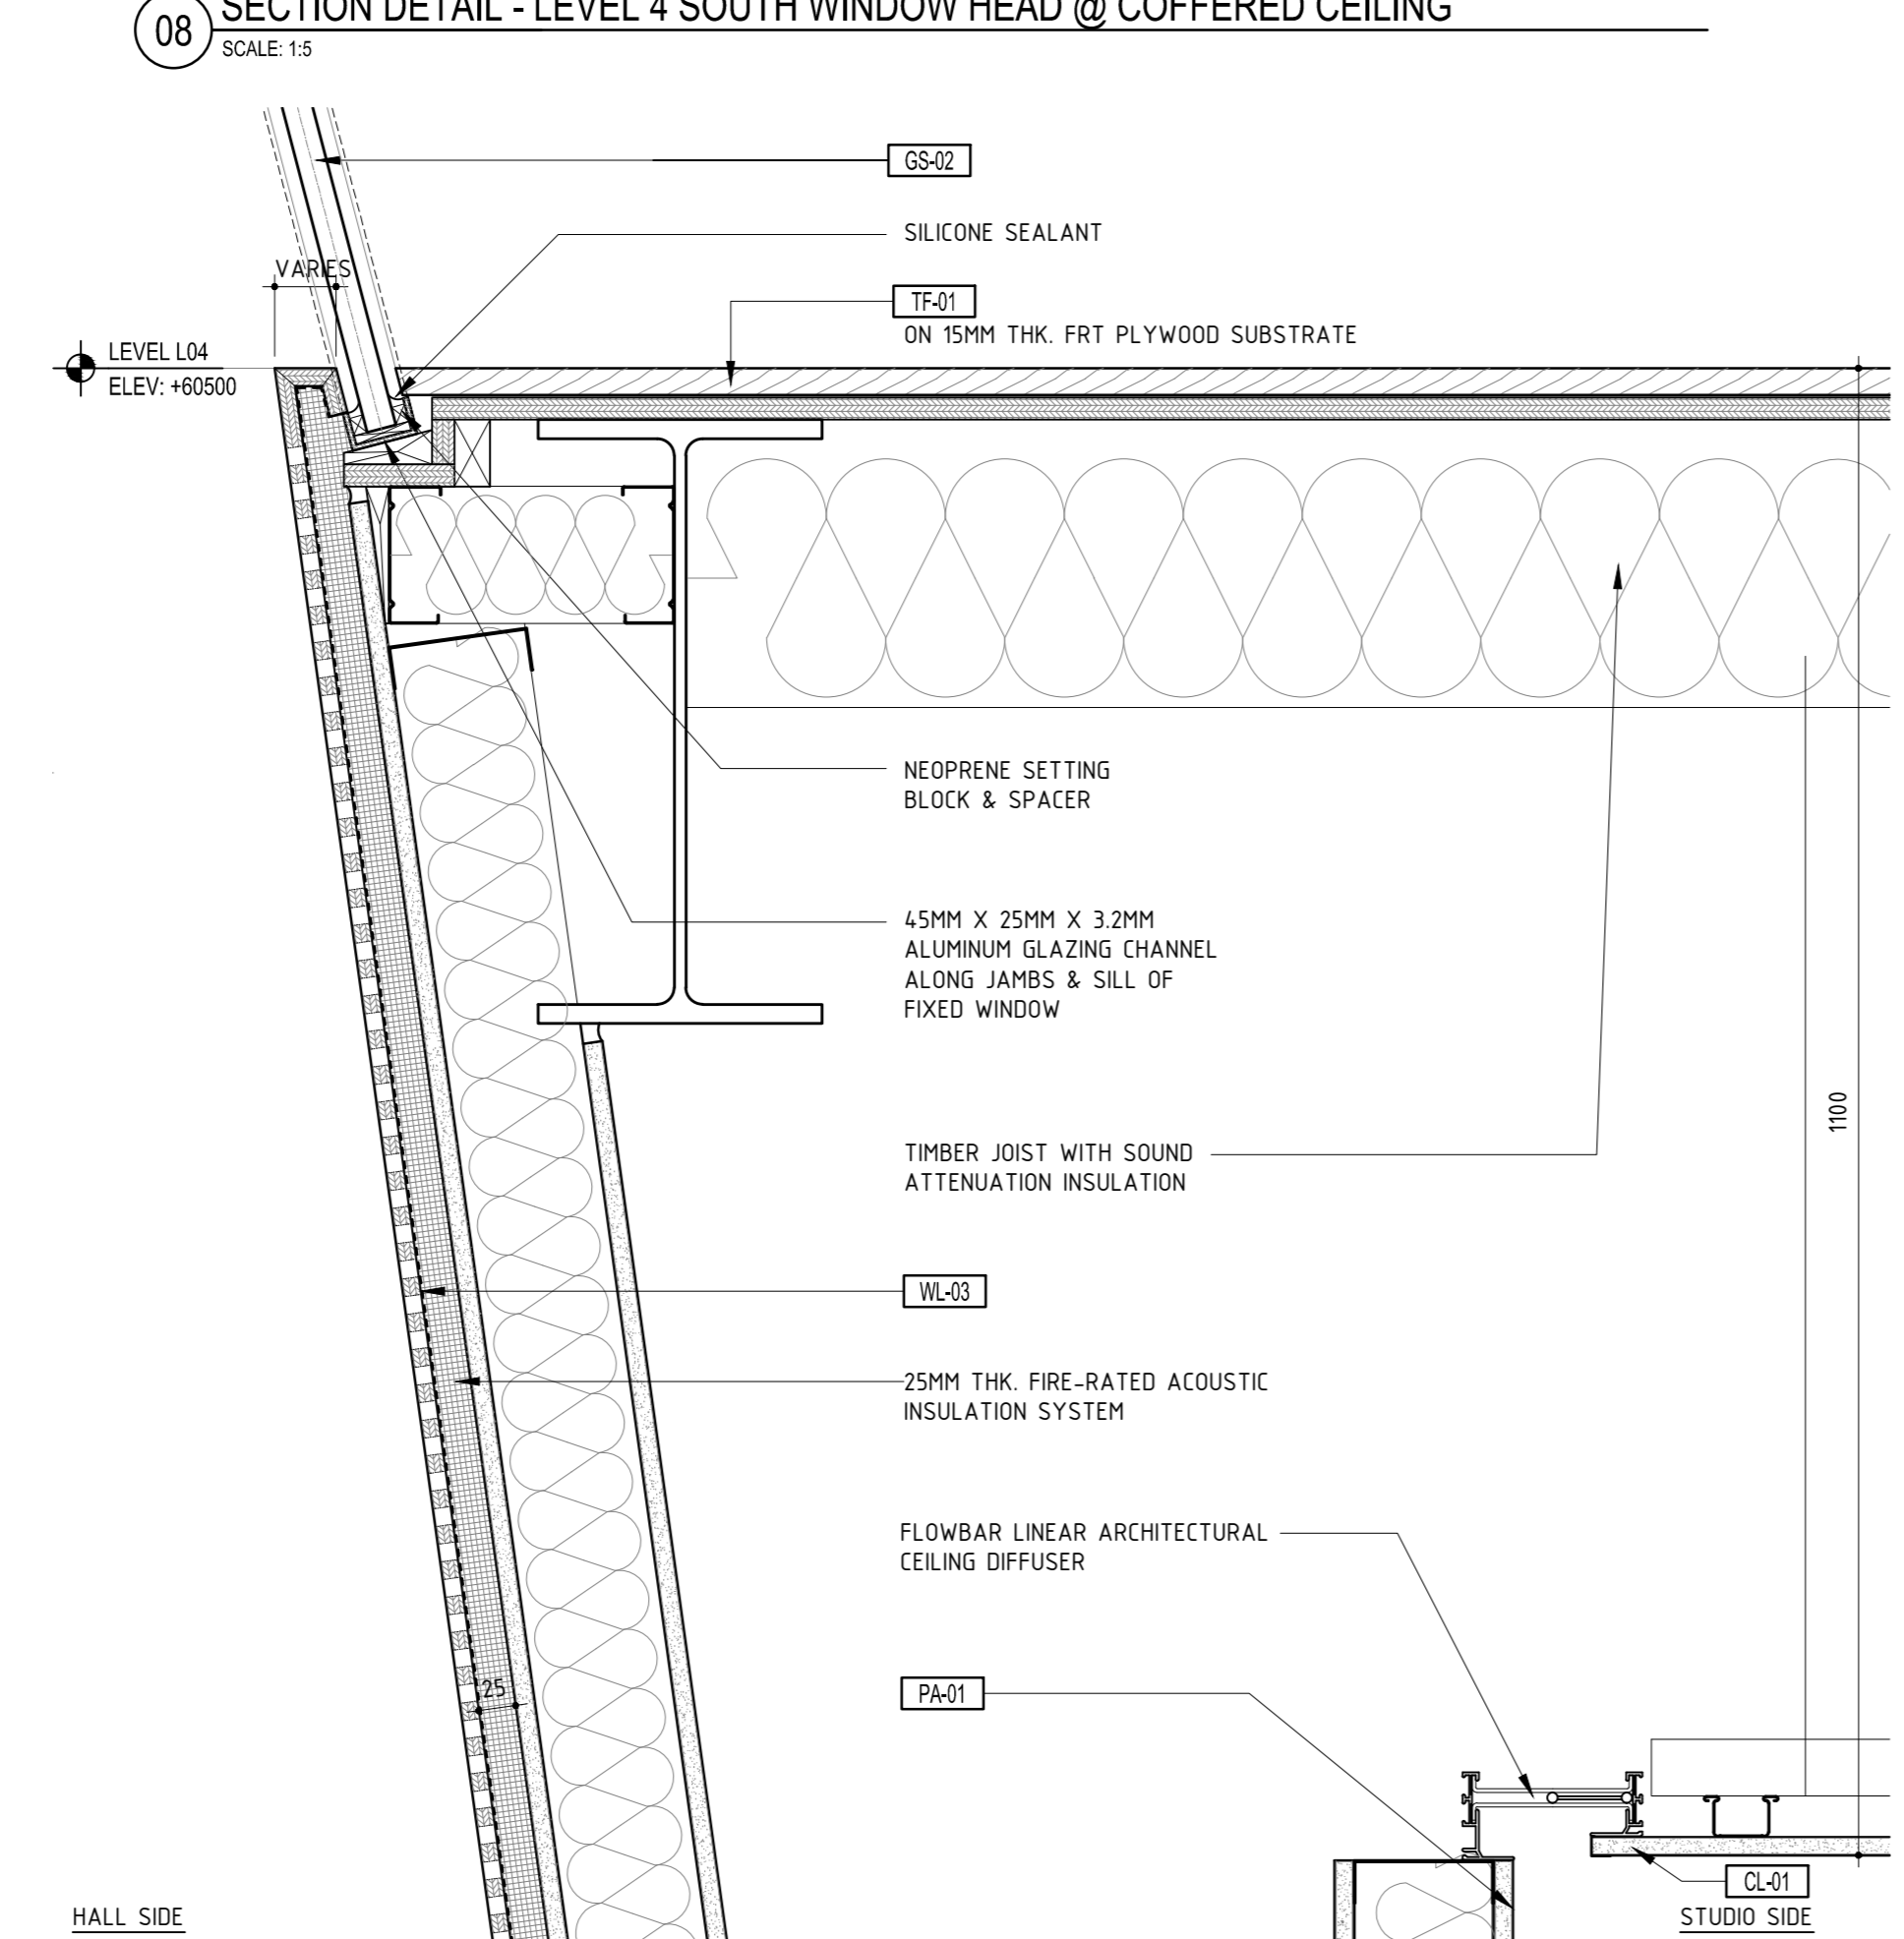

07 SECTION DETAIL - LEVEL 4 SOUTH WINDOW SILL  
SCALE: 1:5

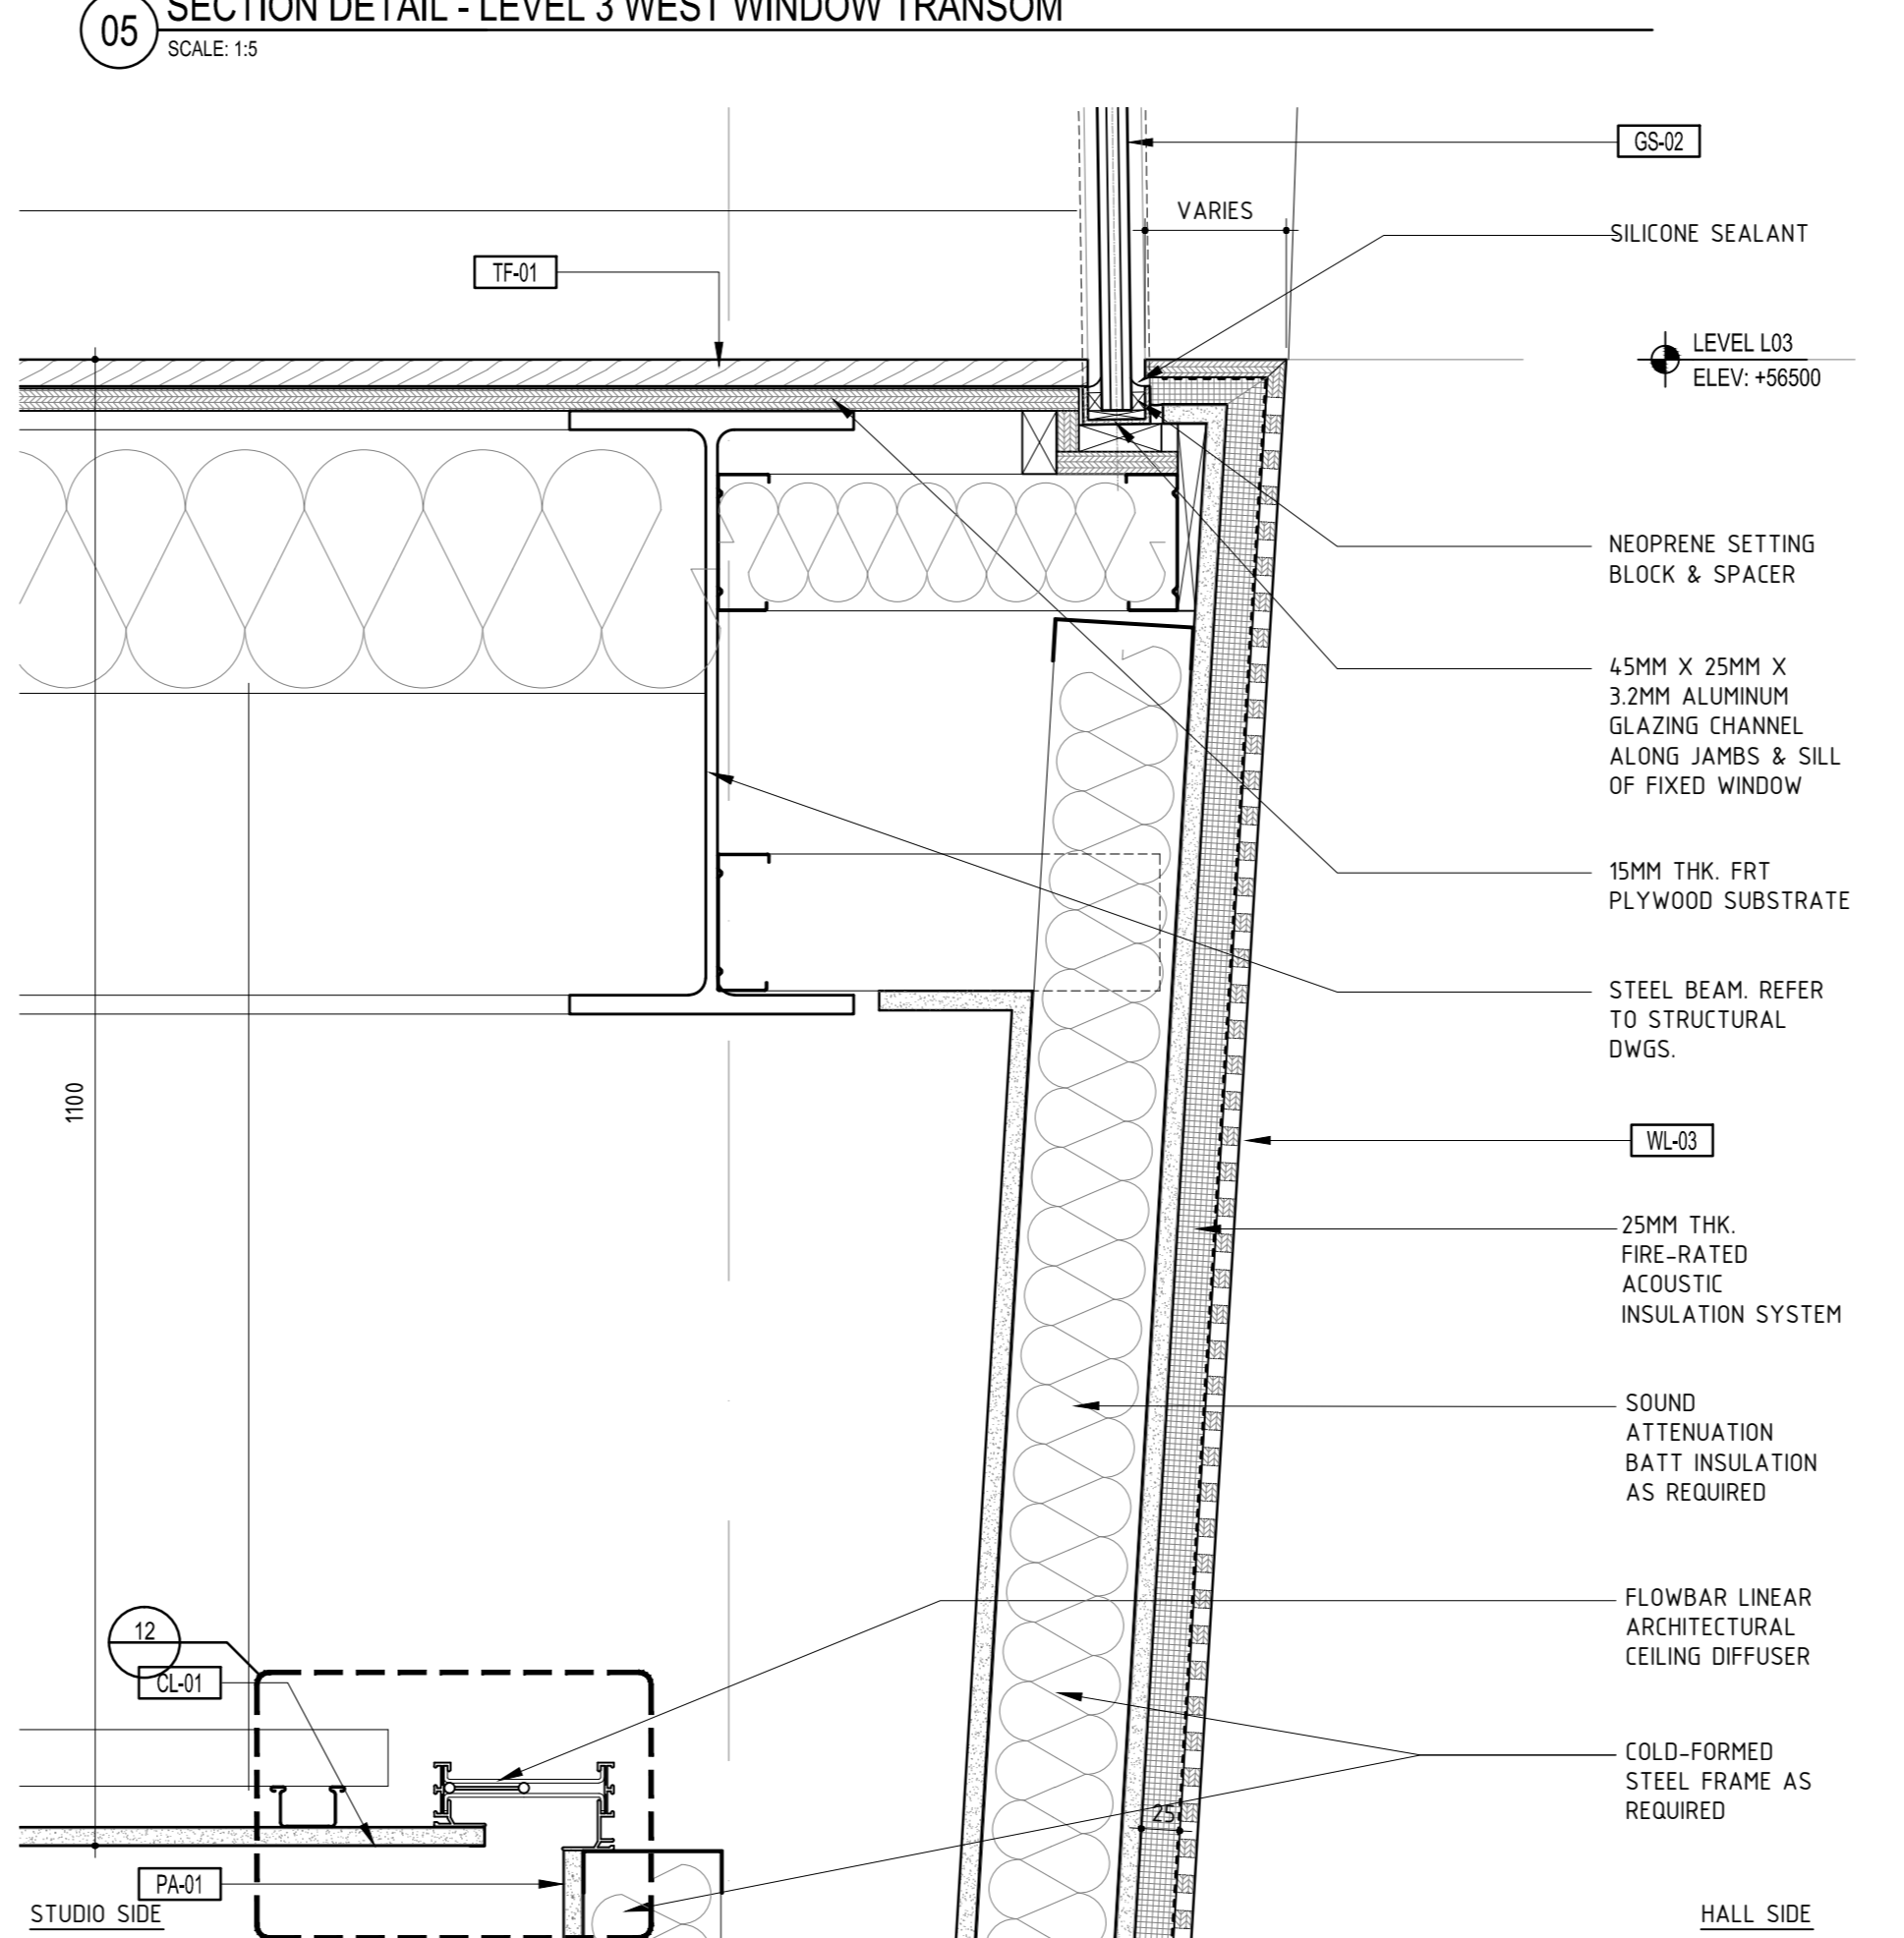


04 SECTION DETAIL - LEVEL 2 WEST WINDOW SILL  
SCALE: 1:5

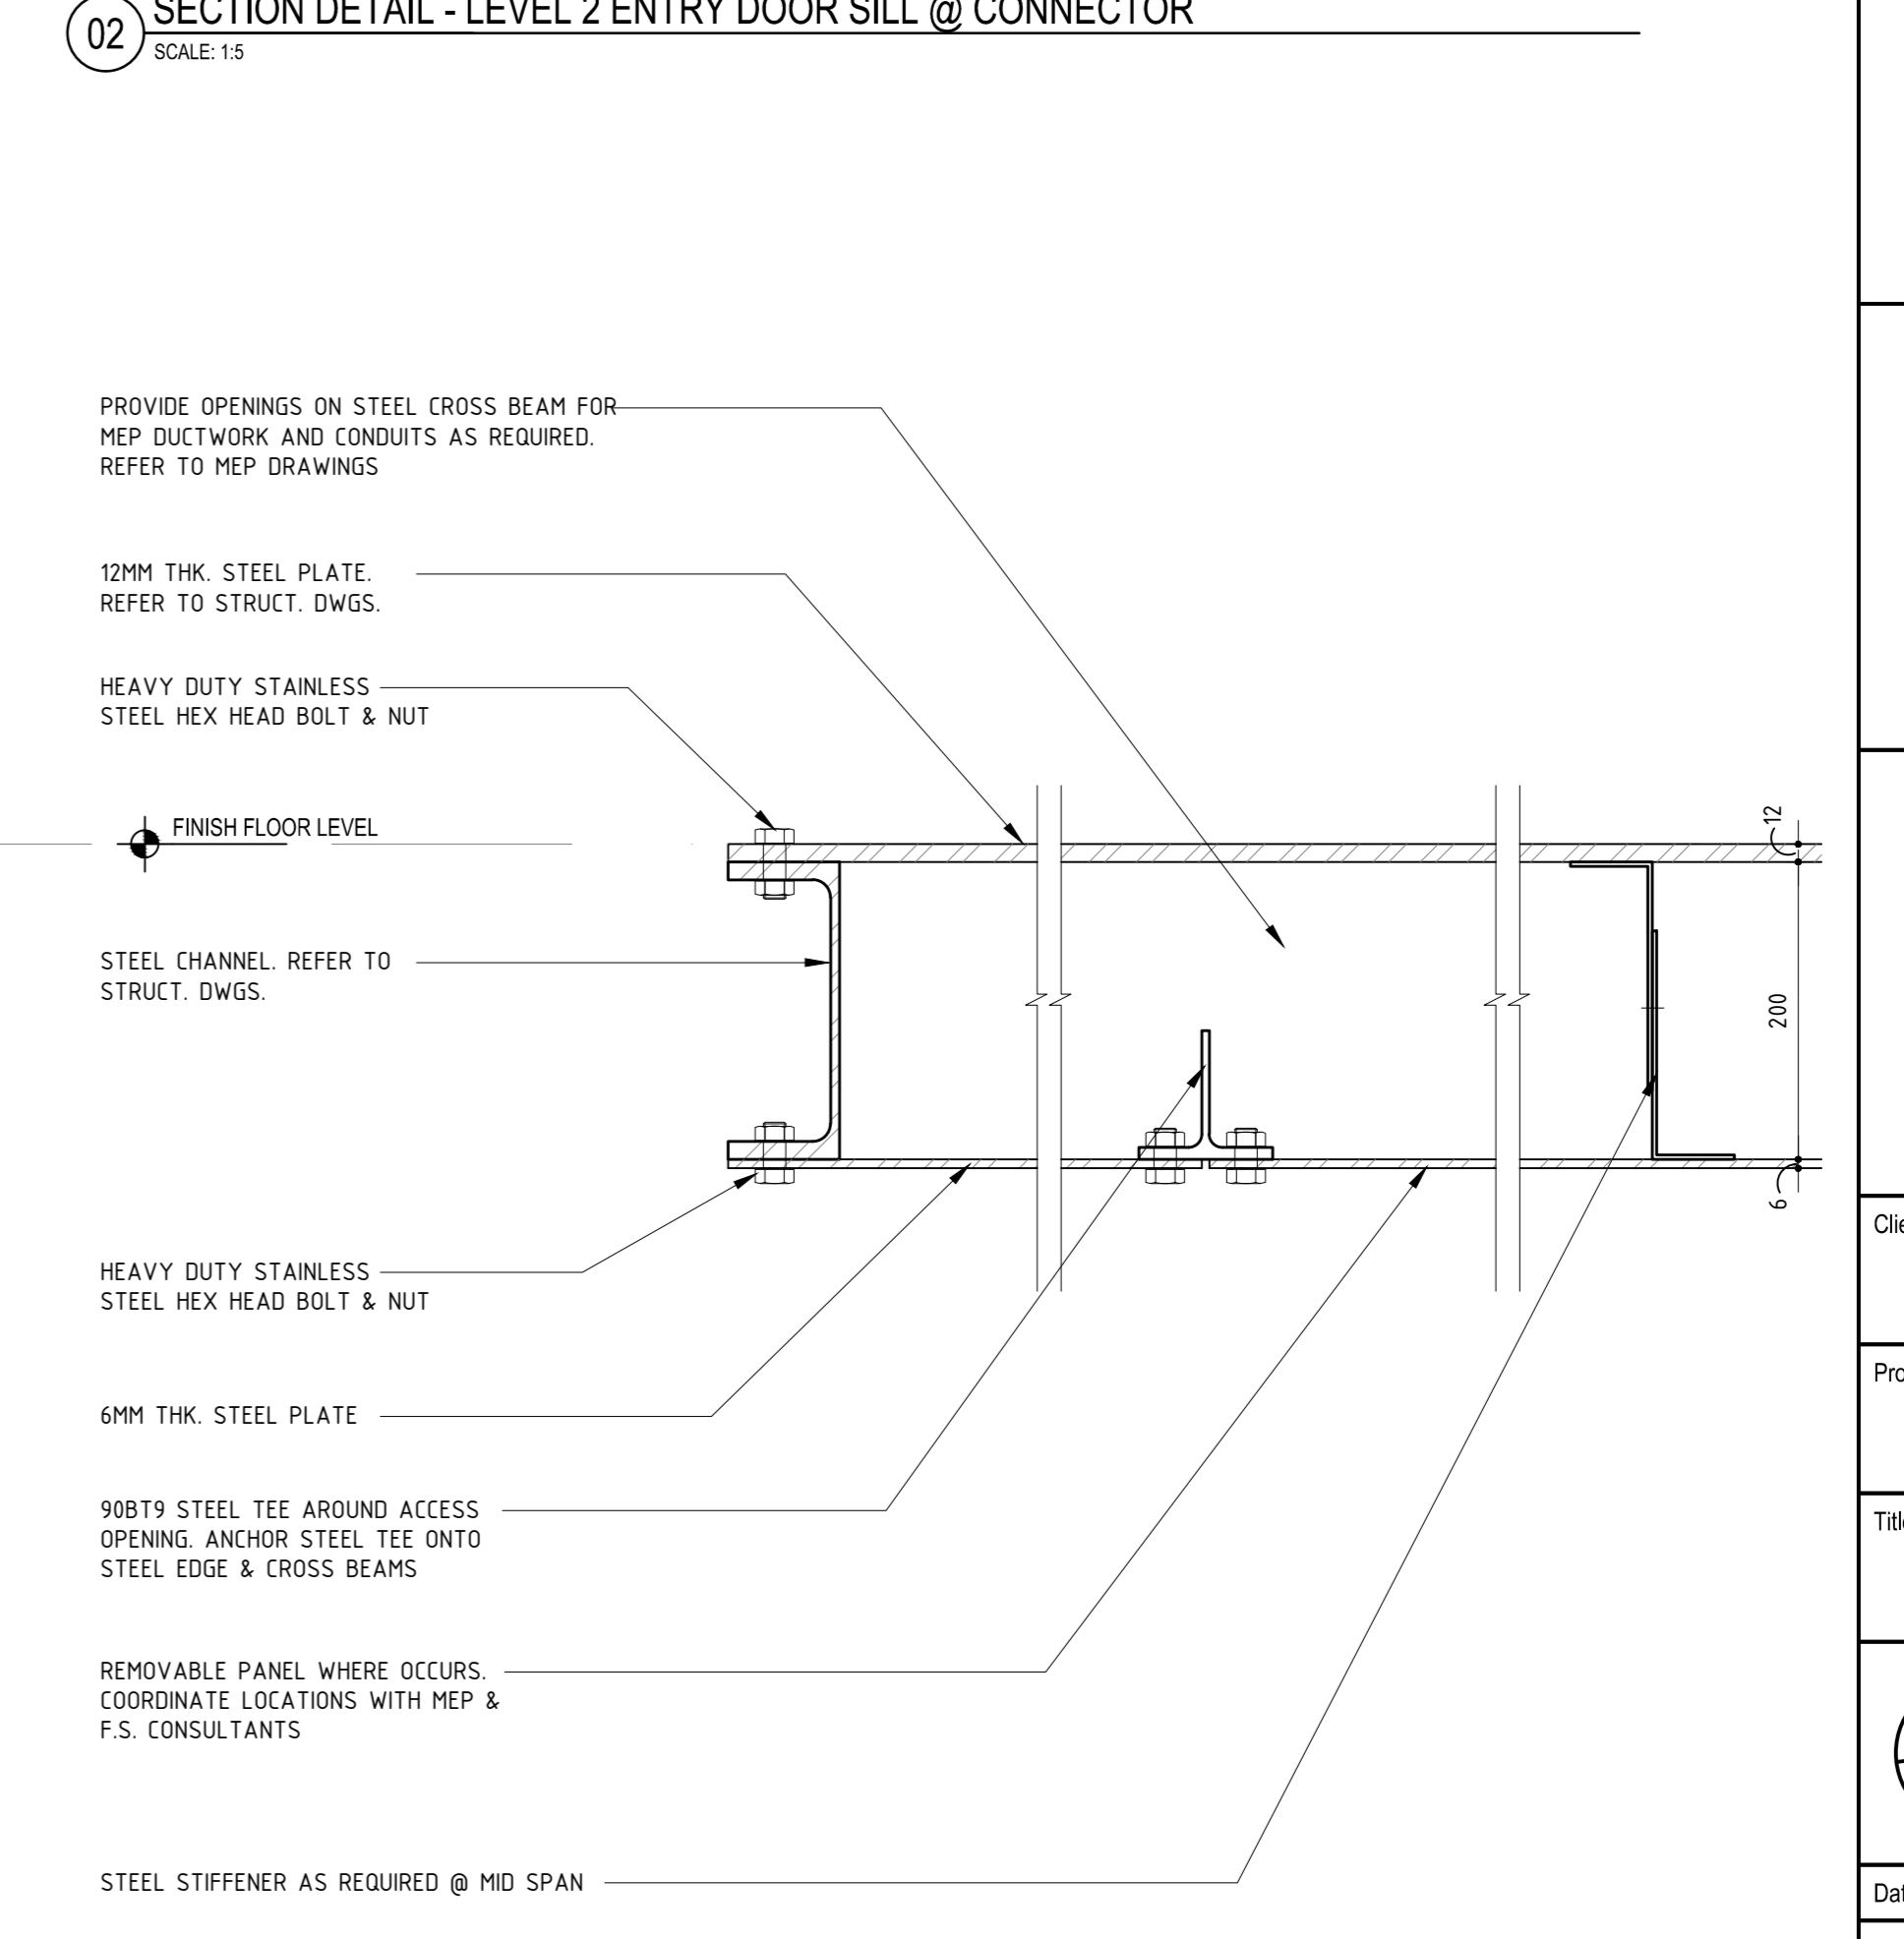

01 SECTION DETAIL - CONNECTOR EDGE  
SCALE: 1:5

Rev	Issue	Revision Description	Amtd	Date
A	SG	CONSTRUCTION ISSUE	-	06.01.14
05	SG	VALUE MANAGEMENT ISSUE	-	28.03.13
04	JC	100% CD - TENDER ISSUE	-	07.08.12
03	JC	90% CD ISSUE	-	10.08.12
02	JC	75% CD ISSUE	-	13.07.12
01	JC	50% CD ISSUE	-	01.06.12

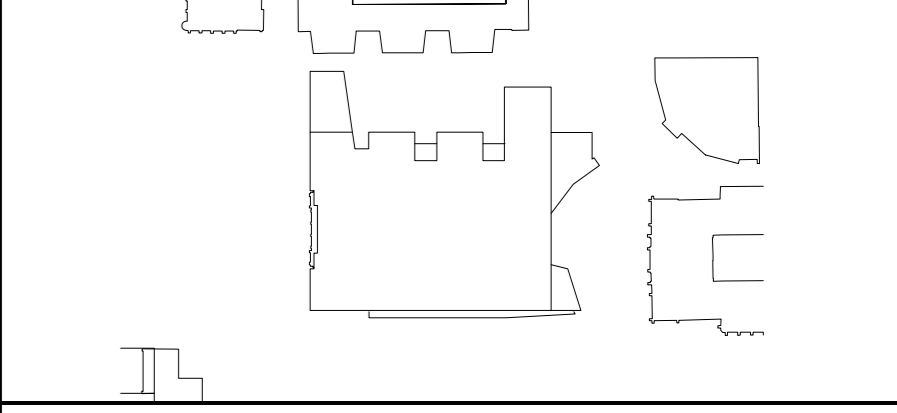

**NADAAA**  
 NADAAA  
 1920 Washington Street No. 2  
 Boston, Massachusetts 02118 USA  
 Telephone: +1 617 442 6232  
 Facsimile: +1 888 442 1417  
 Email: nadaaa@nadaaa.com

**John Wardle Architects**  
 © 2011 John Wardle Architects  
 Level 10, 180 Russell Street, Melbourne Victoria 3000 Australia  
 Tel: +613 9654 8700 www.johnwardlearchitects.com

Client	University of Melbourne Parkville Campus		
Project	Faculty of Architecture Building and Planning		
Title	HANGING STUDIO SECTION DETAILS		
Project No.	0913	Scale	as shown
Drawing No.	AR5146	Revision	A
Date	JAN 2014	Drawn	Co-Ord
Checked		Check	
FILENAME	- 0000		

FOR CONSTRUCTION