


THIS DRAWING IS AN UNCONTROLLED COPY UNLESS STAMPED OTHERWISE  
 CONTRACTOR SHALL VERIFY ALL DIMENSIONS BEFORE ANY WORK COMMENCES  
 ALL SHOP DRAWINGS SHALL BE SUBMITTED TO THE SUPERINTENDENT AND MANUFACTURE  
 SHALL NOT COMMENCE PRIOR TO THE RETURN OF DIMENSIONED SHOP DRAWINGS SIGNED  
 BY THE CONSULTANT. REVISIONS SHALL TAKE PRECEDENCE OVER SCALES. THIS  
 DRAWING SHOULD BE READ IN CONJUNCTION WITH ALL RELEVANT CONTRACT SPECIFICATIONS  
 AND DRAWINGS COPYRIGHT OF THIS DRAWING IS VESTED IN WARDLE


General Notes

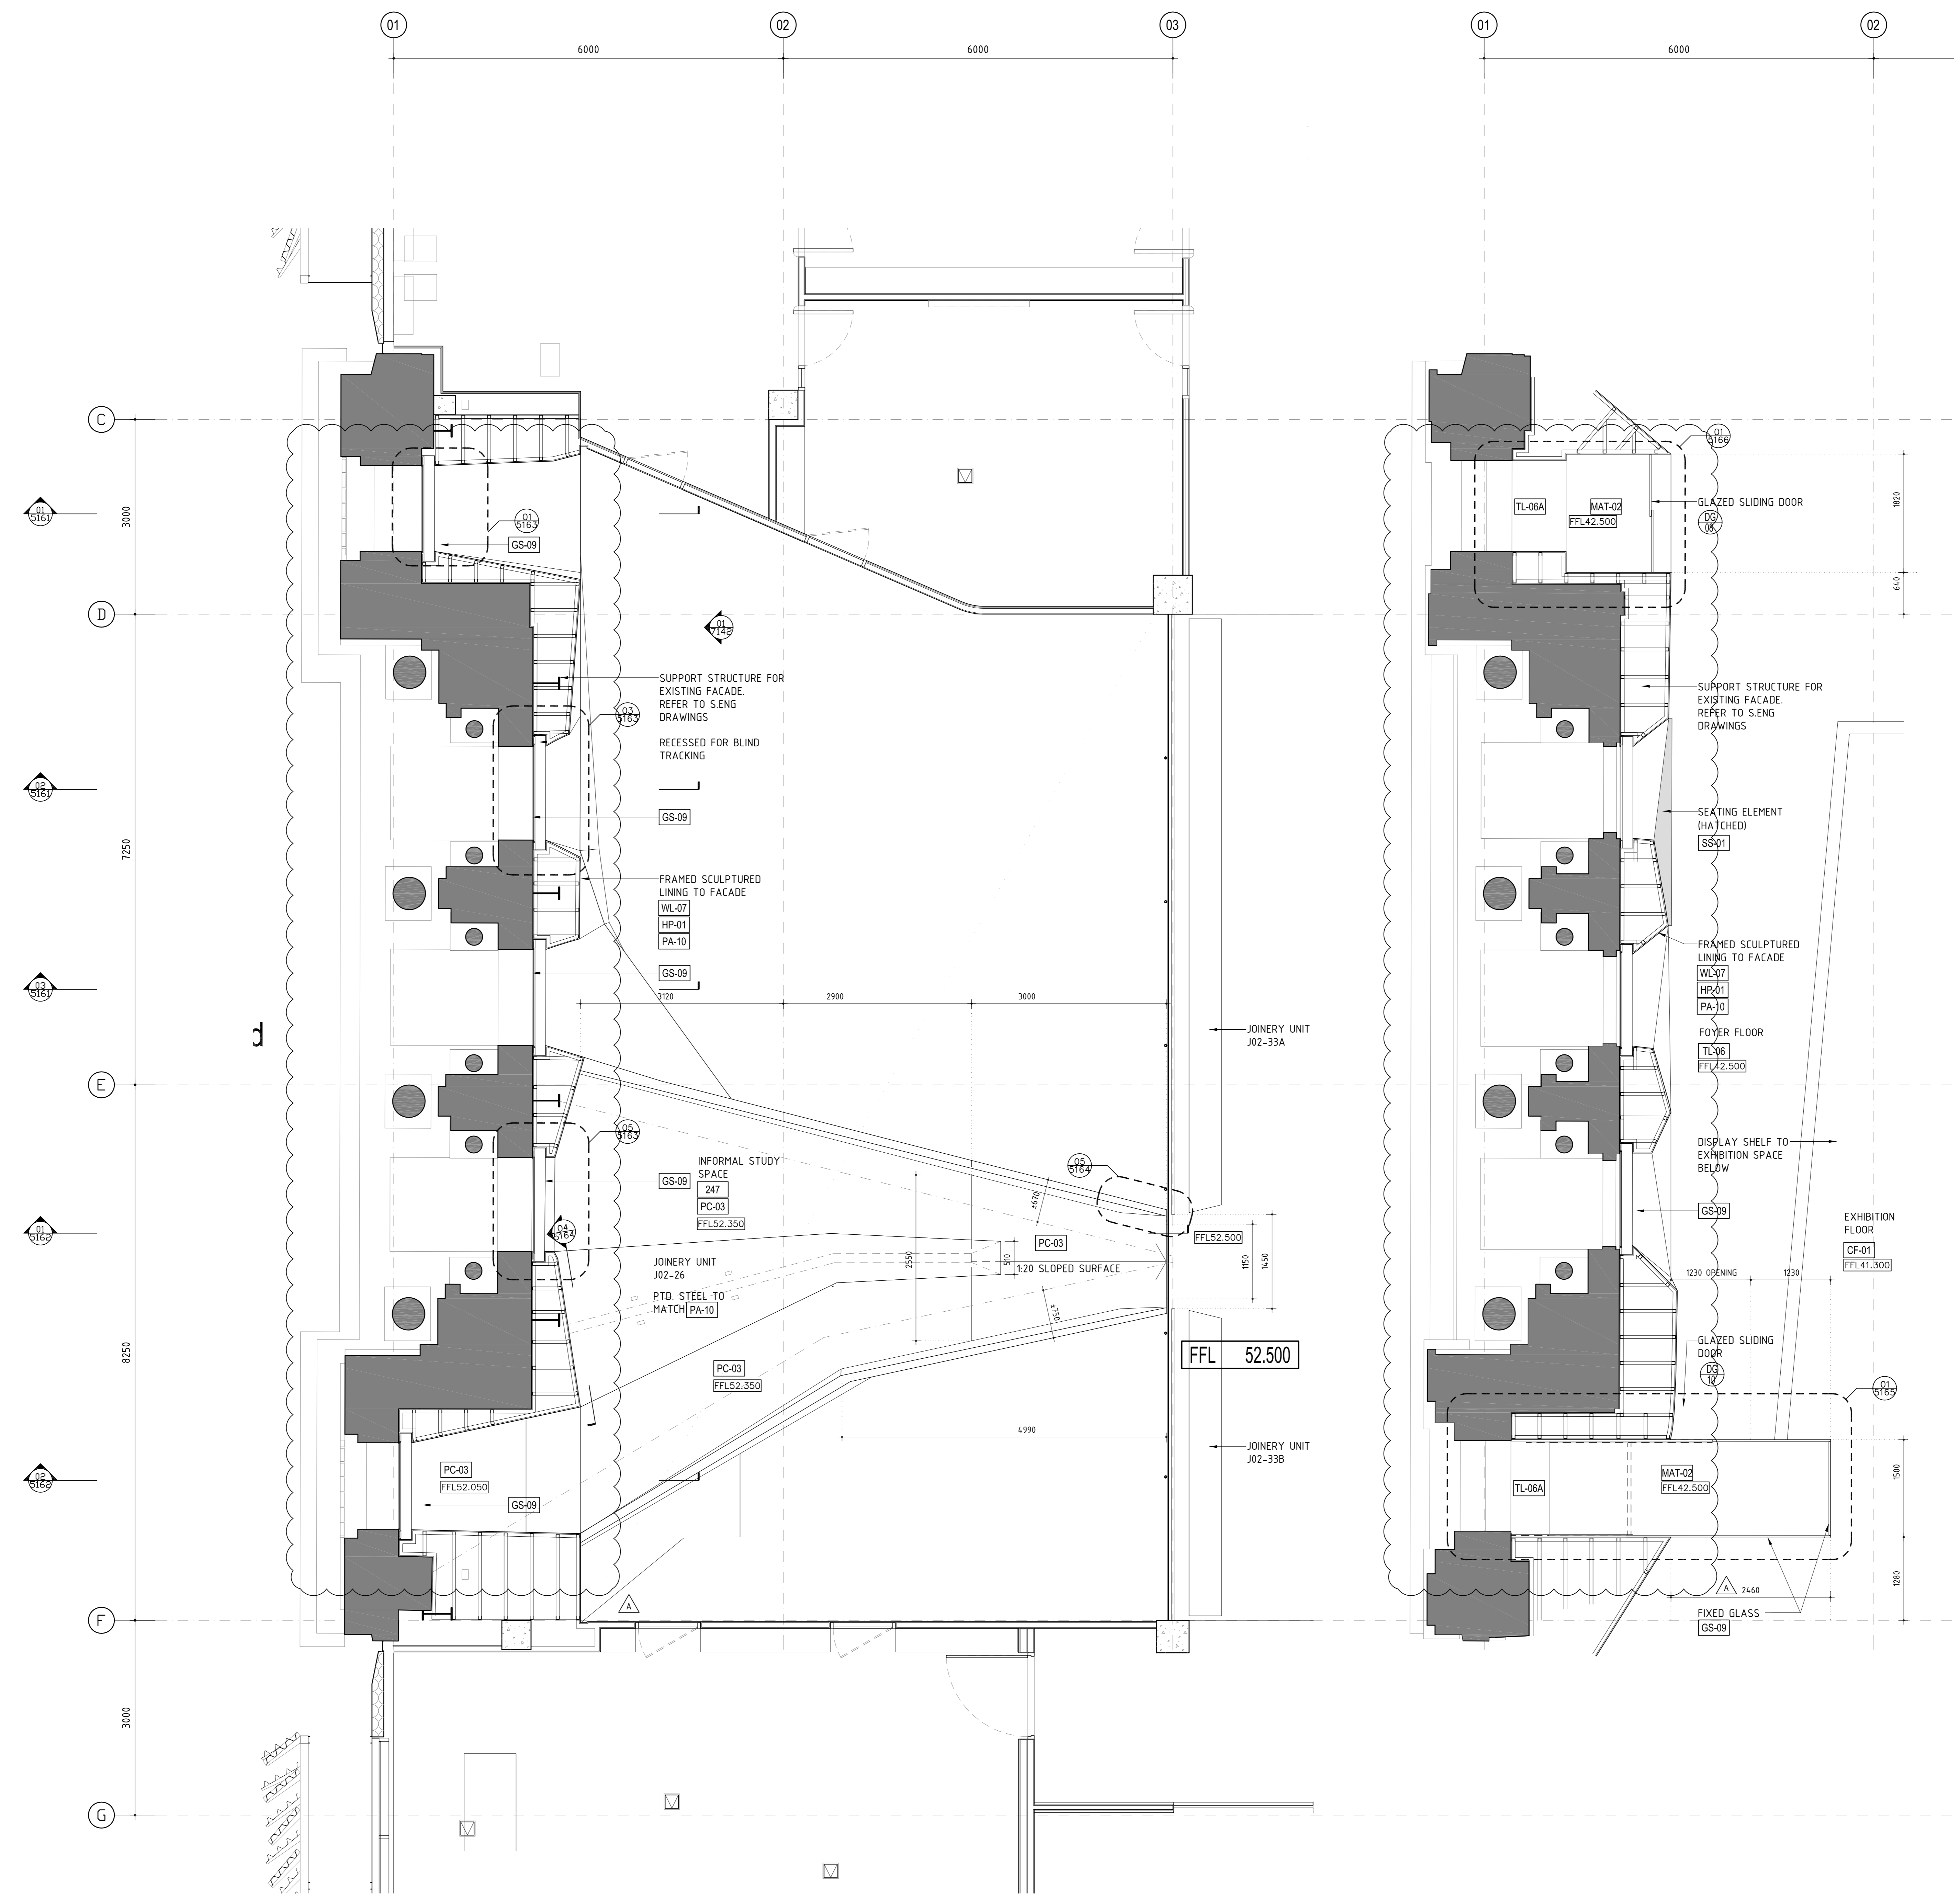

02 JR FACADE - L02 FLOOR PLAN  
SCALE 1:40

01 JR FACADE - G01 FLOOR PLAN  
SCALE 1:40

Rev	Issue	Revision Description	Amtd	Date
A	SO	FOR CONSTRUCTION		08.13.13
05	JC	TENDER ADDENDUM NO.4		08.10.12
04	JC	100% CD - TENDER ISSUE		07.08.12
03	JC	90% CD ISSUE		10.08.12
02	JC	75% CD ISSUE		13.07.12
01	JC	50% CD ISSUE		01.08.12

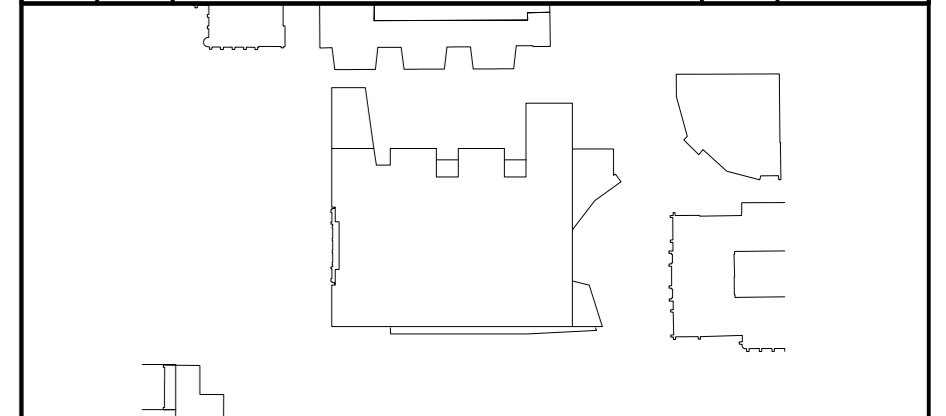

**NADAAA**  
 NADAAA  
 1520 Washington Street No.2  
 Boston Massachusetts 02118 USA  
 Telephone +1 617 442 8232  
 Facsimile +1 608 442 1417  
 Email nada@nadaaa.com

**John Wardle Architects**  
 © 2011 John Wardle Architects  
 Level 10, 180 Russell Street, Melbourne Victoria 3000 Australia  
 Tel : +613 9654 8700 www.johnwardlearchitects.com

Client **University of Melbourne Parkville Campus**  
 Project **Faculty of Architecture Building and Planning**  
 Title **JOSEPH REED FACADE PLANS**

Project No.	<b>0913</b>	Scale	1:40 @ A0
Drawing No.	<b>AR5160</b>	Revision	<b>A</b>

Dwg: DEC 2013 Dwn: - Co-Ord: - Chk: -

FILENAME: #####

**FOR CONSTRUCTION**