


CONTRACTORS SHALL VERIFY JOB DIMENSIONS BEFORE ANY JOB COMMENCES. ALL SHOP DRAWINGS SHALL BE SUBMITTED TO THE SUPERINTENDENT AND MANUFACTURE SHALL NOT COMMENCE PRIOR TO THE RETURN OF DIMENSIONED SHOP DRAWINGS SIGNED BY THE CONSULTANT. FURTHER DIMENSIONS SHALL TAKE PRECEDENCE OVER SCALES. THIS DRAWING SHOULD BE READ IN CONJUNCTION WITH ALL RELEVANT CONTRACT SPECIFICATIONS AND DRAWINGS COPYRIGHT OF THIS DRAWING IS VESTED IN WARDLE.

General Notes

Rev	Issue	Revision Description	Amtd	Date
A	SO	FOR CONSTRUCTION	-	08.12.13
04	JC	100% CD - TENDER ISSUE	-	07.09.12
03	JC	90% CD ISSUE	-	10.08.12
02	JC	75% CD ISSUE	-	13.07.12
01	JC	DRAWINGS MOVED FROM OTHER SHEETS	-	01.06.12
01	JC	50% CD ISSUE	-	01.06.12

Rev	Issue	Revision Description	Amtd	Date
01	JC	50% CD ISSUE	-	01.06.12

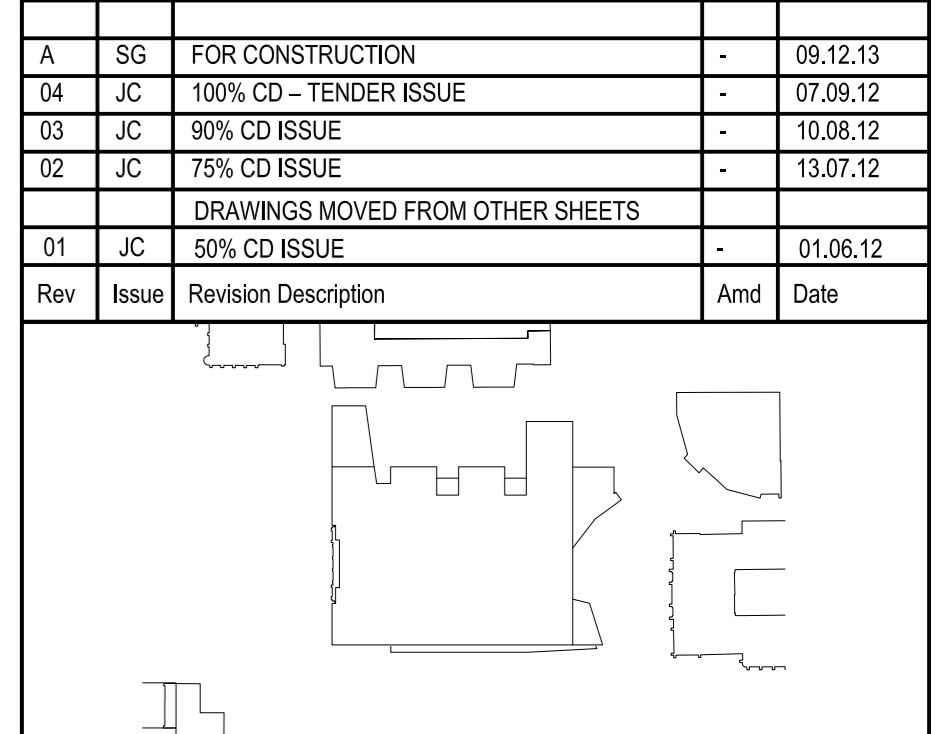

NADAAA
 NADAAA
 1520 Washington Street No.2
 Boston Massachusetts 02118 USA
 Telephone +1 617 442 8232
 Facsimile +1 604 442 1417
 Email nadaaa@nadaaa.com

John Wardle Architects
 © 2011 John Wardle Architects
 Level 10, 180 Russell Street, Melbourne Victoria 3000 Australia
 Tel : +613 9654 8700 www.johnwardlearchitects.com

Client **University of Melbourne Parkville Campus**

Project **Faculty of Architecture Building and Planning**













Title **JOSEPH REED FACADE DETAILS**

Project No. **0913** Scale 1:5 @ A0
 Drawing No. **AR5163** Revision **A**

Date: DEC 2013 Drawn: Co-Ord: Check:

FILENAME: #####

FOR CONSTRUCTION

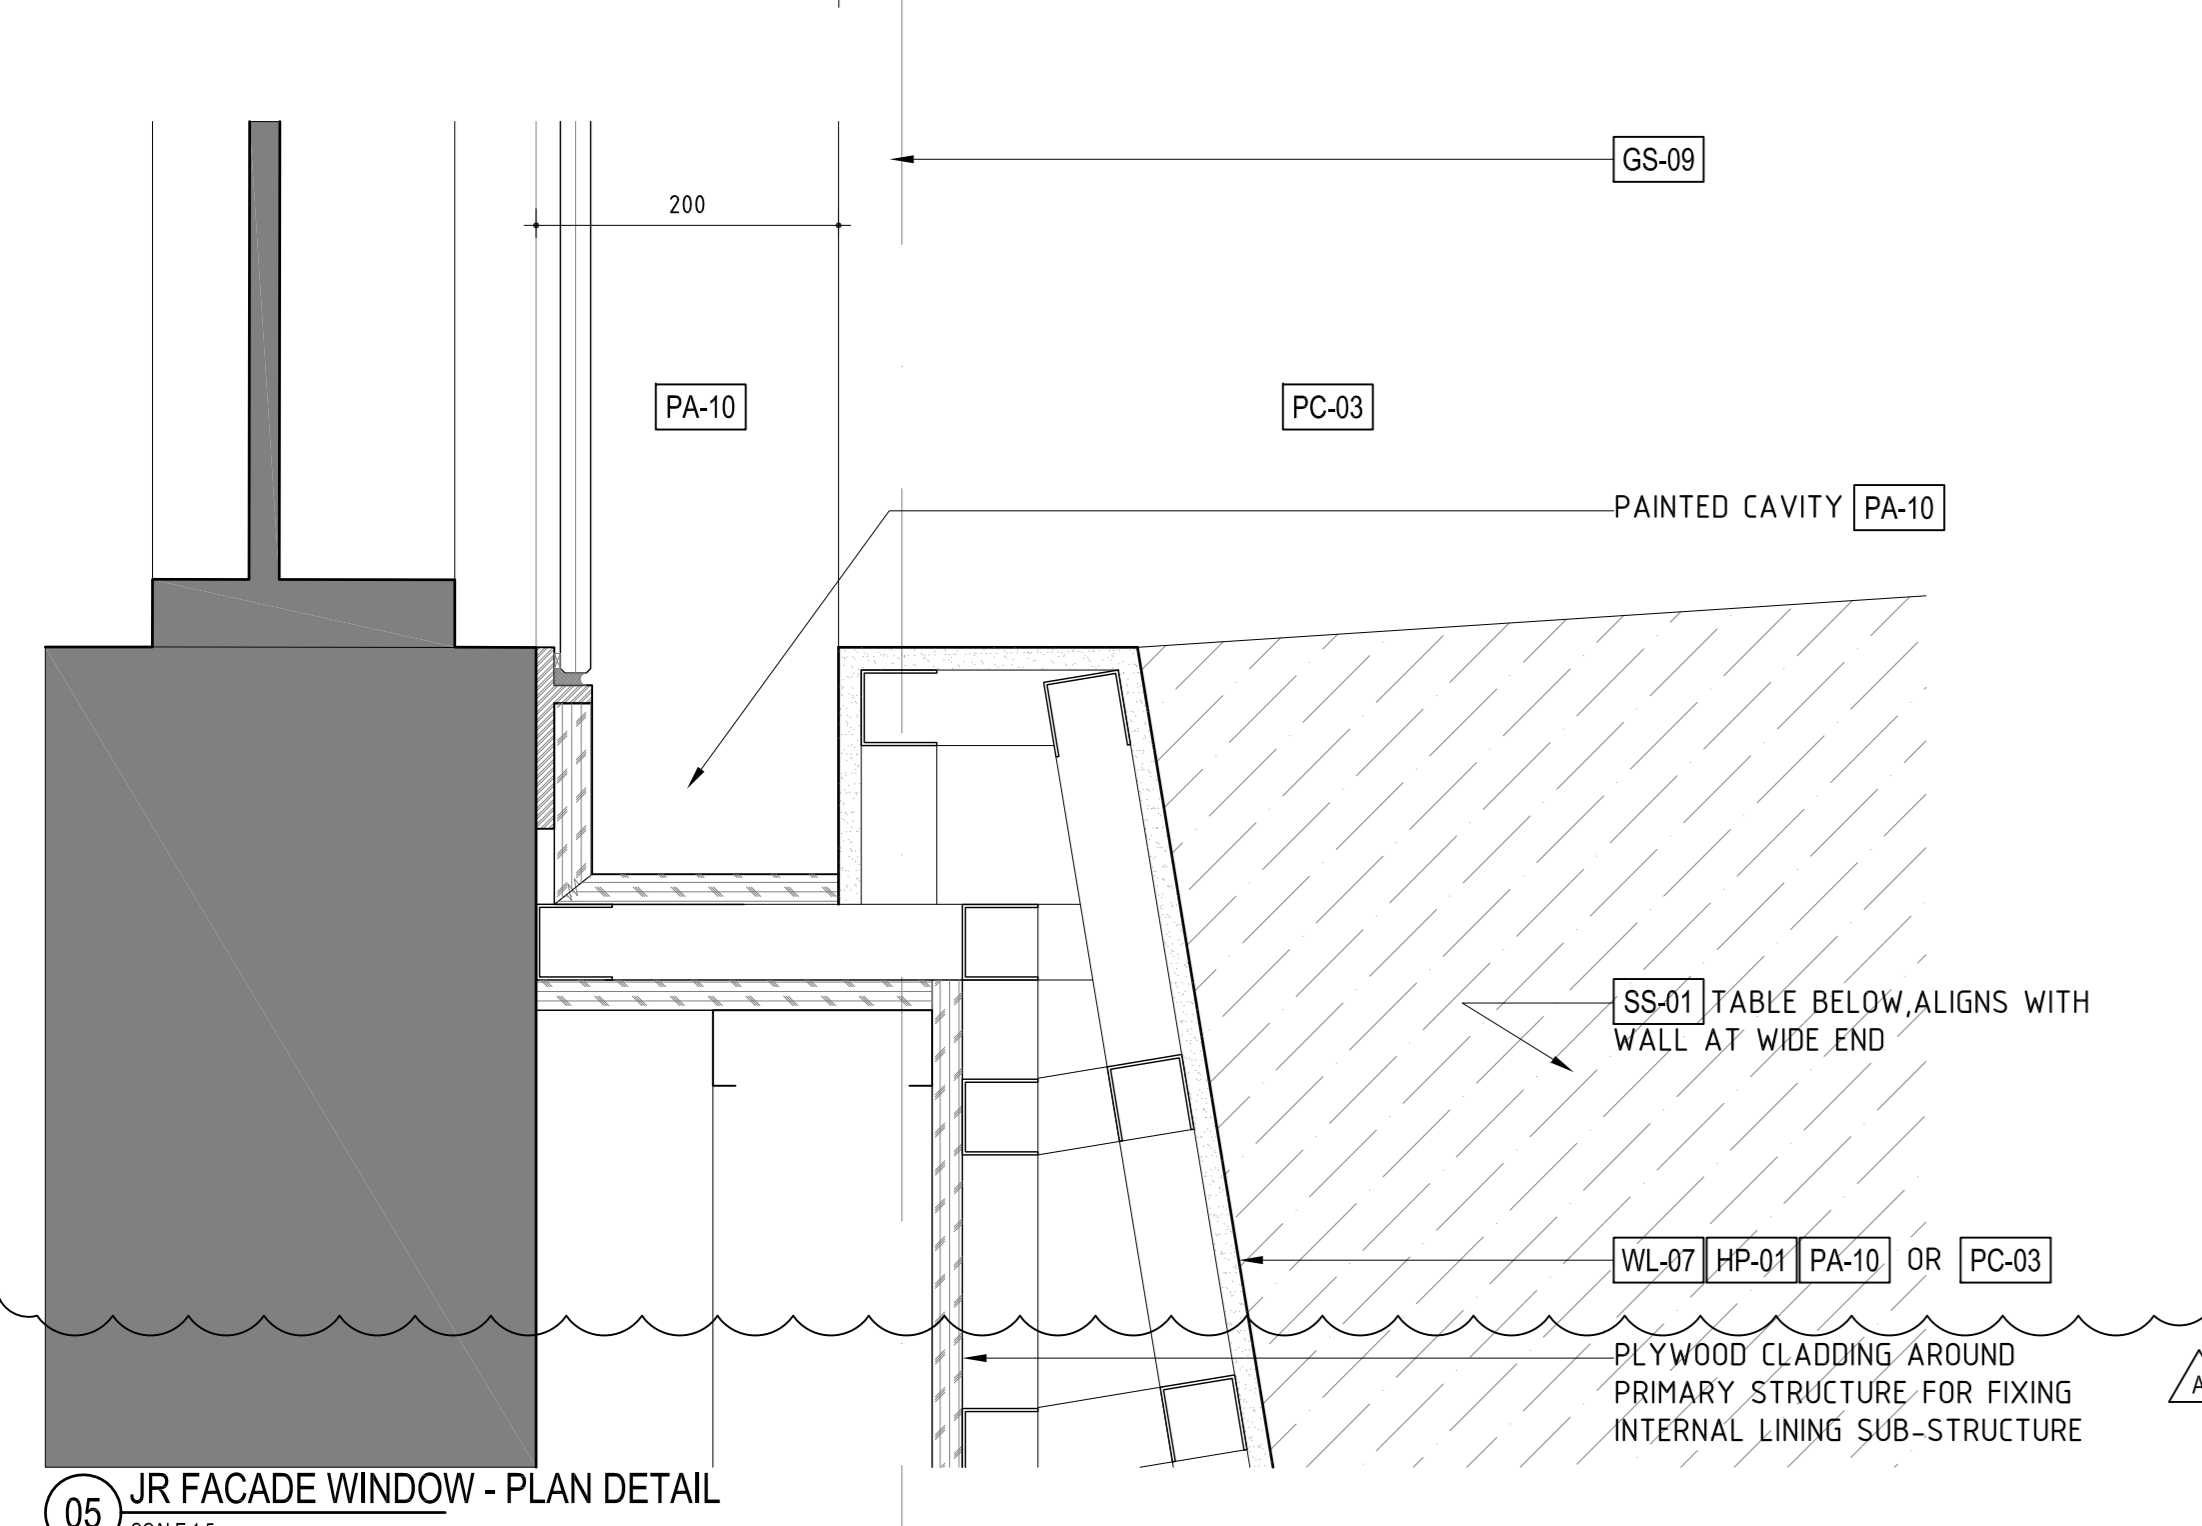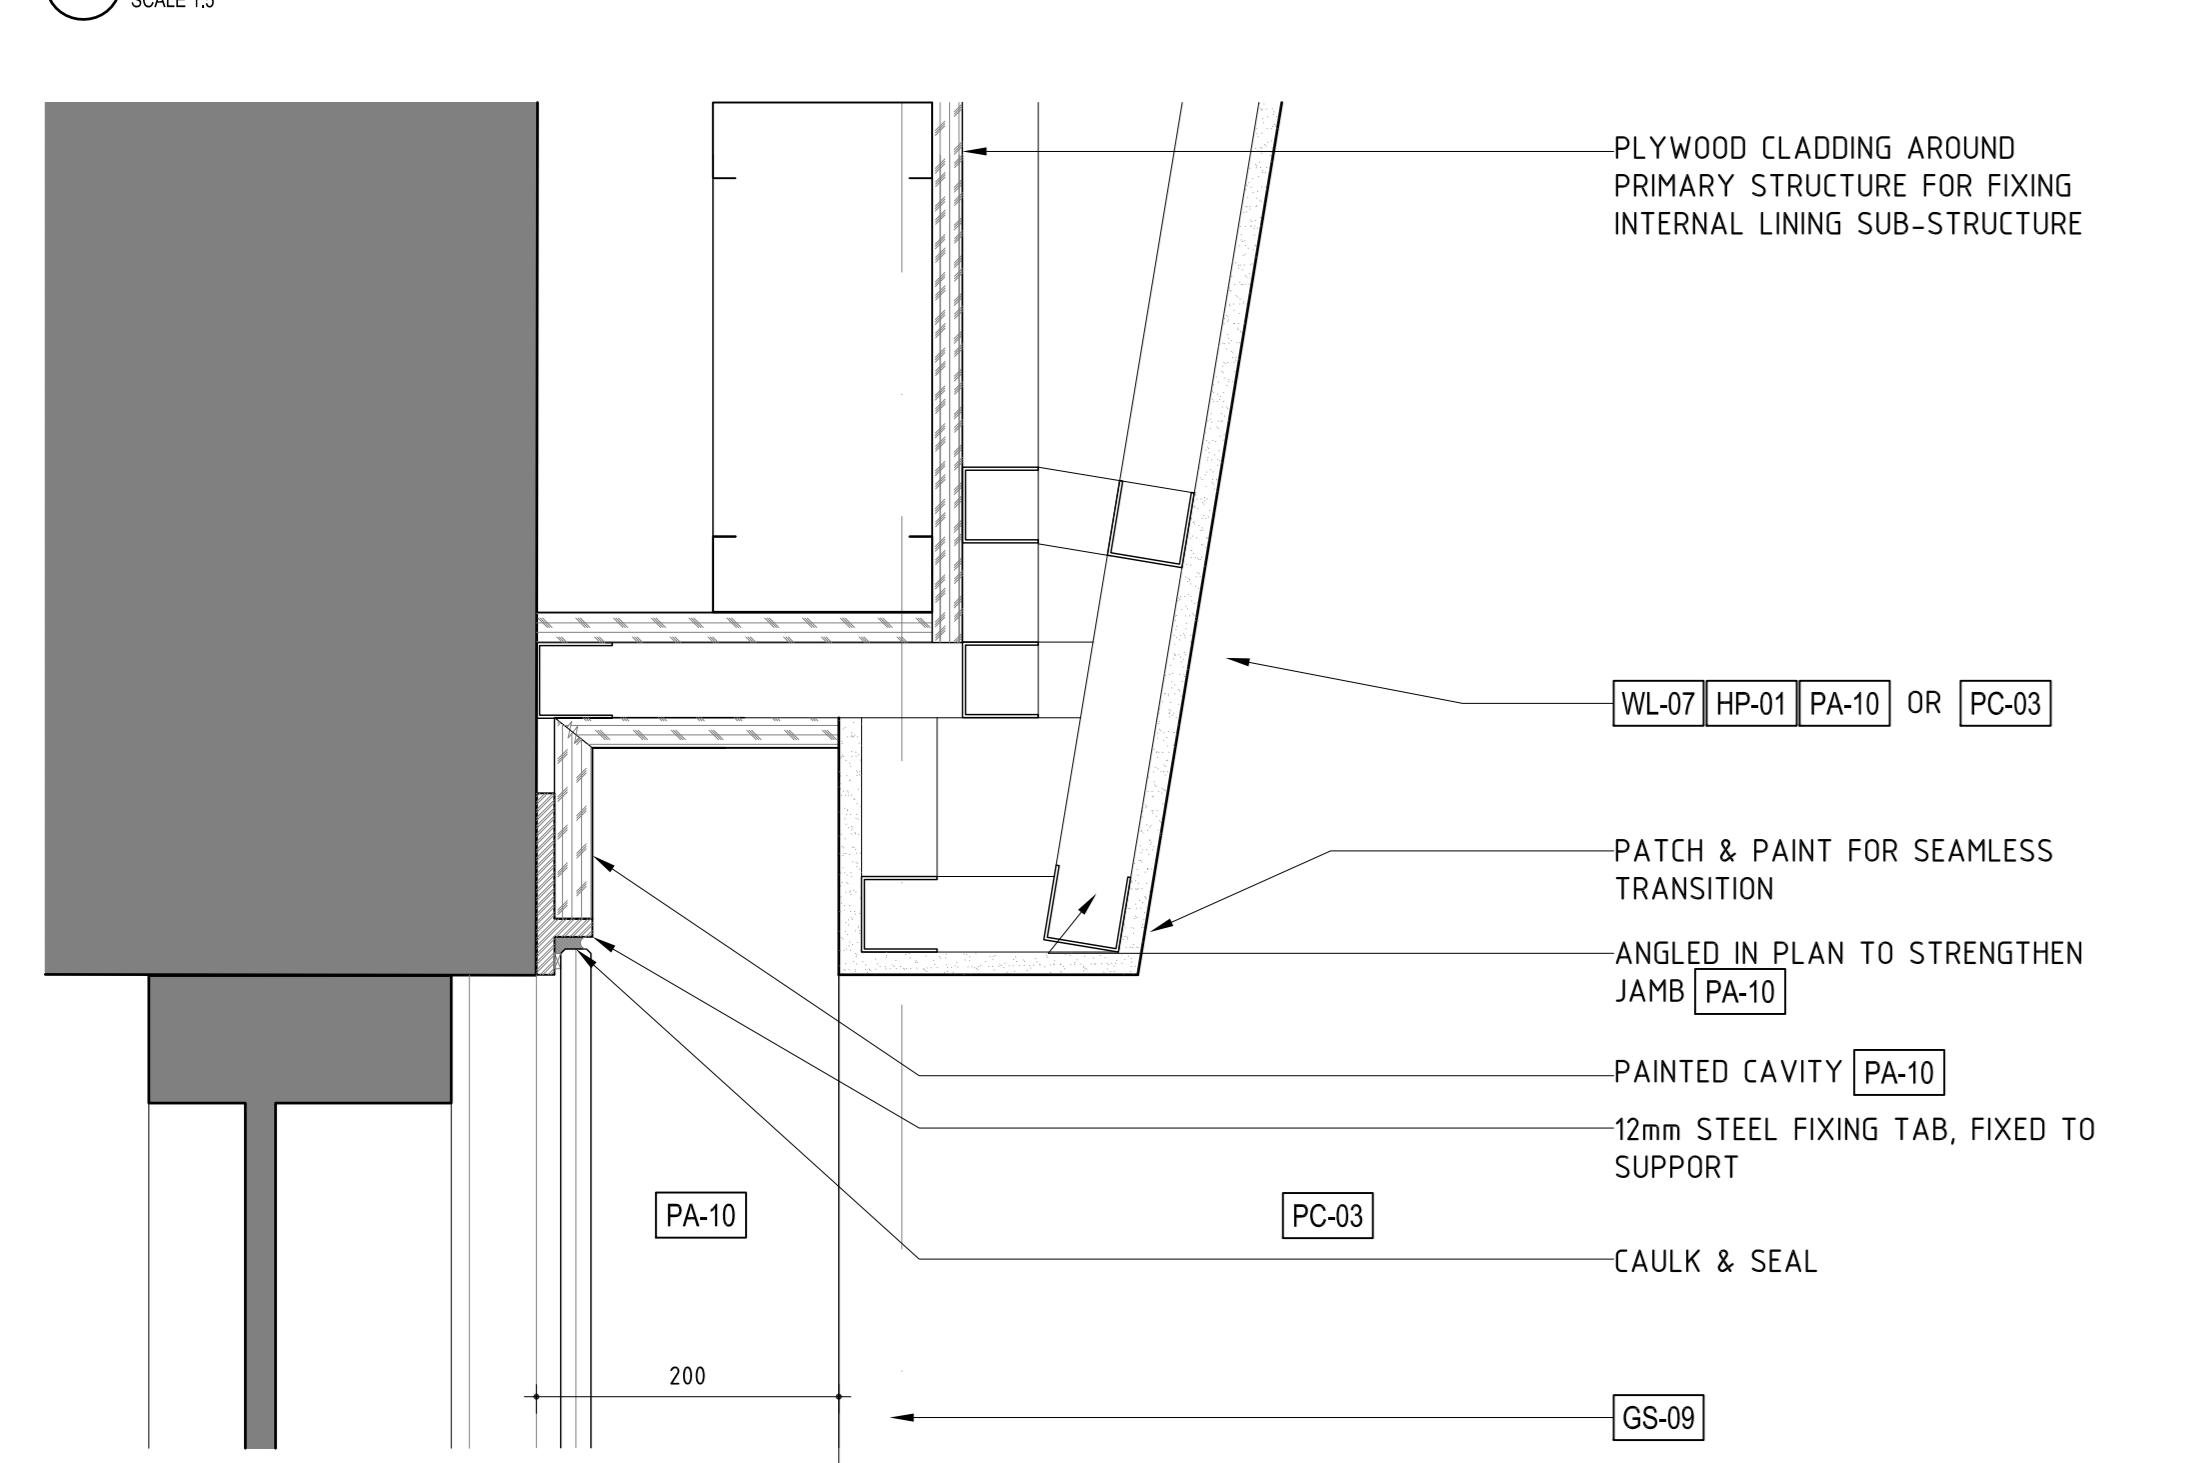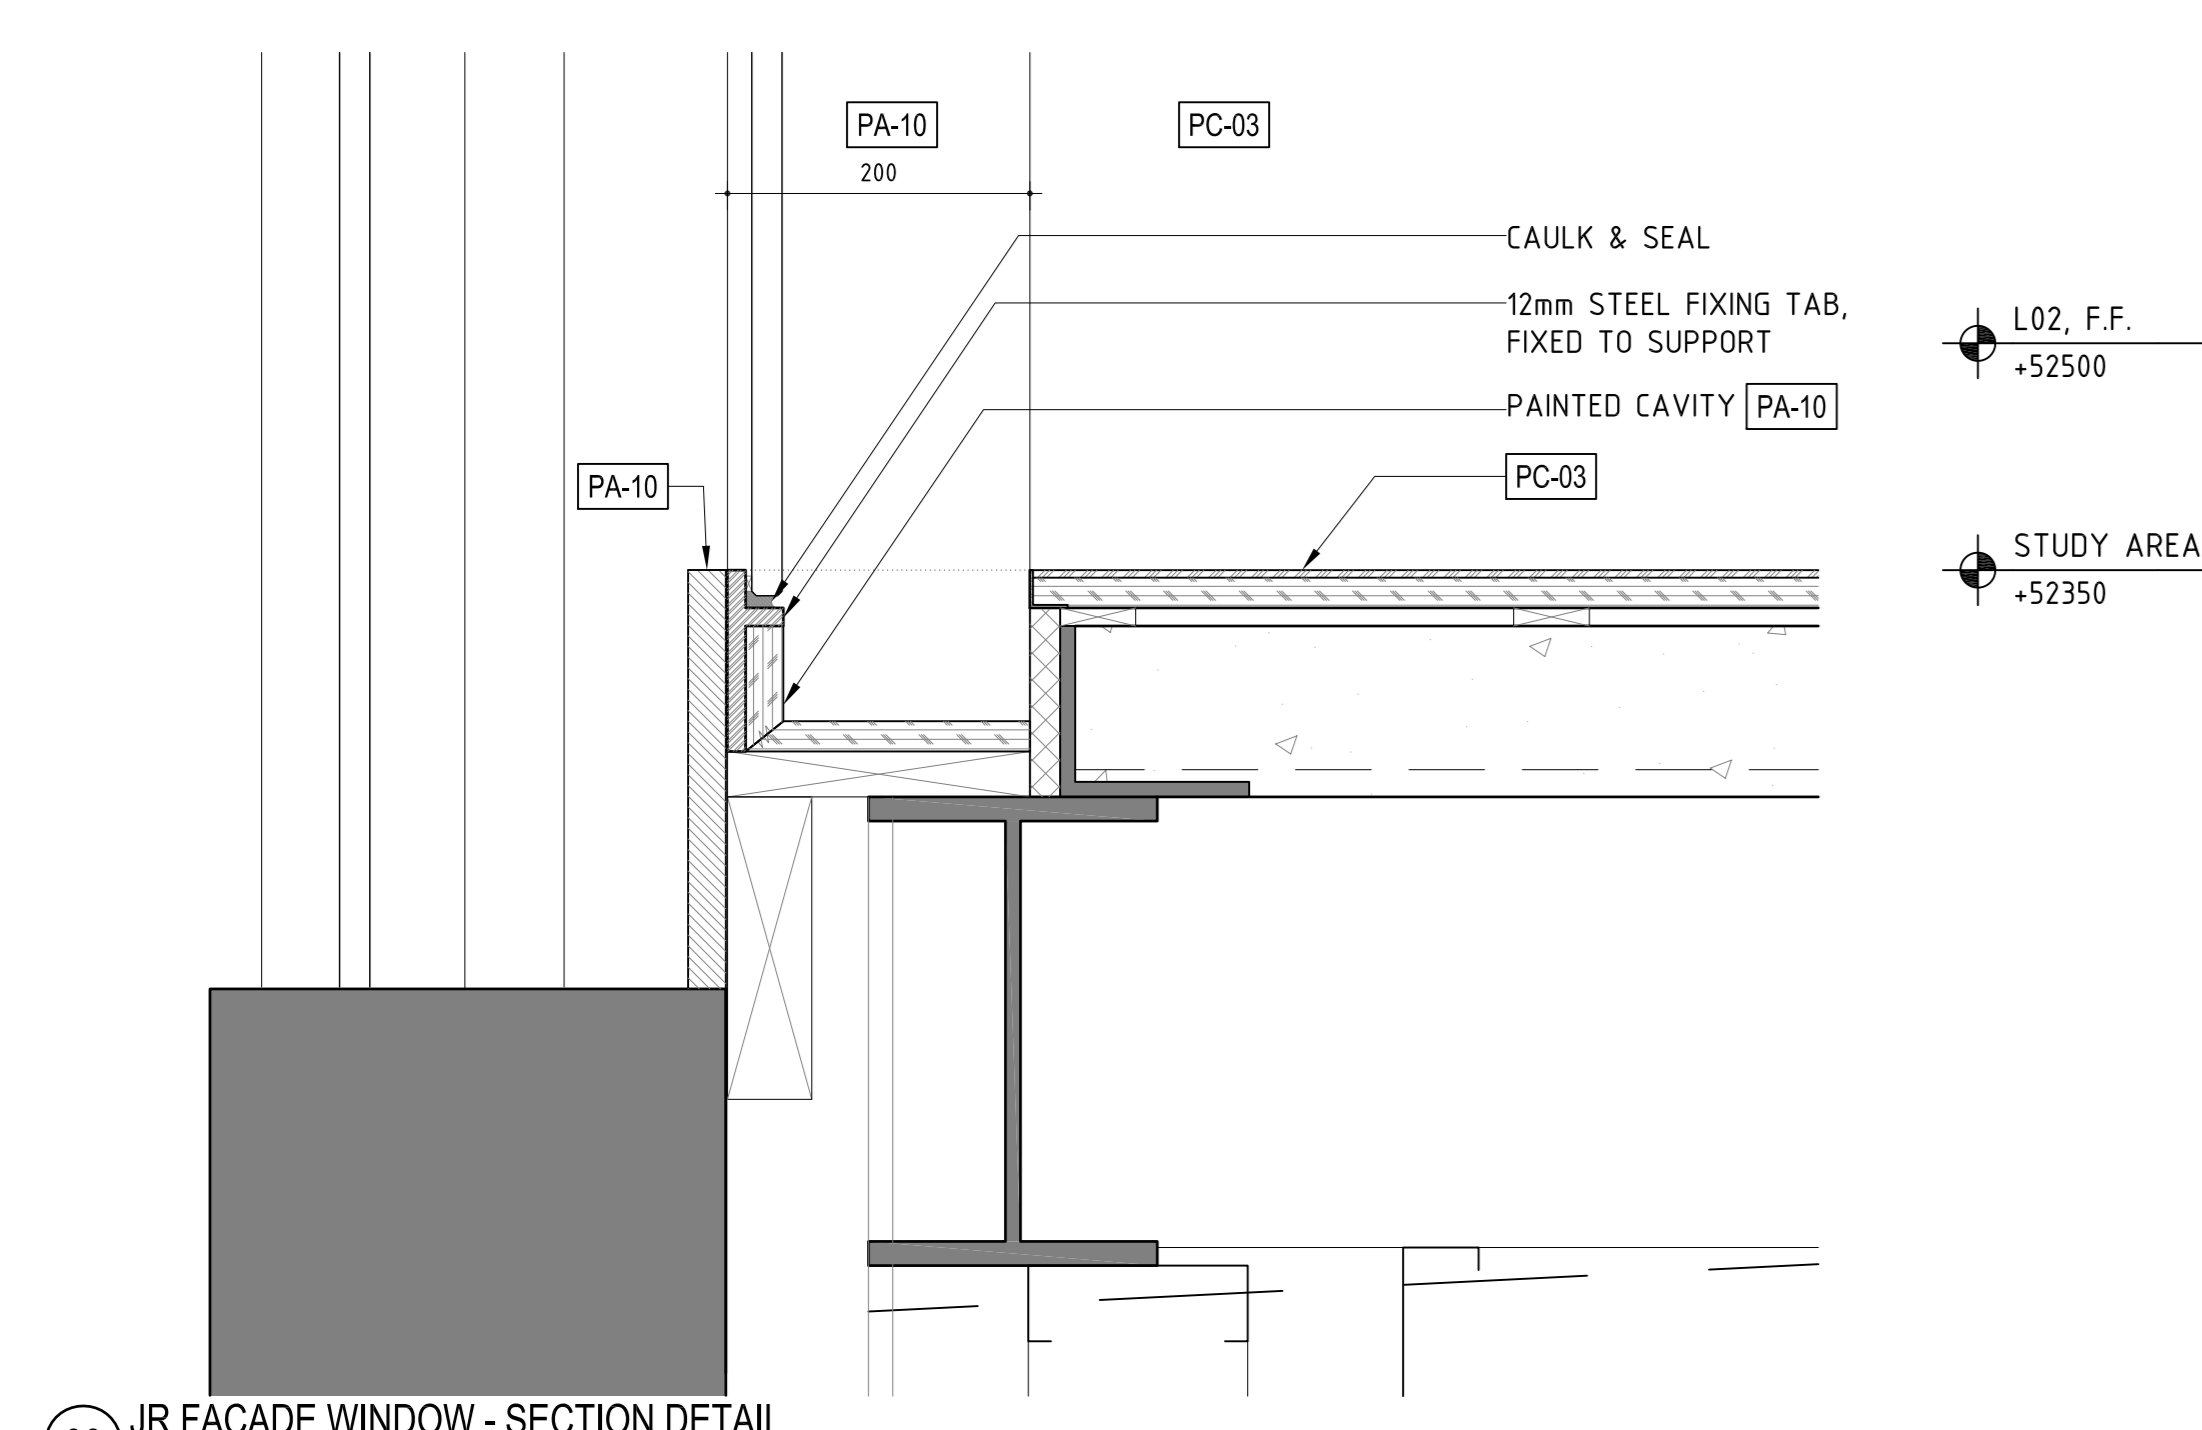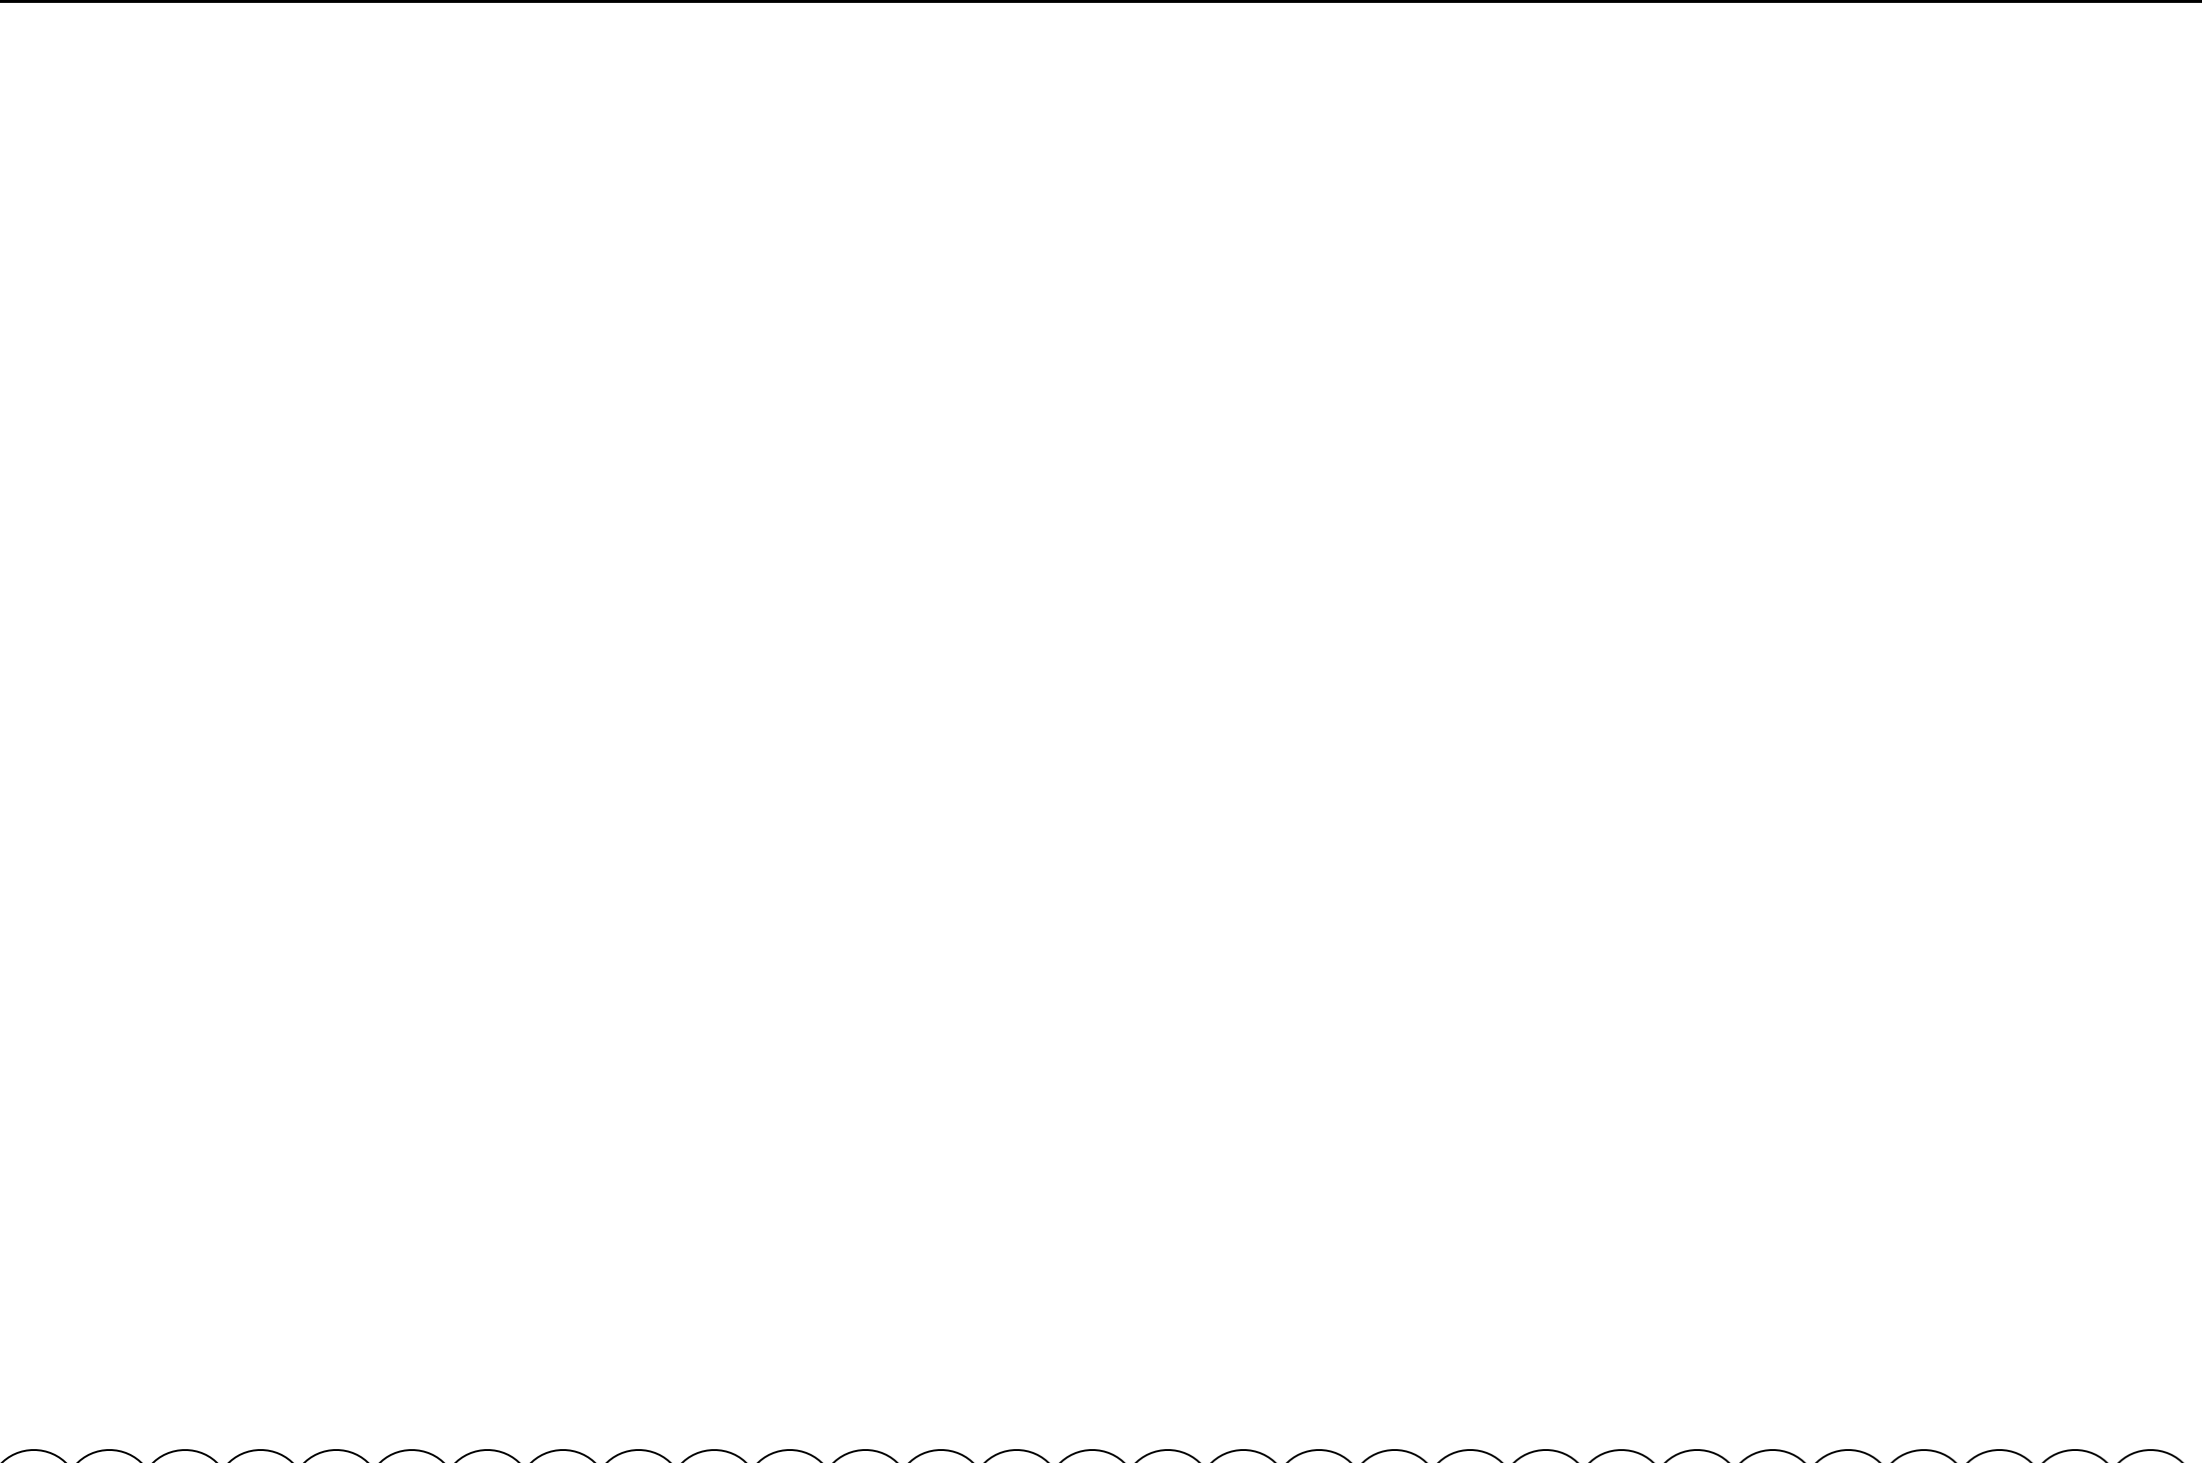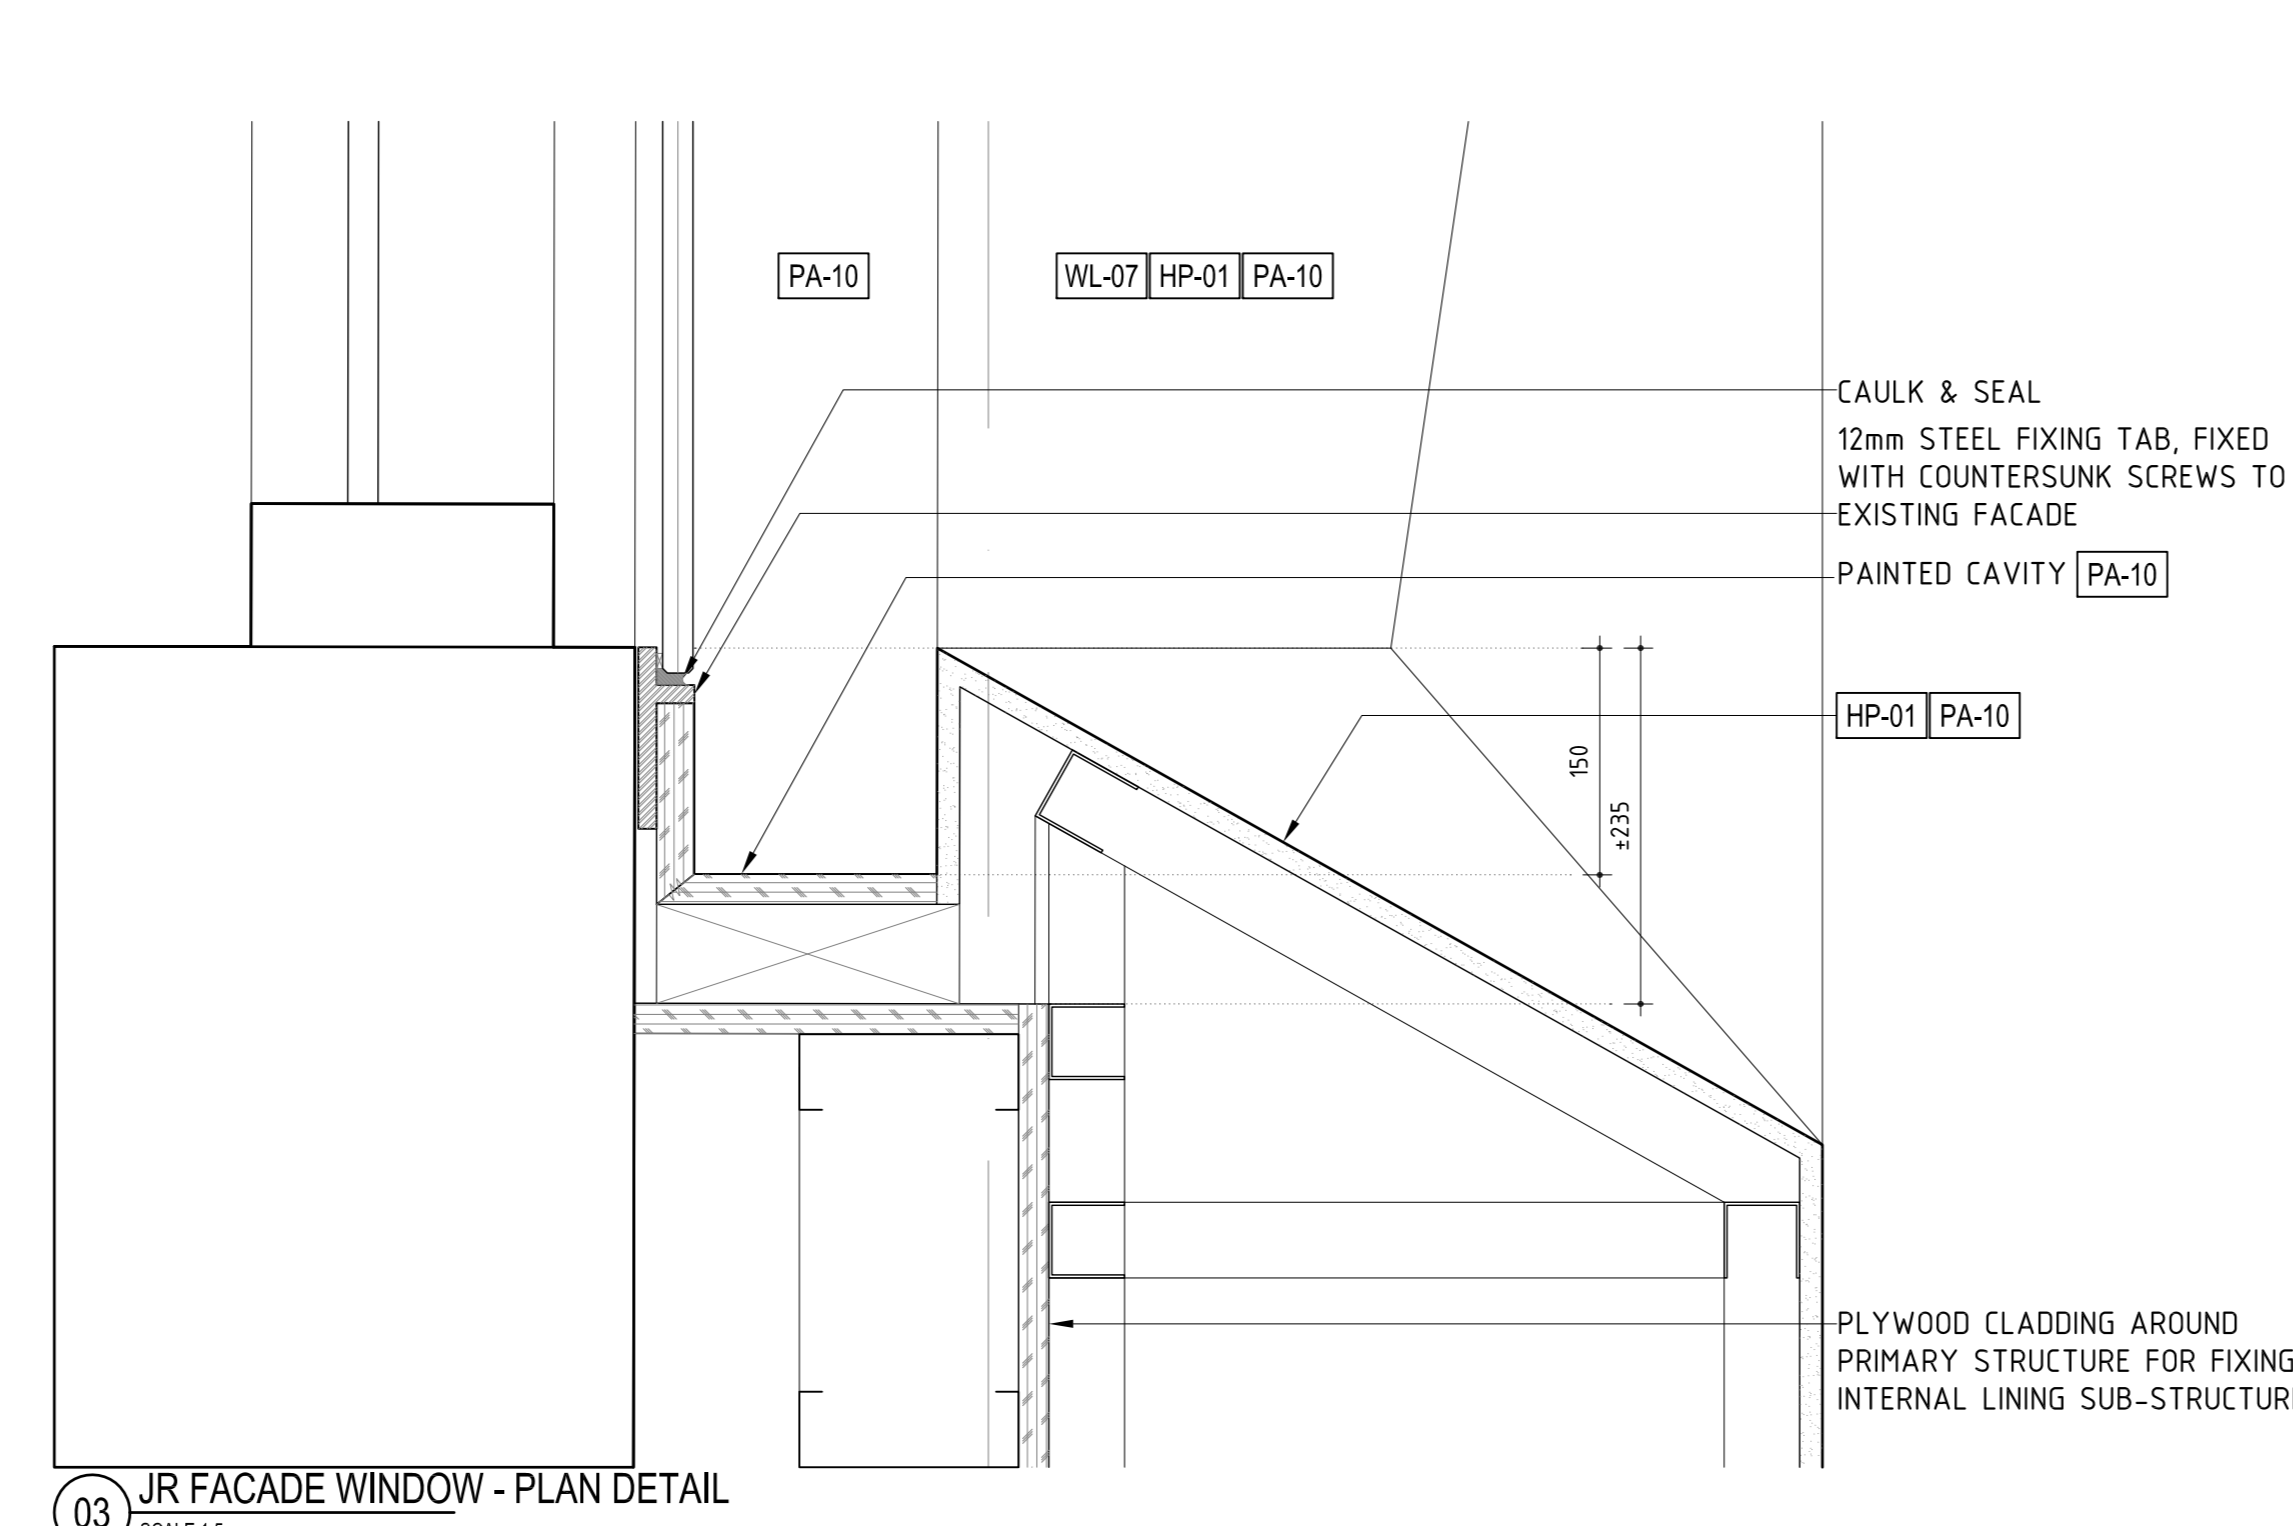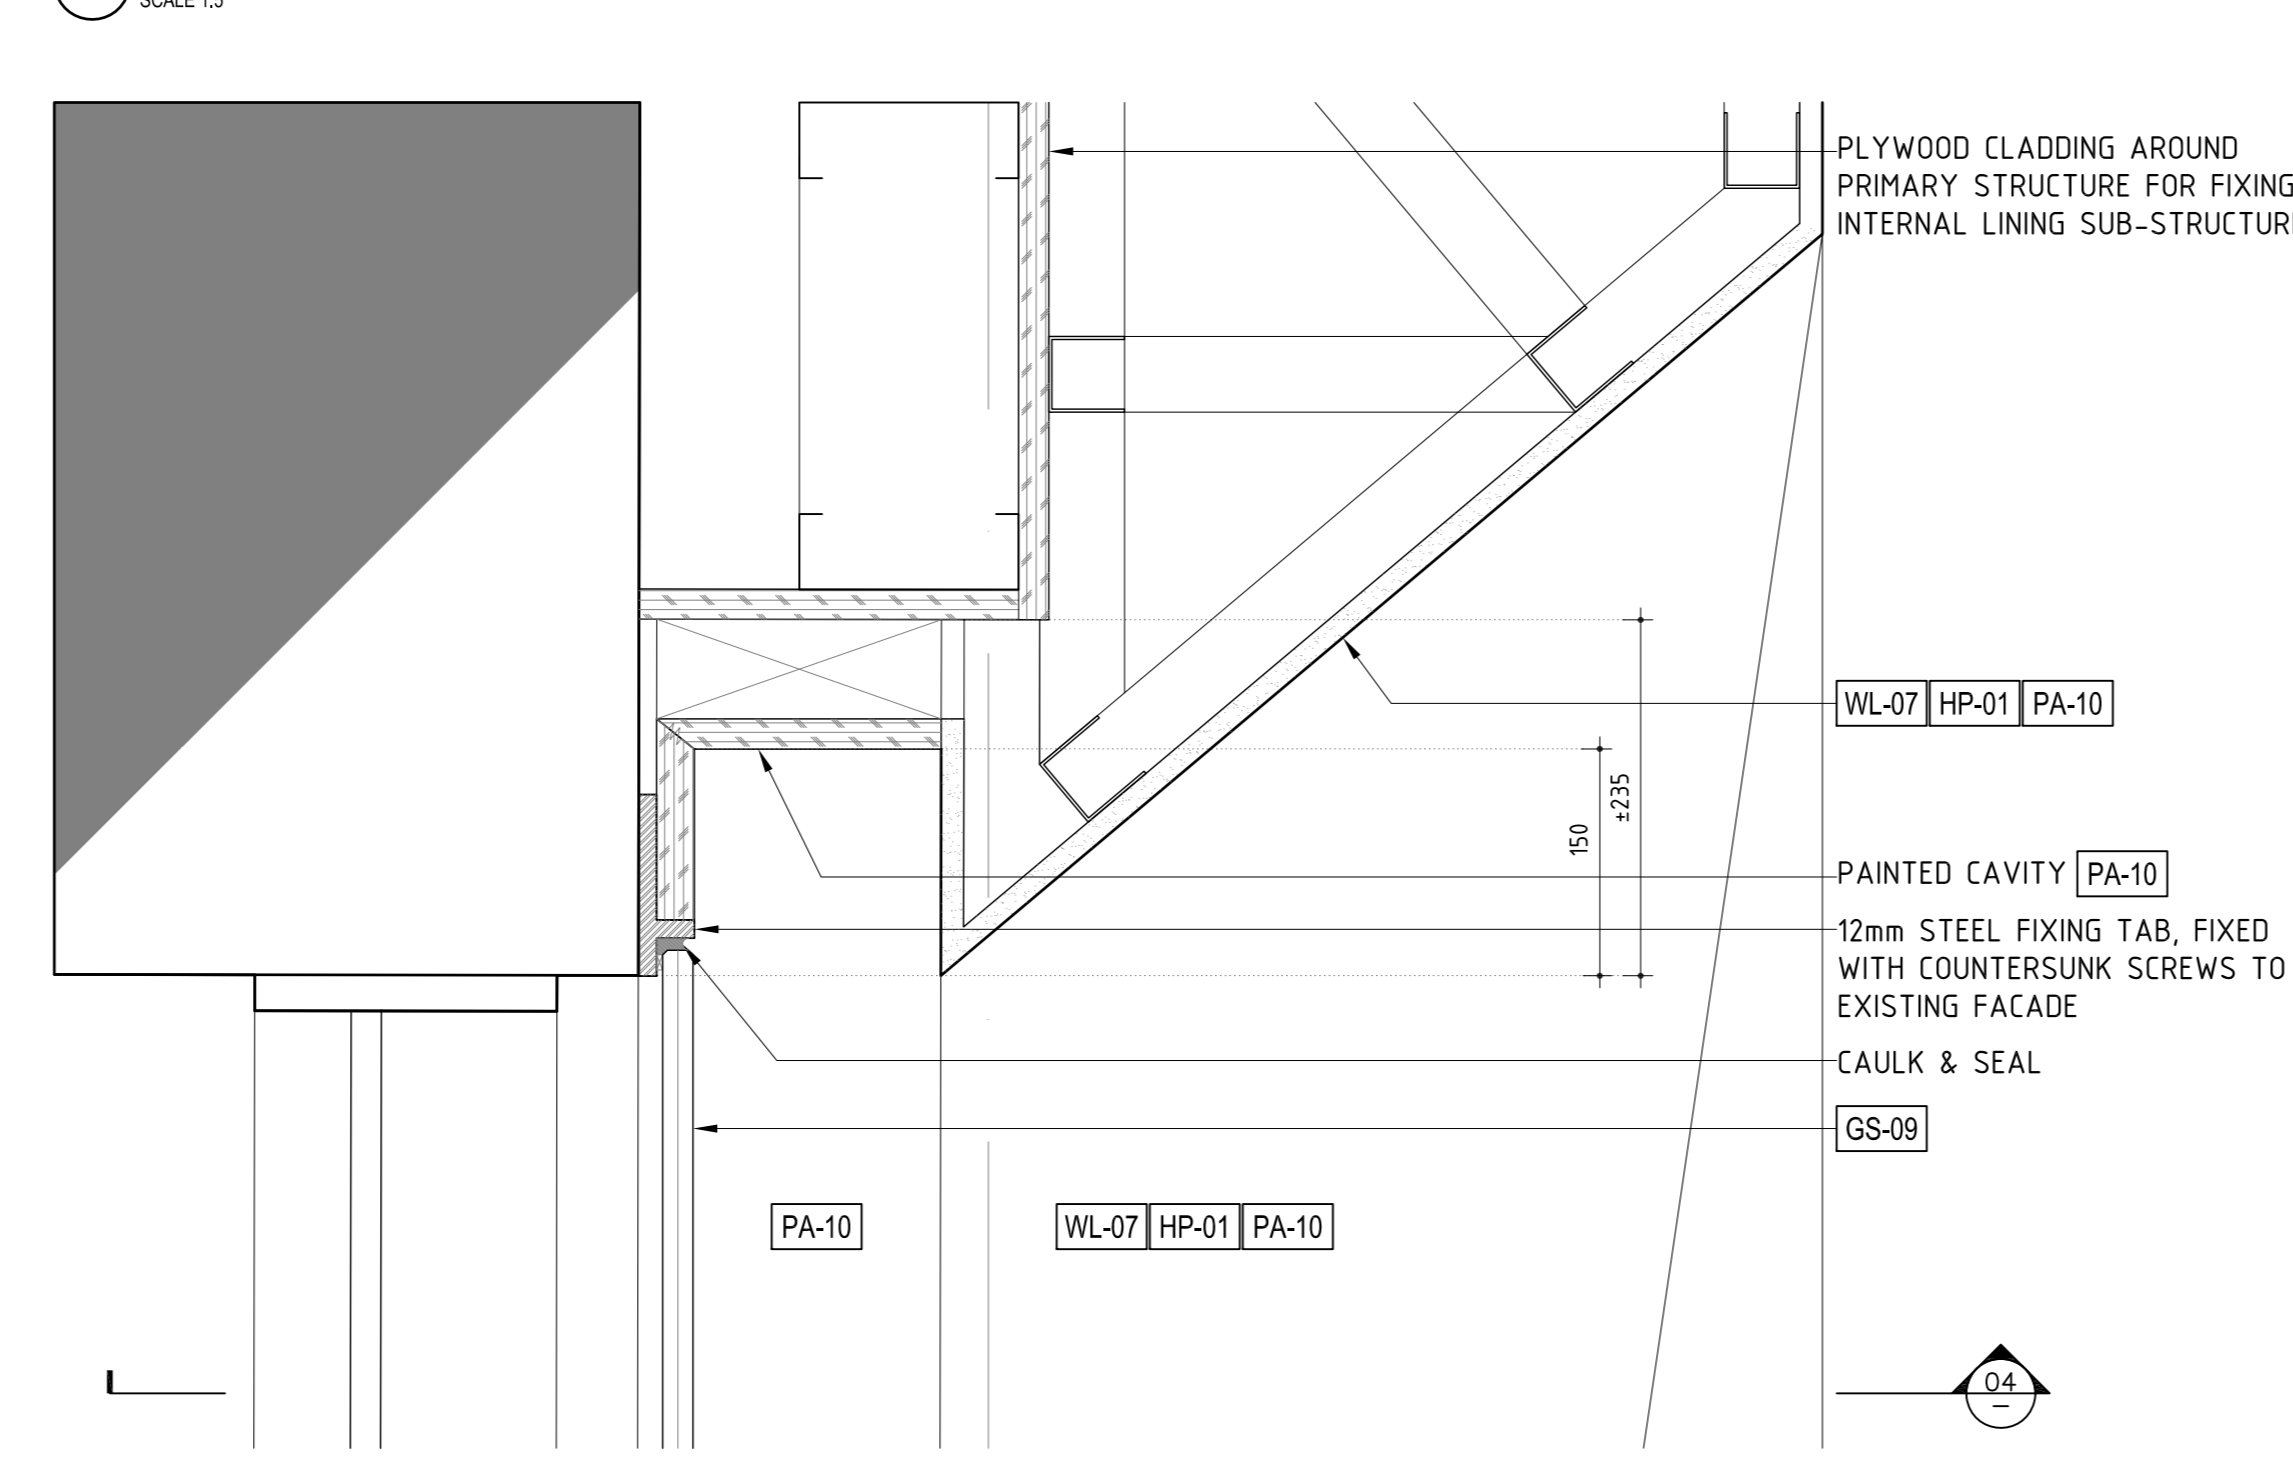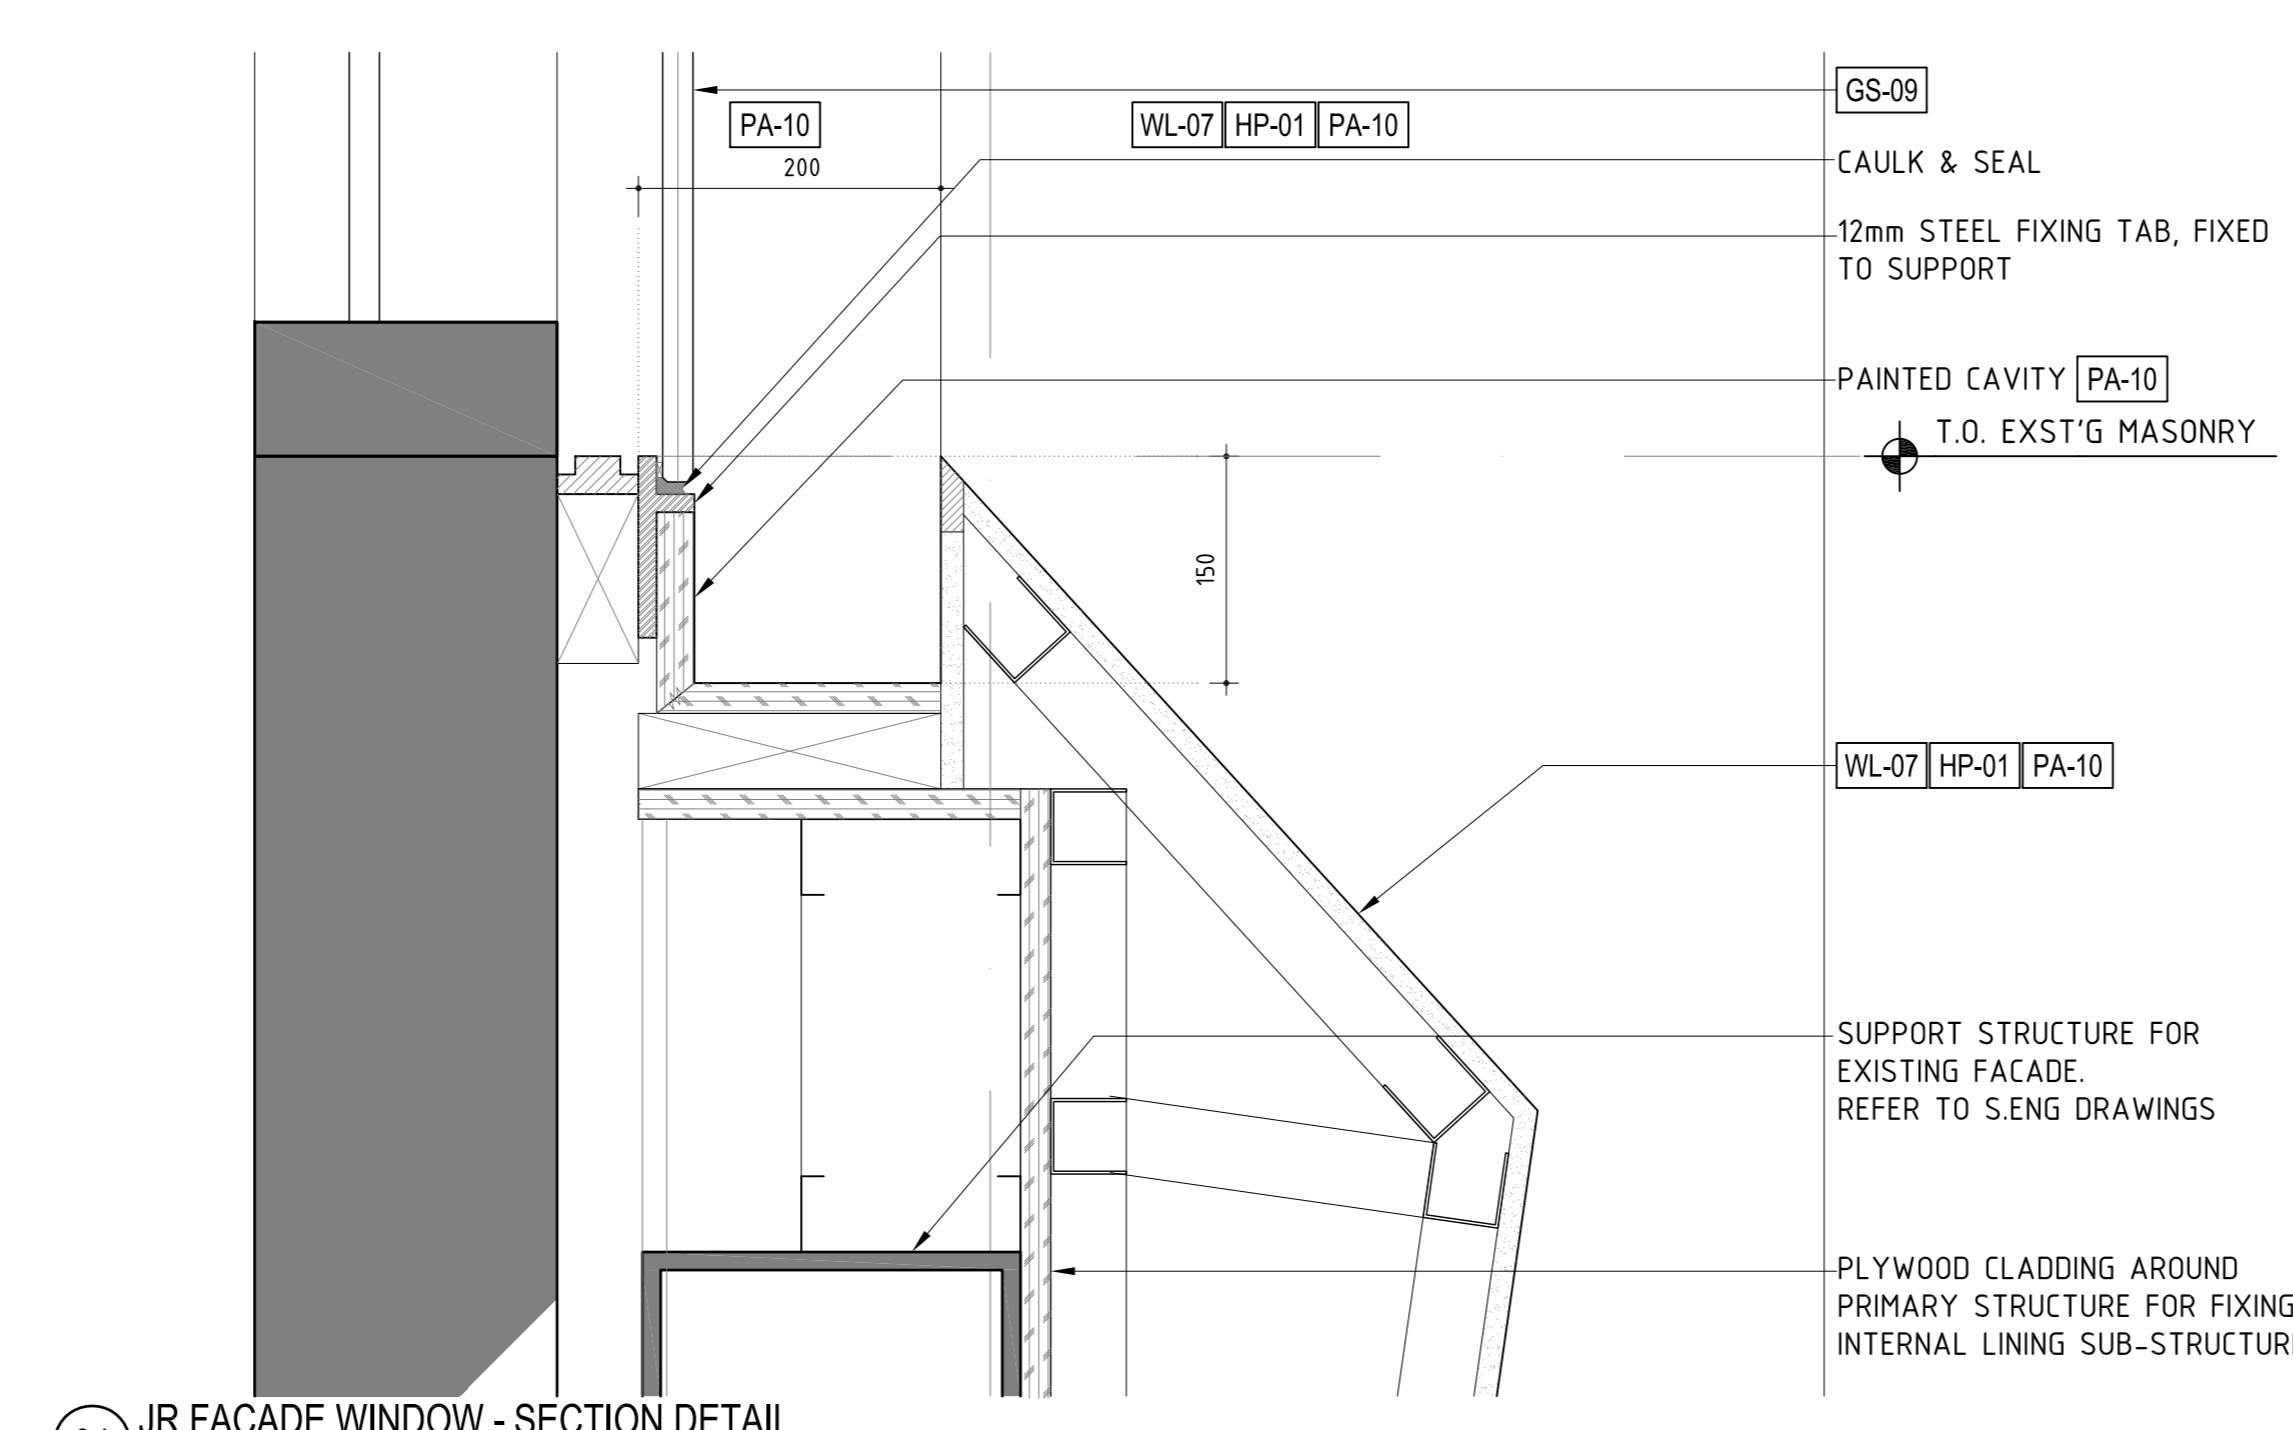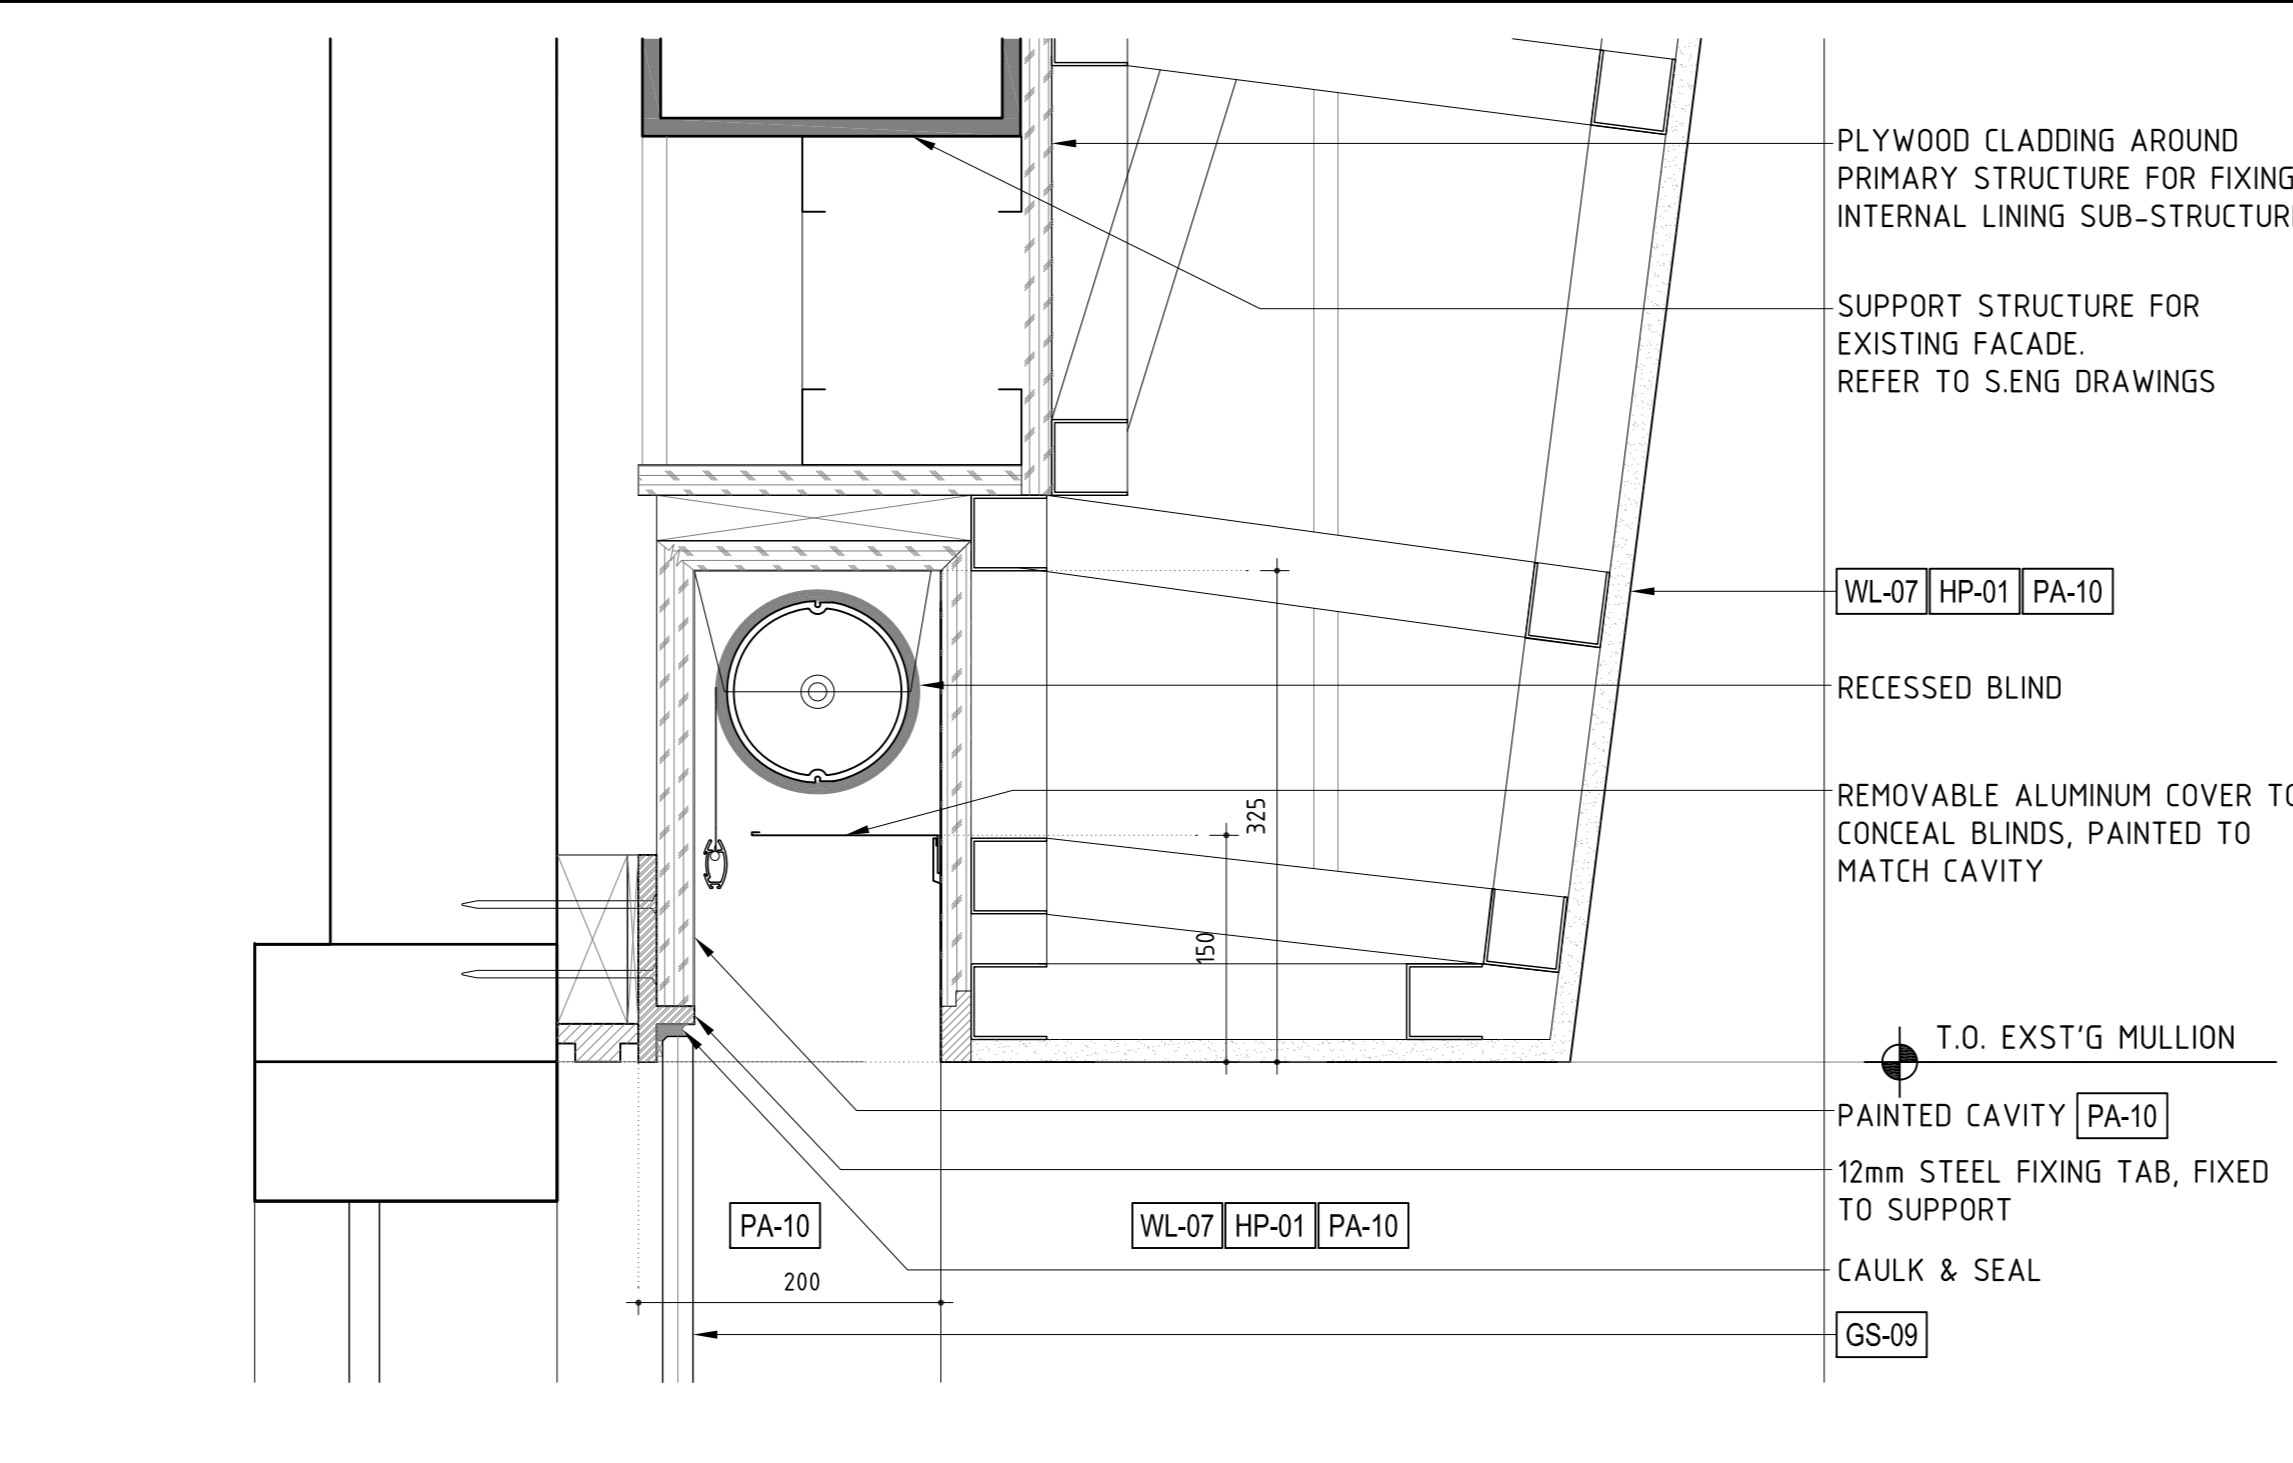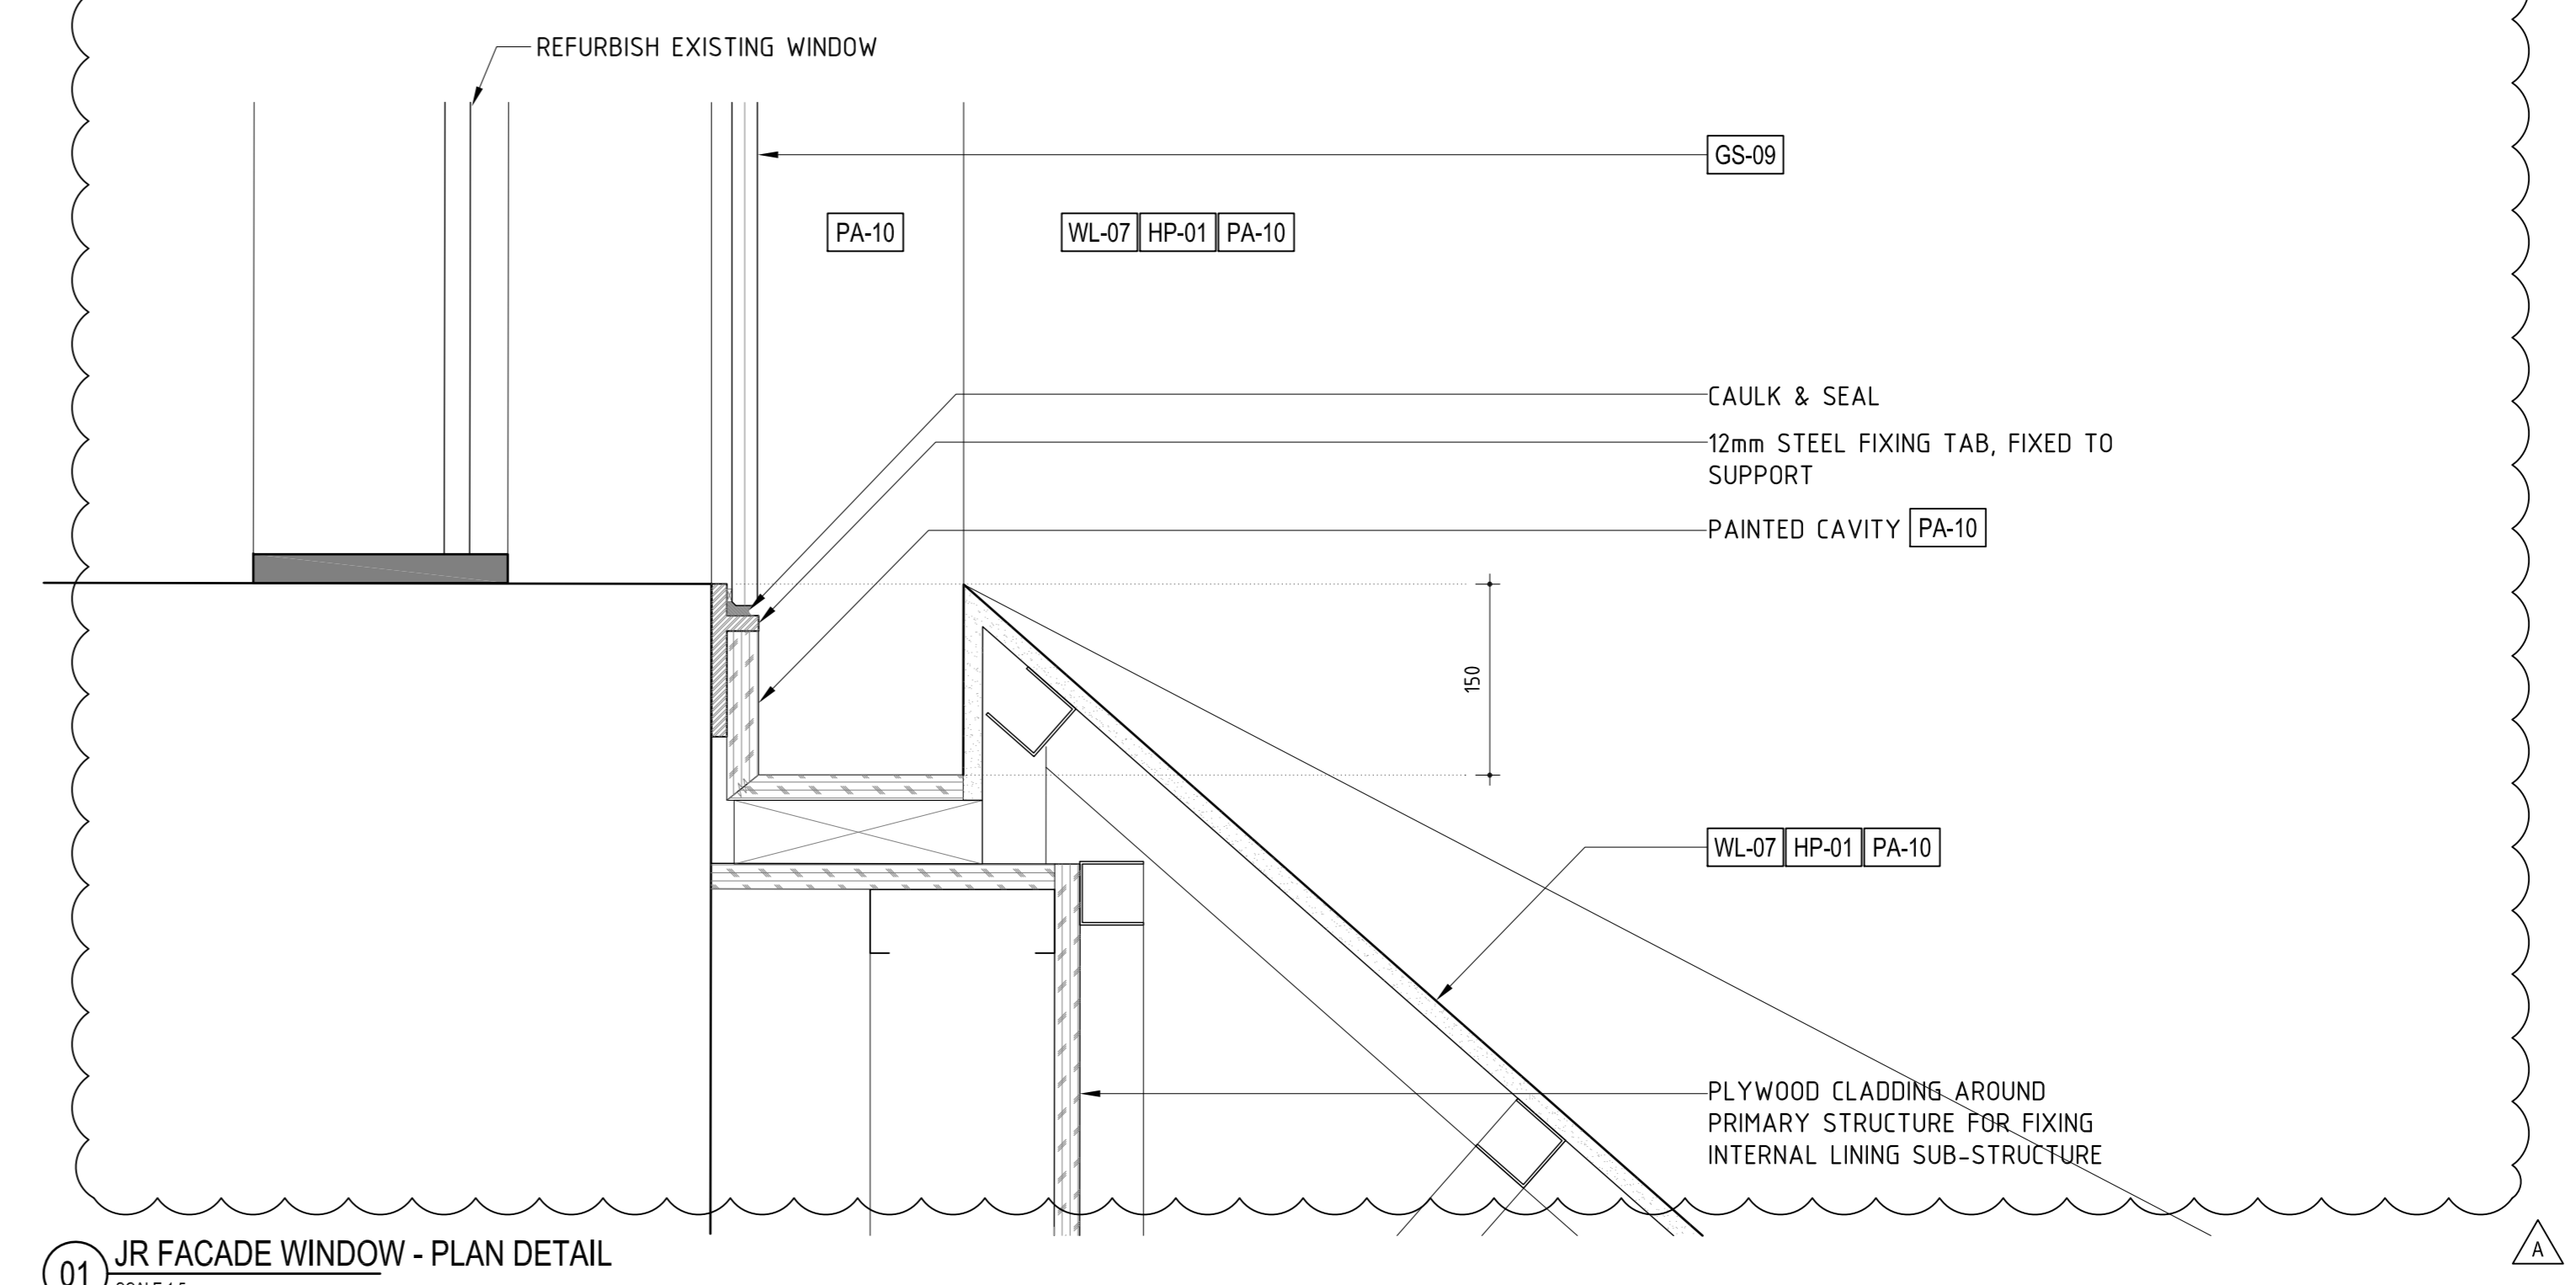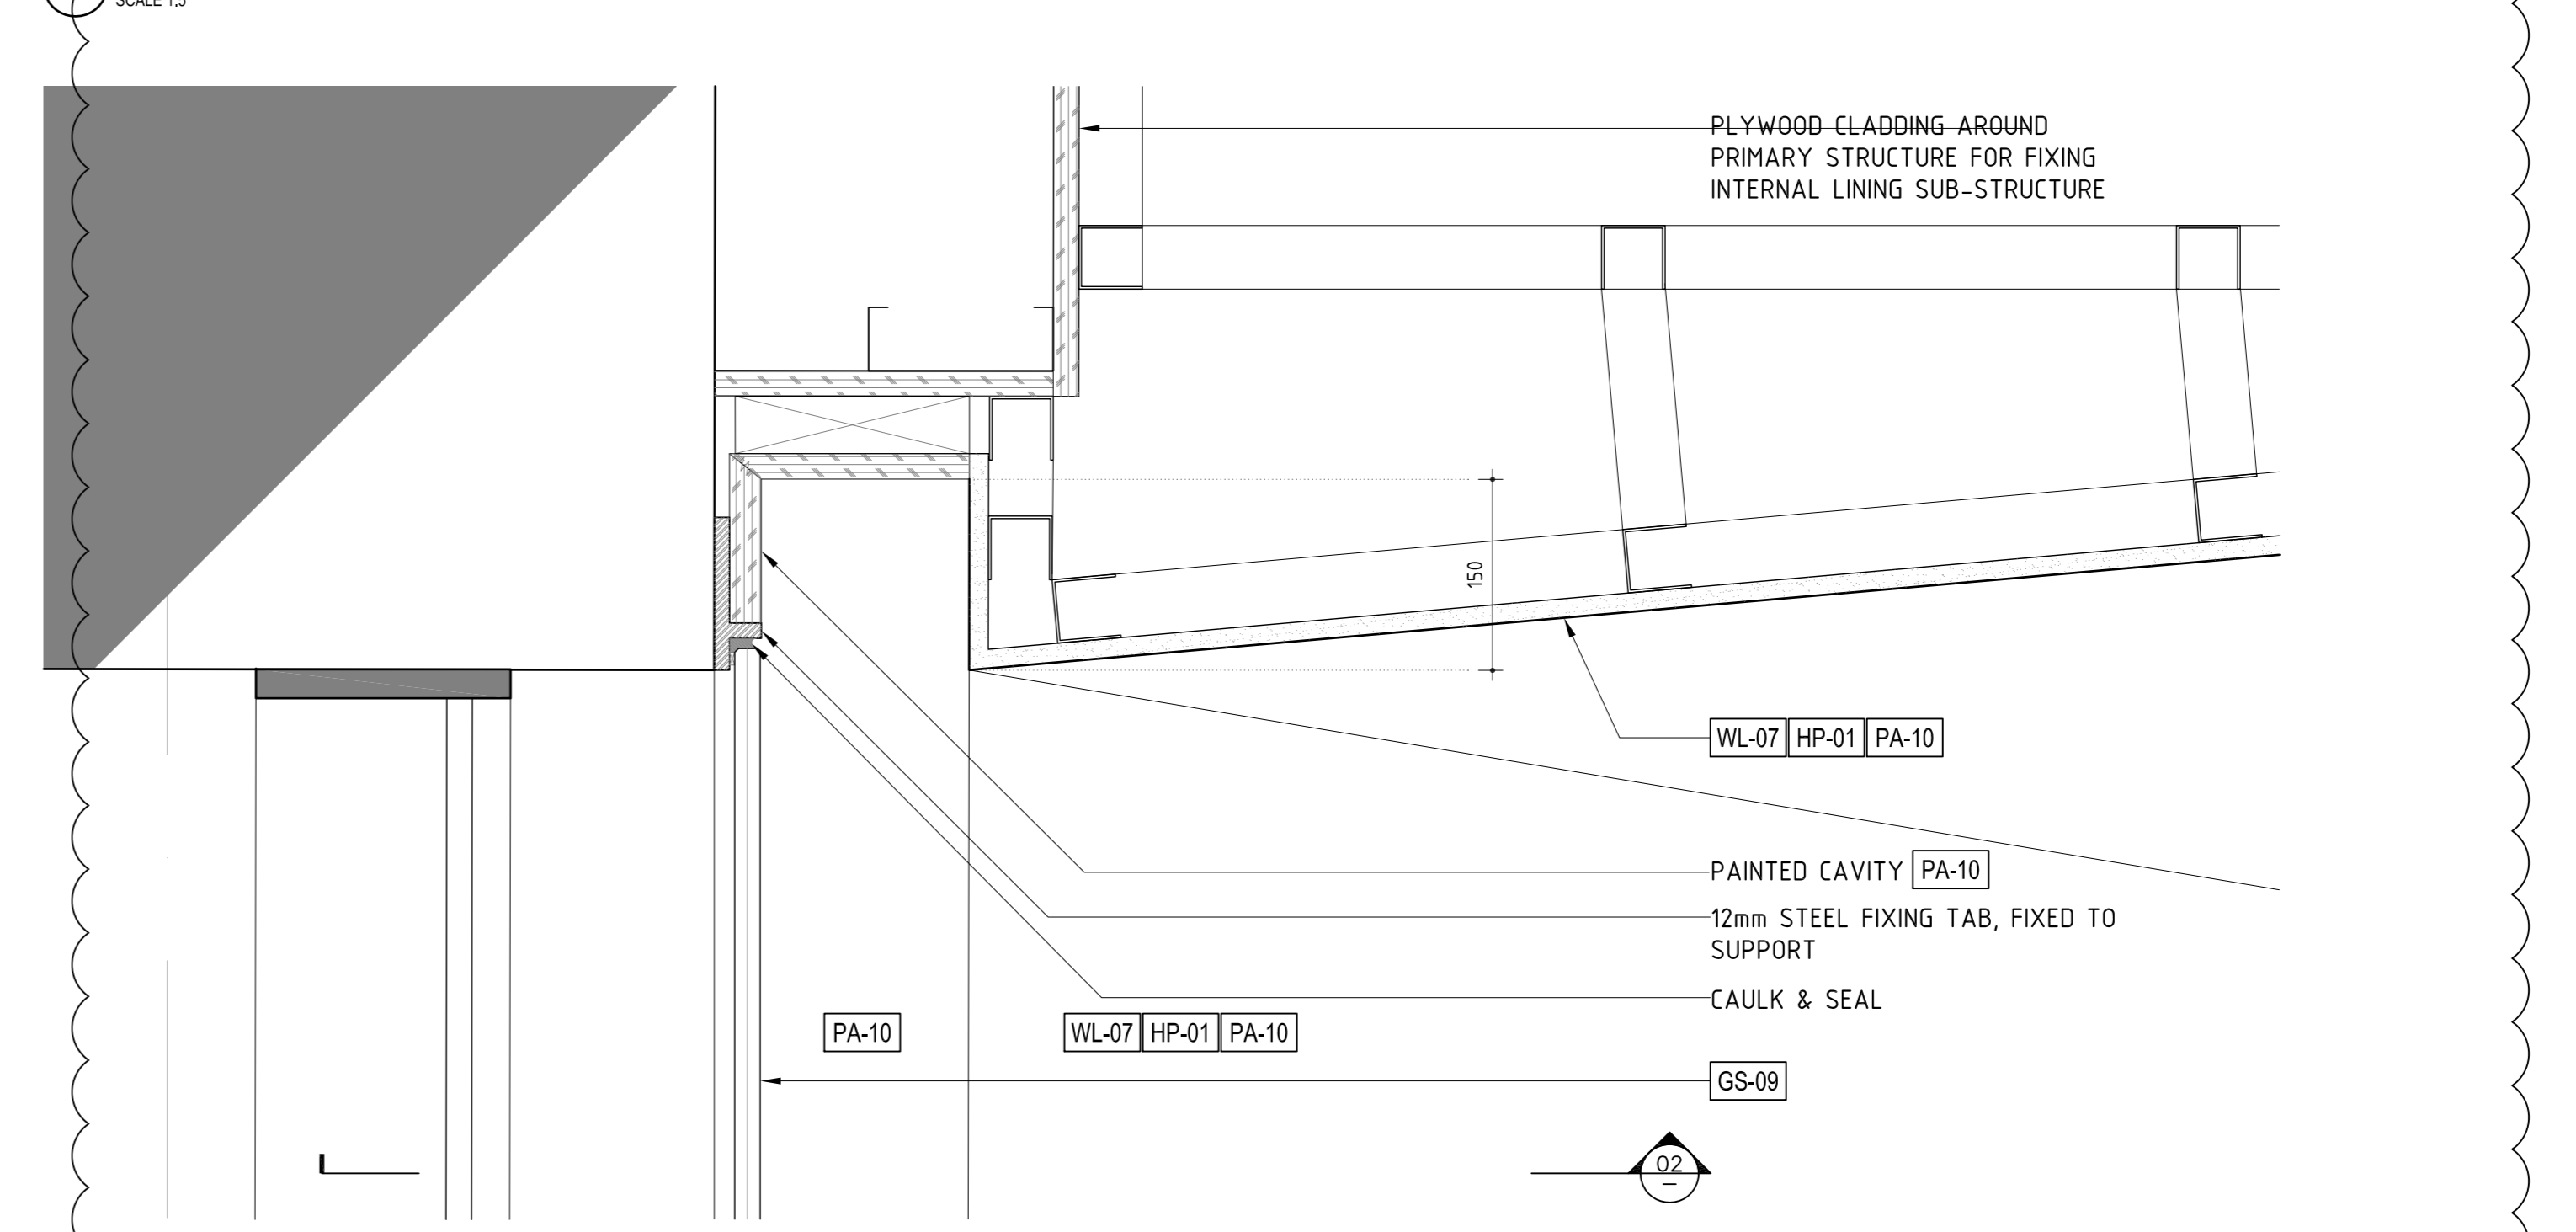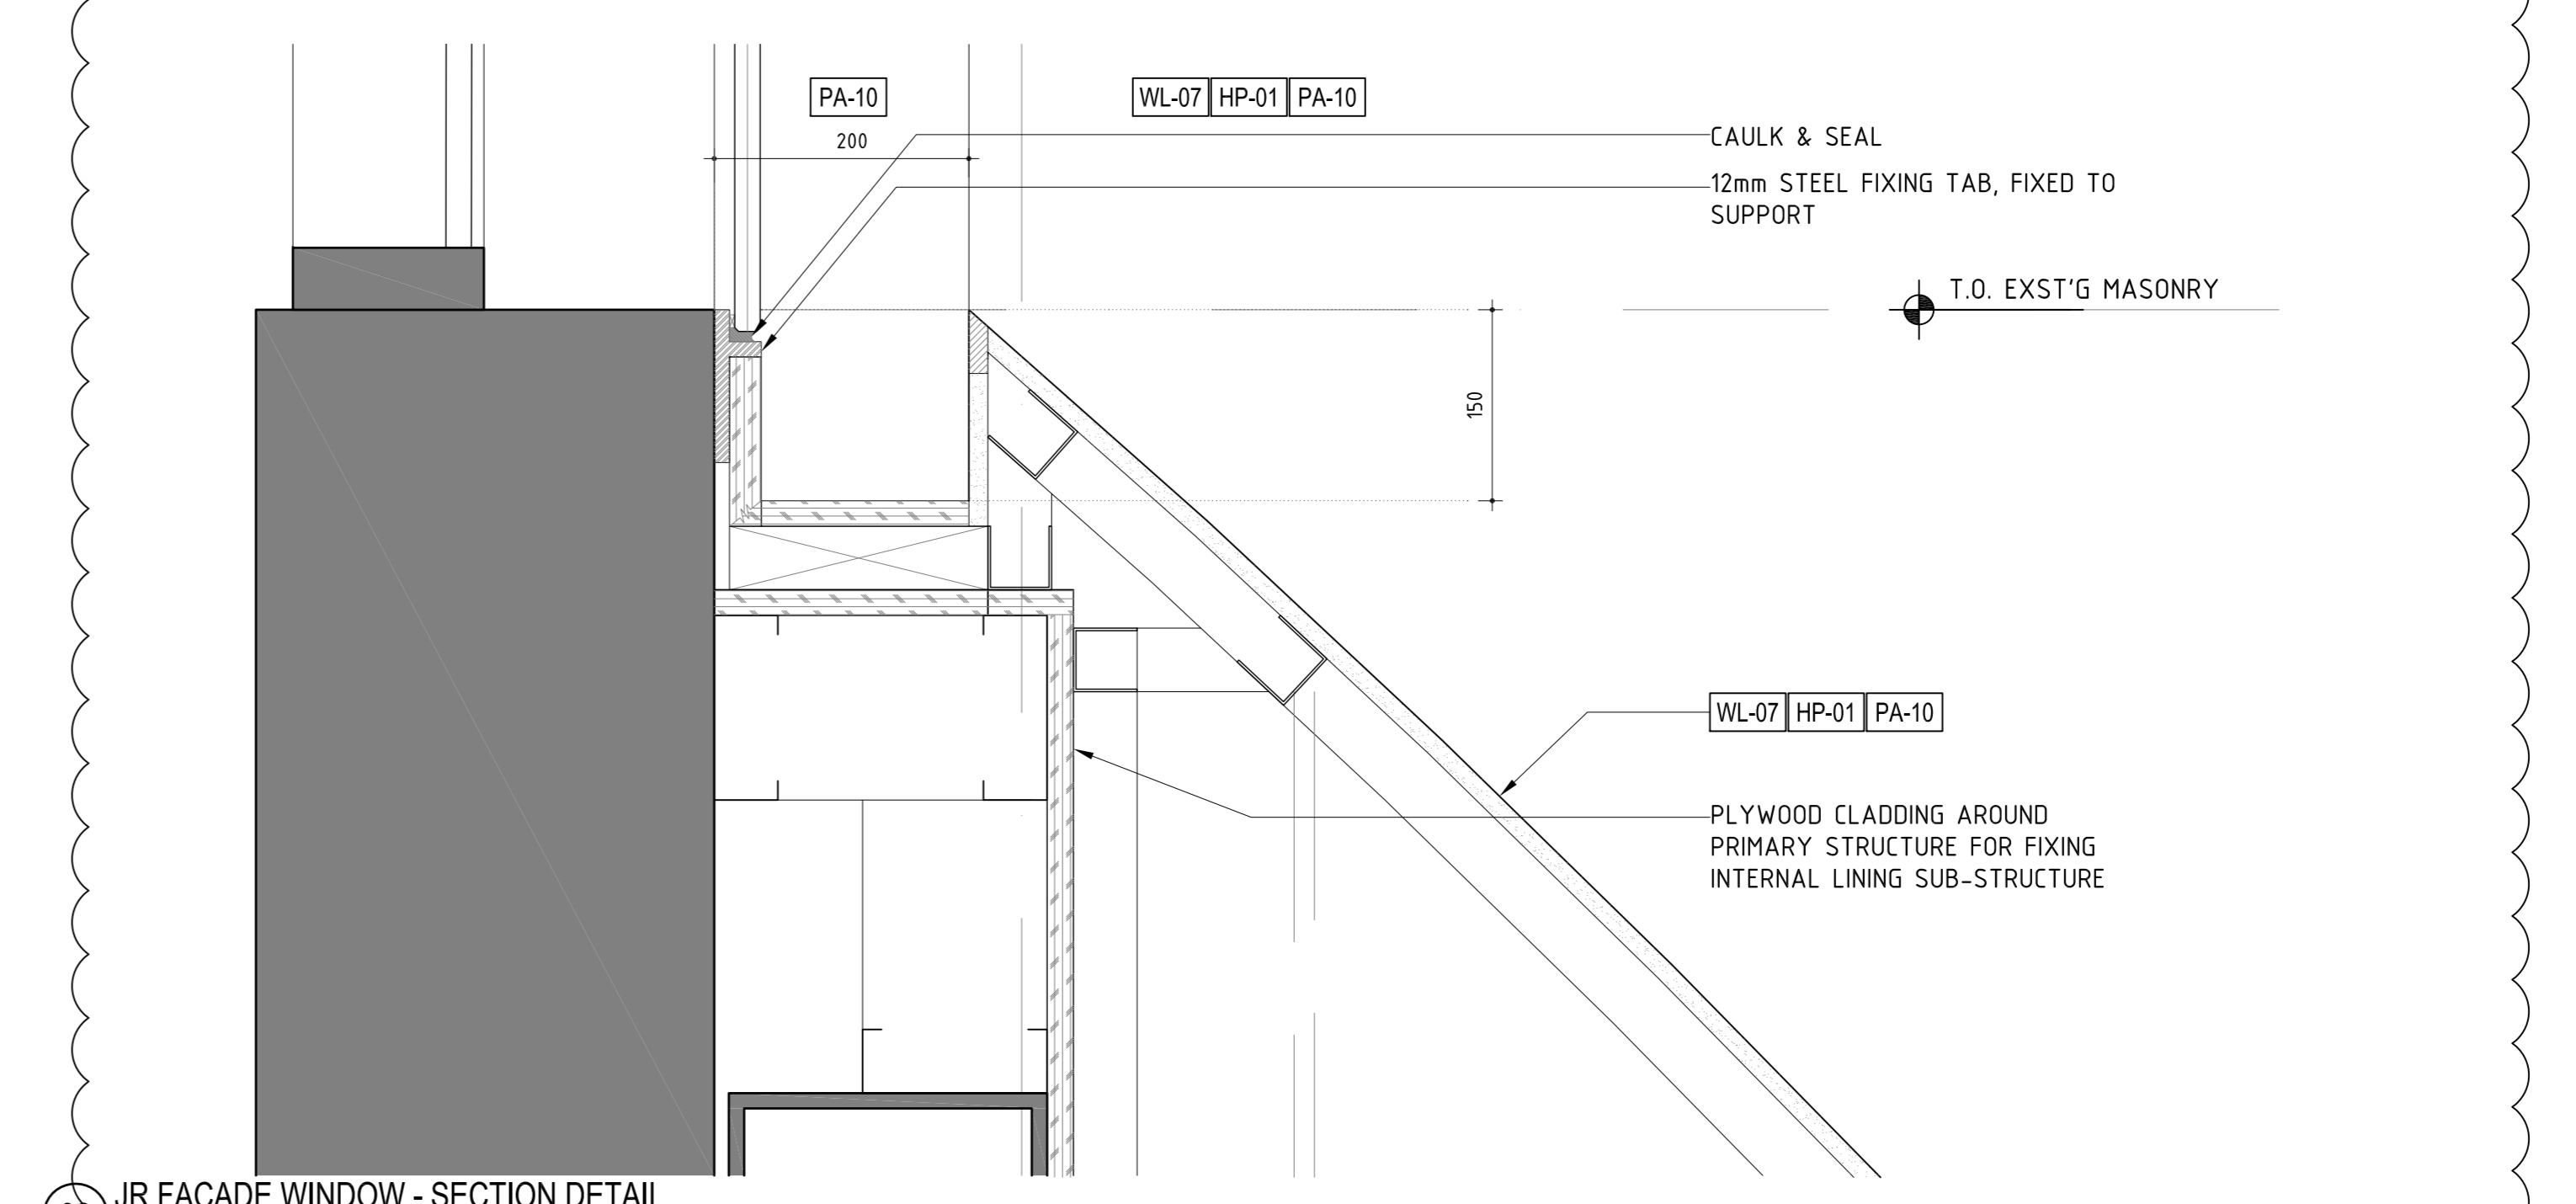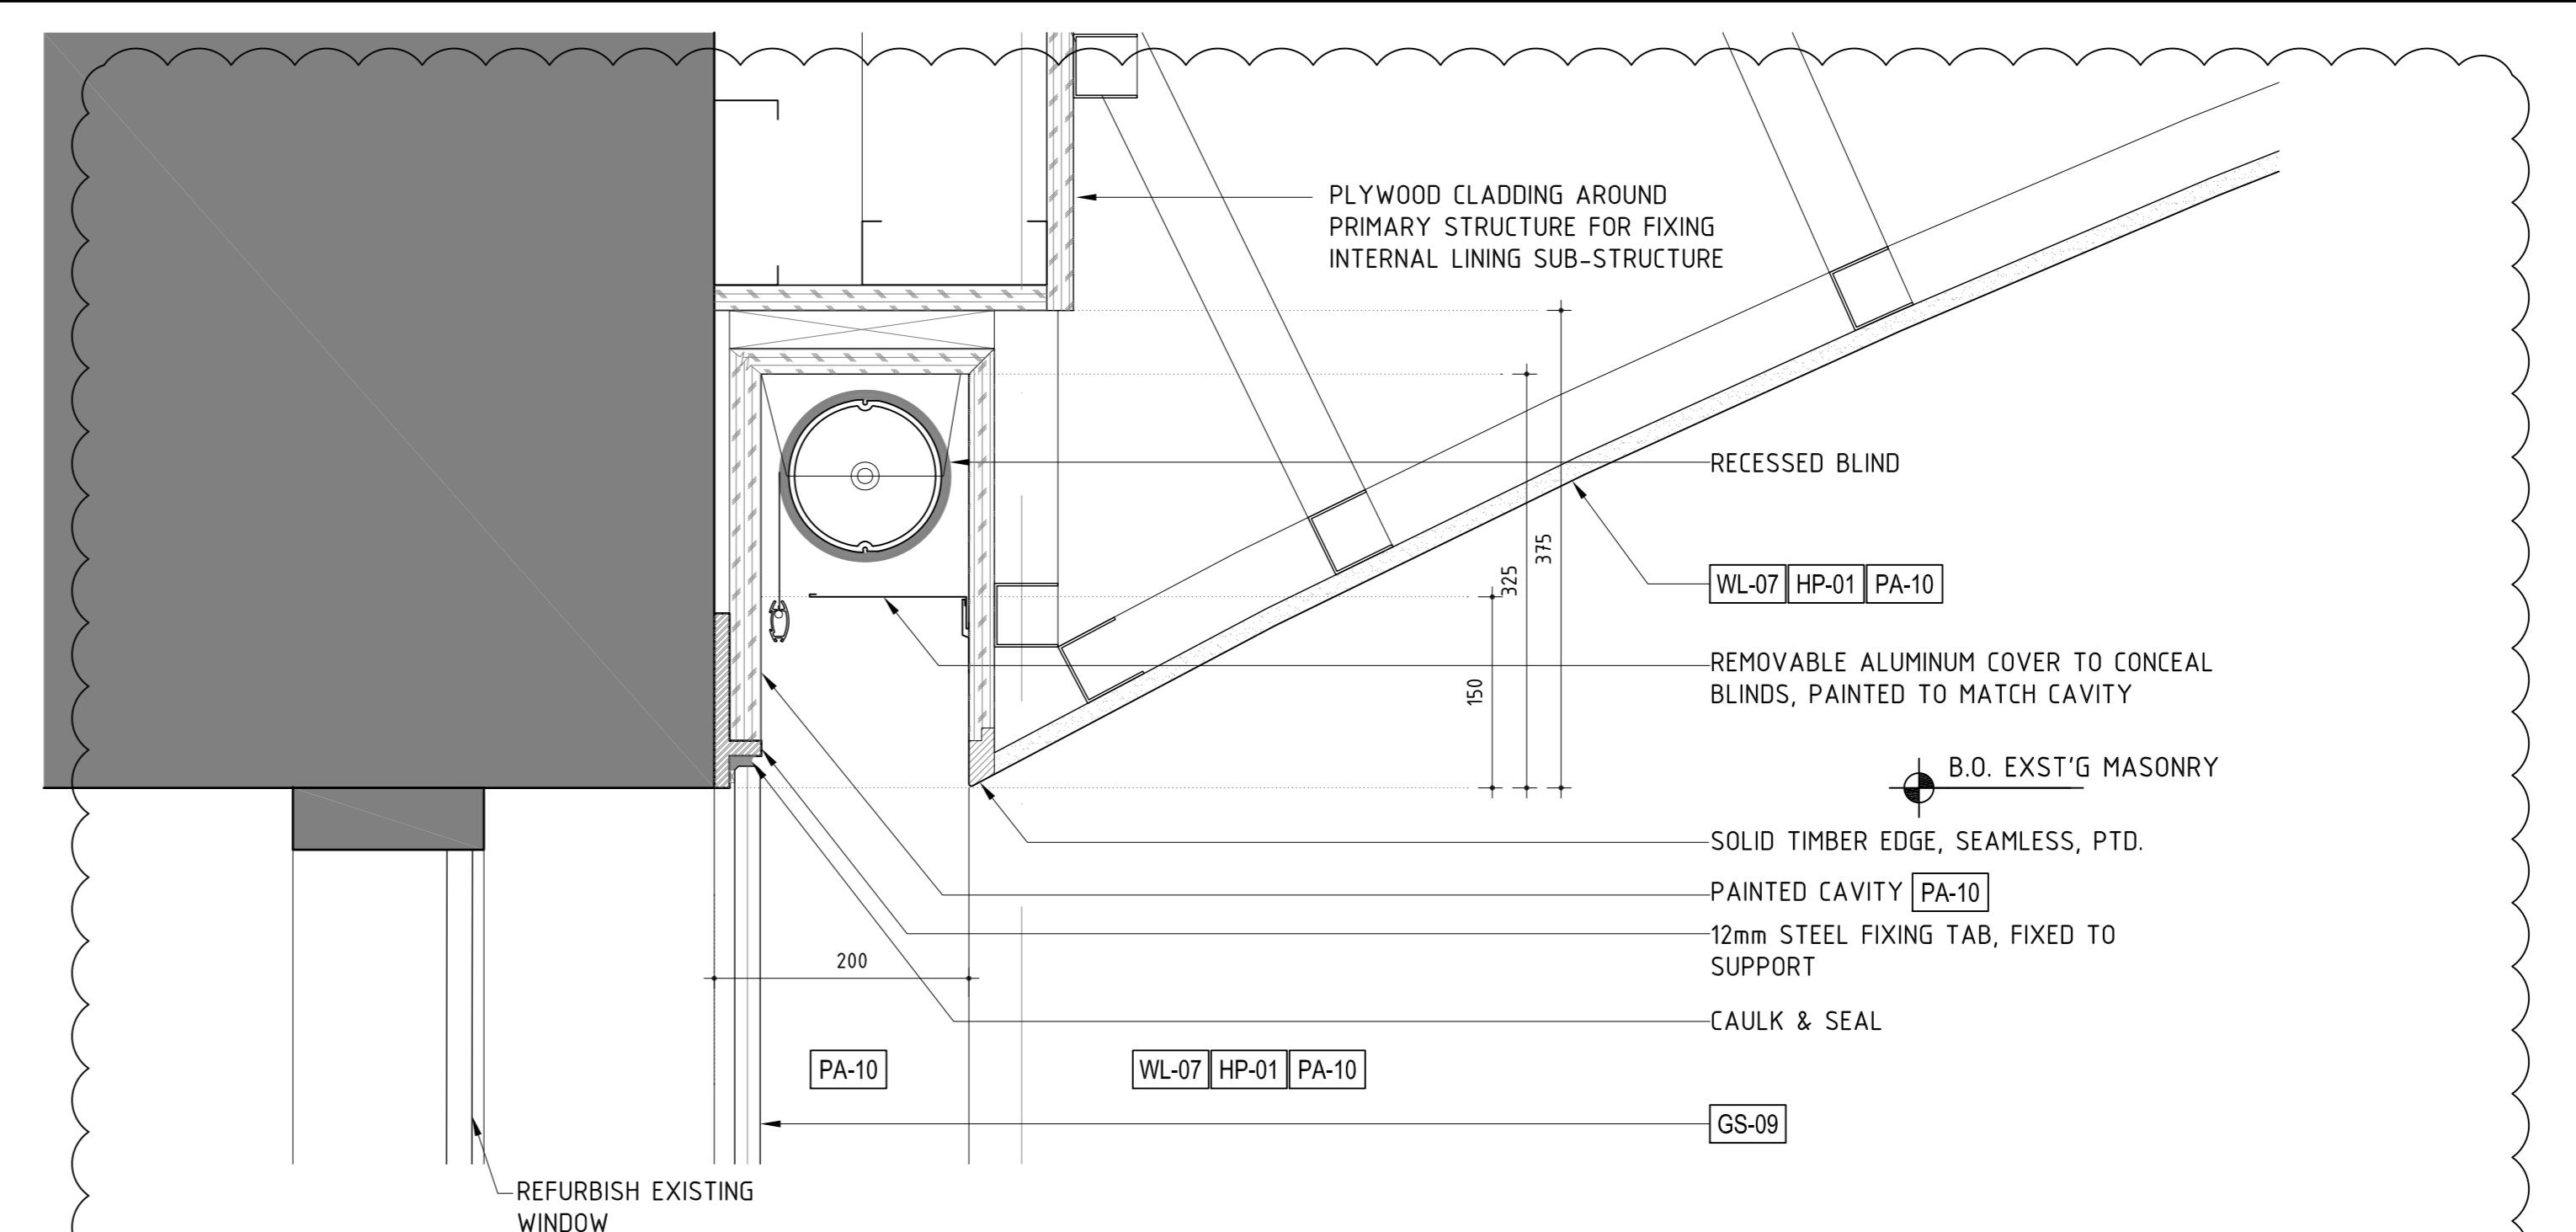

06 JR FACADE WINDOW - SECTION DETAIL SCALE 1:5

05 JR FACADE WINDOW - PLAN DETAIL SCALE 1:5

04 JR FACADE WINDOW - SECTION DETAIL SCALE 1:5

03 JR FACADE WINDOW - PLAN DETAIL SCALE 1:5

02 JR FACADE WINDOW - SECTION DETAIL SCALE 1:5

01 JR FACADE WINDOW - PLAN DETAIL SCALE 1:5