



CONTRACTORS SHALL VERIFY ALL DIMENSIONS BEFORE ANY JOB COMMENCES. ALL SHOP DRAWINGS SHALL BE SUBMITTED TO THE SUPERINTENDENT AND MANUFACTURE SHALL NOT COMMENCE PRIOR TO THE RETURN OF DIMENSIONED SHOP DRAWINGS SIGNED BY THE CONSULTANT. DIMENSIONS SHALL TAKE PRECEDENCE OVER SCALES. THIS DRAWING SHOULD BE READ IN CONJUNCTION WITH ALL RELEVANT CONTRACT SPECIFICATIONS AND DRAWINGS COPYRIGHT OF THIS DRAWING IS VESTED IN WARDLE.

General Notes

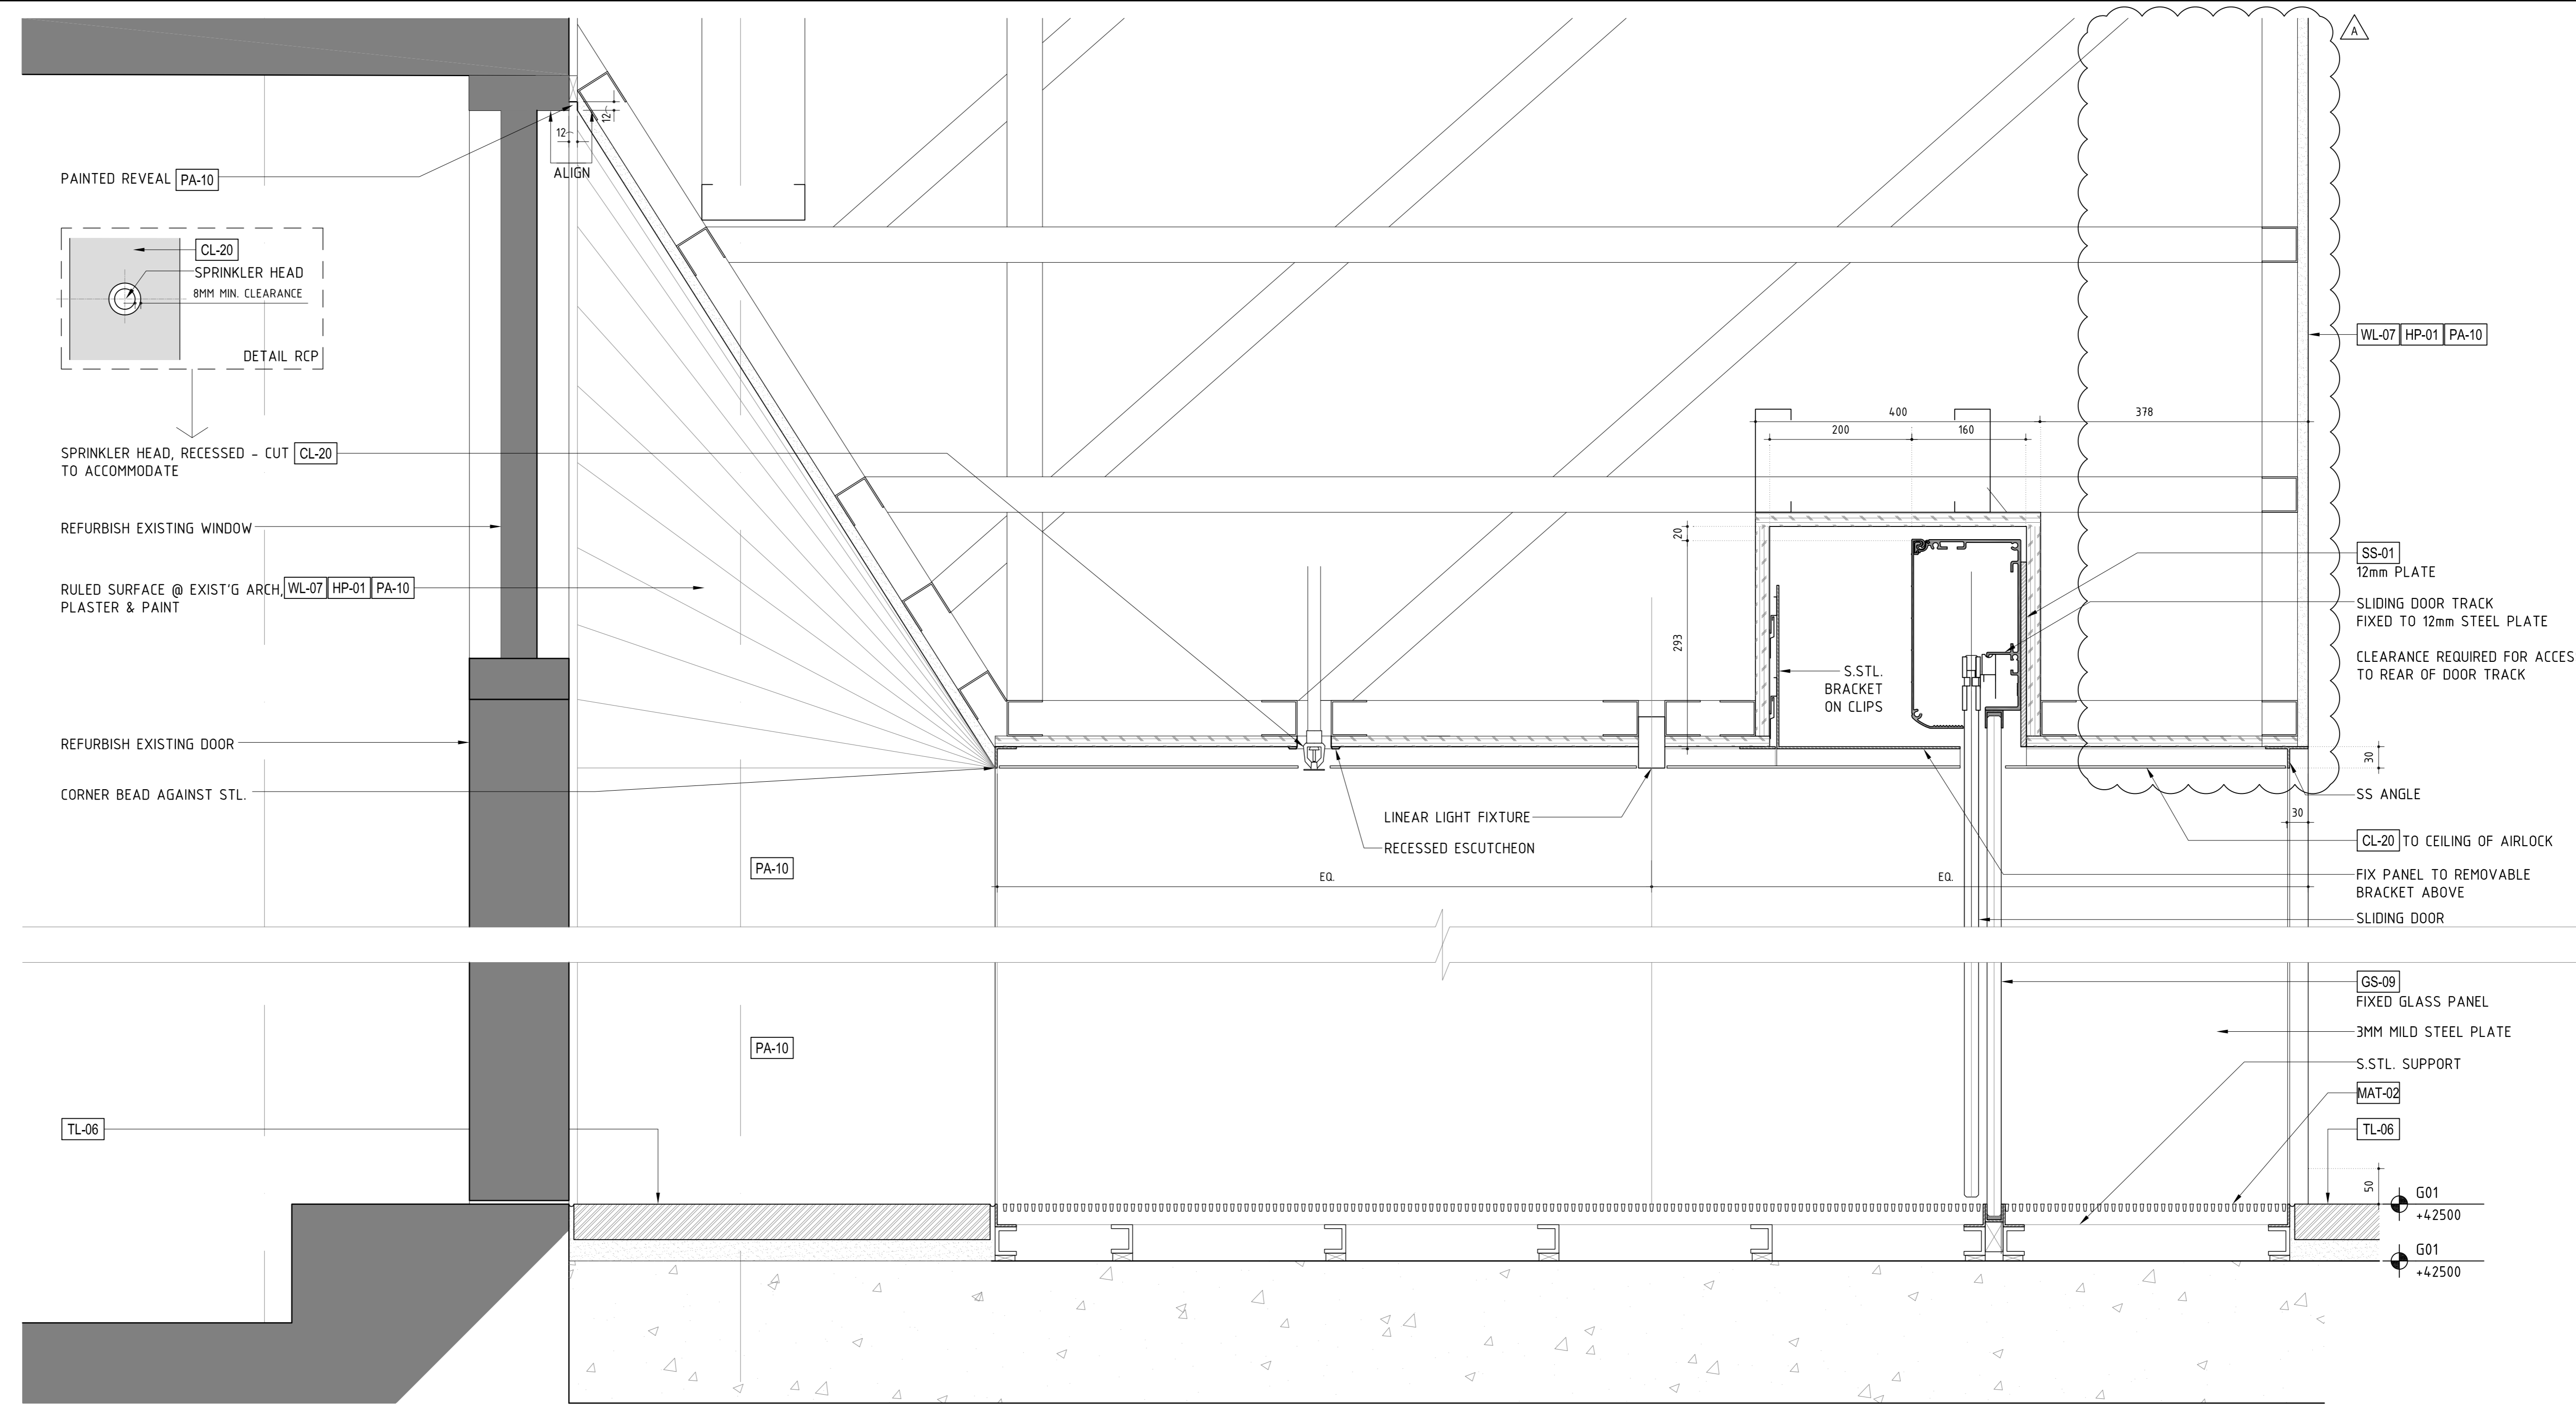


02 JR FACADE ENTRY - SECTION DETAIL
SCALE 1:5

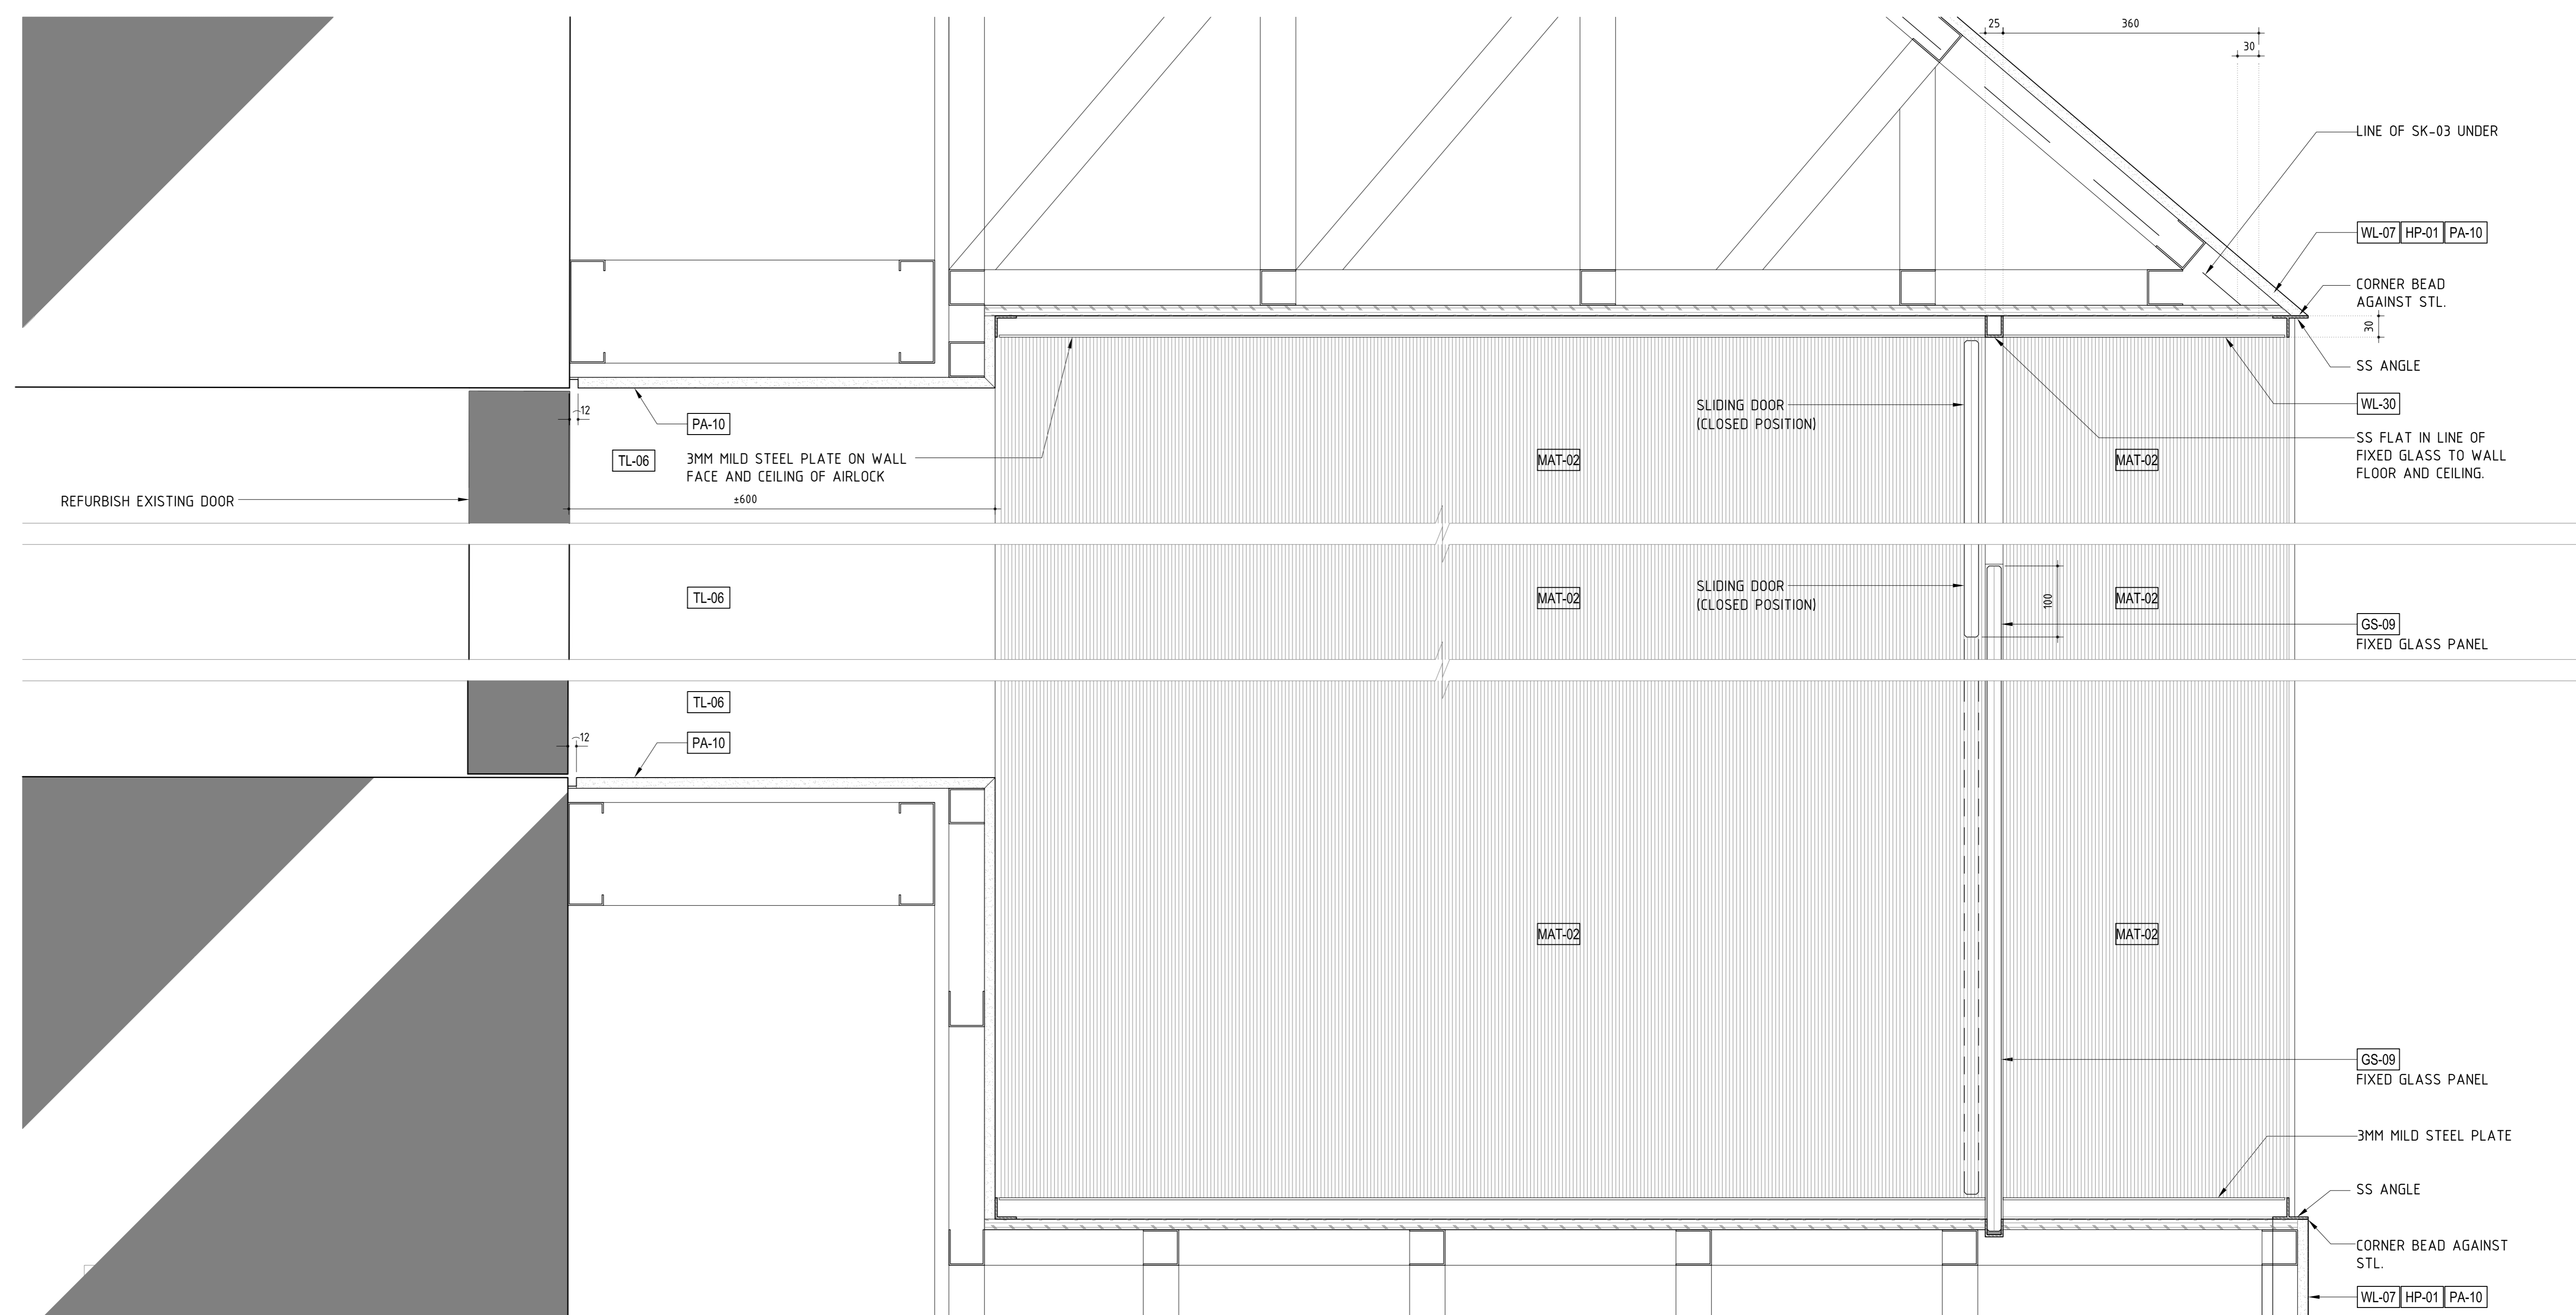

01 JR FACADE ENTRY - PLAN DETAIL
SCALE 1:5

Rev	Issue	Revision Description	Amtd	Date
A	SG	FOR CONSTRUCTION	-	09.12.13
04	SG	VALUE MANAGEMENT ISSUE	-	28.03.13
03	JC	100% CD - TENDER ISSUE	-	07.09.12
02	JC	90% CD ISSUE	-	10.08.12
01	JC	75% CD ISSUE	-	13.07.12

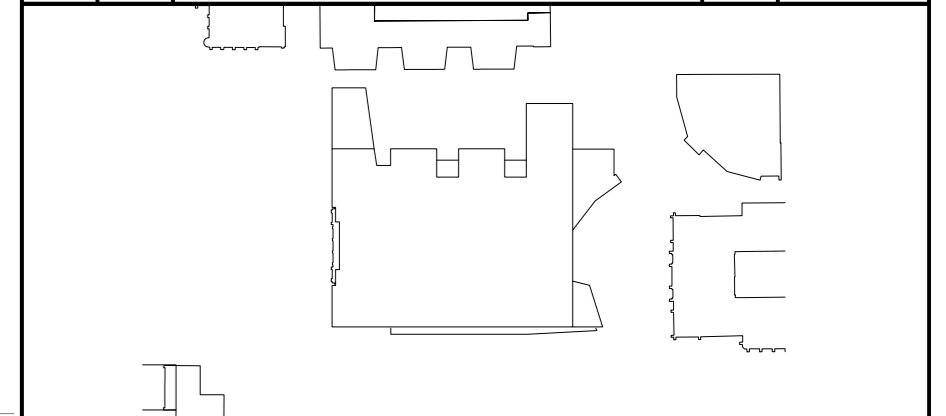

NADAAA
 NADAAA
 1520 Washington Street No.2
 Boston Massachusetts 02118 USA
 Telephone +1 617 442 6232
 Facsimile +1 604 442 1417
 Email nadaaa@nadaaa.com

John Wardle Architects
 © 2011 John Wardle Architects
 Level 10, 180 Russell Street, Melbourne Victoria 3000 Australia
 Tel : +613 9654 8700 www.johnwardlearchitects.com

Client **University of Melbourne Parkville Campus**
 Project **Faculty of Architecture Building and Planning**
 Title **JOSEPH REED FACADE DETAILS**

Project No.	0913	Scale	1:5 @ A0
Drawing No.	AR5166	Revision	A
Daily DEC 2013	Dwn	Co-Ord	Chk

FILENAME: #####
FOR CONSTRUCTION