



THIS DRAWING IS AN UNCONTROLLED COPY UNLESS STAMPED OTHERWISE

CONTRACTORS SHALL VERIFY ALL DIMENSIONS BEFORE ANY JOB COMMENCES. ALL SHOP DRAWINGS SHALL BE SUBMITTED TO THE SUPERINTENDENT AND MANUFACTURE SHALL NOT COMMENCE PRIOR TO THE RETURN OF APPROVED SHOP DRAWINGS SIGNED BY THE CONSULTANT. DIMENSIONS SHALL TAKE PRECEDENCE OVER SCALES. THIS DRAWING SHOULD BE READ IN CONJUNCTION WITH ALL RELEVANT CONTRACT SPECIFICATIONS AND DRAWINGS COPYRIGHT OF THIS DRAWING IS HELD IN WAIVER.


General Notes

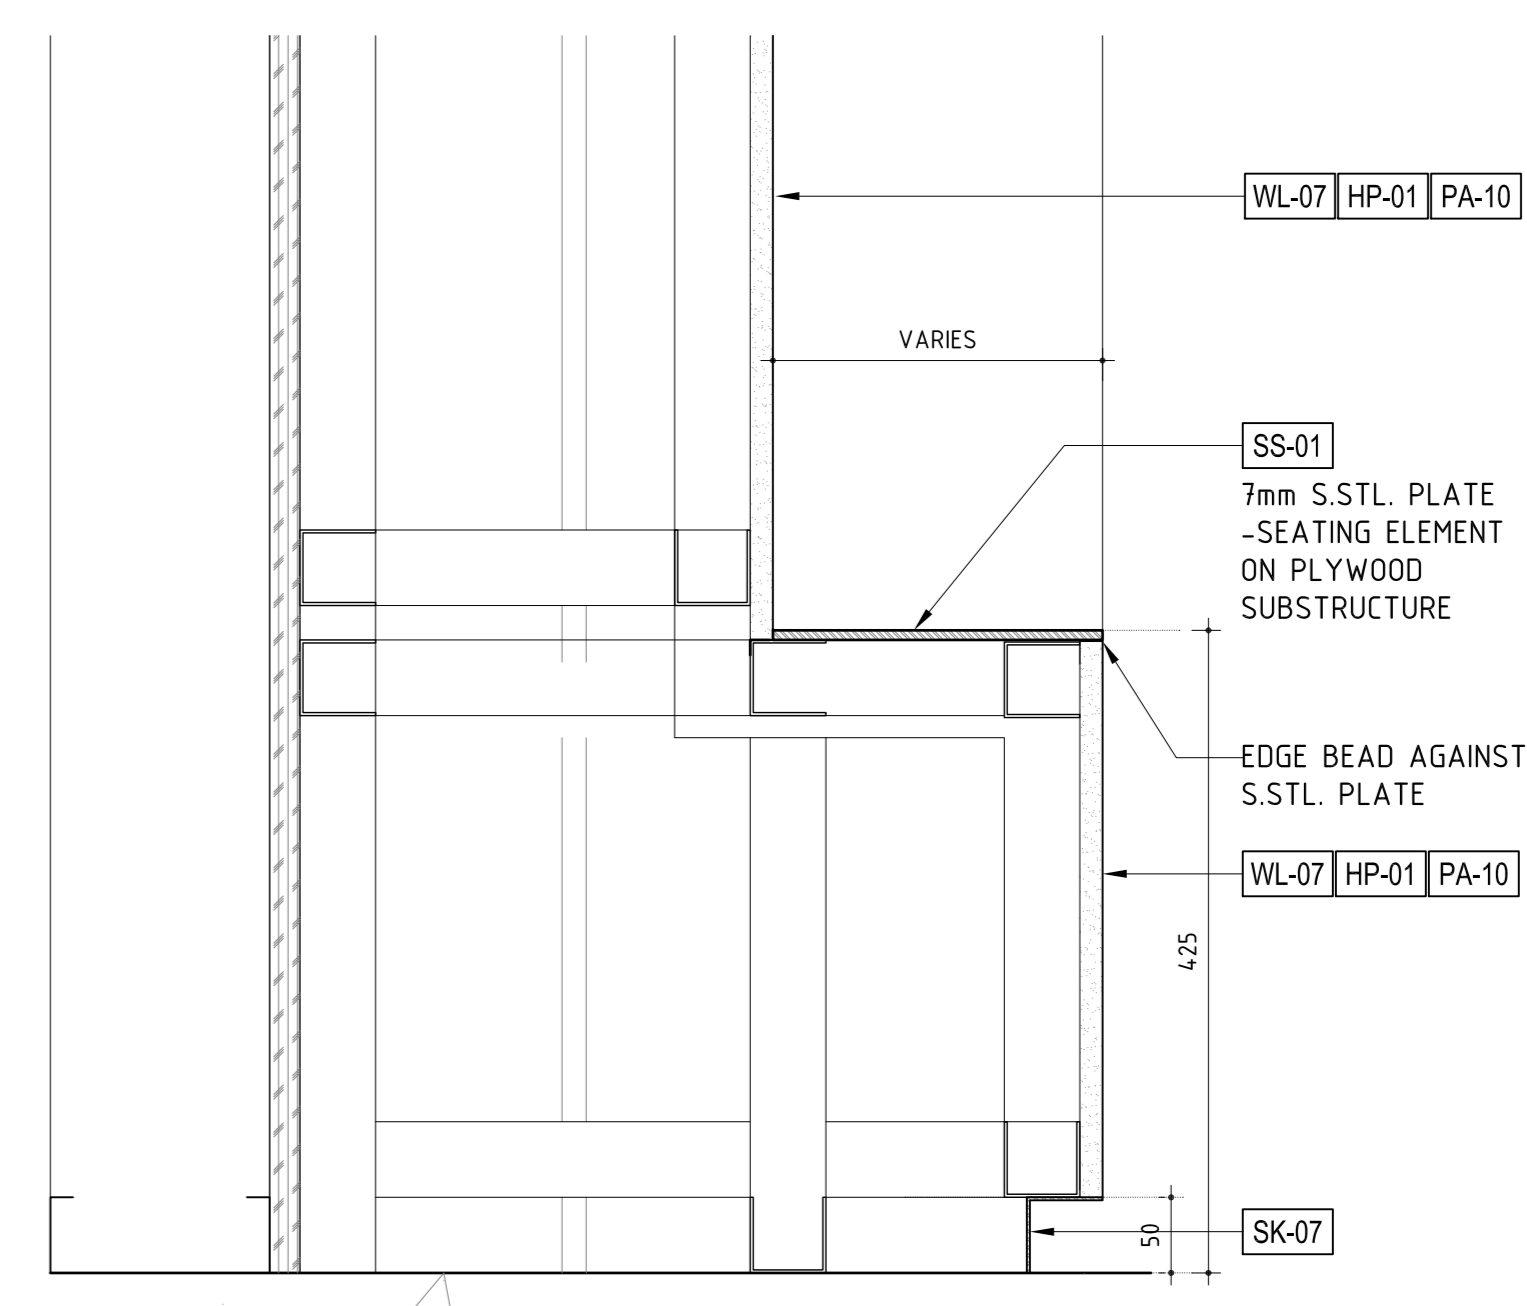

09 JR LOBBY - SECTION DETAIL
SCALE 1:5

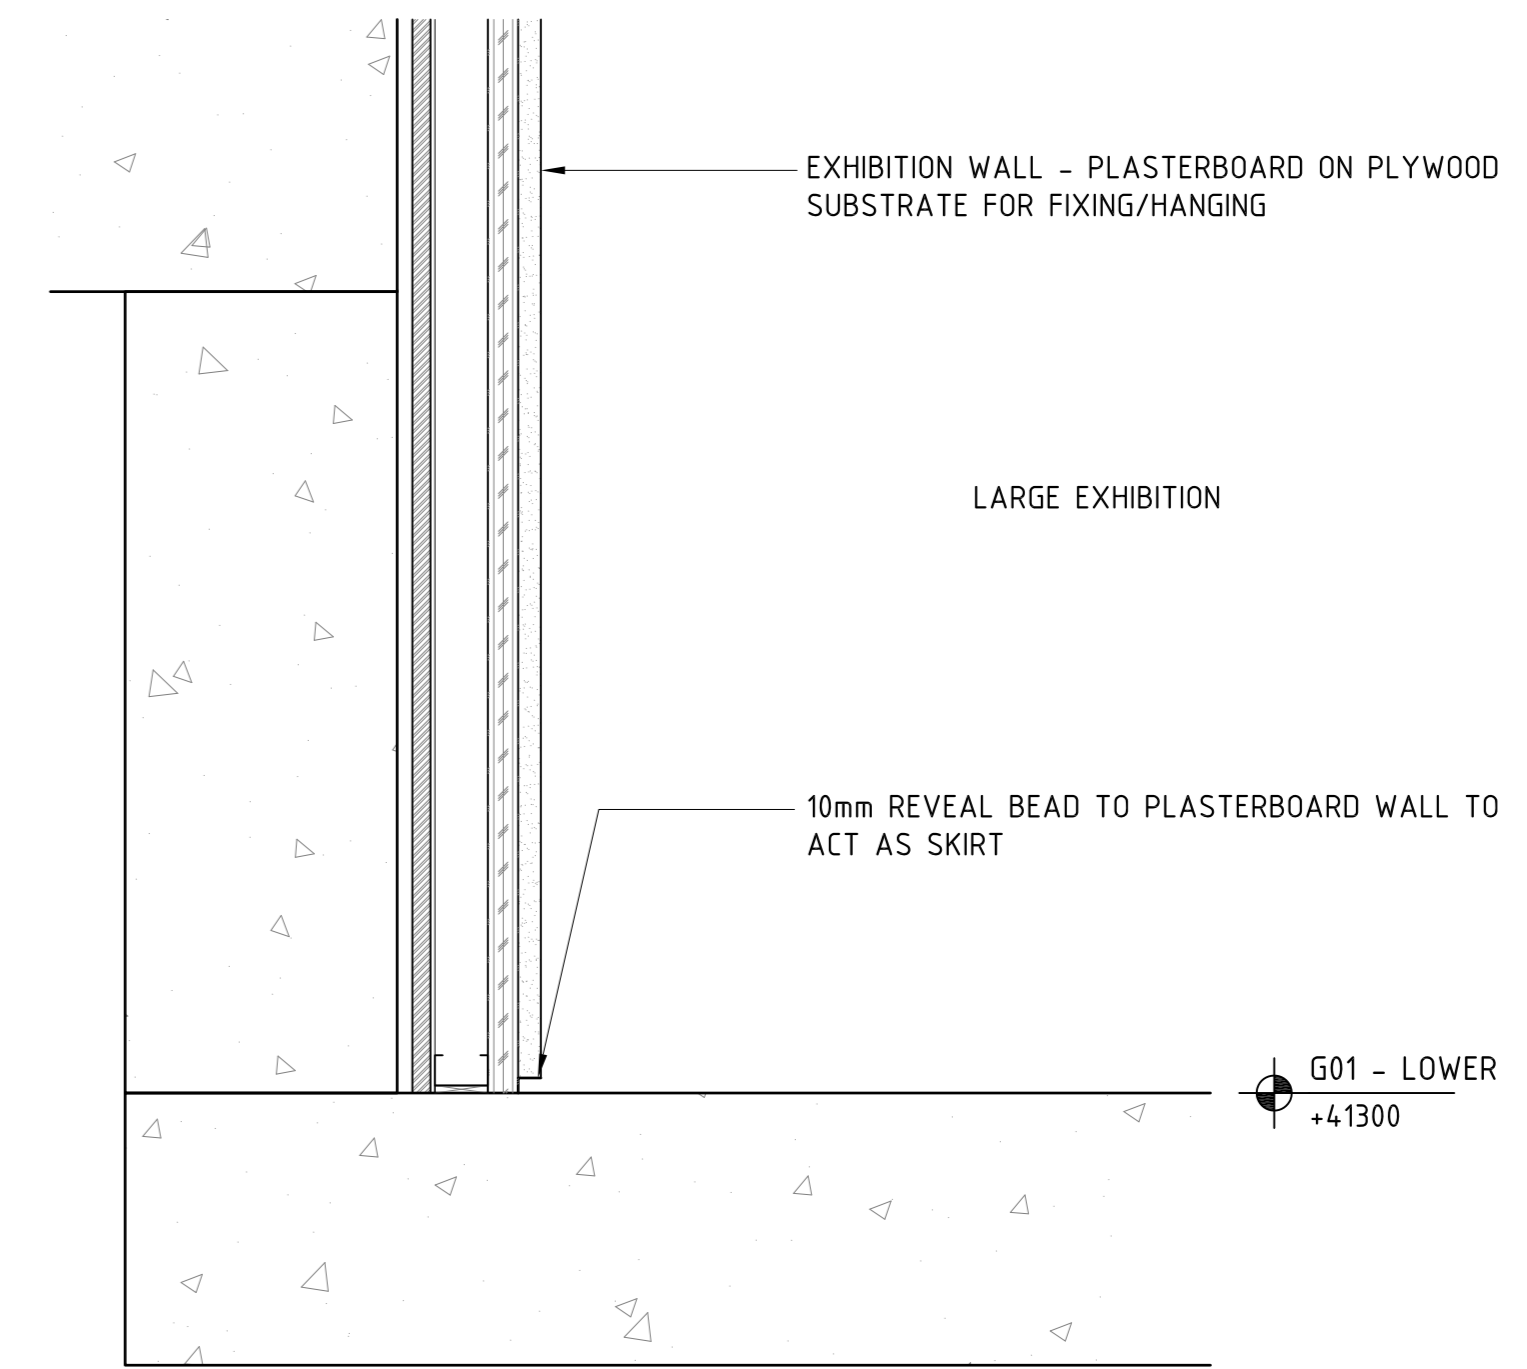


08 LARGE EXHIBITION - SECTION DETAIL
SCALE 1:5

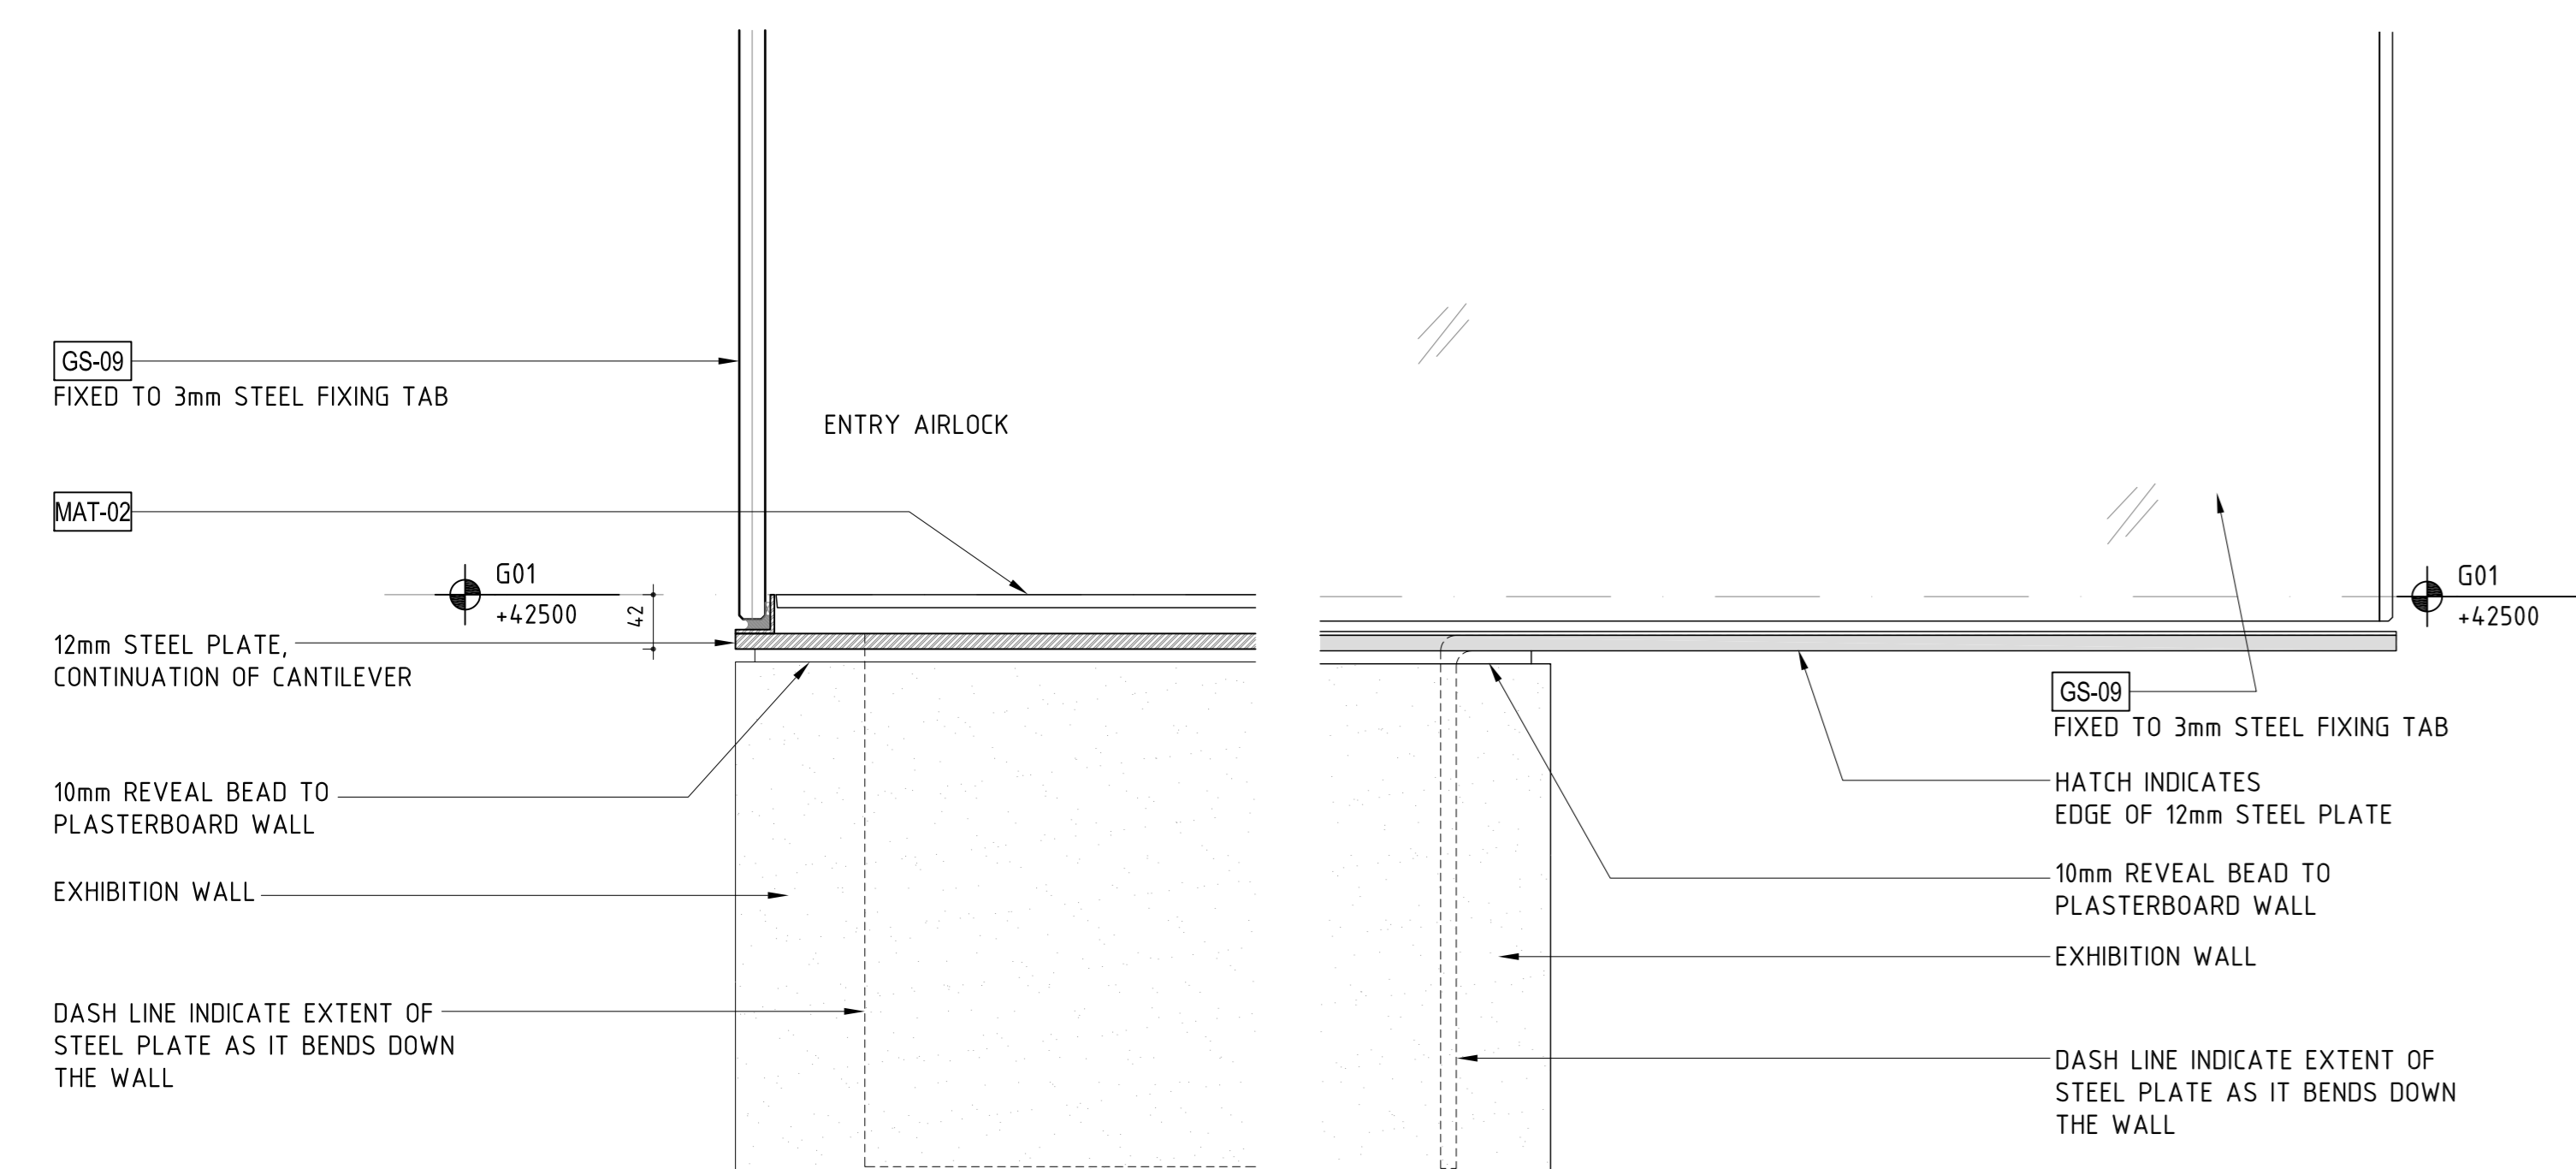


07 JR ENTRY - SECTION DETAIL
SCALE 1:5


06 JR LOBBY - ELEVATION DETAIL
SCALE 1:5

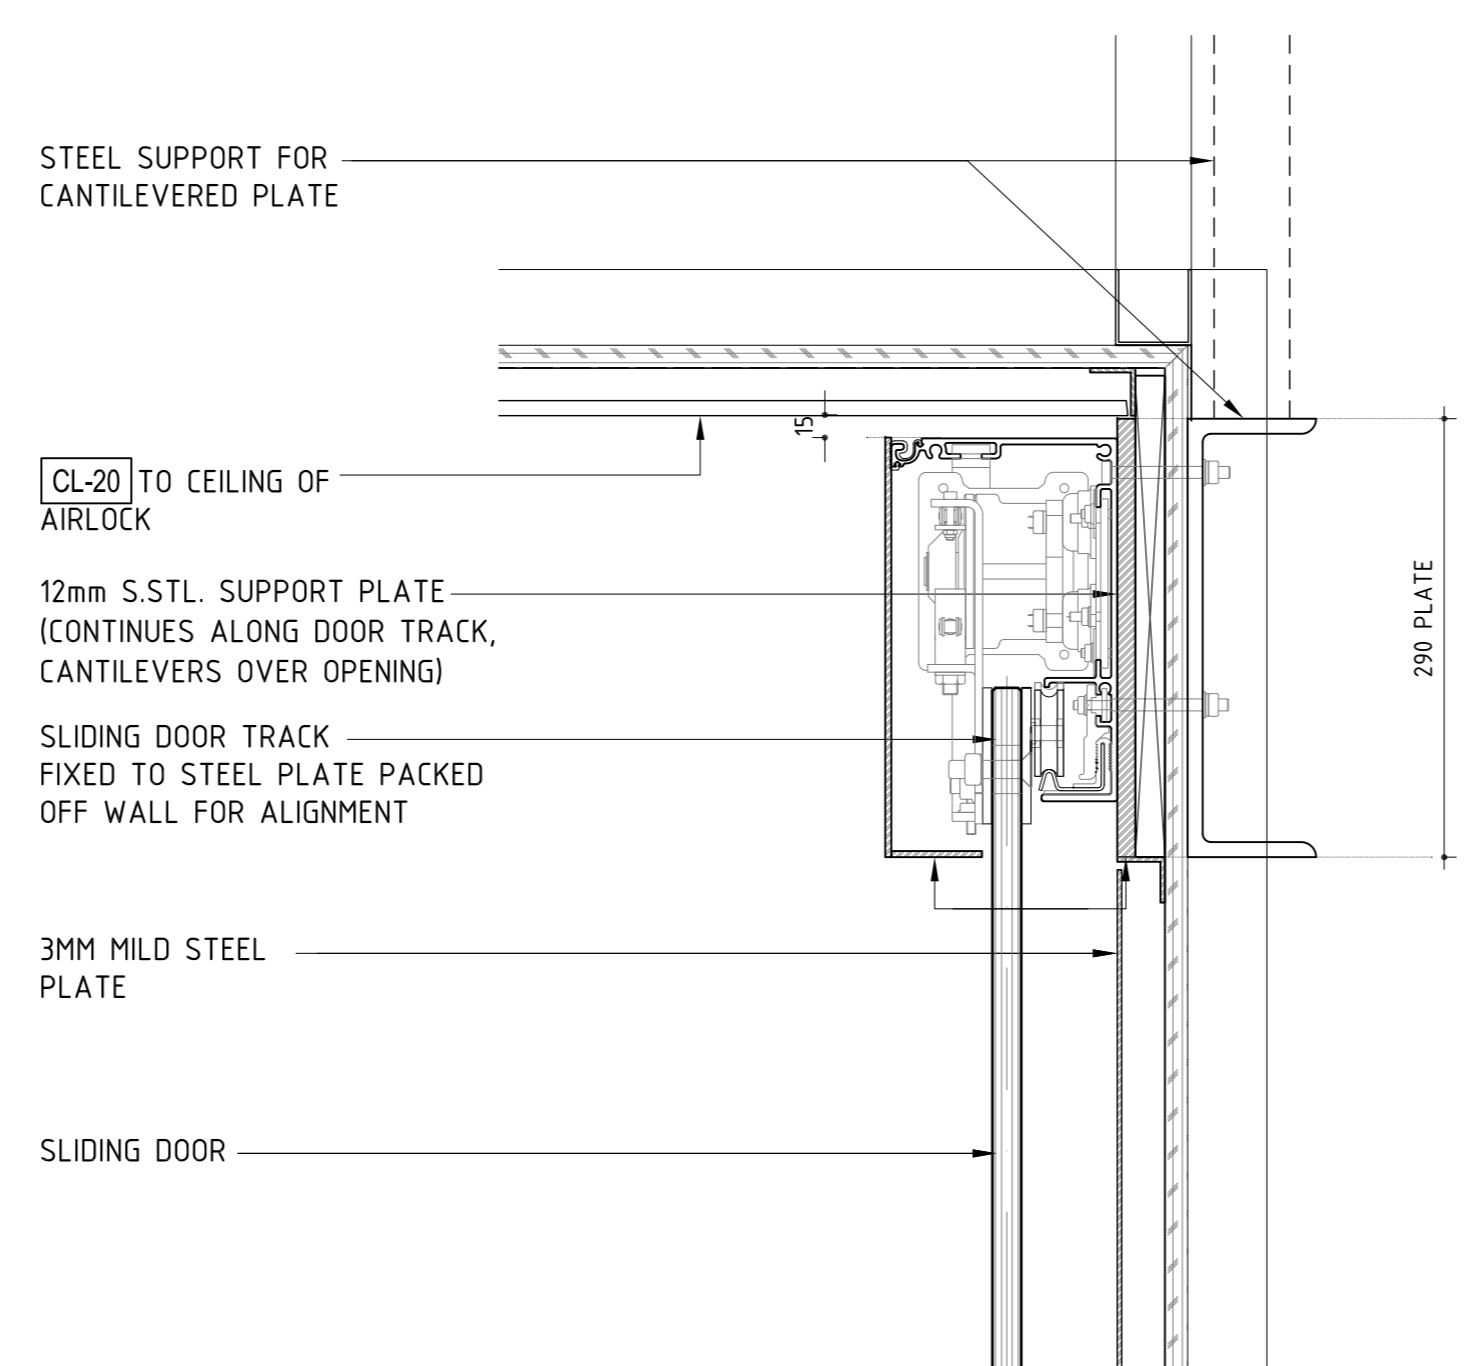


03 JR ENTRY - SECTION DETAIL
SCALE 1:5

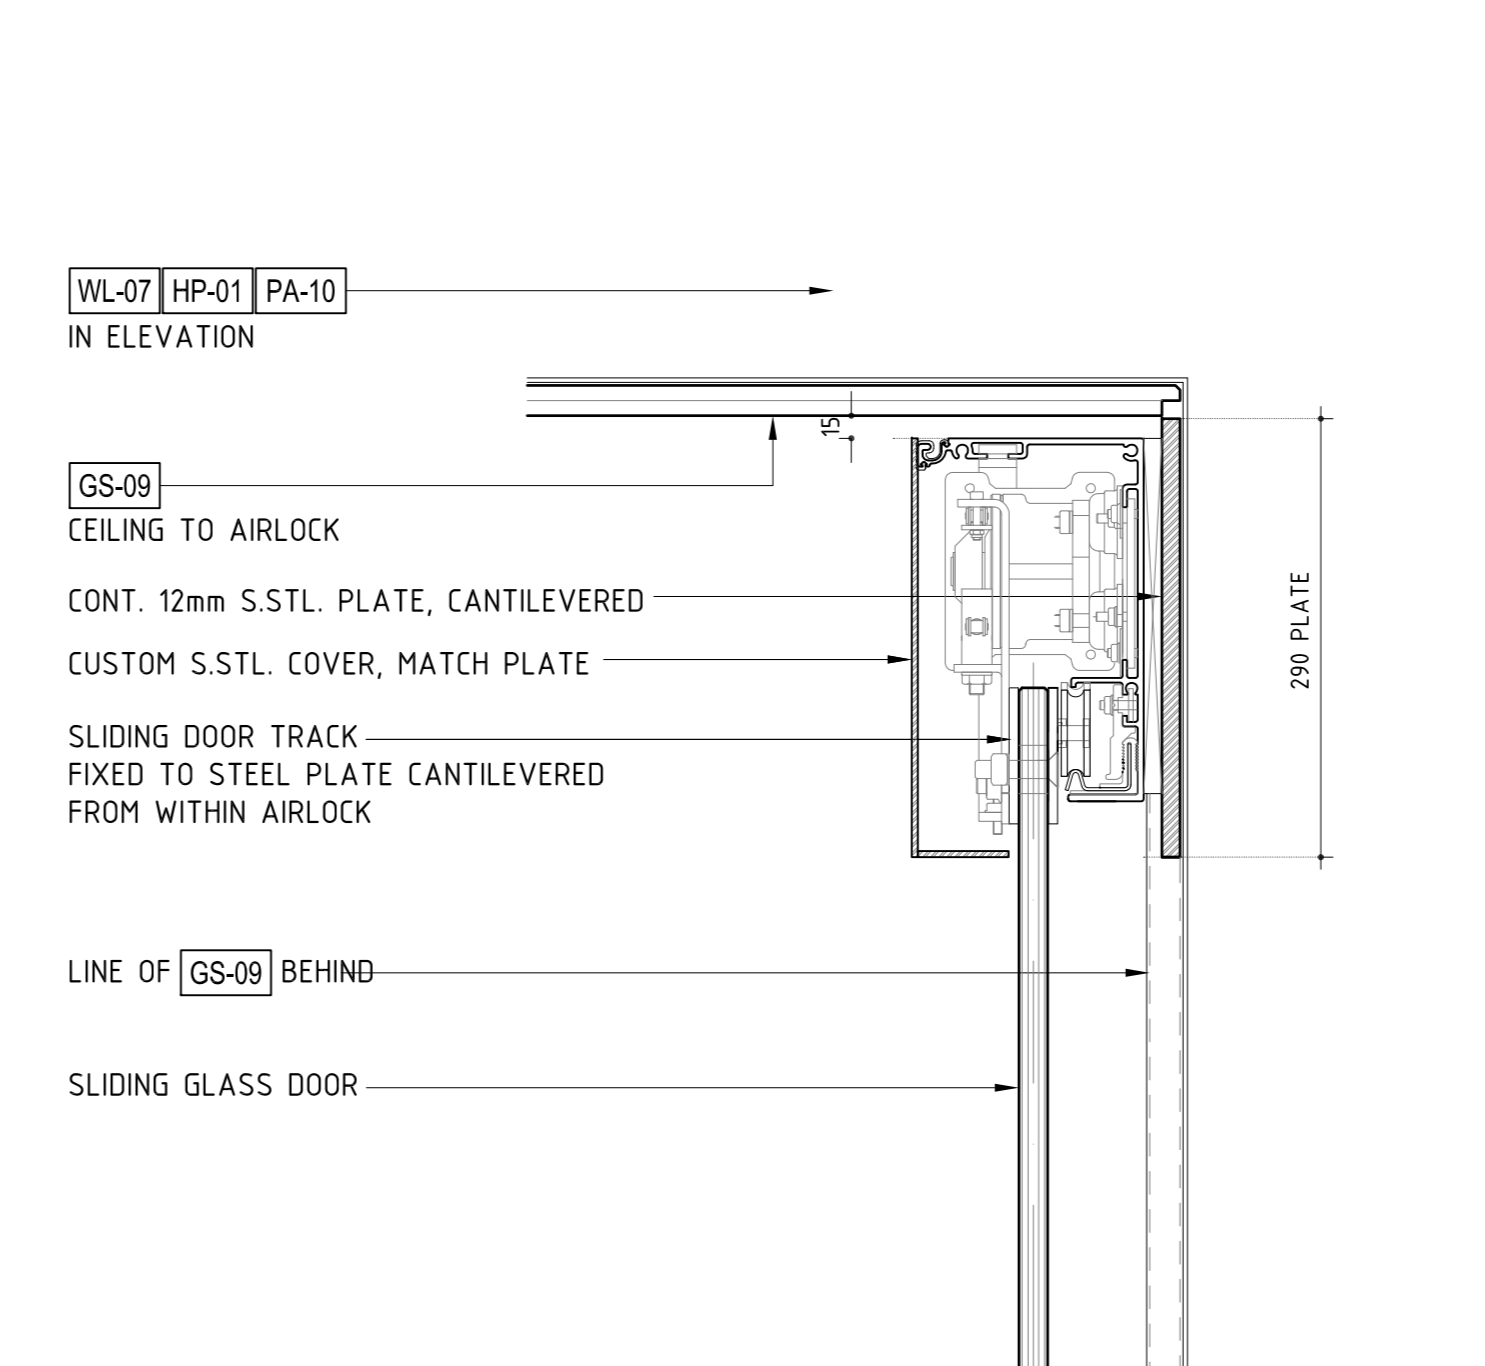

02 JR ENTRY - SECTION DETAIL
SCALE 1:5

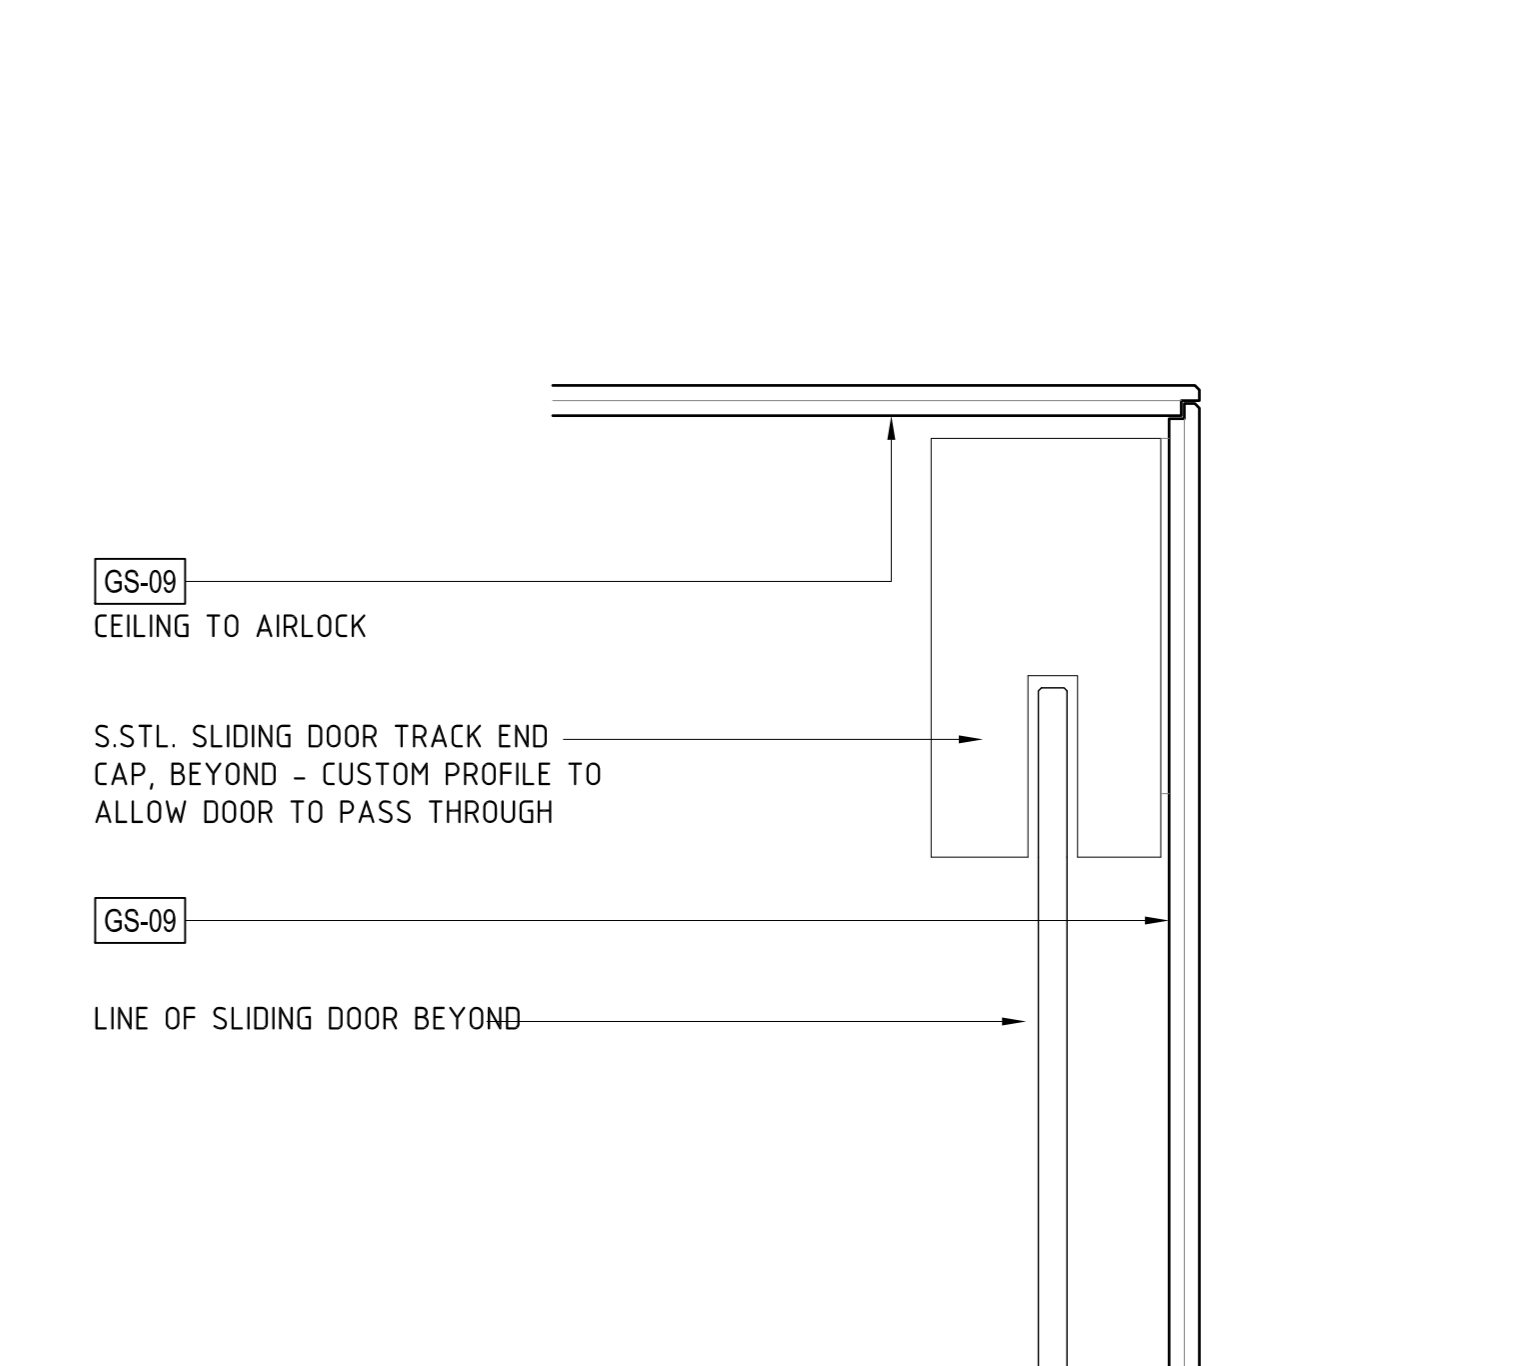


01 JR ENTRY - SECTION DETAIL
SCALE 1:5

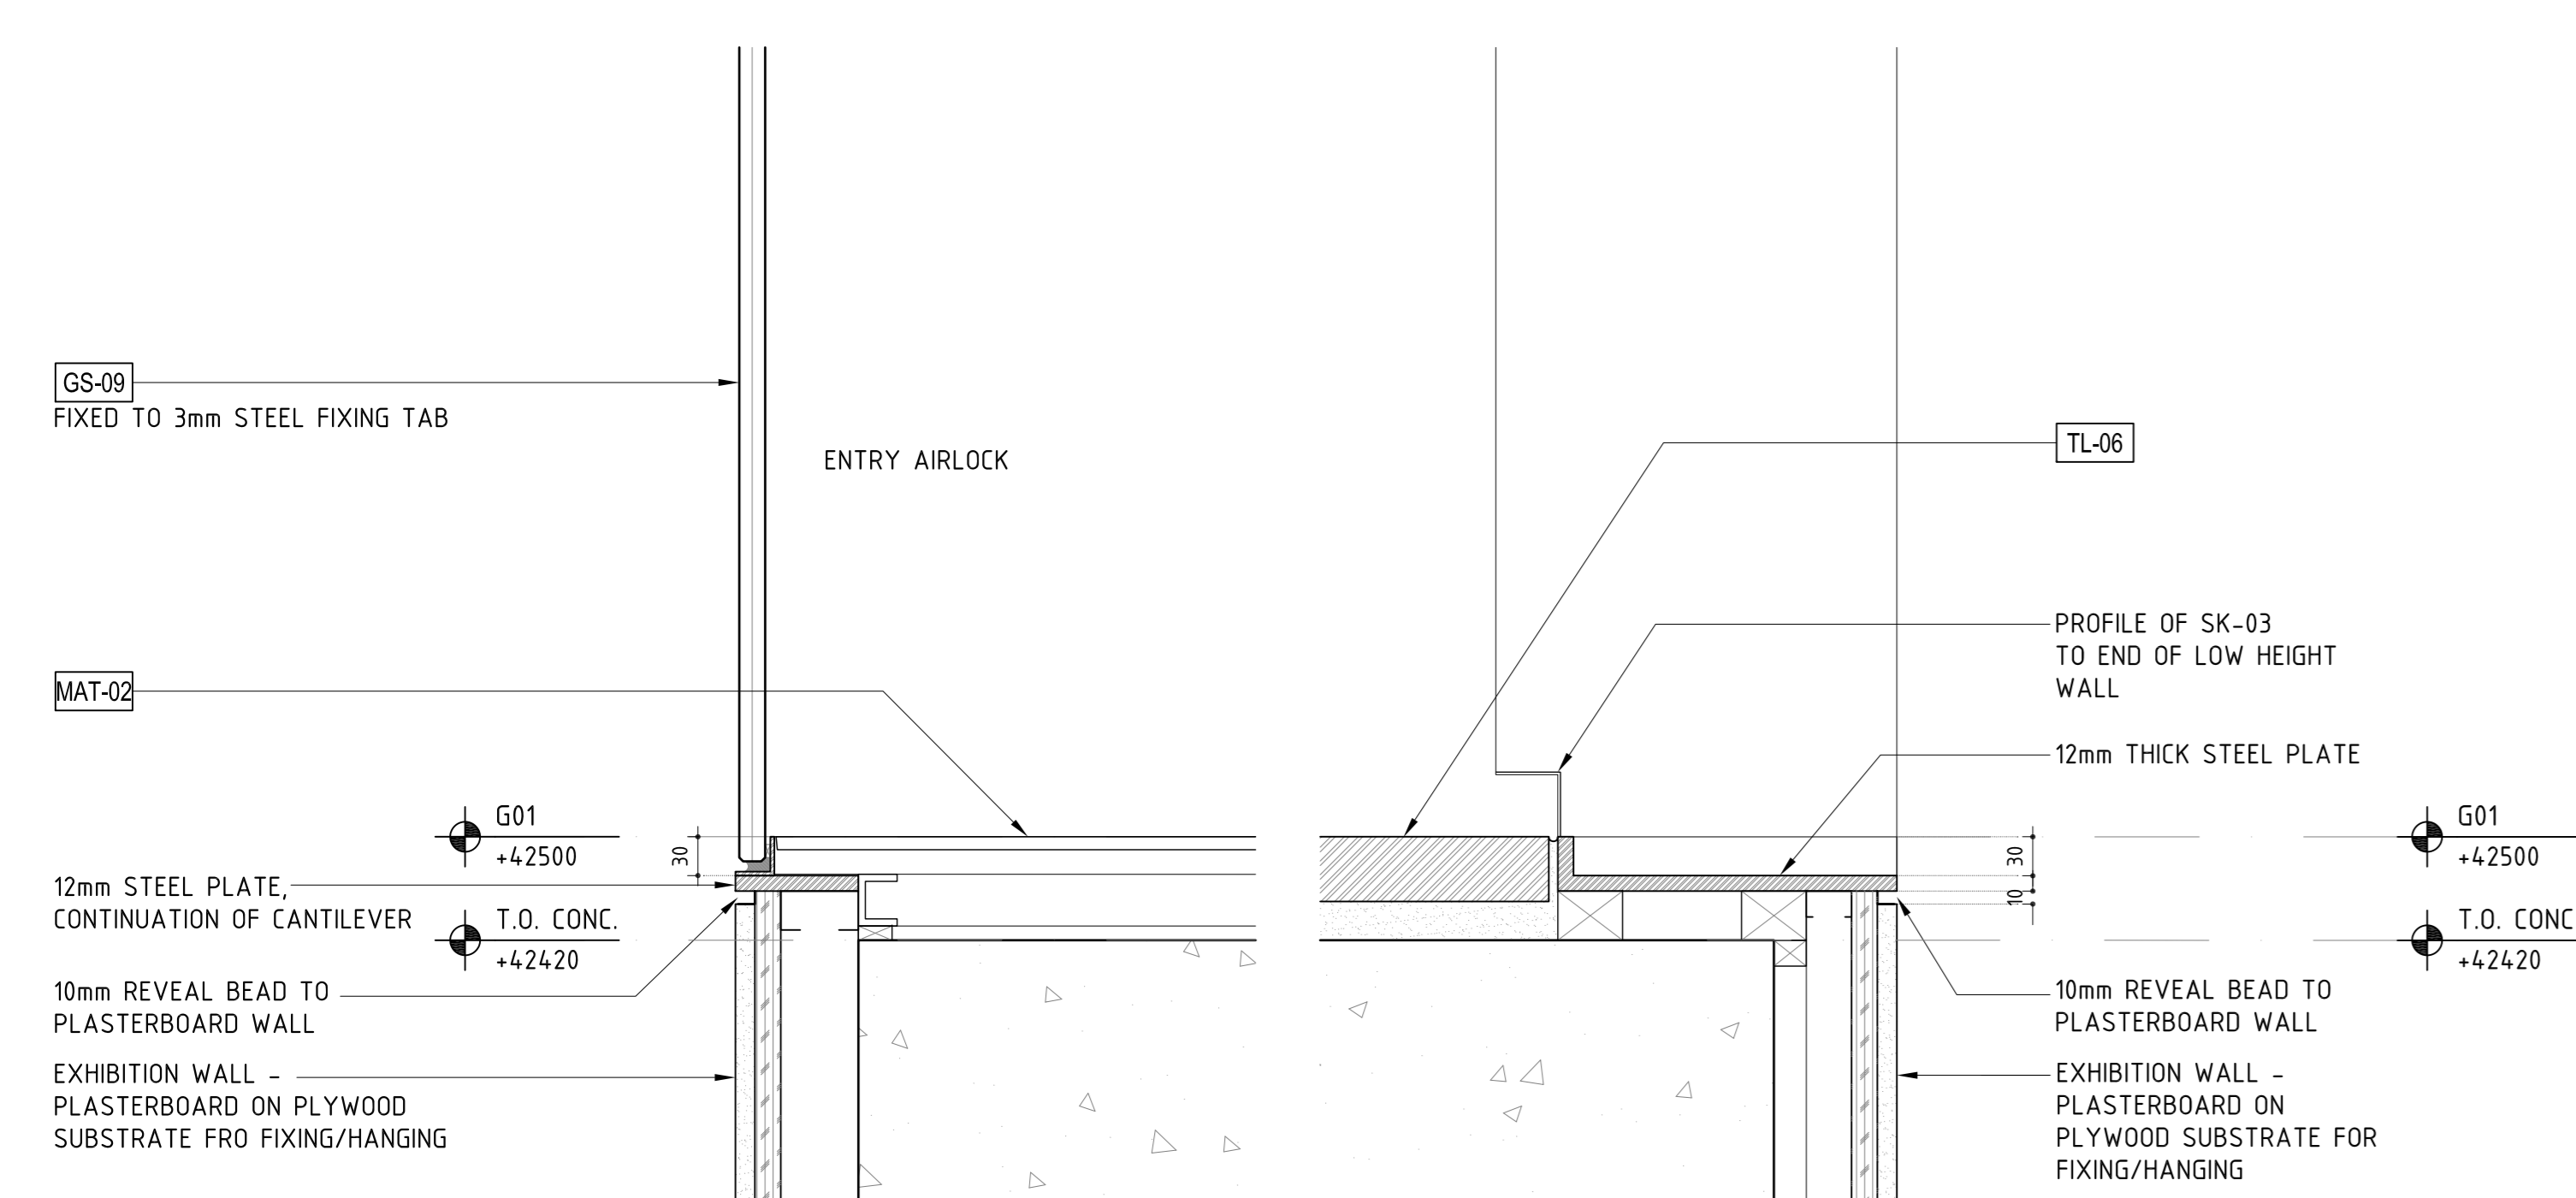


05 JR ENTRY - SECTION DETAIL
SCALE 1:5


04 JR LOBBY - SECTION DETAIL
SCALE 1:5

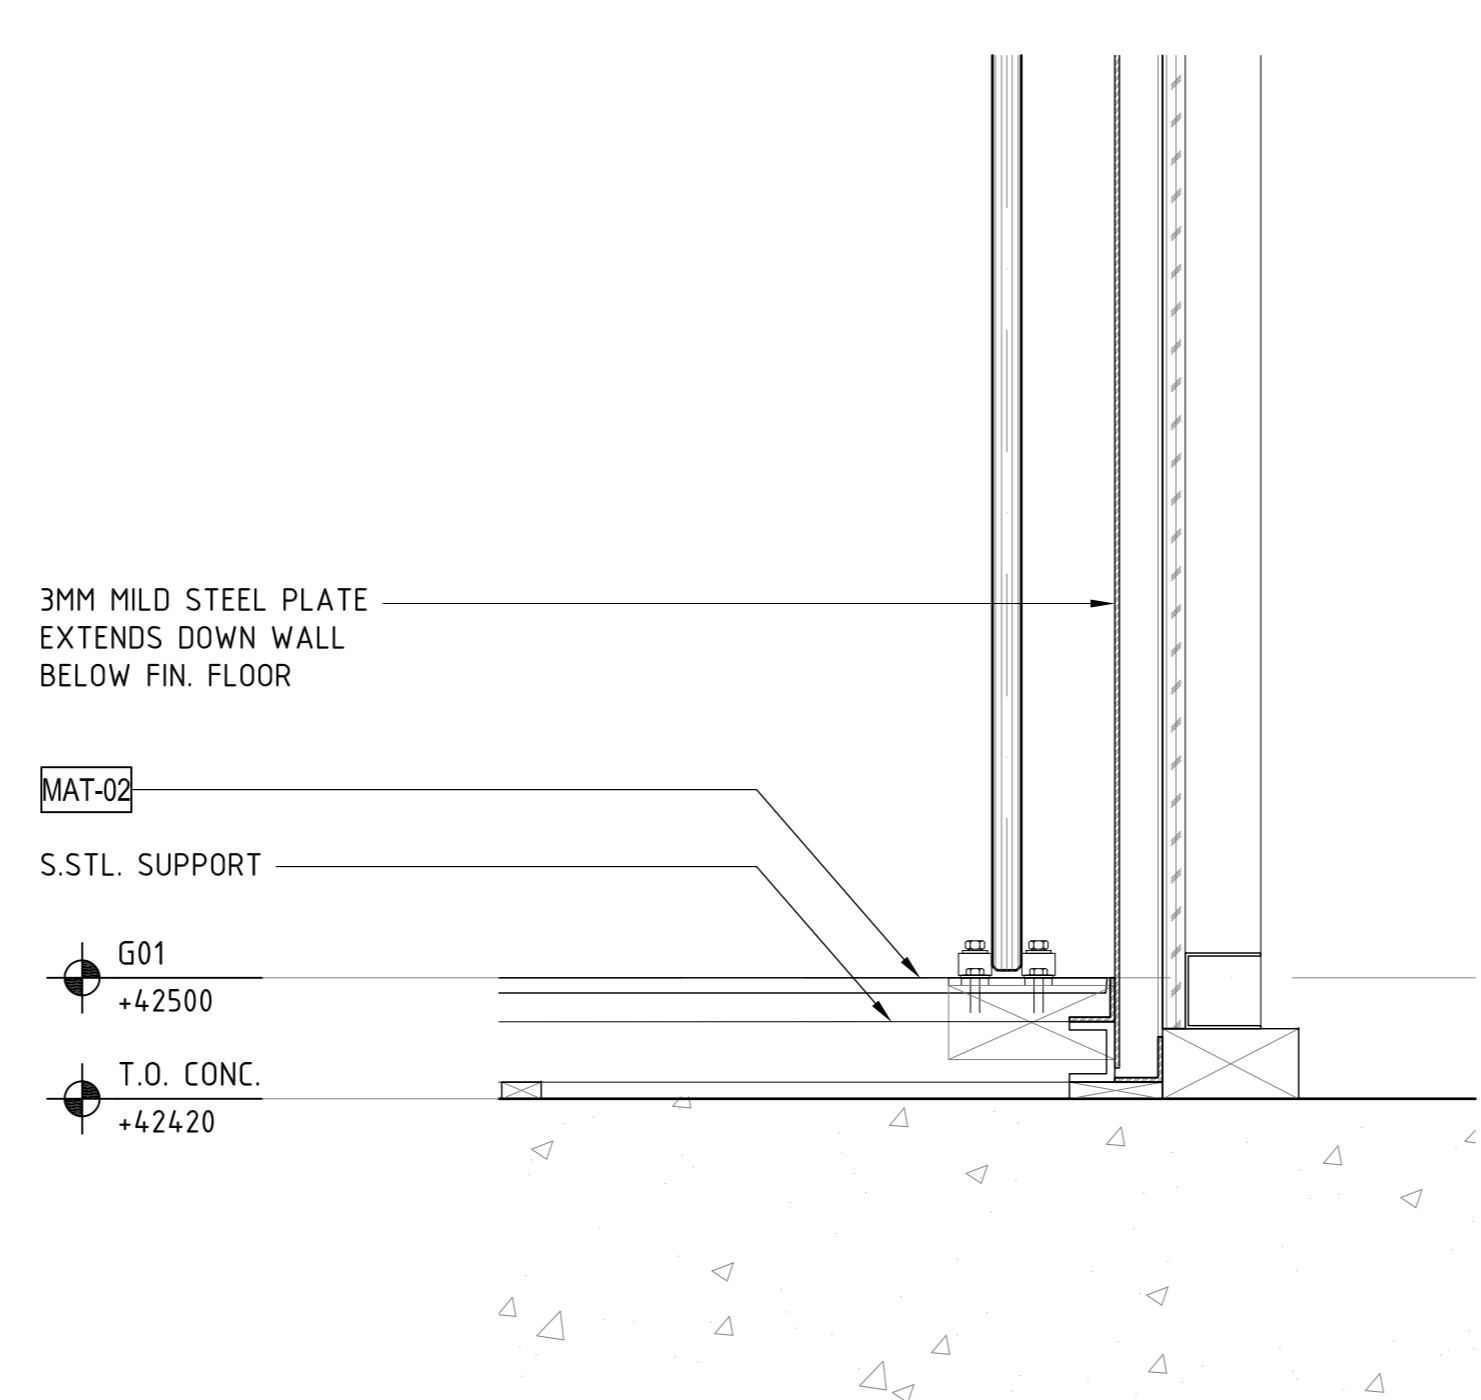

03 JR ENTRY - SECTION DETAIL
SCALE 1:5

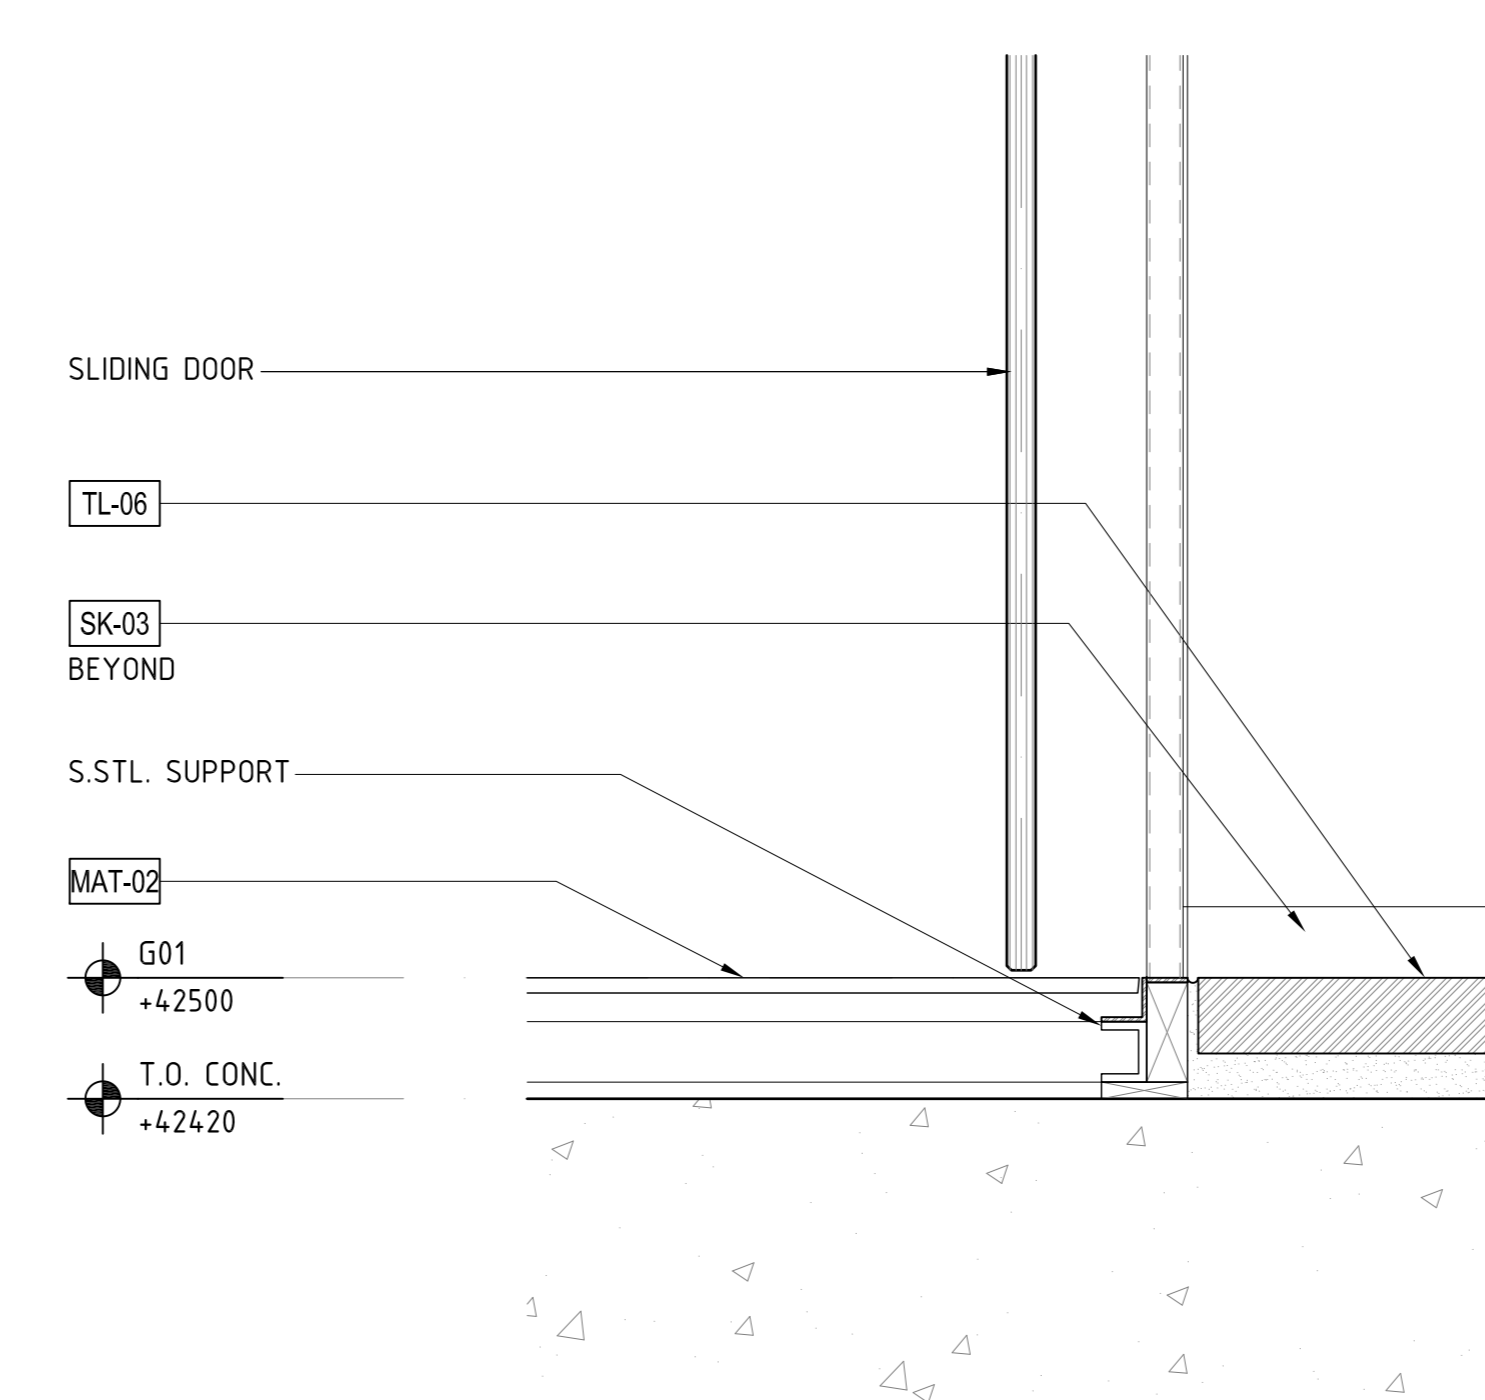


02 JR ENTRY - SECTION DETAIL
SCALE 1:5

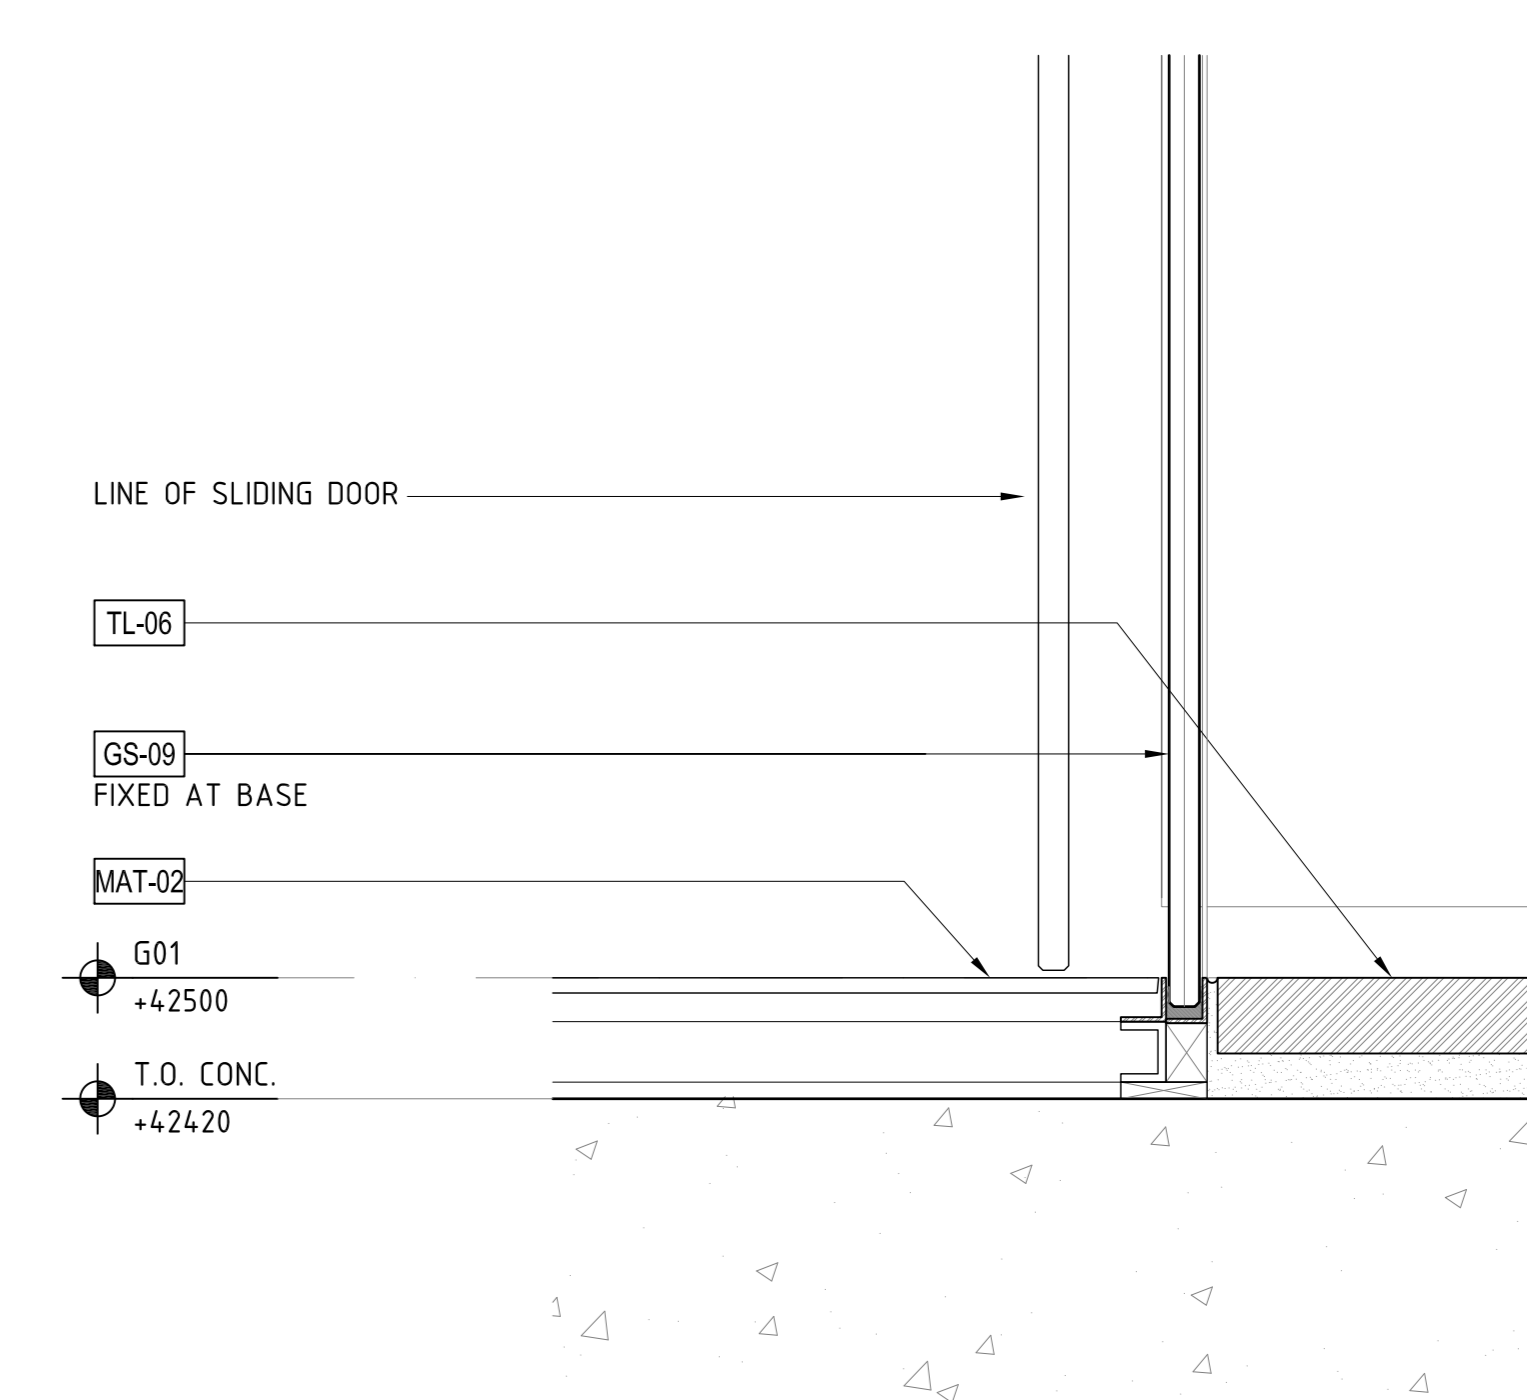

01 JR ENTRY - SECTION DETAIL
SCALE 1:5

Rev	Issue	Revision Description	And	Date
A	SG	FOR CONSTRUCTION	-	09.12.13
B3	SG	VALUE MANAGEMENT ISSUE	-	28.03.13
02	JC	100% CD - TENDER ISSUE	-	07.09.12
01	JC	90% CD ISSUE	-	10.08.12

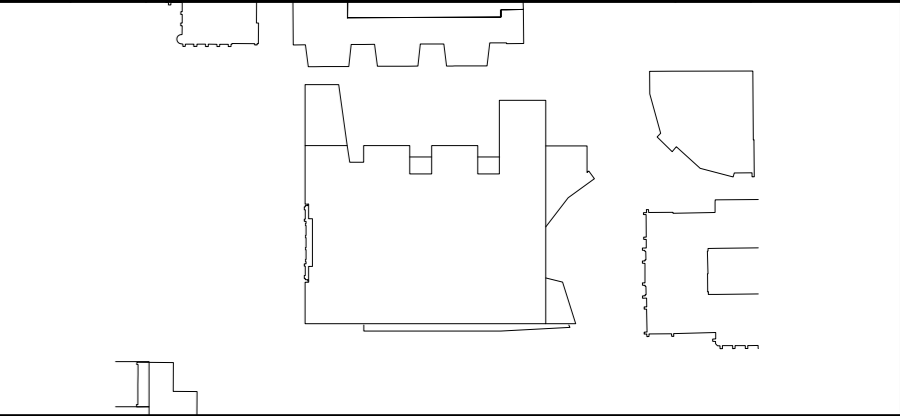

NADAAA
 NADAAA Telephone +61 817 442 6232
 1020 Washington Street No.2 Facsimile +61 888 442 1417
 Boston Massachusetts Email nadaa@nadaaa.com
 02118 USA

John Wardle Architects
 © 2011 John Wardle Architects
 Level 10, 180 Russell Street, Melbourne Victoria 3000 Australia
 Tel : +613 9654 8700 www.johnwardlearchitects.com

Client **University of Melbourne Parkville Campus**
 Project **Faculty of Architecture Building and Planning**
 Title **JOSEPH REED FACADE DETAILS**

Project No.	0913	Scale	1:100
Drawing No.	AR5168	Revision	A
Date	DEC 2013	Co-Ord	Chk

FOR CONSTRUCTION