



THIS DRAWING IS AN UNCONTROLLED COPY UNLESS STAMPED OTHERWISE

CONTRACTORS SHALL VERIFY FOR DIMENSIONS BEFORE ANY JOB COMMENCES.
 ALL SHOP DRAWINGS SHALL BE SUBMITTED TO THE SUPERINTENDENT AND MANUFACTURE
 SHALL NOT COMMENCE PRIOR TO THE RETURN OF UNAMENDED SHOP DRAWINGS SIGNED
 BY THE CONSULTANT. FIGURED DIMENSIONS SHALL TAKE PRECEDENCE OVER SCALED THIS
 DRAWING SHOULD BE USED IN CONJUNCTION WITH ALL RELEVANT CONTRACT, SPECIFICATIONS
 AND DRAWINGS COPYRIGHT OF THIS DRAWING IS VESTED IN WARDLE

General Notes

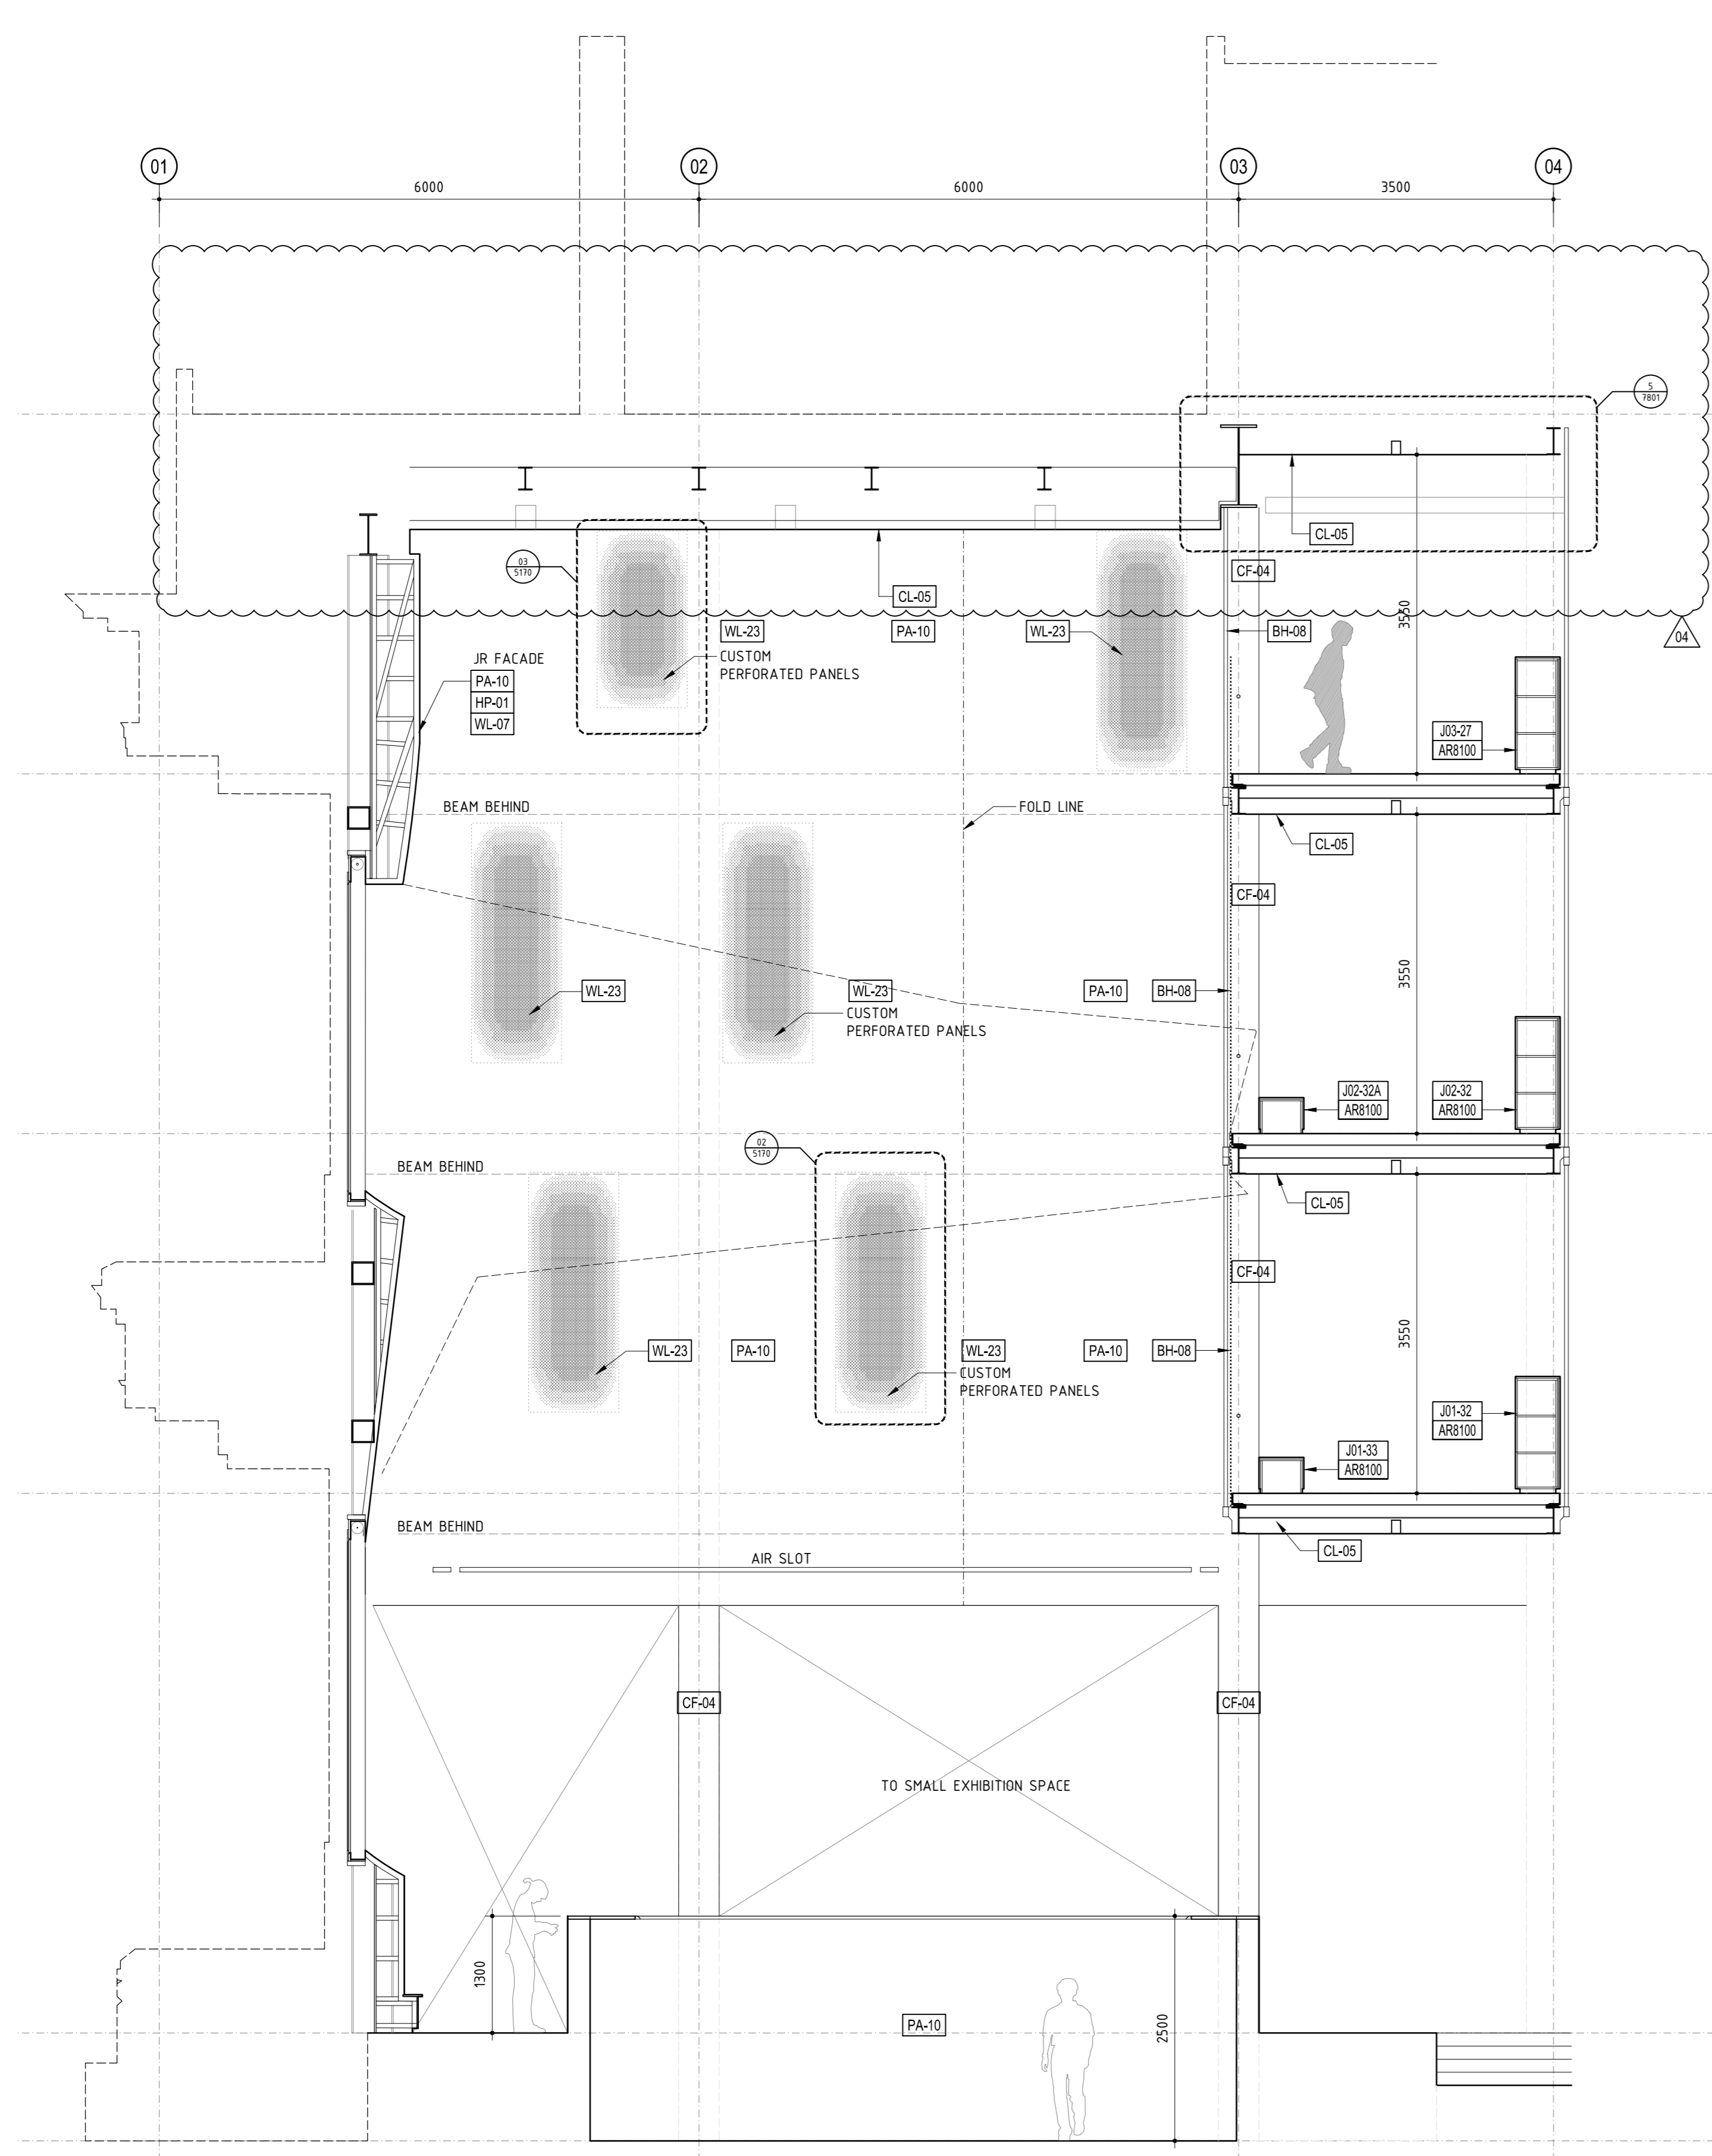


02 LARGE EXHIBITION (G42) - NORTH ELEVATION
 SCALE 1:50

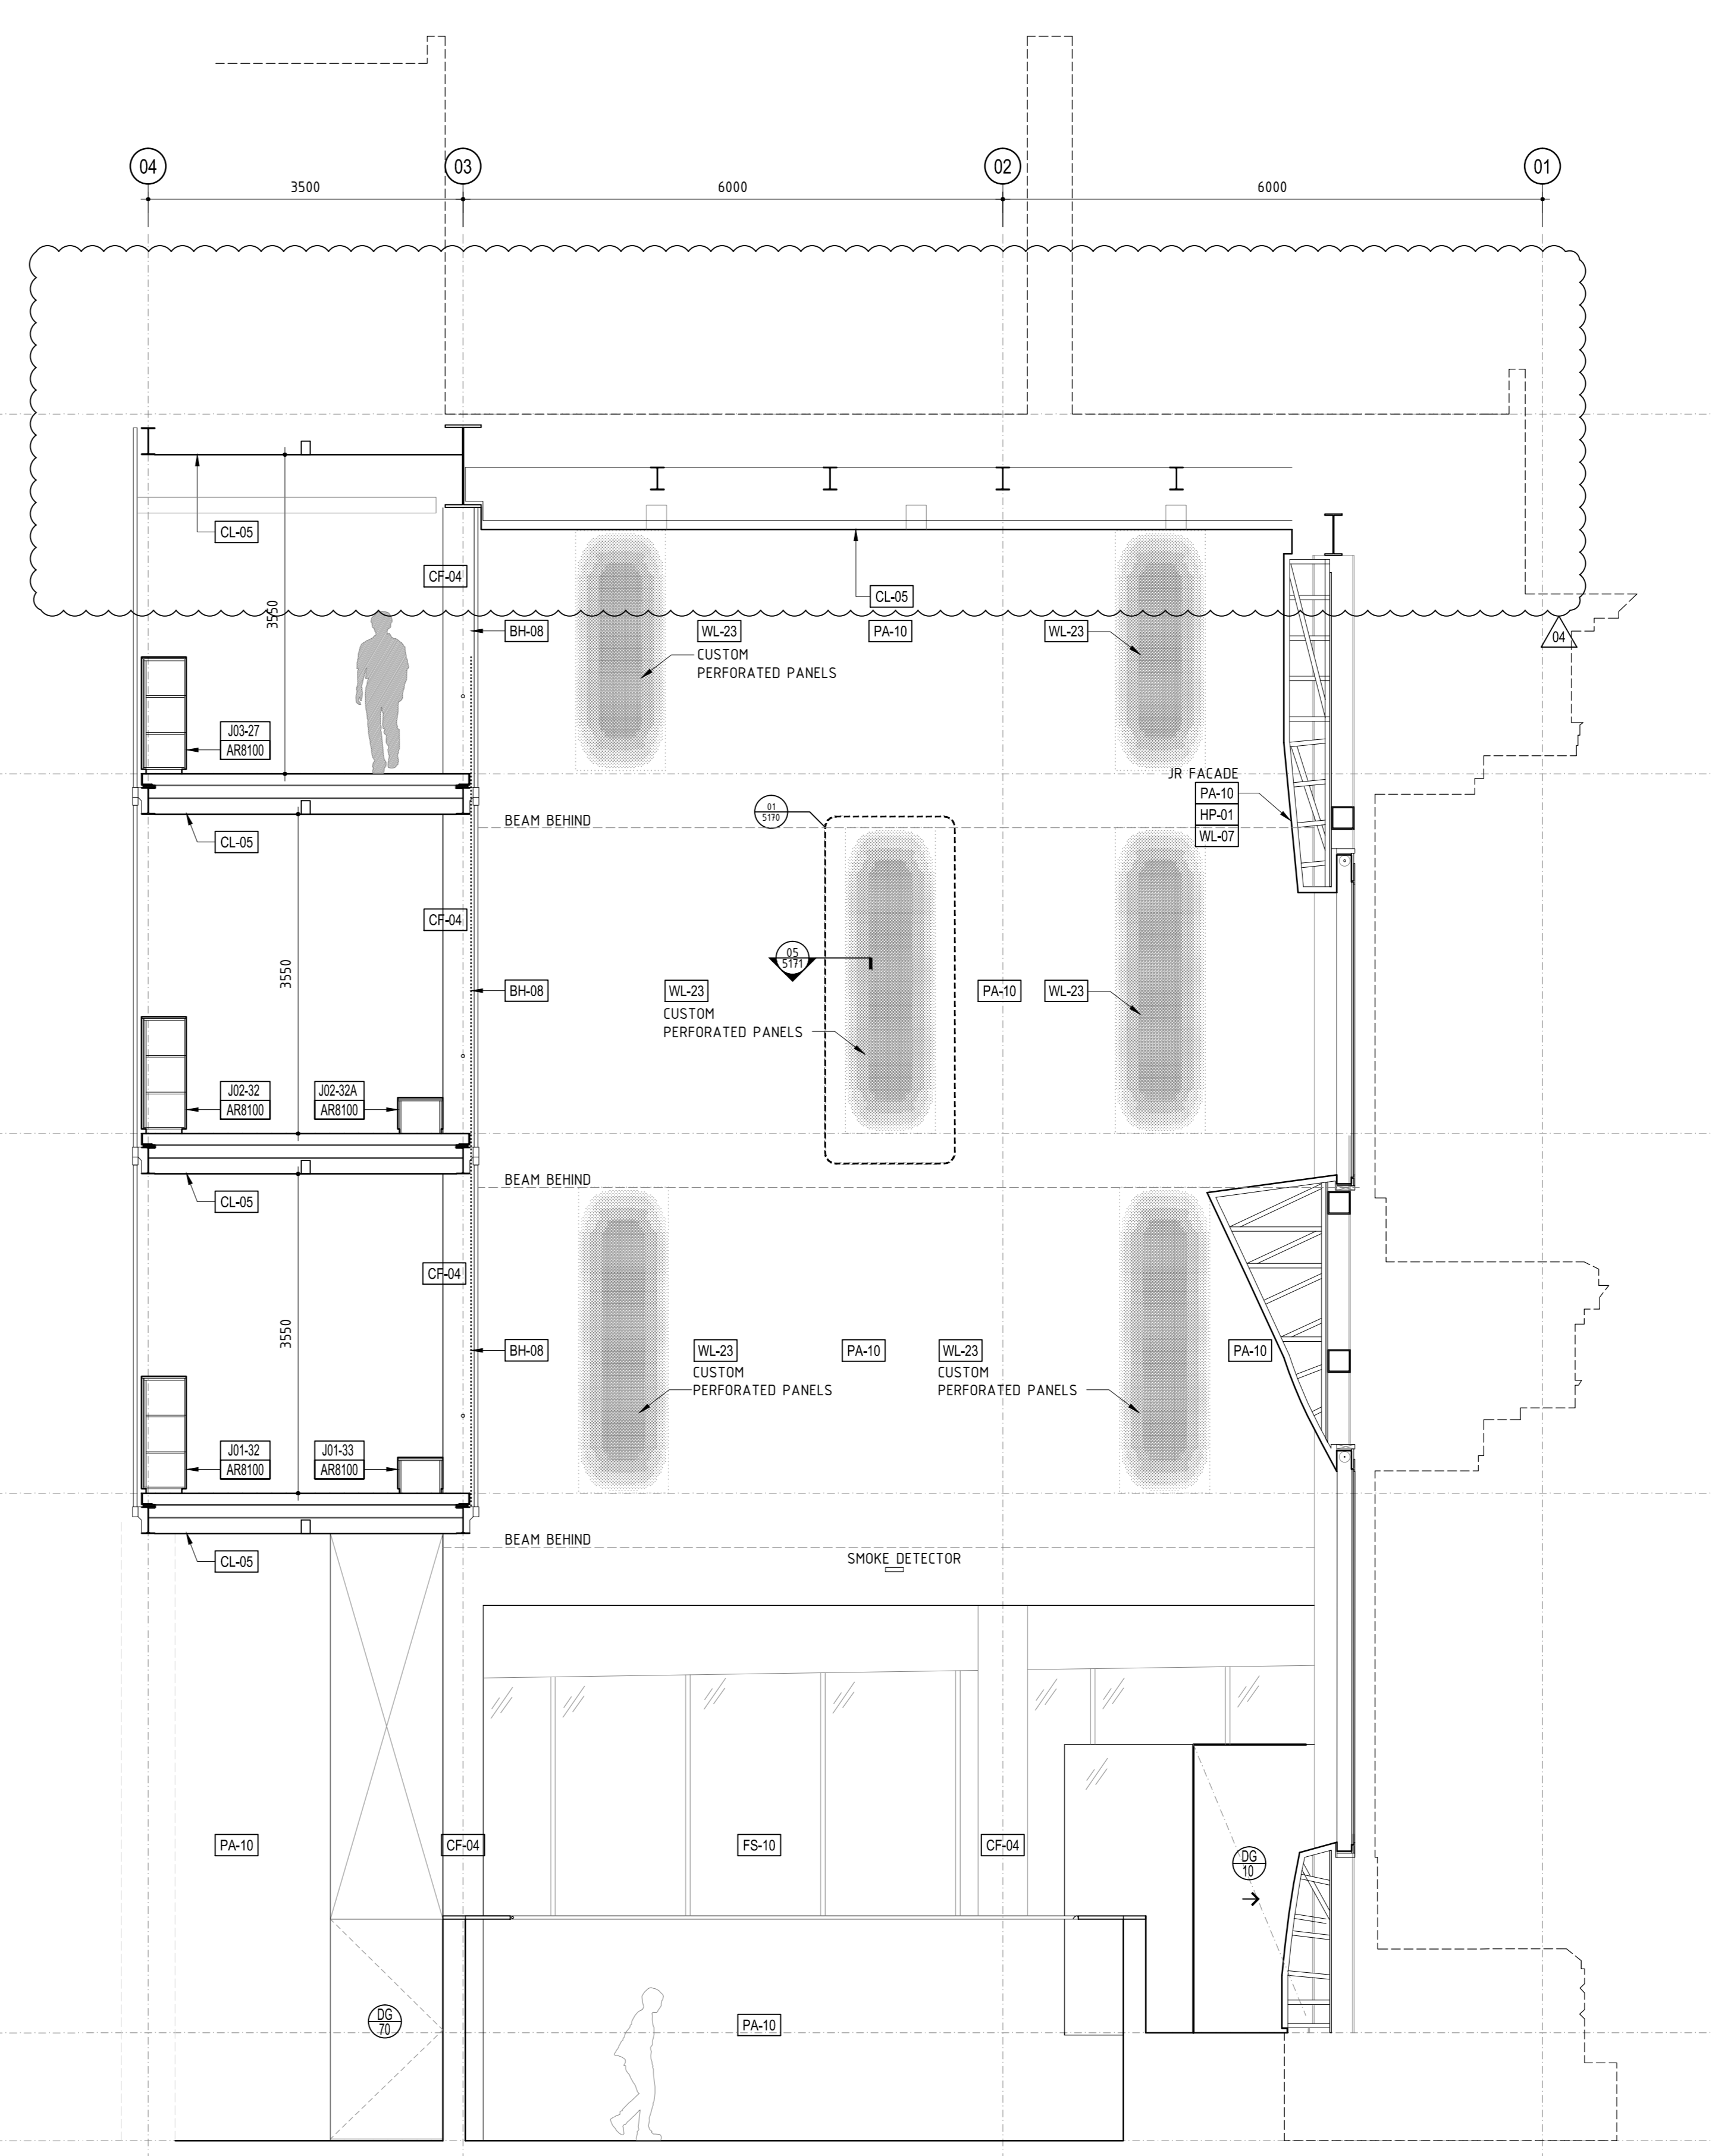

01 LARGE EXHIBITION (G42) - SOUTH ELEVATION
 SCALE 1:50

Rev	Issue	Revision Description	Amd	Date
04	JC	100% CD - TENDER ISSUE	-	07.09.12
03	JC	90% CD ISSUE	-	10.08.12
02	JC	75% CD ISSUE	-	13.07.12
01	JC	50% CD ISSUE	-	01.06.12

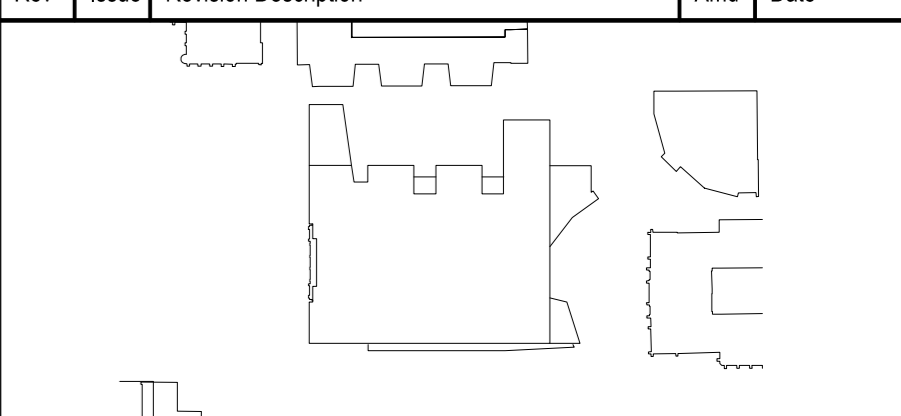

NADAAA
 NADAAA
 1920 Washington Street No.2
 Boston
 Massachusetts 02118 USA
 Telephone +1 617 442 6232
 Facsimile +1 888 442 1417
 Email nadaa@nadaaa.com

John Wardle Architects
 © 2011 John Wardle Architects
 Level 10, 180 Russell Street, Melbourne Victoria 3000 Australia
 Tel : +613 9654 8700 www.johnwardlearchitects.com

Client **University of Melbourne
 Parkville Campus**

Project **Faculty of Architecture
 Building and Planning**

Title **JOSEPH REED FLANKING WALL
 ELEVATIONS**

Project No.	0913	Scale	1:50 @ A0 1:100 @ A2
Drawing No.	AR5170	Revision	04
Date	Draw	Co-Ord	Check

FILENAME: #####
100% CD - TENDER ISSUE