



CONTRACTORS SHALL VERIFY JOB DIMENSIONS BEFORE ANY JOB COMMENCES. ALL SHOP DRAWINGS SHALL BE SUBMITTED TO THE SUPERINTENDENT AND MANUFACTURER SHALL NOT COMMENCE FROM THE RETURN OF DIMENSIONS SHOP DRAWINGS REVIEWED BY THE CONSULTANT. REQUIRED DIMENSIONS SHALL TAKE PRECEDENCE OVER SCALES. THIS DRAWING SHALL BE READ IN CONJUNCTION WITH ALL RELEVANT CONTRACT SPECIFICATIONS AND DRAWINGS COPYRIGHT OF THIS DRAWING IS VESTED IN WARDLE.


General Notes

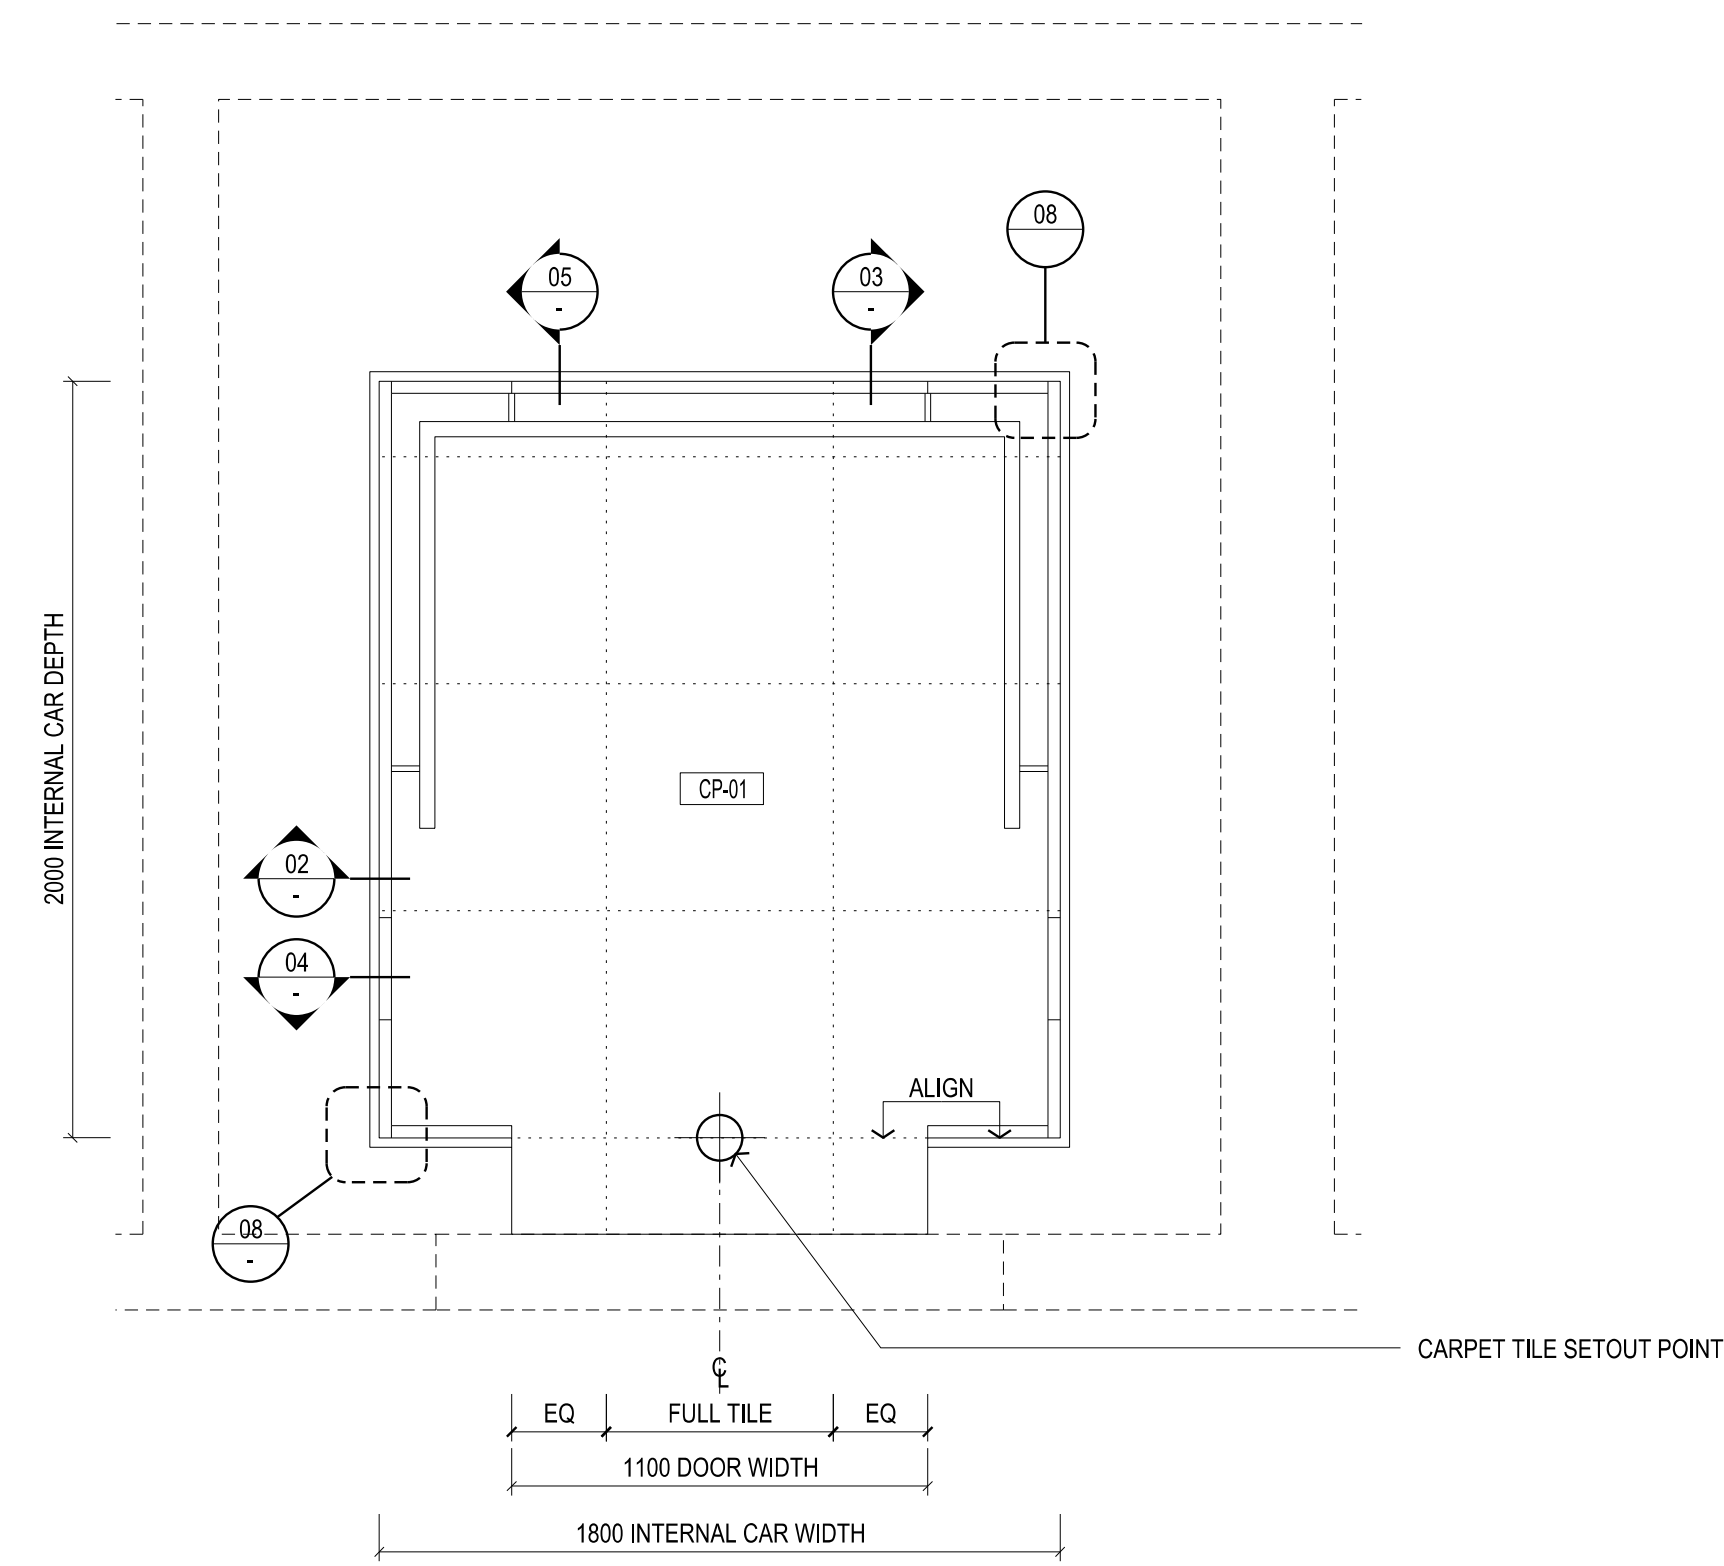


01 PLAN - LIFT CAR 01, 02, 03
SCALE 1:20
NOTE: LIFT CAR INTERNAL FITTINGS AND FINISHES TO BE REVIEWED AND SELECTED BY ARCHITECT

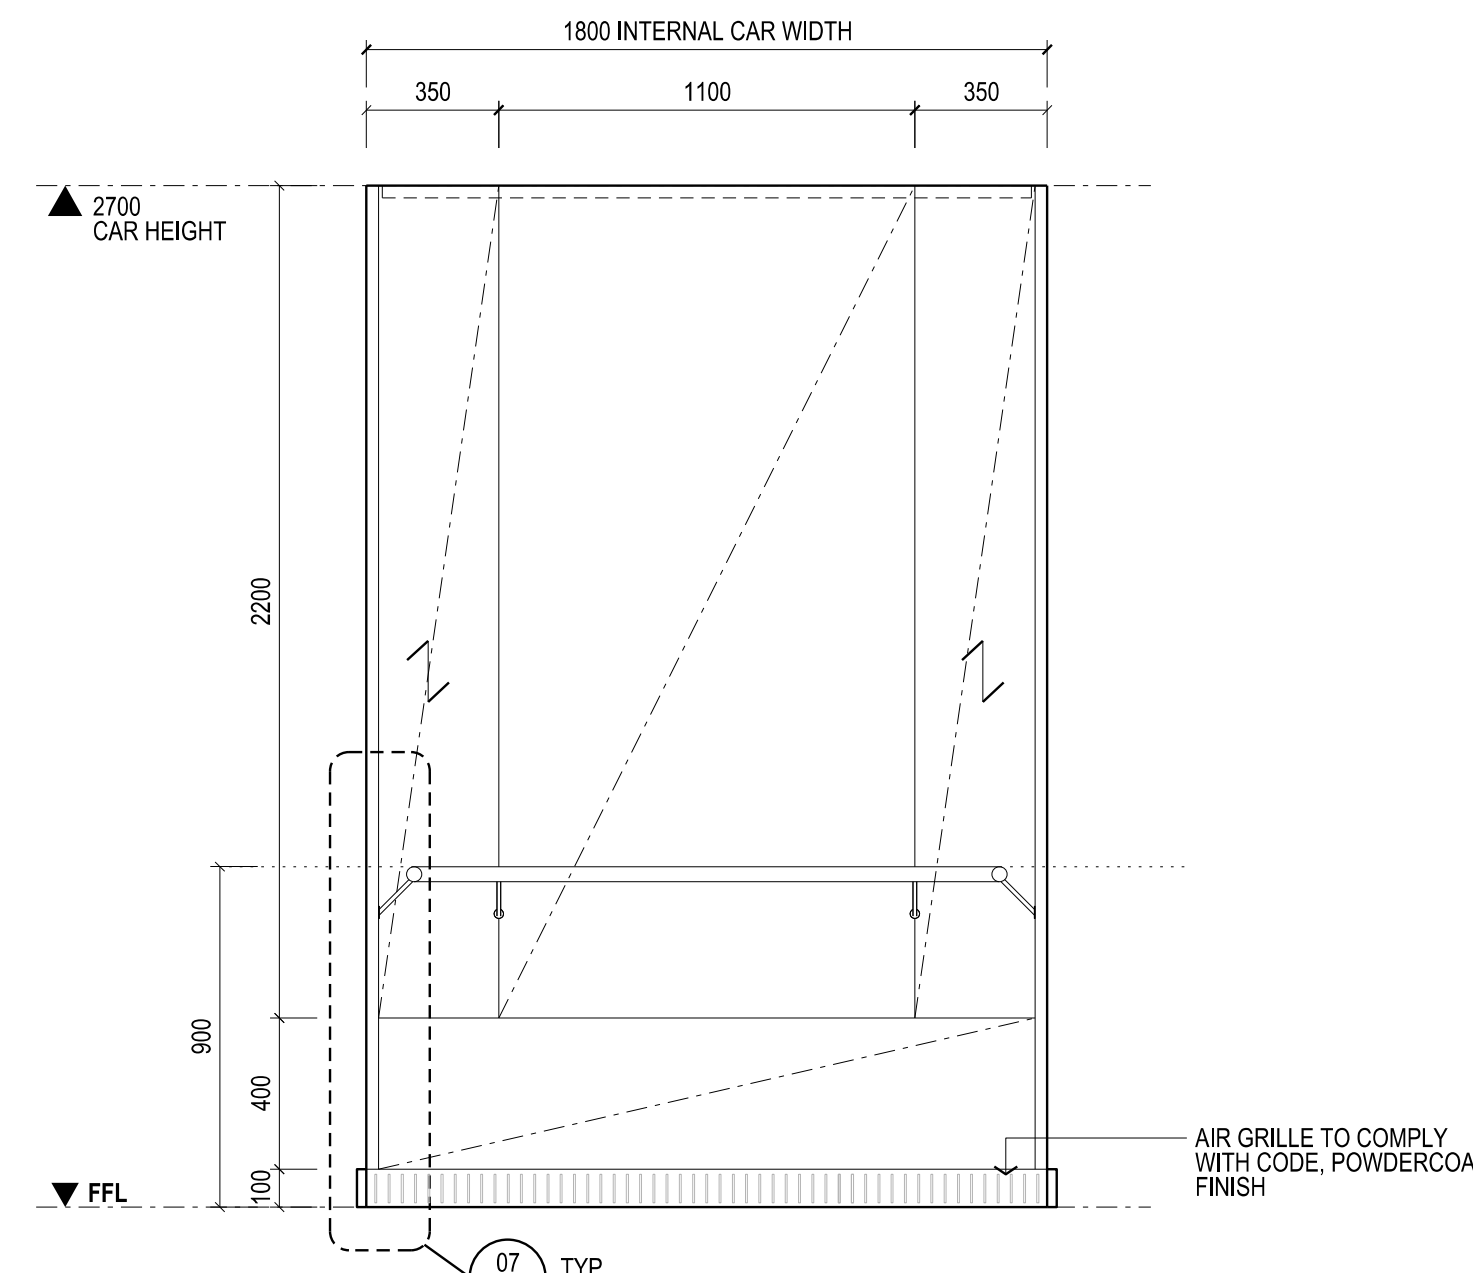


02 ELEVATION
SCALE 1:20
NOTE: LIFT CAR INTERNAL FITTINGS AND FINISHES TO BE REVIEWED AND SELECTED BY ARCHITECT

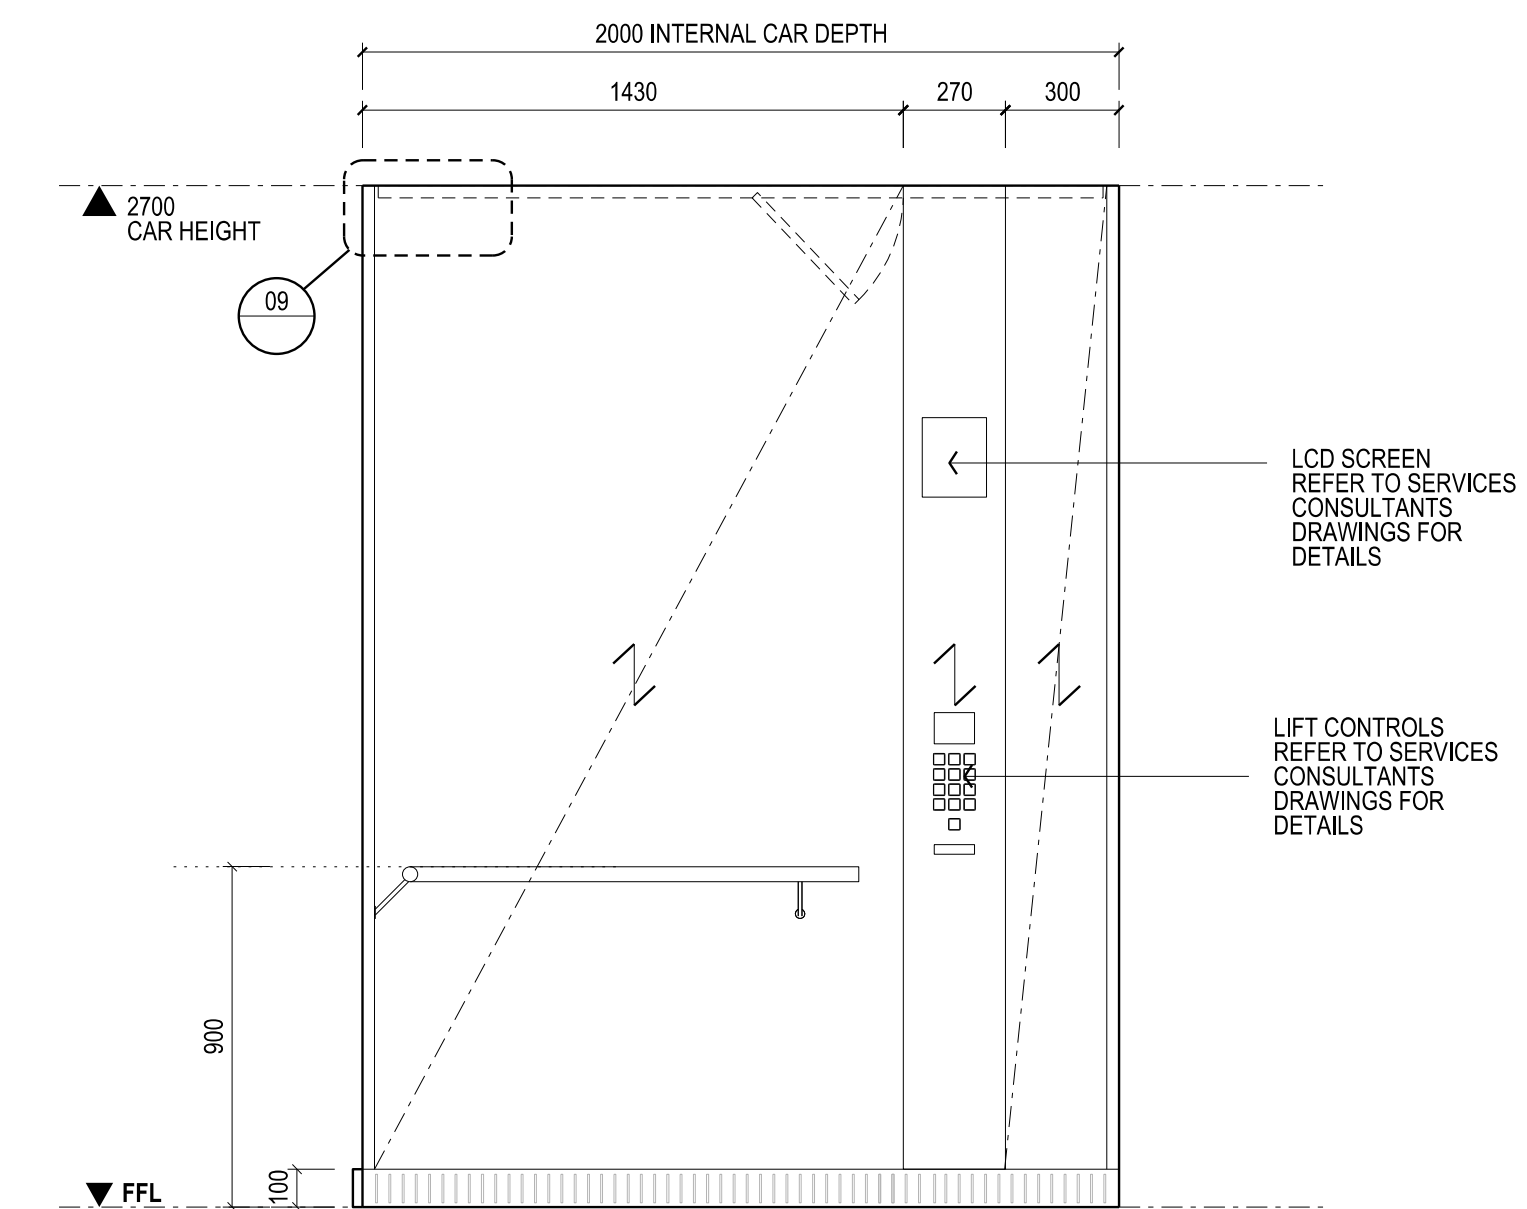


03 ELEVATION
SCALE 1:20
NOTE: LIFT CAR INTERNAL FITTINGS AND FINISHES TO BE REVIEWED AND SELECTED BY ARCHITECT

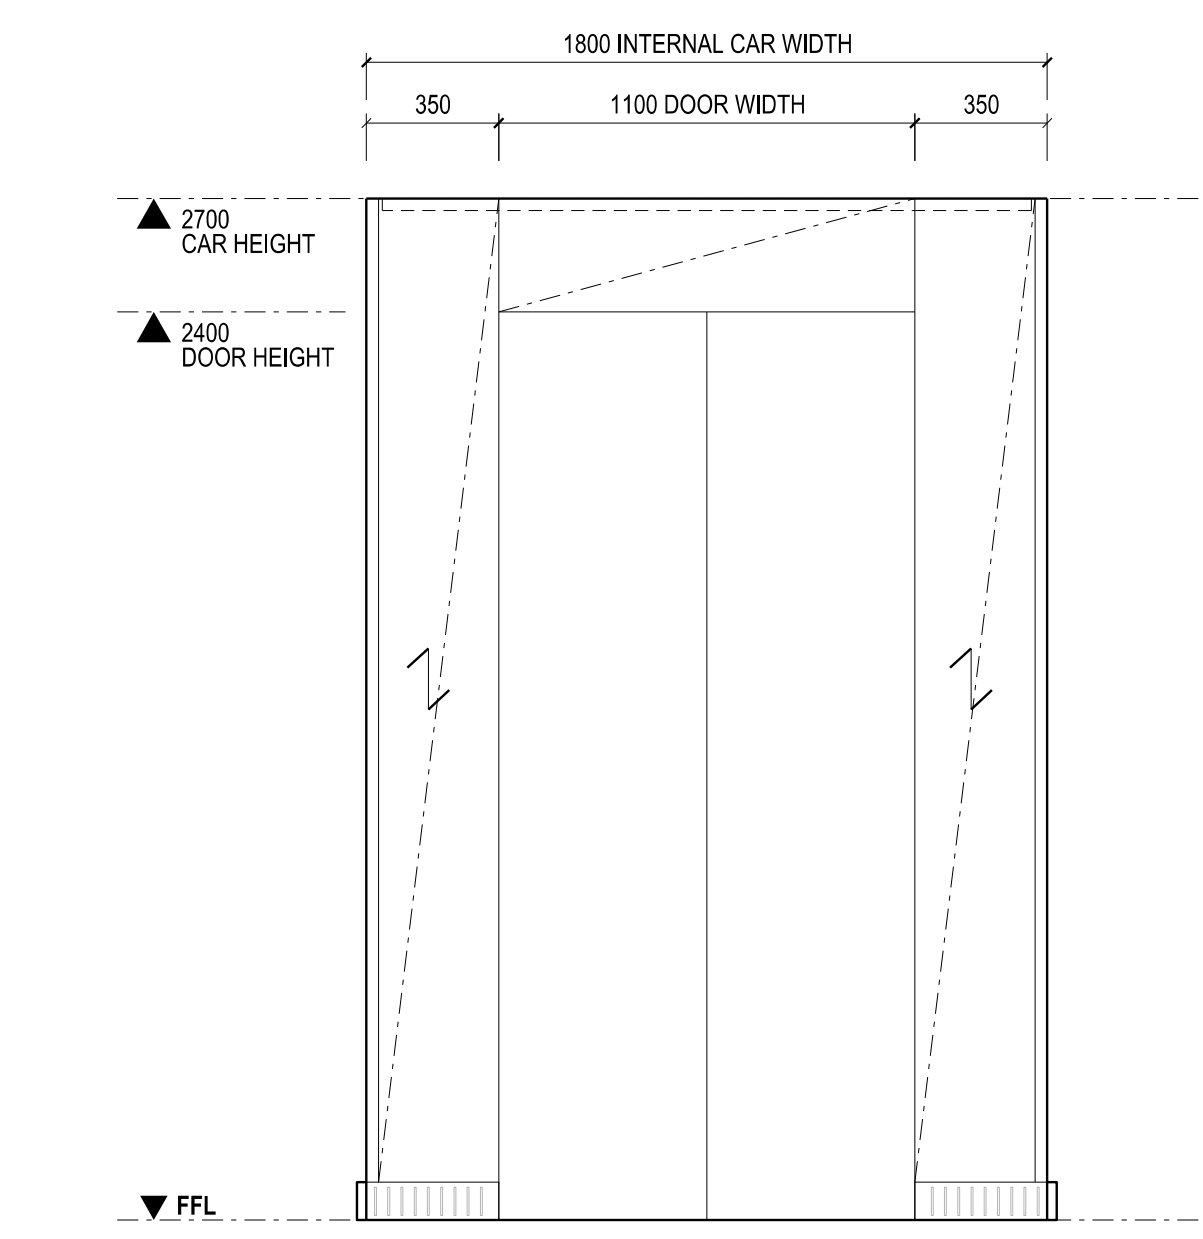

04 ELEVATION
SCALE 1:20
NOTE: LIFT CAR INTERNAL FITTINGS AND FINISHES TO BE REVIEWED AND SELECTED BY ARCHITECT

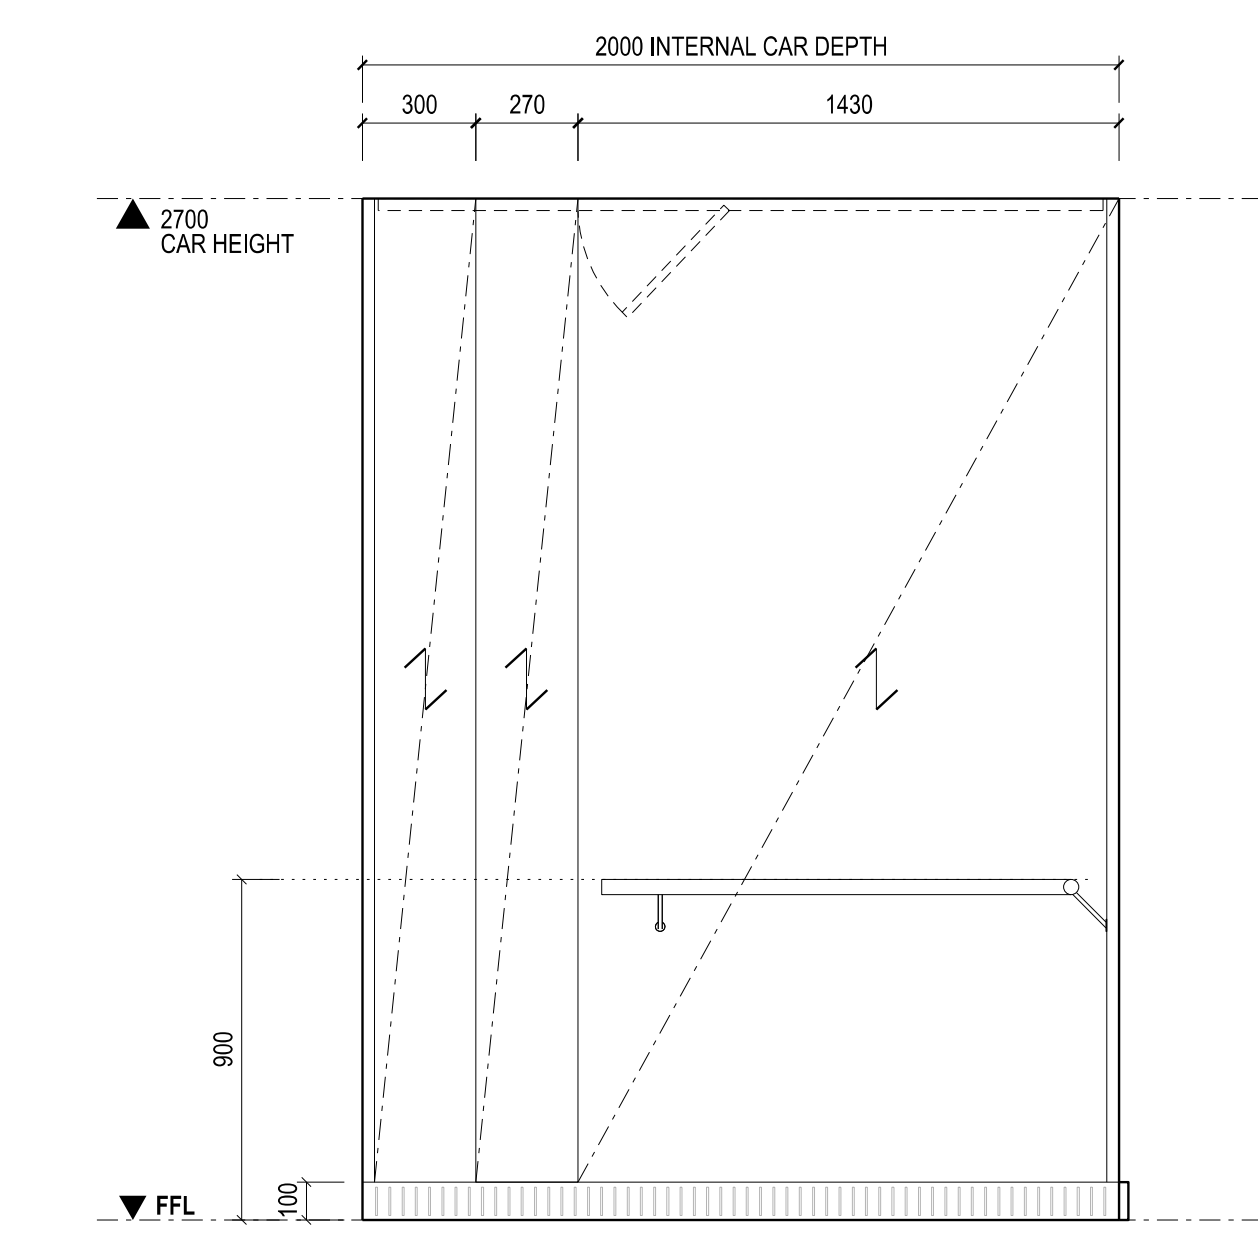

05 ELEVATION
SCALE 1:20
NOTE: LIFT CAR INTERNAL FITTINGS AND FINISHES TO BE REVIEWED AND SELECTED BY ARCHITECT

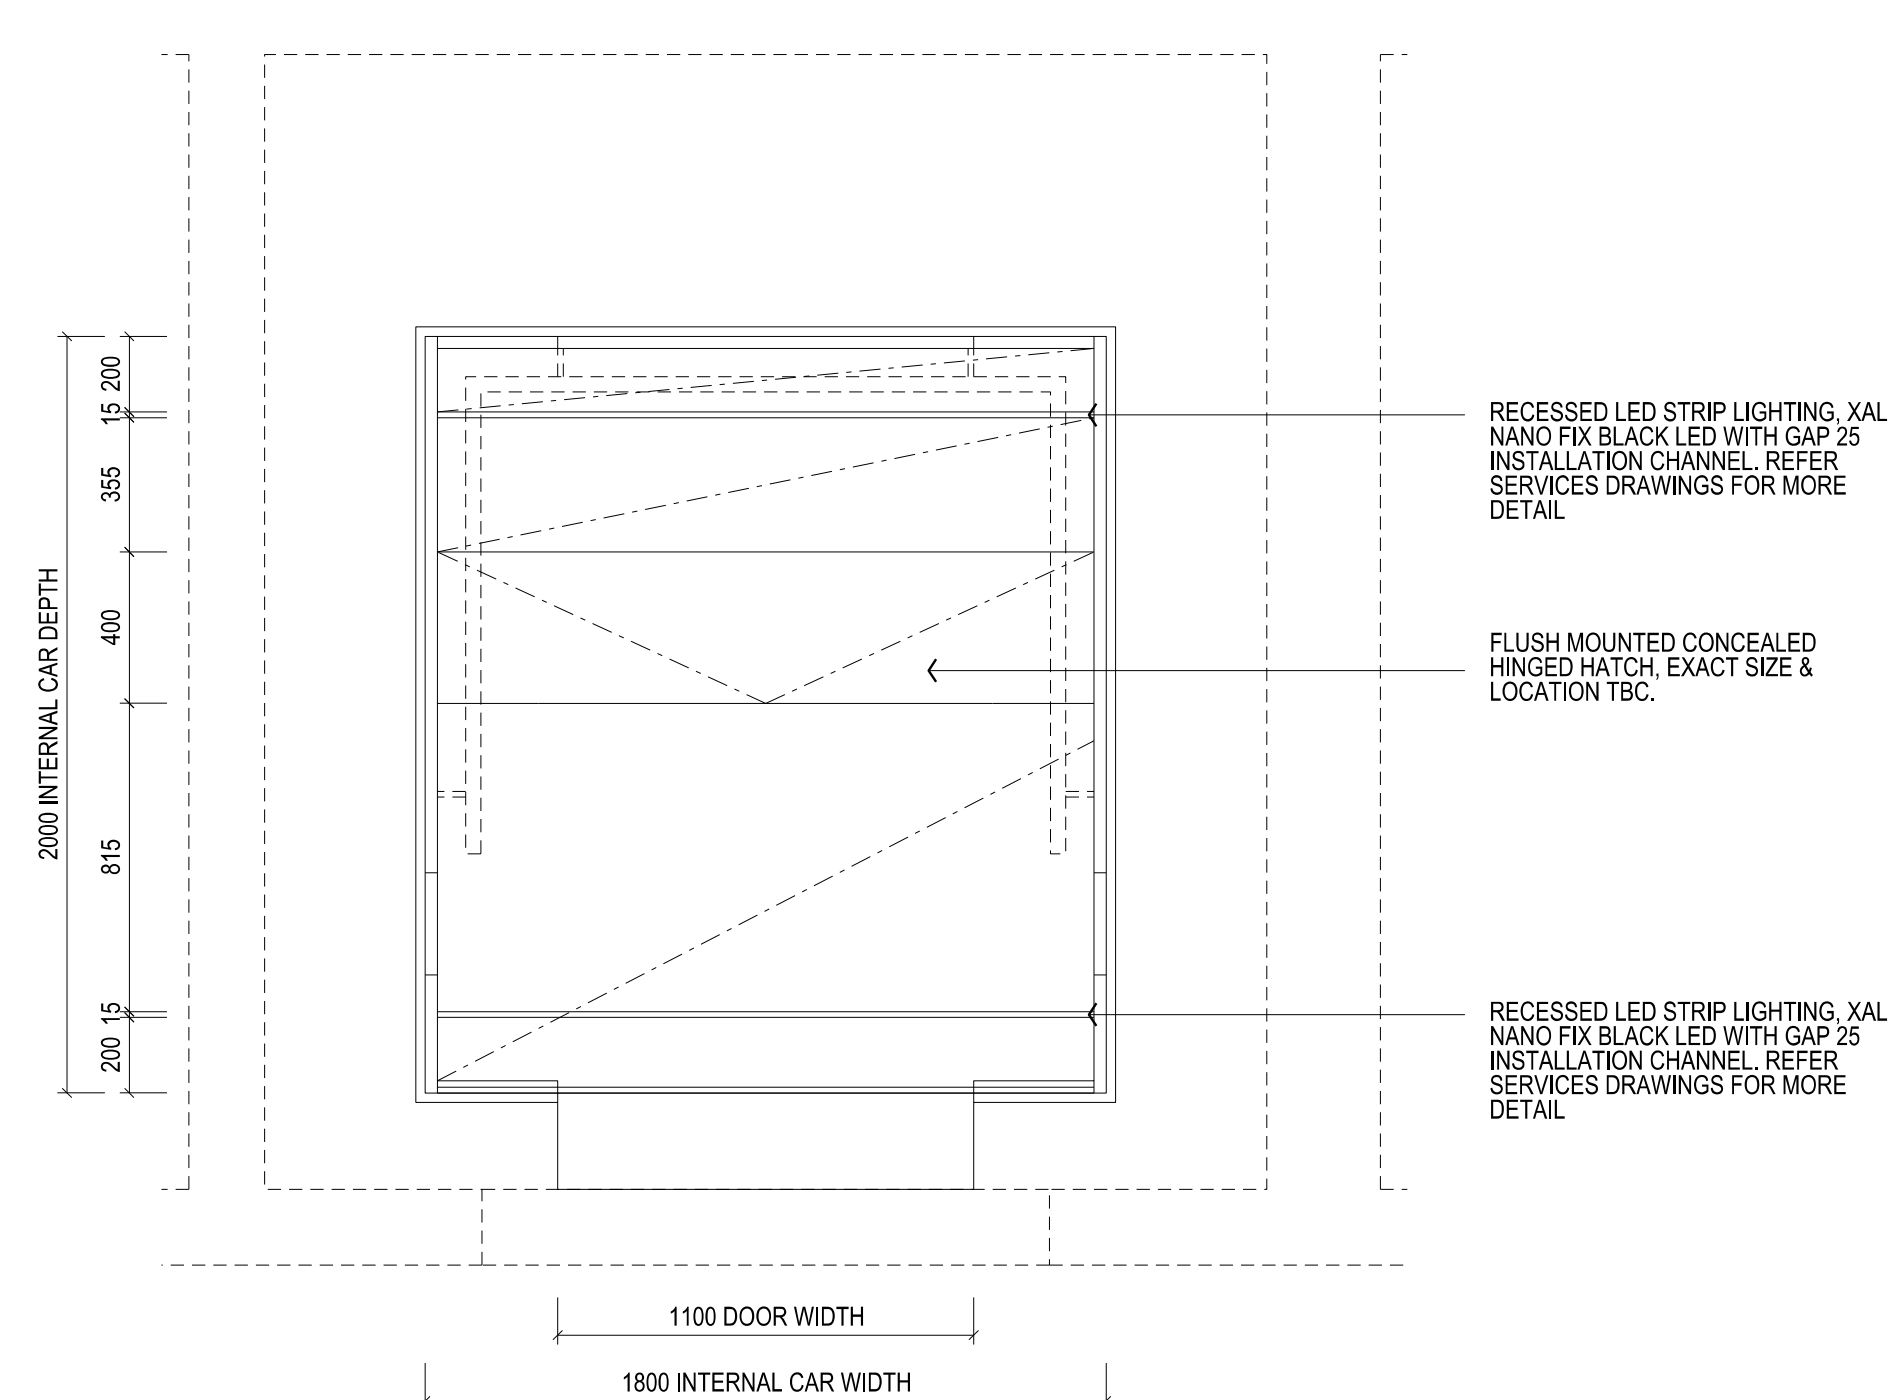

06 REFLECTED CEILING PLAN - LIFT CAR 01, 02, 03
SCALE 1:20
NOTE: LIFT CAR INTERNAL FITTINGS AND FINISHES TO BE REVIEWED AND SELECTED BY ARCHITECT

Rev	Issue	Revision Description	And	Date
A	SG	ISSUED FOR CONSTRUCTION	-	10.01.14
08	SG	VM UPDATE	-	17.04.13
07	SG	100% CD - TENDER ISSUE	-	07.09.12
06	SG	95% CD ISSUE	-	10.08.12
05	SG	75% CD ISSUE	-	13.07.12
04	SG	50% CD ISSUE	-	01.06.12
03	SG	25% CD ISSUE	-	20.04.12
02	SG	FINAL CD ISSUE	-	24.02.12
01	SG	DD UPDATE	-	20.01.12



NADAAA
 NADAAA
 1920 Washington Street No.2 Boston Massachusetts 02118 USA
 Telephone +1 817 442 8232 Facsimile +1 888 442 1417 Email nadaa@nadaaa.com

John Wardle Architects
 25 Rokeby Street, Collingwood, Victoria 3066 Australia
 Tel: +61 3 8662 0400 www.johnwardlearchitects.com
 © 2012 John Wardle Architects ABN 83 006 814 268

Client **University of Melbourne Parkville Campus**

Project **Faculty of Architecture Building and Planning**

Title **LIFT CAR 01, 02, 03 - PLANS, SECTIONS DETAILS - SHEET 1**

Project No.	0913	Scale	1:20 @ A0 1:100 @ A2
Drawing No.	AR5200	Revision	A

Date: Jan 2012 Dwn - Co-Ord - Chk -

FILENAME - \$FILES

FOR CONSTRUCTION