



06 REFLECTED CEILING PLAN - LIFT CAR 04, 05 - SCALE 1:20

NOTE: LIFT CAR INTERNAL FITTINGS AND FINISHES TO BE SELECTED FROM LIFT MANUFACTURERS STANDARD RANGE. FITTINGS AND FINISHES TO BE REVIEWED AND SELECTED BY ARCHITECT

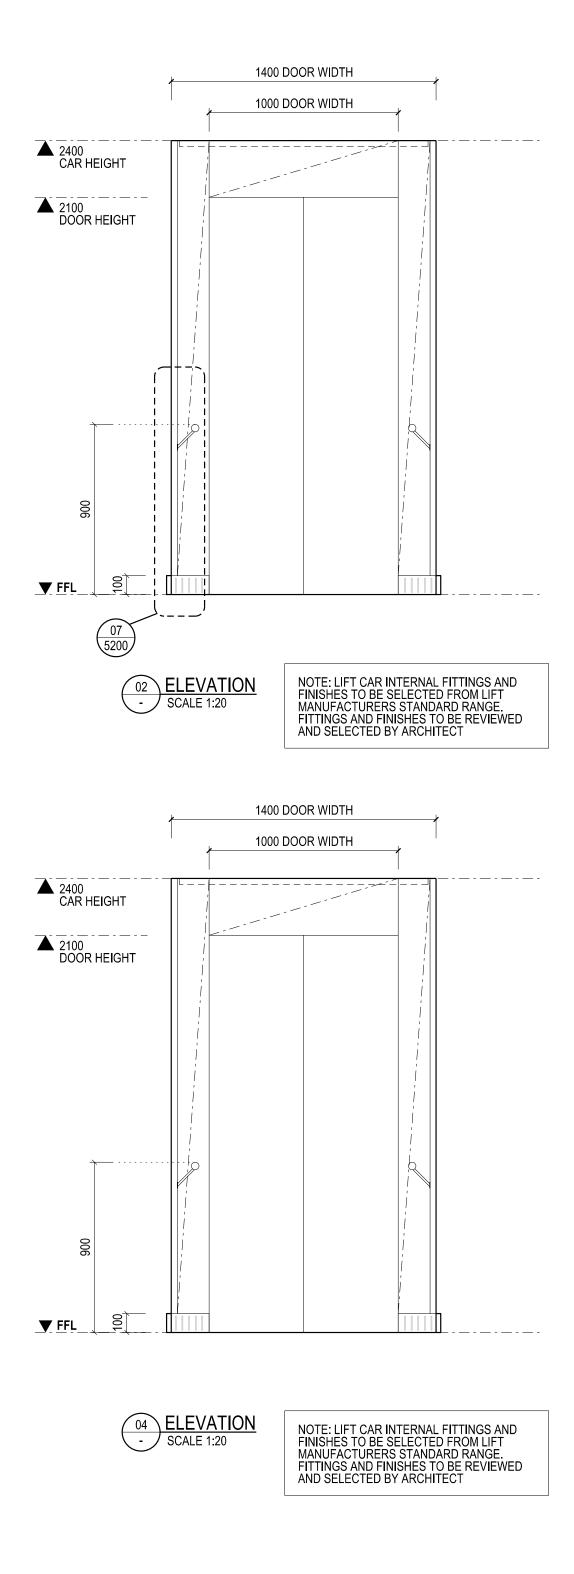

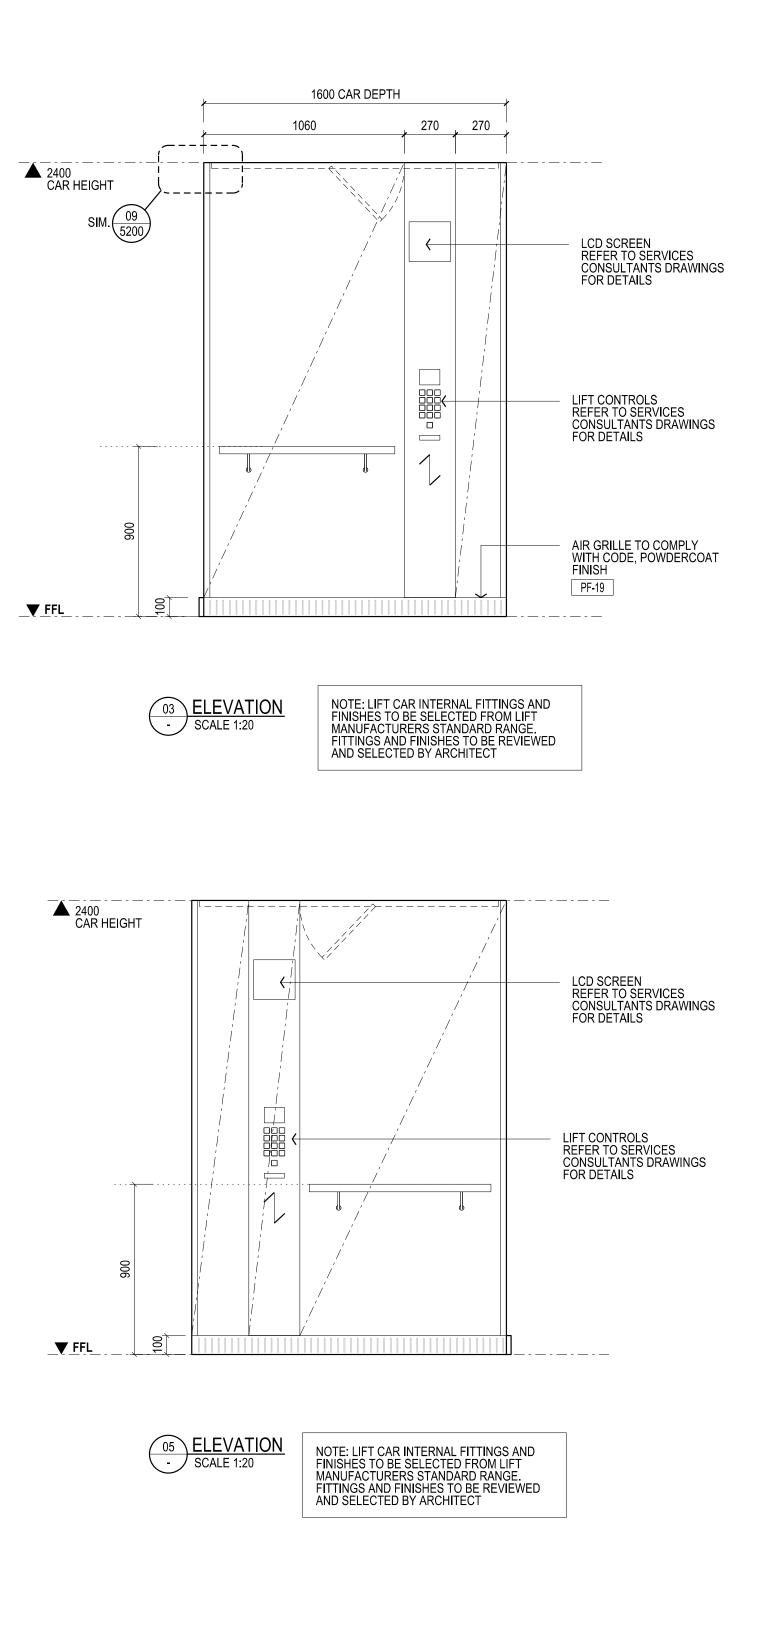

CONTRACTC ALL SHOP DF SHALL NOT ( BY THE CON DRAWING SF	WING IS AN UNCONTROLLED COPY UNLESS STAMF RAWINGS SHALL VERIFY JOB DIMENSIONS BEFORE ANY JOB COMMENCE COMMENCE PRIOR TO THE SUPERINTENDENT AND M COMMENCE PRIOR TO THE RETURN OF UNAMENDED SHOP DRAWI SULTANT. FIGURED DIMENSIONS SHALL TAKE PRECEDENCE OVER HOULD BE READ IN CONJUNCTION WITH ALL RELEVANT CONTRACT IGS COPYRIGHT OF THIS DRAWING IS VESTED IN WARDLE	ES. ANUFACTURE NGS SIGNED & SCALED. THIS
A SG 07 SG 06 SG 05 SG	ISSUED FOR CONSTRUCTION VM UPDATE 100% CD - TENDER ISSUE 90% CD ISSUE	- 10.01.14 - 17.04.13 - 07.09.12 - 10.08.12
04         SG           03         SG           02         SG           01         SG           Rev         Issue	75% CD ISSUE         50% CD ISSUE         FINAL DD ISSUE         DD UPDATE         Revision Description	-     13.07.12       -     01.06.12       -     24.02.12       -     20.01.12       Amd     Date
Brookfield MULTIPLEX		
NAD/ 1920 Stree Bosto Mass	Washington +1 617 442 6232 t No.2 Facsimile	
Tel :	John Wa           John Wa           Architec           Rokeby Street, Collingwood, Victoria 306           +61 3 8662 0400         www.johnwardlea	66 Australia architects.com
© 2012 John Wardle Architects ABN 83 006 814 268 Client University of Melbourne		
Parkville Campus Project Faculty of Architecture Building and Planning		
	T CARS 04, 05 - PLANS, S TAILS	Scale 1:20 @ A0
Date Jan 20	0913 Drawing No. AR5201	1:100 @ A2 Revision A Chck -
FILENAME - \$FILE\$		