



CONTRACTORS SHALL VERIFY JOB DIMENSIONS BEFORE ANY JOB COMMENCES. ALL SHOP DRAWINGS SHALL BE SUBMITTED TO THE SUPERINTENDENT AND MANUFACTURER SHALL NOT COMMENCE FROM THE RETURN OF DRAWINGS SHOWN BY THE CONSULTANT. DIMENSIONS SHALL TAKE PRECEDENCE OVER SCALES. THIS DRAWING SHALL BE READ IN CONJUNCTION WITH ALL RELEVANT CONTRACT SPECIFICATIONS AND DRAWINGS COPYRIGHT OF THIS DRAWING IS VESTED IN HANDLE.


General Notes

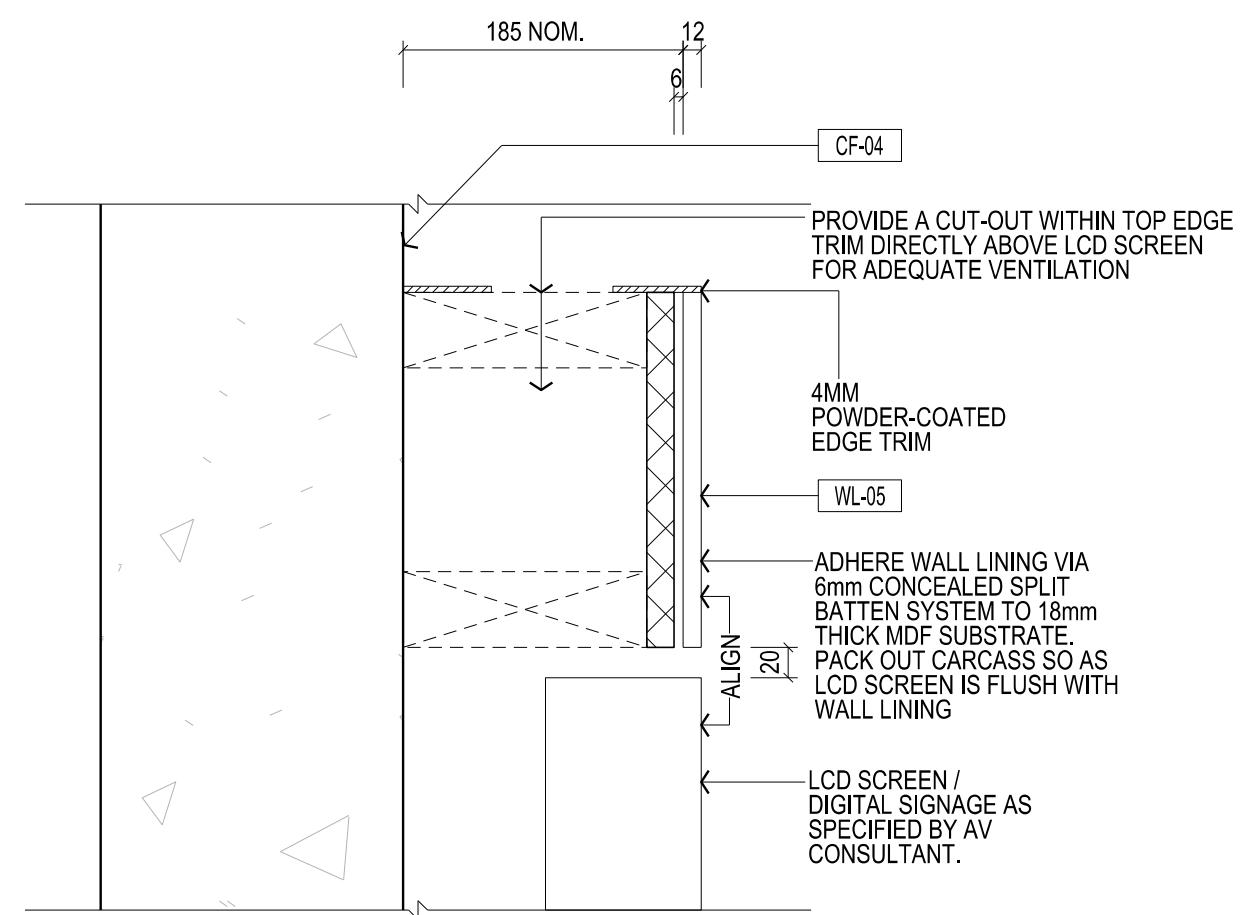


07 WALL LINING EDGE JUNCTION SECTION DETAIL - DIGITAL SIGNAGE, LIFT LOBBY FOYER 1 GROUND FLOOR SCALE 1:5

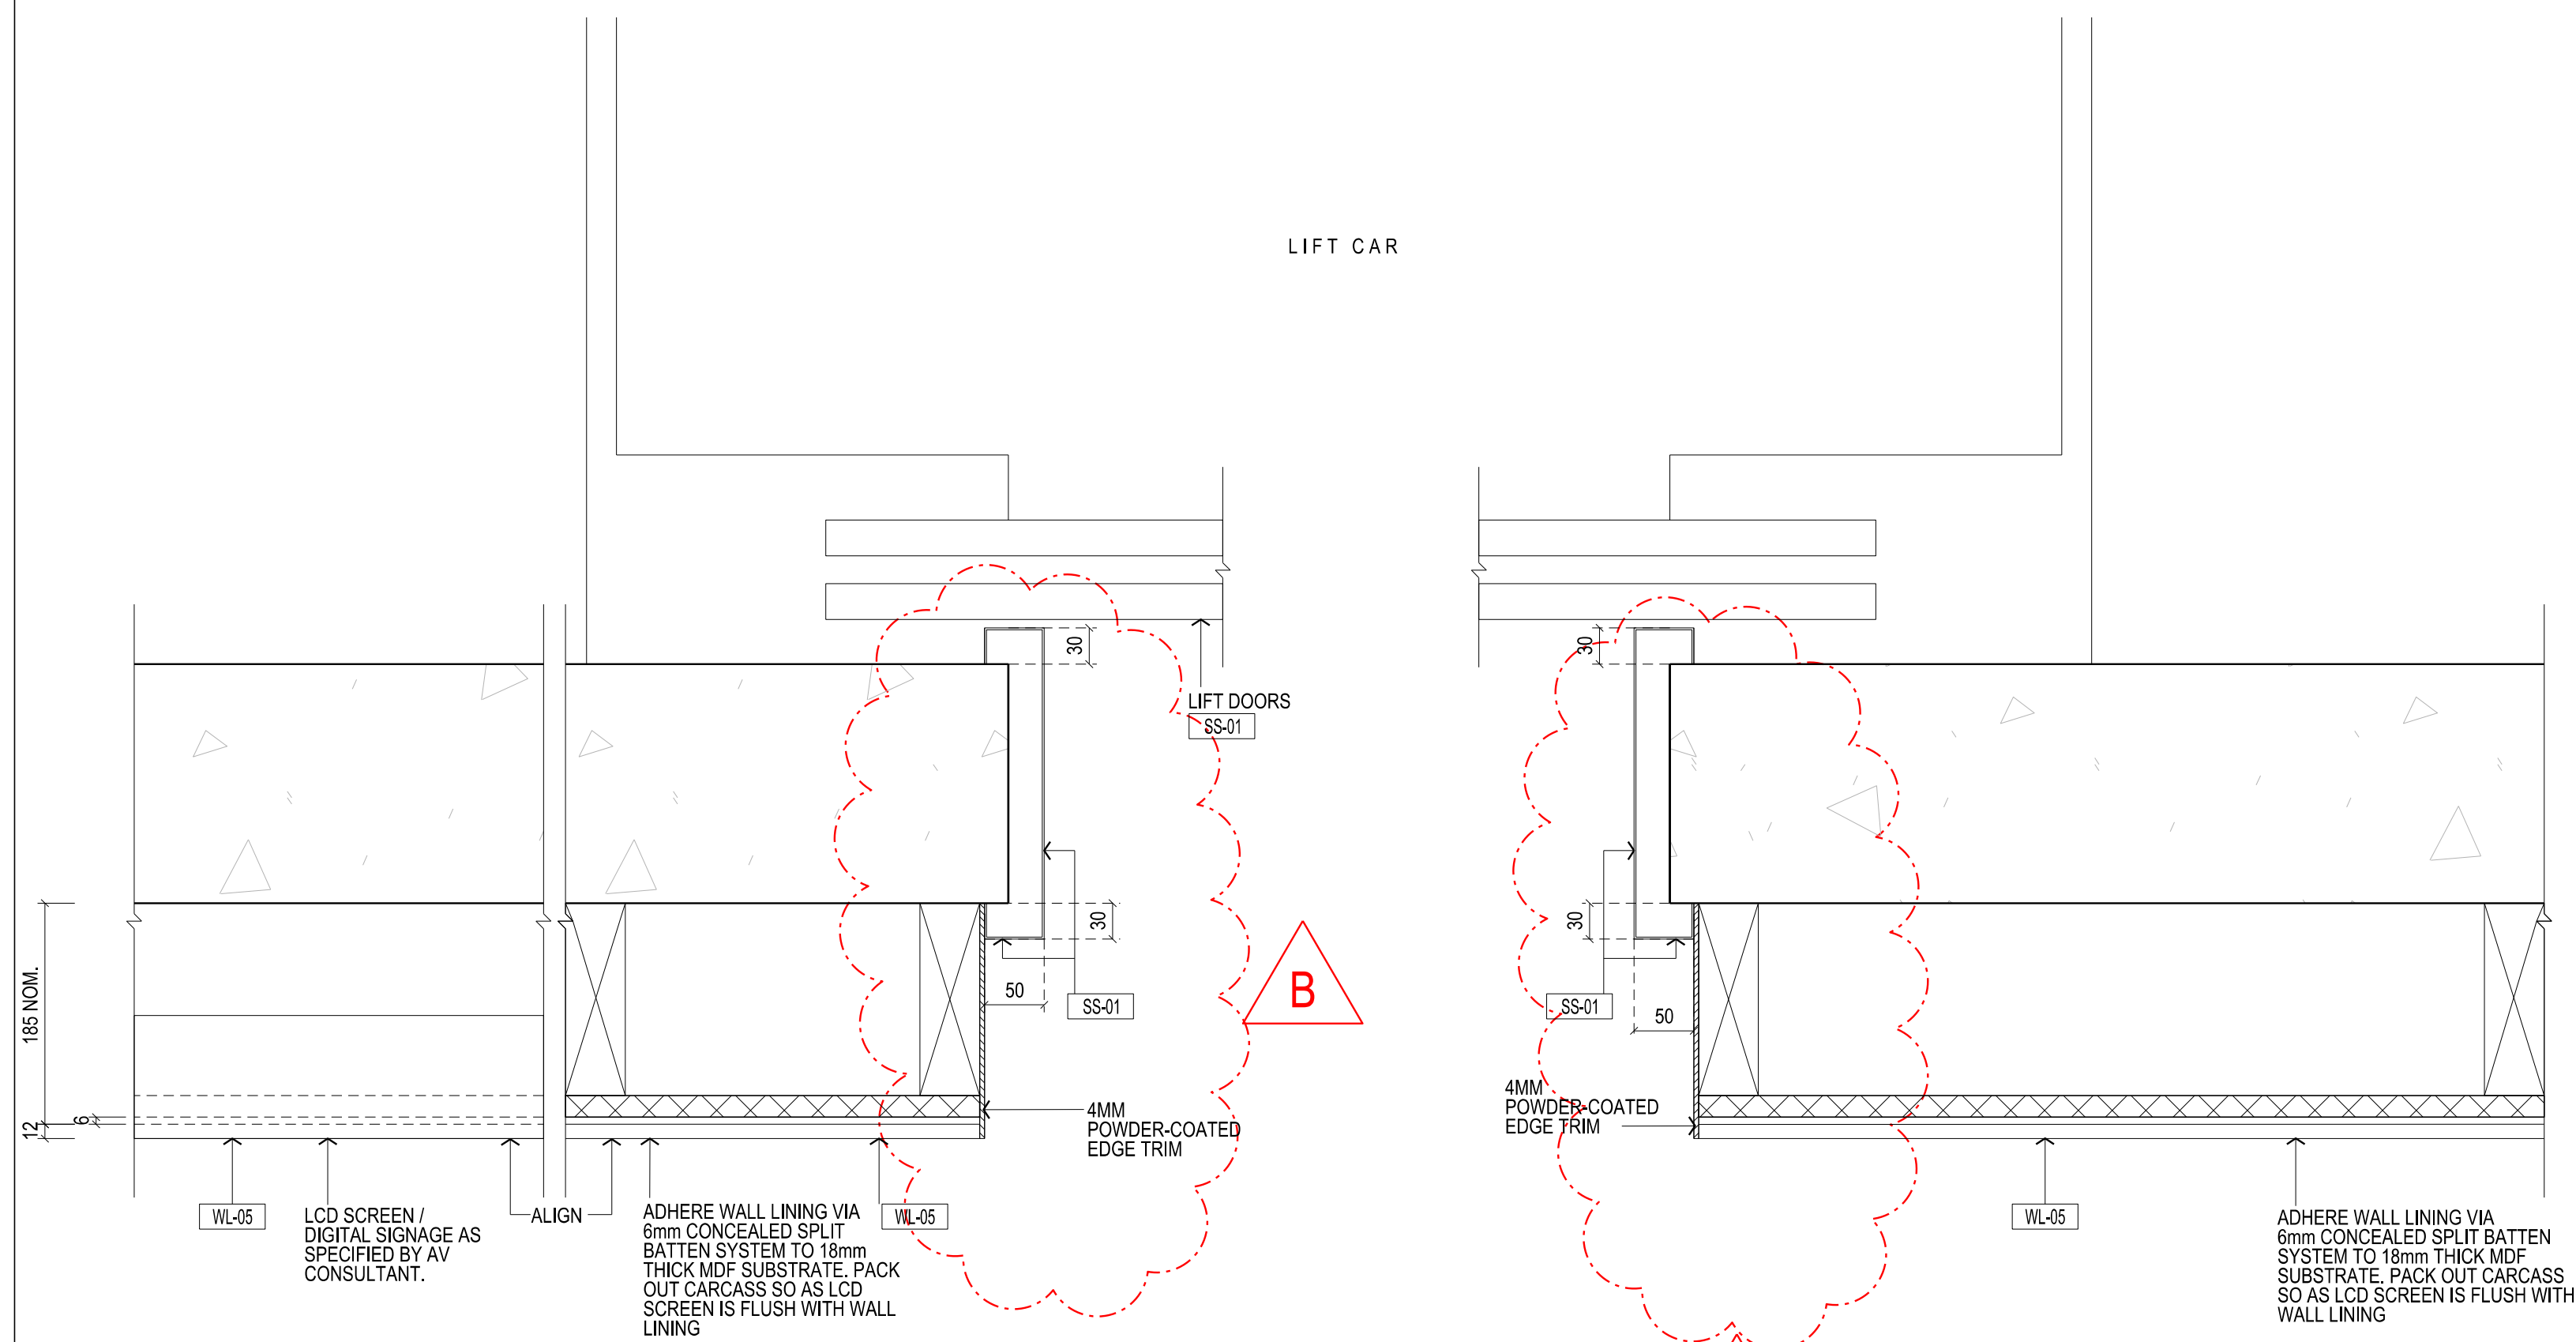


08 TYP. LIFT REVEAL DETAIL & WALL LINING JUNCTION AT LIFT JAMB DETAIL PLAN - LIFT LOBBY FOYER 1 GROUND FLOOR SCALE 1:5

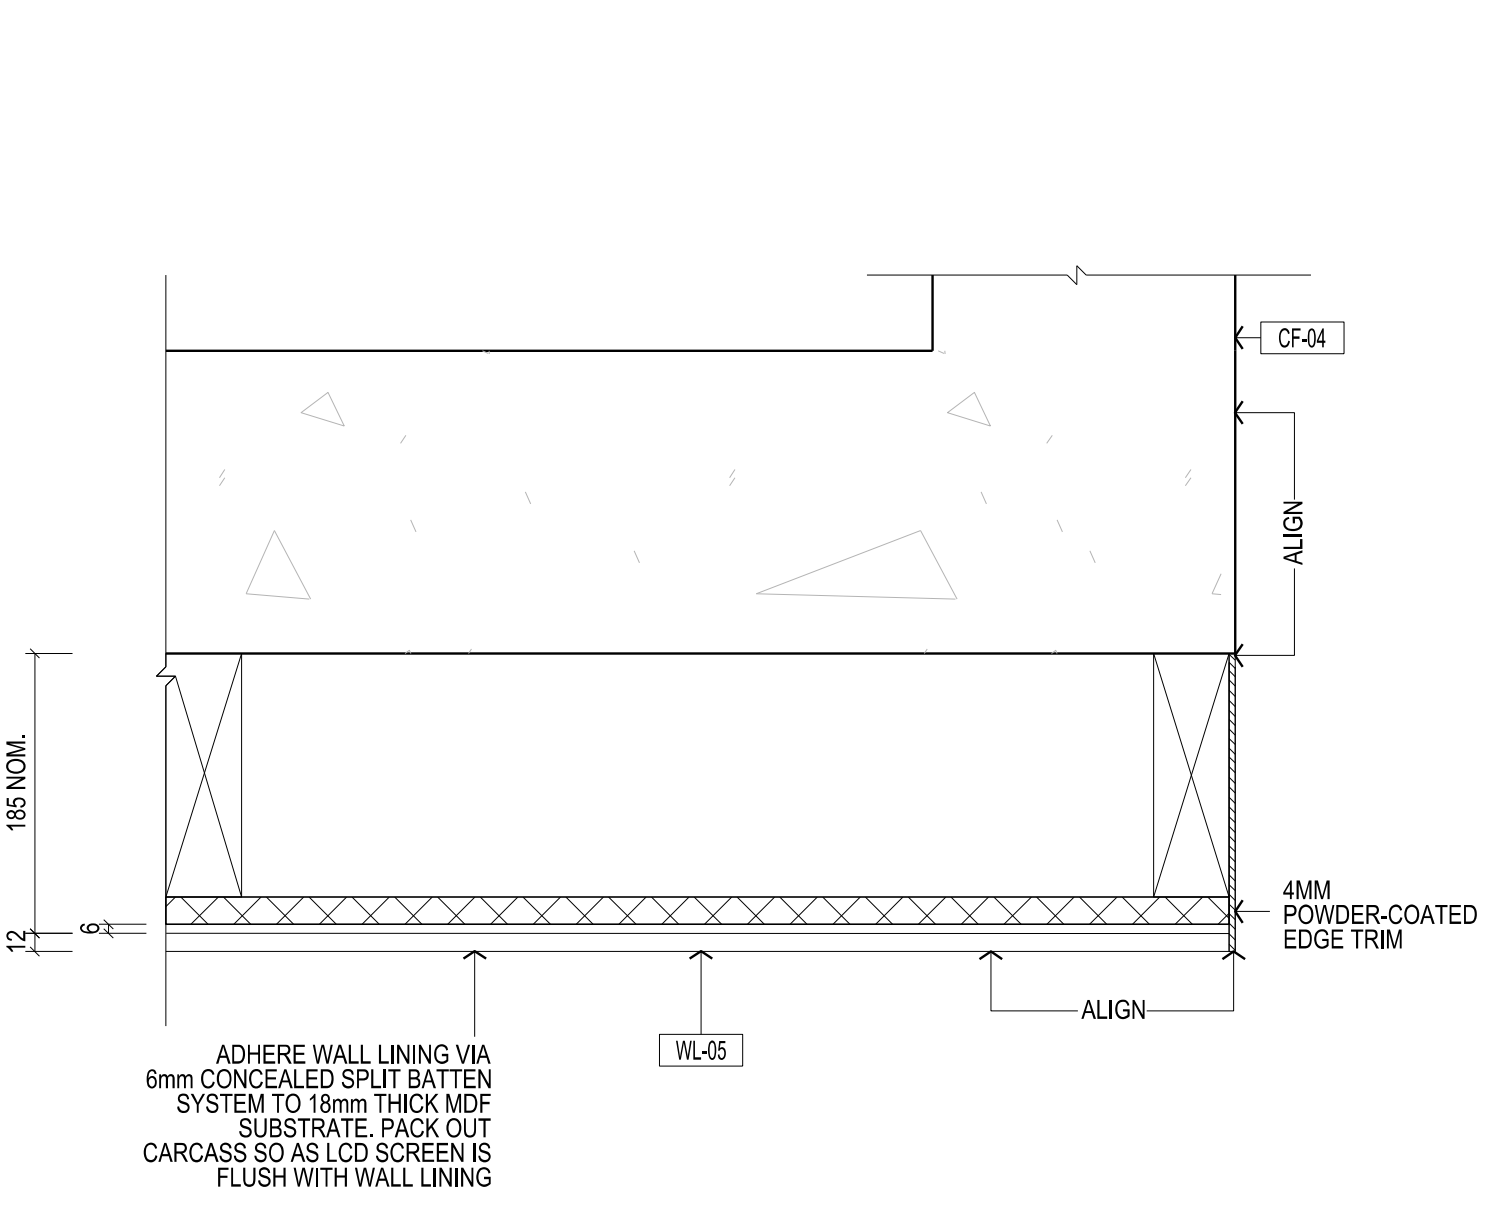


09 WALL LINING EDGE JUNCTION DETAIL PLAN - LIFT LOBBY FOYER 1 GROUND FLOOR SCALE 1:5

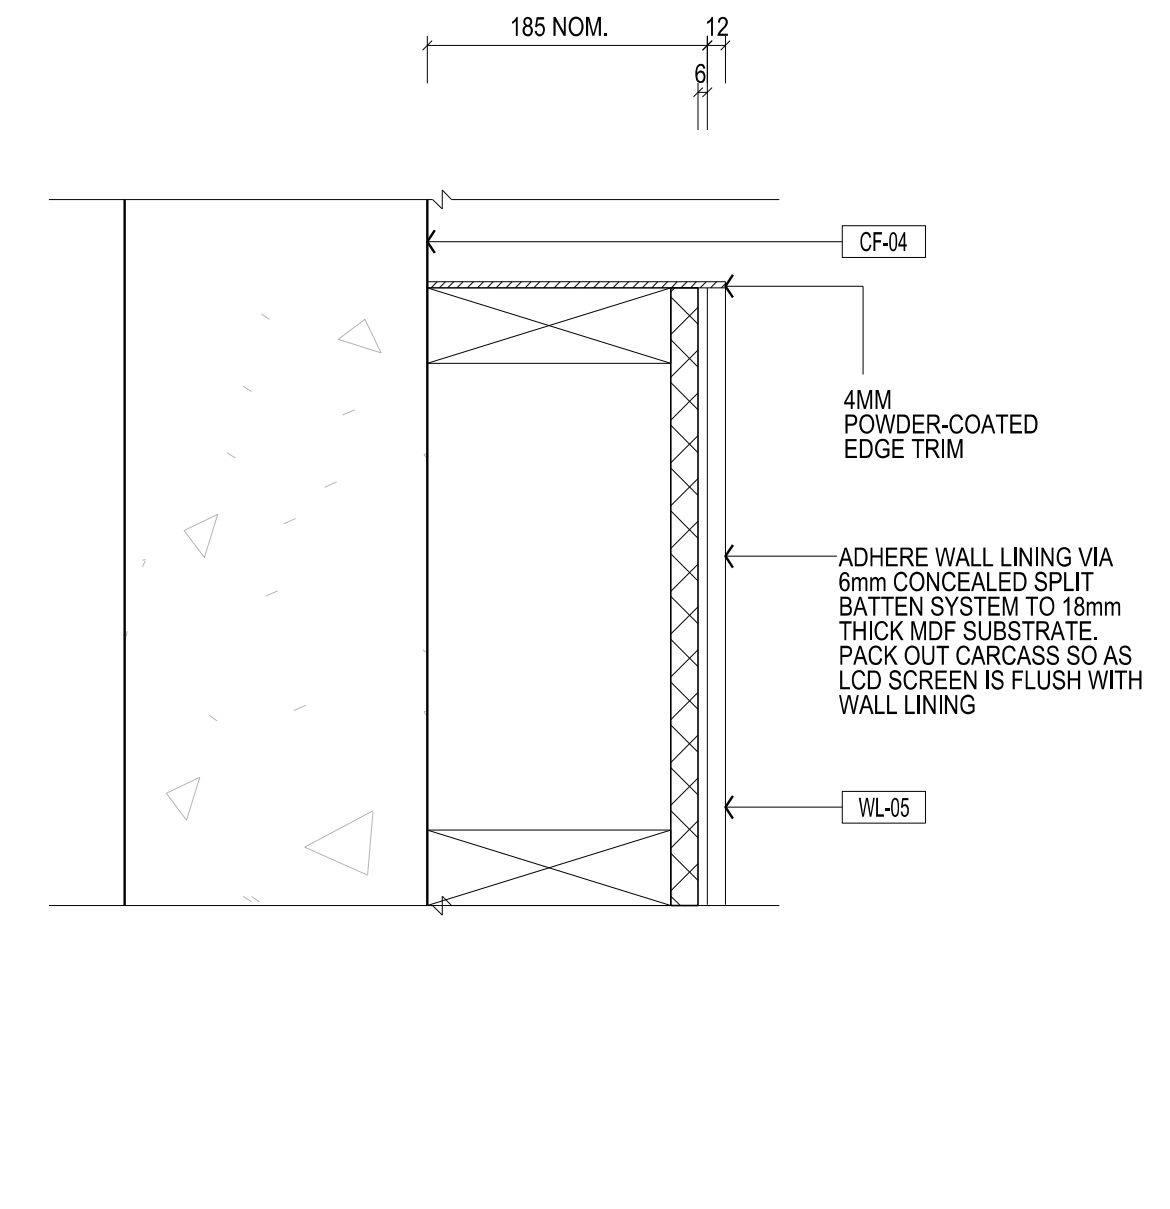


10 WALL LINING EDGE JUNCTION SECTION DETAIL - LIFT LOBBY FOYER 1 GROUND FLOOR SCALE 1:5

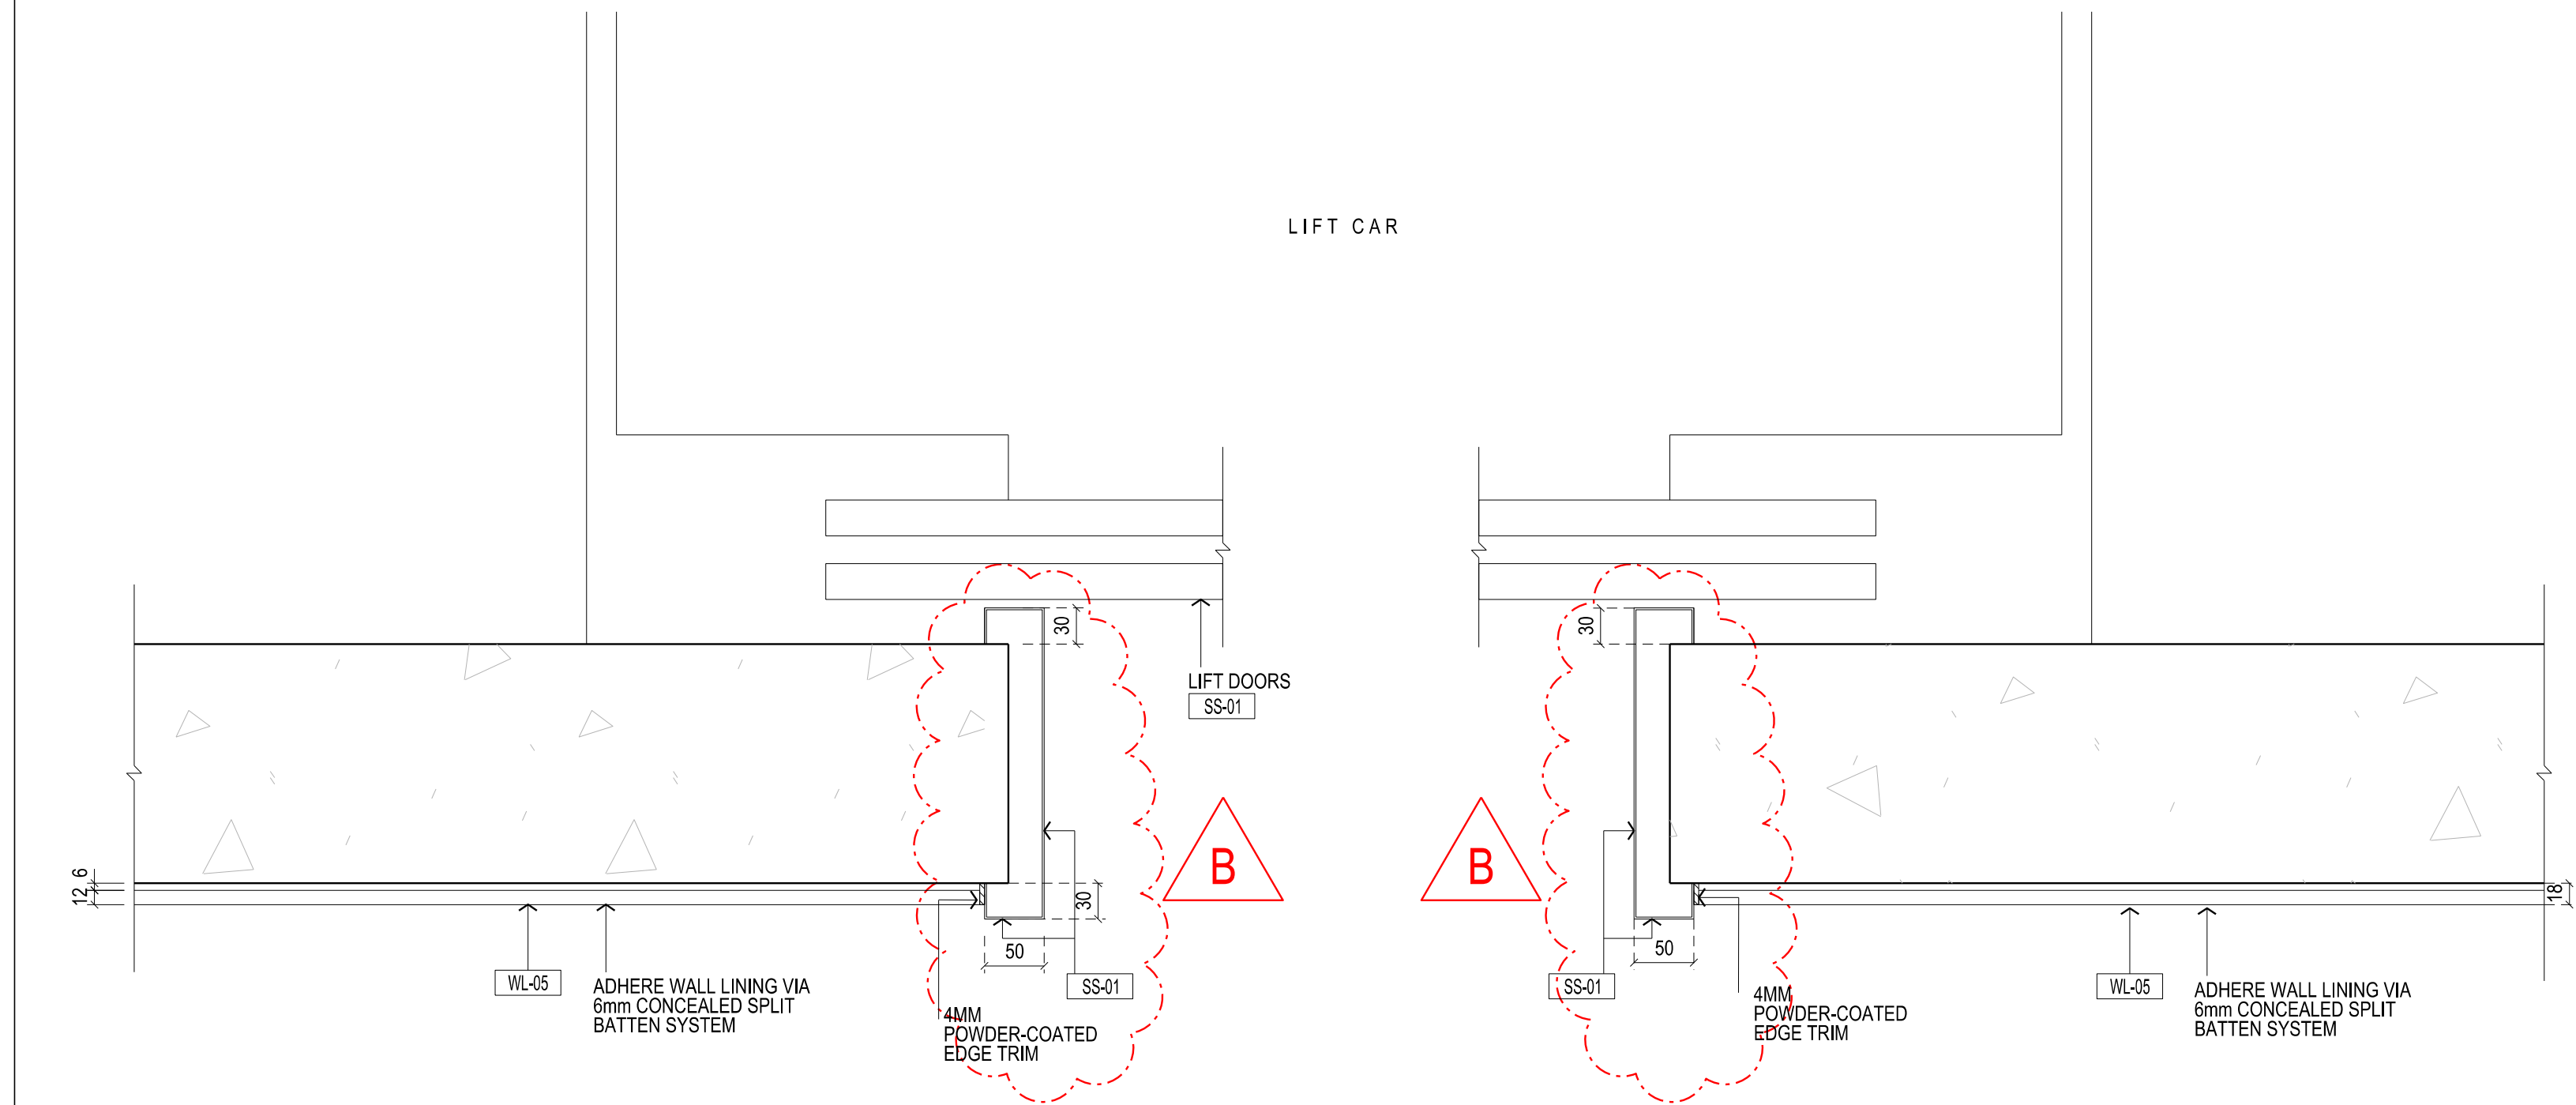

11 TYP. LIFT REVEAL DETAIL & WALL LINING JUNCTION AT LIFT JAMB DETAIL PLAN SCALE 1:5

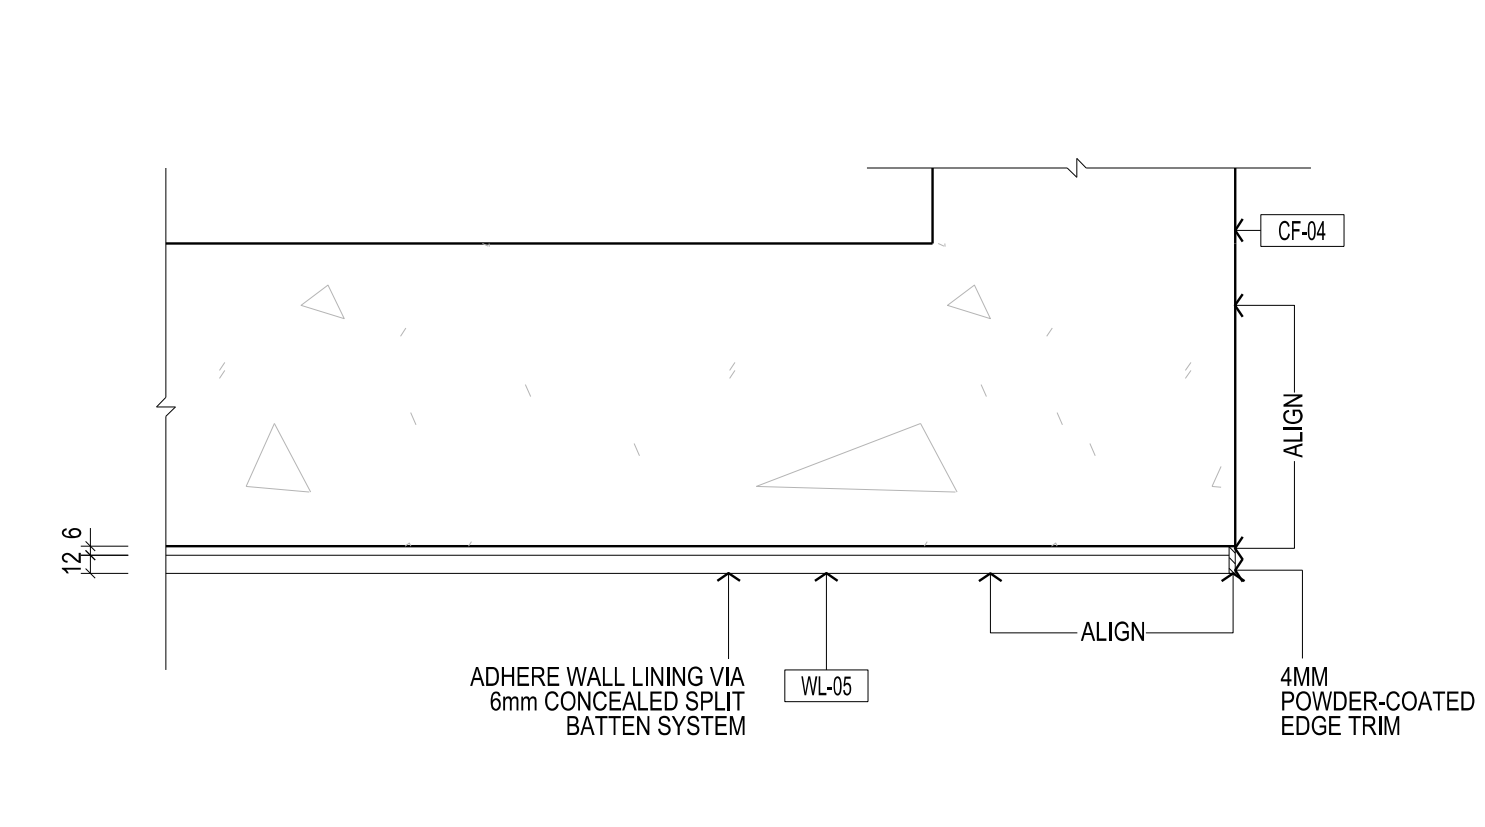

12 WALL LINING EDGE JUNCTION DETAIL PLAN SCALE 1:5

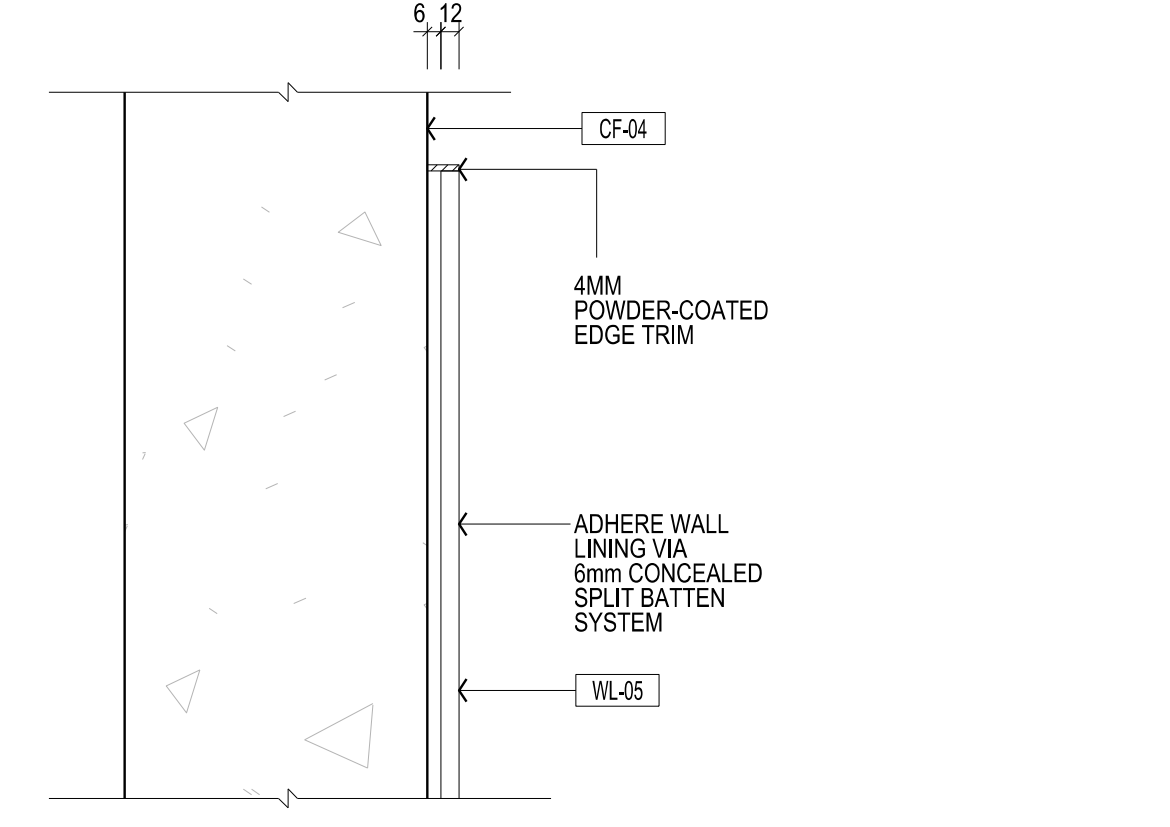

13 WALL LINING EDGE JUNCTION SECTION DETAIL SCALE 1:5

Rev	Issue	Revision Description	Amd	Date
B	SG	LIFT DOOR FRAMES UPDATED	-	24.10.13
A	SG	EDGE TRIM AMENDED	-	23.09.13
01	SG	TENDER ADJUDICUM NO. 05	-	15.10.12



NADAAA
 NADAAA
 1020 Washington Street No.2 Boston Massachusetts 02118 USA
 Telephone +1 817 442 8232 Facsimile +1 888 442 1417 Email nadaaa@nadaaa.com

John Wardle Architects
 25 Rokeby Street, Collingwood, Victoria 3066 Australia
 Tel: +61 3 8662 0400 www.johnwardlearchitects.com
 © 2012 John Wardle Architects ABN 83 006 814 268

Client **University of Melbourne Parkville Campus**
 Project **Faculty of Architecture Building and Planning**
 Title **TYPICAL LIFT REVEAL EDGE JUNCTION DETAILS**

Project No.	0913	Scale	1:20 @ A0 1:100 @ A2
Drawing No.	AR5202	Revision	B
Date	Jan 2012	Dwn	-
Co-Ord	-	Chk	-

FILENAME - \$FILES
FOR CONSTRUCTION