




01 PLAN - CORE 1 TYPICAL - LEVEL 02, 03 & 04  
SCALE 1:50

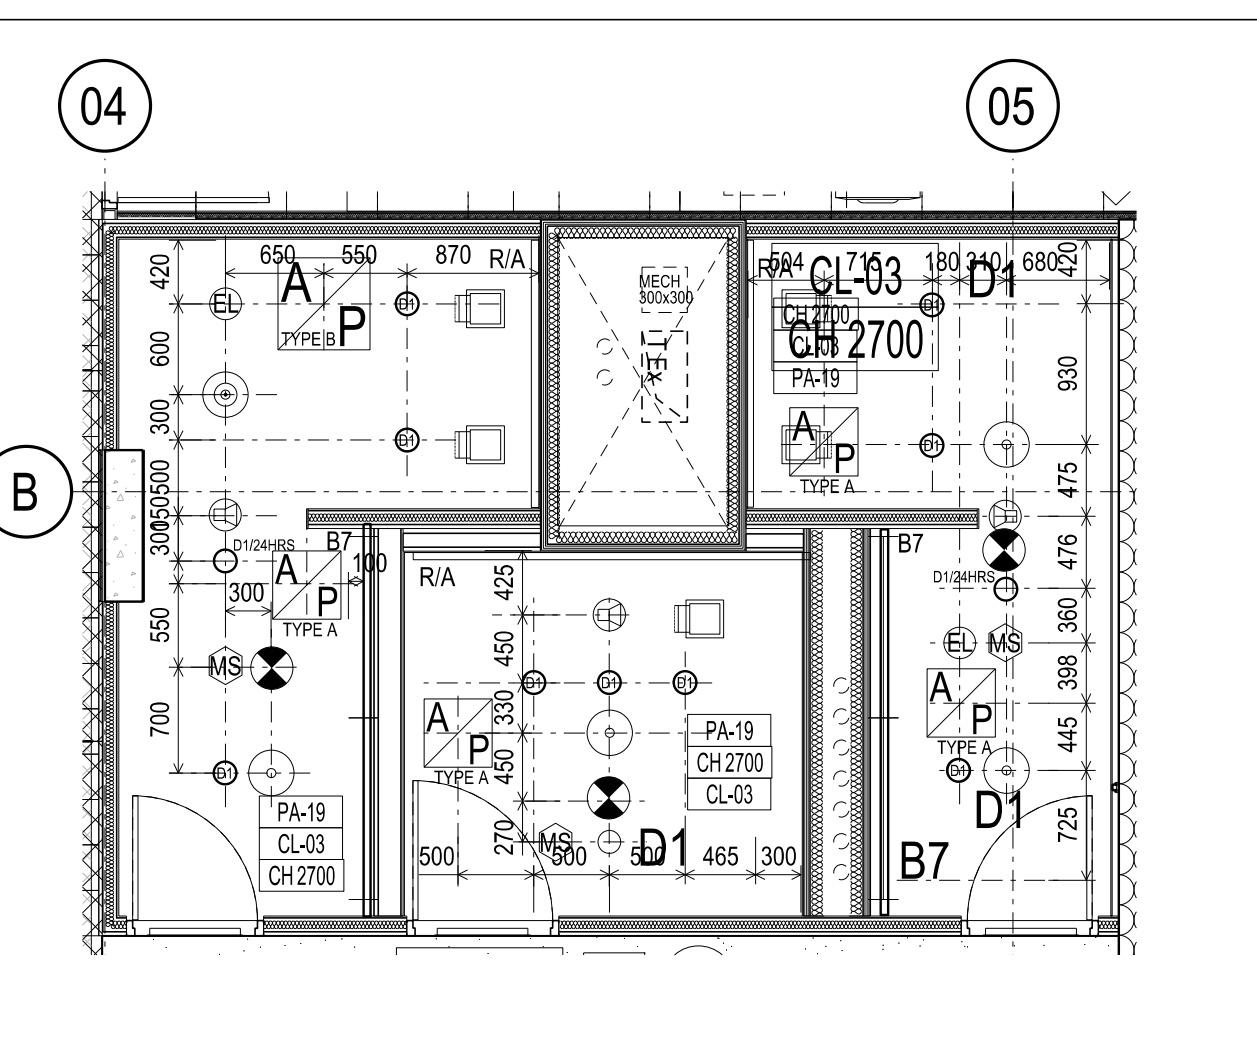


02 REFLECTED CEILING PLAN - CORE 1 TYPICAL - LEVEL 02, 03 & 04  
SCALE 1:50

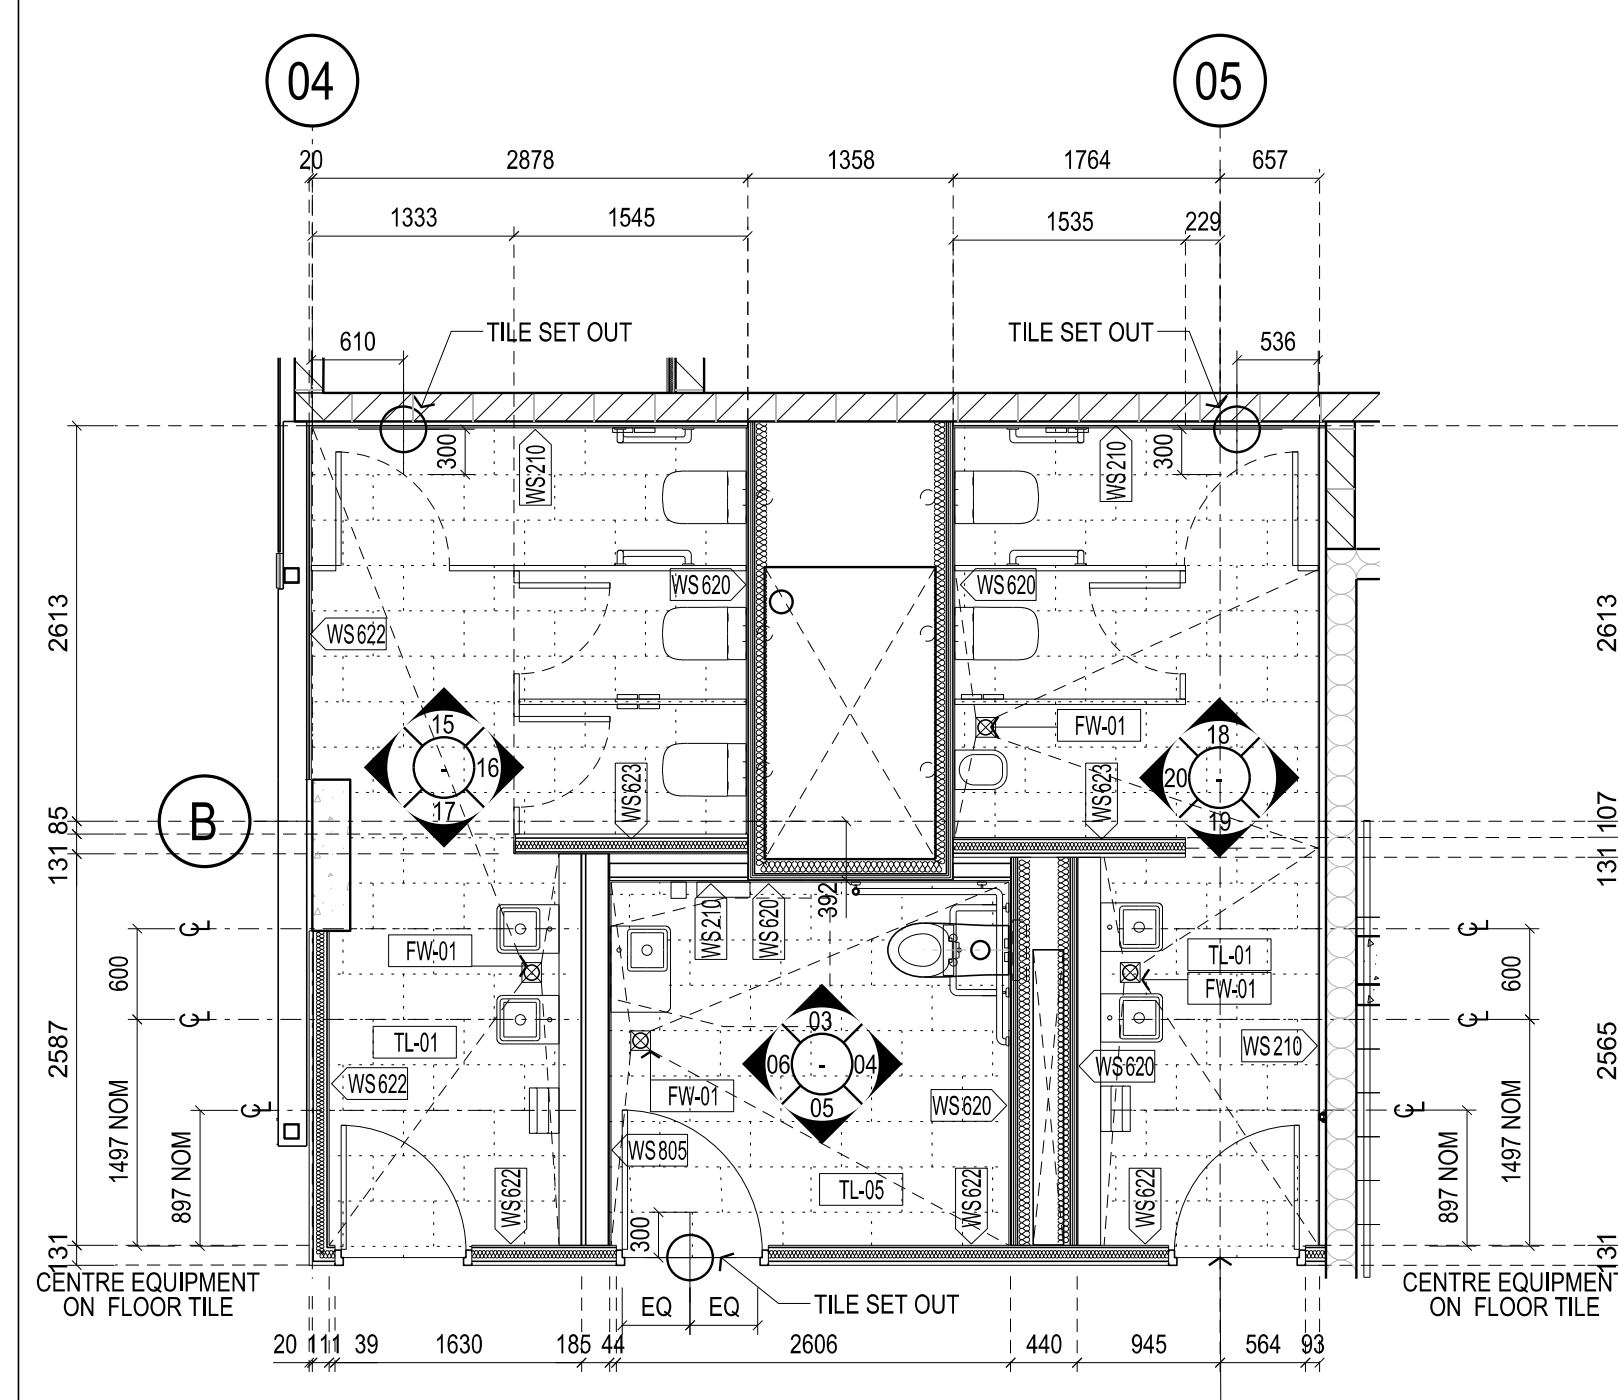


13 PLAN - CORE 1 - G01  
SCALE 1:50

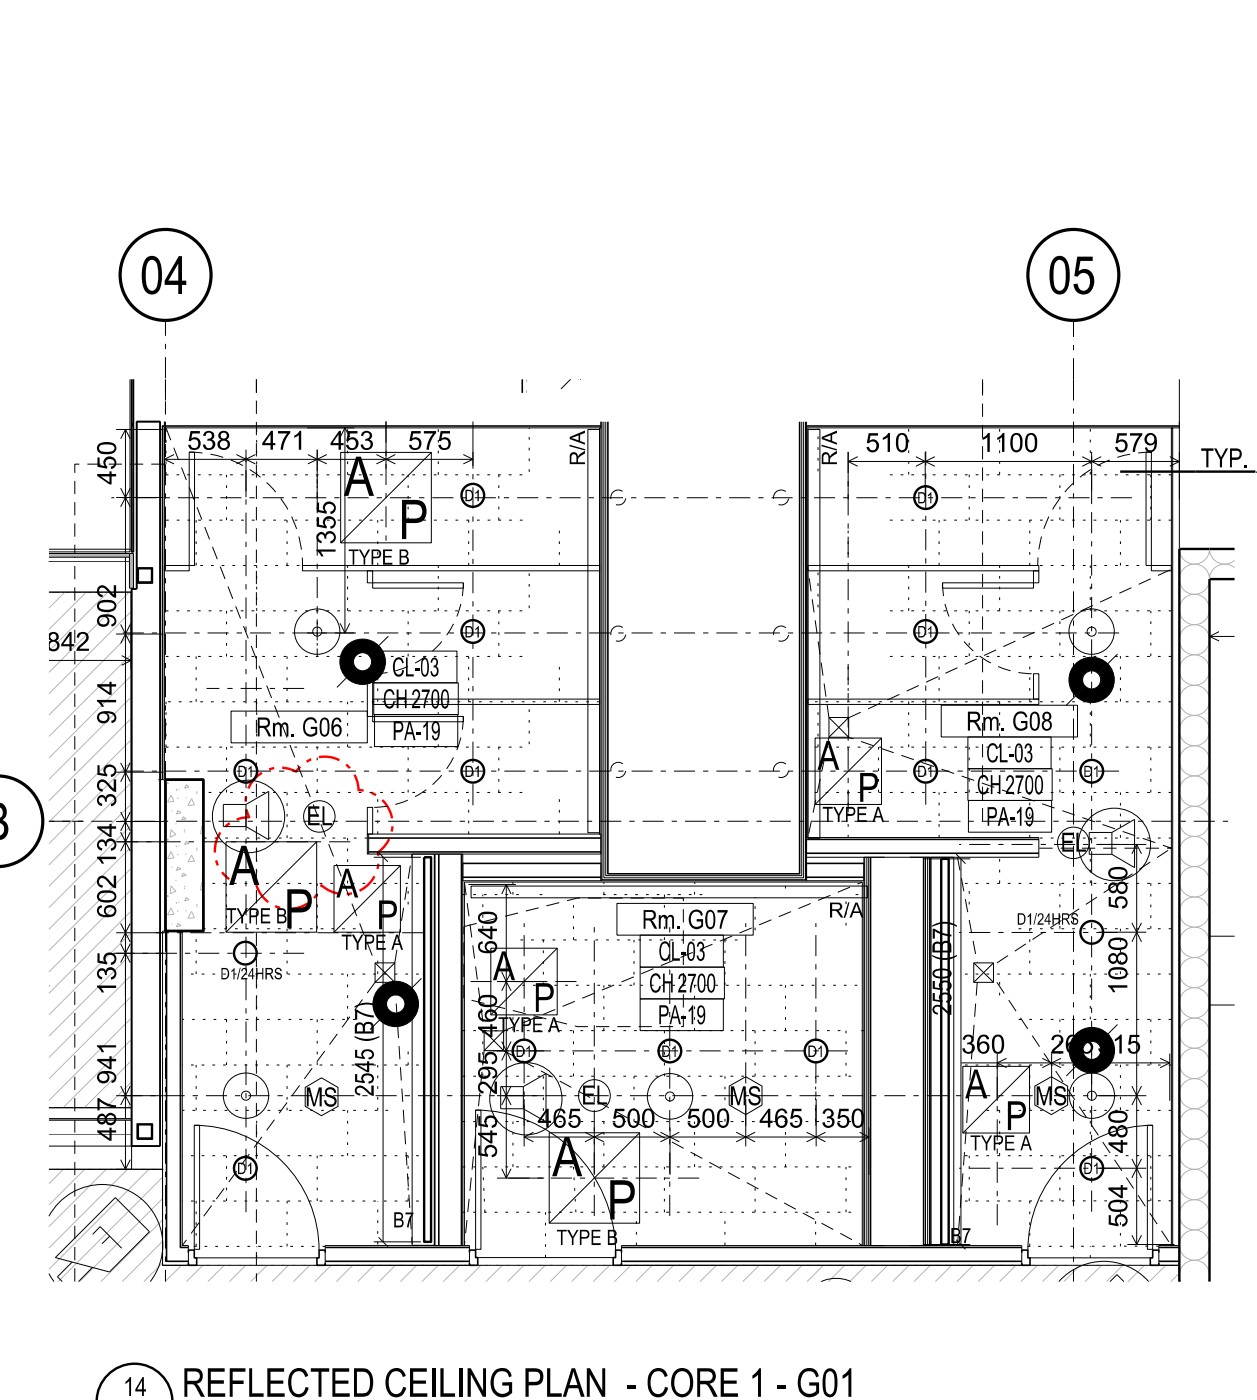


14 REFLECTED CEILING PLAN - CORE 1 - G01  
SCALE 1:50

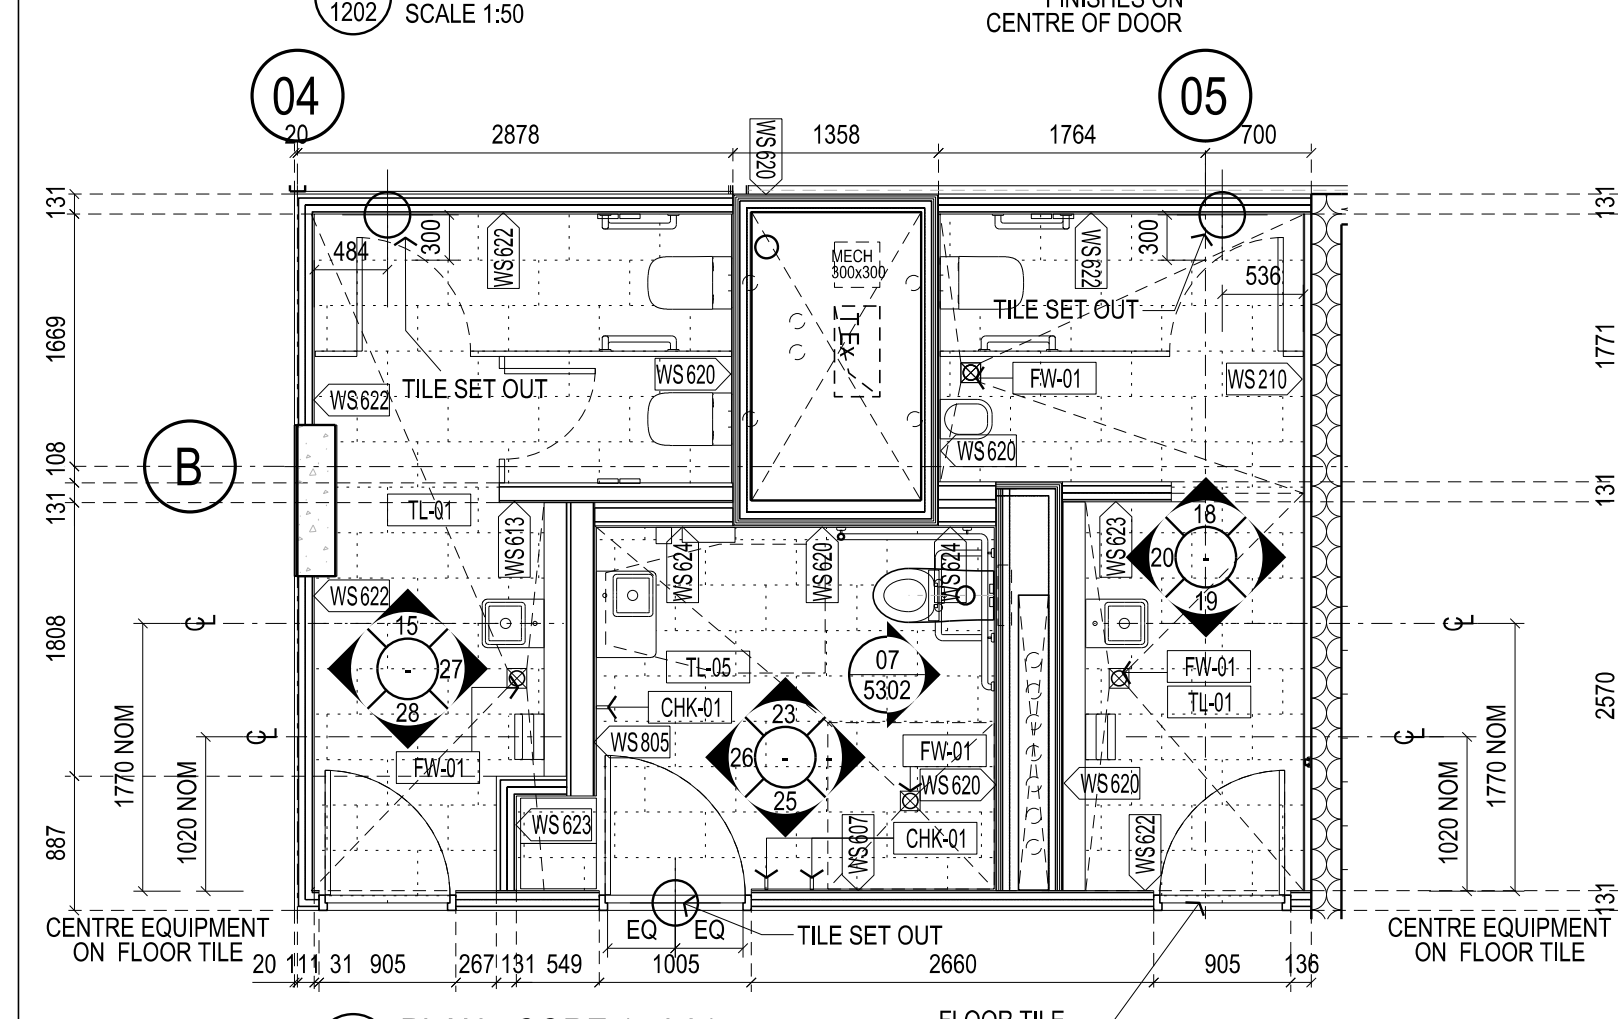


21 PLAN - CORE 1 - L01  
SCALE 1:50

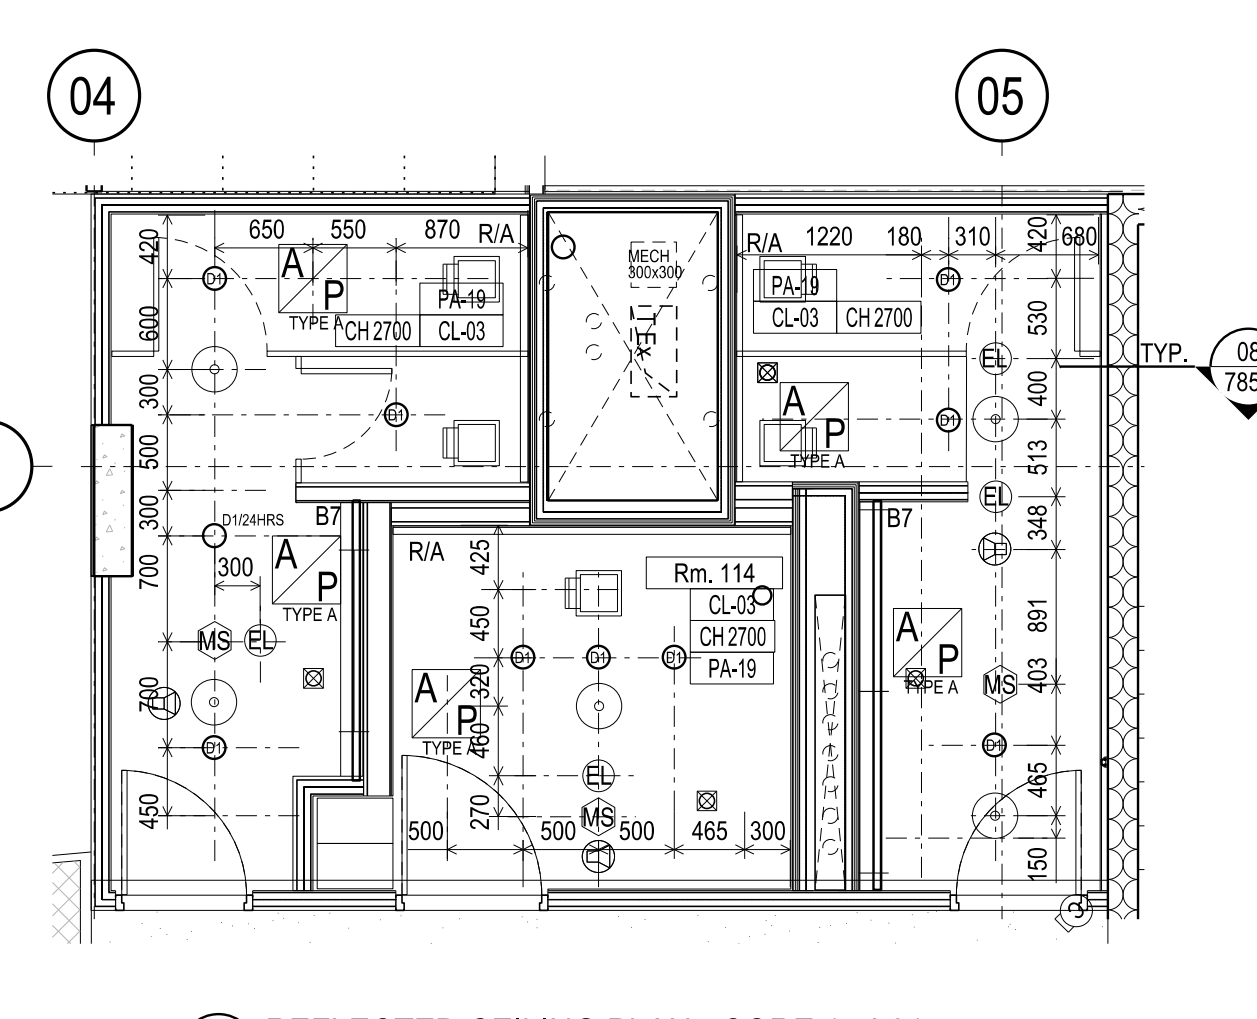


22 REFLECTED CEILING PLAN - CORE 1 - L01  
SCALE 1:50

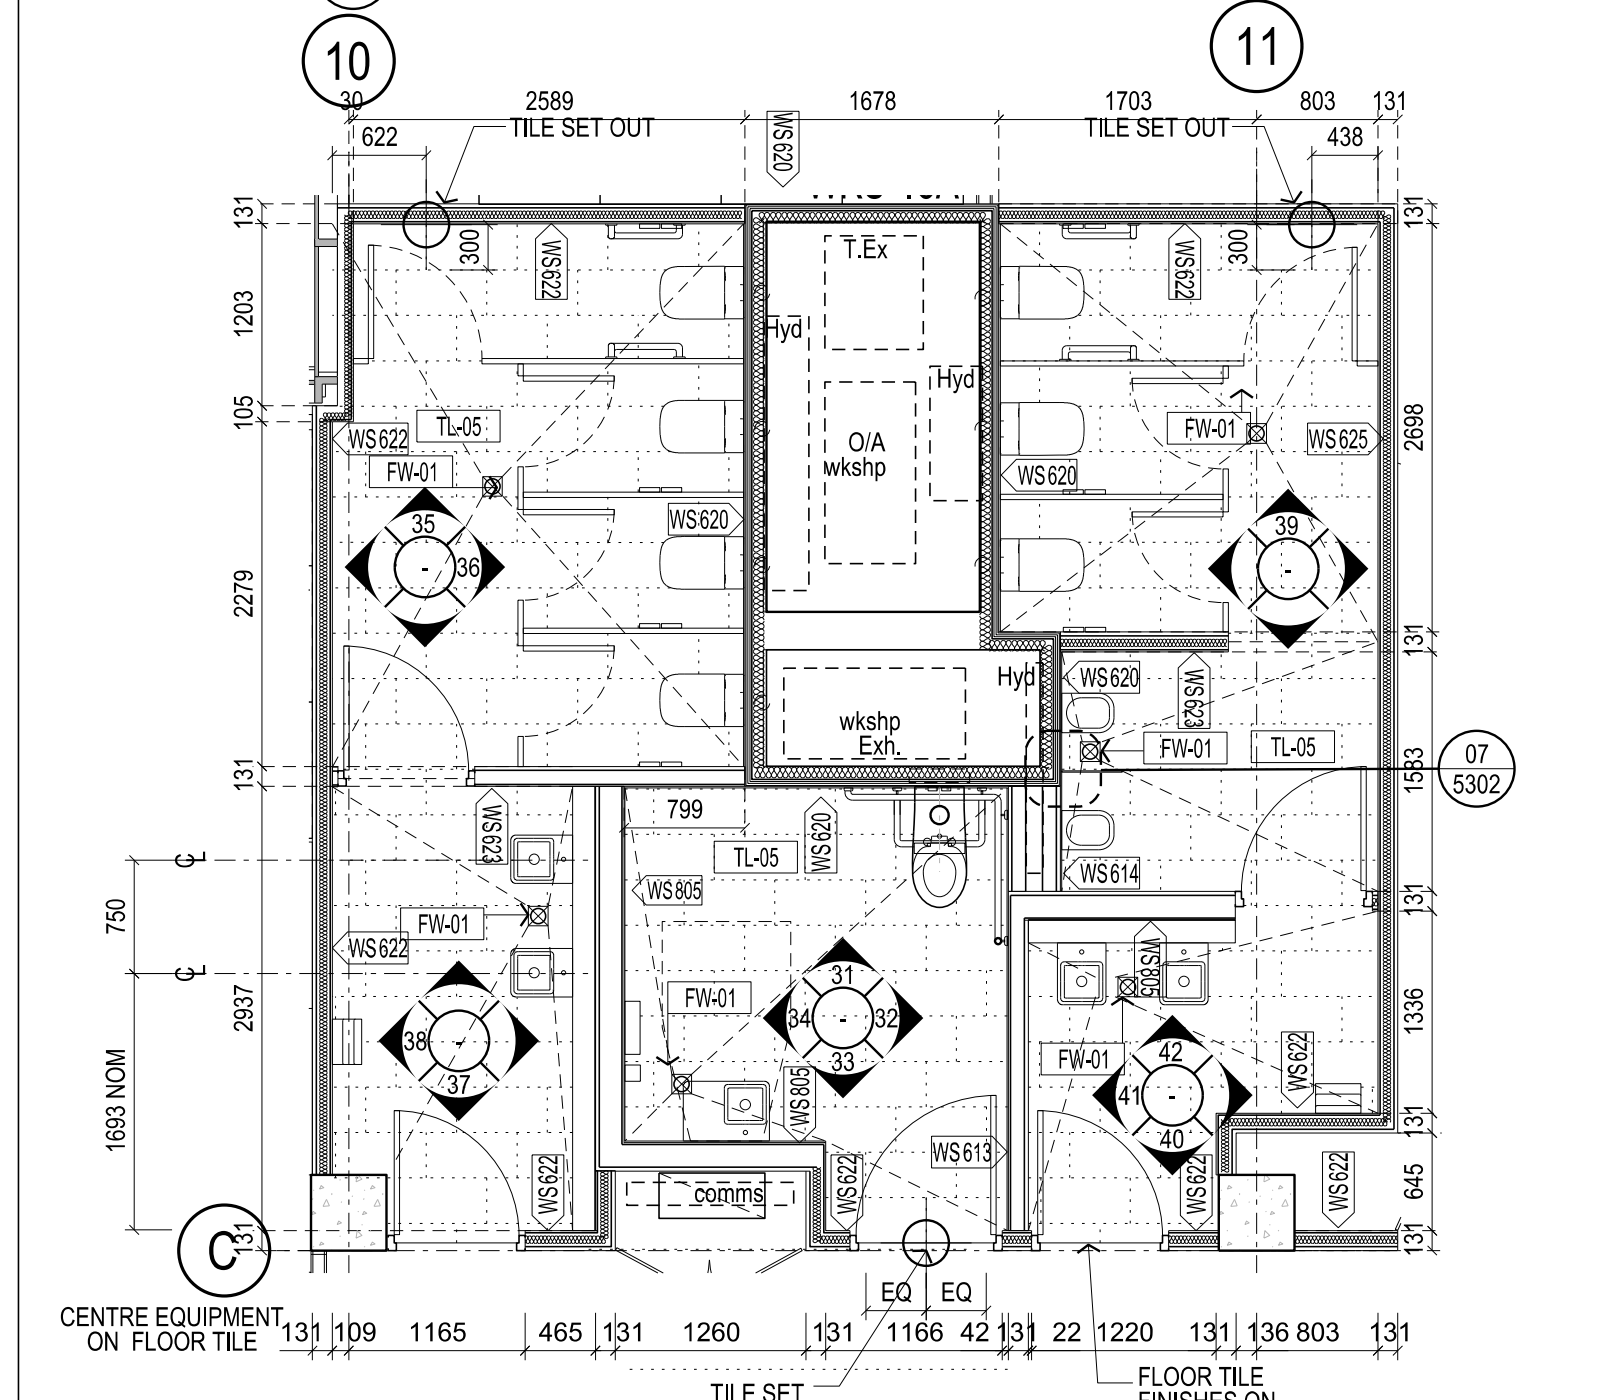


29 PLAN - CORE 4 TYPICAL - LEVEL 03 & 04  
SCALE 1:50

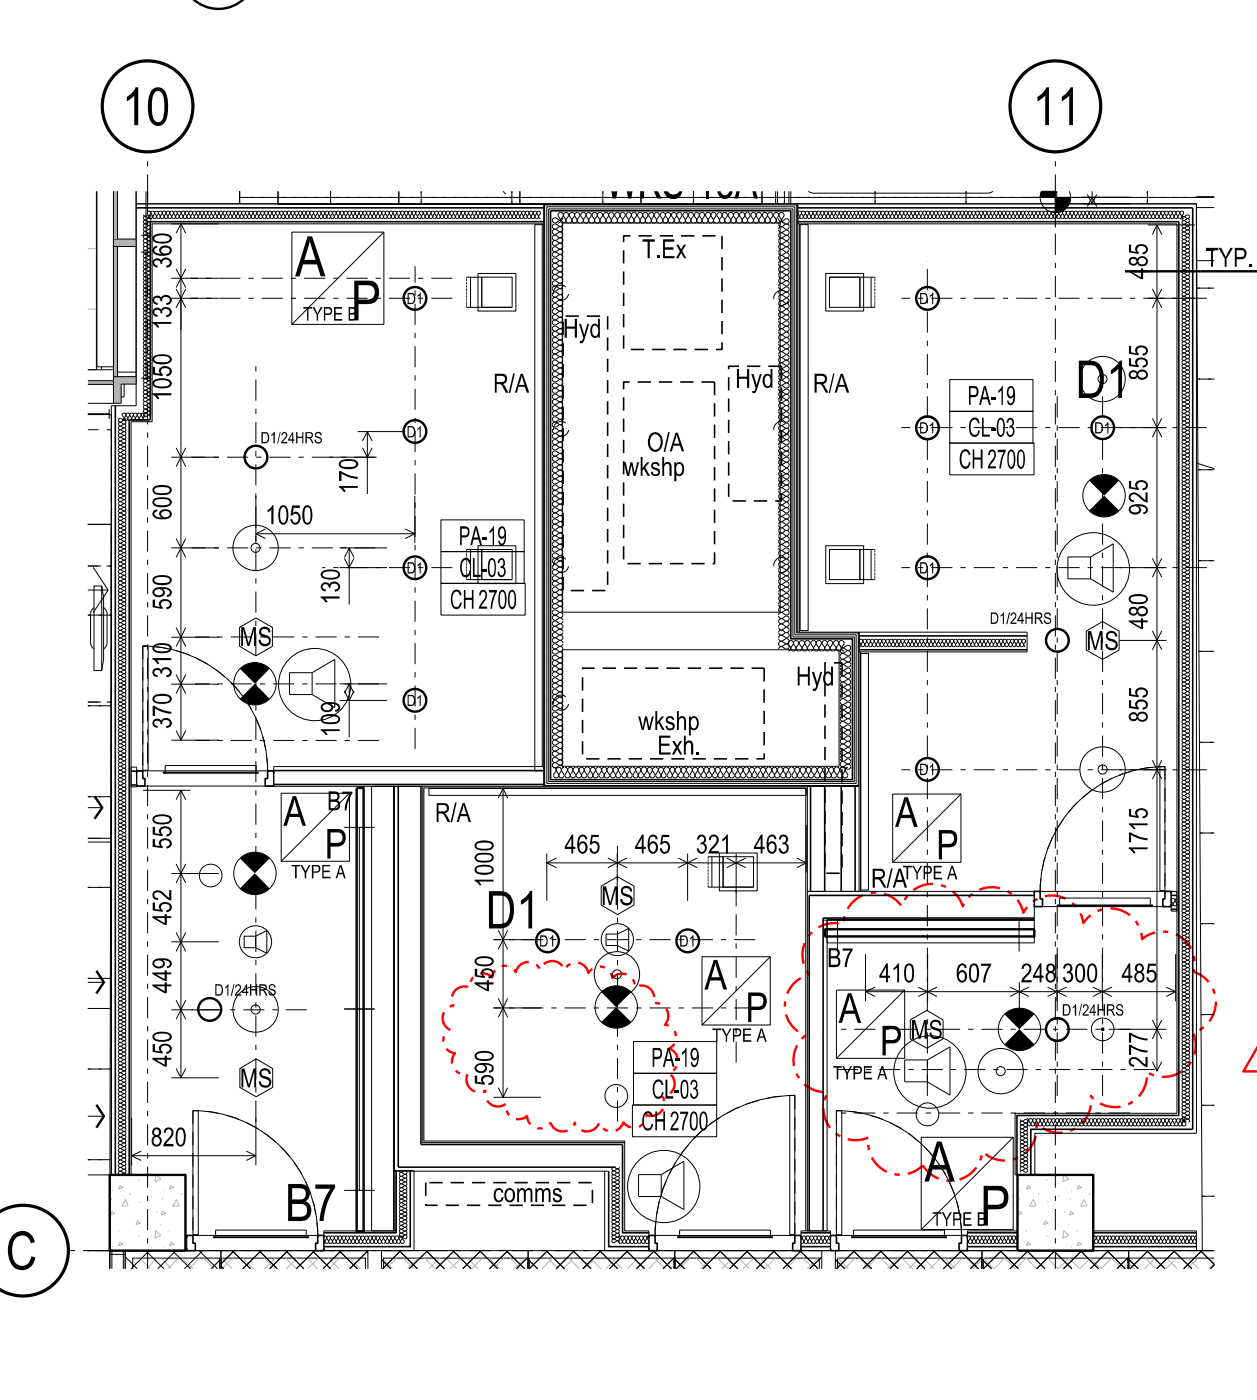


30 REFLECTED CEILING PLAN - CORE 4 TYPICAL - LEVEL 03, 04  
SCALE 1:50

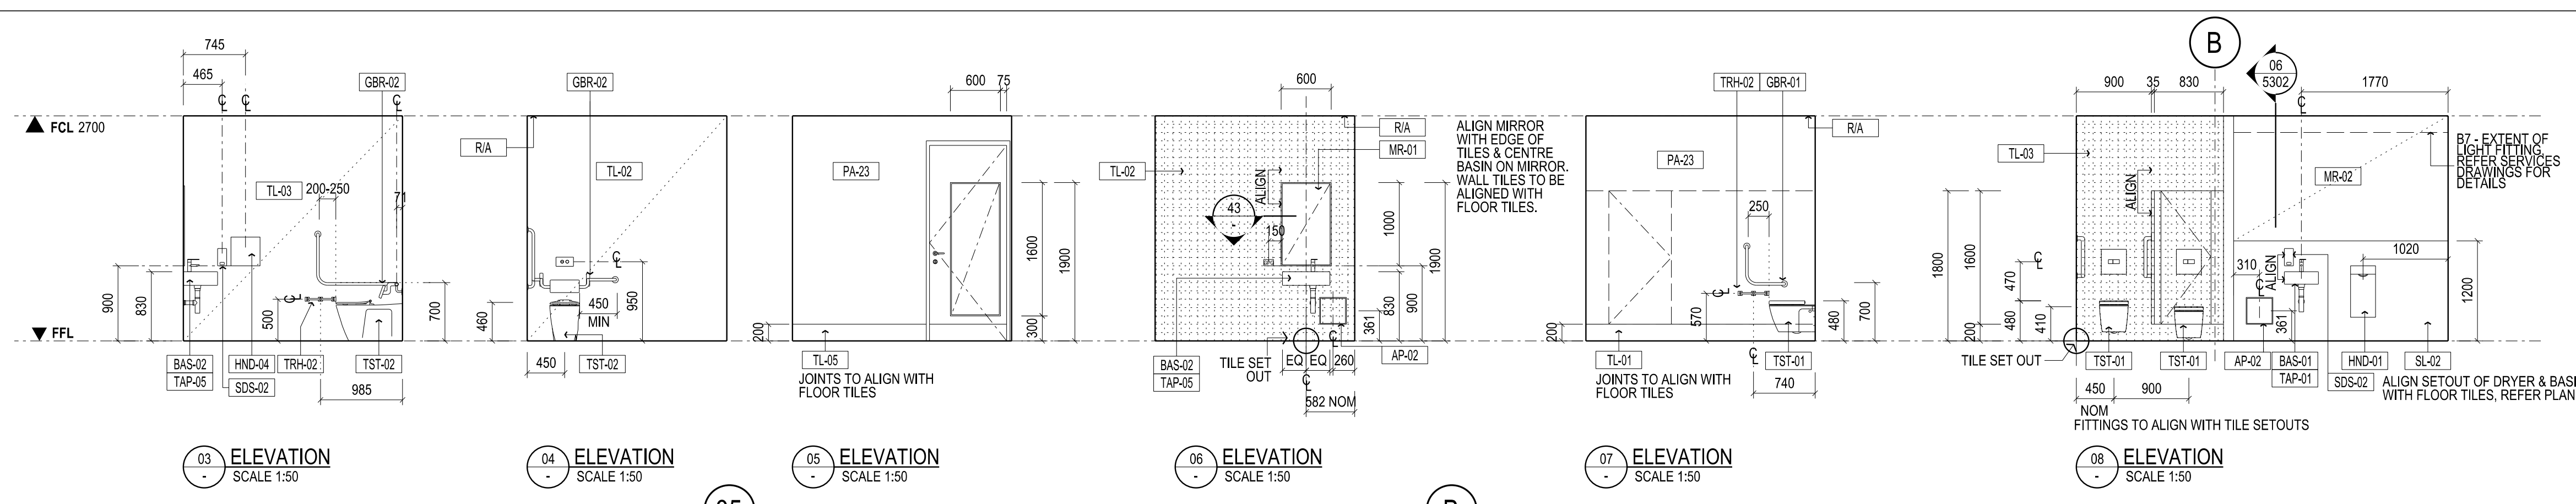


03 ELEVATION SCALE 1:50  
04 ELEVATION SCALE 1:50  
05 ELEVATION SCALE 1:50  
06 ELEVATION SCALE 1:50  
07 ELEVATION SCALE 1:50  
08 ELEVATION SCALE 1:50

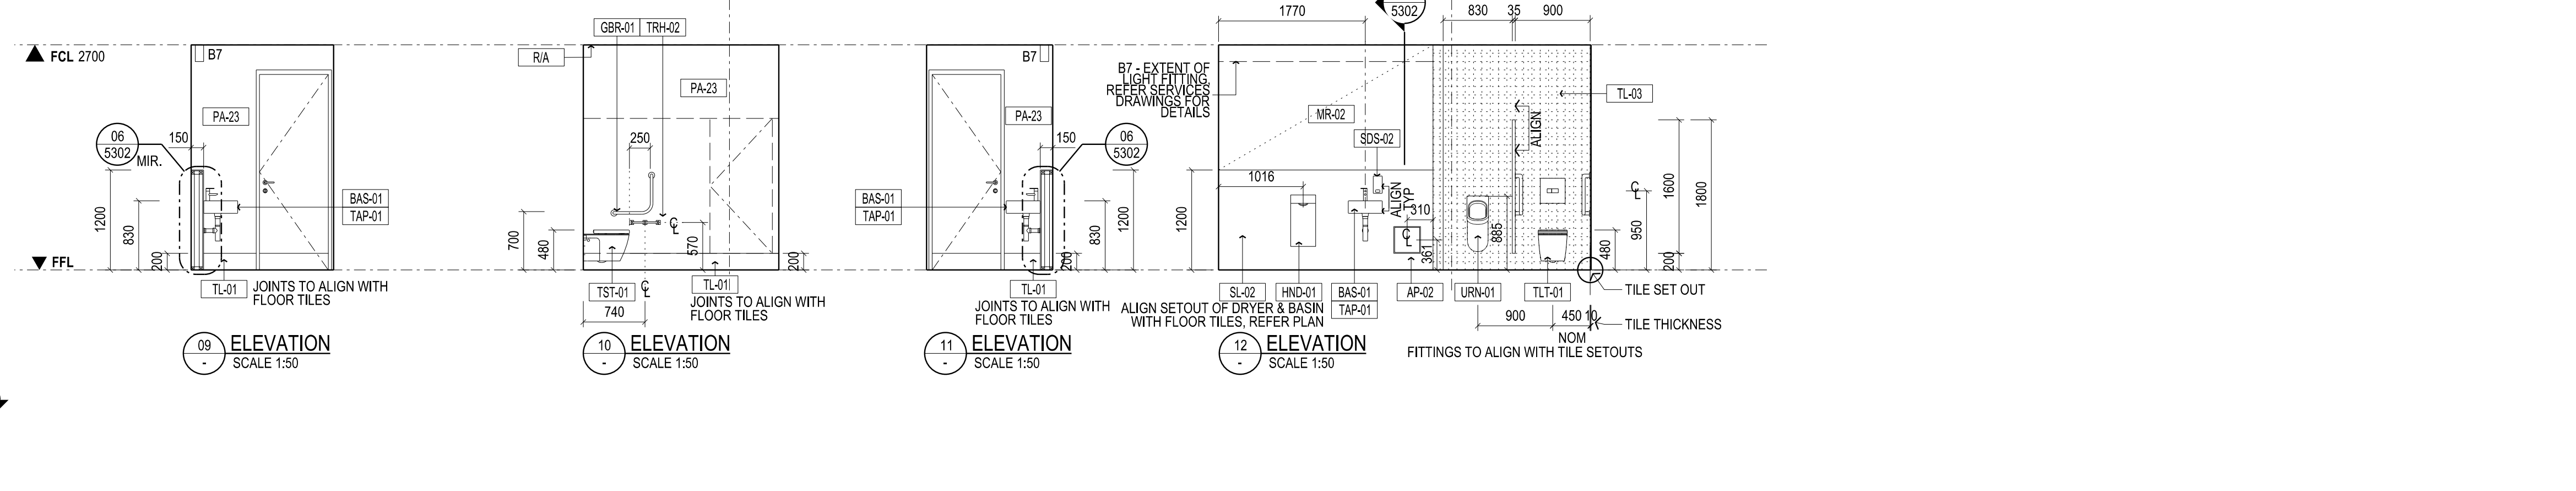


09 ELEVATION SCALE 1:50  
10 ELEVATION SCALE 1:50  
11 ELEVATION SCALE 1:50  
12 ELEVATION SCALE 1:50  
13 ELEVATION SCALE 1:50  
14 ELEVATION SCALE 1:50

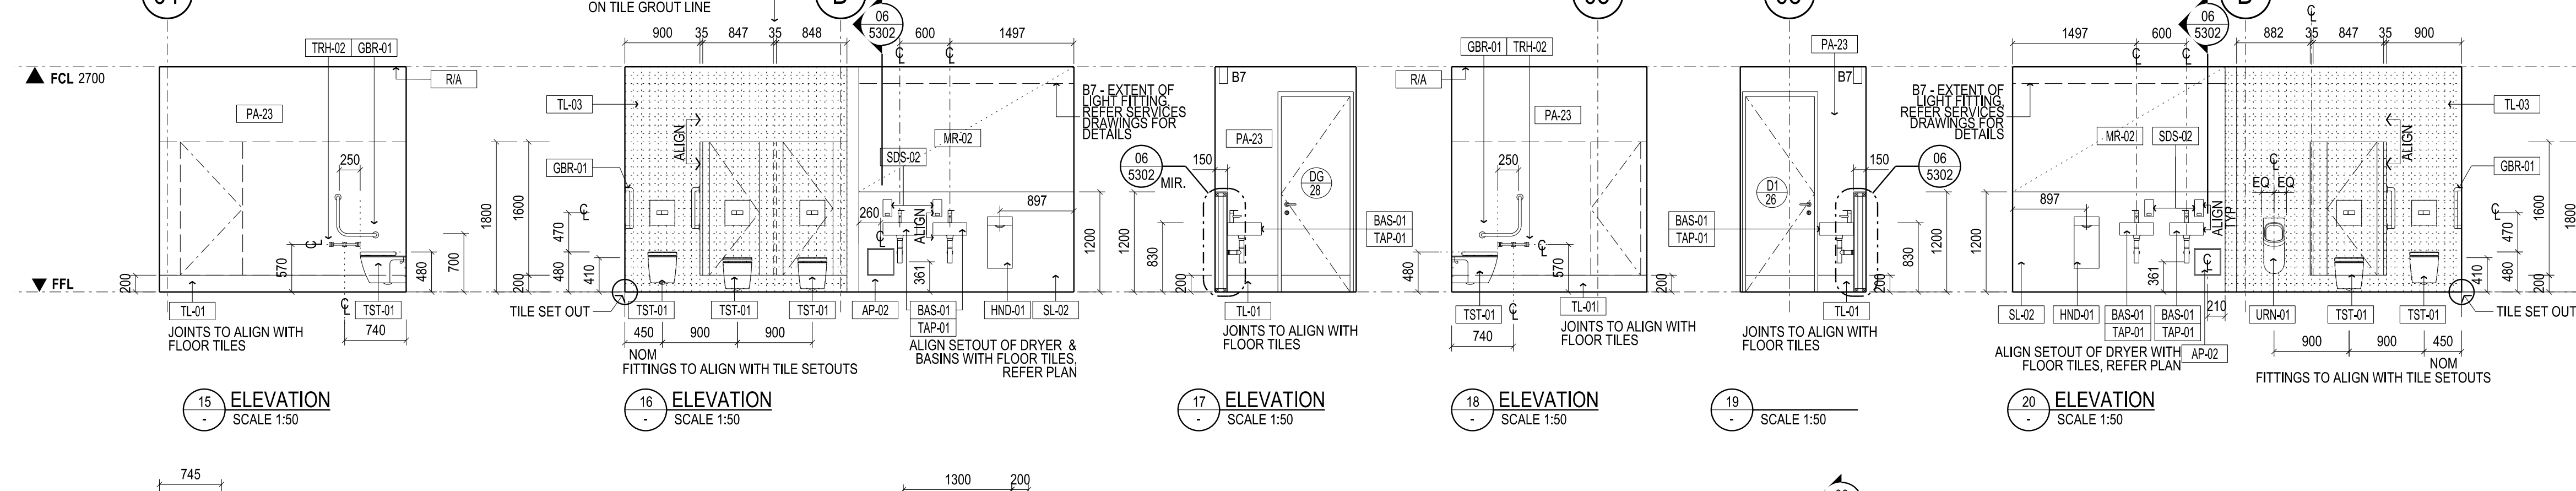


15 ELEVATION SCALE 1:50  
16 ELEVATION SCALE 1:50  
17 ELEVATION SCALE 1:50  
18 ELEVATION SCALE 1:50  
19 ELEVATION SCALE 1:50  
20 ELEVATION SCALE 1:50

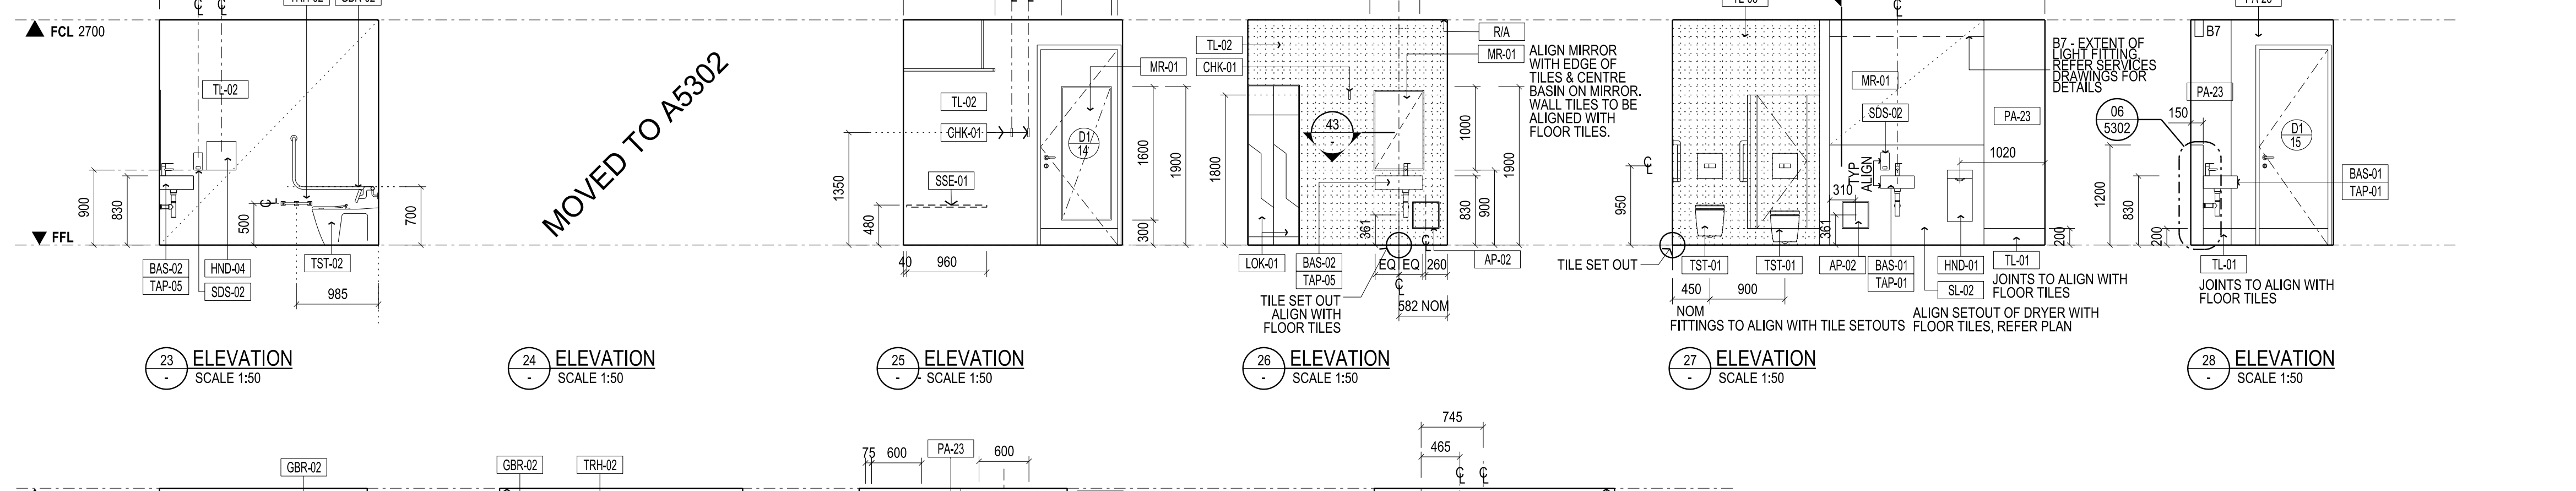


23 ELEVATION SCALE 1:50  
24 ELEVATION SCALE 1:50  
25 ELEVATION SCALE 1:50  
26 ELEVATION SCALE 1:50  
27 ELEVATION SCALE 1:50  
28 ELEVATION SCALE 1:50

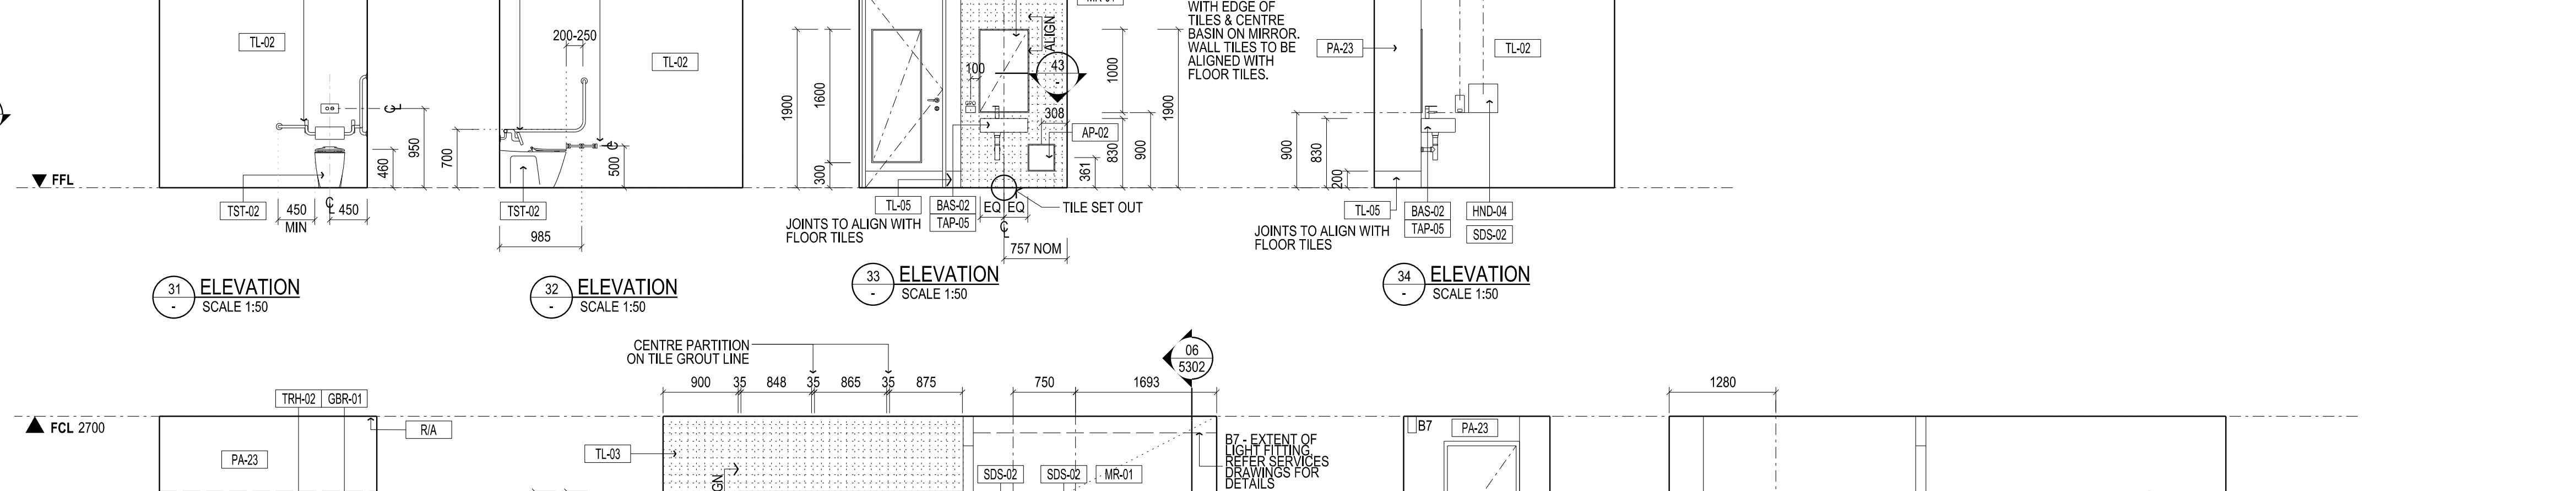

31 ELEVATION SCALE 1:50  
32 ELEVATION SCALE 1:50  
33 ELEVATION SCALE 1:50  
34 ELEVATION SCALE 1:50

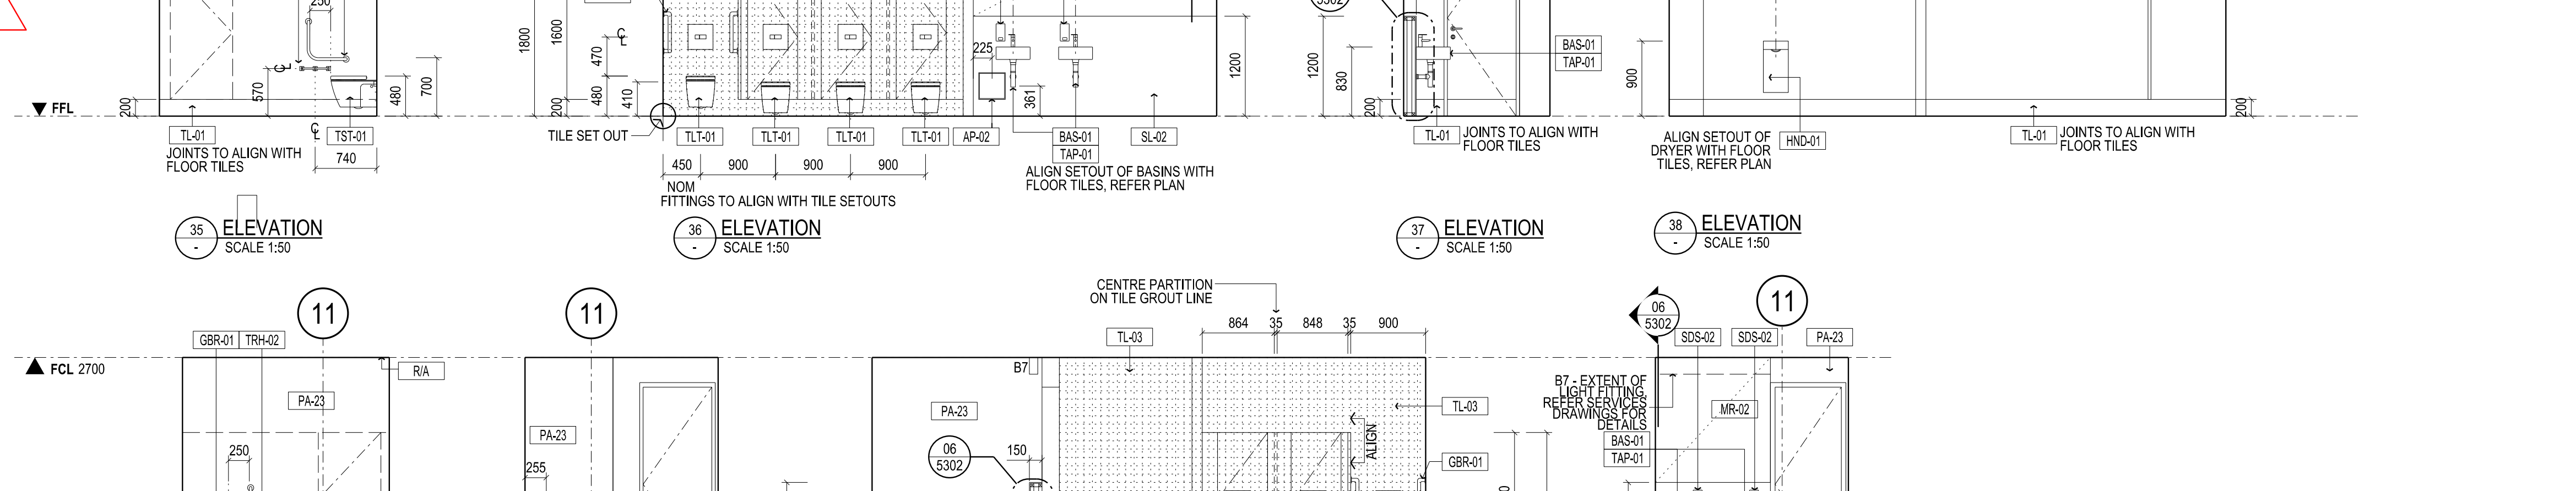

35 ELEVATION SCALE 1:50  
36 ELEVATION SCALE 1:50  
37 ELEVATION SCALE 1:50  
38 ELEVATION SCALE 1:50  
39 ELEVATION SCALE 1:50  
40 ELEVATION SCALE 1:50  
41 ELEVATION SCALE 1:50  
42 ELEVATION SCALE 1:50

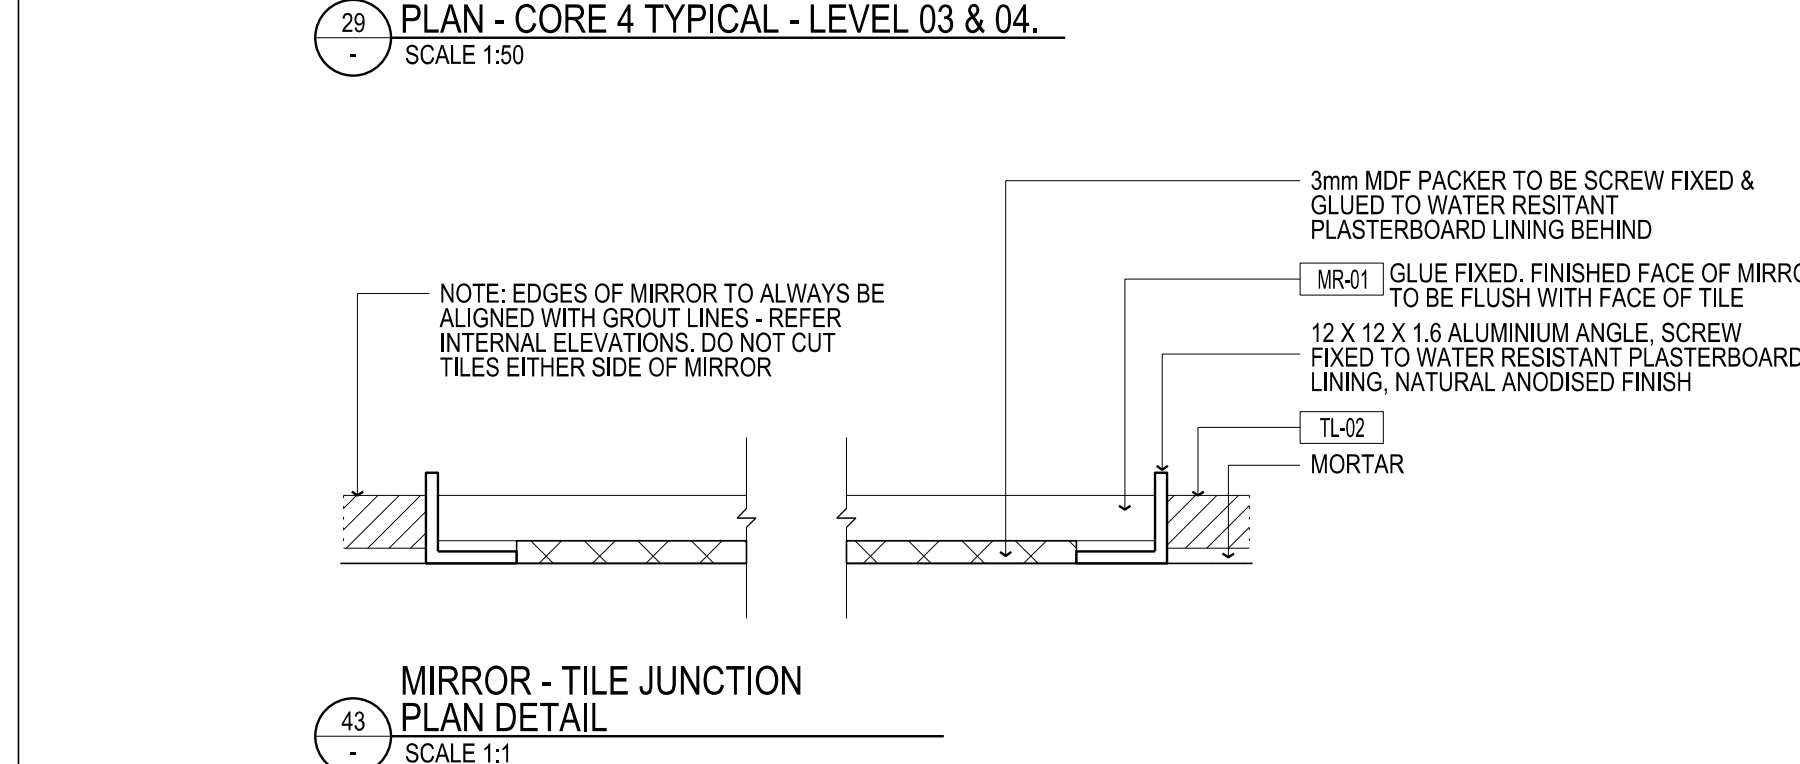

43 MIRROR - TILE JUNCTION PLAN DETAIL  
SCALE 1:1

THIS DRAWING IS AN UNCONTROLLED COPY UNLESS STAMPED OTHERWISE

CONTRACTORS SHALL VERIFY ALL DIMENSIONS BEFORE ANY WORK COMMENCES. ALL SHOP DRAWINGS SHALL BE SUBMITTED TO THE SUPERINTENDENT AND MANUFACTURERS SHALL NOT COME FROM THE RETURN OF MANUFACTURER'S SHOP DRAWINGS ISSUED BY THE CONSULTANT. FLOOR DIMENSIONS SHALL TAKE PRECEDENCE OVER SCALES. THIS DRAWING SHOULD BE READ IN CONJUNCTION WITH ALL RELEVANT CONTRACT SPECIFICATIONS AND DRAWINGS COPYRIGHT OF THIS DRAWING IS VESTED IN NADAAA.

General Notes

- NOTES
- REFER TO 2000 SERIES DIMS FOR RCP LEGEND
  - ALL FITTINGS TO ALIGN WITH FLOOR/WALL TILE SETOUT. ALL FLOOR TILE JOINTS TO ALIGN WITH WALL TILE JANTS. TILING PARTITION & PLUMBING CONTRACTOR TO USE TO ACHIEVE THIS
  - ALL WALL & CEILING JOINTS TYPICALLY SQUARE SET
  - MEMBRANE WALL FINISHES REFER TO GAS & CONCRETE PROFILE DRAWINGS FOR RALS & FTL

J	SG	UPDATES AS CLOUED	-	21.01.14
H	SG	UPDATES AS CLOUED	-	09.12.13
G	SG	UPDATES AS CLOUED	-	25.11.13
F	SG	UPDATES AS CLOUED	-	20.11.13
E	SG	UPDATES AS CLOUED	-	18.11.13
D	SG	UPDATES AS CLOUED	-	07.11.13
C	SG	UPDATES AS CLOUED	-	06.11.13
B	SG	DRAWING ALIGNED WITH AURECON DOCS	-	06.09.13
A	SG	ISSUE FOR CONSTRUCTION	-	01.08.13
10	SG	BUILDING PERMIT ISSUE FW LOCATION & GRADIENT ADDED RETURN AIR SLOT LOCATIONS ADDED	-	24.05.13
09	SG	VALUE MANAGEMENT ISSUE	-	28.03.13
08	SG	TENDER AGREEMENT #4	-	08.12.12
07	SG	100% CD - TENDER ISSUE	-	07.09.12
06	SG	90% CD ISSUE	-	10.08.12
05	SG	75% CD ISSUE	-	13.07.12
04	SG	50% CD ISSUE	-	01.06.12
03	SG	FINAL DD ISSUE	-	24.02.12
02	SG	PLINTH TO SQUAT TOILET ADDED 2 BASINS ADDED	-	20.01.12
01	SG	DD UPDATE DESIGN DEVELOPMENT ISSUE	-	22.12.11



NADAAA

NADAAA  
1920 Wellington  
Street No.2  
Boston  
Massachusetts  
02115 USA  
Telephone  
+1 817 442 8232  
Facsimile  
+1 888 442 1417  
Email  
nadaaa@nadaaa.com



25 Rokeby Street, Collingwood, Victoria 3066 Australia  
Tel: +61 3 8662 0400  
www.johnwardlearchitects.com  
© 2014 John Wardle Architects  
ABN 83 006 814 268

Client University of Melbourne  
Parkville Campus

Project Faculty of Architecture  
Building and Planning

Title TOILETS & WET AREAS, KITCHEN  
DETAILS - SHEET 01

Project No.	0913	Scale	1:50 @ A0 1:100 @ A2
Drawing No.	AR5300	Revision	J

Date: Dec 2011 Drawn - Co-Ord - Check -

FILENAME - SFRS

FOR CONSTRUCTION