

THIS DRAWING IS AN UNCONTROLLED COPY UNLESS STAMPED OTHERWISE

CONTRACTORS SHALL VERIFY JOB DIMENSIONS BEFORE ANY JOB COMMENCES. ALL SHOP DRAWINGS SHALL BE SUBMITTED TO THE SUPERINTENDENT AND MANUFACTURERS SHALL NOT COMMENCE FROM THE RETURN OF DIMENSIONS SHOP DRAWINGS ISSUED BY THE CONSULTANT. DIMENSIONS SHALL TAKE PRECEDENCE OVER SCALES. THIS DRAWING SHALL BE READ IN CONJUNCTION WITH ALL RELEVANT CONTRACT SPECIFICATIONS AND DRAWINGS COPYRIGHT OF THIS DRAWING IS VESTED IN HANDLE.

General Notes

NOTES

- REFER TO 2000 SERIES DWGS FOR RCP LEGEND
- ALL FITTINGS TO ALIGN WITH FLOOR/WALL TILE SETOUT. ALL FLOOR TILE JOINTS TO ALIGN WITH WALL TILE JOINTS. TILING PARTITION & PLUMBING CONTRACTOR TO LAISE TO ACHIEVE THIS.
- ALL WALL & CEILING JOINTS TYPICALLY SQUARE SET
- IMMEDIATELY TO FWS. REFER TO GAS & CONCRETE PROFILE DRAWINGS FOR RLS & FFL.

B	SG	UPDATES AS CLOUED	SG	25.11.13
A	SG	ISSUE FOR CONSTRUCTION	SG	18.11.13



NADAAA
 NADAAA
 1520 Washington Street No.2 Boston Massachusetts 02118 USA
 Telephone +1 617 442 8232 Facsimile +1 688 442 1417 Email nadaa@nadaaa.com

John Wardle Architects
 25 Rokeby Street, Collingwood, Victoria 3066 Australia
 Tel: +61 3 8662 0400 www.johnwardlearchitects.com
 © 2012 John Wardle Architects ABN 83 006 814 268

Client **University of Melbourne Parkville Campus**

Project **Faculty of Architecture Building and Planning**


Title **TOILETS & WET AREAS, KITCHEN DETAILS - SHEET 04**

Project No.	0913	Scale	1:50 @ A0 1:100 @ A2
Drawing No.	AR5303	Revision	B


Date: Dec 2011 Drawn - Co-Ord - Check -

FILENAME - SFRFS


FOR CONSTRUCTION

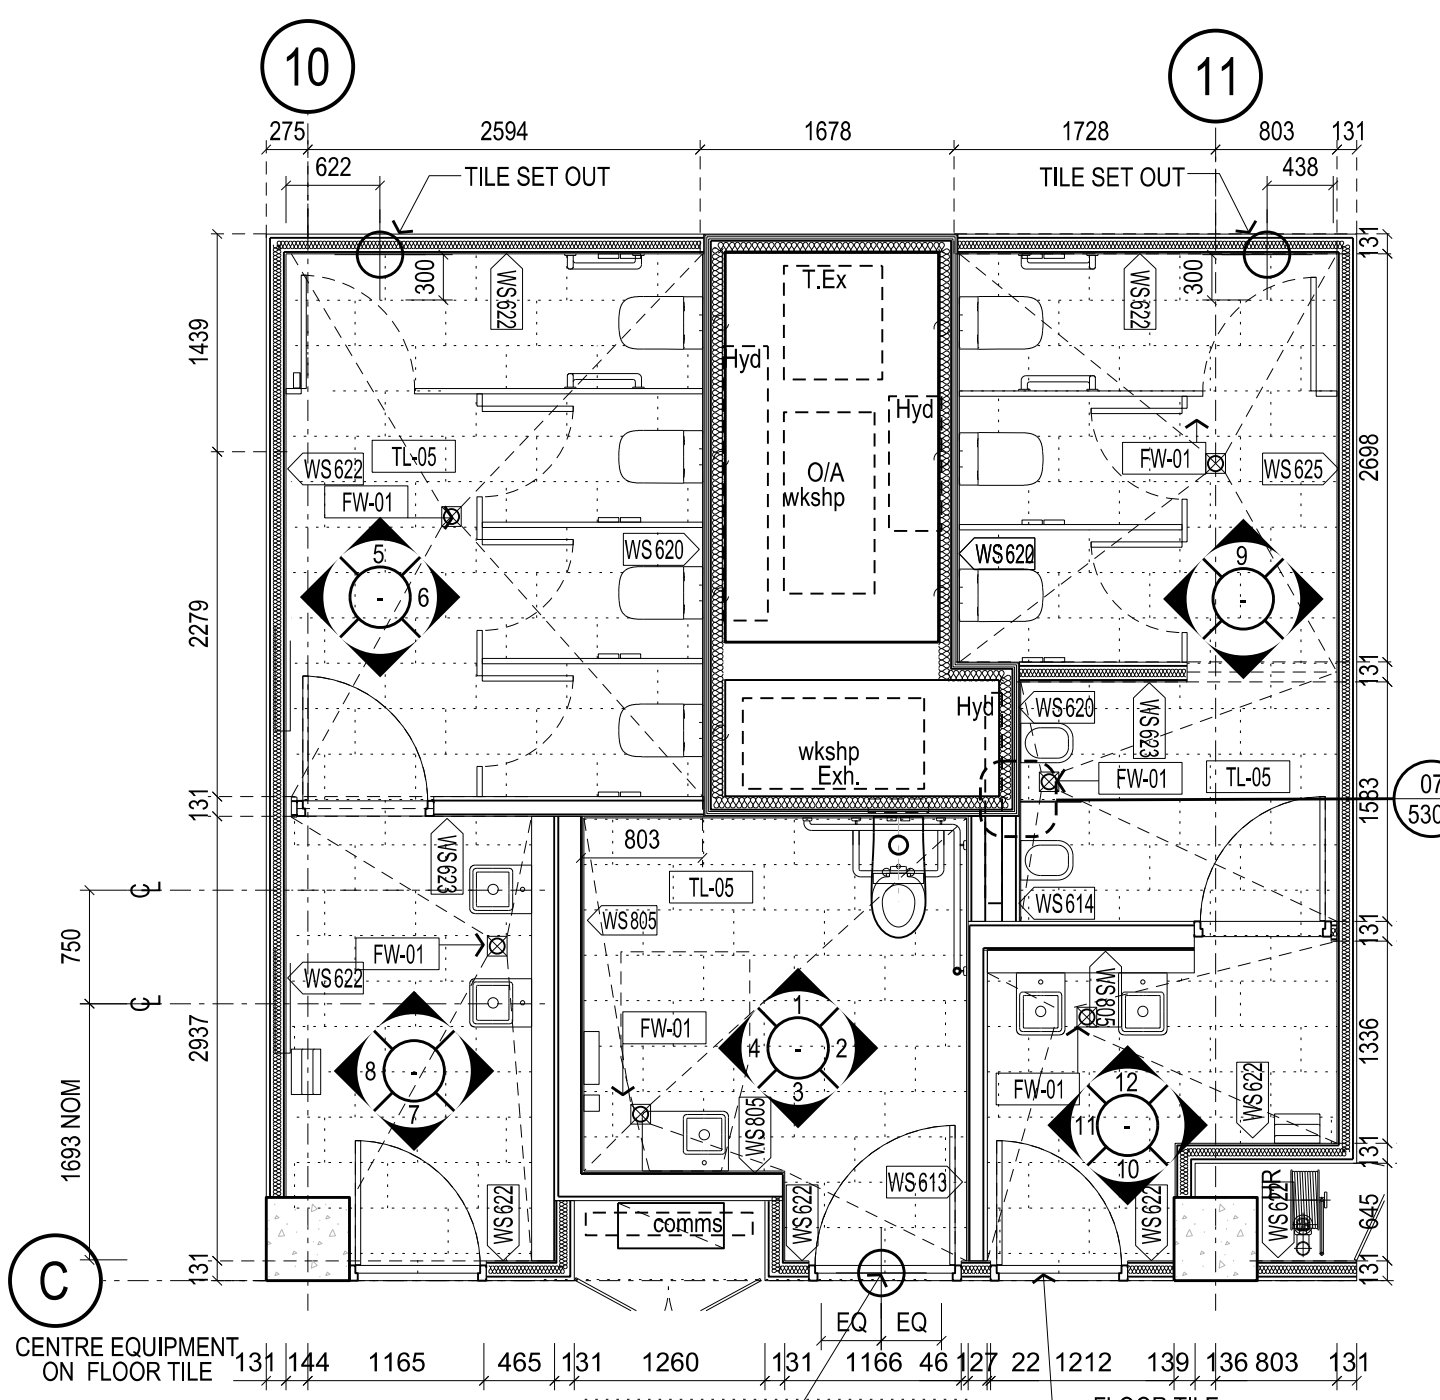


30 PLAN - CORE 4 - LEVEL 02 SCALE 1:50

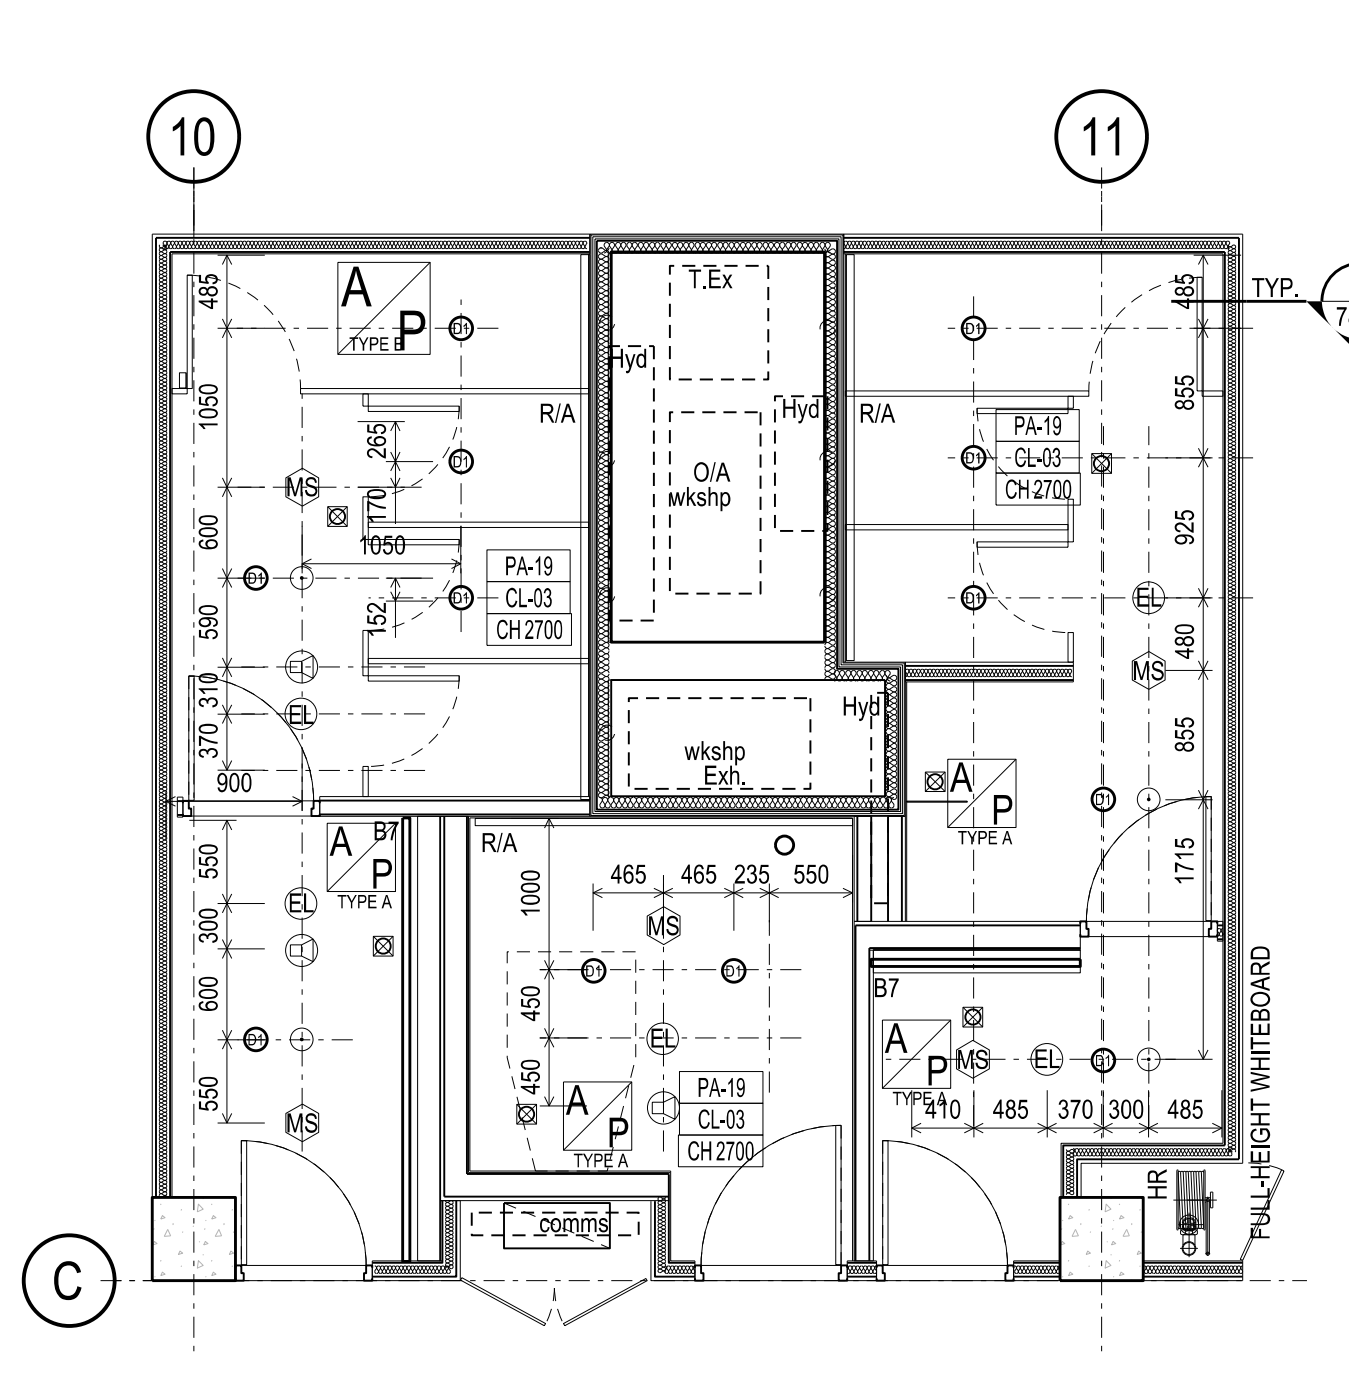


31 REFLECTED CEILING PLAN - CORE 4 - LEVEL 02 SCALE 1:50

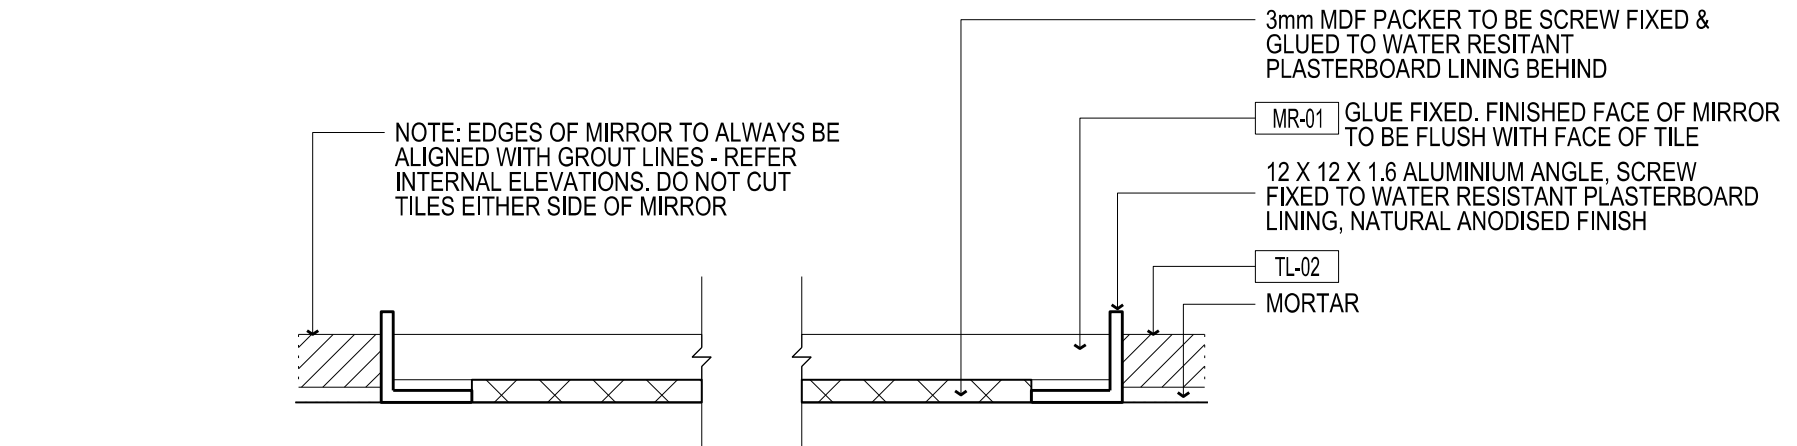


32 MIRROR - TILE JUNCTION PLAN DETAIL SCALE 1:1

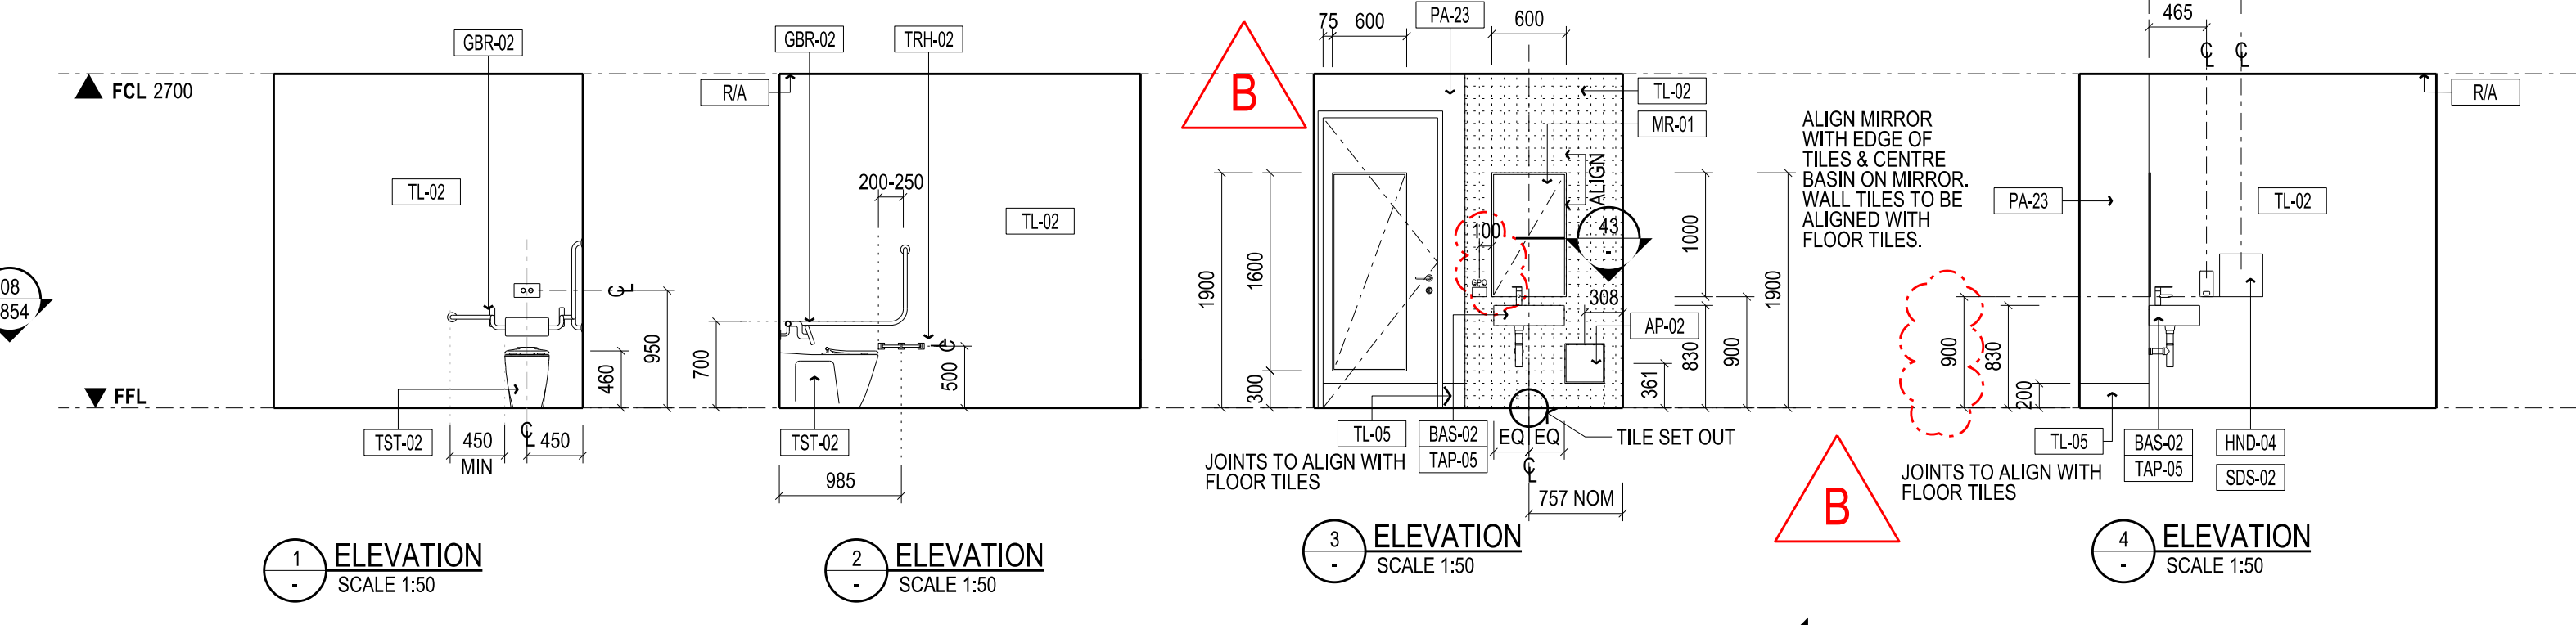

1 ELEVATION SCALE 1:50
2 ELEVATION SCALE 1:50
3 ELEVATION SCALE 1:50
4 ELEVATION SCALE 1:50

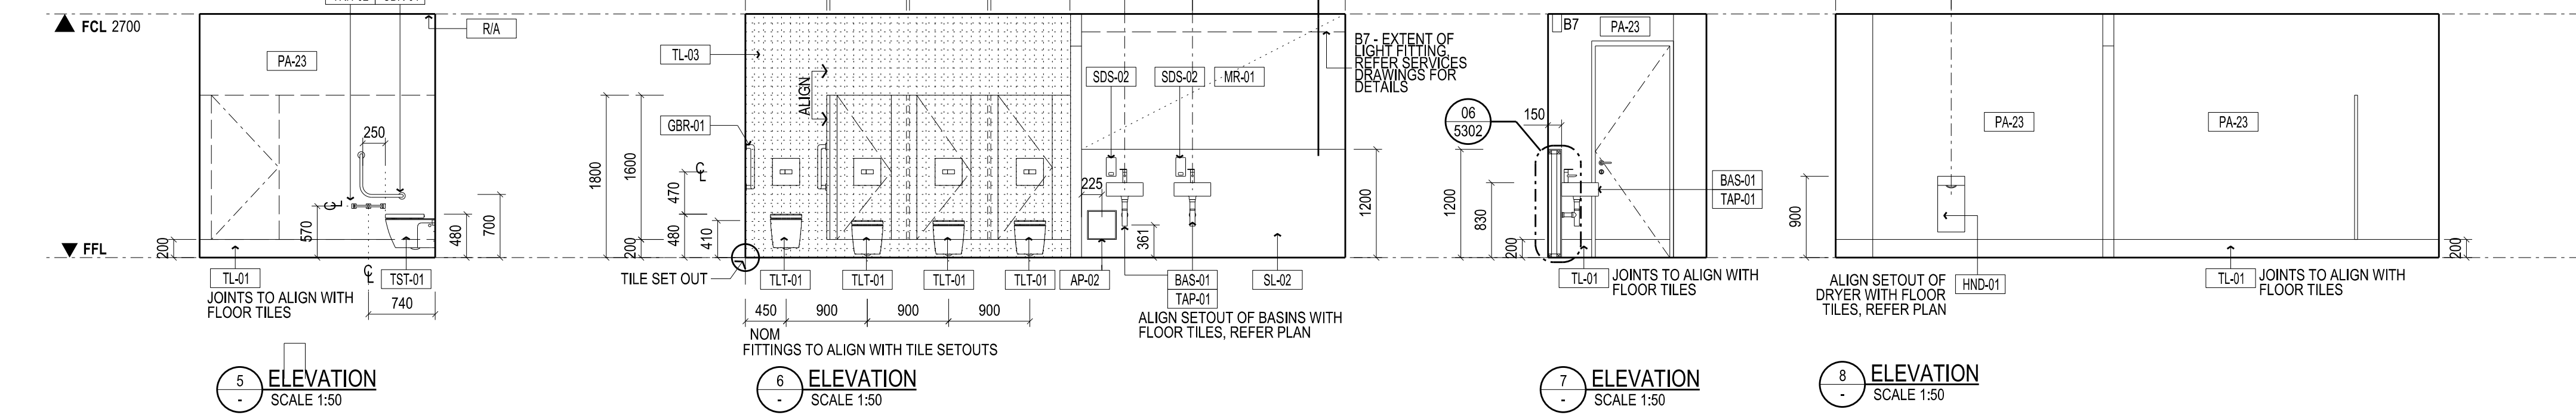

5 ELEVATION SCALE 1:50
6 ELEVATION SCALE 1:50
7 ELEVATION SCALE 1:50
8 ELEVATION SCALE 1:50

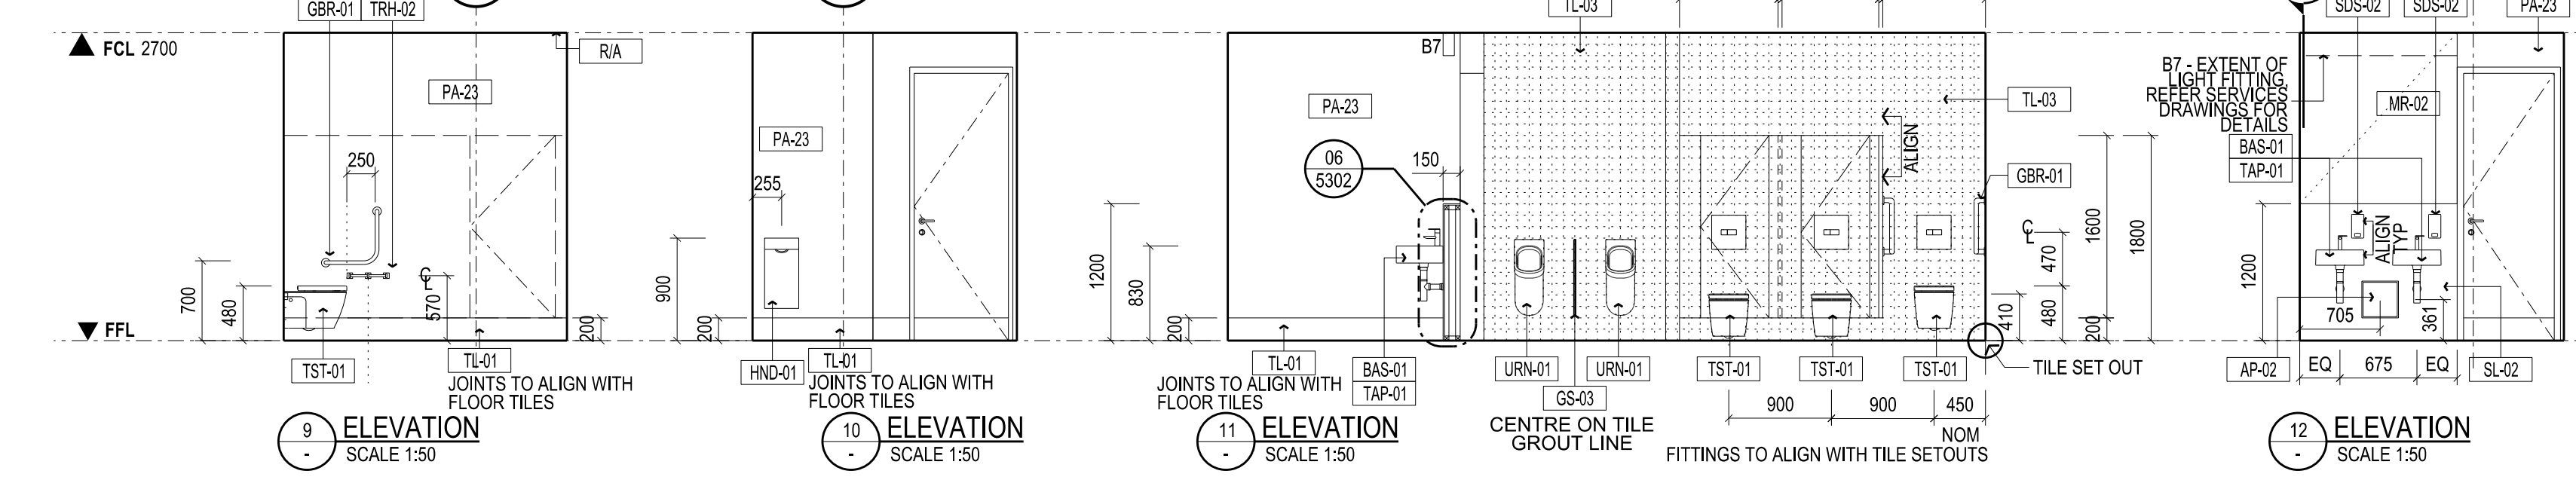

9 ELEVATION SCALE 1:50
10 ELEVATION SCALE 1:50
11 ELEVATION SCALE 1:50
12 ELEVATION SCALE 1:50