



THIS DRAWING IS AN UNCONTROLLED COPY UNLESS STAMPED OTHERWISE

CONTRACTORS SHALL VERIFY JOB DIMENSIONS BEFORE ANY JOB COMMENCES. ALL SHOP DRAWINGS SHALL BE SUBMITTED TO THE SUPERINTENDENT AND MANUFACTURERS SHALL NOT COMBINE FROM TO THE RETURN OF DIMENSIONS SHOWN. BY THE CONSULTANT, DIMENSIONS SHALL TAKE PRECEDENCE OVER SCALES. THIS DRAWING SHALL BE READ IN CONJUNCTION WITH ALL RELEVANT CONTRACT SPECIFICATIONS AND DRAWINGS COPYRIGHT OF THIS DRAWING IS VESTED IN HANDLE.


General Notes

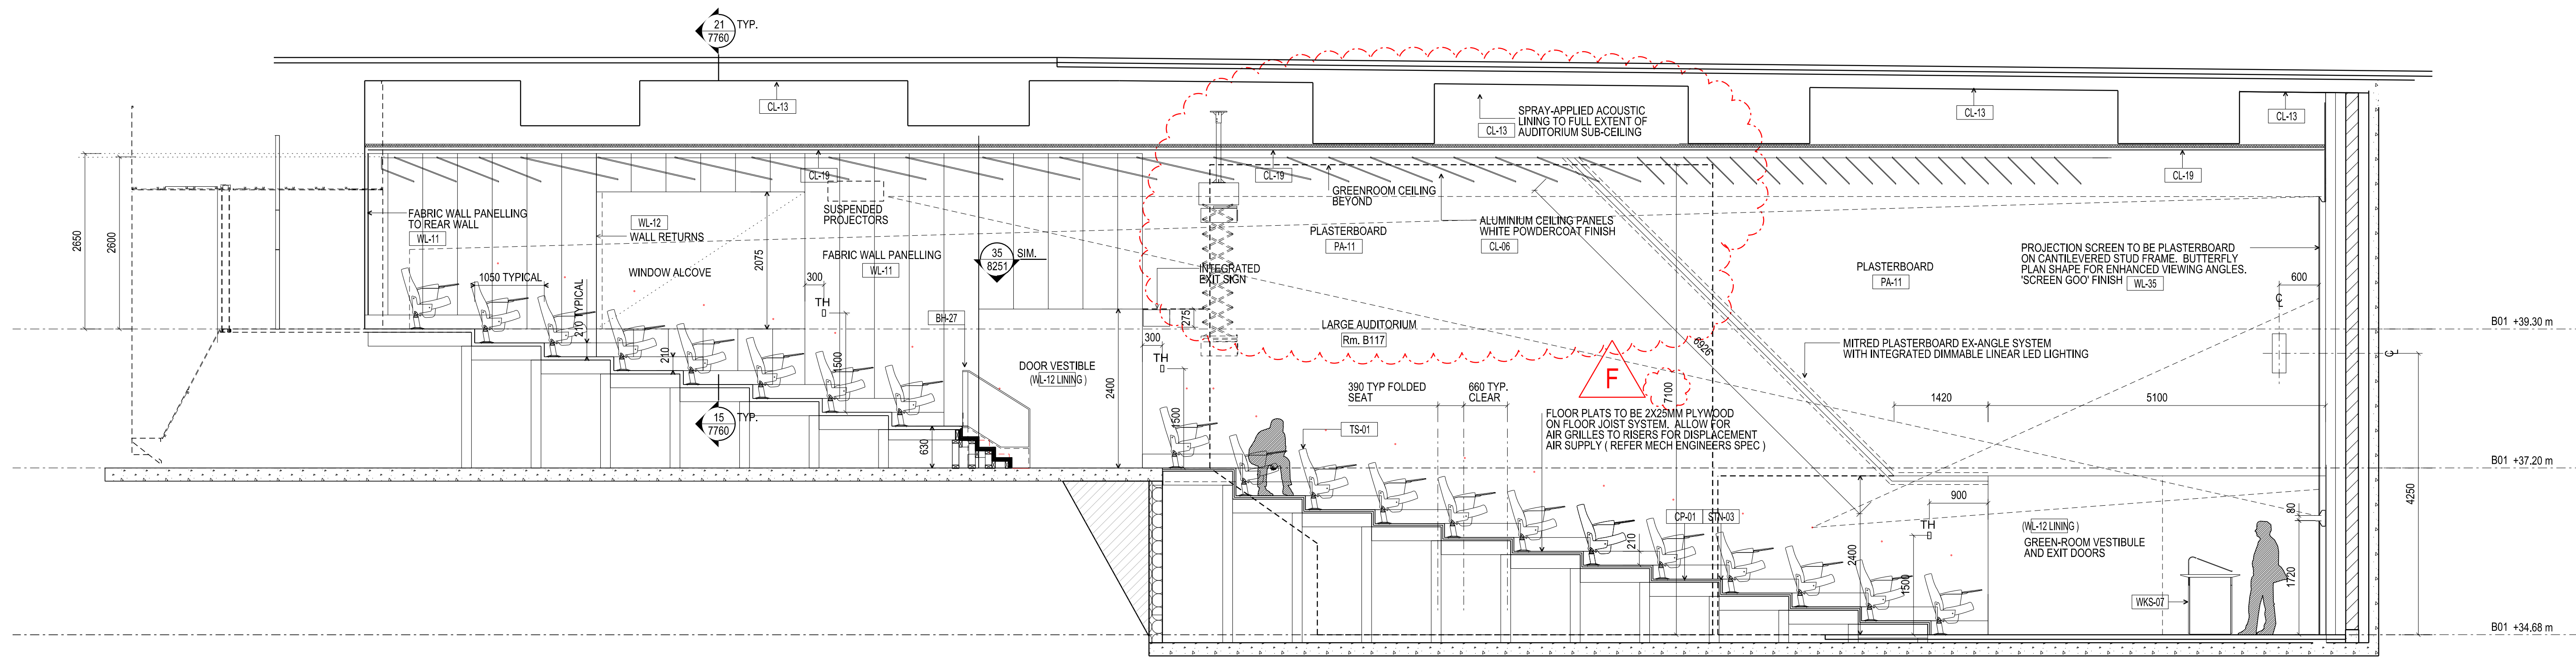


SECTION
AUDITORIUM 01
SCALE 1:50

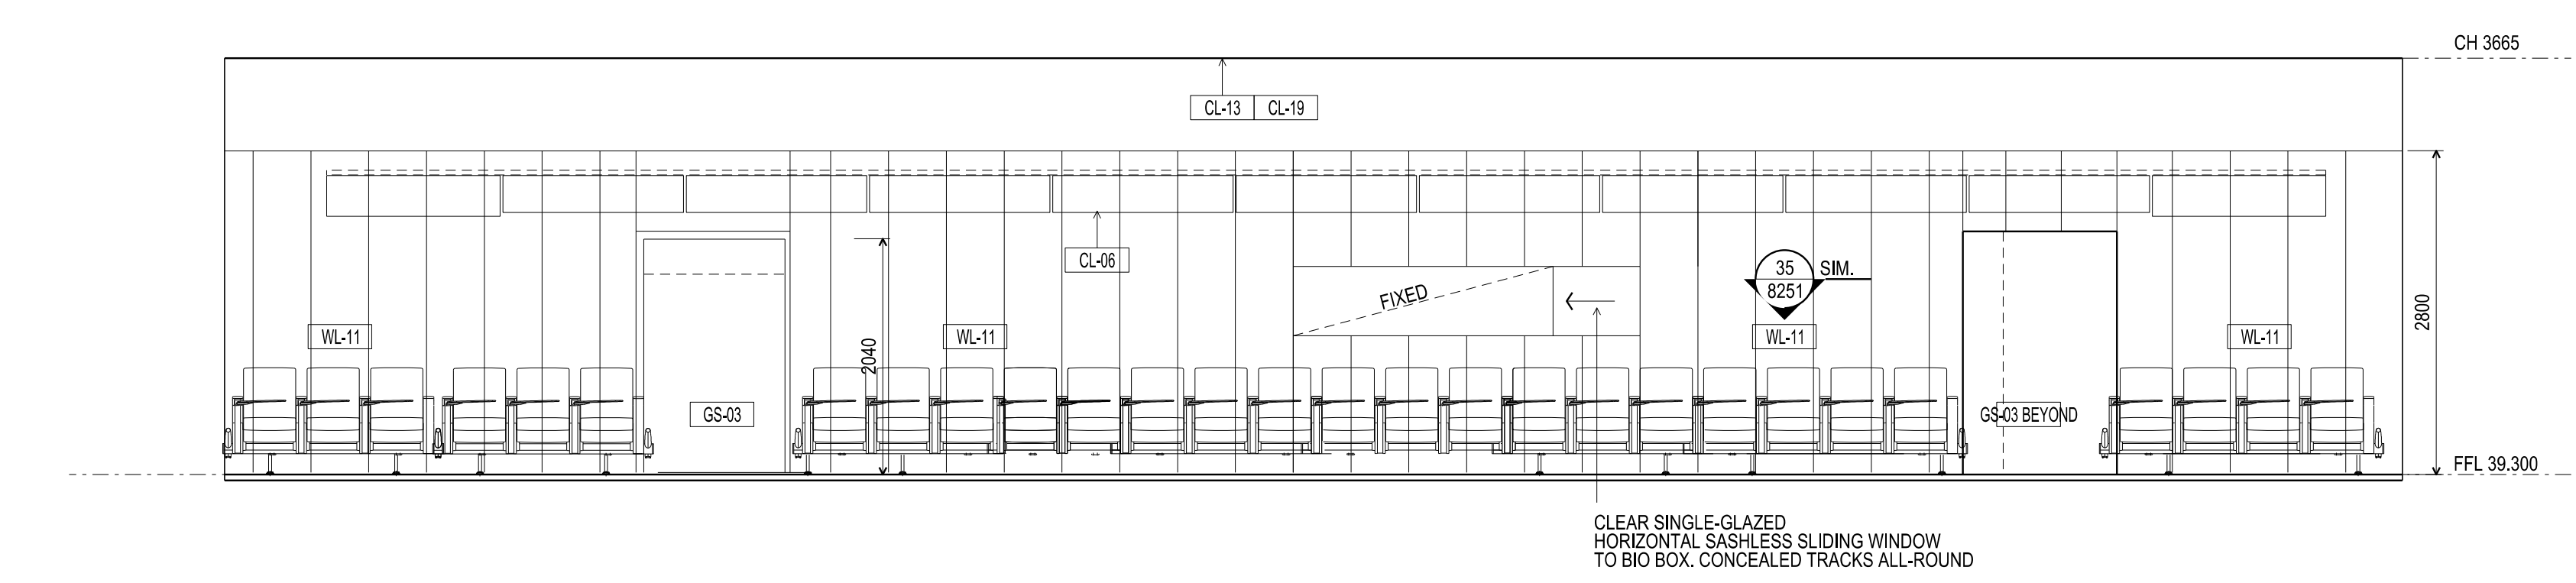


ELEVATION
AUDITORIUM 01
SCALE 1:50

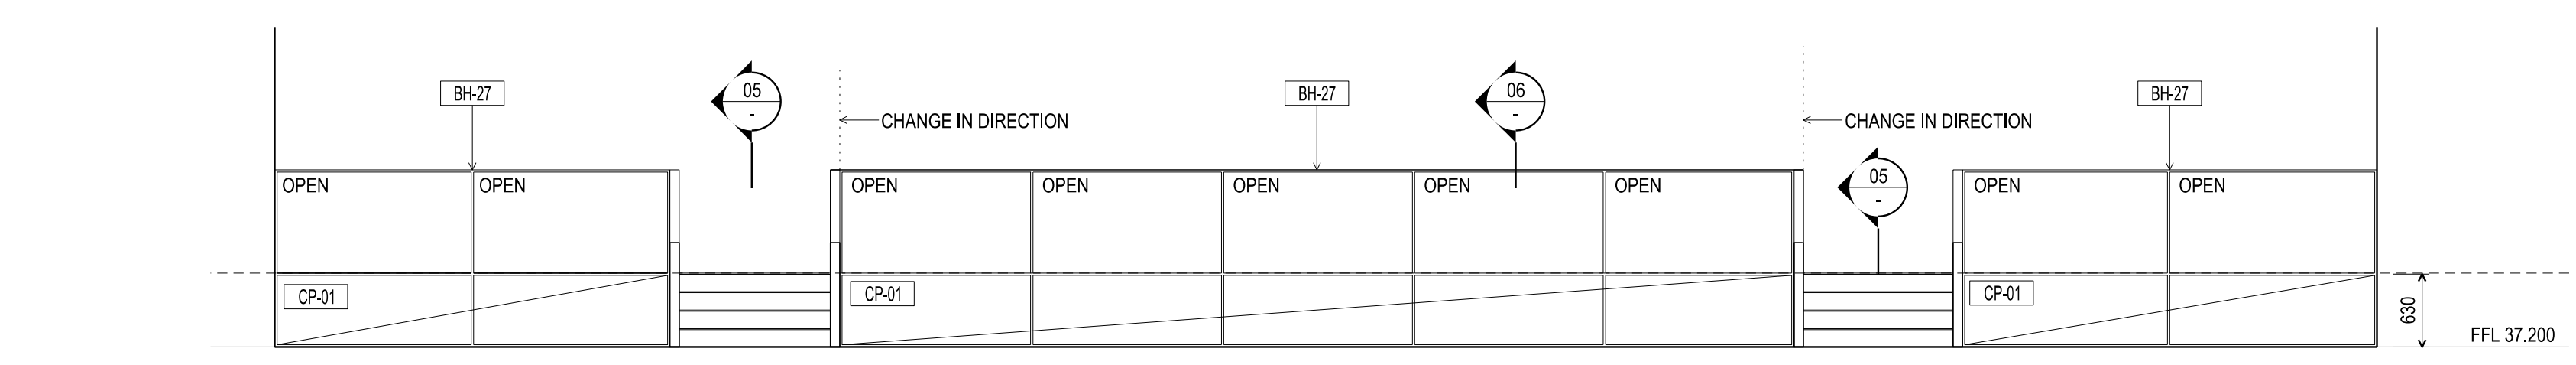


ELEVATION
BALUSTRADE
SCALE 1:50

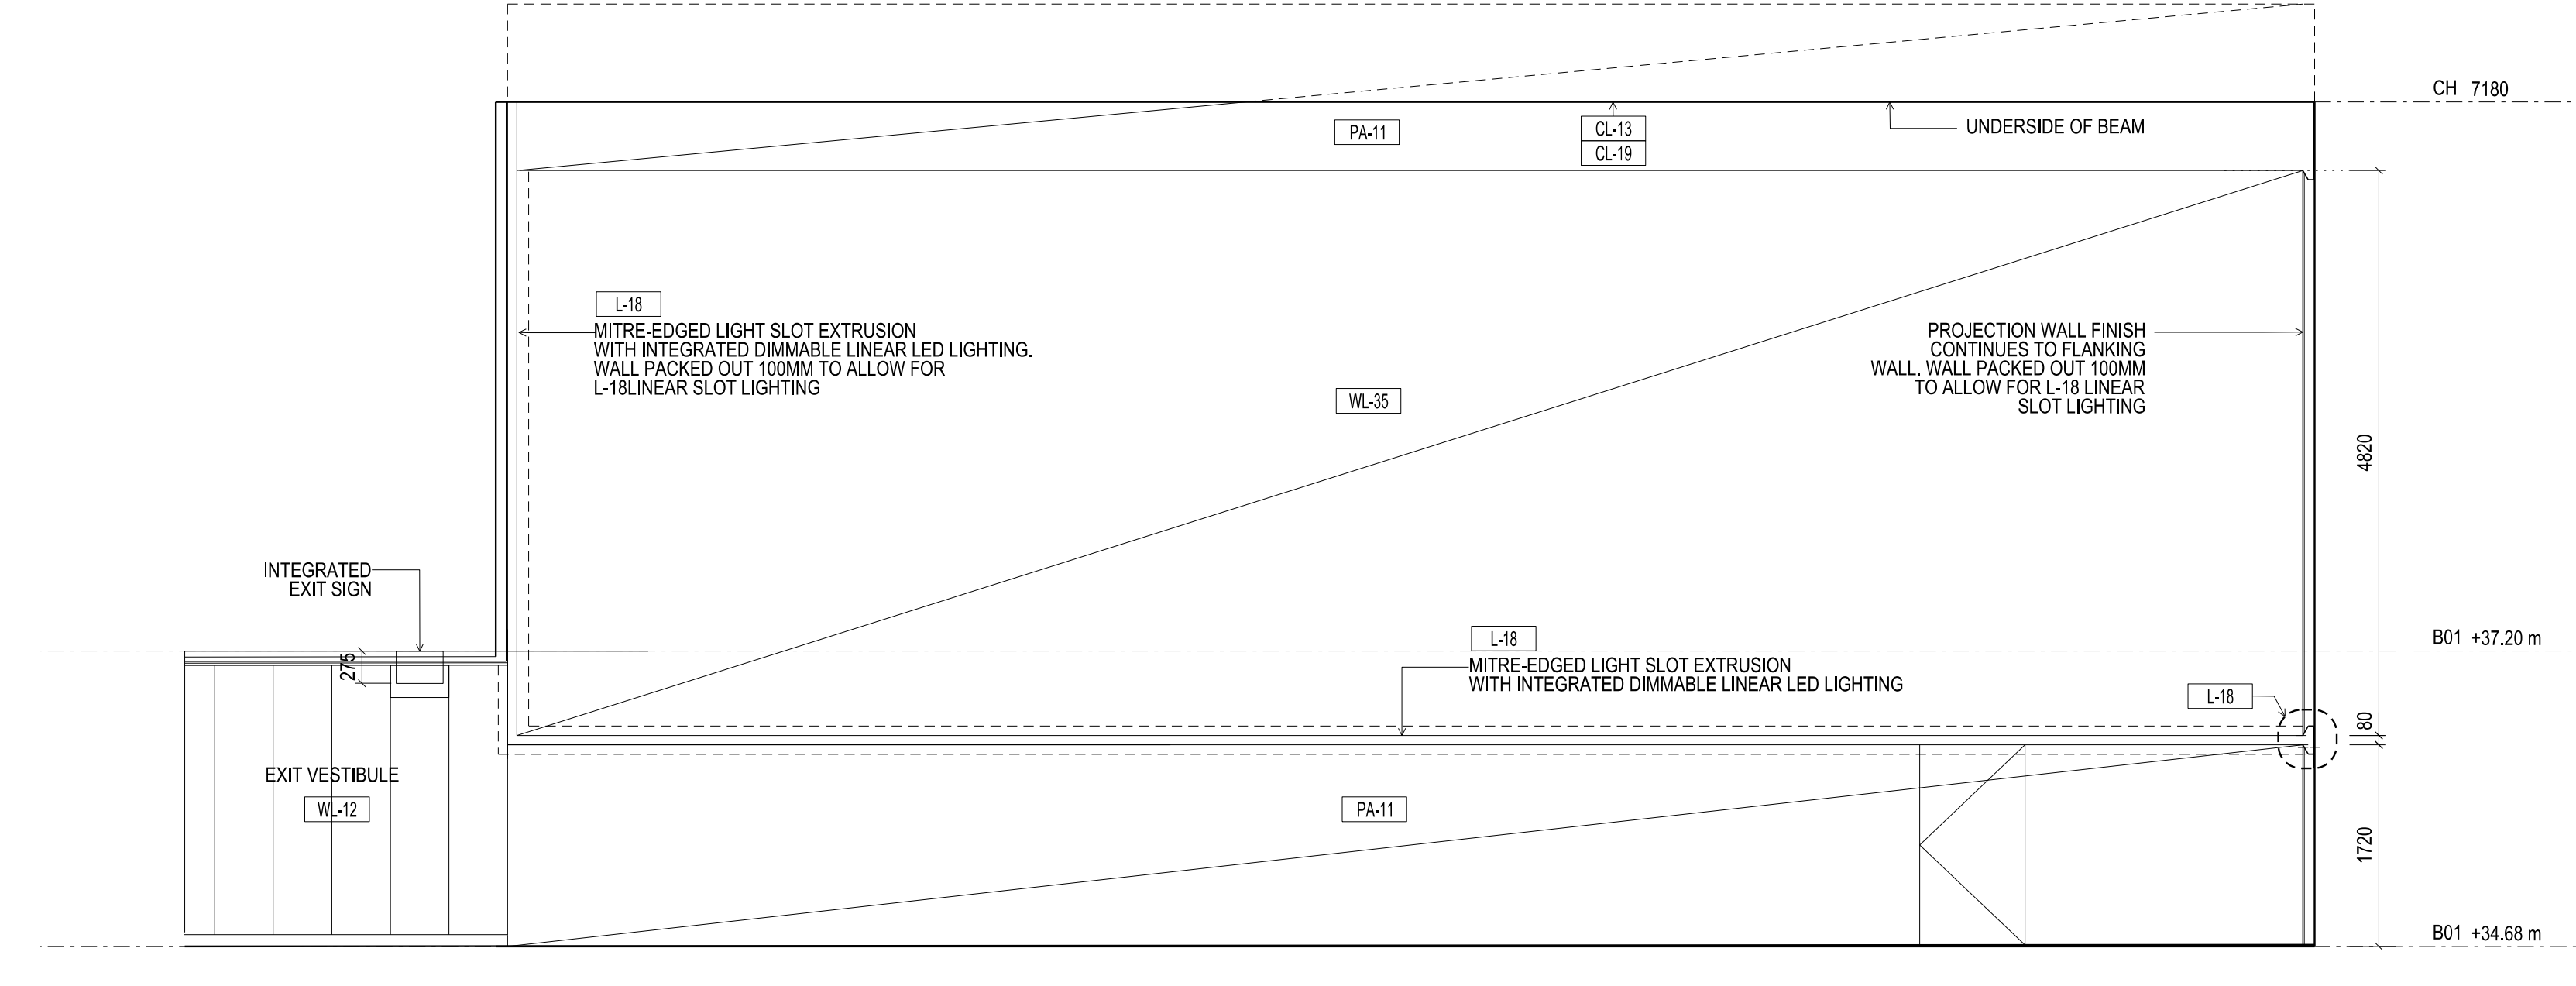


ELEVATION
AUDITORIUM 01
SCALE 1:50

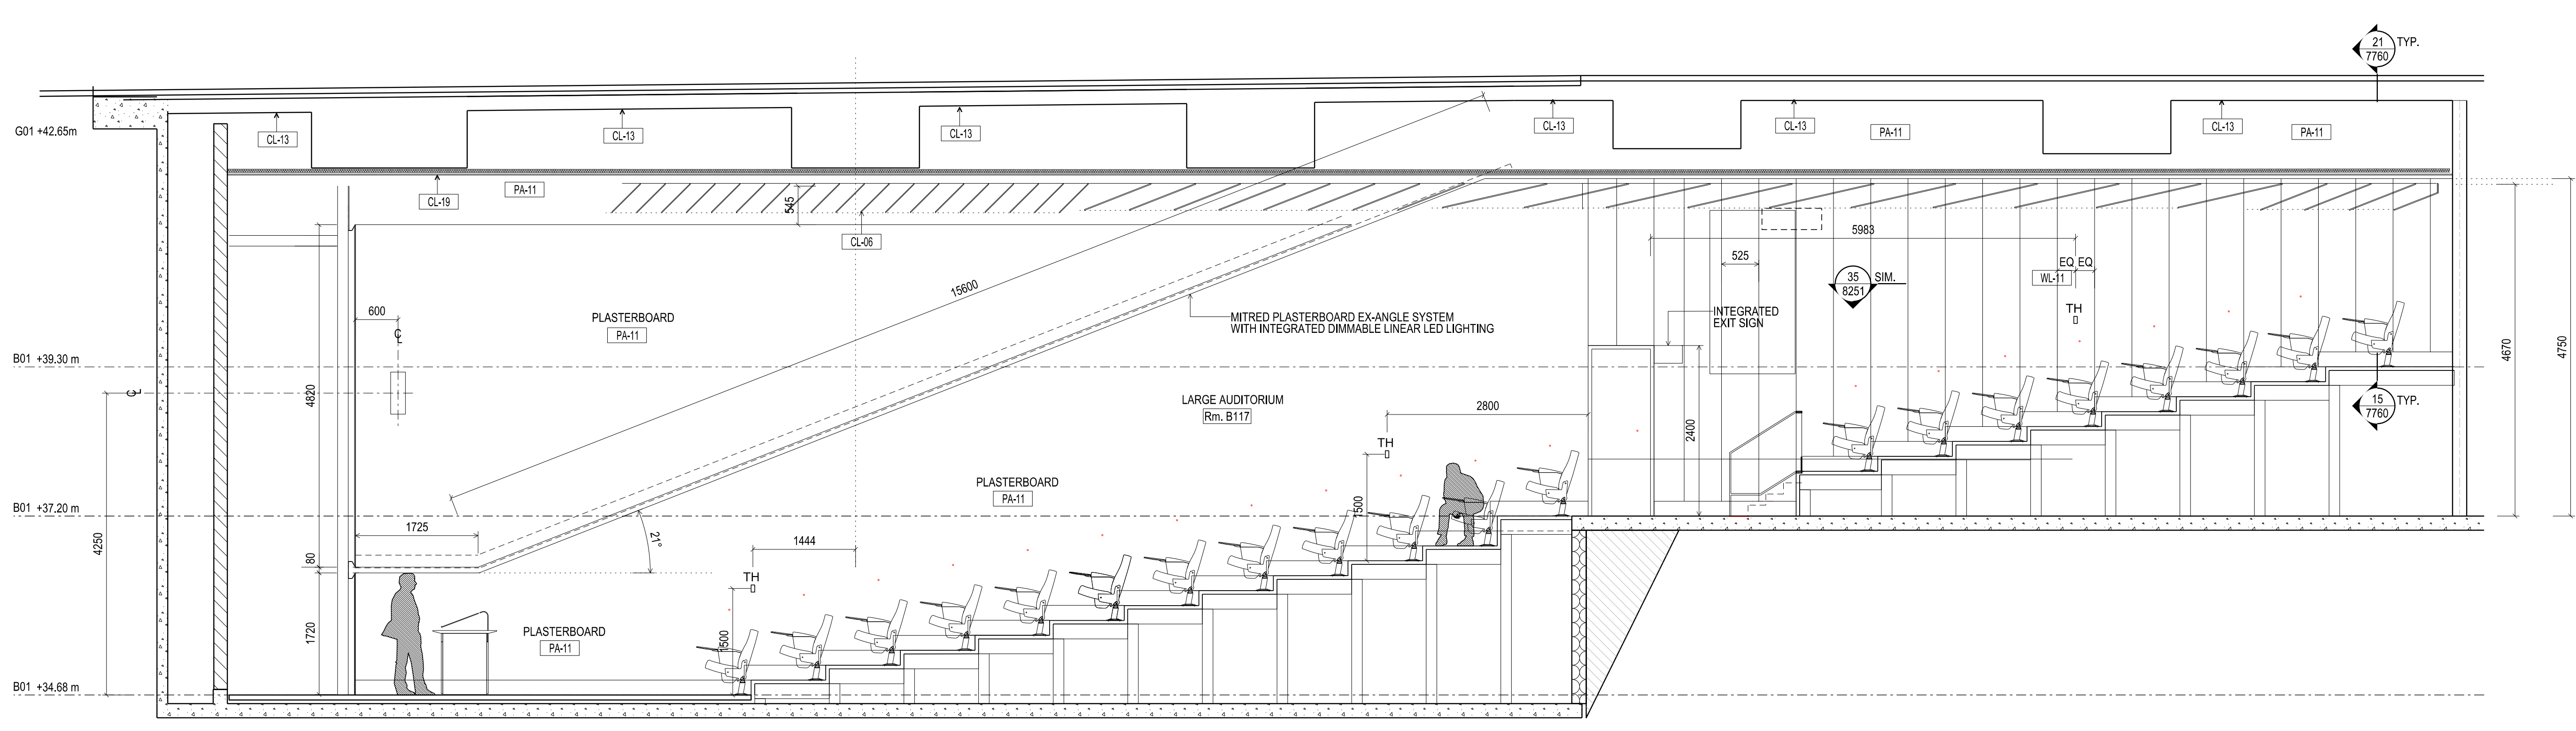

SECTION
AUDITORIUM 01
SCALE 1:50

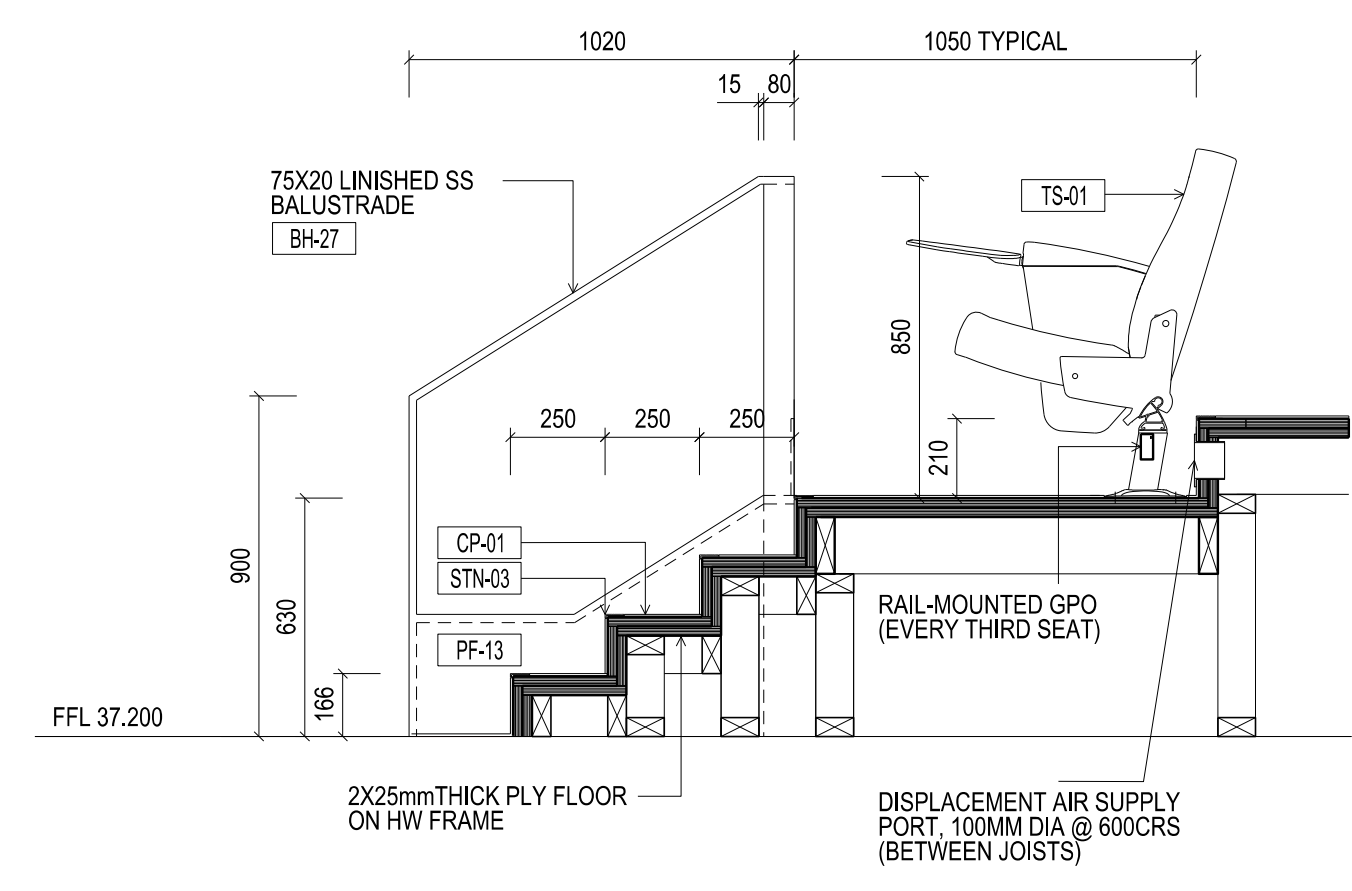

SECTION
TYPICAL PLAT BALUSTRADE
SCALE 1:20

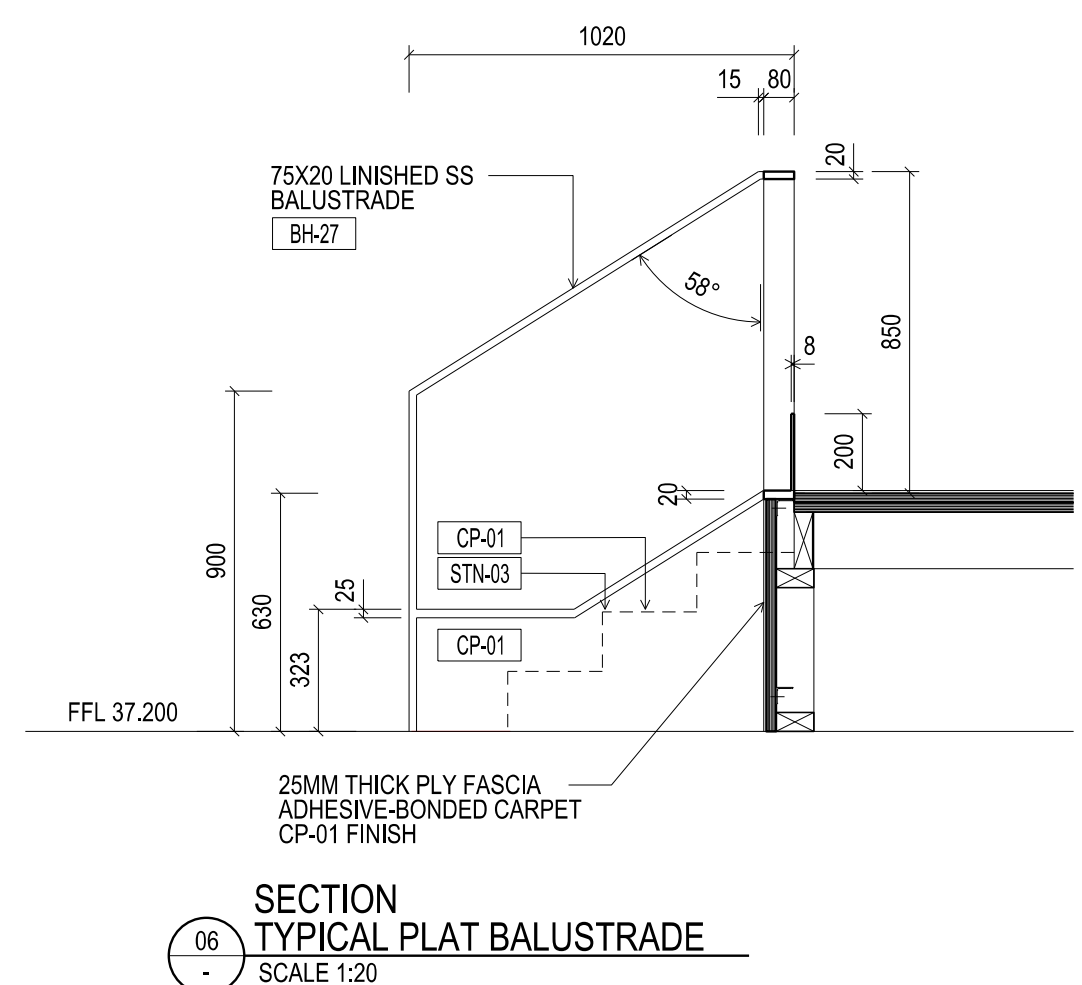

SECTION
TYPICAL PLAT BALUSTRADE
SCALE 1:20

Rev	Issue	Revision Description	Amd	Date
F	SG	UPDATES AS CLOUDED	-	XX
E	SG	UPDATES AS CLOUDED	-	29.01.14
D	SG	UPDATES AS CLOUDED	-	21.01.14
C	SG	UPDATES AS CLOUDED	-	10.07.14
B	SG	UPDATES AS CLOUDED	-	12.12.13
A	SG	CONSTRUCTION ISSUE	-	18.11.13
03	SG	BUILDING PERMIT ISSUE	-	24.05.13
		ASLE CLEARANCES NOTED		
02	SG	100% CD - TENDER ISSUE	-	07.09.12
01	SG	95% CD ISSUE	-	10.08.12
Rev	Issue	Revision Description	Amd	Date

Brookfield
MULTIPLEX

NADAAA
NADAAA
1920 Washington Street No.2
Boston Massachusetts 02118 USA
Telephone +1 817 442 8232
Facsimile +1 888 442 1417
Email nadaa@nadaaa.com

John Wardle Architects
25 Rokeby Street, Collingwood, Victoria 3066 Australia
Tel: +61 3 8662 0400 www.johnwardlearchitects.com
© 2014 John Wardle Architects ABN 83 006 814 268

Client **University of Melbourne Parkville Campus**

Project **Faculty of Architecture Building and Planning**

Title **INTERIOR ELEVATIONS LEVEL B01 AUDITORIUM 01**

Project No. 0913	Scale: 1:50 @ A0
Drawing No. AR5701	Revision F
Date: May 2011	Dwn -
Co-Ord -	Chk -

FILENAME - SFLES

FOR CONSTRUCTION