



CONTRACTORS SHALL VERIFY DIMENSIONS BEFORE ANY JOB COMMENCES. ALL SHOP DRAWINGS SHALL BE SUBMITTED TO THE SUPERINTENDENT AND MANUFACTURER SHALL NOT COMMENCE FROM THE RETURN OF AWARDED SHOP DRAWINGS ISSUED BY THE CONSULTANT. DIMENSIONS SHALL TAKE PRECEDENCE OVER SCALES. THIS DRAWING SHALL BE READ IN CONJUNCTION WITH ALL RELEVANT CONTRACT SPECIFICATIONS AND DRAWINGS COPYRIGHT OF THIS DRAWING IS VESTED IN WARDLE.


General Notes

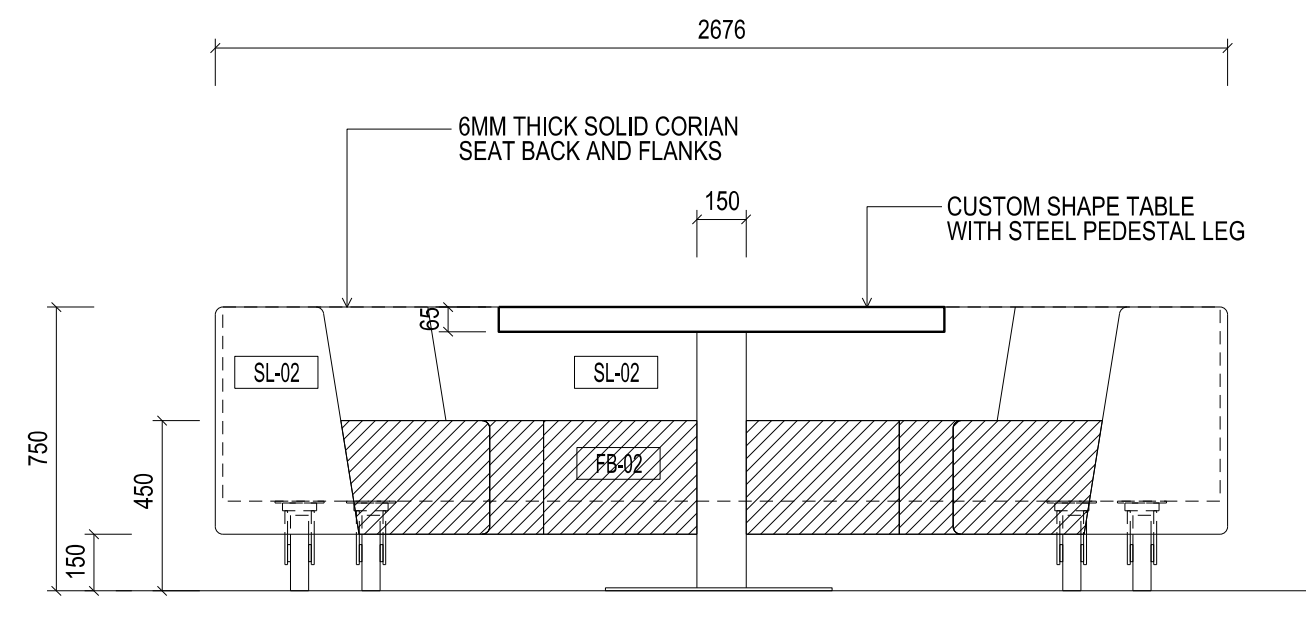


FRONT ELEVATION
J01-06 A/B
SCALE 1:20

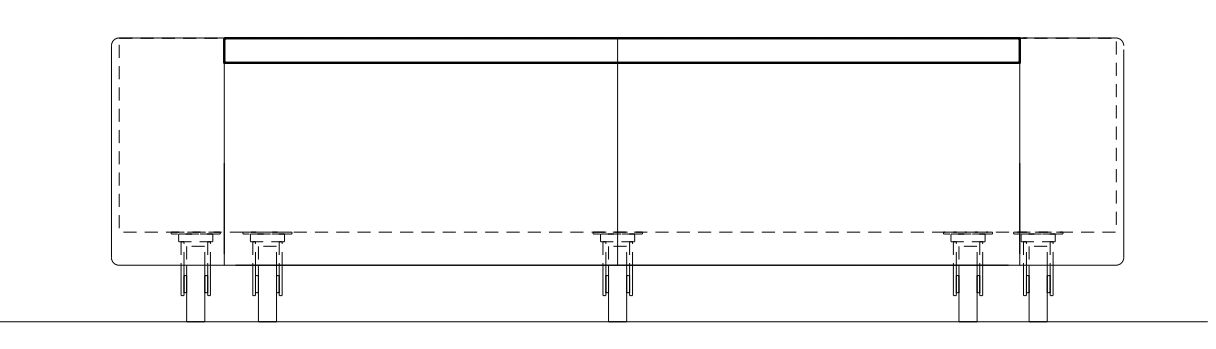


REAR ELEVATION
J01-04 A/B/C/D
SCALE 1:20

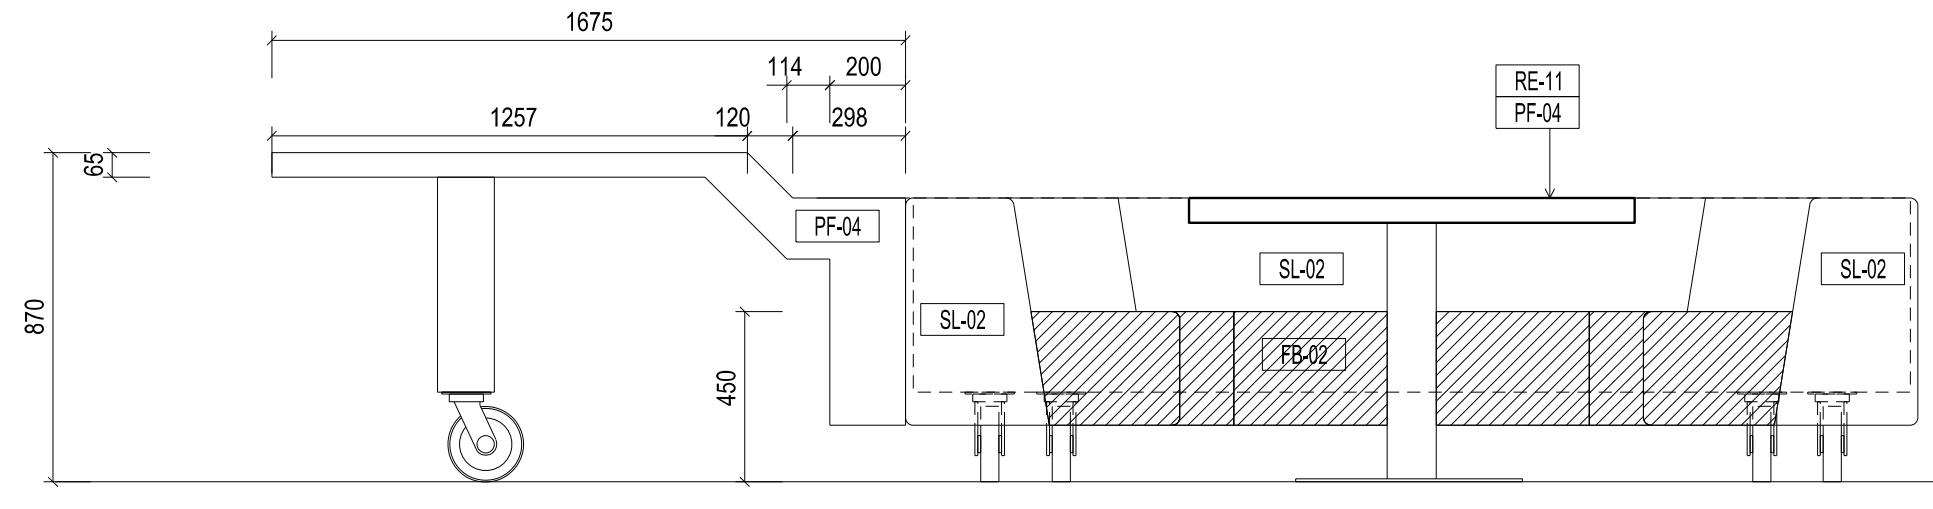


FRONT ELEVATION
J01-04 A/B/C/D
SCALE 1:20

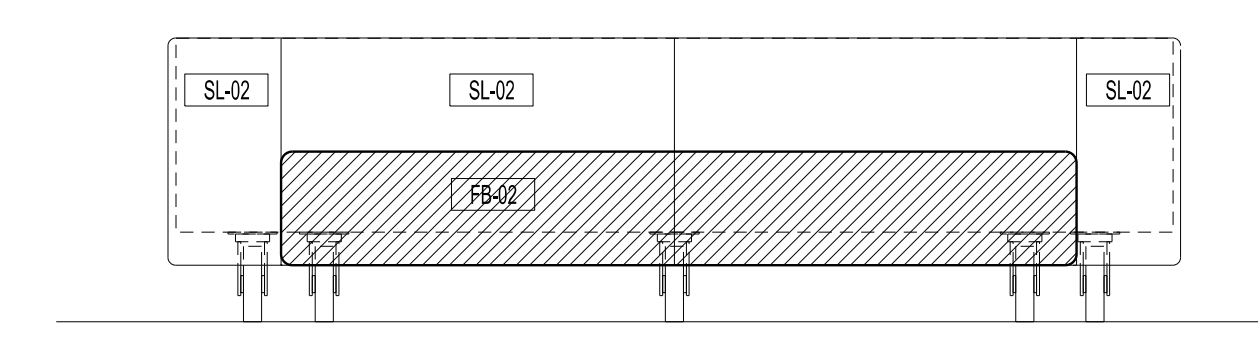


REAR ELEVATION
J01-04 A/B/C/D
SCALE 1:20

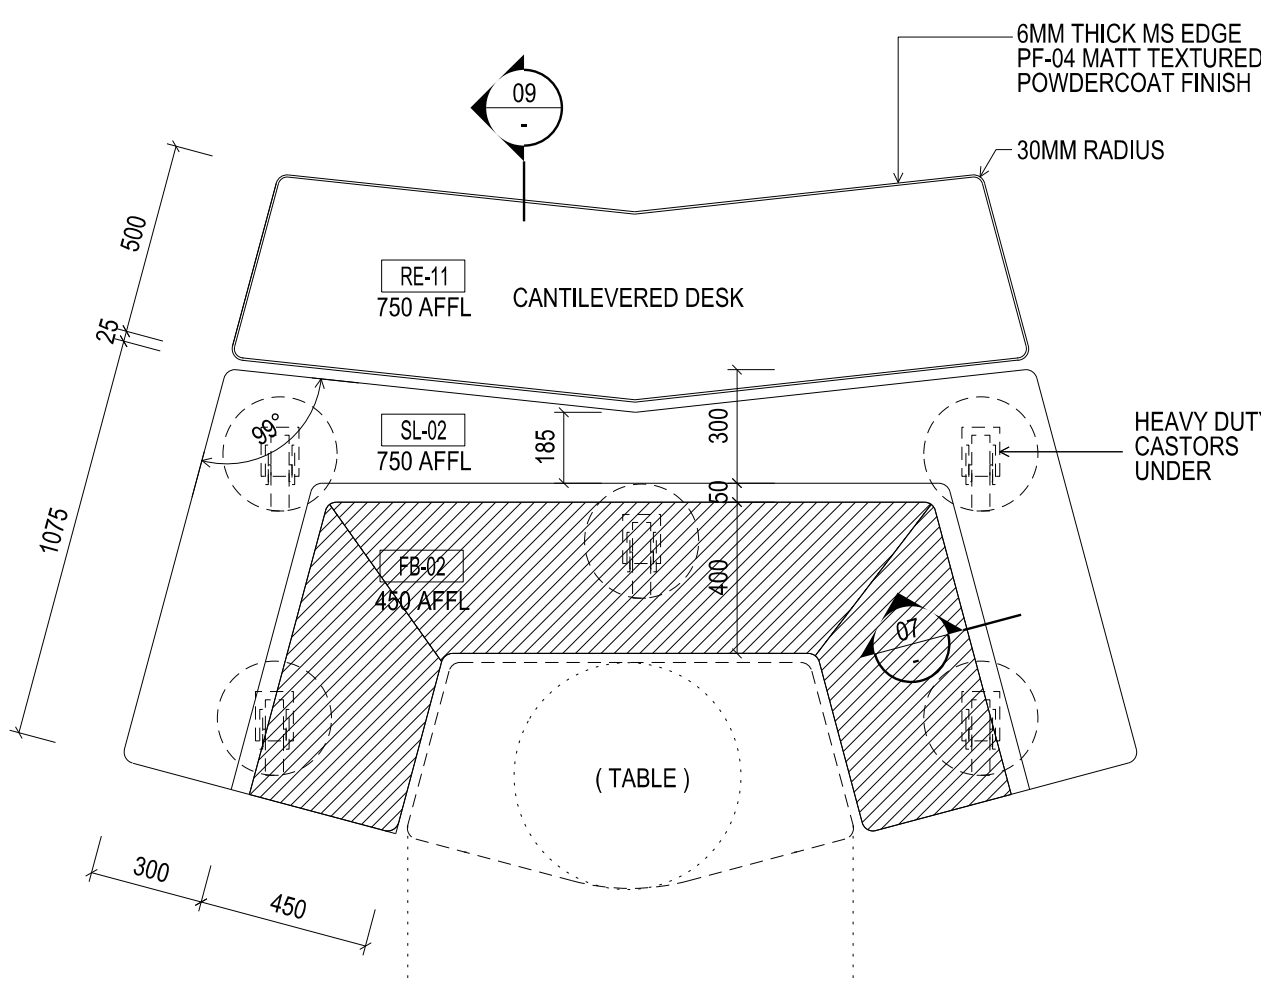


PLAN
J01-06 A/B
SCALE 1:20

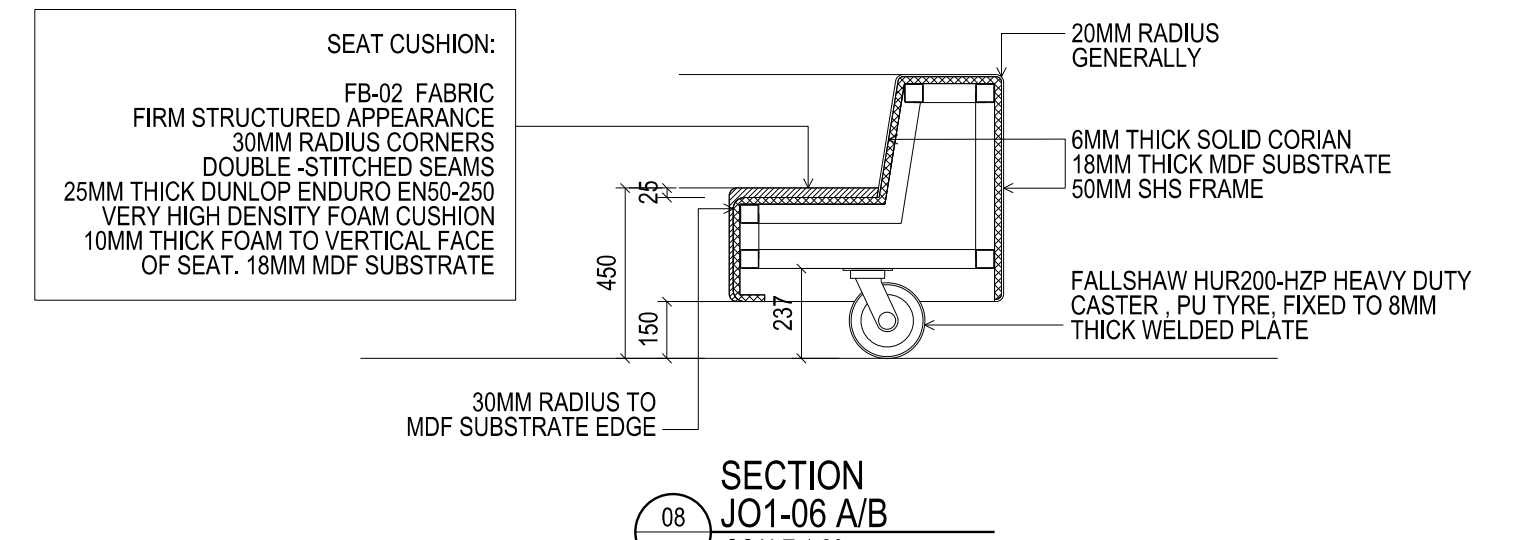


SECTION
J01-06 A/B
SCALE 1:20

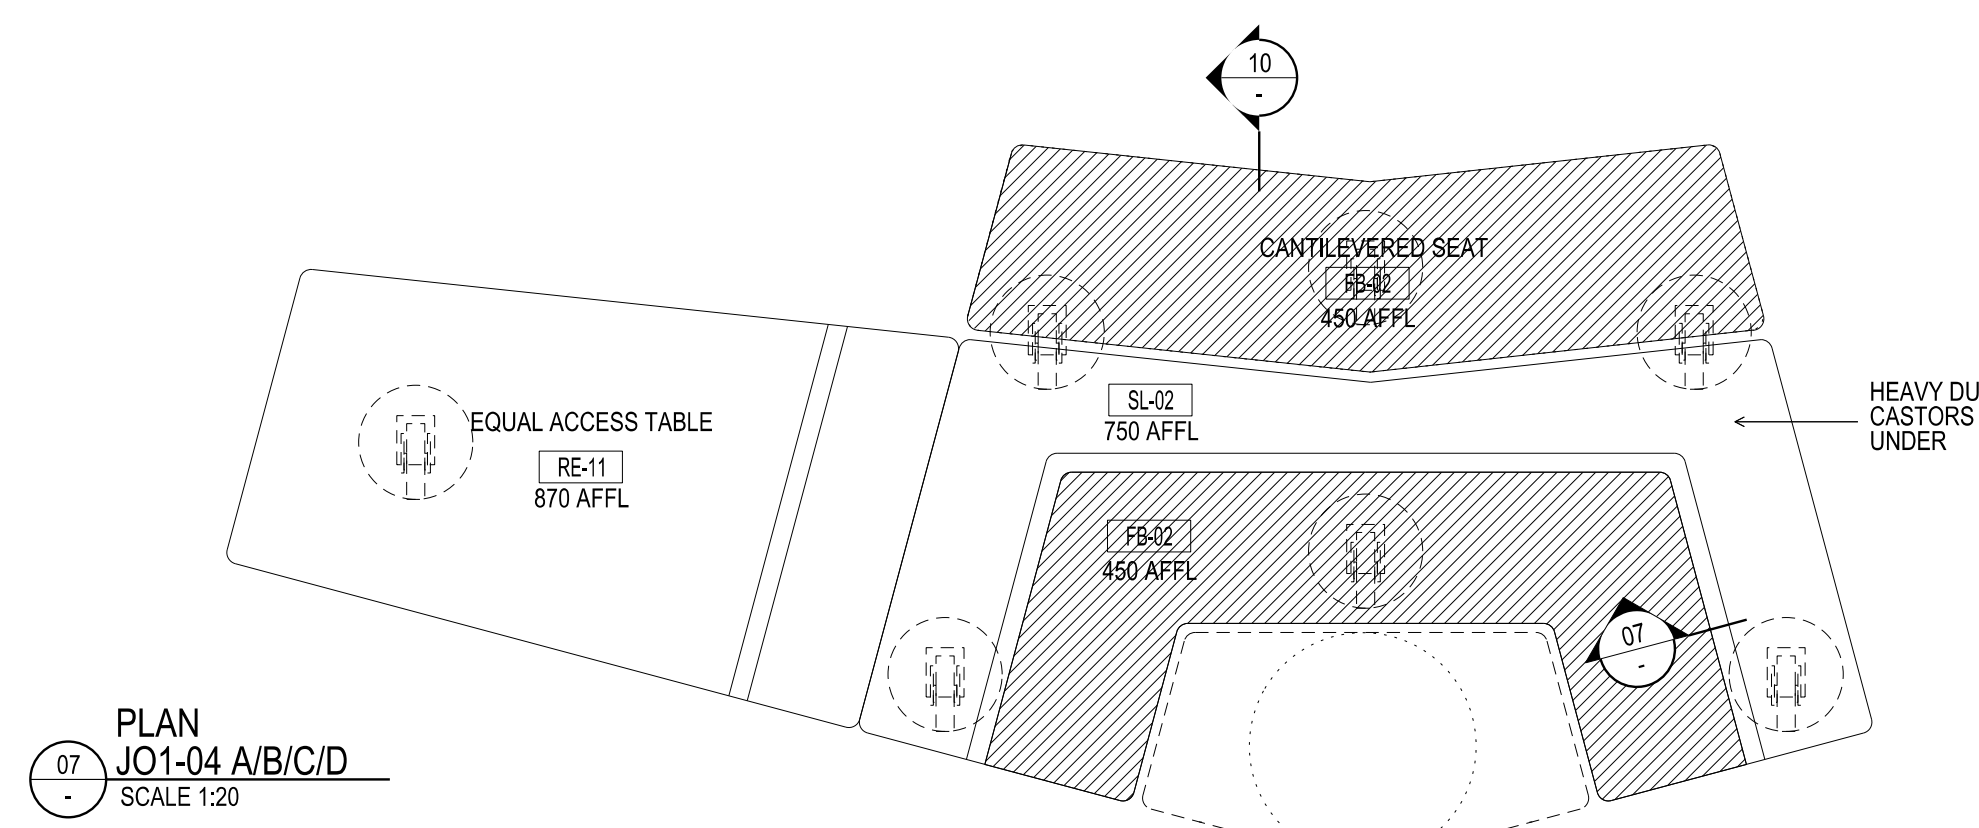


PLAN
J01-04 A/B/C/D
SCALE 1:20

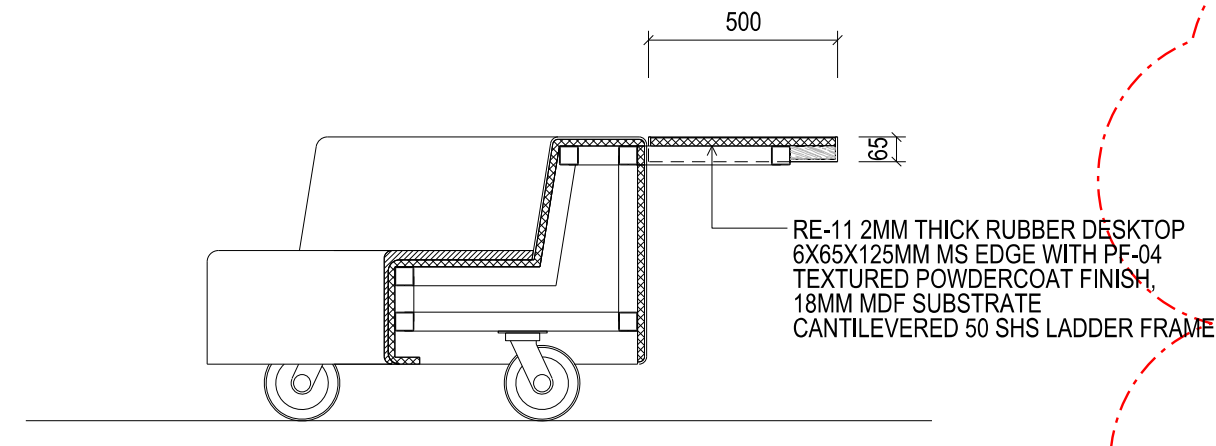


SECTION
J01-06 A/B/C/D
SCALE 1:20

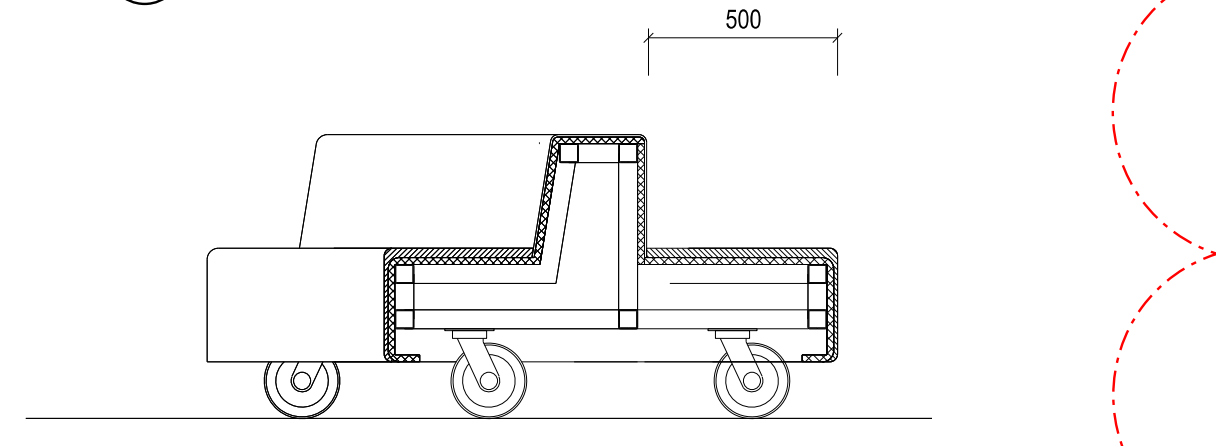


SECTION
J01-04 A/B/C/D
SCALE 1:20

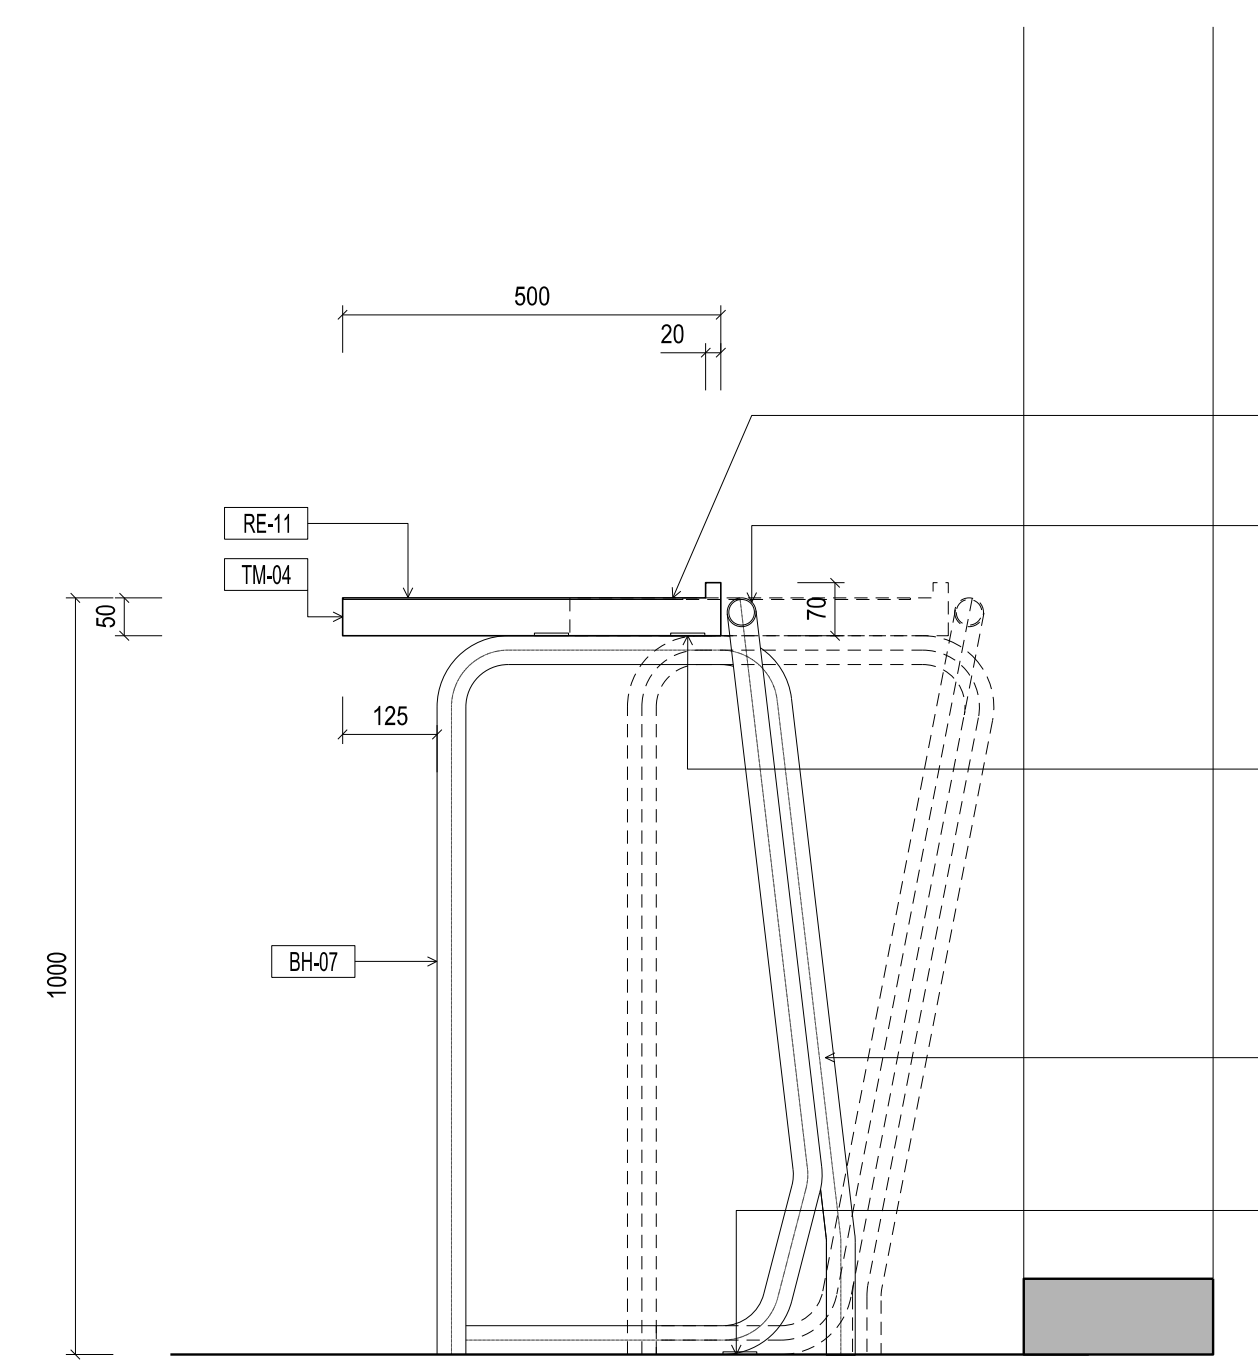


SECTION
J01-02C WINDOW COUNTER
SCALE 1:20

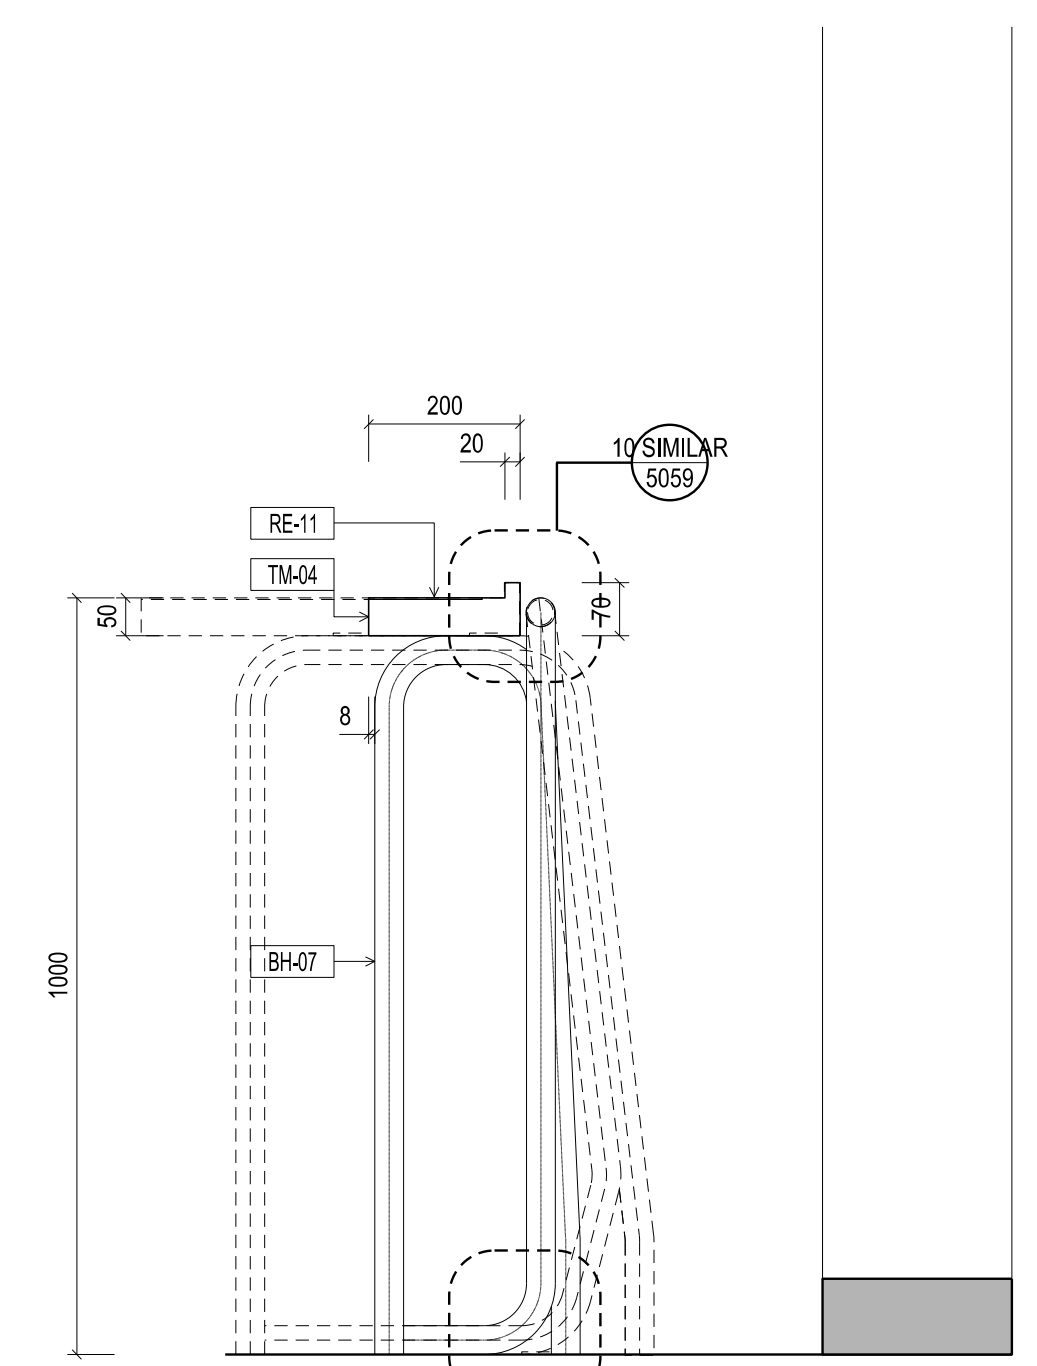


SECTION
J01-02C WINDOW COUNTER
SCALE 1:20

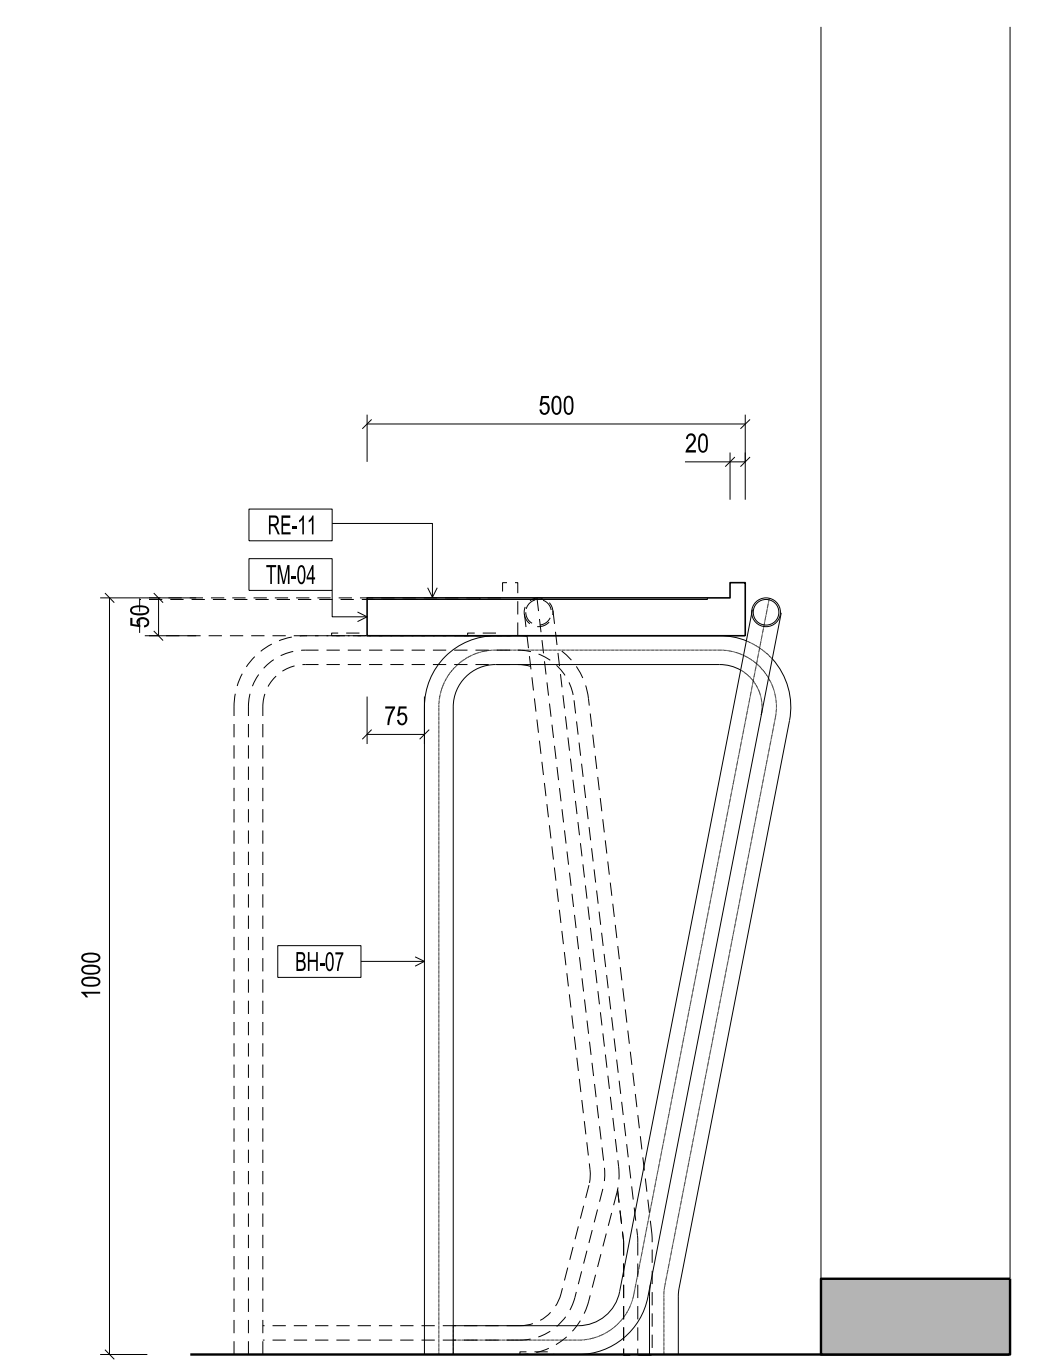

SECTION
J01-02C WINDOW COUNTER
SCALE 1:20

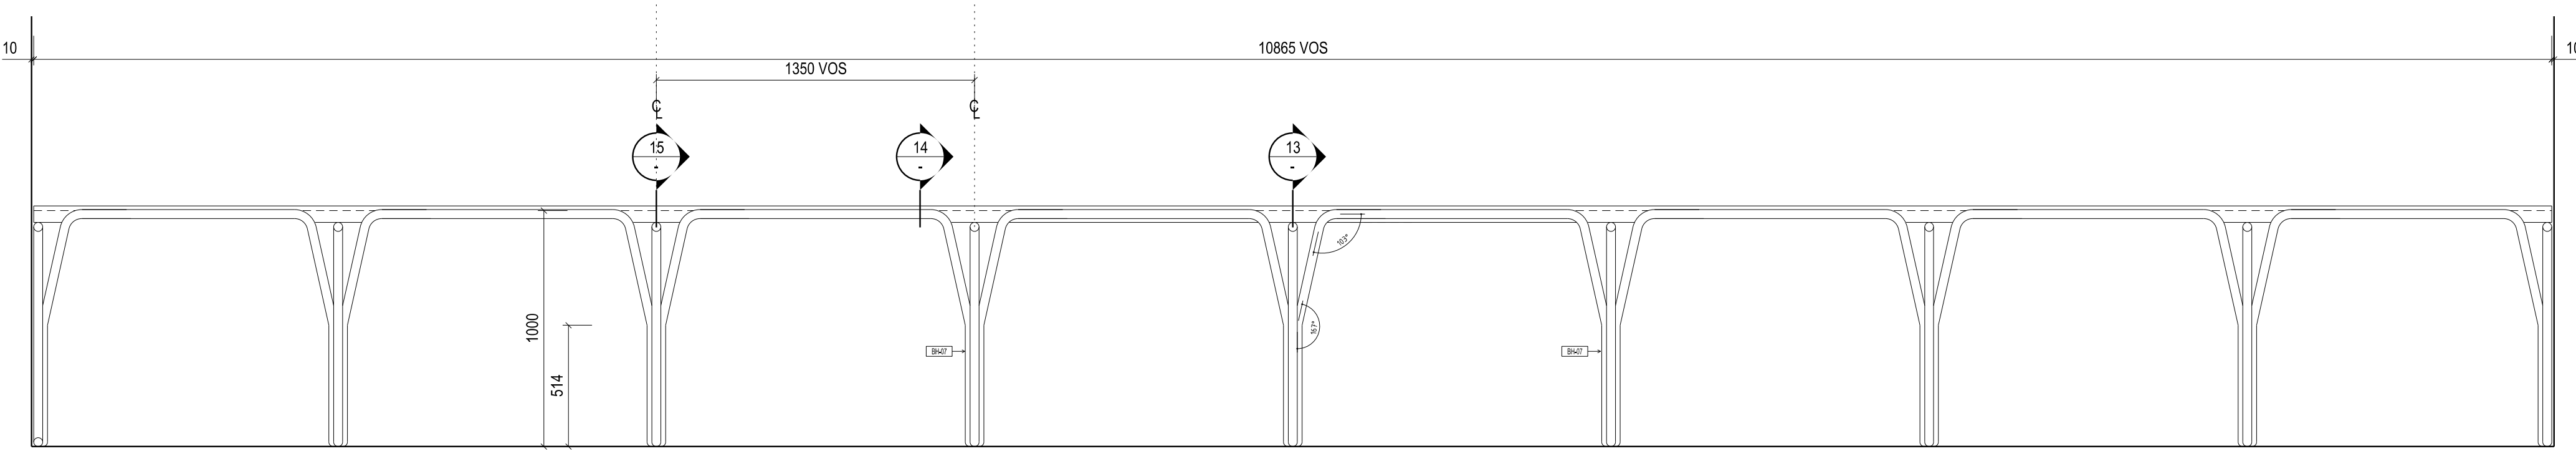

REAR ELEVATION
J01-02C WINDOW COUNTER
SCALE 1:20

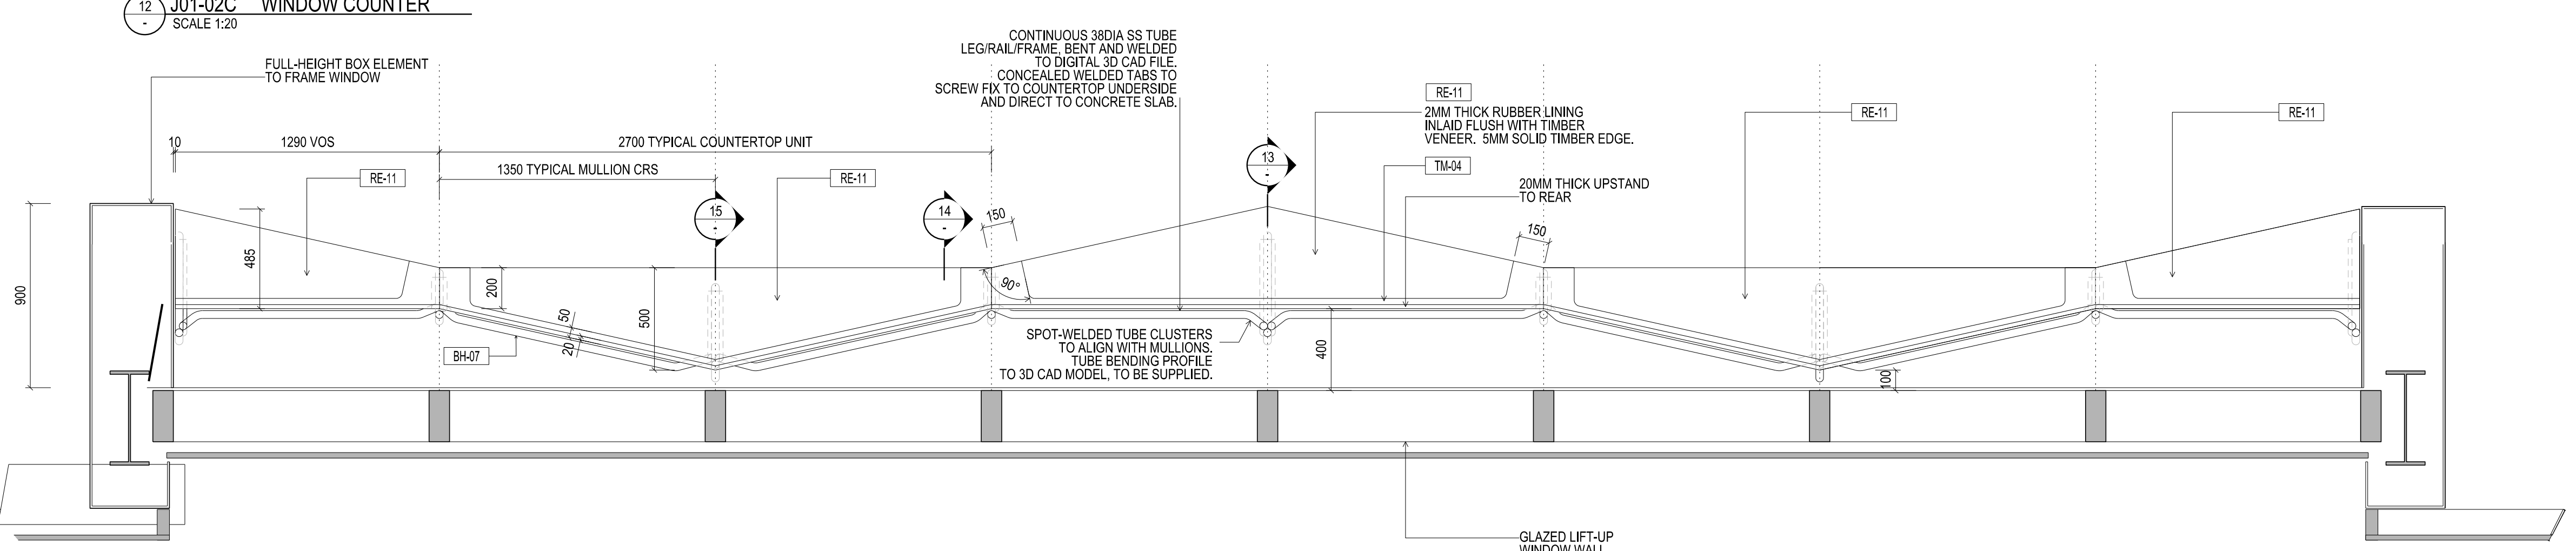

PLAN
J01-02C WINDOW COUNTER
SCALE 1:20

Rev	Issue	Revision Description	And	Date
A	SG	J01-02C DETAILS UPDATED	-	10.01.14
02	SG	J01-02C DETAILS ADDED	-	16.06.13
01	SG	ISSUED FOR ADDENDUM No.5	-	17.10.12



NADAAA
 NADAAA
 1520 Washington Street No.2 Boston Massachusetts 02118 USA
 Telephone +1 817 442 8232 Facsimile +1 888 442 1417 Email nadaaa@nadaaa.com

John Wardle Architects
 25 Rokeby Street, Collingwood, Victoria 3066 Australia
 Tel: +61 3 8662 0400 www.johnwardlearchitects.com
 © 2012 John Wardle Architects ABN 83 006 814 268

Client: University of Melbourne Parkville Campus
 Project: Faculty of Architecture Building and Planning
 Title: DETAILS L01 HALL MOBILE JOINERY

Project No.	0913	Scale	1:20 @ A0
Drawing No.	AR5712	Revision	A
Date	May 2011	Dwn	Co-Ord
FILENAME	- SFILES	Chk	

FOR CONSTRUCTION

