



CONTRACTORS SHALL VERIFY DIMENSIONS BEFORE ANY WORK COMMENCES. ALL SHOP DRAWINGS SHALL BE SUBMITTED TO THE SUPERINTENDENT AND MANUFACTURERS SHALL NOT COMMENCE FROM THE RETURN OF DIMENSIONS SHOP DRAWINGS ISSUED BY THE CONSULTANT. DIMENSIONS SHALL TAKE PRECEDENCE OVER SCALES. THIS DRAWING SHALL BE READ IN CONJUNCTION WITH ALL RELATED CONTRACT SPECIFICATIONS AND DRAWINGS COPYRIGHT OF THIS DRAWING IS VESTED IN HANDLE.


General Notes

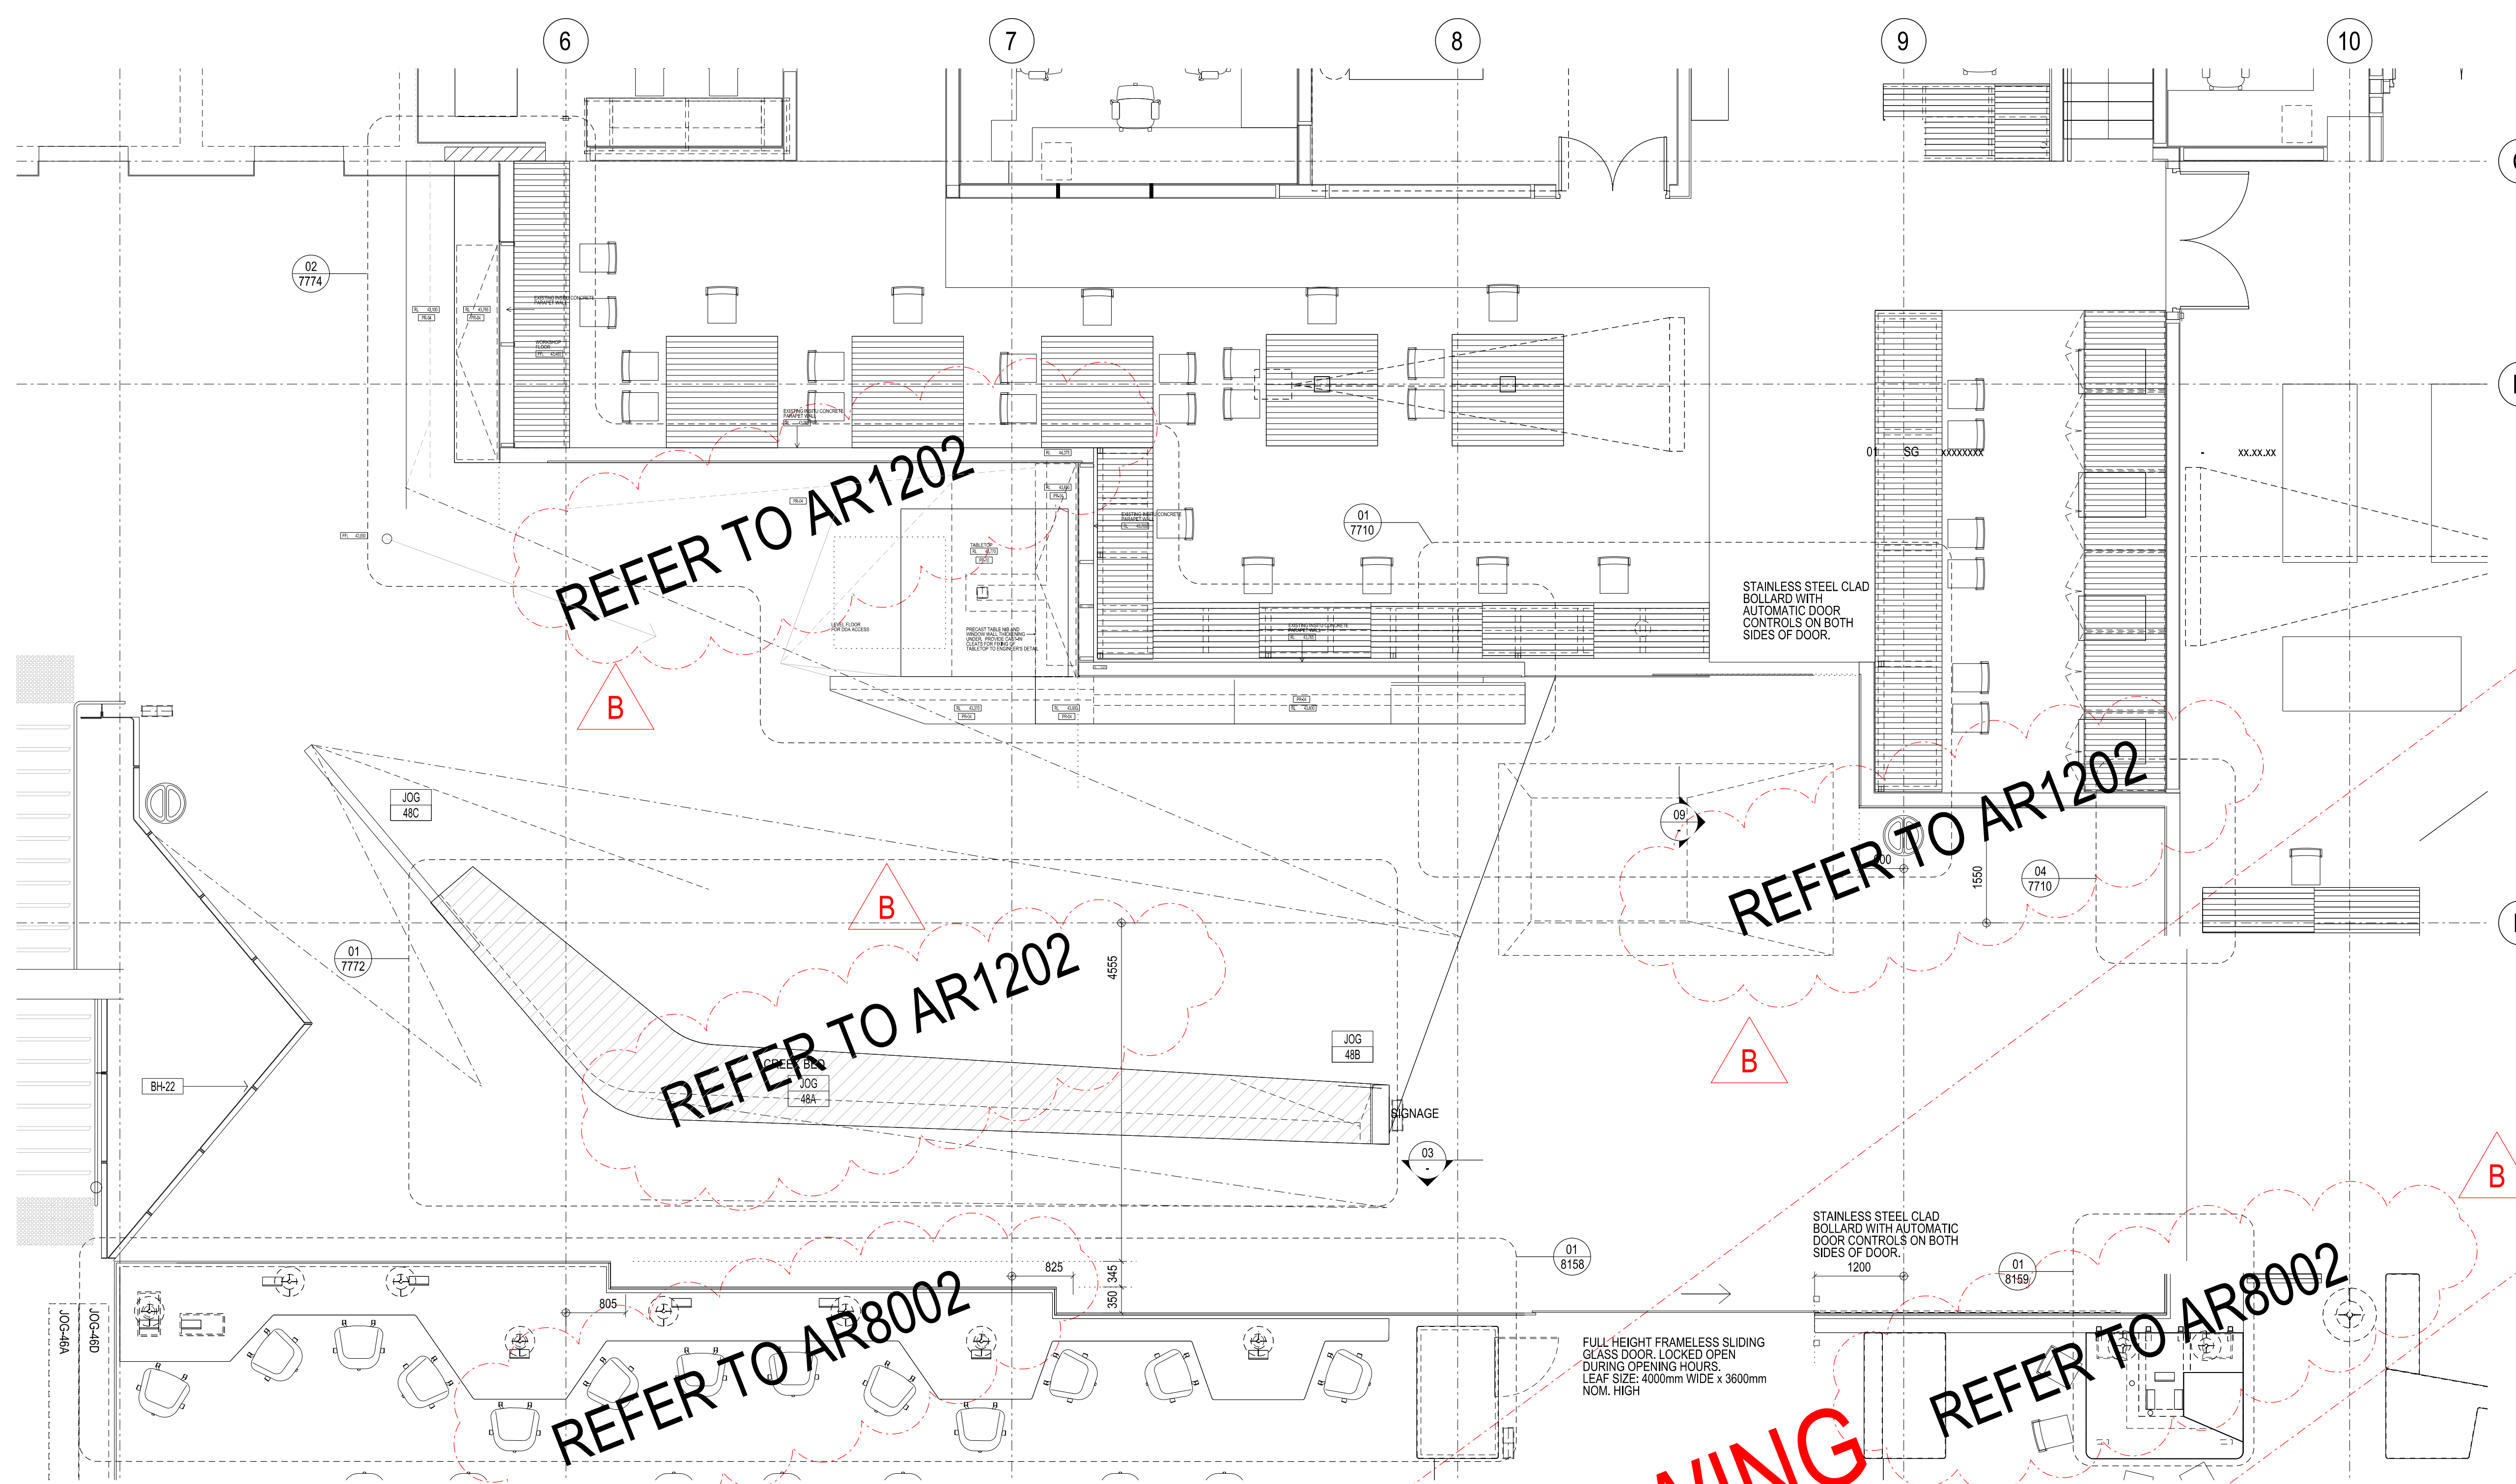


1 GROUND FLOOR - PARTIAL PLAN SCALE 1:50

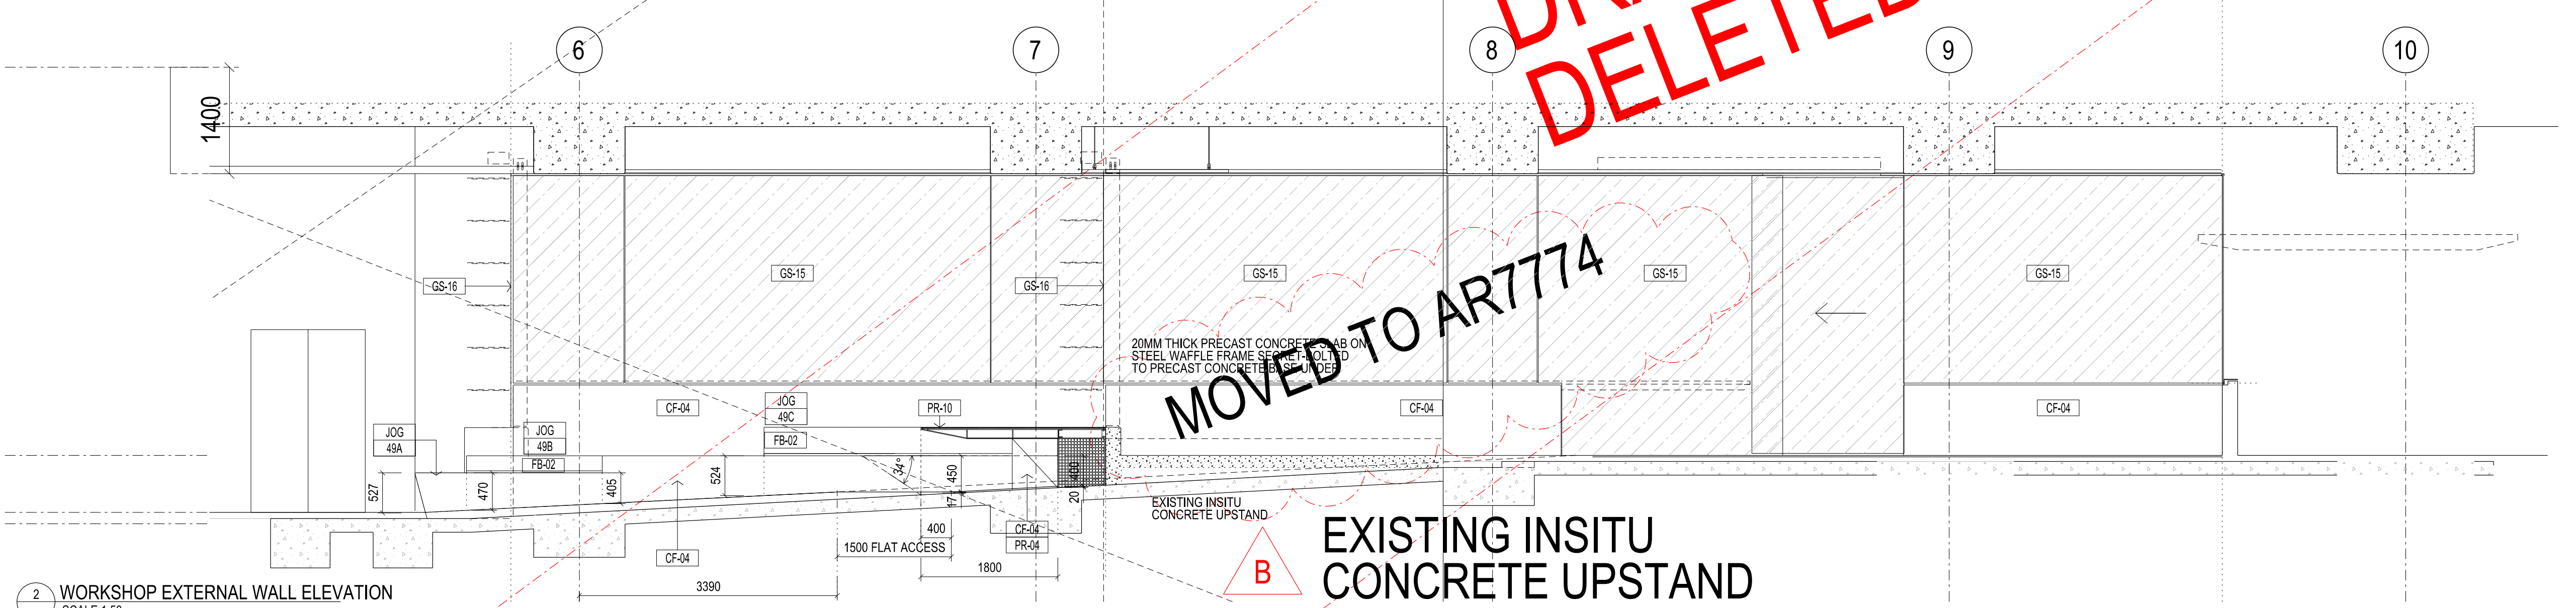

2 WORKSHOP EXTERNAL WALL ELEVATION SCALE 1:50

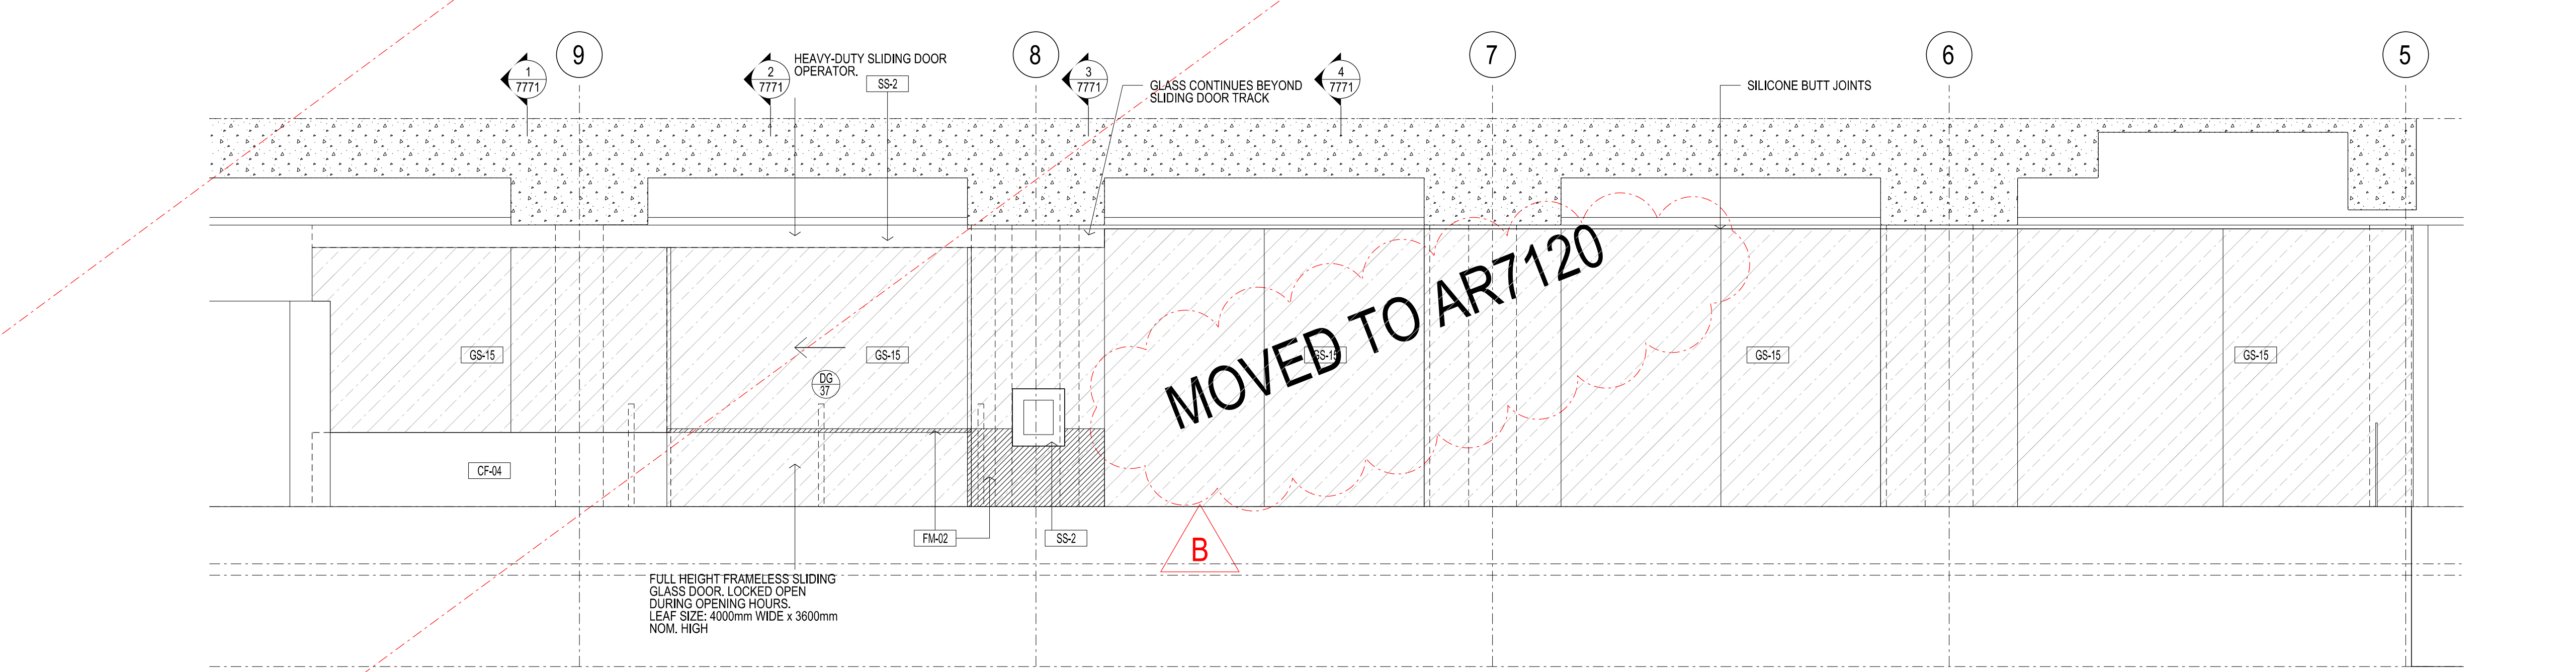

3 LIBRARY EXTERNAL WALL ELEVATION SCALE 1:50

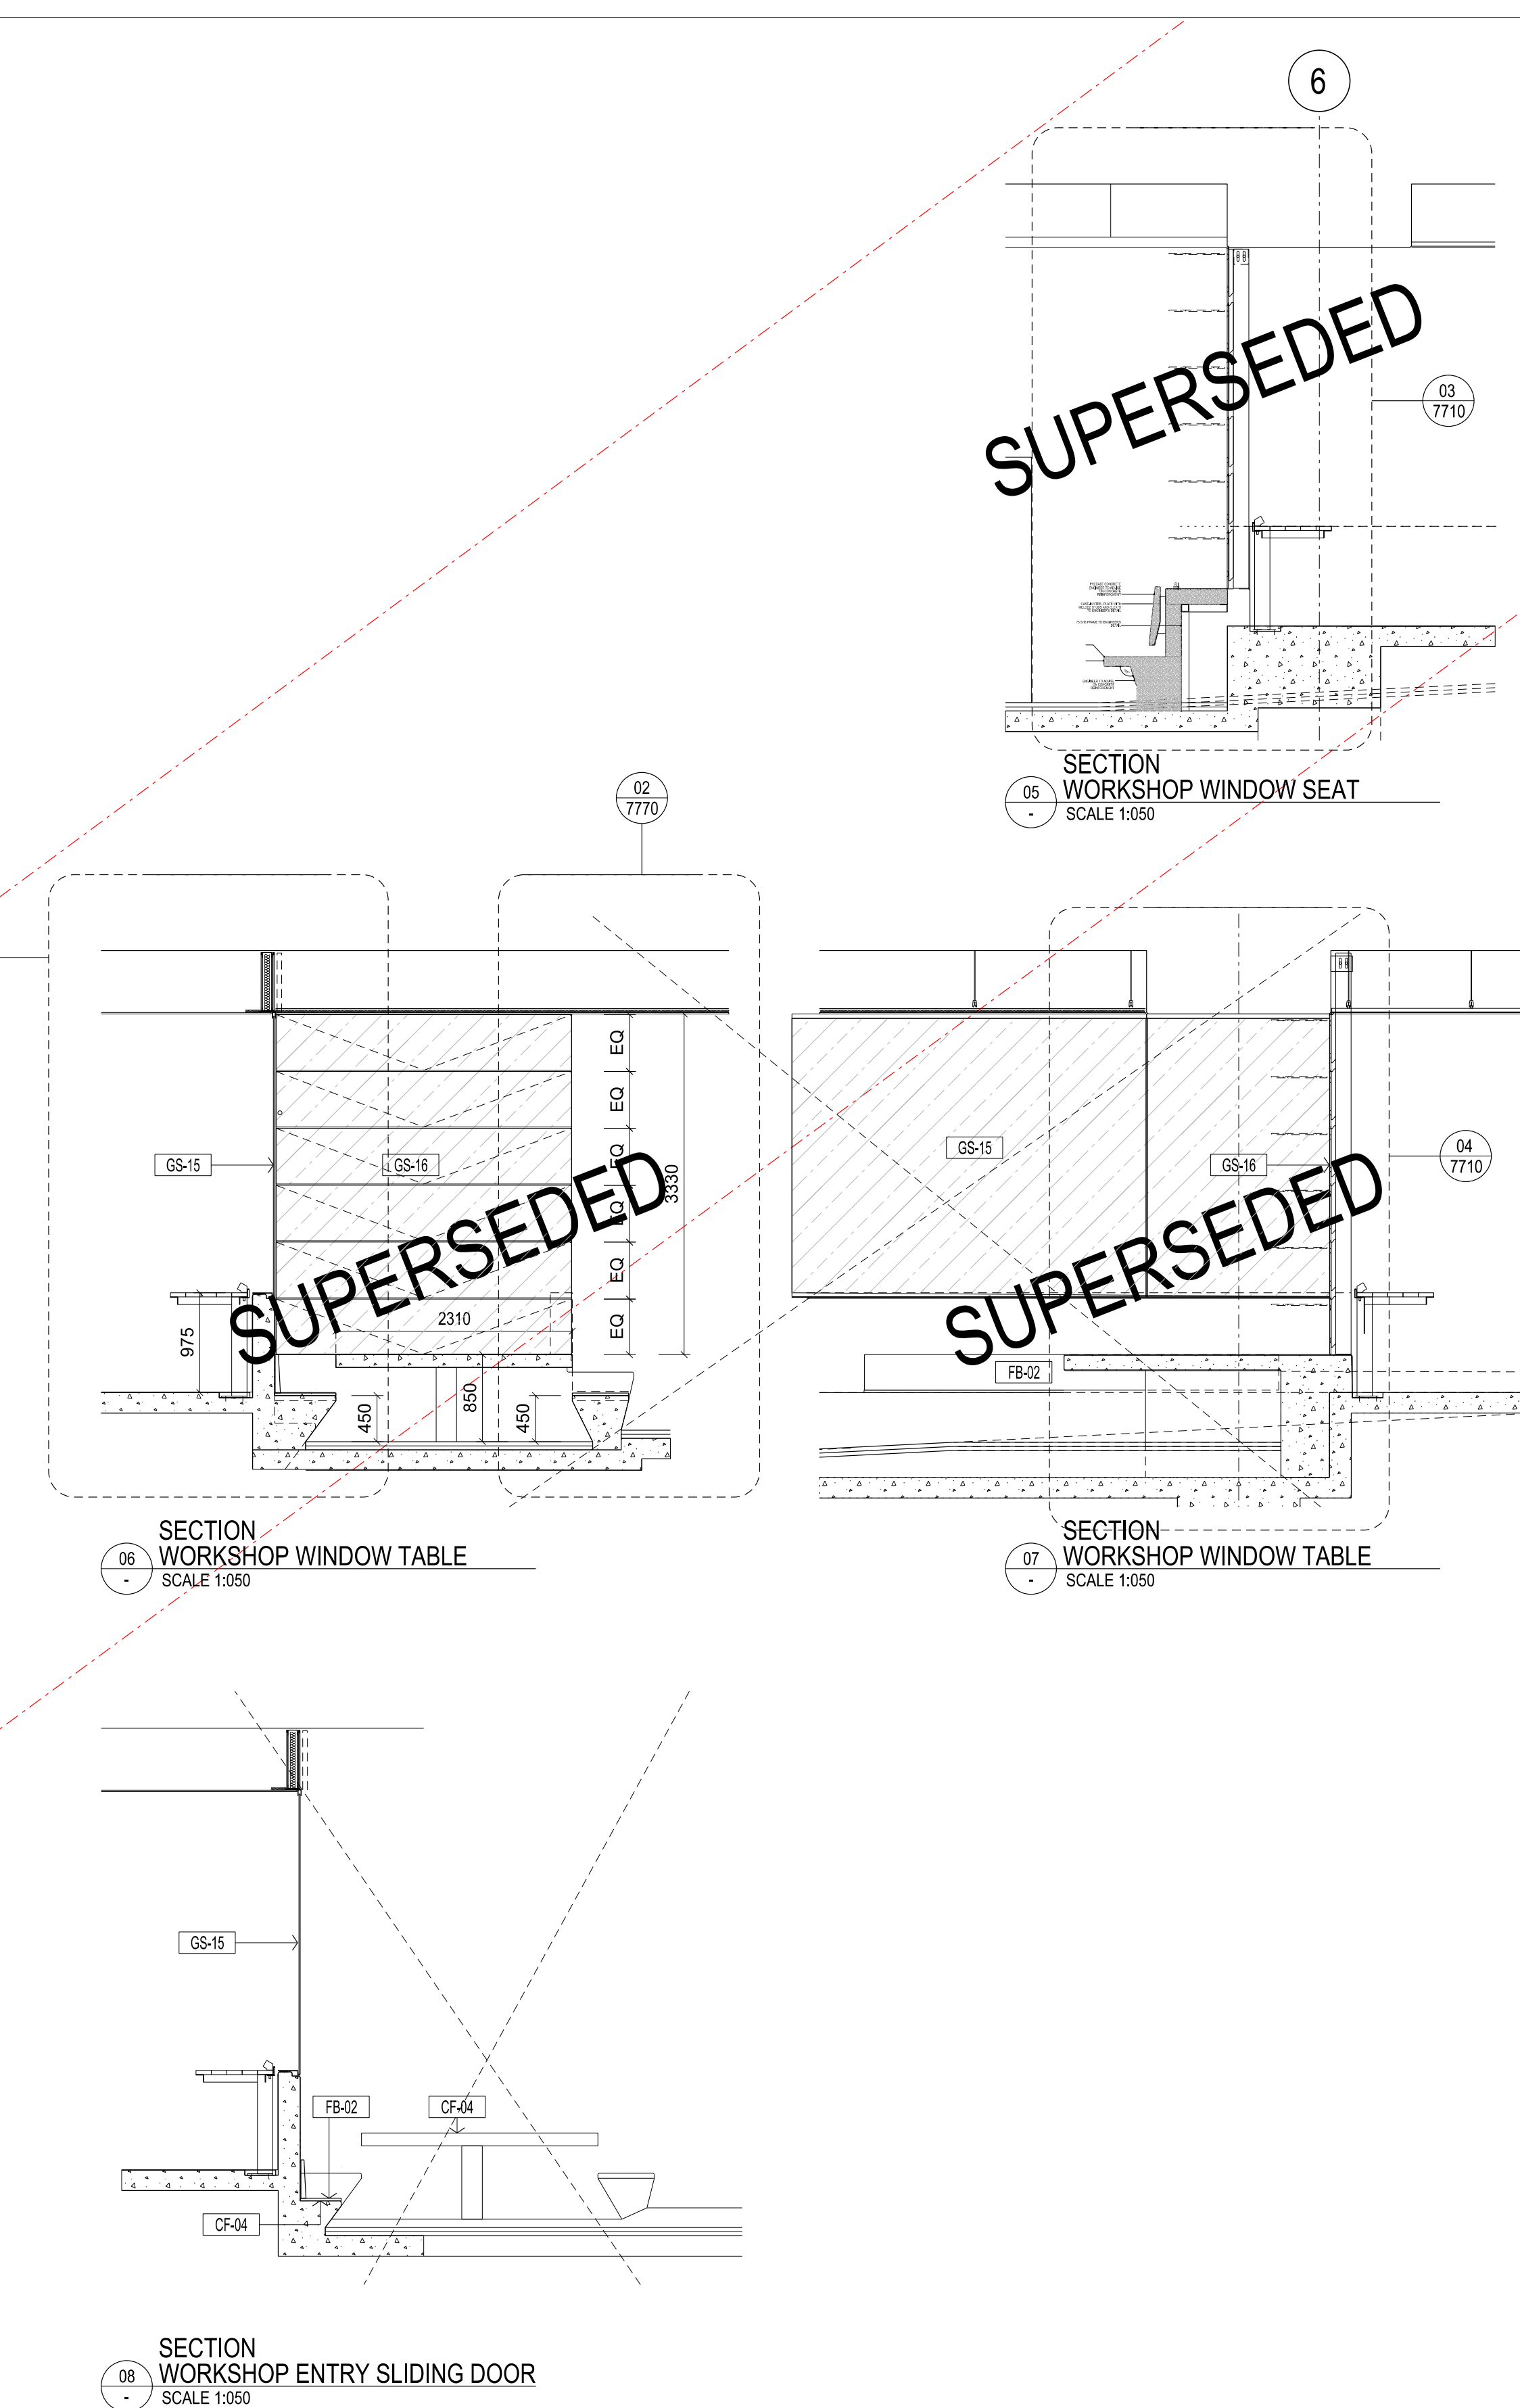

08 SECTION WORKSHOP ENTRY SLIDING DOOR SCALE 1:50

Rev	Issue	Revision Description	And	Date
B	SG	DRAWING DELETED		20.12.13
A	SG	FOR INFORMATION		08.12.13
03	SG	TENDER ADDENDUM 4		08.10.12
02	SG	100% CD - TENDER ISSUE		07.09.12
01	SG	95% CD ISSUE		10.08.12



NADAAA
 NADAAA
 1520 Washington Street No.2 Boston Massachusetts 02118 USA
 Telephone +1 617 442 8232 Facsimile +1 688 442 1417 Email nad@nadaaa.com

John Wardle Architects
 25 Rokeby Street, Collingwood, Victoria 3066 Australia
 Tel: +61 3 8662 0400 www.johnwardlearchitects.com
 © 2012 John Wardle Architects ABN 83 006 814 268

Client University of Melbourne Parkville Campus

Project Faculty of Architecture Building and Planning

Title INTERIOR ELEVATIONS G01 FOYER GLAZING

Project No.	0913	Scale	1:50 @ A0
Drawing No.	AR5730	Revision	B

Date: May 2011 Drawn: Co-Ord: Check:

FILENAME - \$FILES FOR CONSTRUCTION