


THIS DRAWING IS AN UNCONTROLLED COPY UNLESS STAMPED OTHERWISE

CONTRACTORS SHALL VERIFY JOB DIMENSIONS BEFORE ANY JOB COMMENCES. ALL SHOP DRAWINGS SHALL BE SUBMITTED TO THE SUPERINTENDENT AND MANUFACTURERS SHALL NOT COMMENCE PRIOR TO THE RETURN OF DIMENSIONS. SHOP DRAWINGS ISSUED BY THE CONSULTANT FIGURED DIMENSIONS SHALL TAKE PRECEDENCE OVER SCALED. THIS DRAWING SHALL BE READ IN CONJUNCTION WITH ALL RELEVANT CONTRACT SPECIFICATIONS AND DRAWINGS COPYRIGHT OF THIS DRAWING IS VESTED IN NADAAA

General Notes

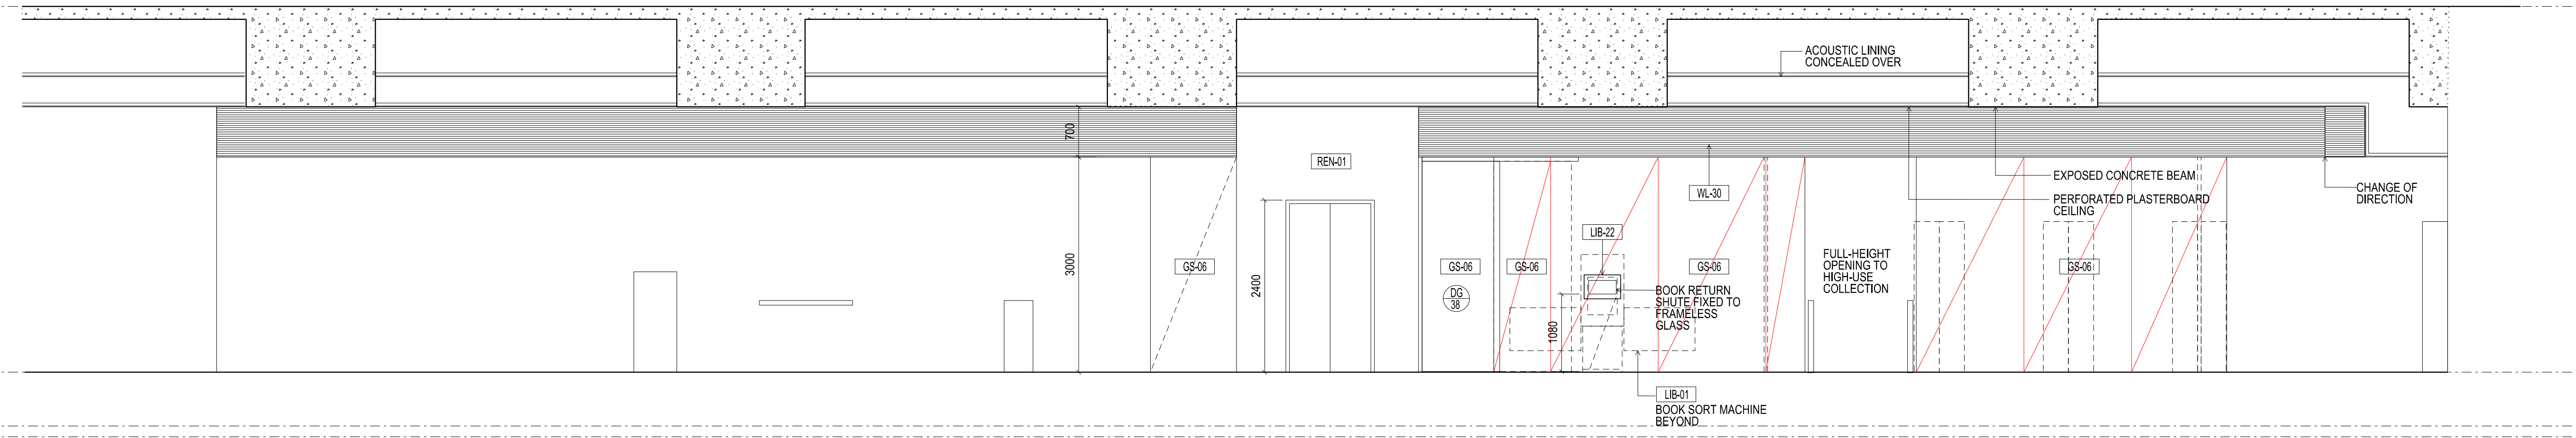

ELEVATION
LIBRARY HIGH-USE COLLECTION
SCALE 1:50

Rev	Issue	Revision Description	Amd	Date
A	SG	ISSUED FOR CONSTRUCTION	-	10.01.14
02	SG	100% CD - TENDER ISSUE	-	07.09.12
01	SG	JAPANESE ROOM DWGS MOVED TO AR5750	-	10.08.12
01	SG	90% CD ISSUE	-	10.08.12

Rev	Issue	Revision Description	Amd	Date



NADAAA

NADAAA
1320 Washington
Street No.2
Boston
Massachusetts
02118 USA

Telephone
+1 617 442 8232
Facsimile
+1 688 442 1417
Email
nadaa@nadaaa.com

John Wardle Architects

25 Rokeby Street, Collingwood, Victoria 3066 Australia
Tel : +61 3 8662 0400 www.johnwardlearchitects.com
© 2012 John Wardle Architects ABN 83 006 814 268

Client **University of Melbourne
Parkville Campus**

Project **Faculty of Architecture
Building and Planning**

Title **LIBRARY INTERNAL ELEVATIONS
LEVEL G01**

	Project No.	0913	Scale	1:50 @ A0 1:100 @ A2
	Drawing No.	AR5731	Revision	A

Date	Apr 2012	Dwn	-	Co-Ord	-	Chk	-
------	----------	-----	---	--------	---	-----	---

FILENAME - \$FILES
FOR CONSTRUCTION