



CONTRACTORS SHALL VERIFY JOB DIMENSIONS BEFORE ANY JOB COMMENCES. ALL SHOP DRAWINGS SHALL BE SUBMITTED TO THE SUPERINTENDENT AND MANUFACTURERS SHALL NOT COMMENCE FROM THE RETURN OF DIMENSIONS SHOP DRAWINGS ISSUED. BY THE CONTRACTOR. DIMENSIONS SHALL TAKE PRECEDENCE OVER SCALES. THIS DRAWING SHOULD BE READ IN CONJUNCTION WITH ALL RELEVANT CONTRACT SPECIFICATIONS AND DRAWINGS COPYRIGHT OF THIS DRAWING IS VESTED IN HANDLE.


General Notes

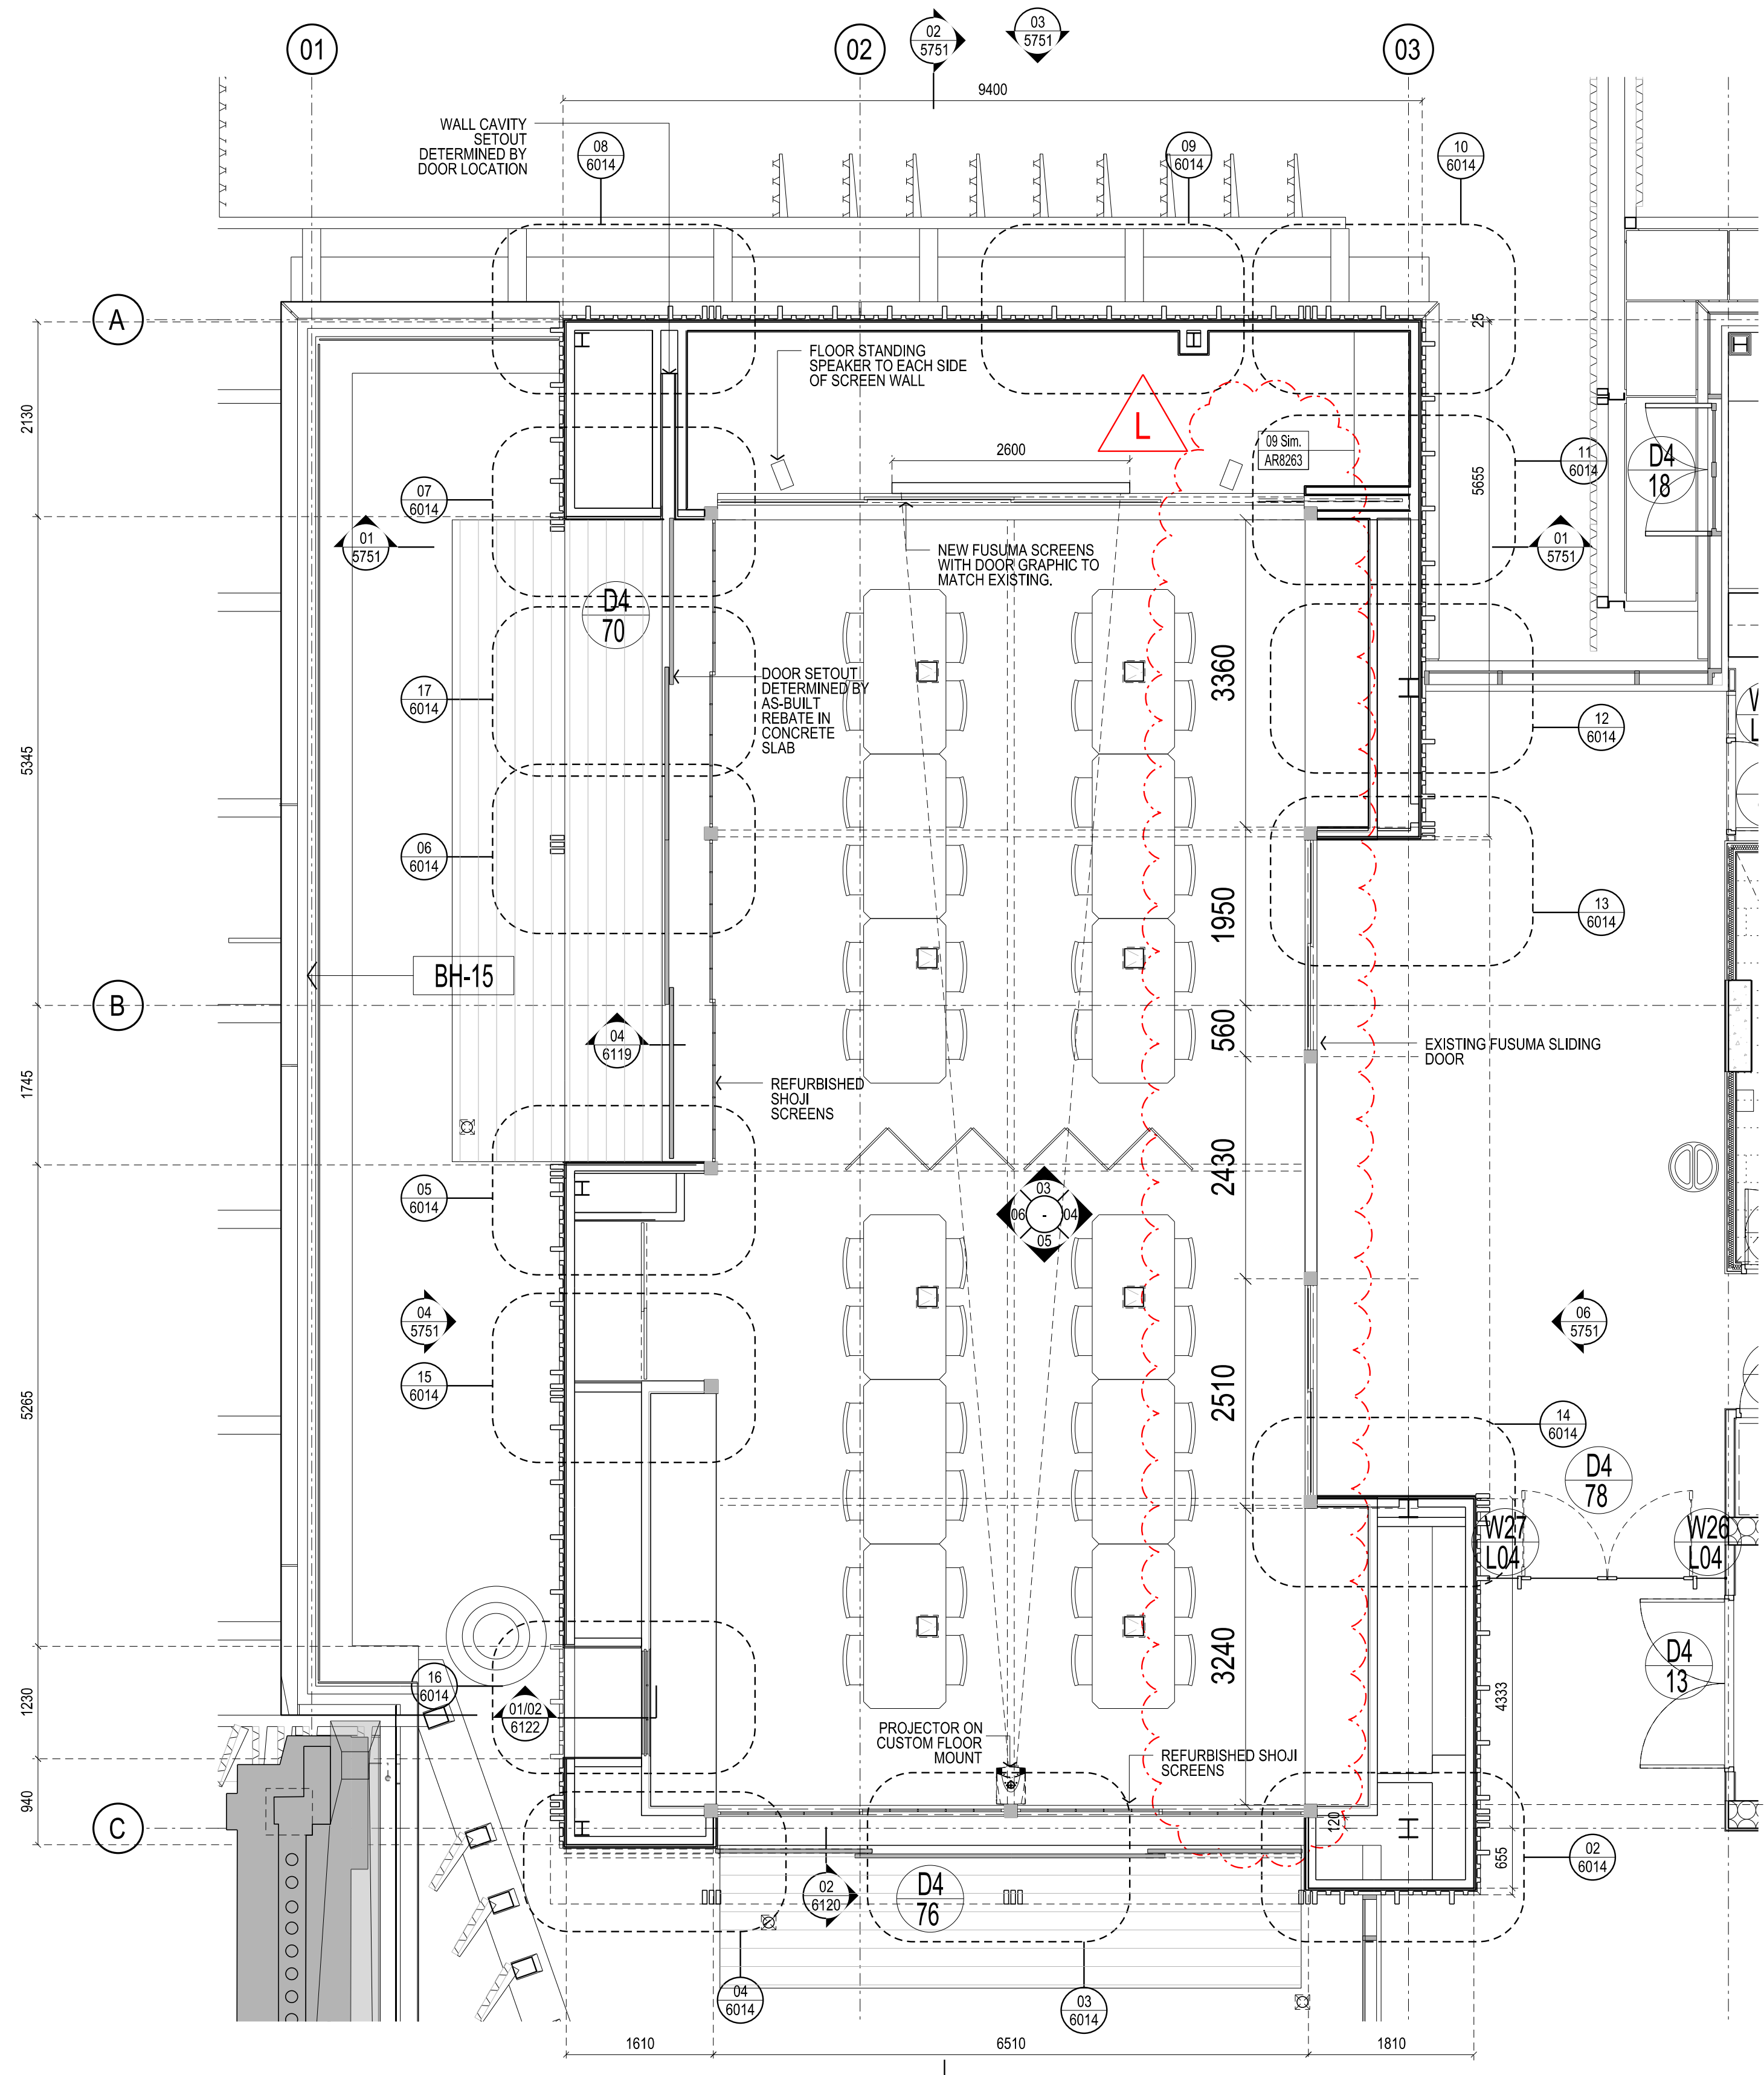


01 JAPANESE ROOM PLAN
SCALE 1:50

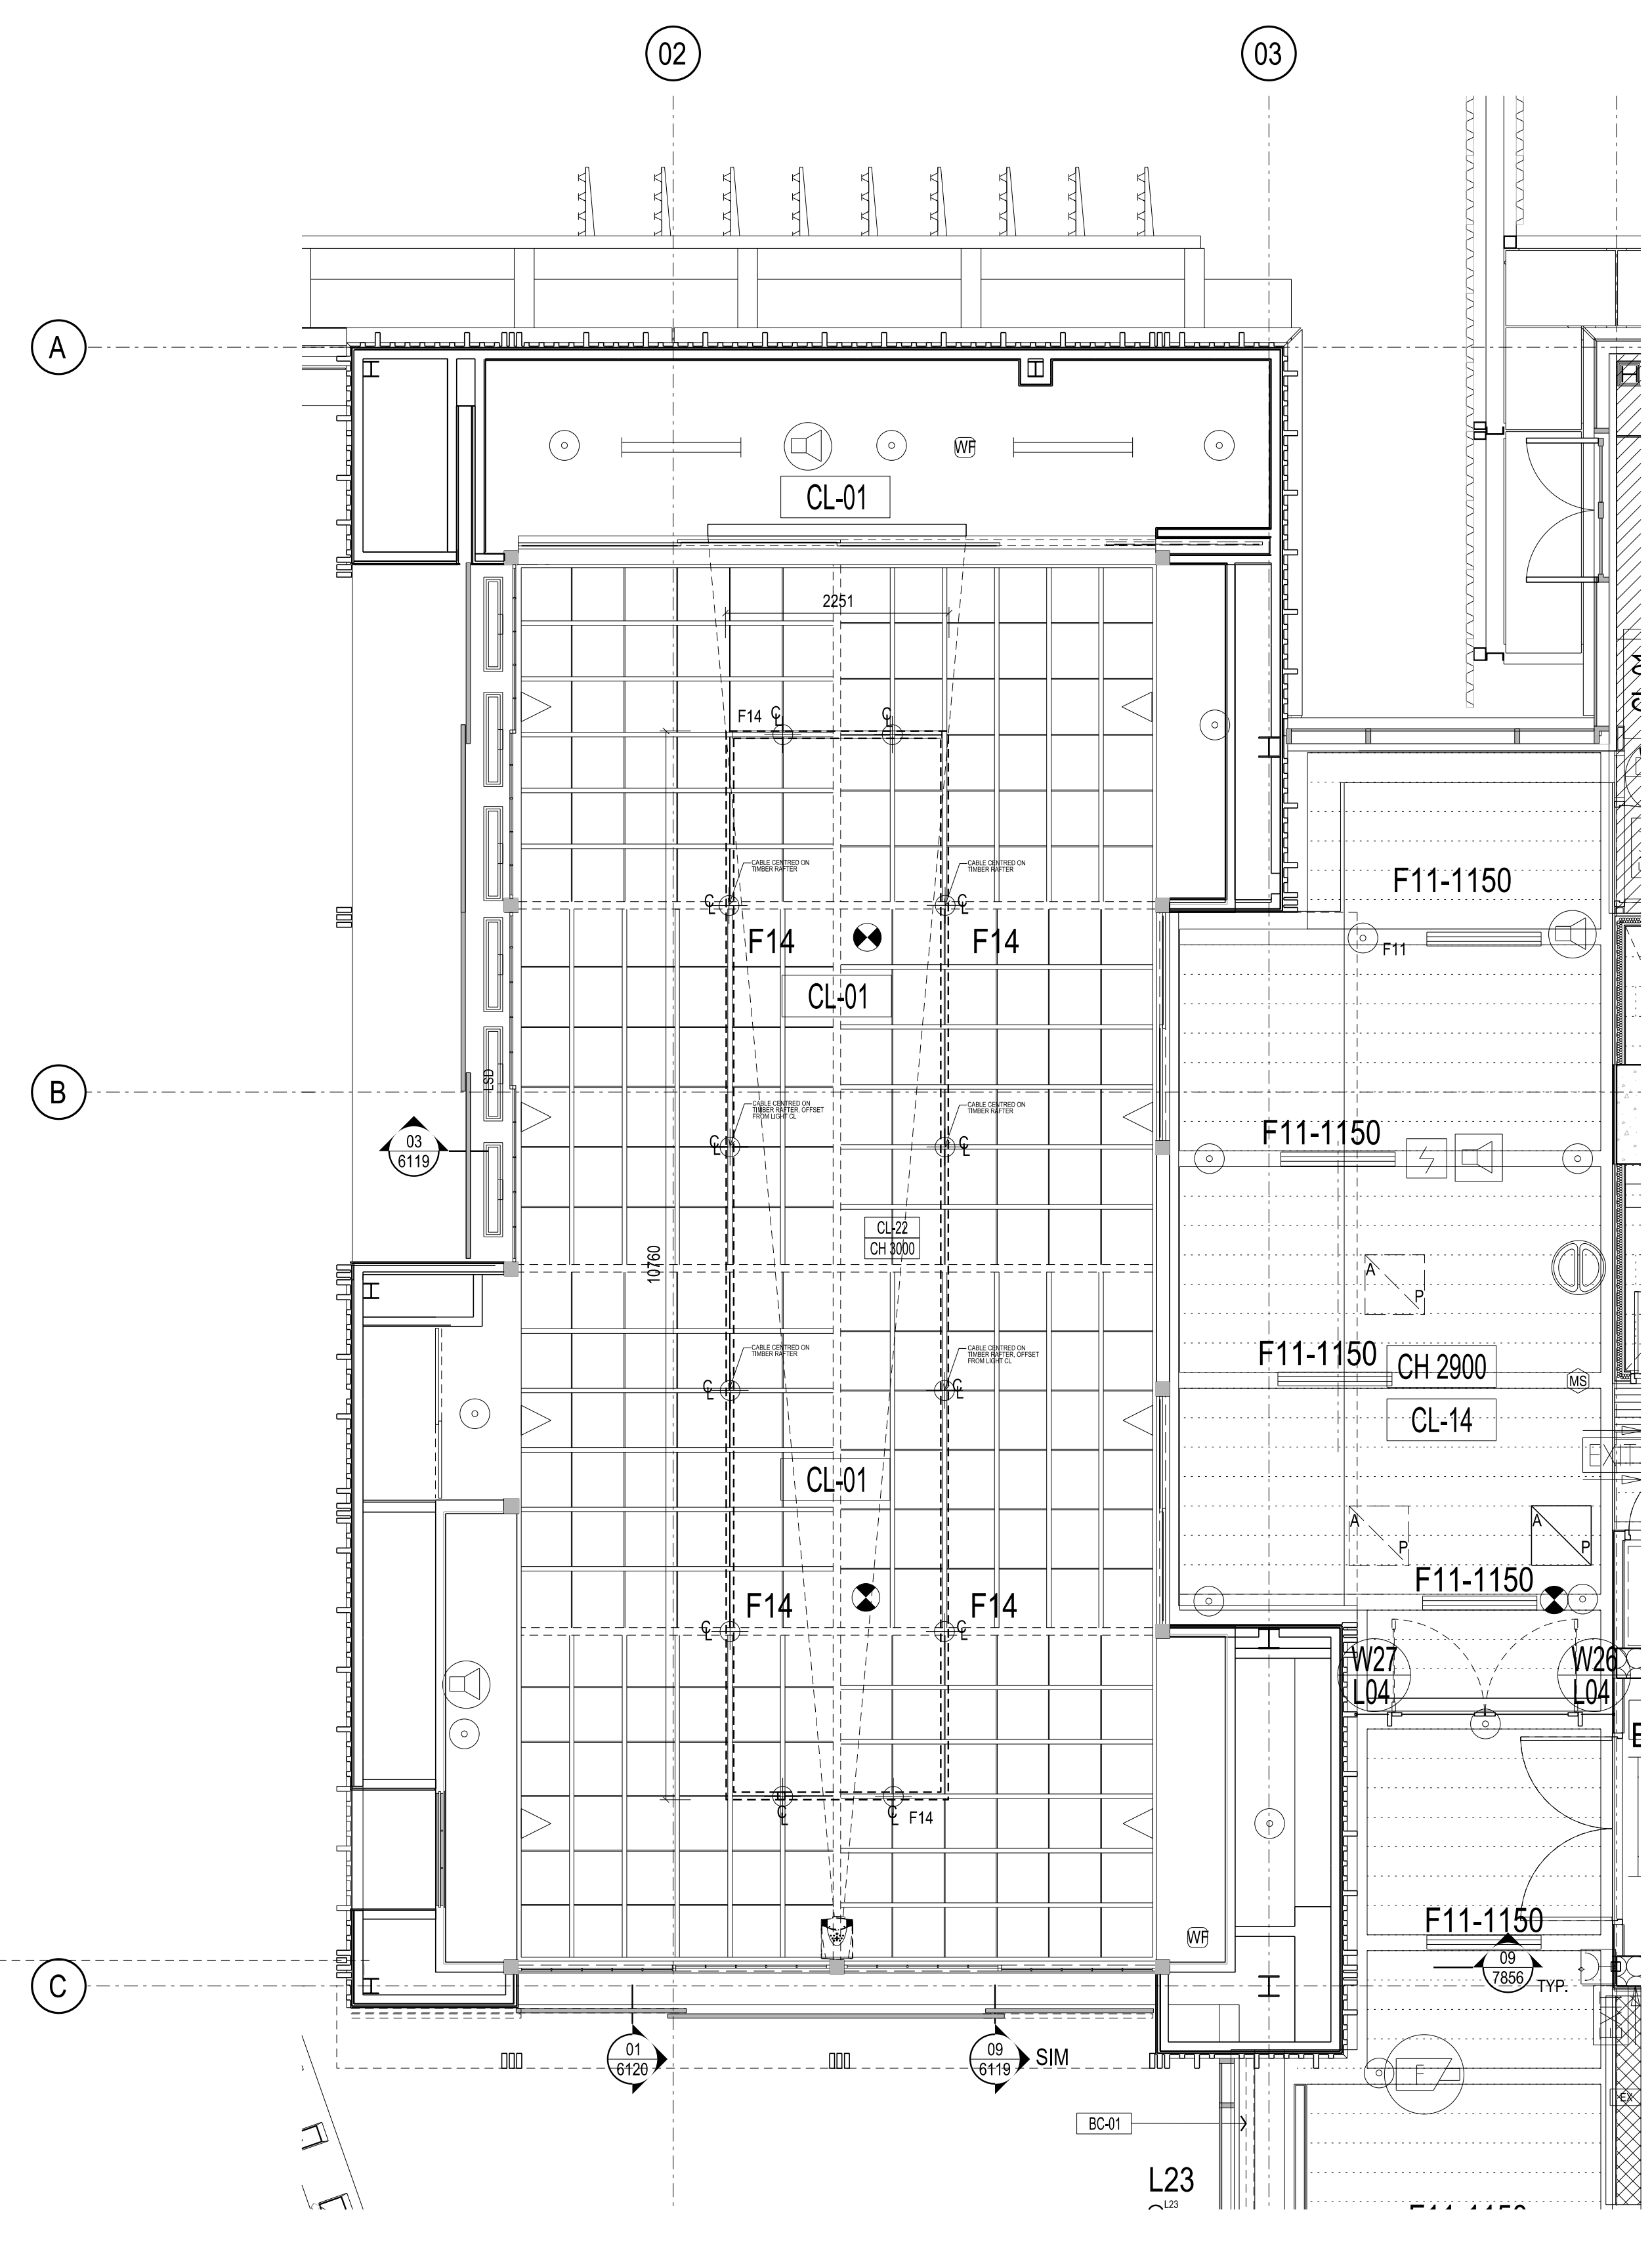


02 JAPANESE ROOM REFLECTED CEILING PLAN
SCALE 1:50

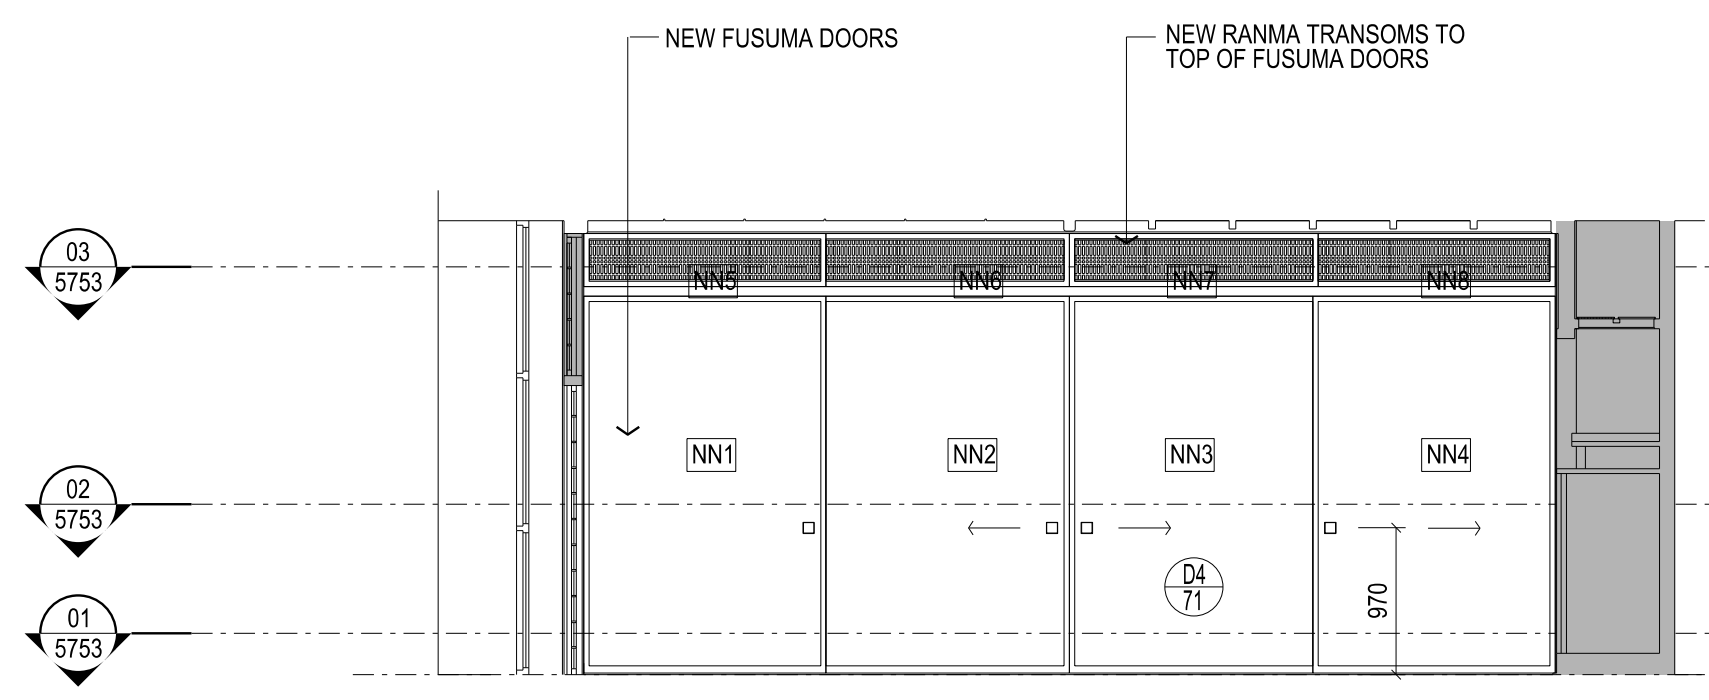


03 PROPOSED NORTH INTERIOR ELEVATION
FUSUMA SCREENS CLOSED
SCALE 1:50

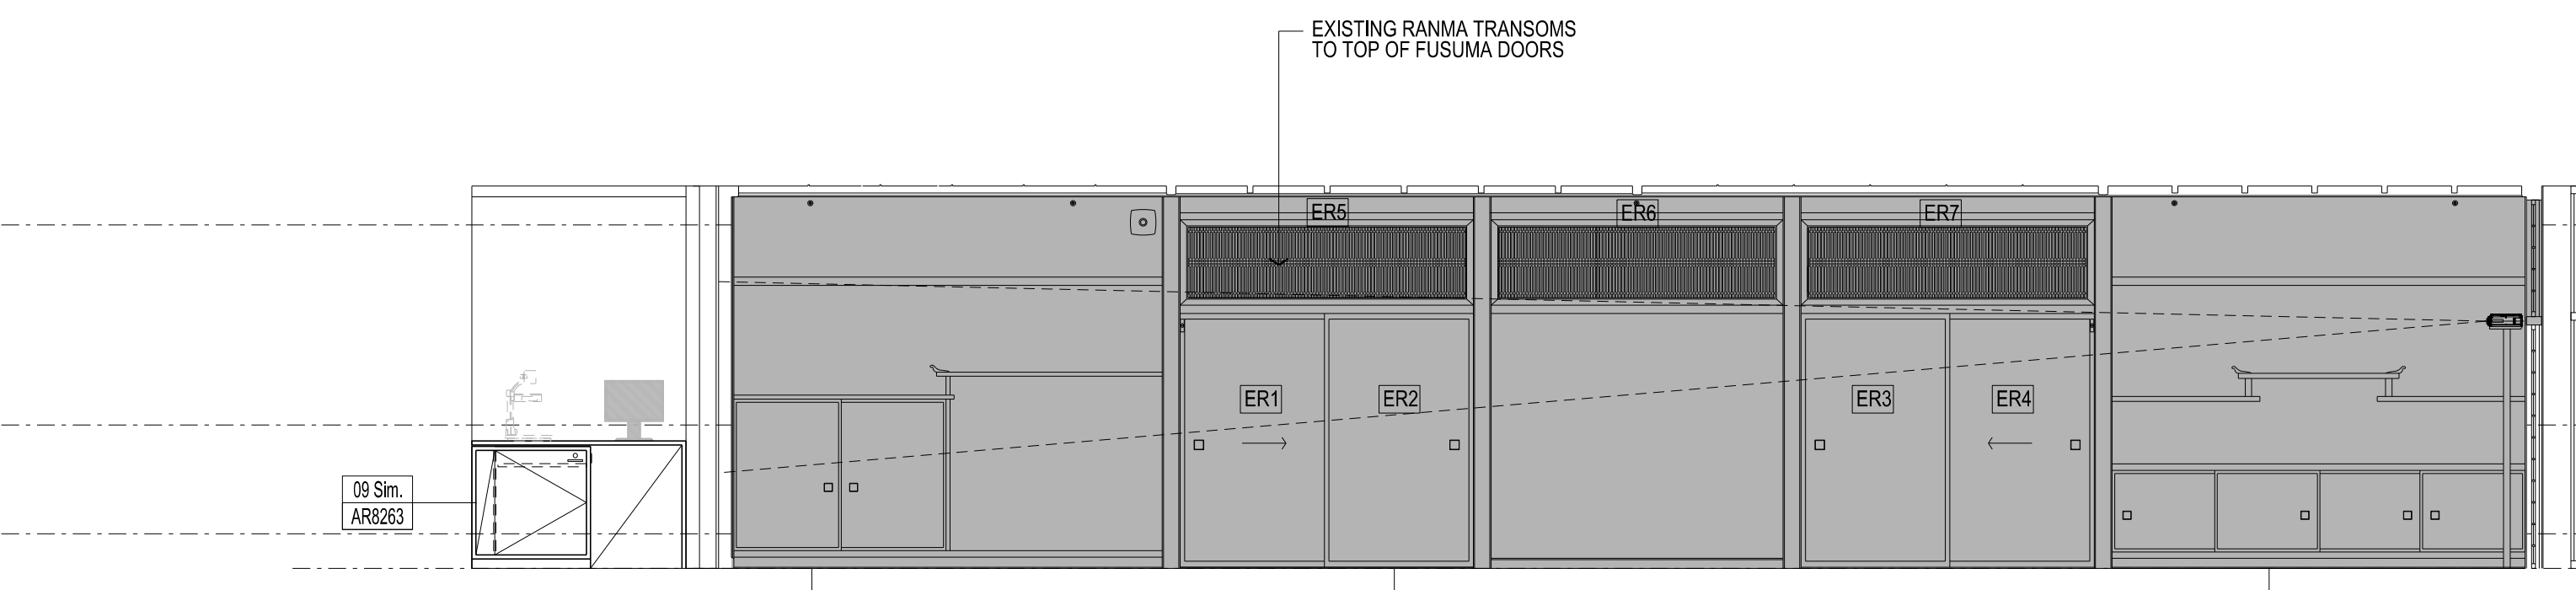

04 PROPOSED EAST INTERIOR ELEVATION
SCALE 1:50

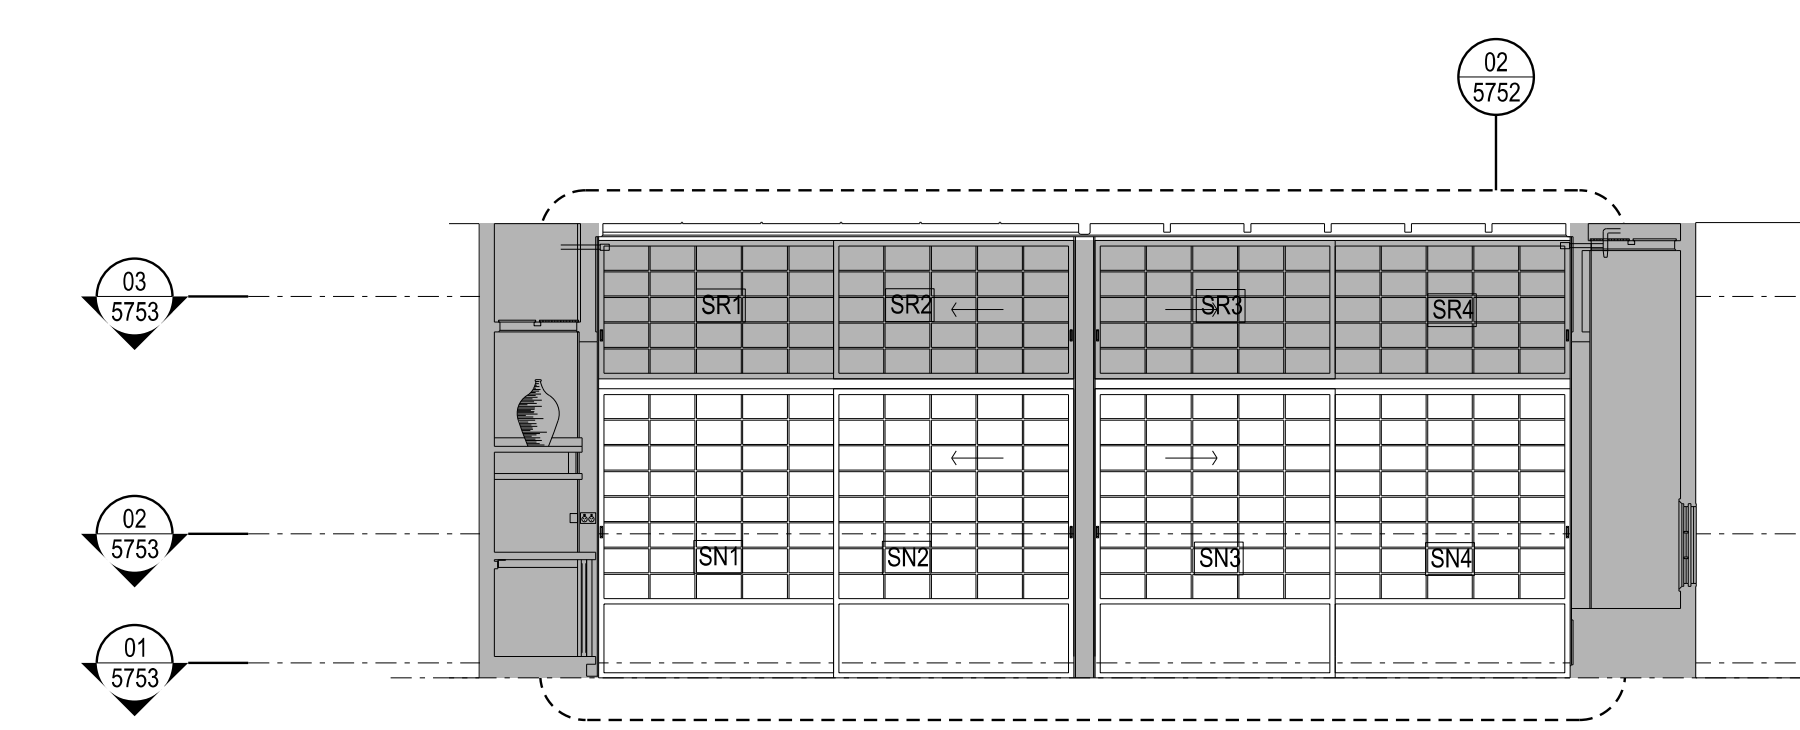

05 PROPOSED SOUTH INTERIOR ELEVATION
SCALE 1:50

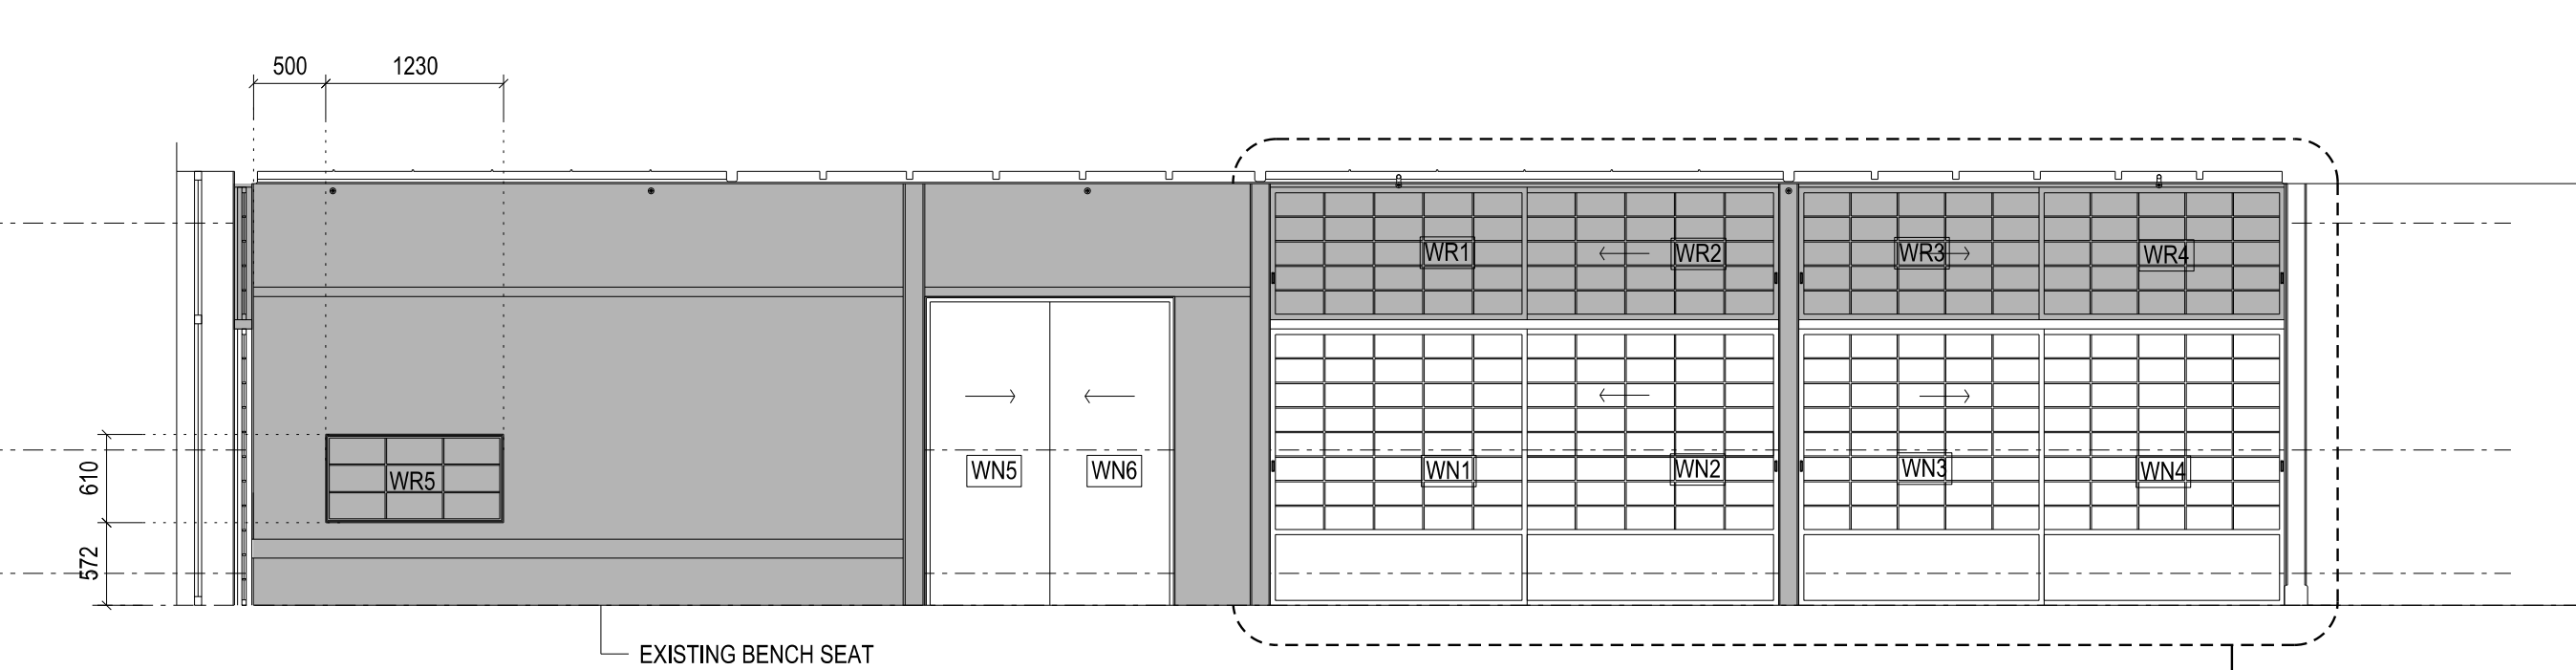

06 PROPOSED WEST INTERIOR ELEVATION
SCALE 1:50

EXISTING TO BE RETAINED

Rev	Issue	Revision Description	And	Date
L	SG	UPDATES AS CLOUED		03.06.14
K	SG	UPDATES AS CLOUED		02.05.14
J	SG	UPDATES AS CLOUED		17.04.14
H	SG	UPDATES AS CLOUED		04.04.14
G	SG	SLIDING EXTERNAL DOORS UNDER REVIEW		26.03.14
F	SG	UPDATES AS CLOUED		28.02.14
E	SG	UPDATES AS CLOUED		13.02.14
D	SG	UPDATES AS CLOUED		06.02.14
C	SG	UPDATES AS CLOUED		21.01.14
B	SG	ISSUED FOR CONSTRUCTION		14.01.14
A	SG	ISSUED FOR CONSTRUCTION		10.01.14
04	SG	100% CD - TENDER ISSUE - UPDATE		12.09.12
03	SG	100% CD - TENDER ISSUE		07.09.12
02	SG	90% CD ISSUE		10.08.12
01	SG	75% CD ISSUE		13.07.12



NADAAA
 NADAAA
 1520 Washington Street No.2 Boston Massachusetts 02118 USA
 Telephone +1 817 442 8232 Facsimile +1 888 442 1417 Email nadaaa@nadaaa.com

John Wardle Architects
 25 Rokeby Street, Collingwood, Victoria 3066 Australia
 Tel: +61 3 8662 0400 www.johnwardlearchitects.com
 © 2014 John Wardle Architects ABN 83 006 814 268

Client **University of Melbourne Parkville Campus**

Project **Faculty of Architecture Building and Planning**

Title **Japanese Room PLAN, RCP & INTERIOR ELEVATIONS**

Project No.	0913	Scale	1:50 @ A0 1:100 @ A2
Drawing No.	AR5750	Revision	L
Date	Apr 2012	Dwn	JL
		Co-Ord	JA
		Chk	SG

FOR CONSTRUCTION