



CONTRACTORS SHALL VERIFY DIMENSIONS BEFORE ANY JOB COMMENCES. ALL SHOP DRAWINGS SHALL BE SUBMITTED TO THE SUPERINTENDENT AND MANUFACTURER SHALL NOT COMMENCE PRIOR TO THE RETURN OF DIMENSIONED SHOP DRAWINGS REVIEWED BY THE CONSULTANT. DIMENSIONS SHALL TAKE PRECEDENCE OVER SCALES. THIS DRAWING SHALL BE READ IN CONJUNCTION WITH ALL RELEVANT CONTRACT SPECIFICATIONS AND DRAWINGS COPYRIGHT OF THIS DRAWING IS VESTED IN WARDLE.


General Notes

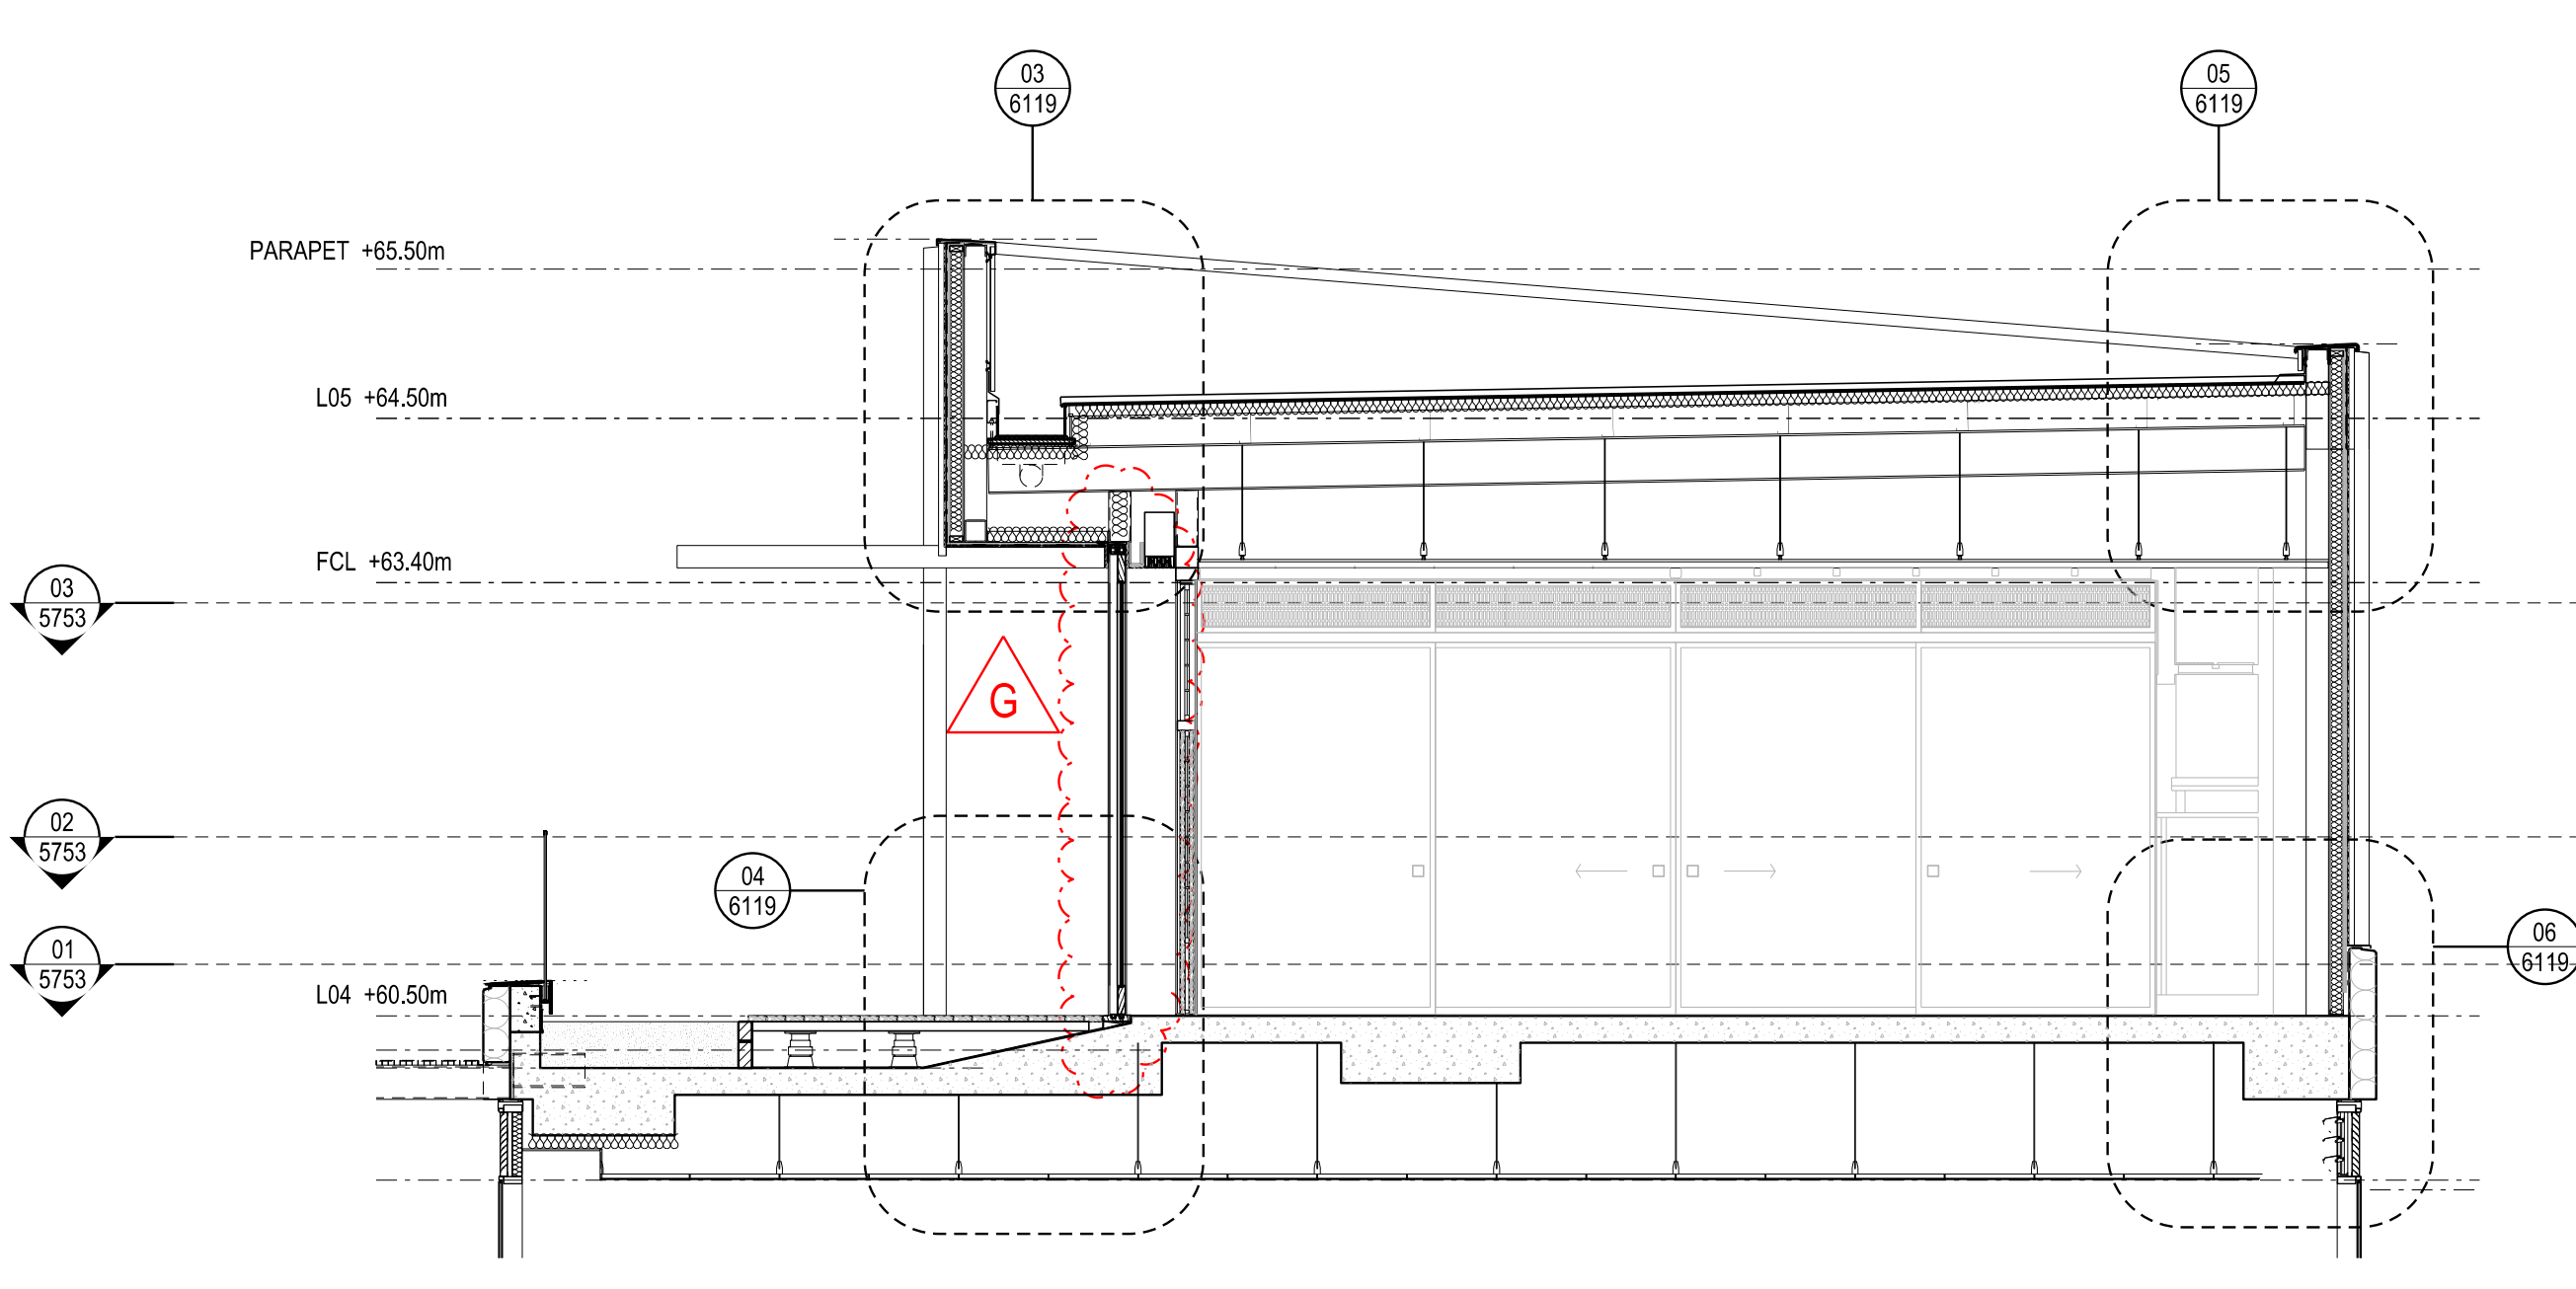


01 JAPANESE ROOM SECTION A  
SCALE 1:50

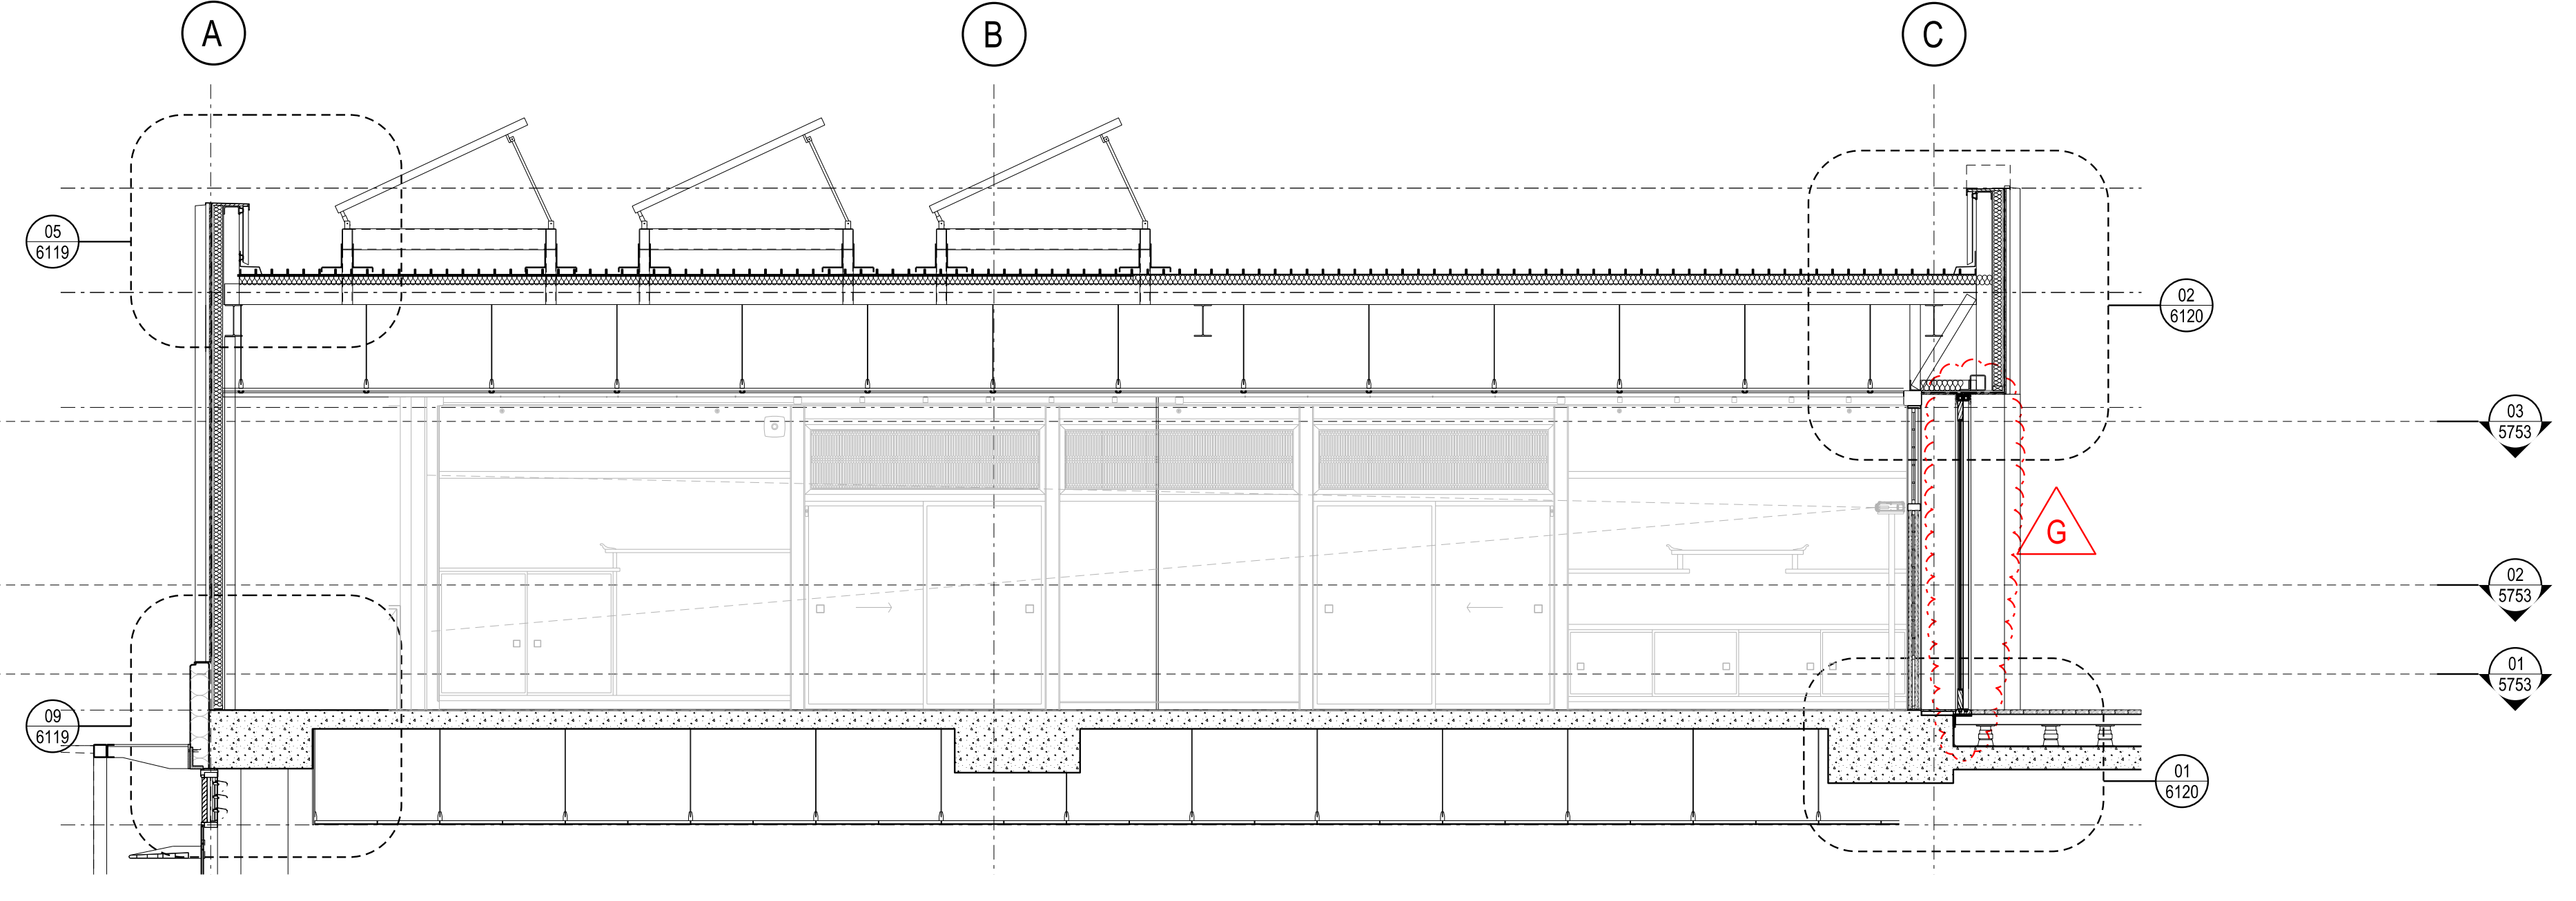


02 JAPANESE ROOM SECTION D  
SCALE 1:50

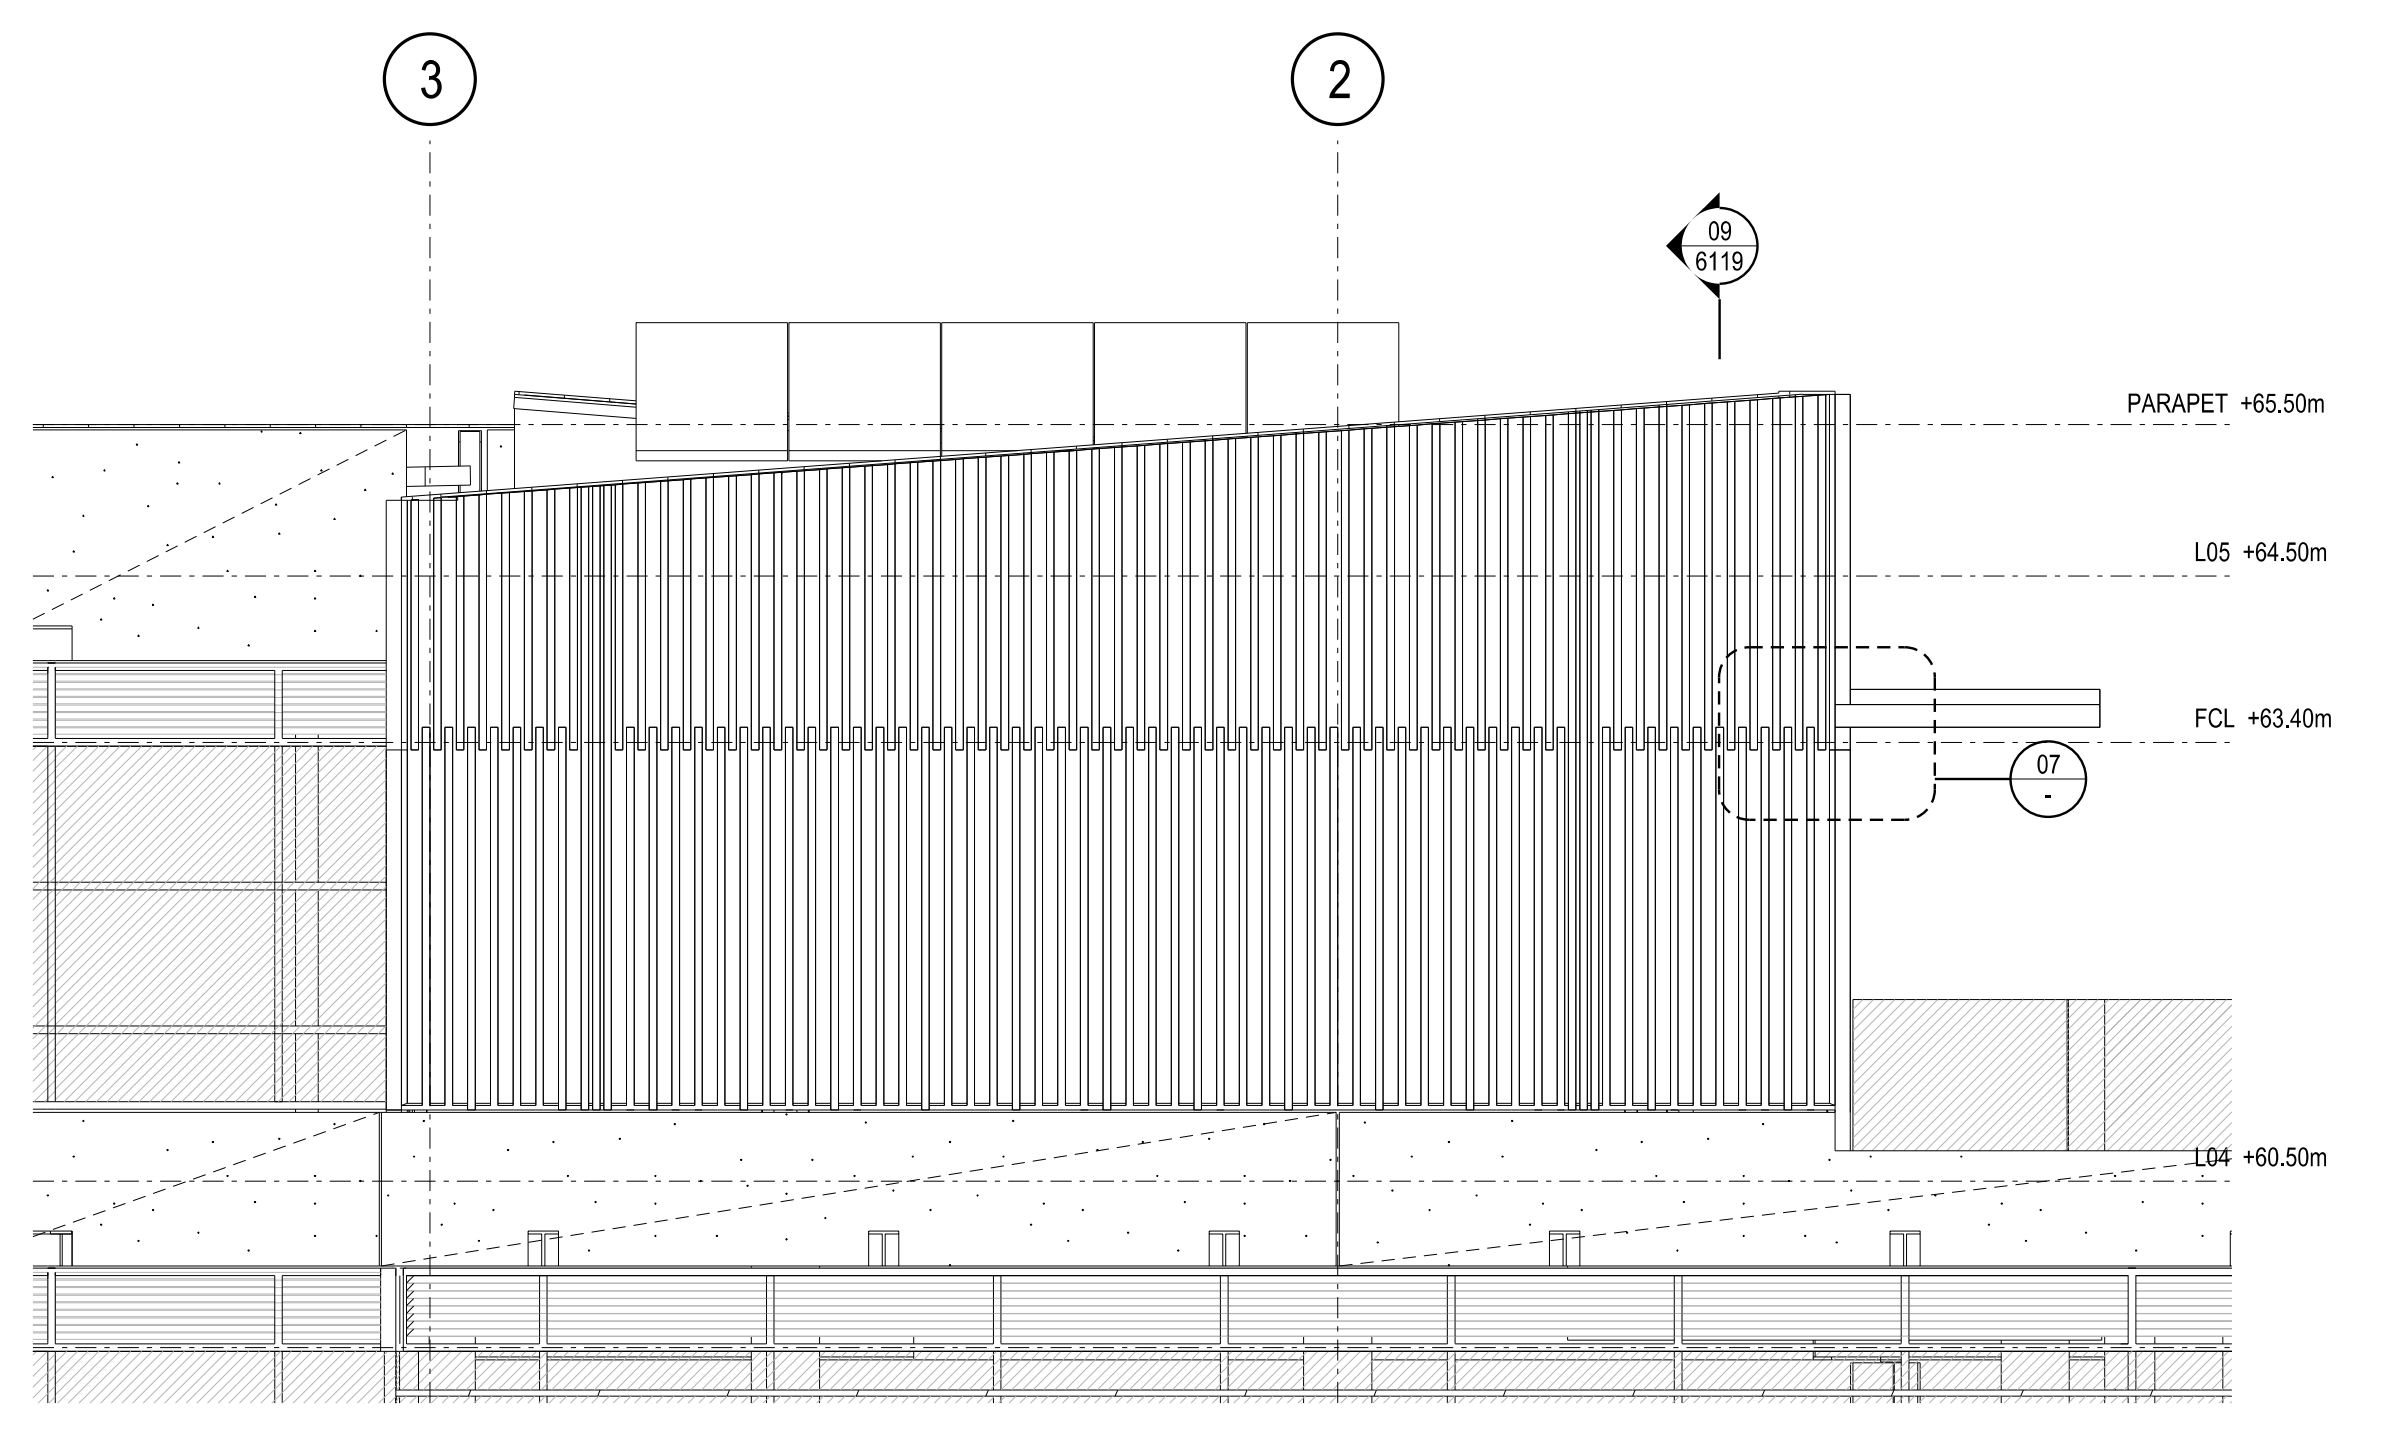


03 JAPANESE ROOM NORTH EXTERIOR ELEVATION  
SCALE 1:50

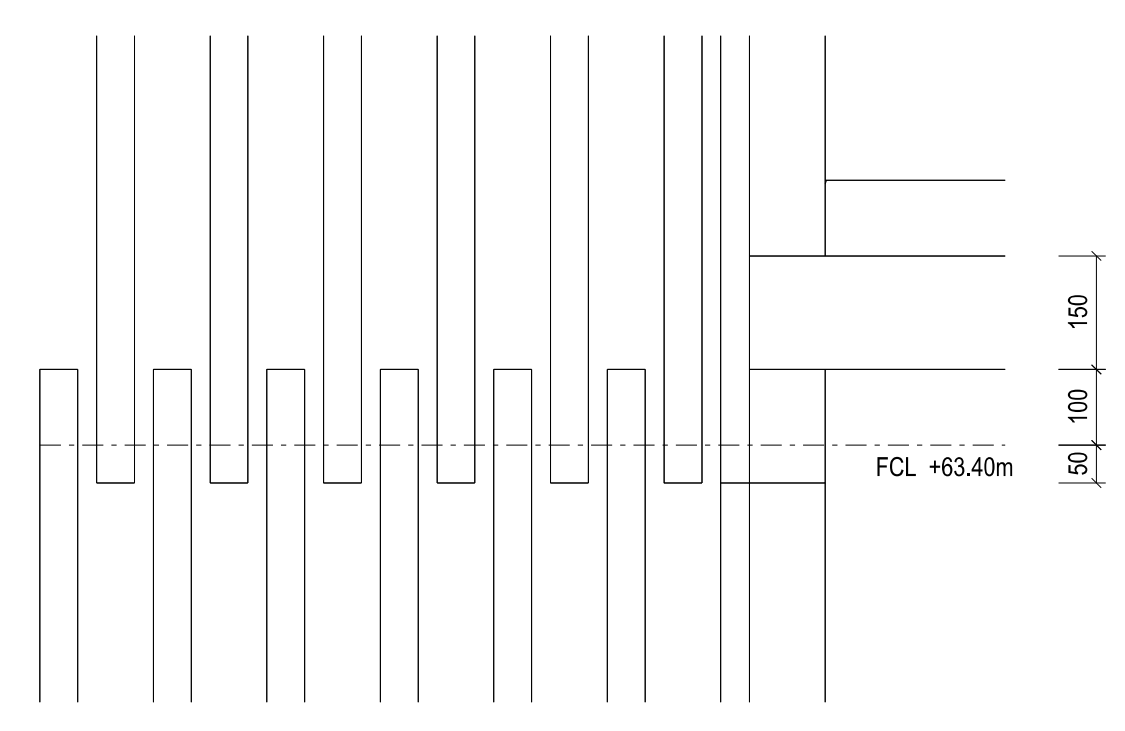


07 JAPANESE ROOM CLADDING DETAIL  
SCALE 1:10

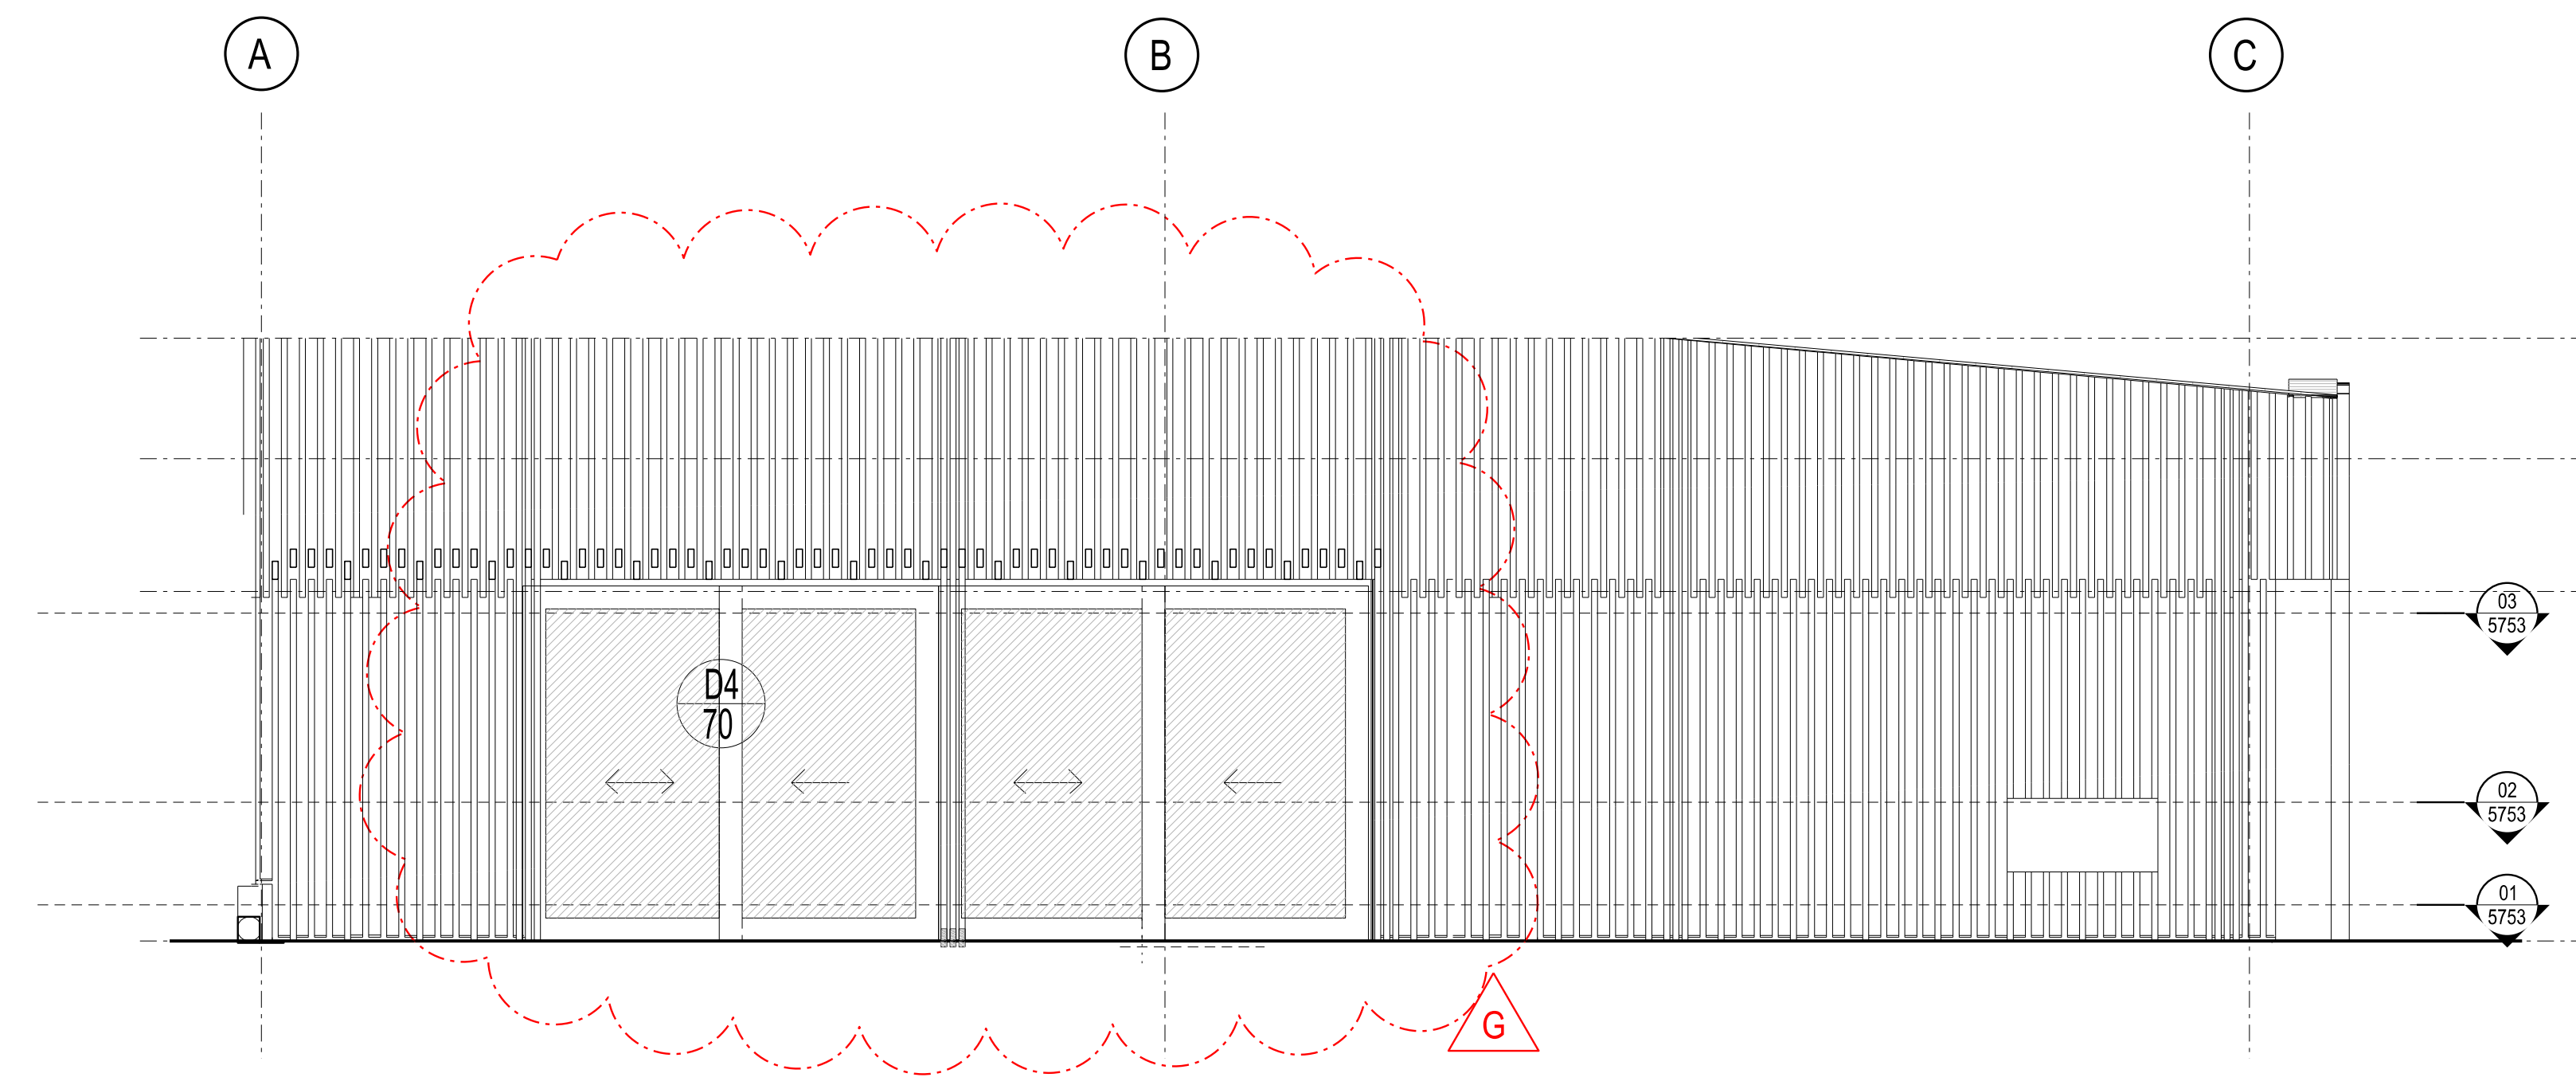

04 JAPANESE ROOM WEST EXTERIOR ELEVATION  
SCALE 1:50

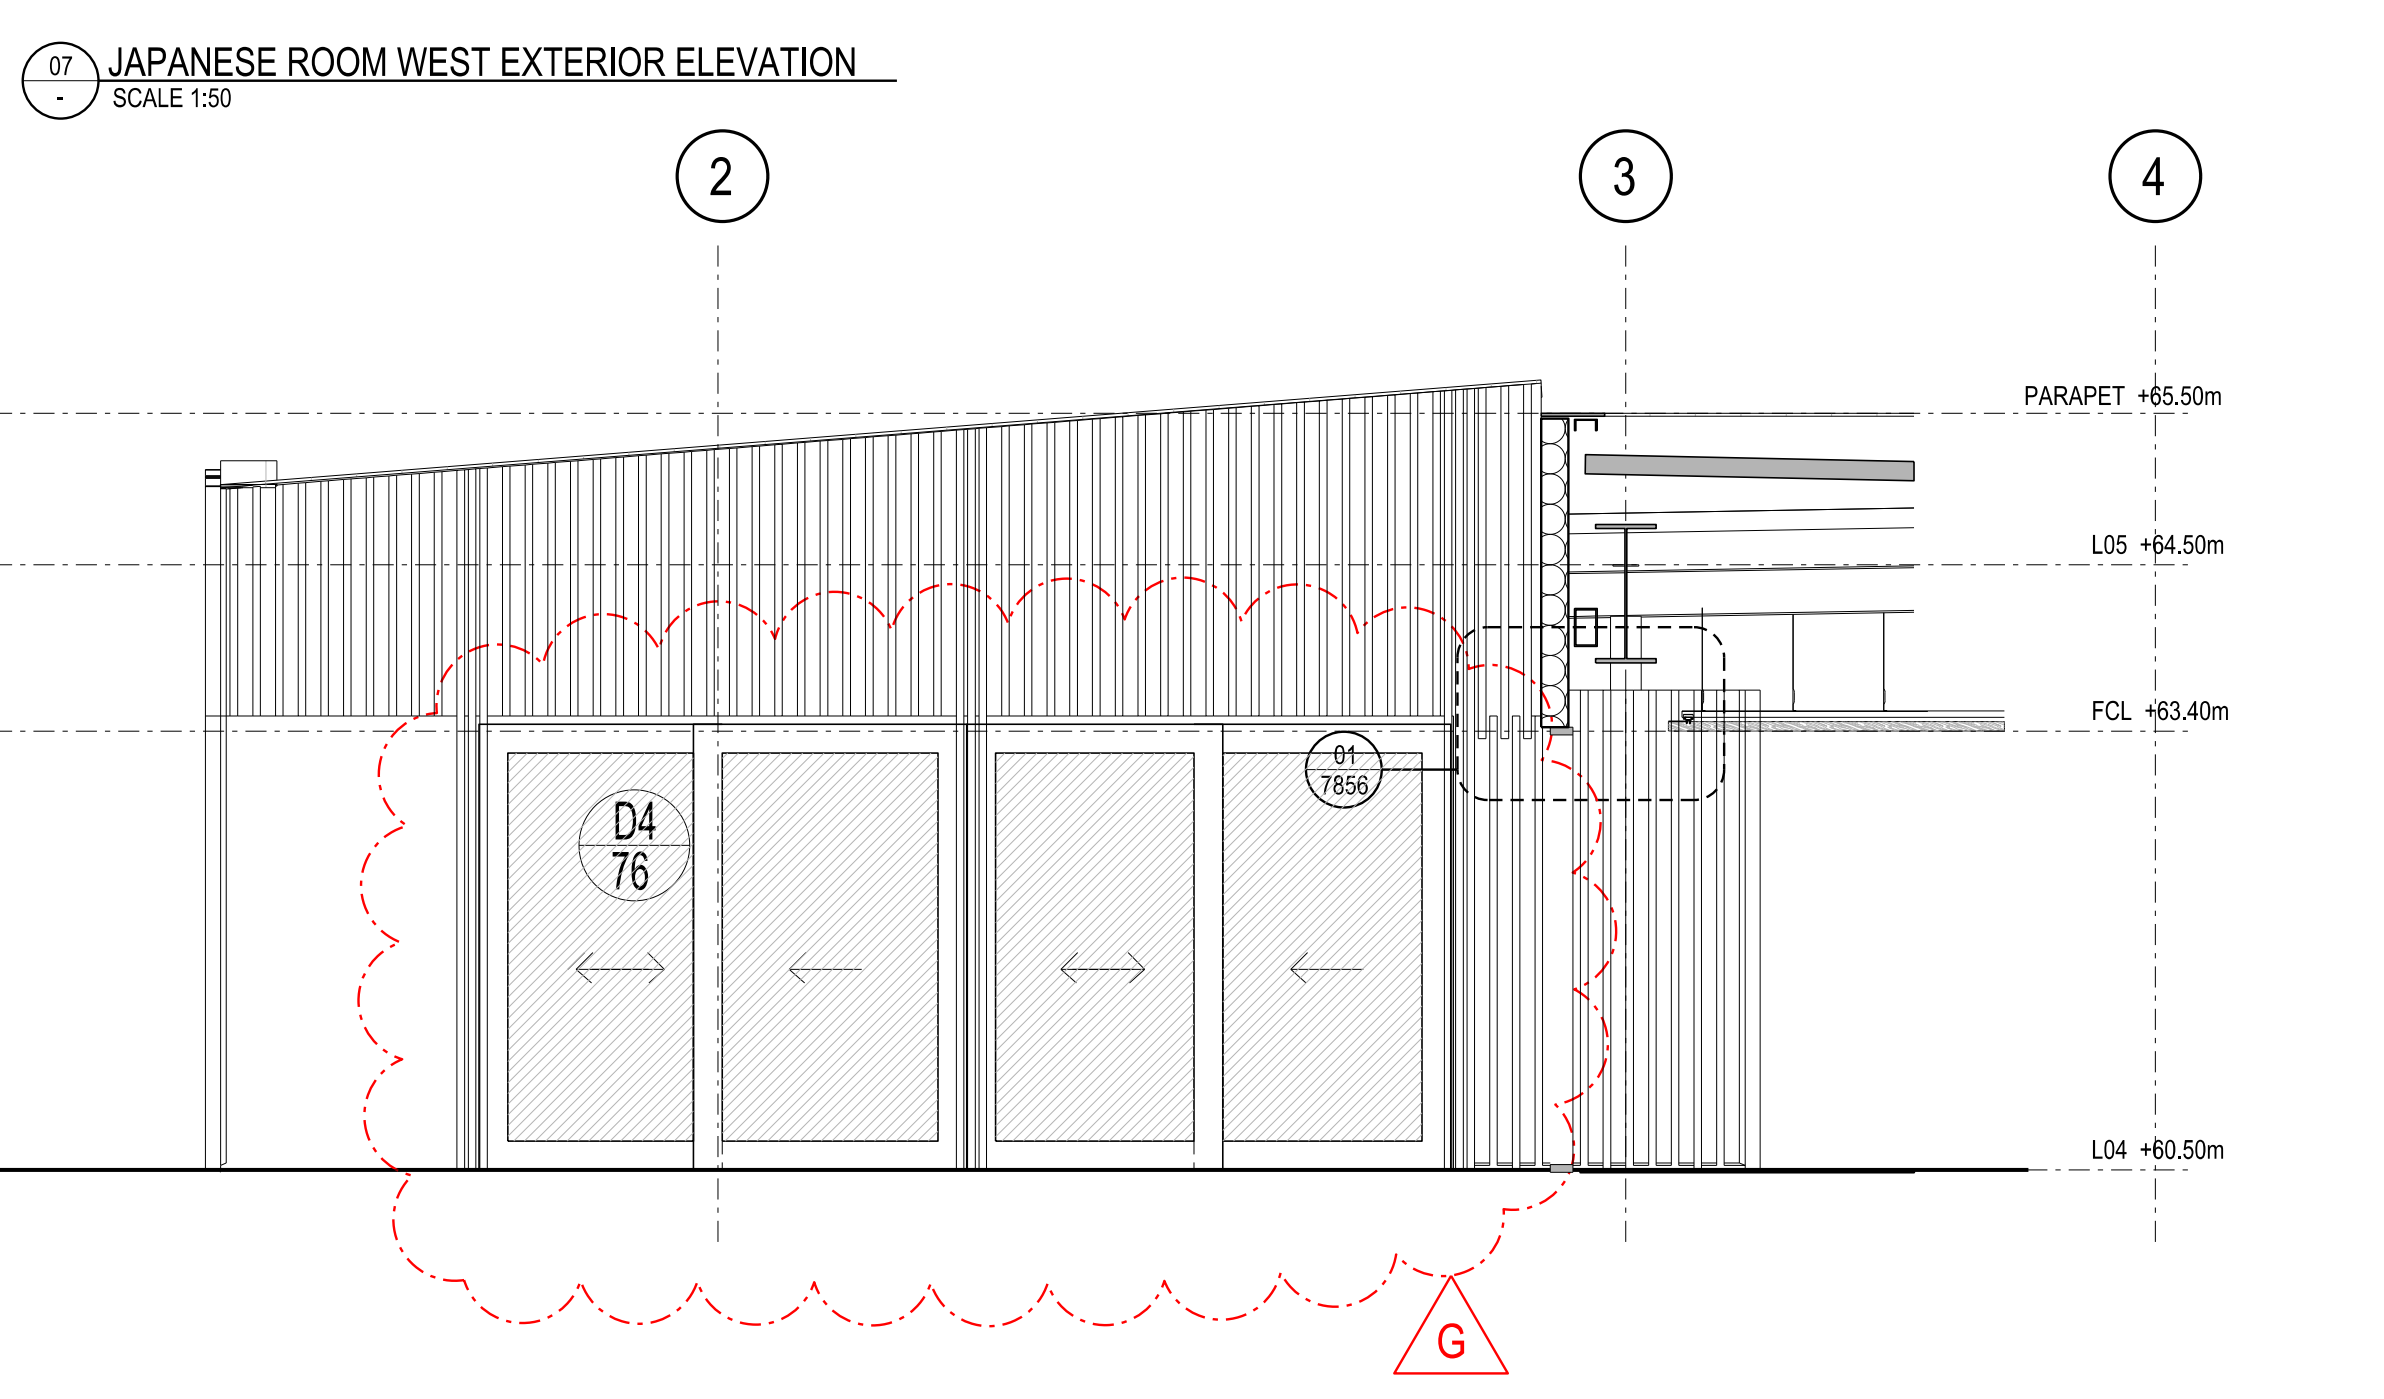

06 JAPANESE ROOM SOUTH EXTERIOR ELEVATION  
SCALE 1:50

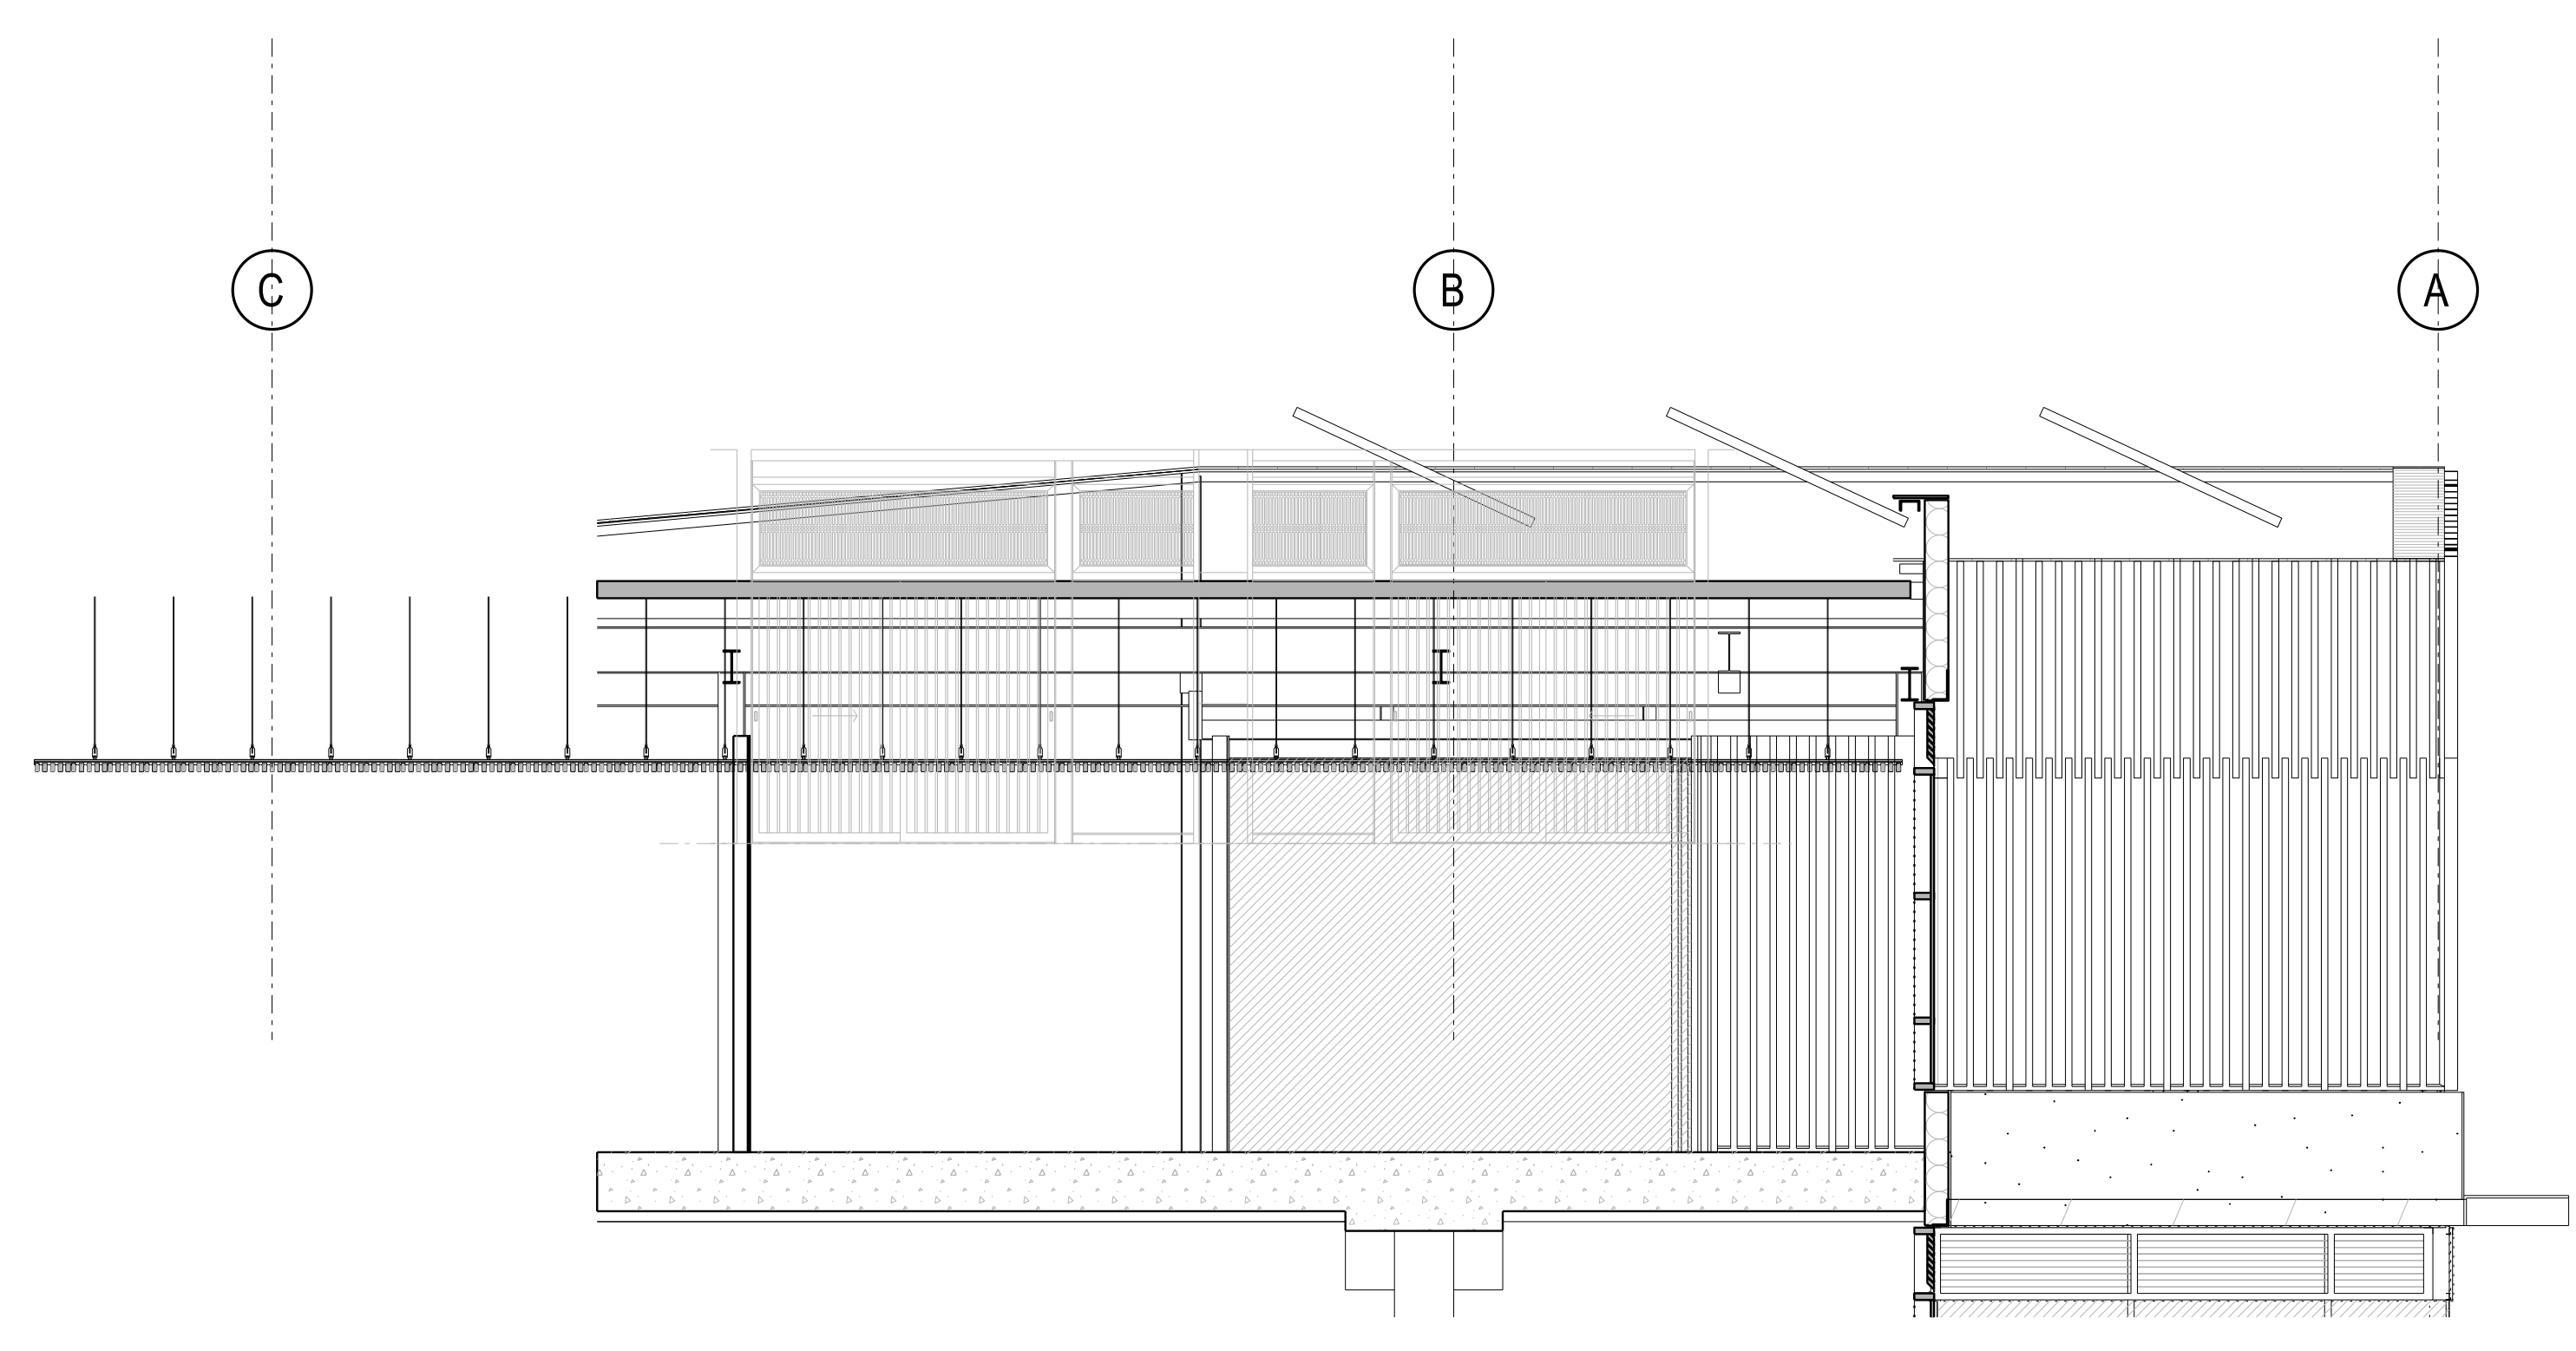

05 JAPANESE ROOM EAST EXTERIOR ELEVATION  
SCALE 1:50

Rev	Issue	Revision Description	Amd	Date
G	SG	SLIDING EXTERNAL DOORS UNDER REVIEW	-	17.04.14
F	SG	SLIDING EXTERNAL DOORS UNDER REVIEW	-	28.03.14
E	SG	UPDATES AS CLOUDED	-	28.03.14
D	SG	UPDATES AS CLOUDED	-	13.02.14
C	SG	UPDATES AS CLOUDED	-	15.01.14
B	SG	UPDATES AS CLOUDED	-	14.01.14
A	SG	ISSUED FOR CONSTRUCTION	-	10.01.14
01	SG	100% CD - TENDER ISSUE	-	07.09.12



**NADAAA**  
 NADAAA  
 1520 Washington Street No.2 Boston Massachusetts 02118 USA  
 Telephone +1 617 442 8232 Facsimile +1 688 442 1417 Email nado@nadaaa.com

**John Wardle Architects**  
 25 Rokeby Street, Collingwood, Victoria 3066 Australia  
 Tel: +61 3 8662 0400 www.johnwardlearchitects.com  
 © 2014 John Wardle Architects ABN 83 006 814 268

Client **University of Melbourne Parkville Campus**

Project **Faculty of Architecture Building and Planning**

Title **Japanese Room SECTIONS & EXTERIOR ELEVATIONS**

Project No.	<b>0913</b>	Scale	1:50 @ A0 1:100 @ A2
Drawing No.	<b>AR5751</b>	Revision	<b>G</b>
Date	Aug 2012	Dwn	-
Co-Ord	-	Chk	-

**FOR CONSTRUCTION**