


CONTRACTORS SHALL VERIFY JOB DIMENSIONS BEFORE ANY JOB COMMENCES. ALL SHOP DRAWINGS SHALL BE SUBMITTED TO THE SUPERINTENDENT AND MANUFACTURER SHALL NOT COMMENCE FROM THE RETURN OF DRAWINGS SHOWN. BY THE CONSULTANT FIGURED DIMENSIONS SHALL TAKE PRECEDENCE OVER SCALES. THIS DRAWING SHALL BE READ IN CONJUNCTION WITH ALL RELEVANT CONTRACT SPECIFICATIONS AND DRAWINGS COPYRIGHT OF THIS DRAWING IS VESTED IN WARDLE


General Notes

REFER ARCHITECTURAL DRAWINGS:


- FACADE SETOUT AR1502-AR1507
- PRECAST SETOUT AR1512-AR1517
- SCREEN SETOUT AR1502-AR1557
- SCREEN DETAILS AR6500-AR6554

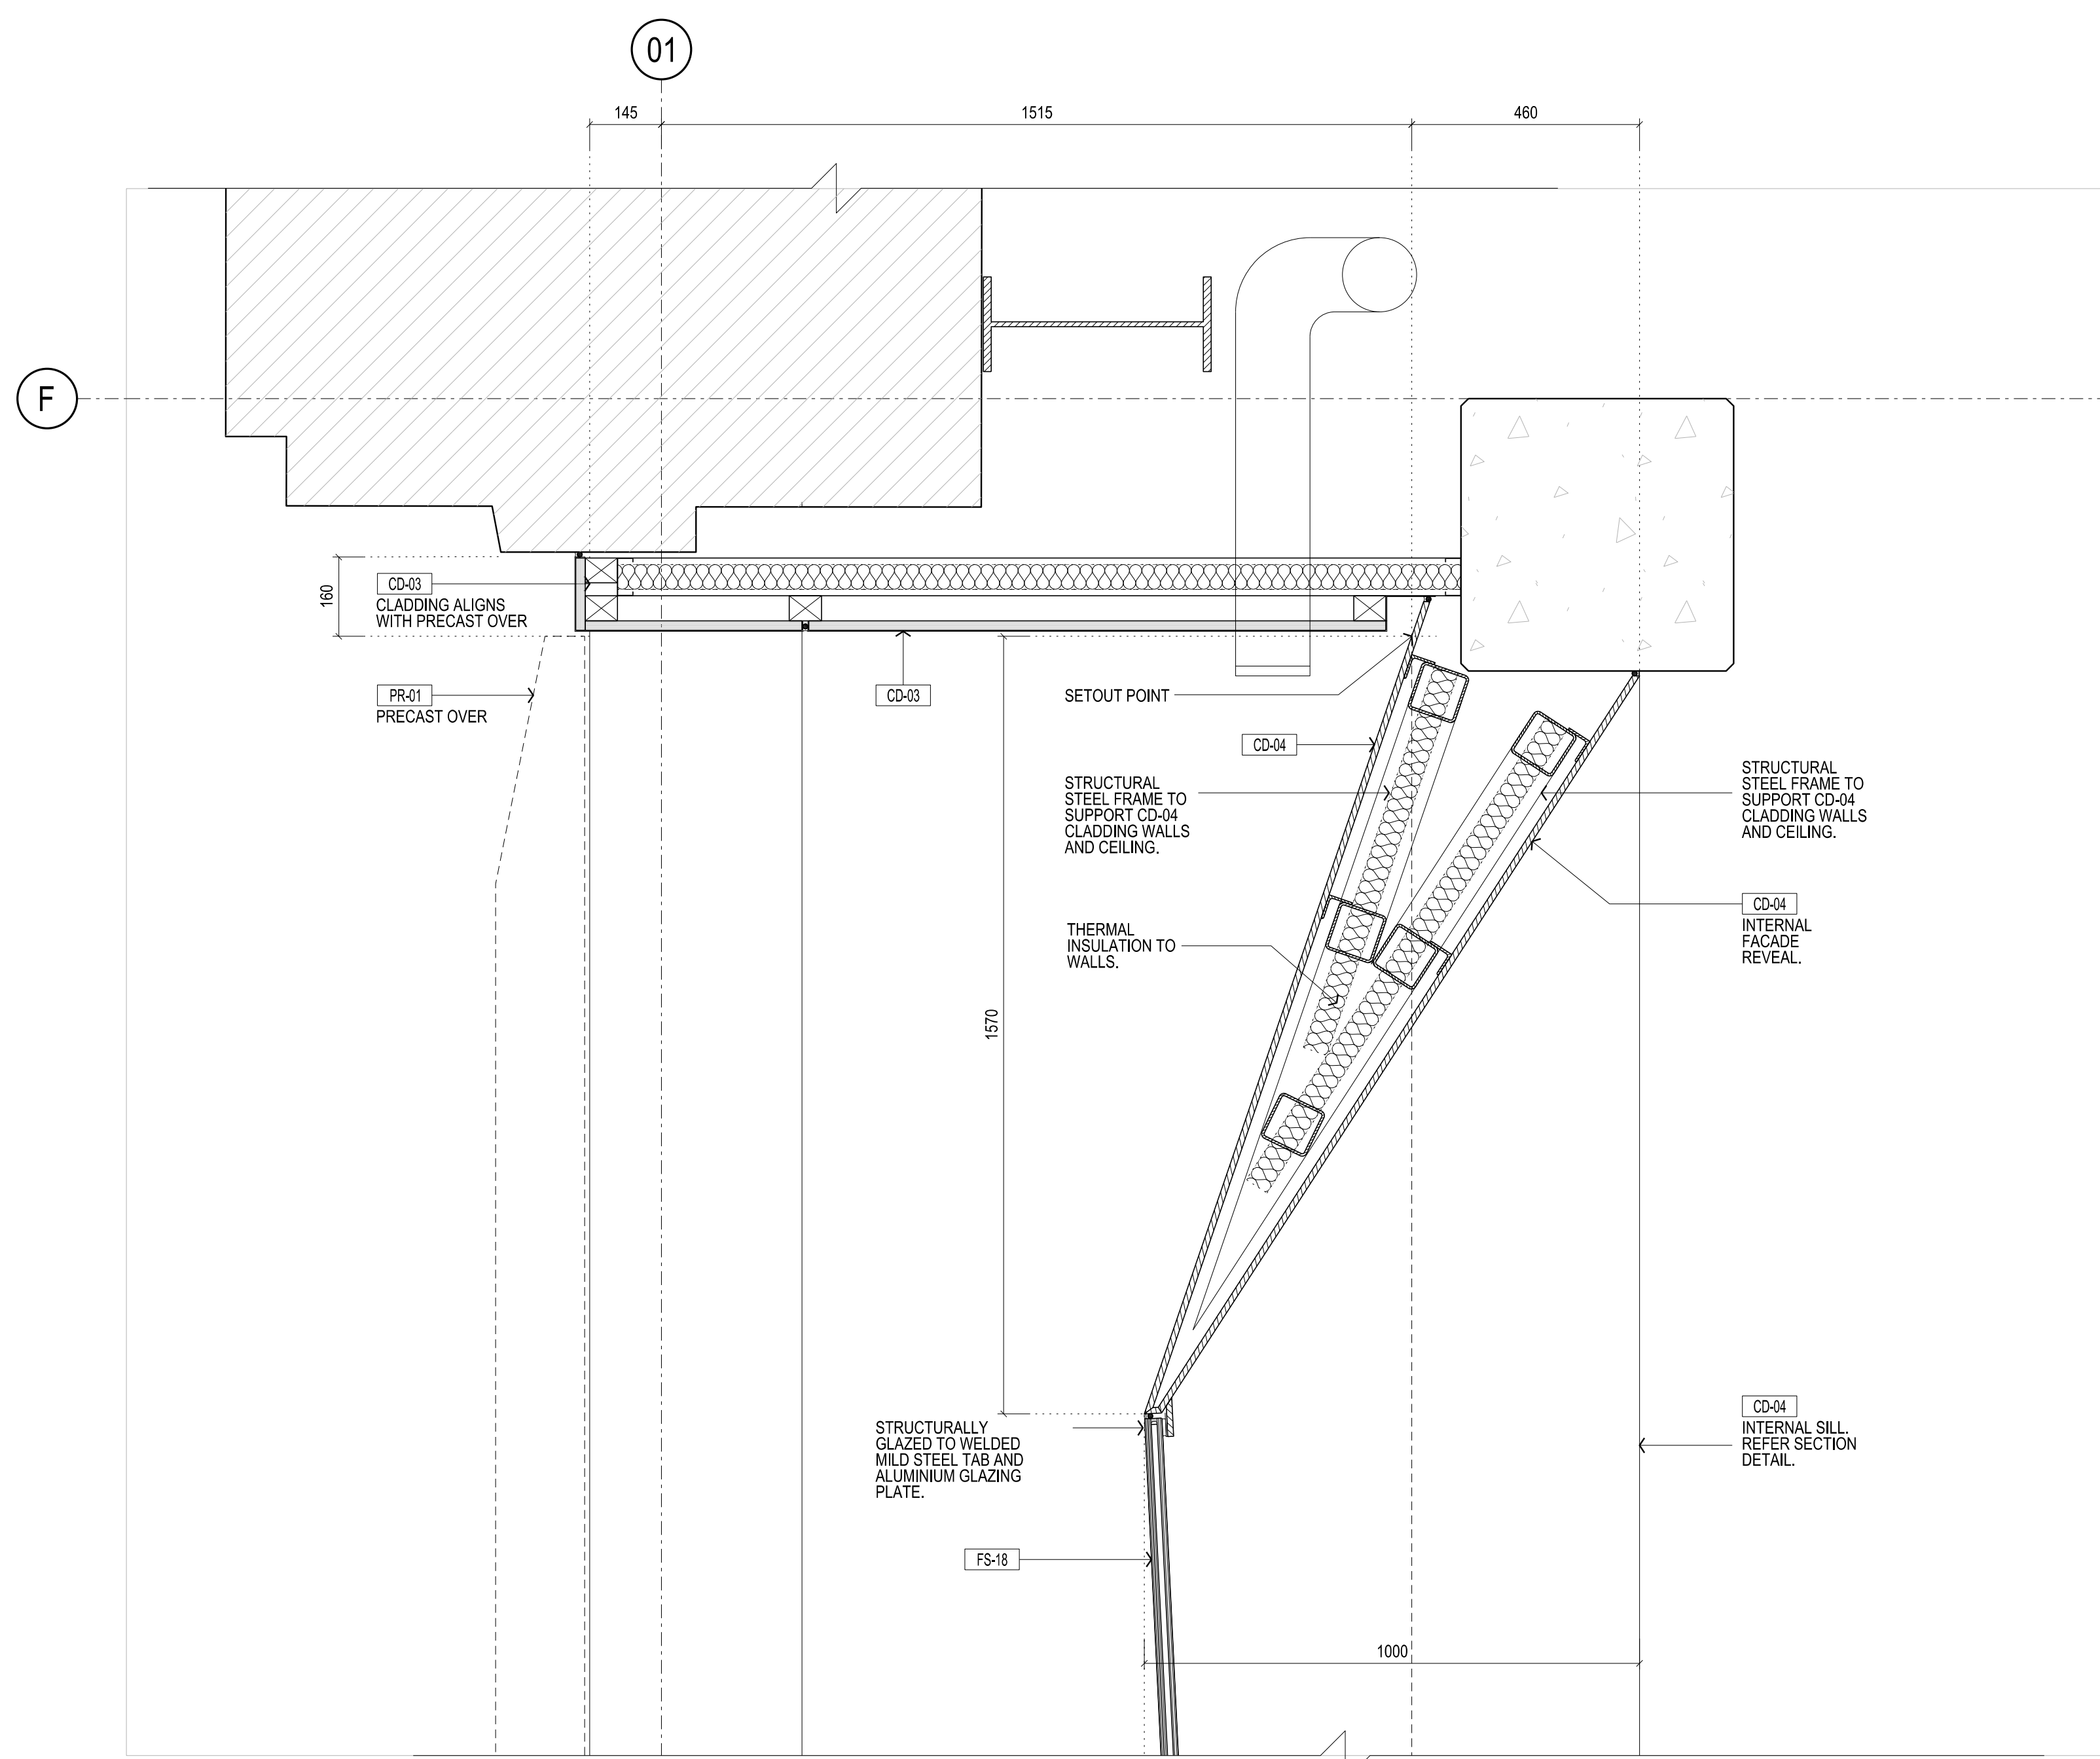


04 PLAN DETAIL - G01  
SCALE 1:10

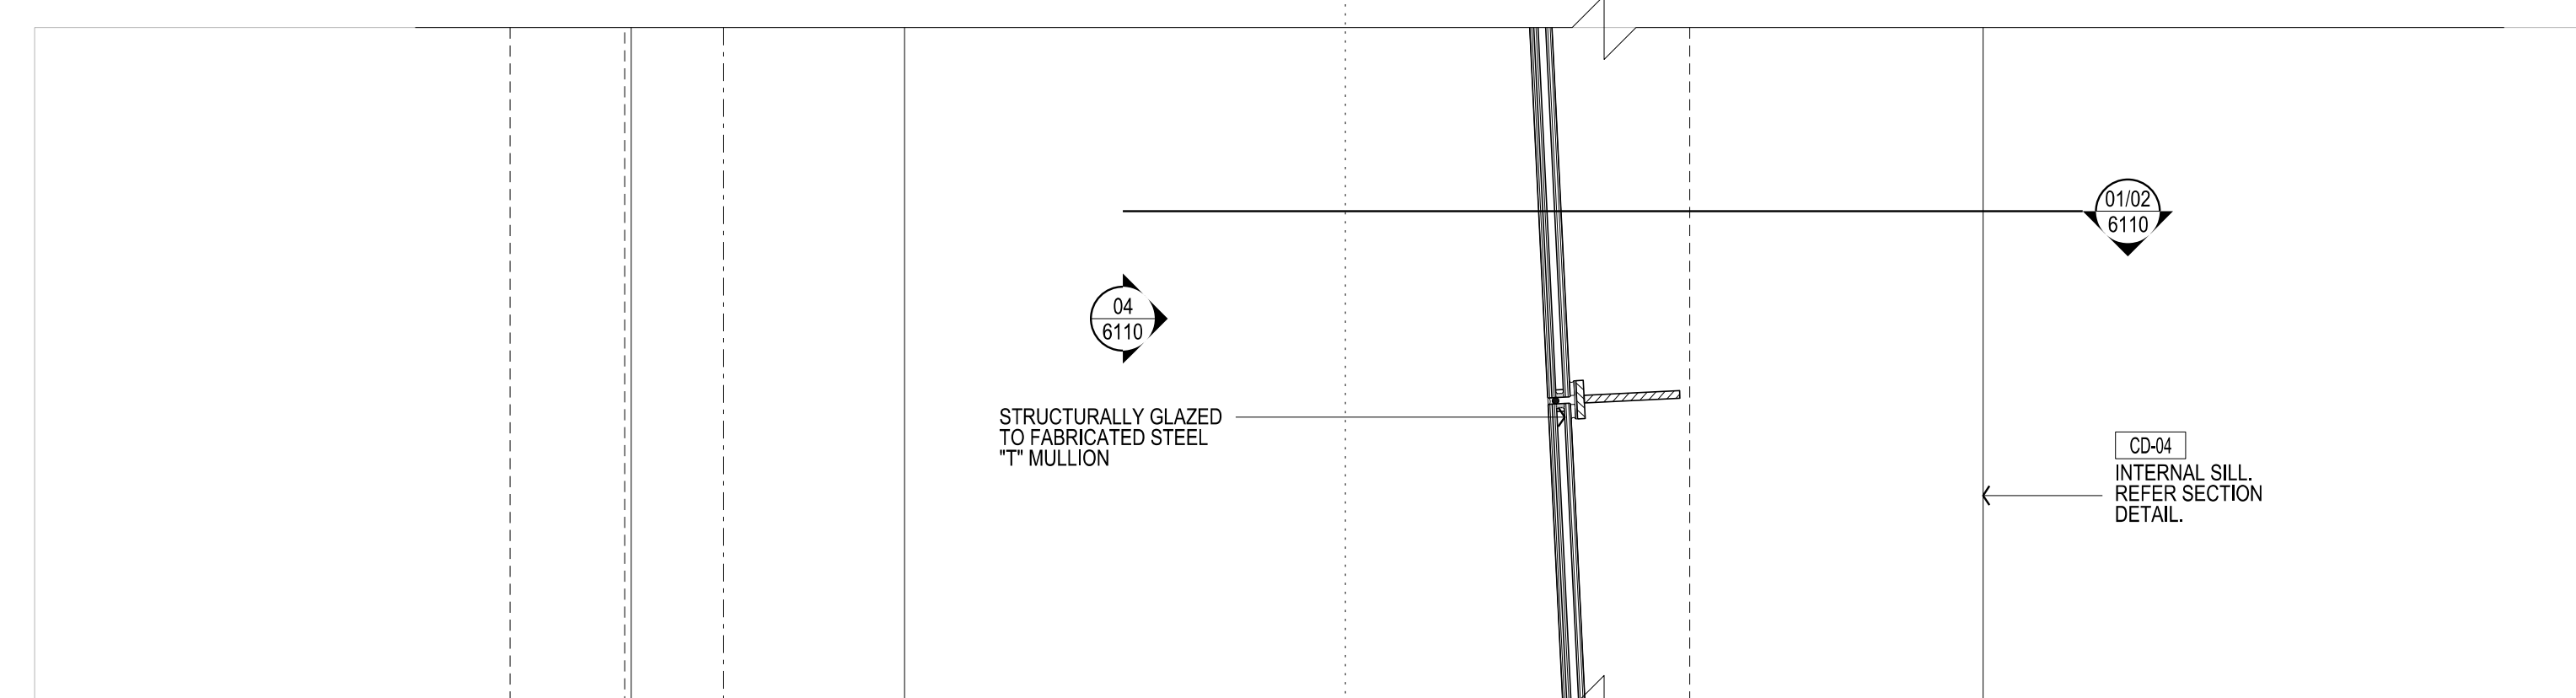

03 PLAN DETAIL - G01  
SCALE 1:10

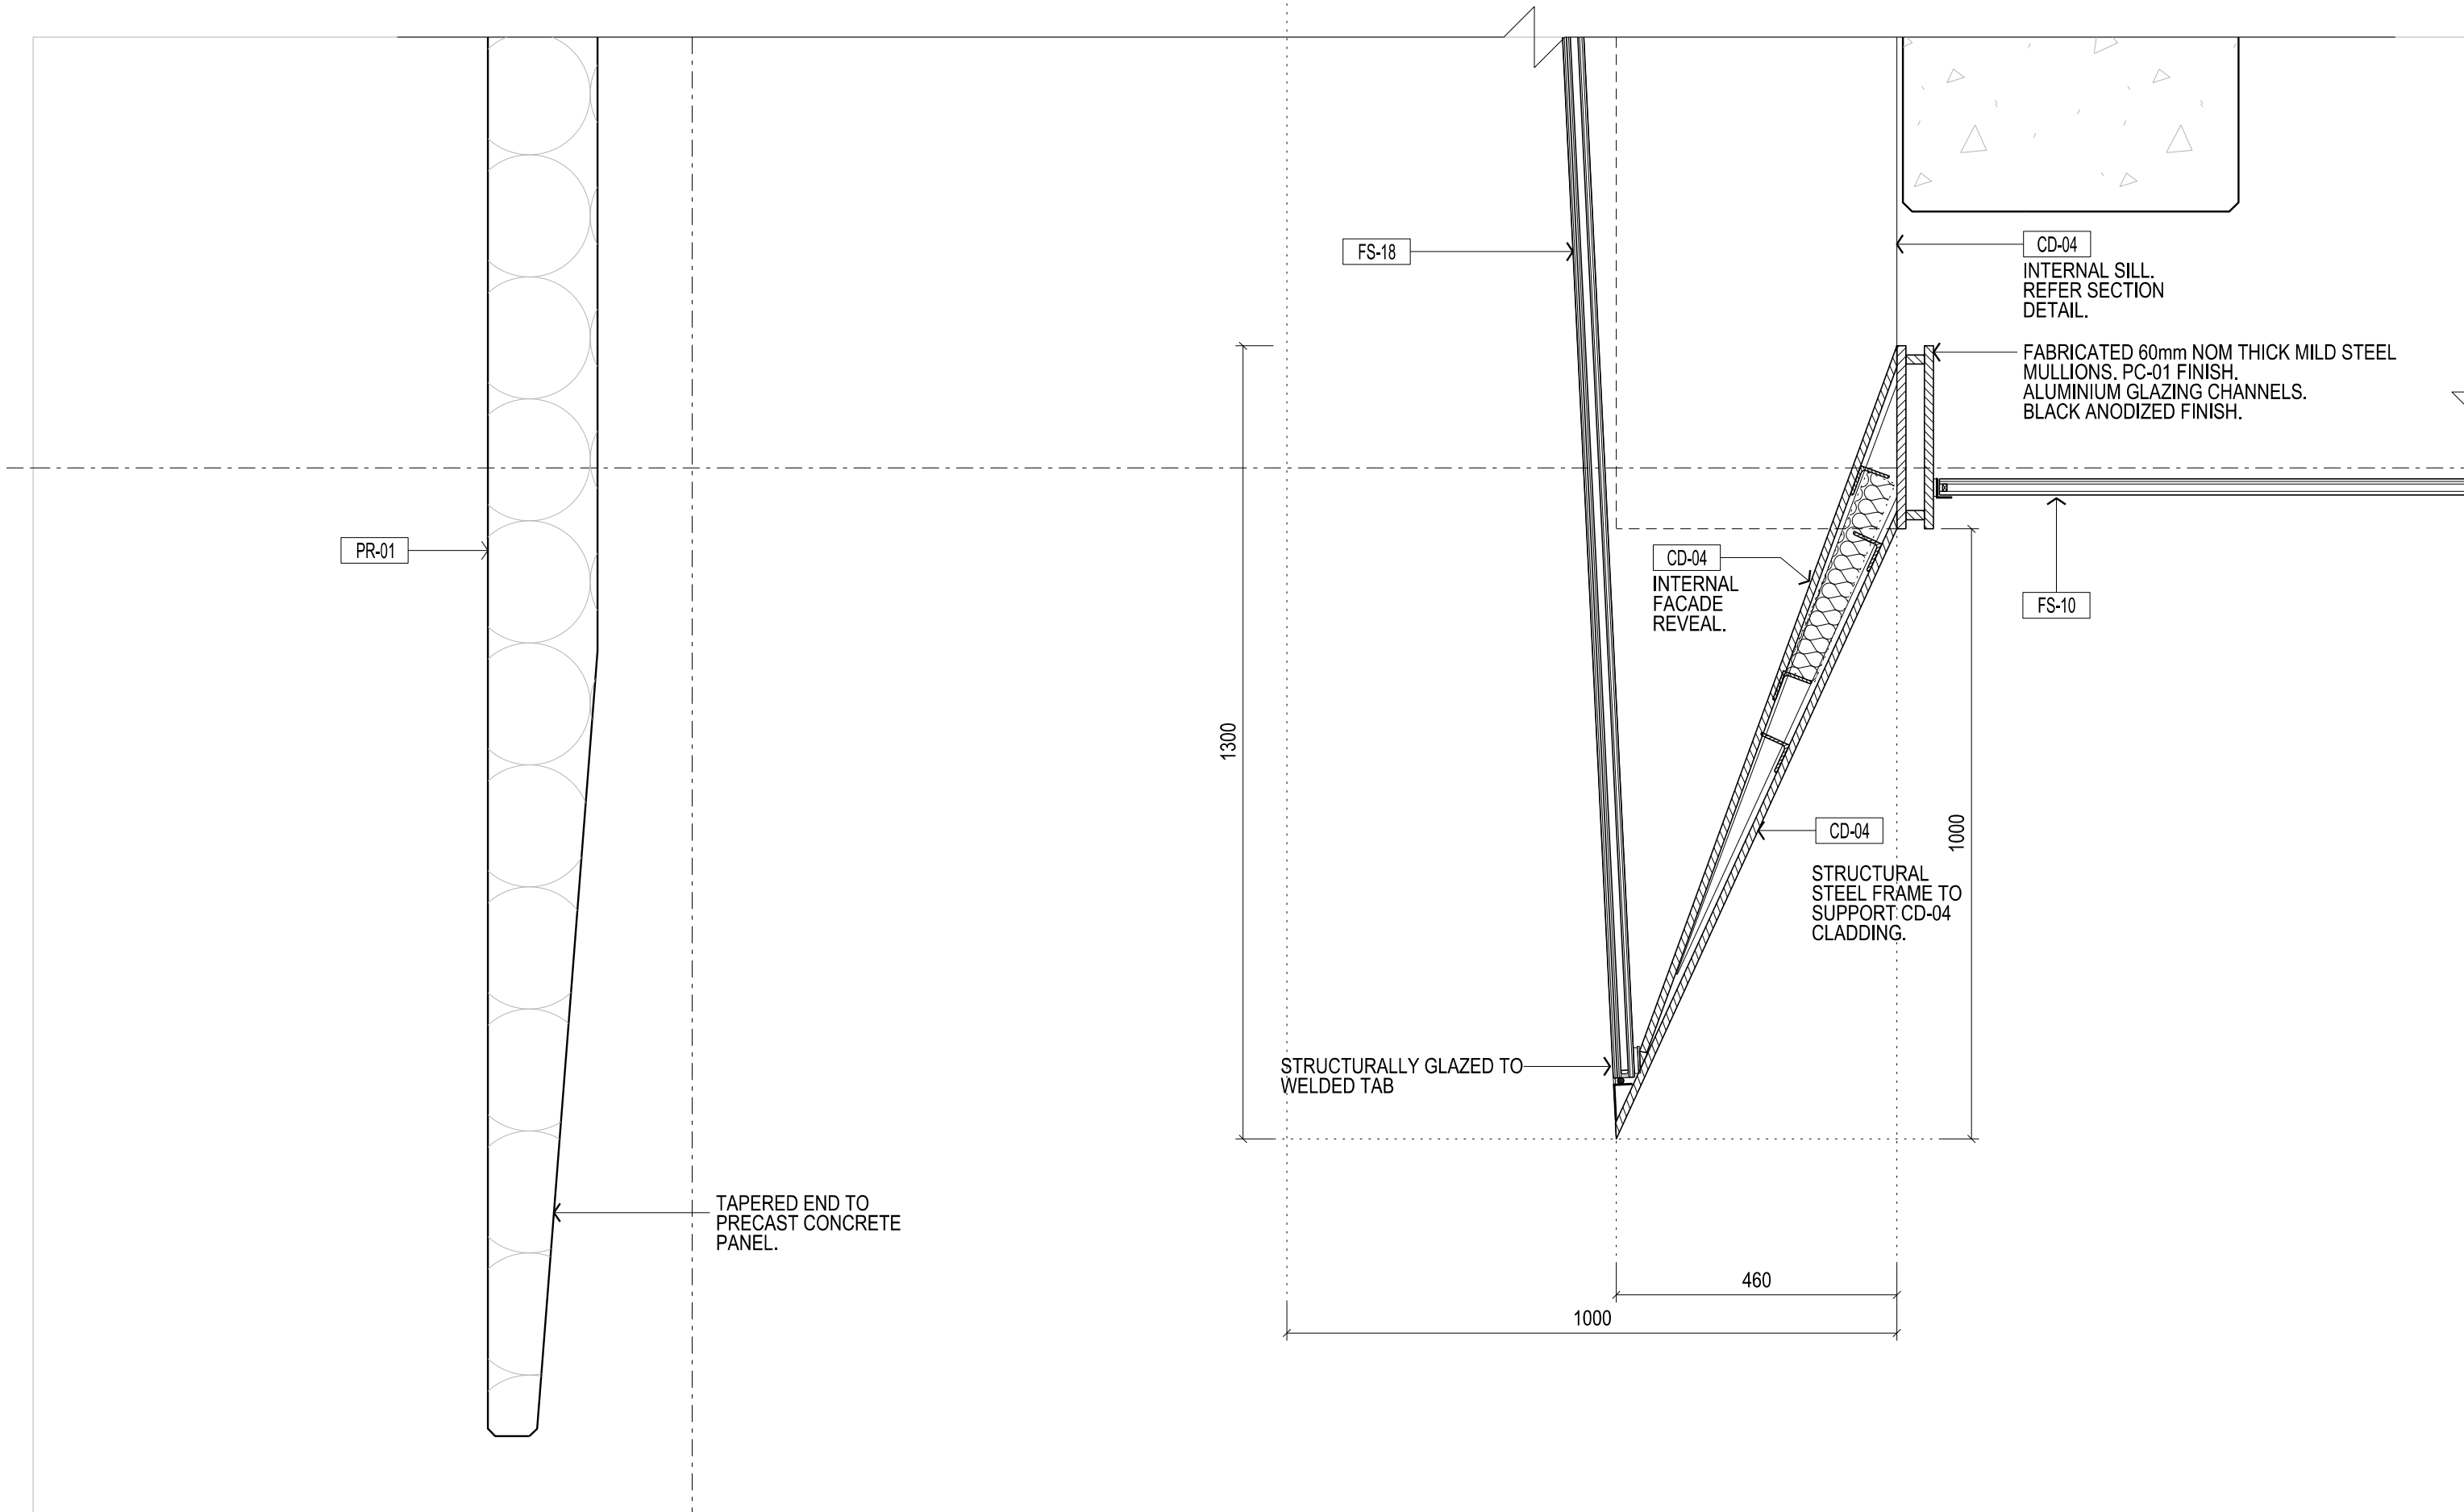


02 PLAN DETAIL - G01  
SCALE 1:10

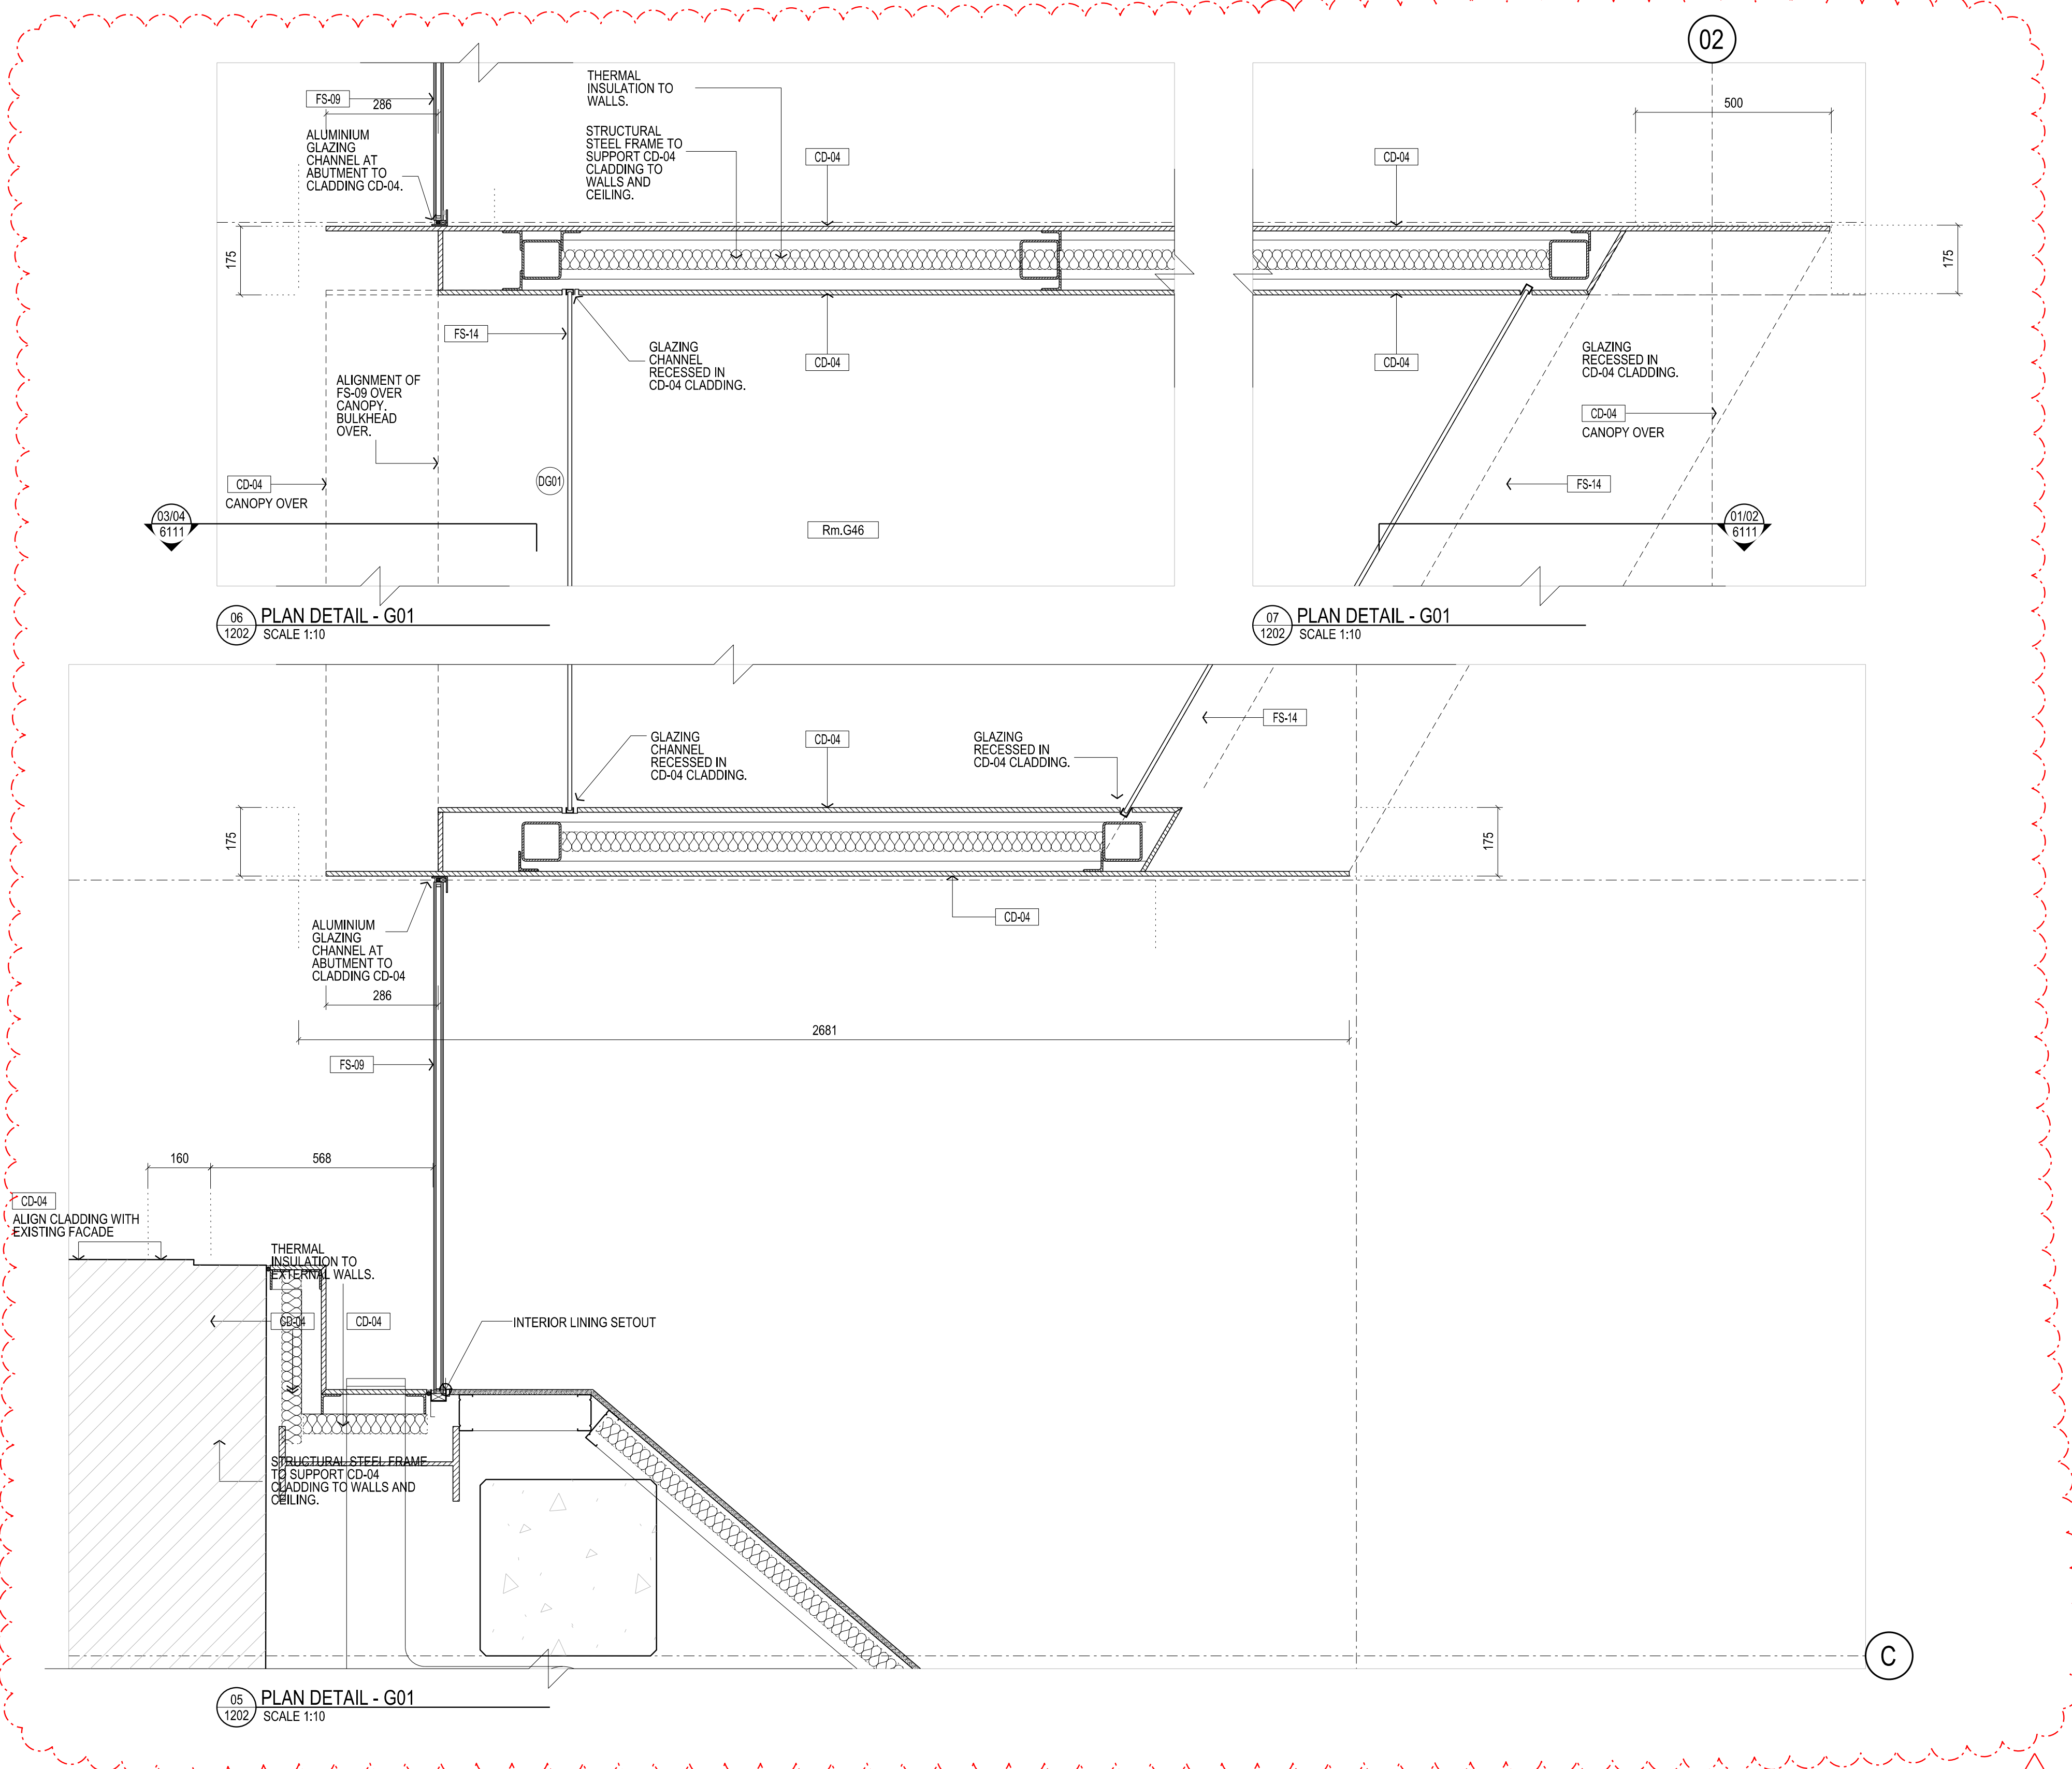


06 PLAN DETAIL - G01  
SCALE 1:10

07 PLAN DETAIL - G01  
SCALE 1:10


05 PLAN DETAIL - G01  
SCALE 1:10

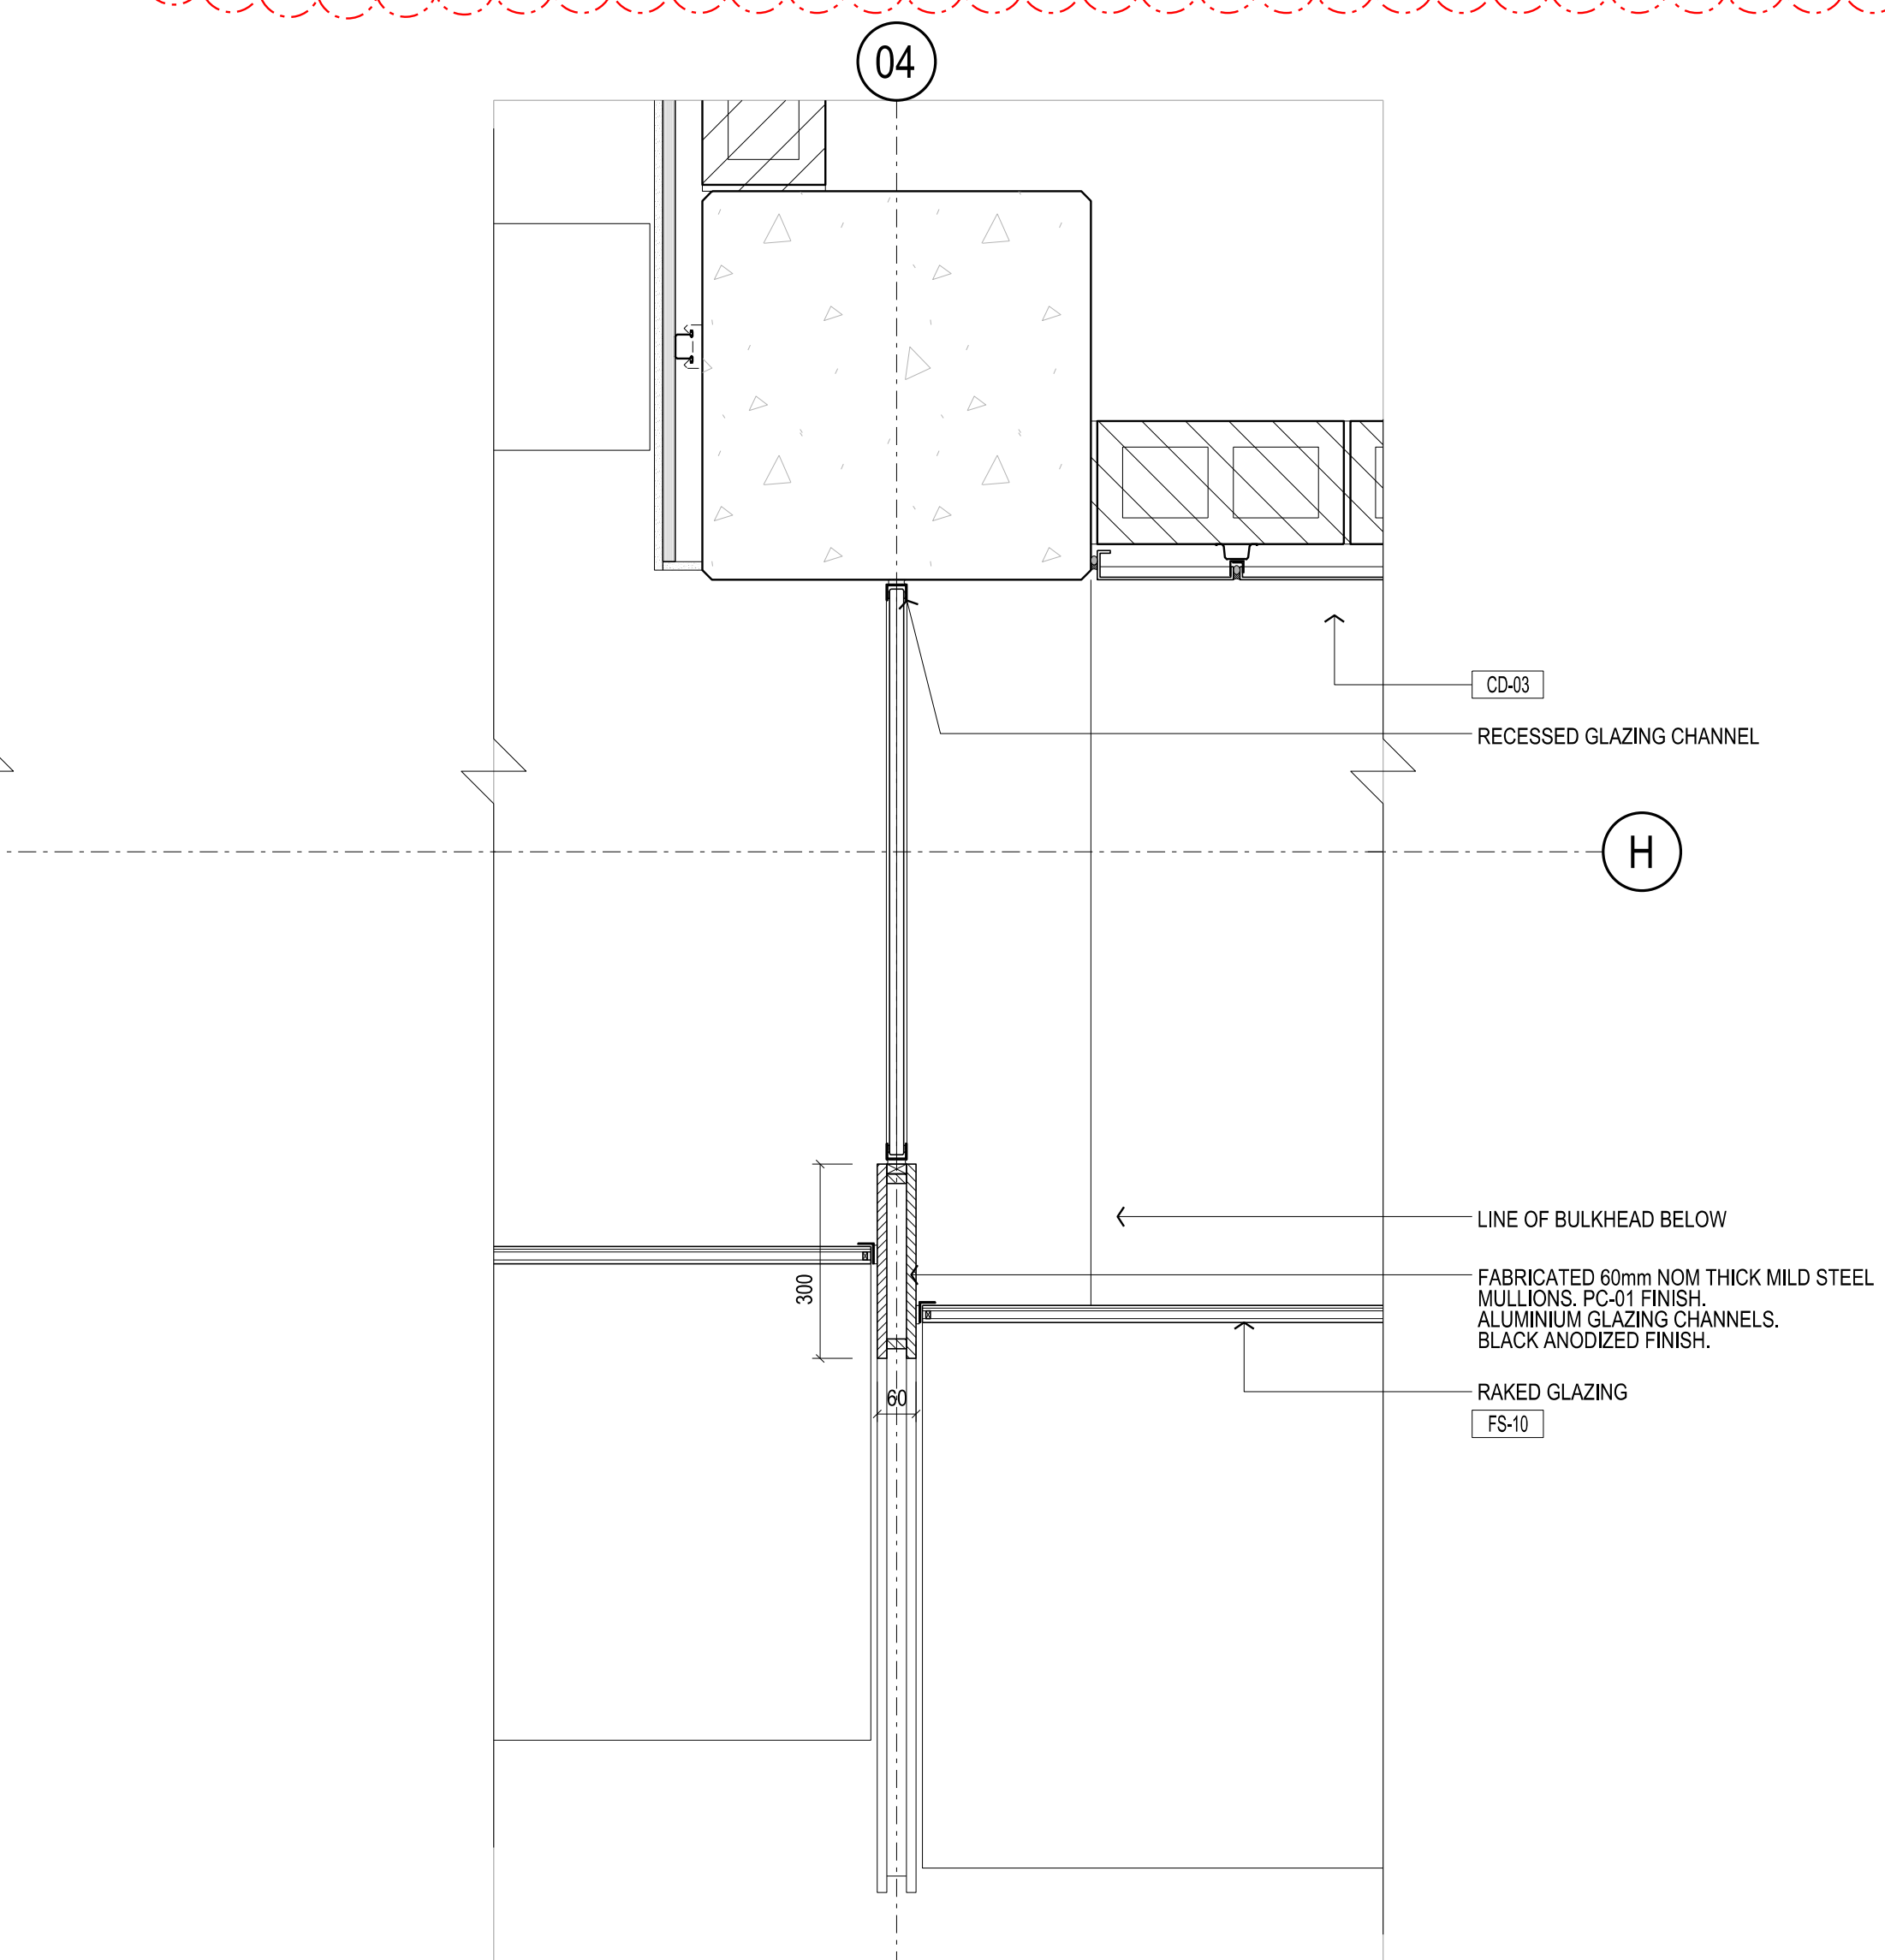

08 PLAN DETAIL - G01  
SCALE 1:10

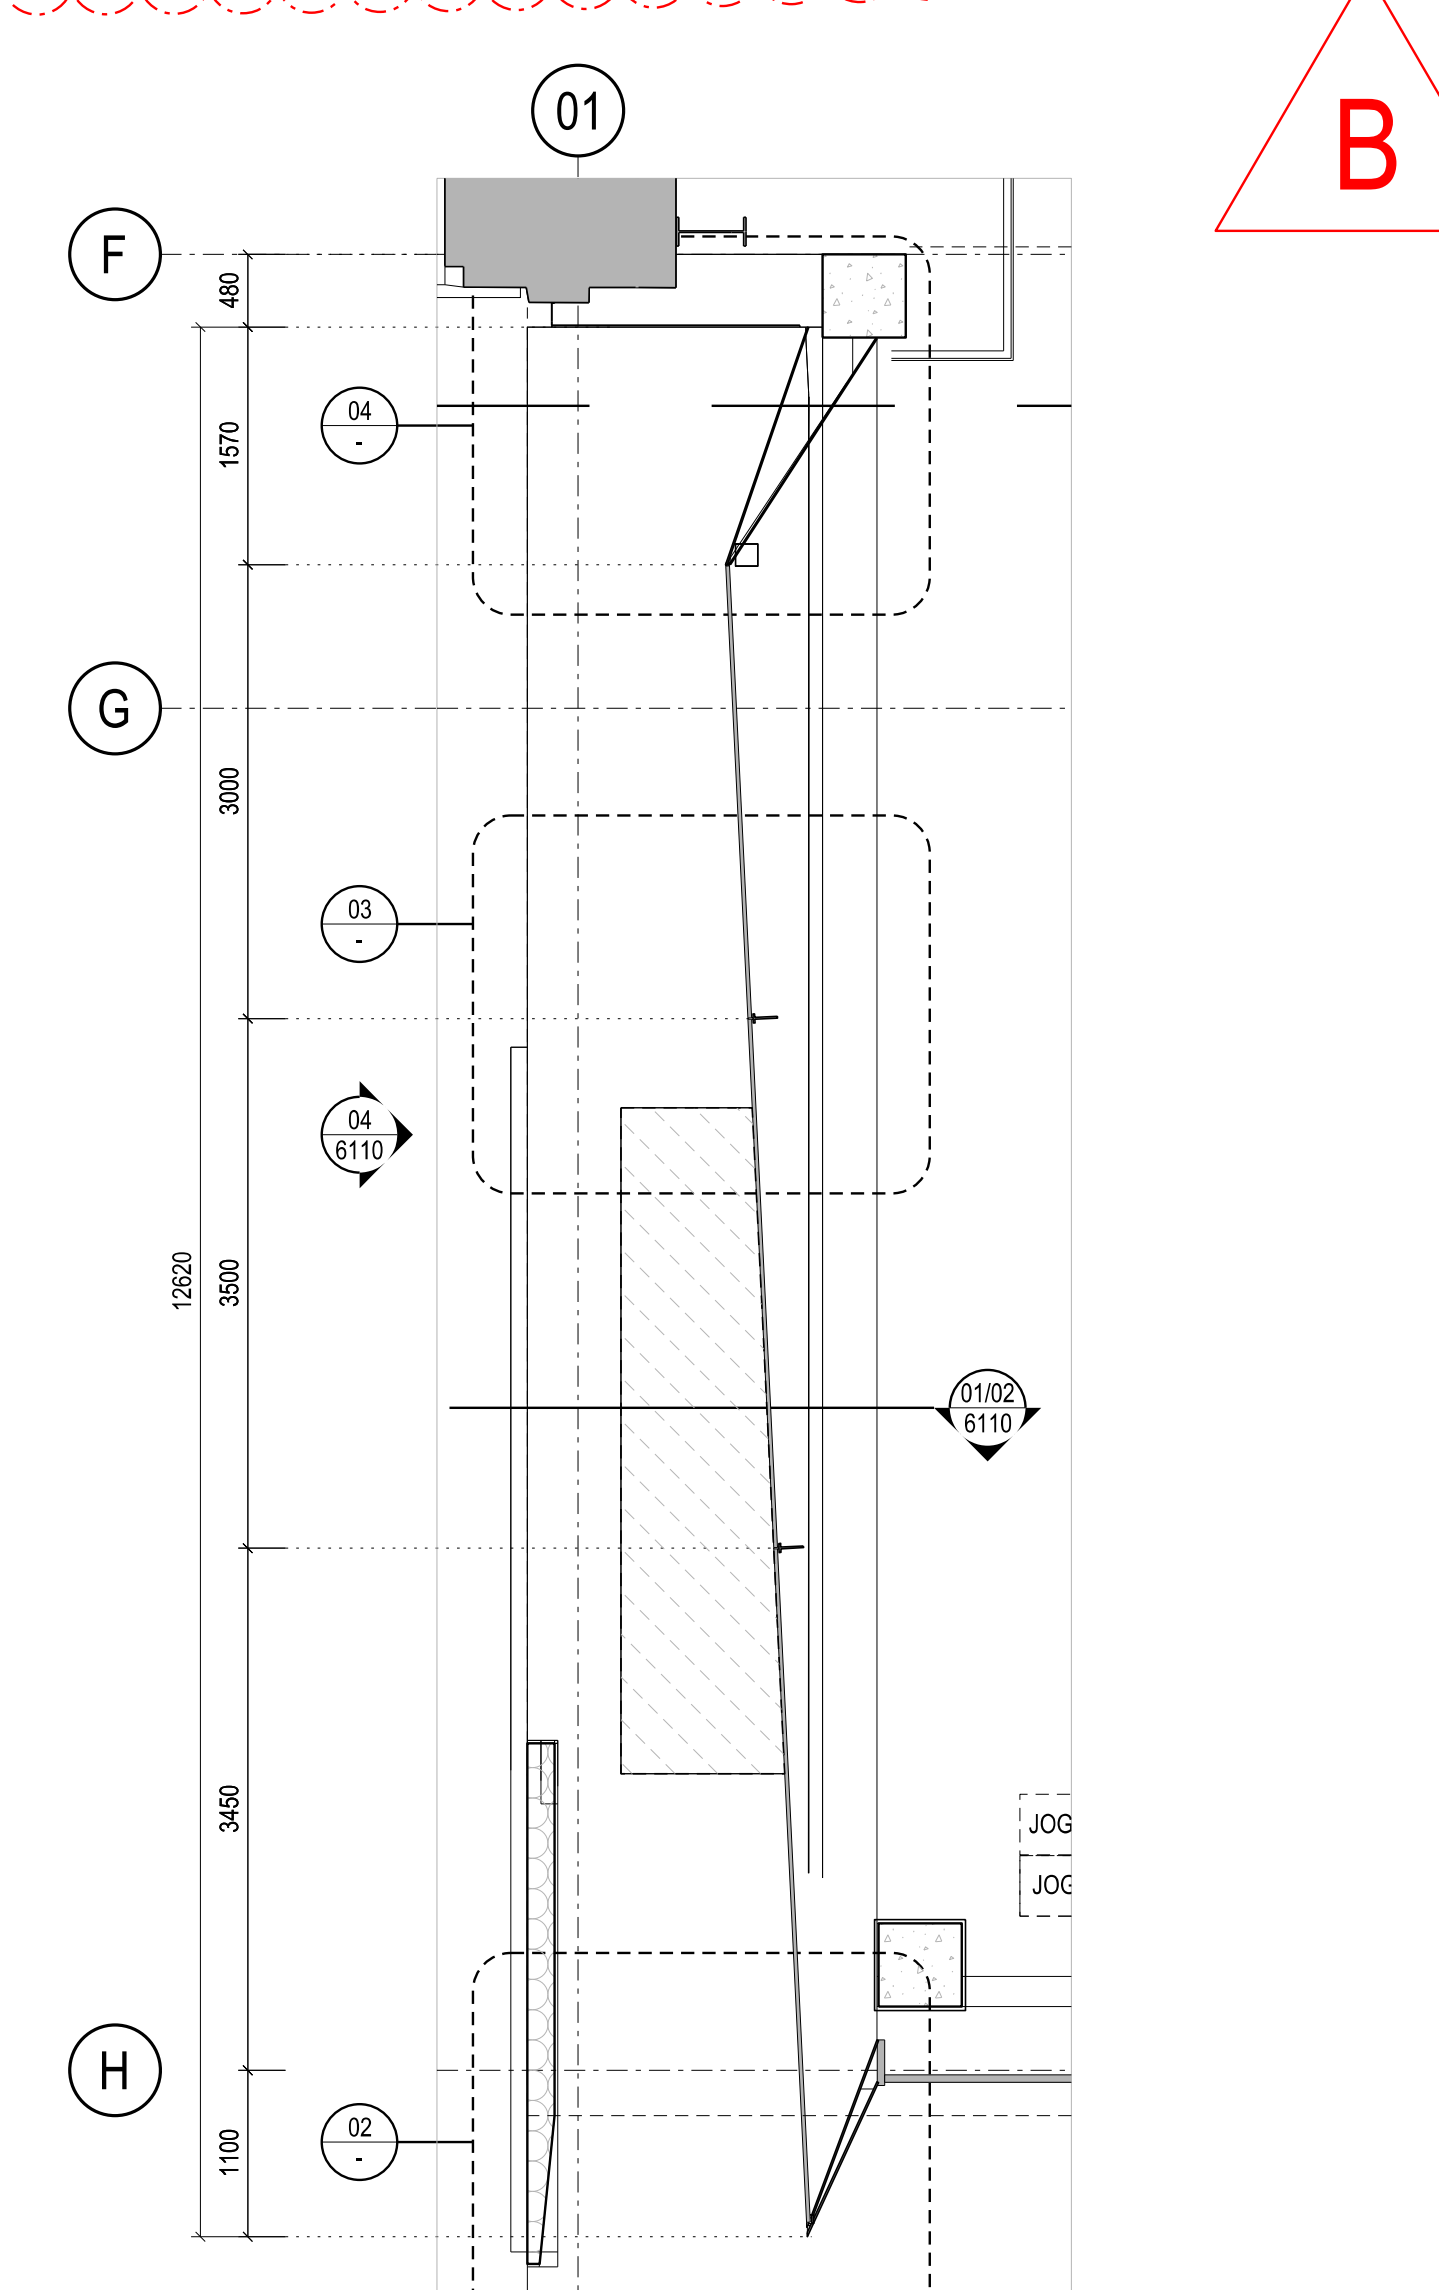

01 PLAN DETAIL - FS-18  
SCALE 1:50

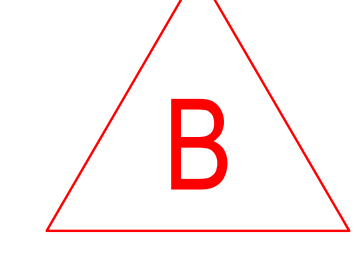

Rev	Issue	Revision Description	Amd	Date
B	SG	REVISED DETAILS		22.11.2013
A	SG	PLASTERBOARD PACKAGE		18.09.13
		DWG REFERENCE CHANGE FROM 1500 - 1200'S		
06	SG	VALUE MANAGEMENT ISSUE		28.03.13
05	SG	PRECAST REVIEW		21.03.13
07	SG	TENDER ISSUE		12.04.13
06	SG	VALUE MANAGEMENT ISSUE		28.03.13
05	SG	PRECAST REVIEW		21.03.13
04	SG	100% CD - TENDER ISSUE		07.09.12
03	SG	90% CD ISSUE		10.08.2012
02	SG	75% CD ISSUE		13.07.2012
01	SG	55% CD ISSUE		08.06.2012



**NADAAA**  
 NADAAA  
 1520 Wellington Street No.2  
 Boston Massachusetts 02118 USA  
 Telephone +1 617 442 8232  
 Facsimile +1 617 442 1417  
 Email nad@nadaaa.com

**John Wardle Architects**  
 25 Rokeby Street, Collingwood, Victoria 3066 Australia  
 Tel: +61 3 8662 0400 www.johnwardlearchitects.com  
 © 2012 John Wardle Architects ABN 83 006 814 268

Client **University of Melbourne Parkville Campus**  
 Project **Faculty of Architecture Building and Planning**  
 Title **PLAN DETAILS G01 - SHEET 1**

Project No.	<b>0913</b>	Scale	1:10 @ A0 1:20 @ A2
Drawing No.	<b>AR6000</b>	Revision	<b>B</b>

Date: Dec 2011 Drawn: Co-Ord: Check:

FILENAME - SFILES

**FOR CONSTRUCTION**