

CONTRACTORS SHALL VERIFY JOB DIMENSIONS BEFORE ANY JOB COMMENCES. ALL SHOP DRAWINGS SHALL BE SUBMITTED TO THE SUPERINTENDENT AND MANUFACTURER SHALL NOT COMMENCE PRIOR TO THE RETURN OF DIMENSIONS SHOP DRAWINGS REVIEWED BY THE CONSULTANT. DIMENSIONS SHALL TAKE PRECEDENCE OVER SCALES. THIS DRAWING SHALL BE READ IN CONJUNCTION WITH ALL RELEVANT CONTRACT SPECIFICATIONS AND DRAWINGS COPYRIGHT OF THIS DRAWING IS VESTED IN WARDLE

General Notes

REFER ARCHITECTURAL DRAWINGS:

- FACADE SETOUT AR1502-AR1507
- PRECAST SETOUT AR1512-AR1517
- SCREEN SETOUT AR1502-AR1507
- SCREEN DETAILS AR6500-AR6554

Rev	Issue	Revision Description	And	Date
A	SG	PLASTERBOARD PACKAGE	-	18.09.13
05	SG	TENDER ISSUE	-	12.04.13
04	SG	100% CD - TENDER ISSUE	-	07.09.12
03	SG	90% CD ISSUE	-	10.08.12
02	SG	75% CD ISSUE	-	13.07.12
01	SG	55% CD ISSUE	-	08.05.12



NADAAA

NADAAA
1520 Washington Street No.2 Boston Massachusetts 02118 USA
Telephone +1 617 442 8232 Facsimile +1 688 442 1417 Email nad@nadaaa.com

John Wardle Architects

25 Rokeby Street, Collingwood, Victoria 3066 Australia
Tel: +61 3 8662 0400 www.johnwardlearchitects.com
© 2012 John Wardle Architects ABN 83 006 814 268

Client University of Melbourne Parkville Campus

Project Faculty of Architecture Building and Planning


Title PLAN DETAILS L01 - SHEET 3

Project No.	0913	Scale	1:10 @ A0 1:20 @ A2
Drawing No.	AR6006	Revision	A


Date: Dec 2011 Dwn - Co-Ord - Chk -

FILENAME - \$FILES


FOR CONSTRUCTION

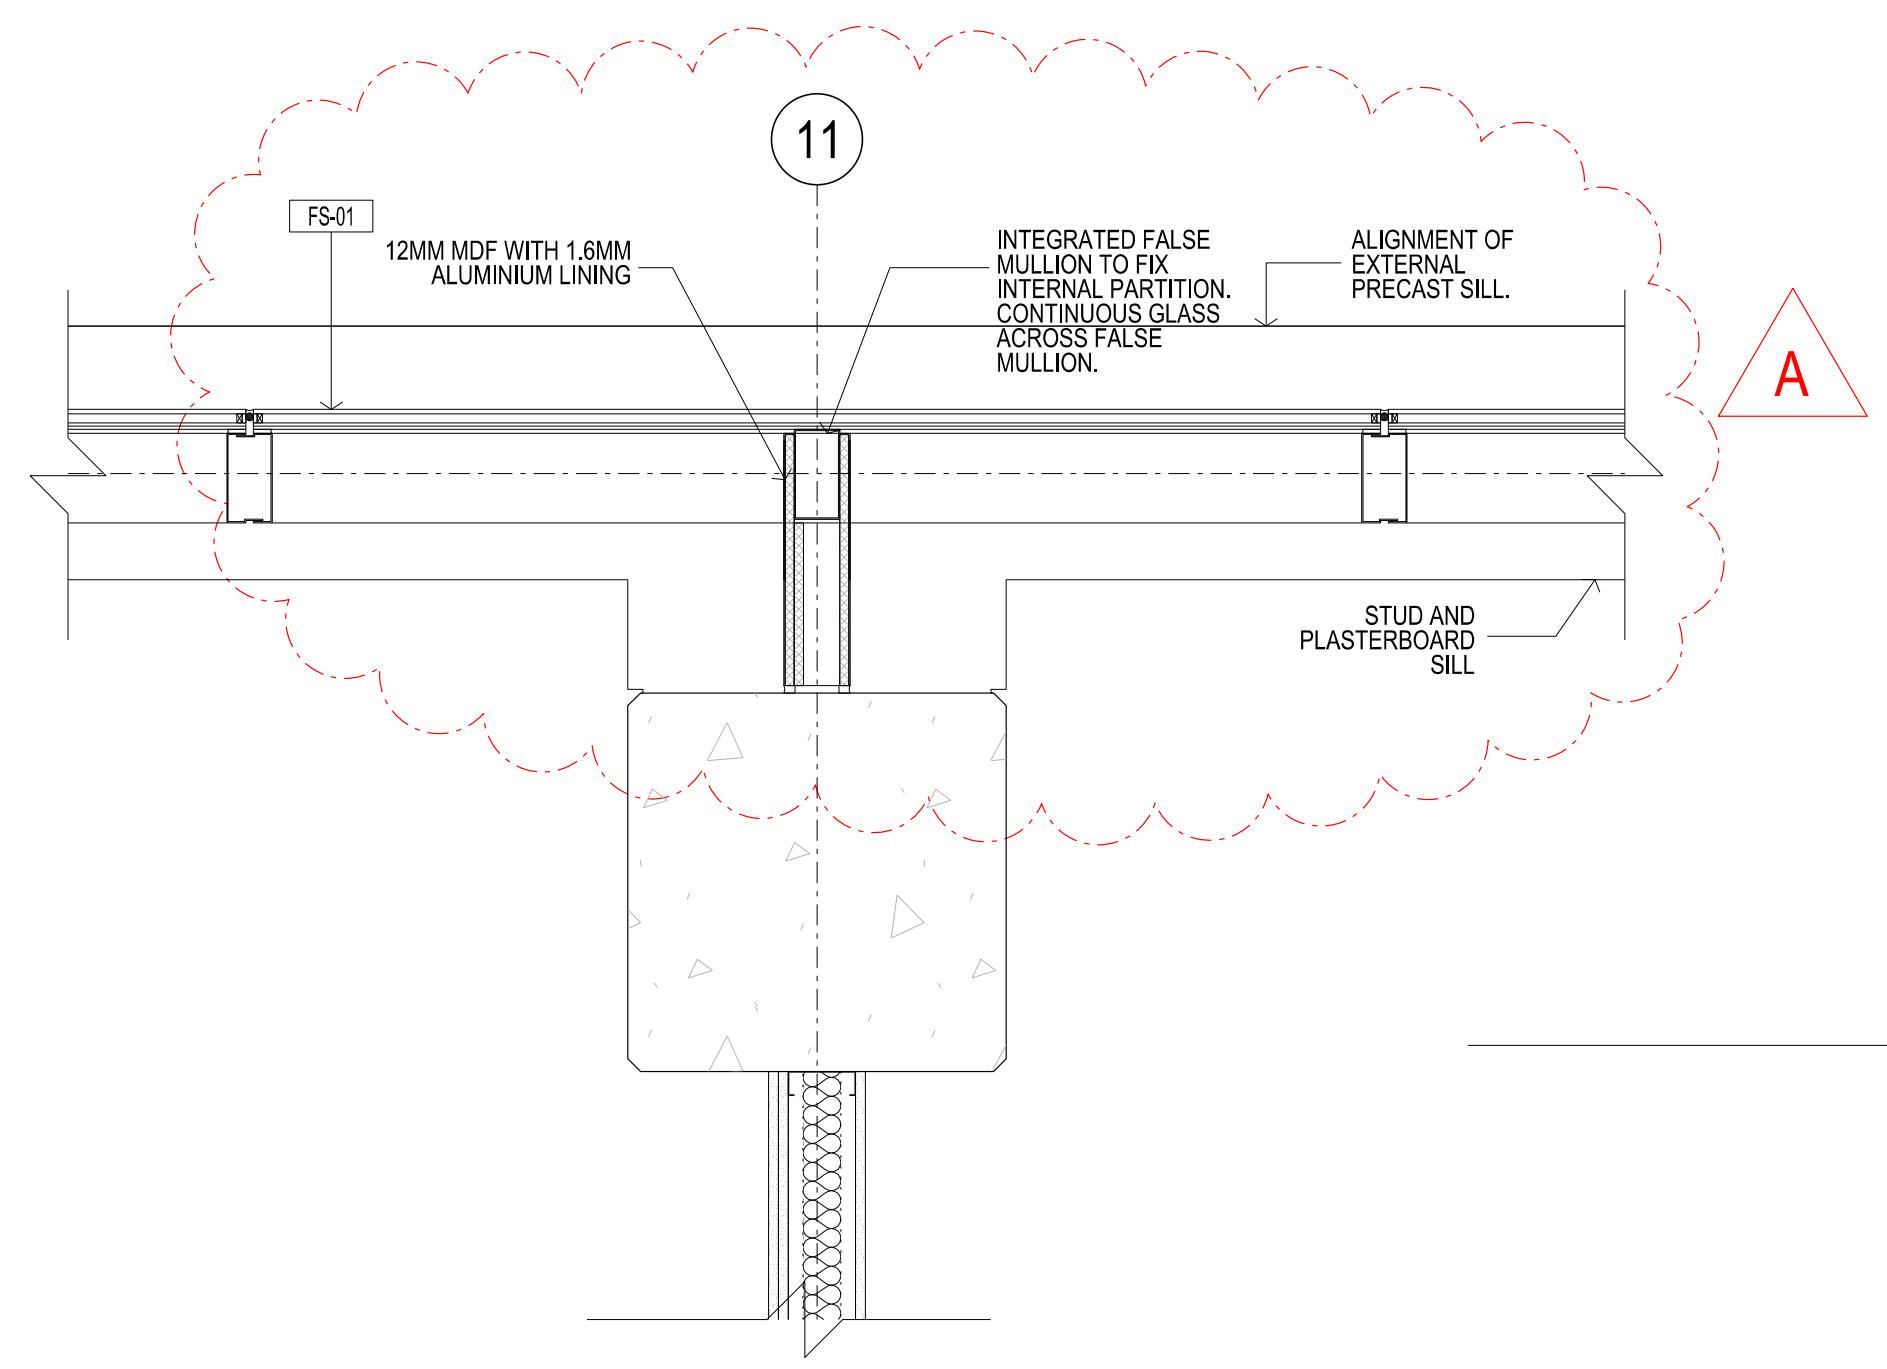


01 PLAN DETAIL - L01
SCALE 1:10

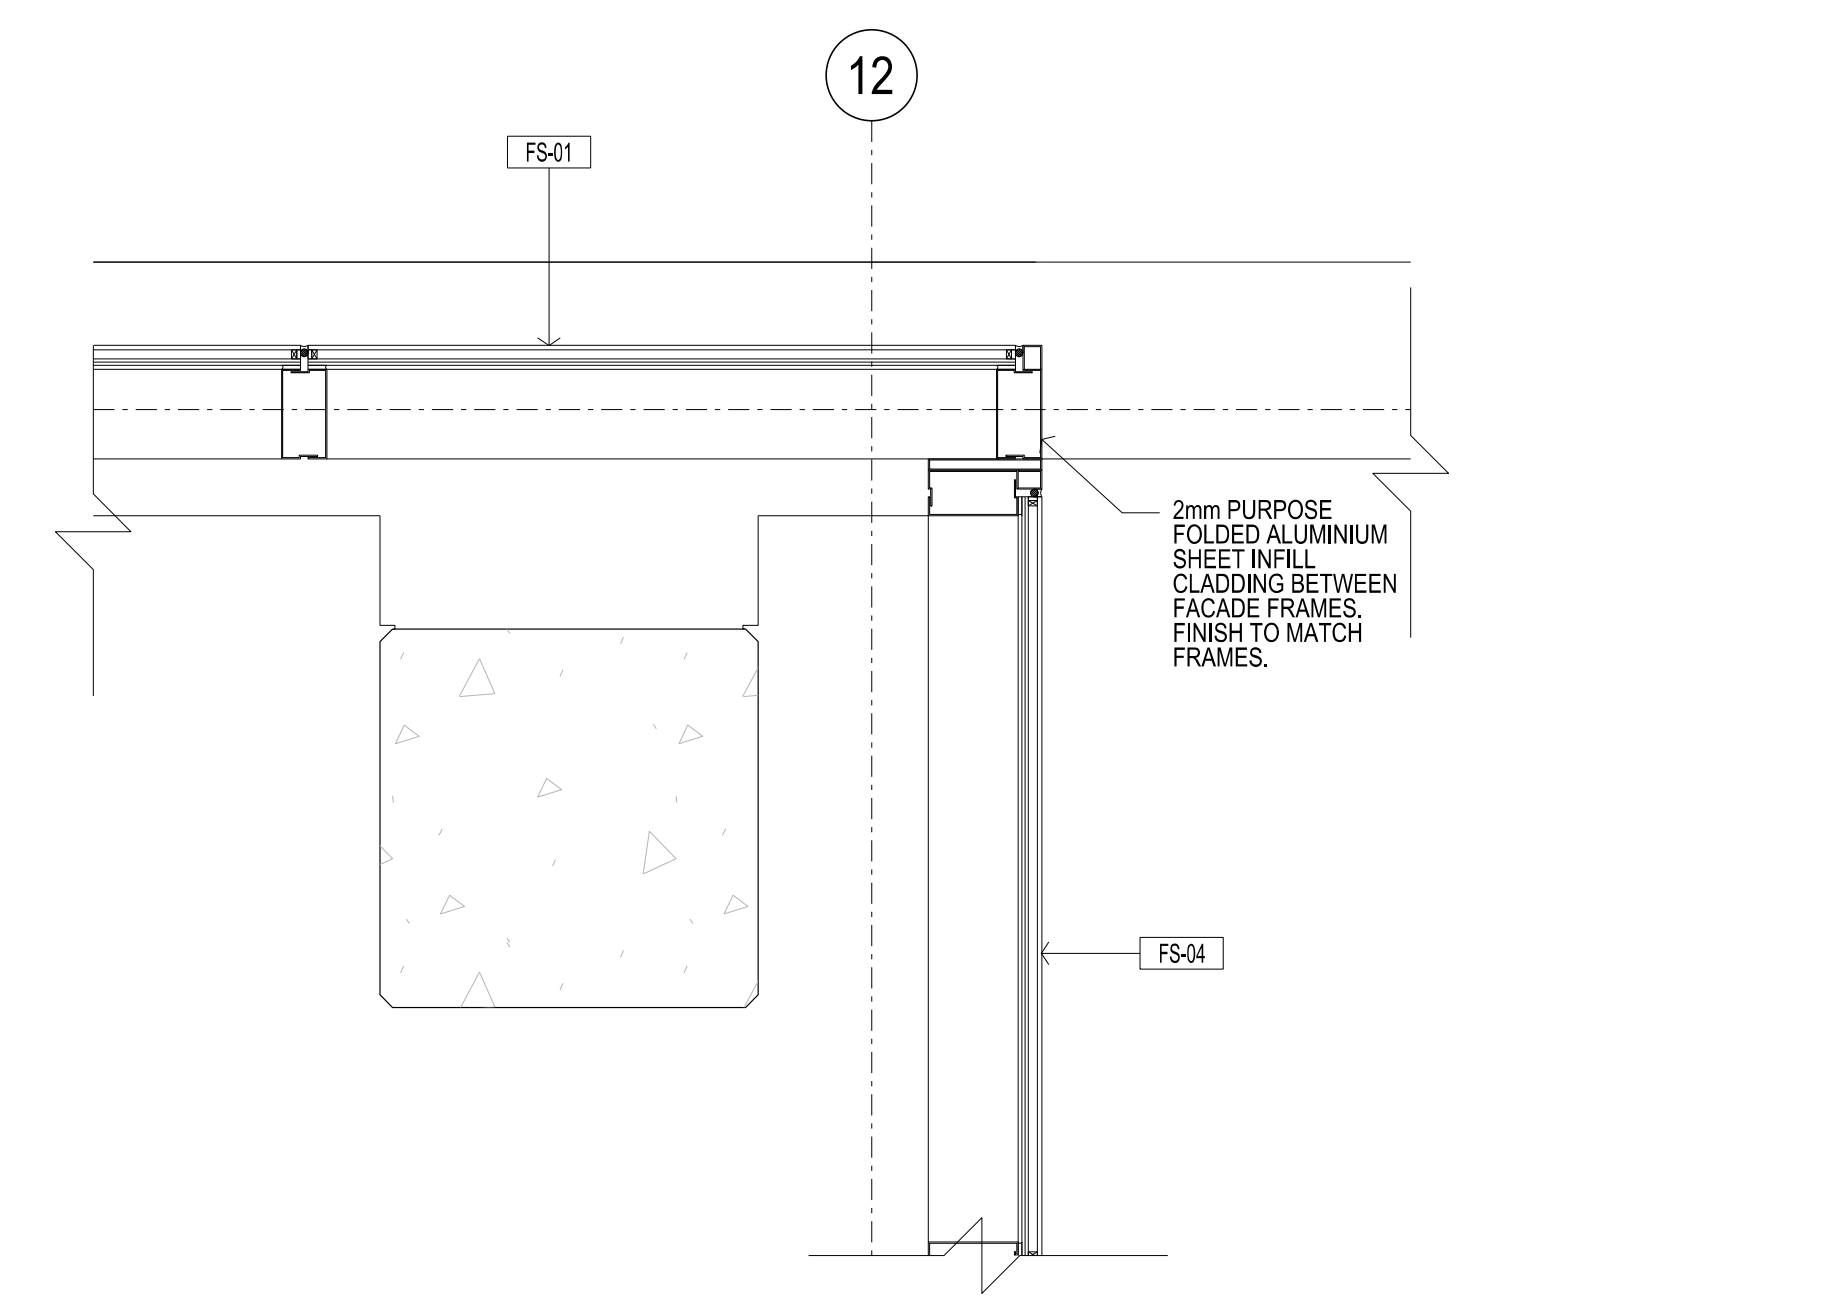


02 PLAN DETAIL - L01
SCALE 1:10

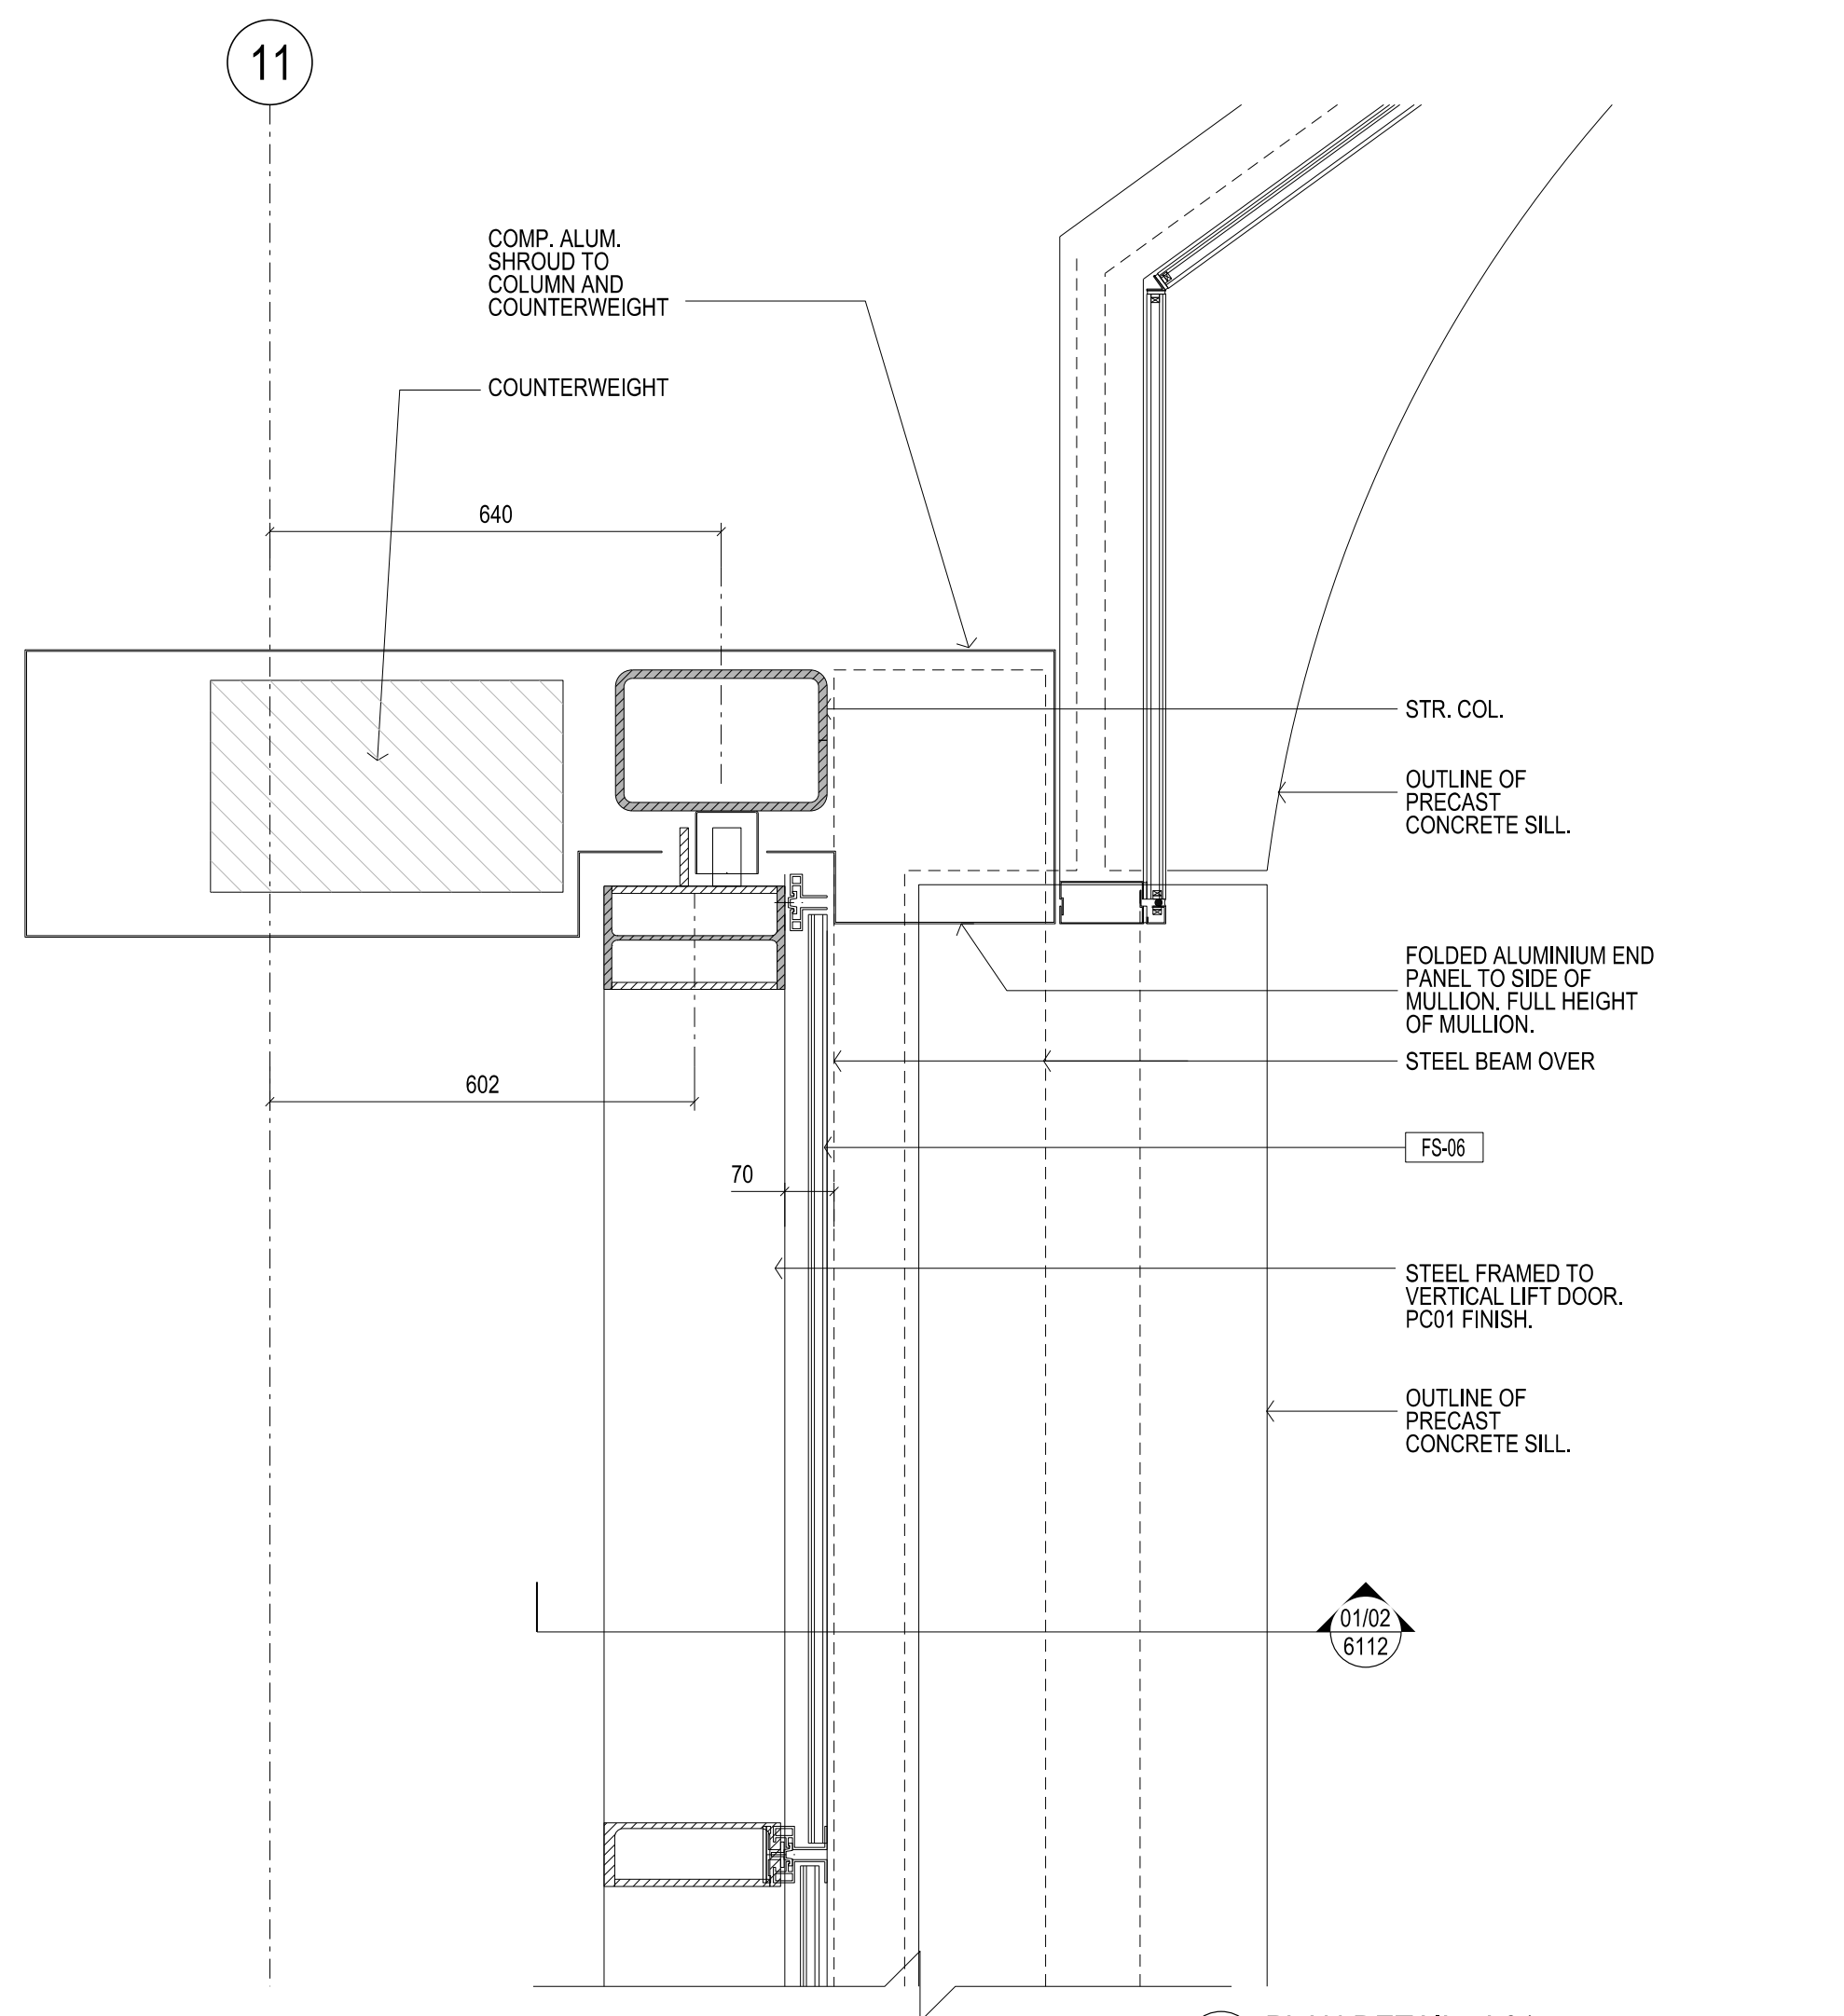


06 PLAN DETAIL - L01
SCALE 1:10

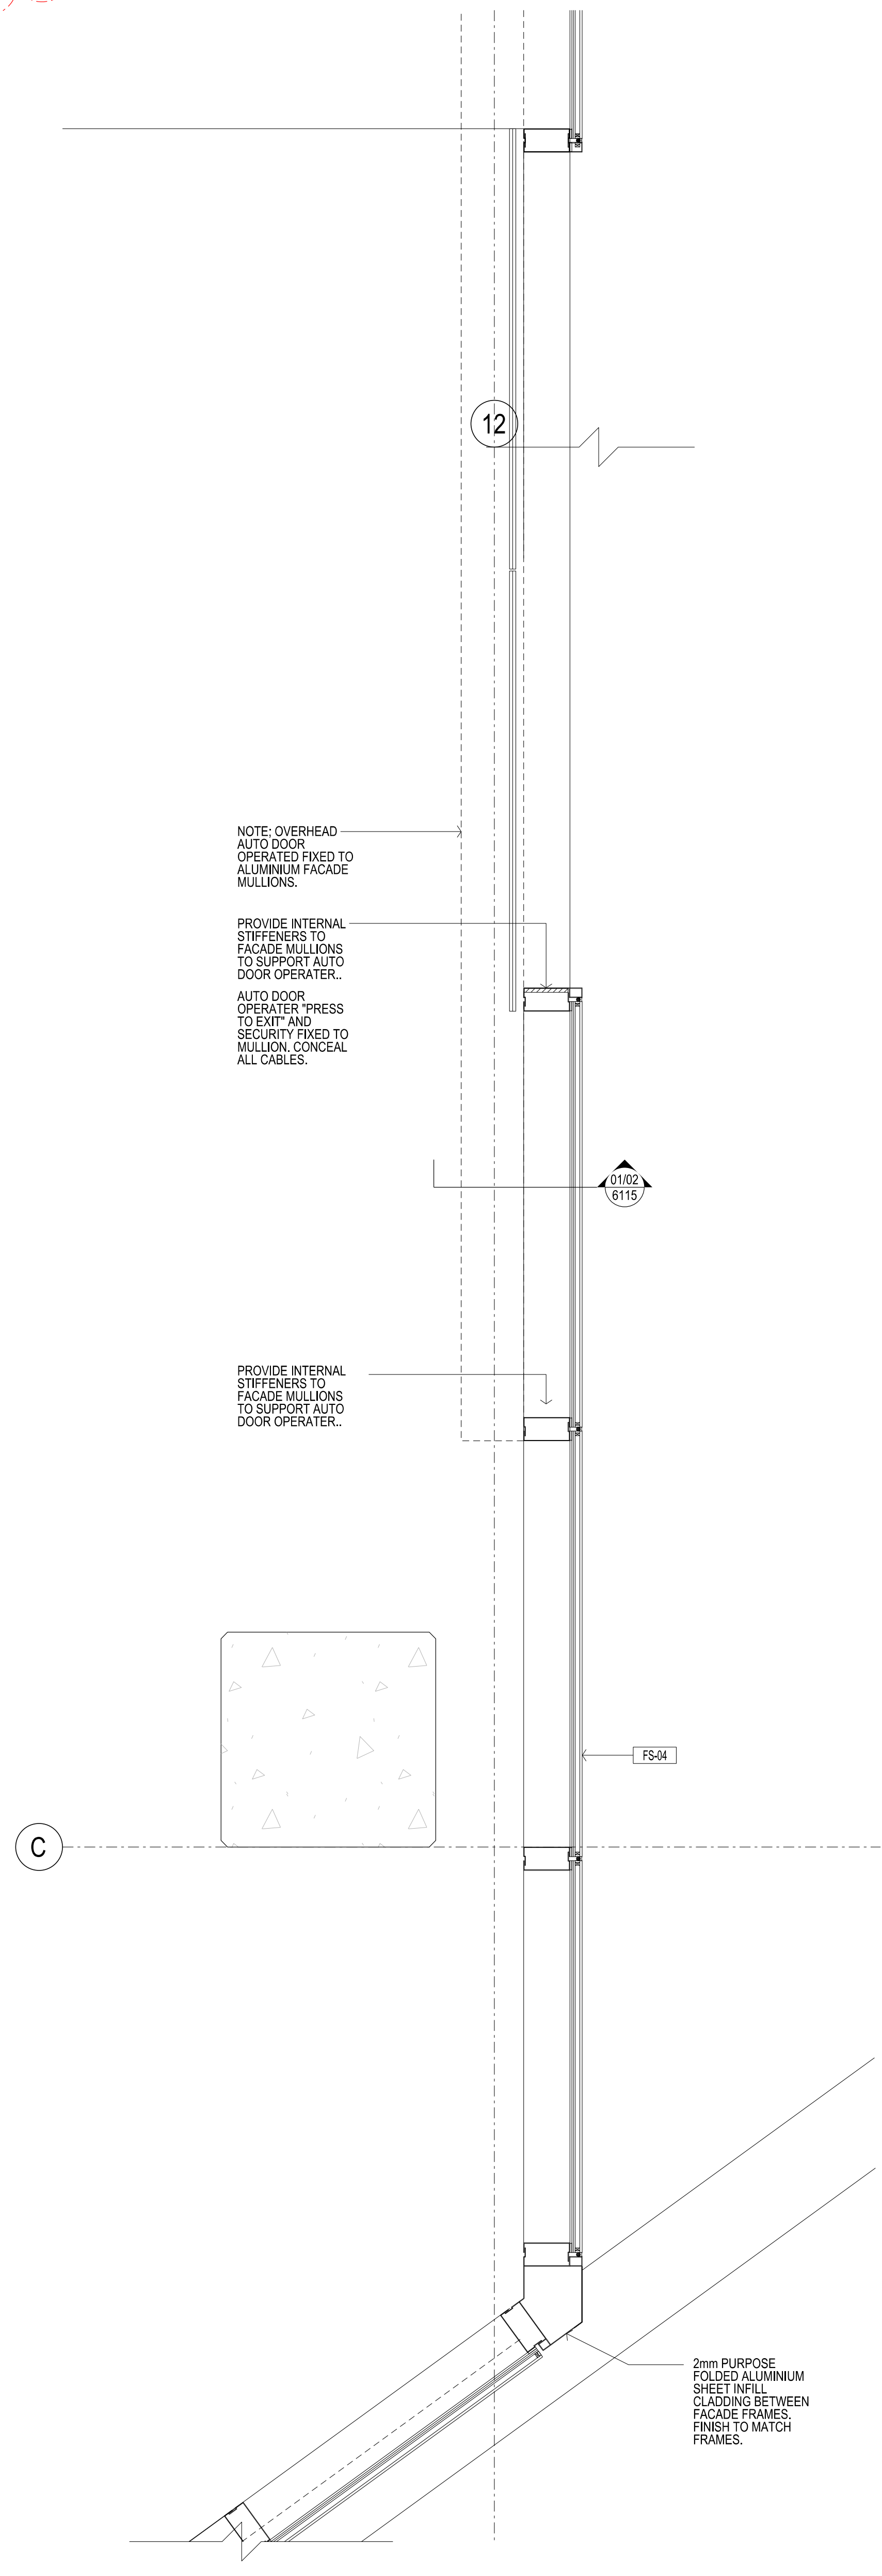


05 PLAN DETAIL - L01
SCALE 1:10

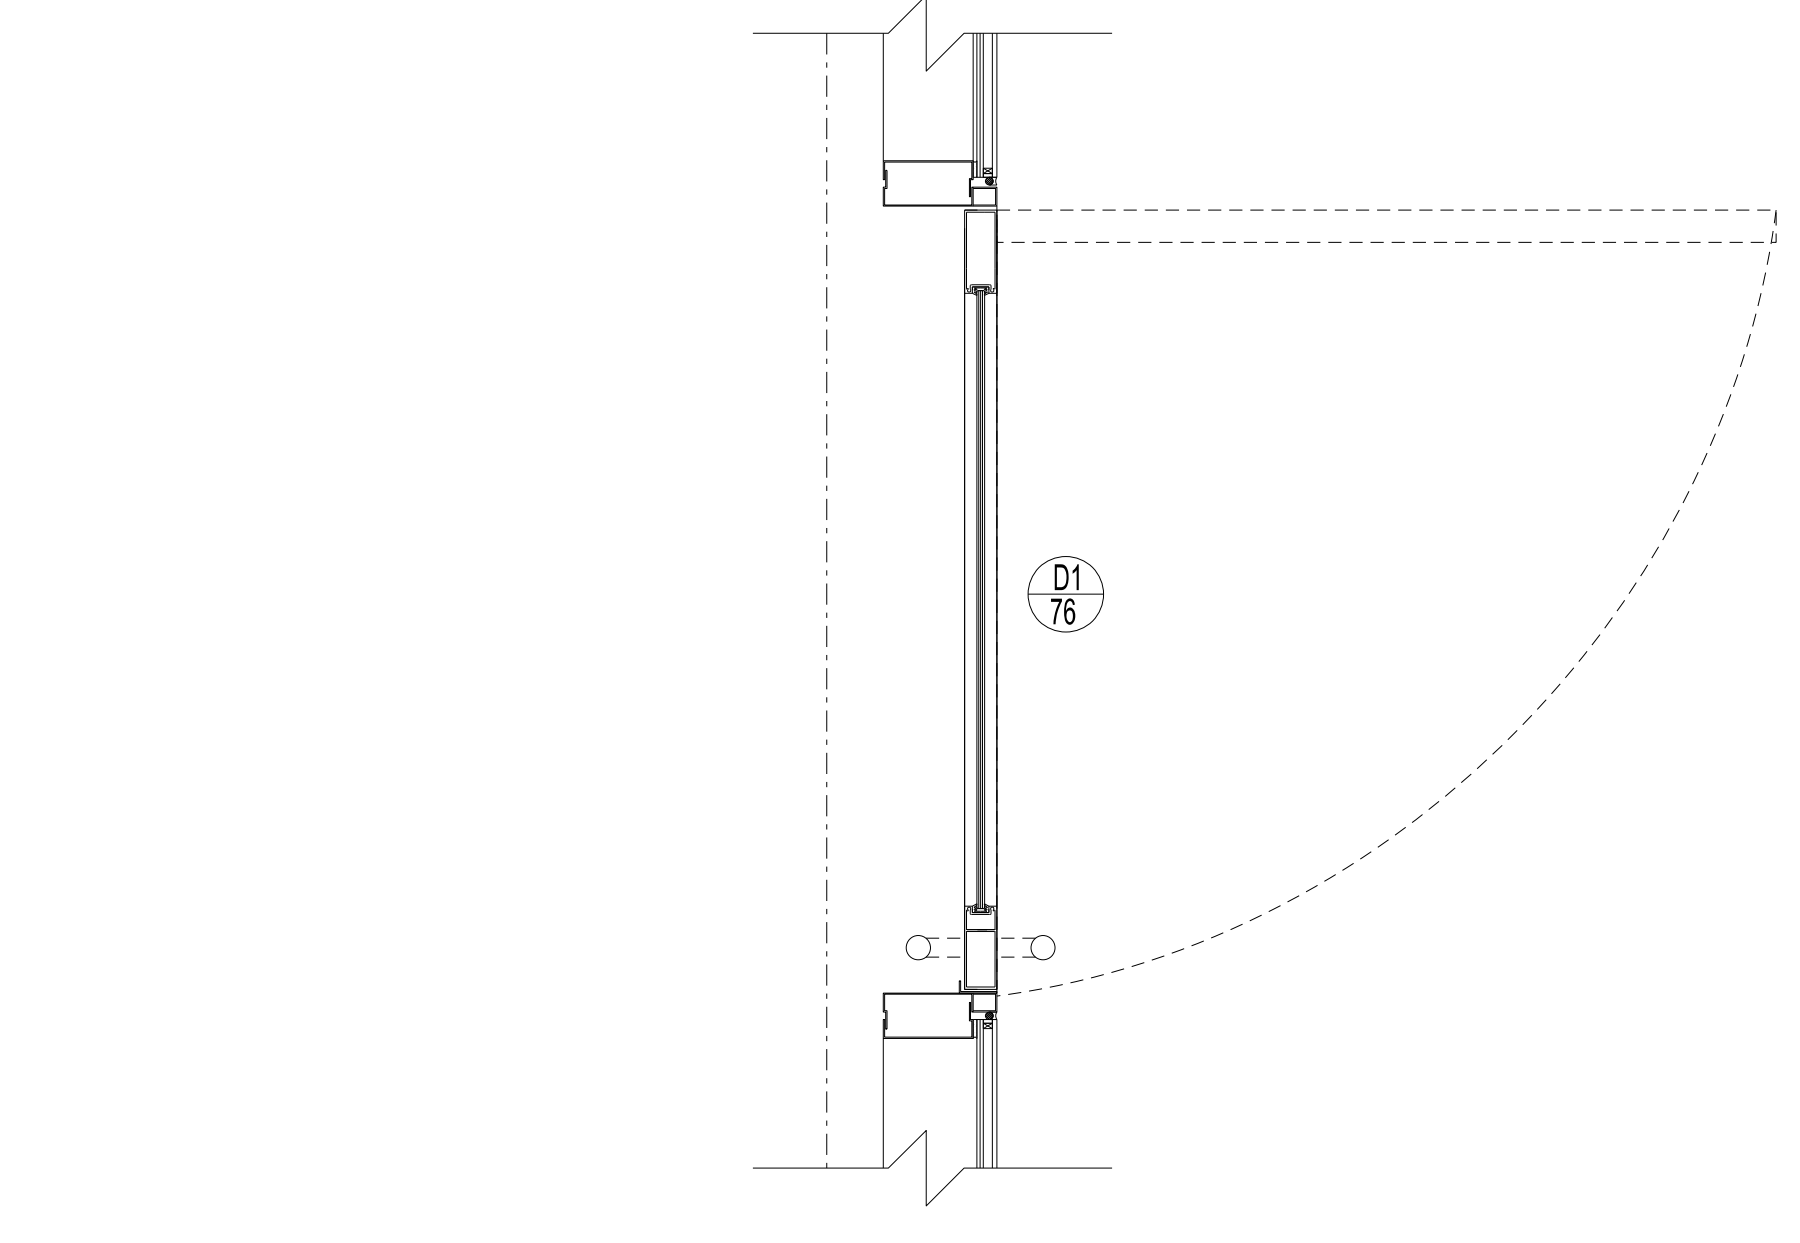

03 PLAN DETAIL - L01
SCALE 1:10

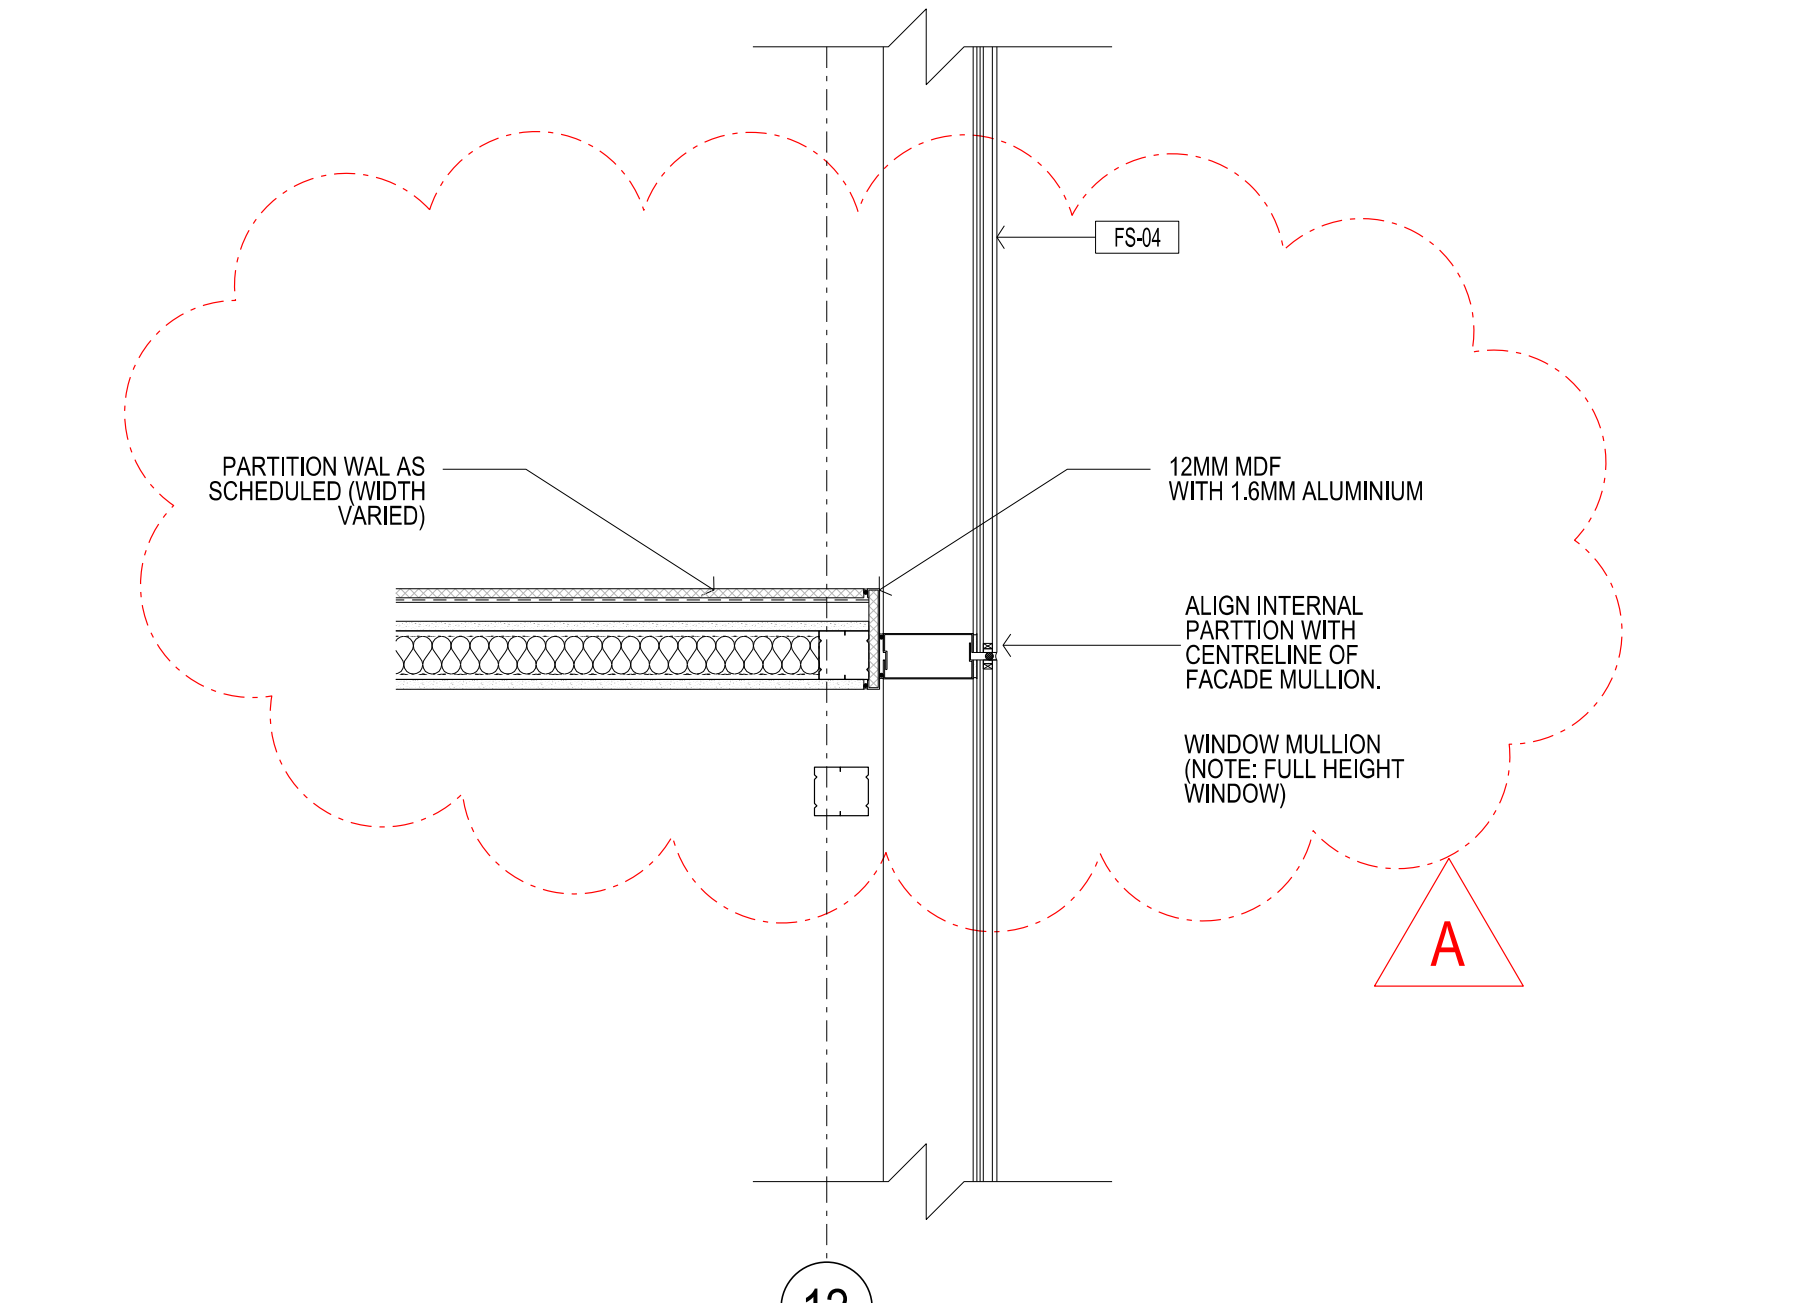

04 PLAN DETAIL - L01
SCALE 1:10

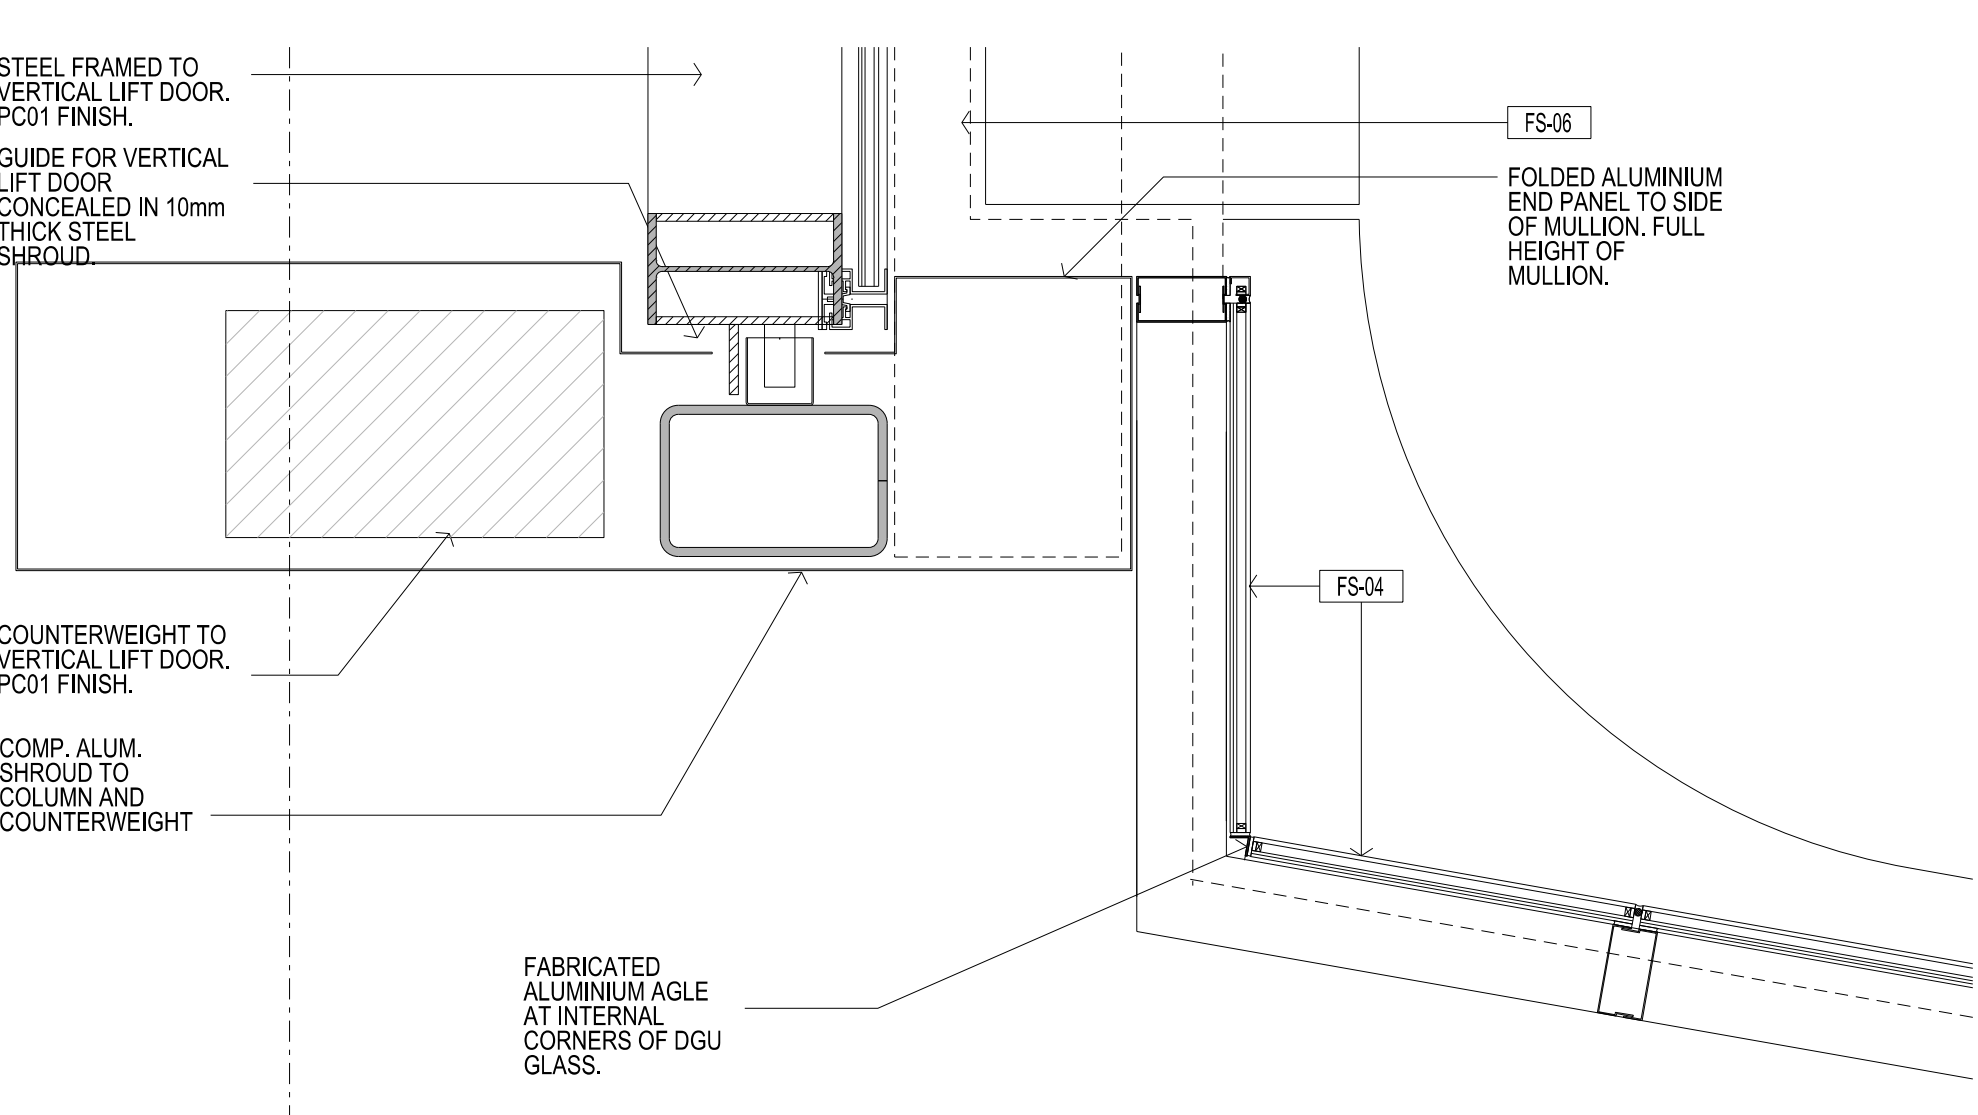

11

07 PLAN DETAIL - L01
SCALE 1:10