


CONTRACTORS SHALL VERIFY JOB DIMENSIONS BEFORE ANY JOB COMMENCES. ALL SHOP DRAWINGS SHALL BE SUBMITTED TO THE SUPERINTENDENT AND MANUFACTURER SHALL NOT COMMENCE FROM THE RESULTS OF DIMENSIONS SHOWN DRAWINGS ISSUED BY THE CONSULTANT. DIMENSIONS SHALL TAKE PRECEDENCE OVER SCALES. THIS DRAWING SHALL BE READ IN CONJUNCTION WITH ALL RELEVANT CONTRACT SPECIFICATIONS AND DRAWINGS COPYRIGHT OF THIS DRAWING IS VESTED IN WARDLE


General Notes

REFER ARCHITECTURAL DRAWINGS:


- FACADE SETOUT AR1502-AR1507
- PRECAST SETOUT AR1512-AR1517
- SCREEN SETOUT AR1502-AR1557
- SCREEN DETAILS AR6550-AR6554

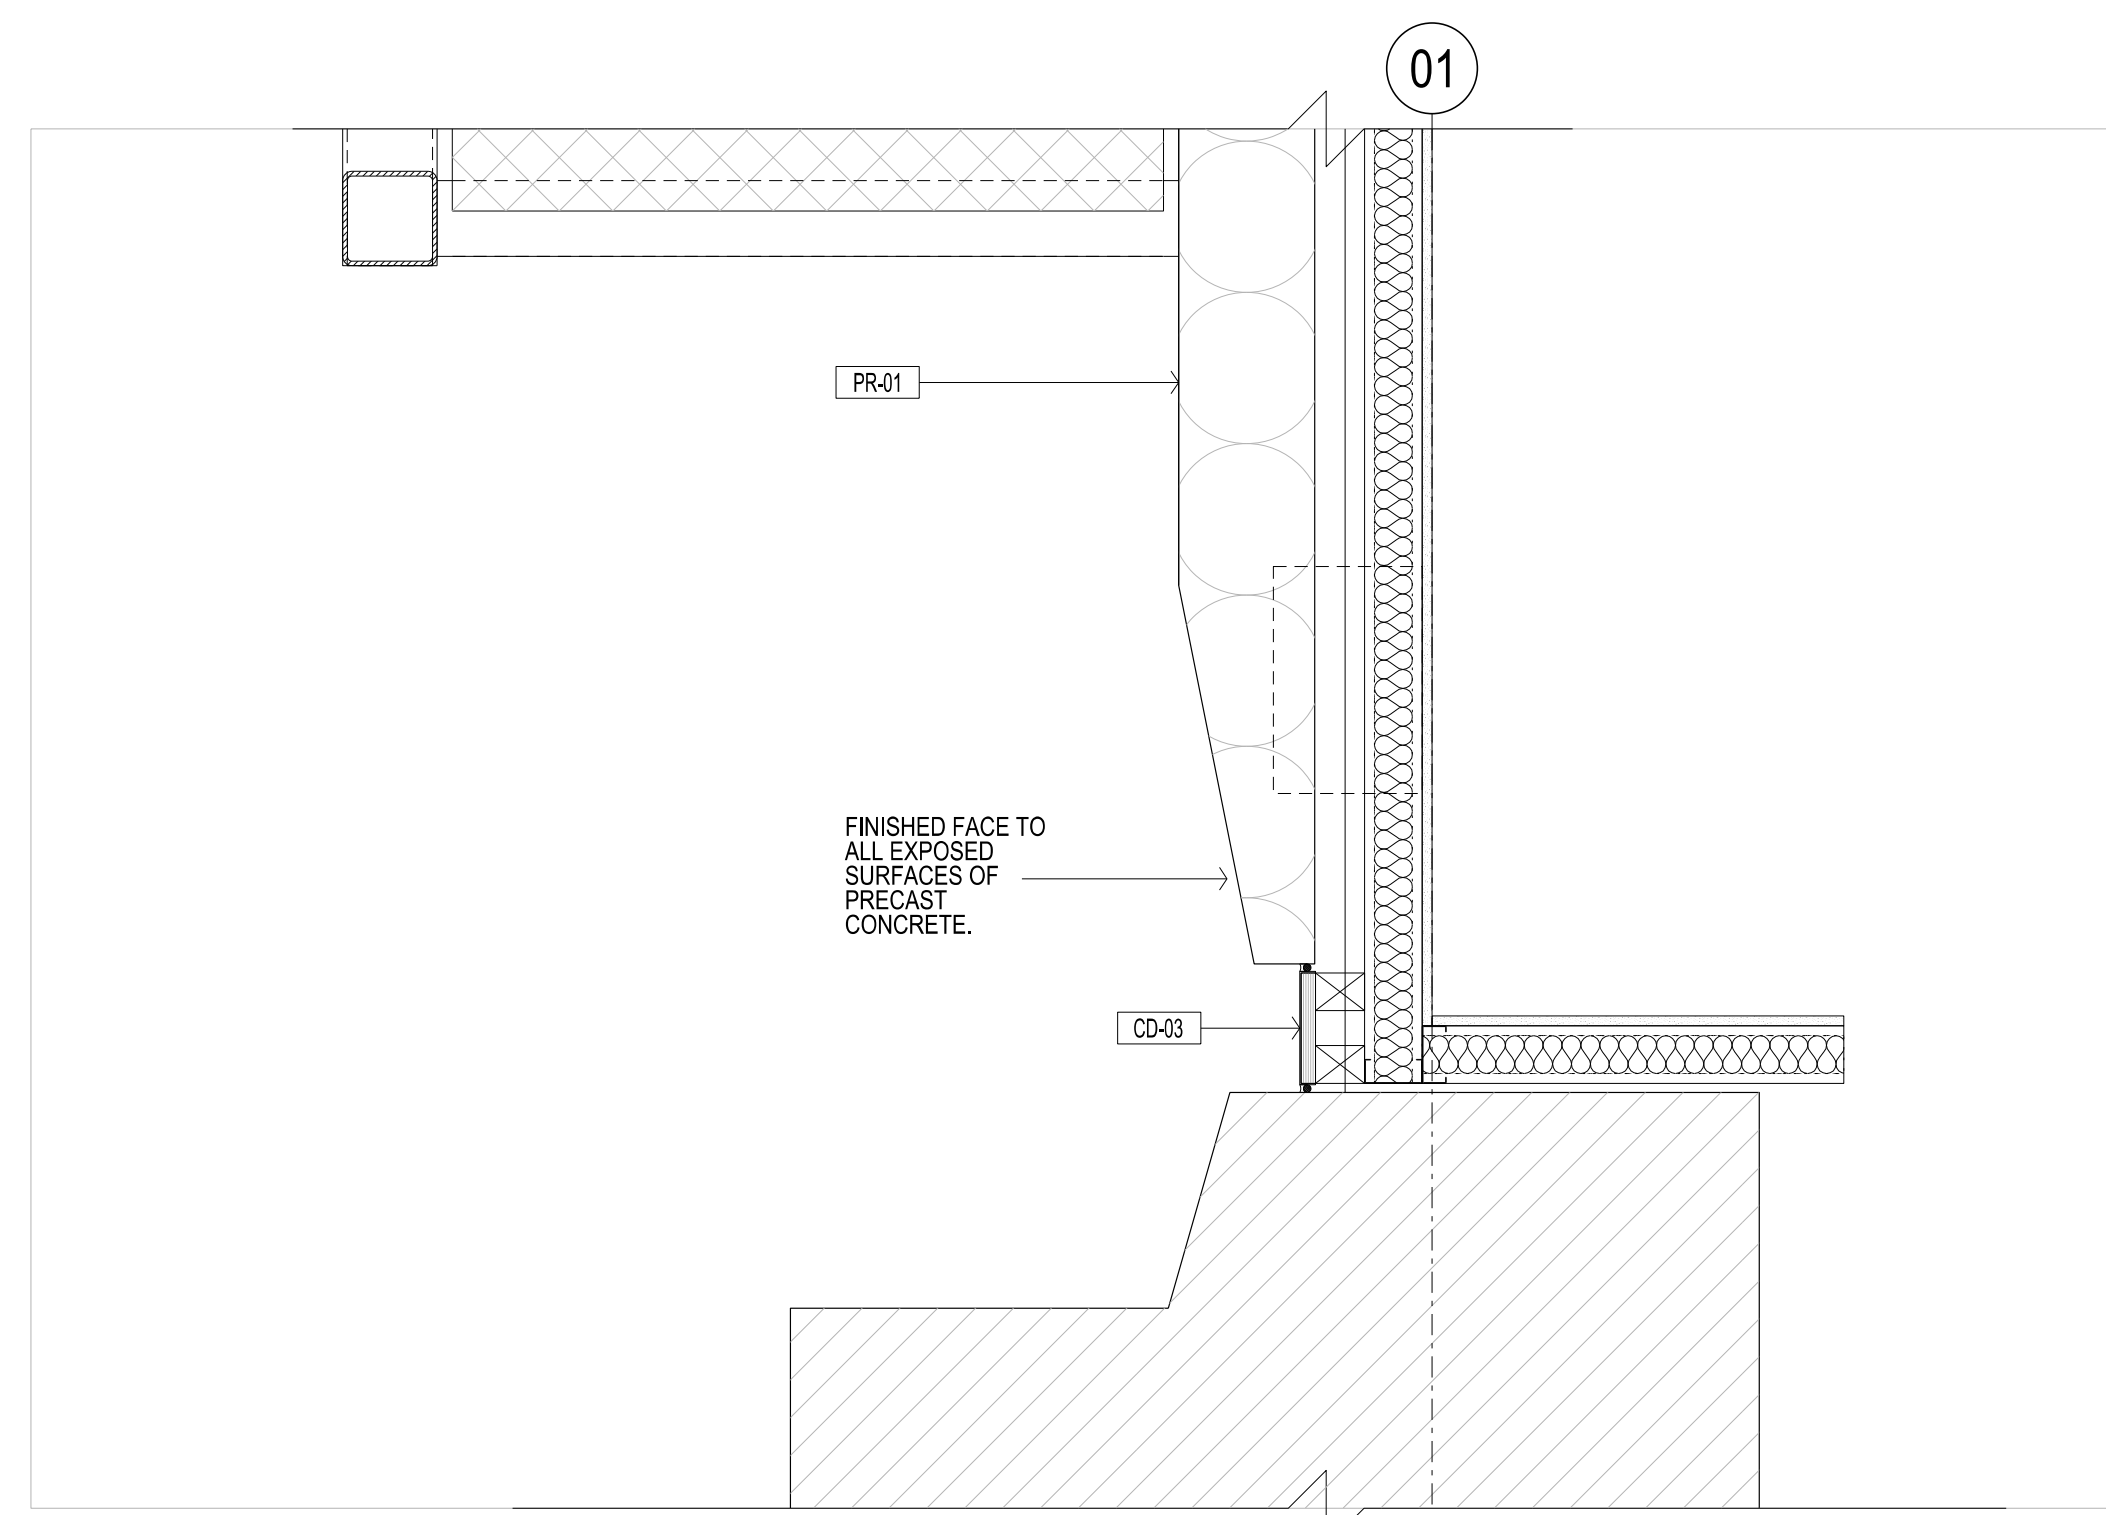


01 PLAN DETAIL - L03
1204 SCALE 1:10

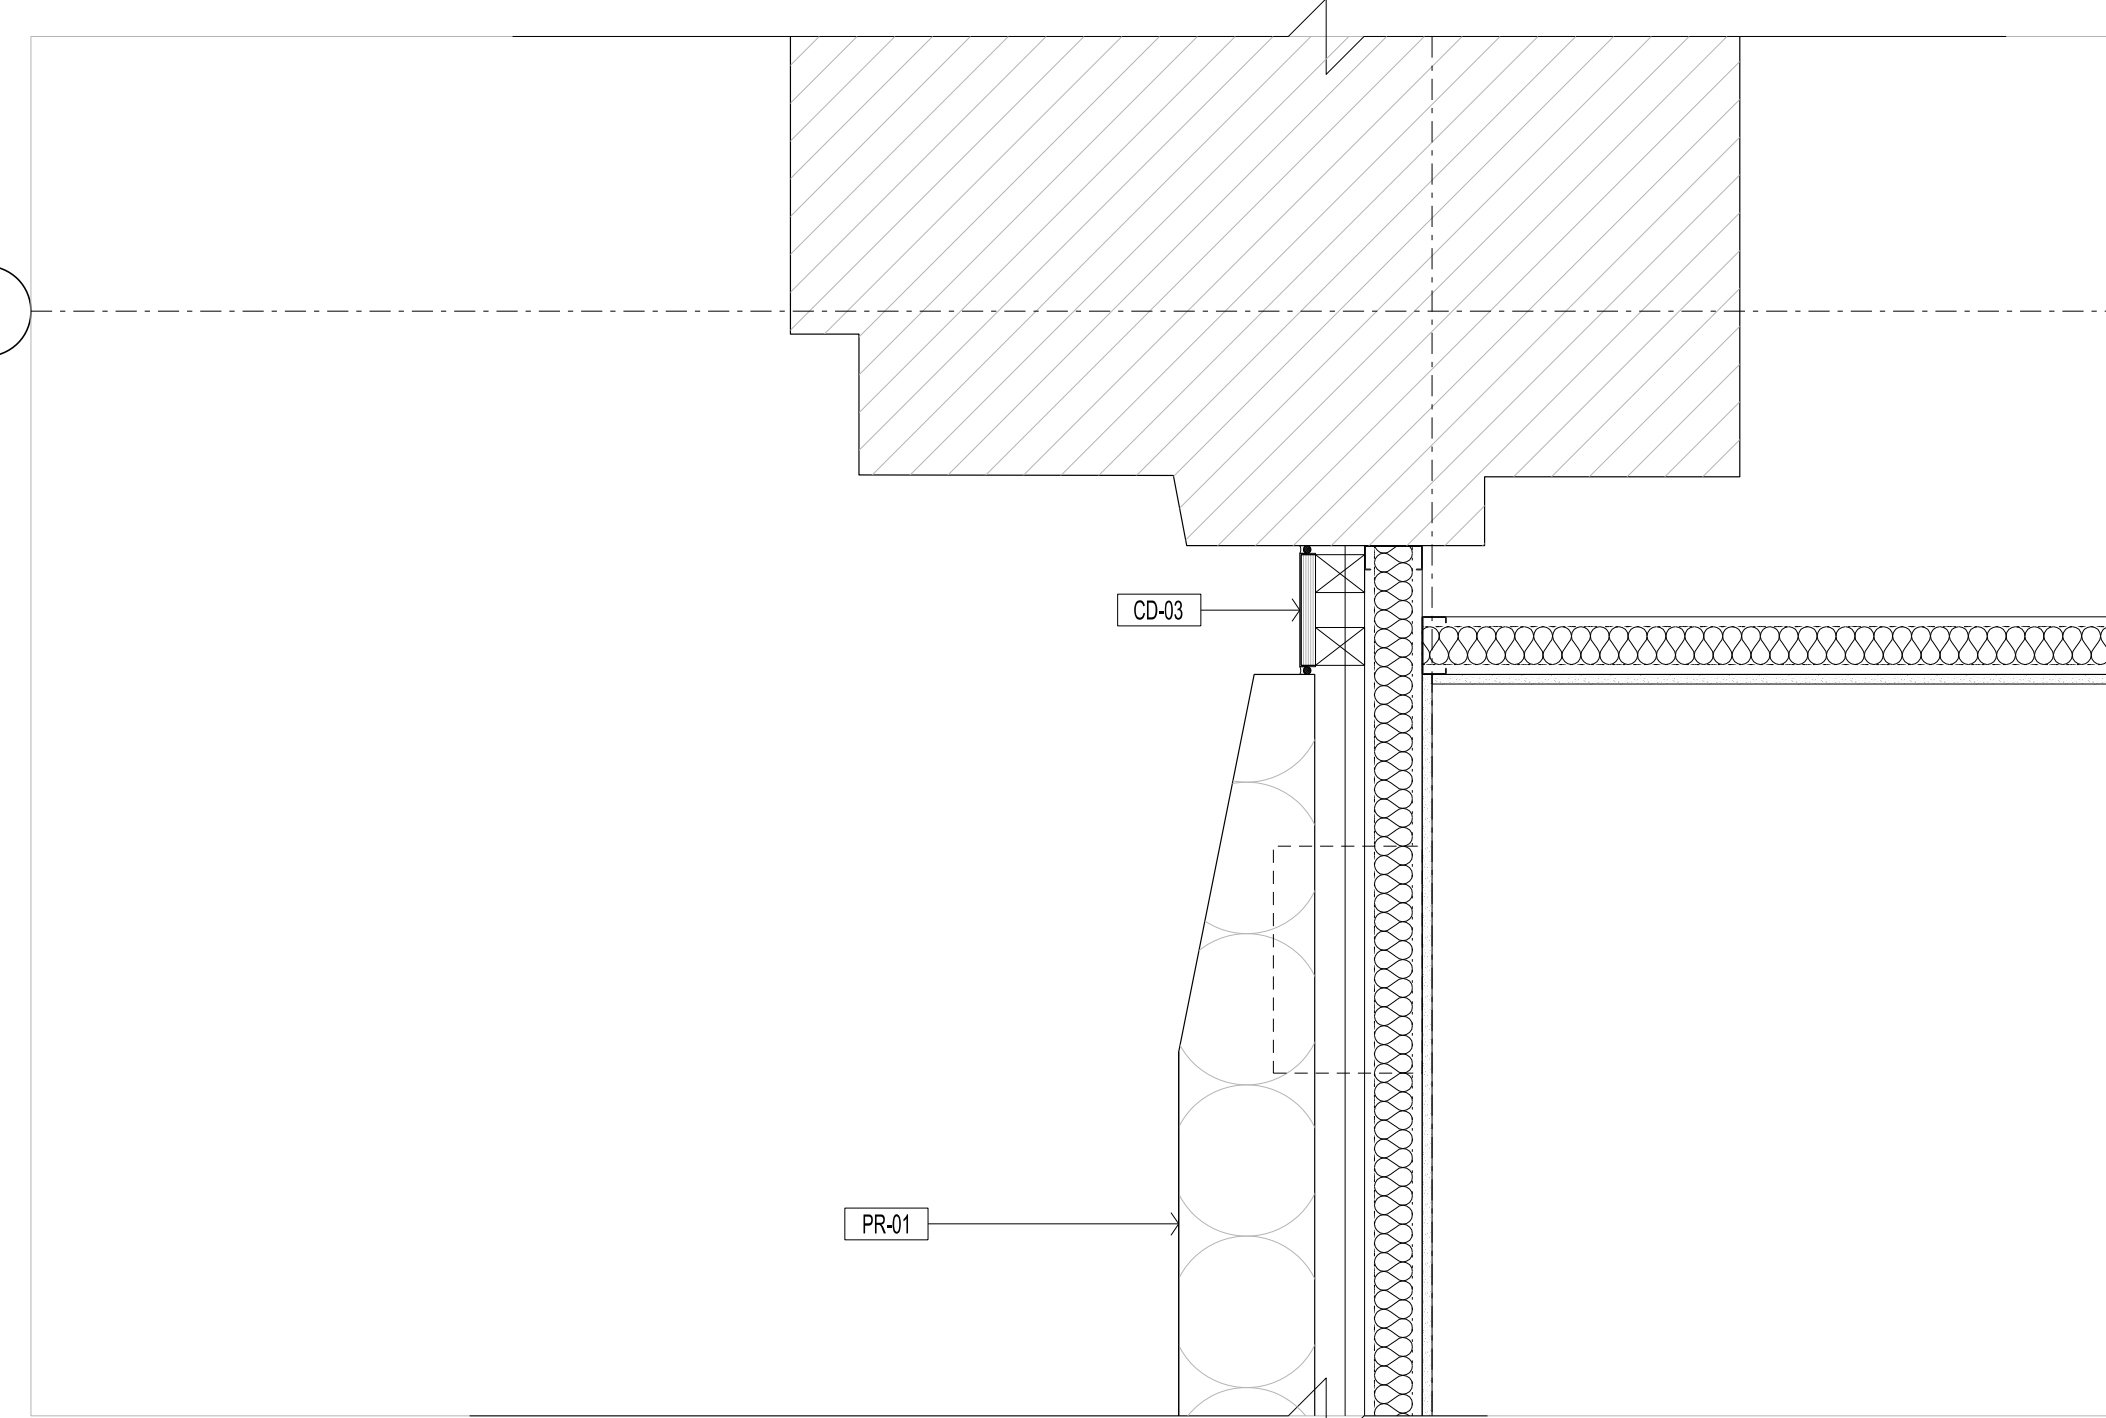


02 PLAN DETAIL - L03
1204 SCALE 1:10

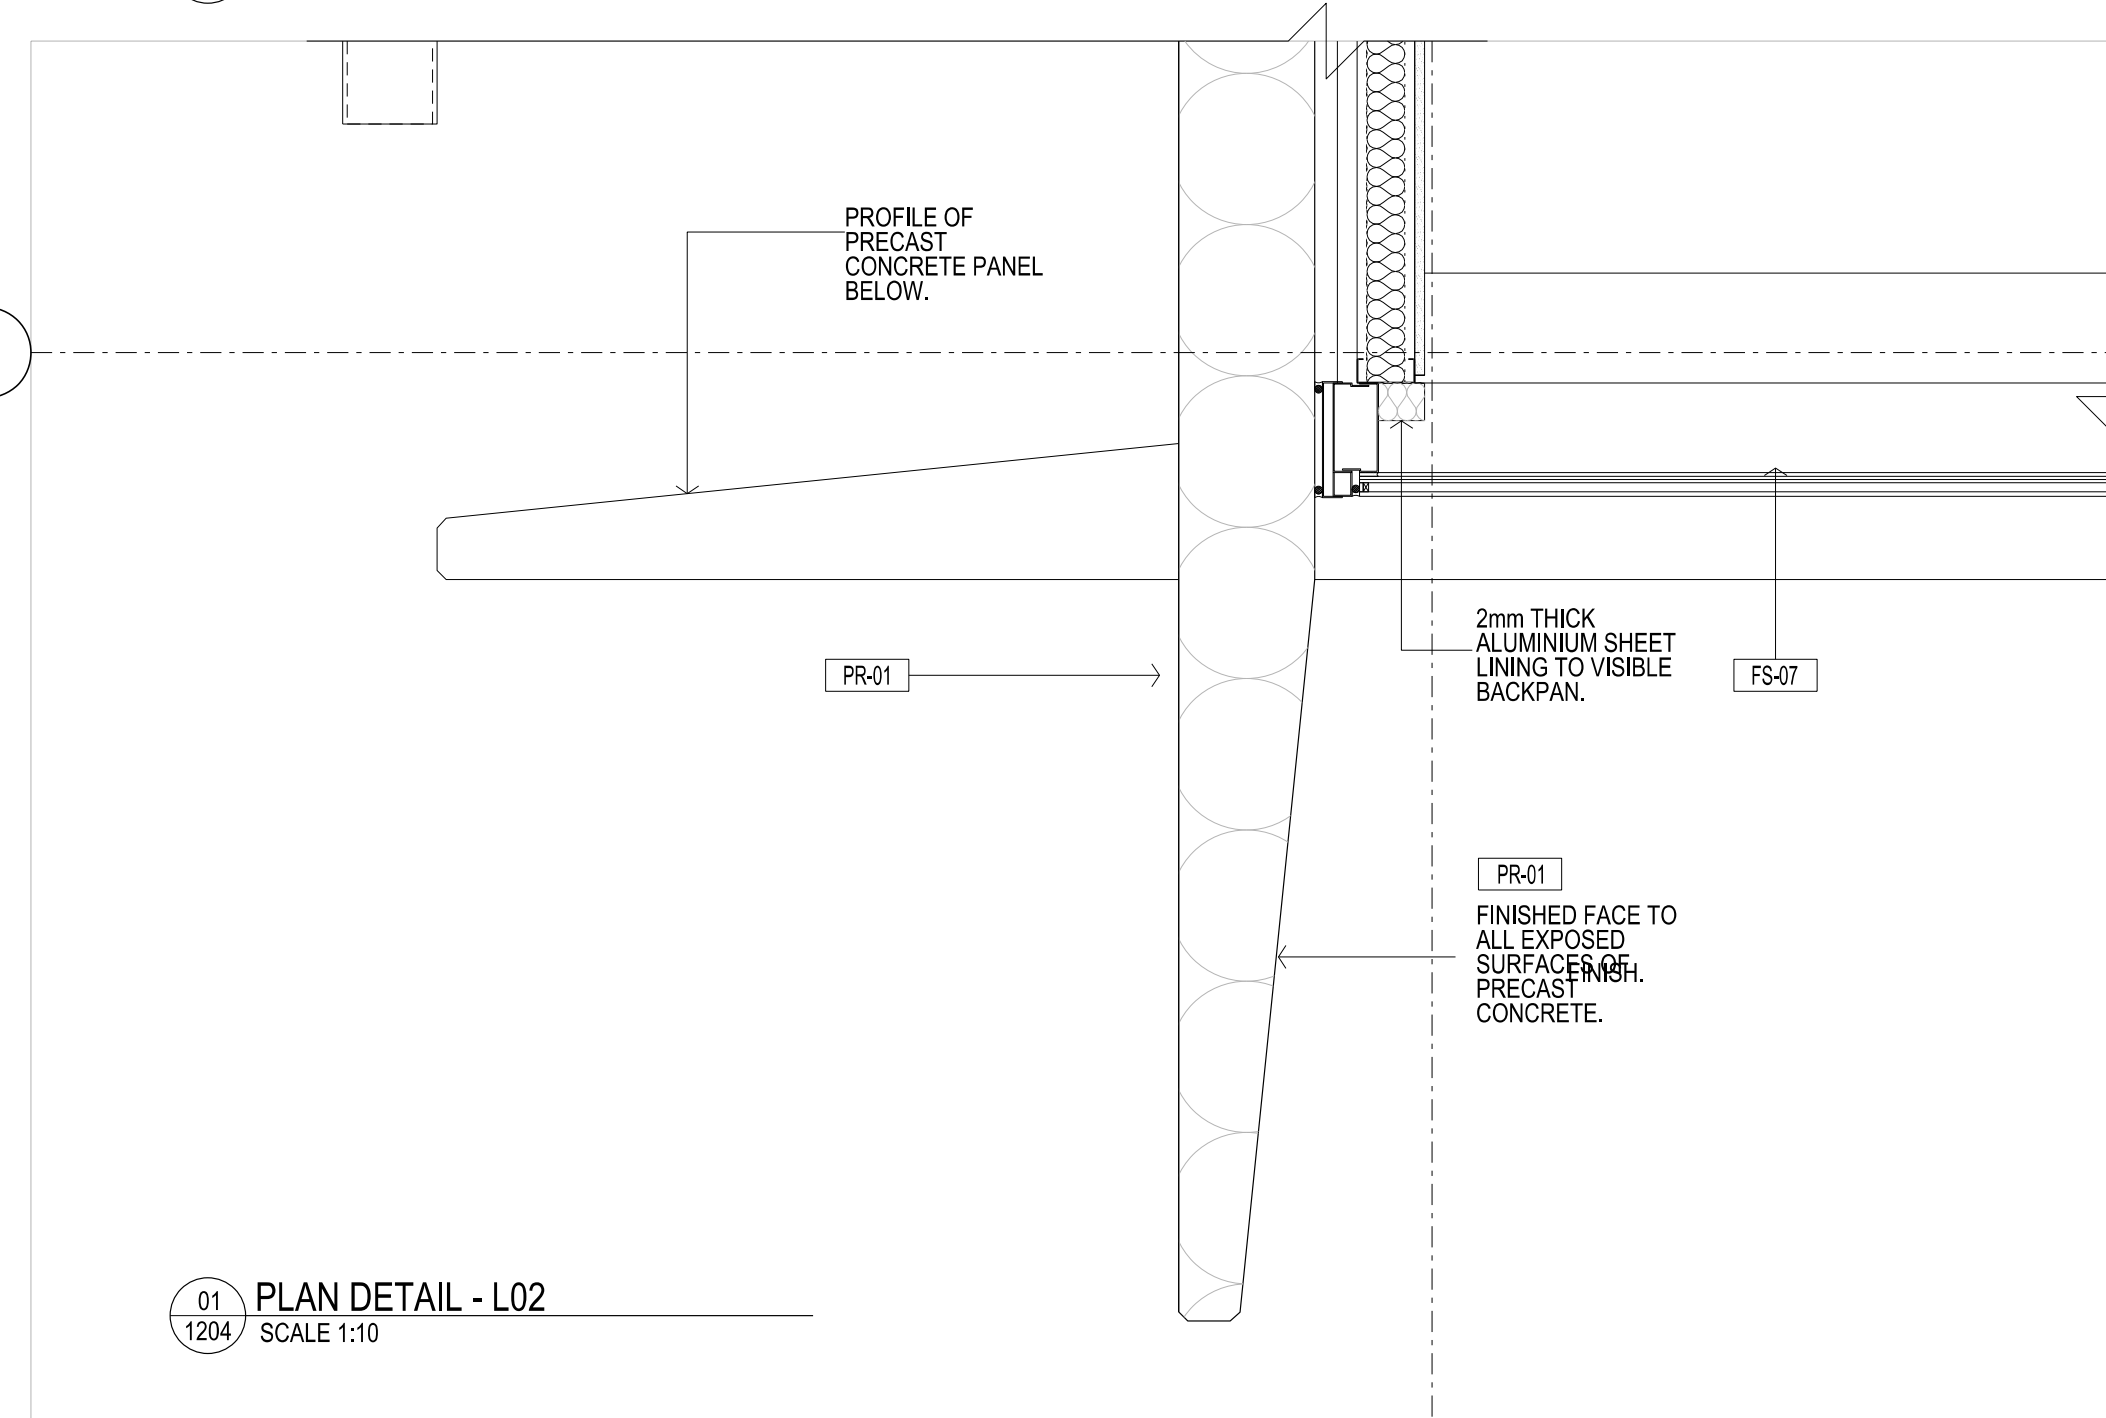


03 PLAN DETAIL - L02
1204 SCALE 1:10

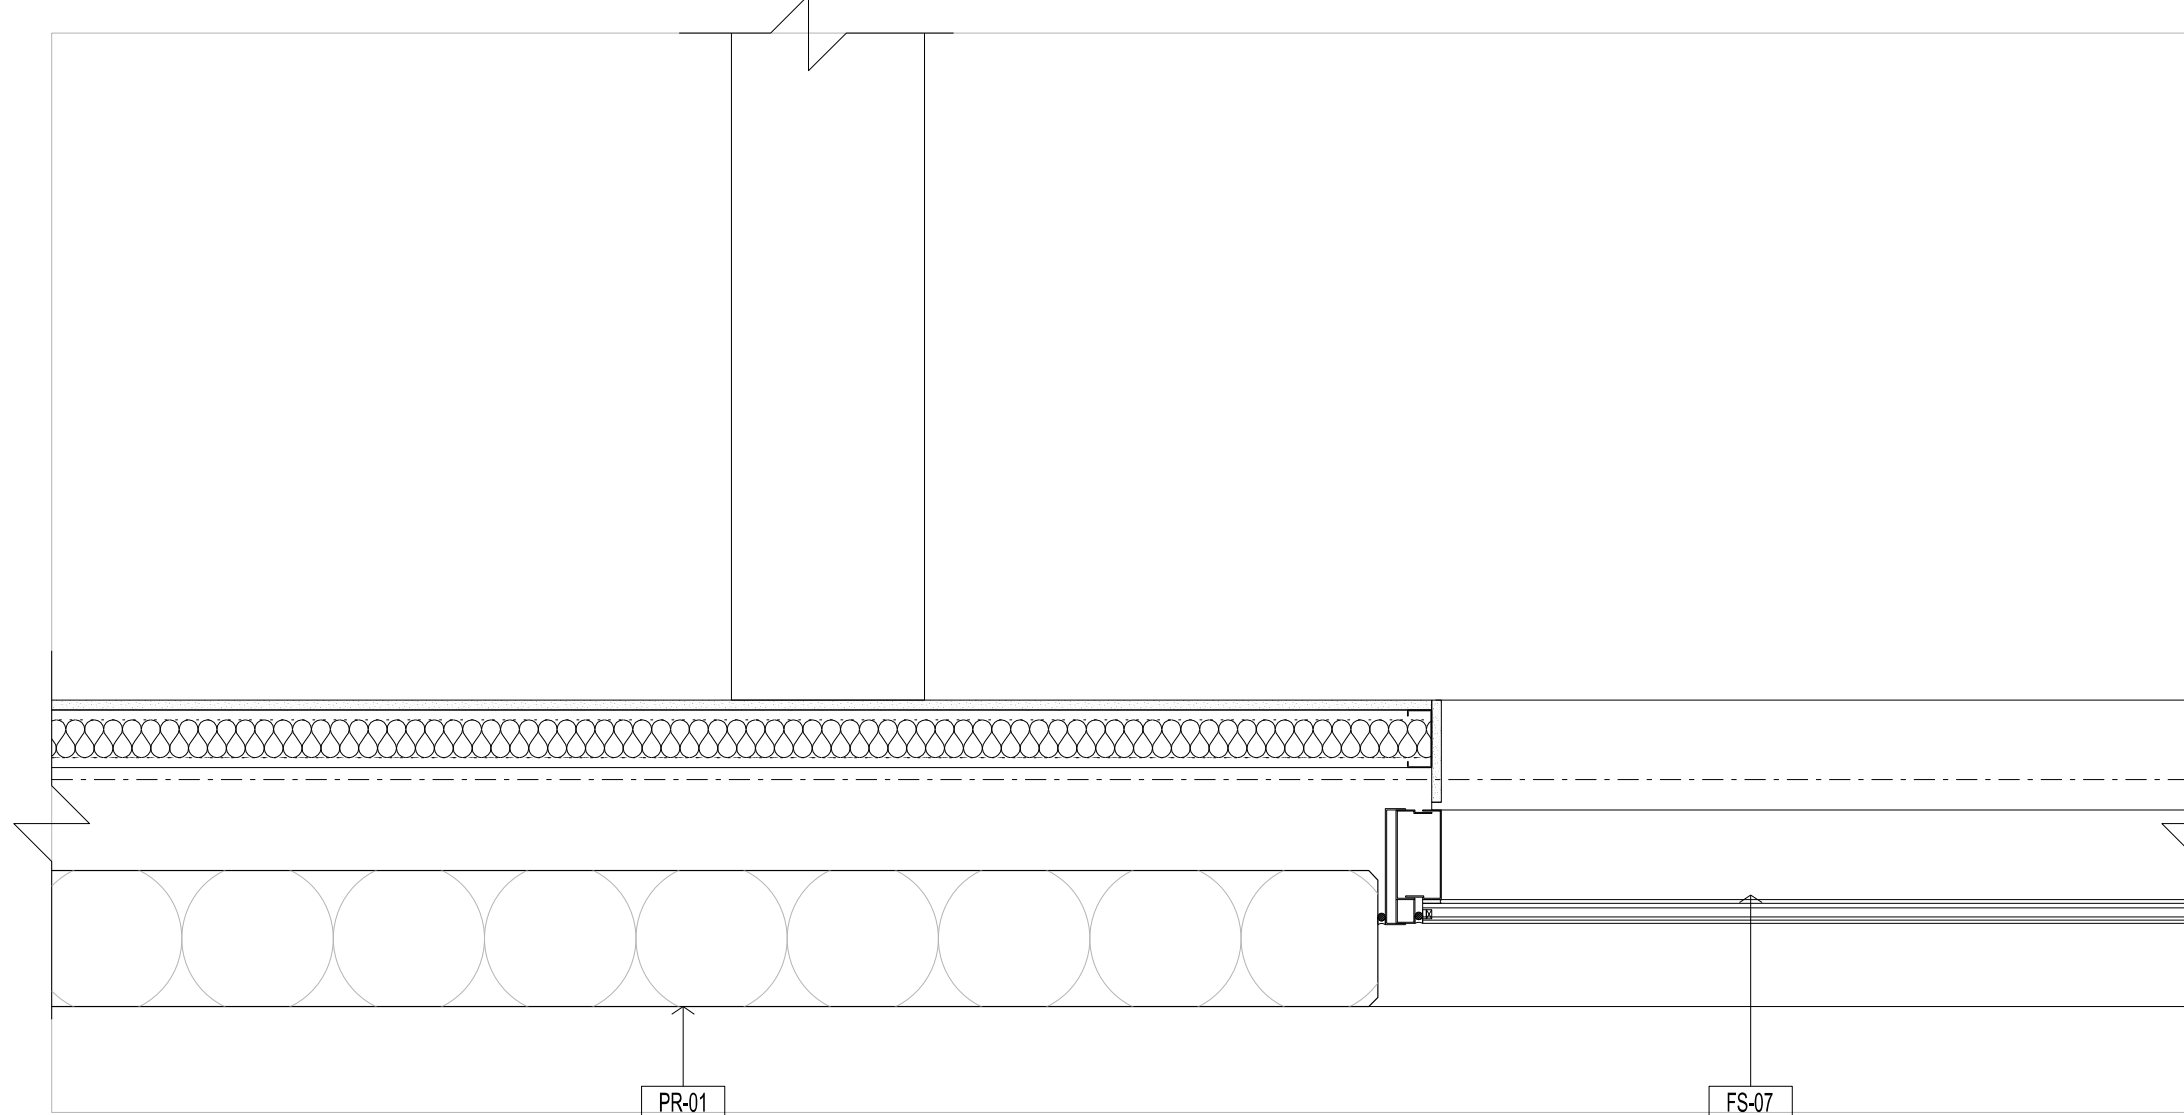


04 PLAN DETAIL - L02
1204 SCALE 1:10

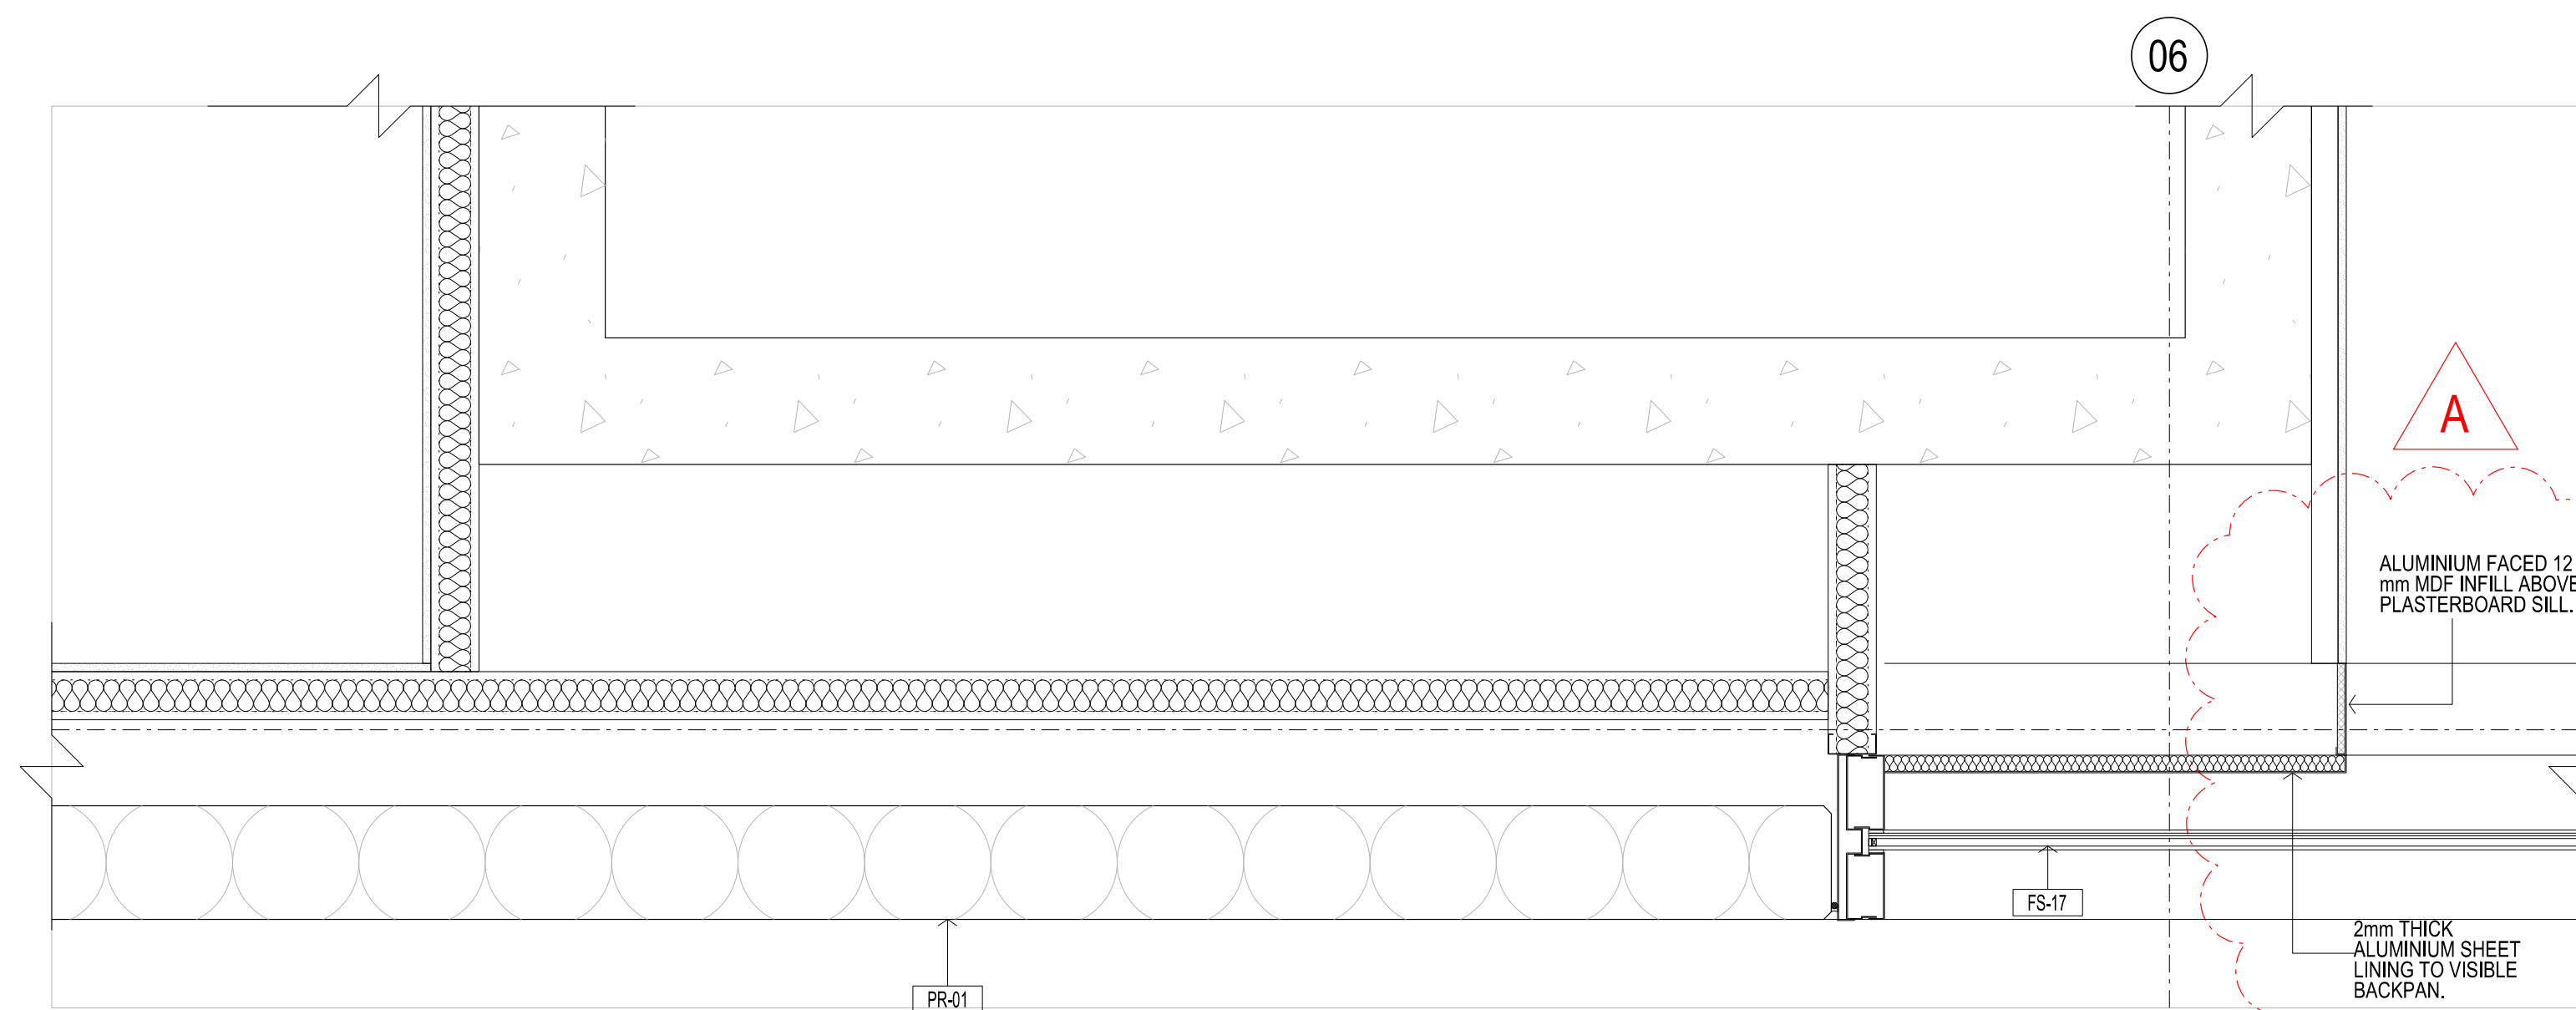


05 PLAN DETAIL - L02
1204 SCALE 1:10

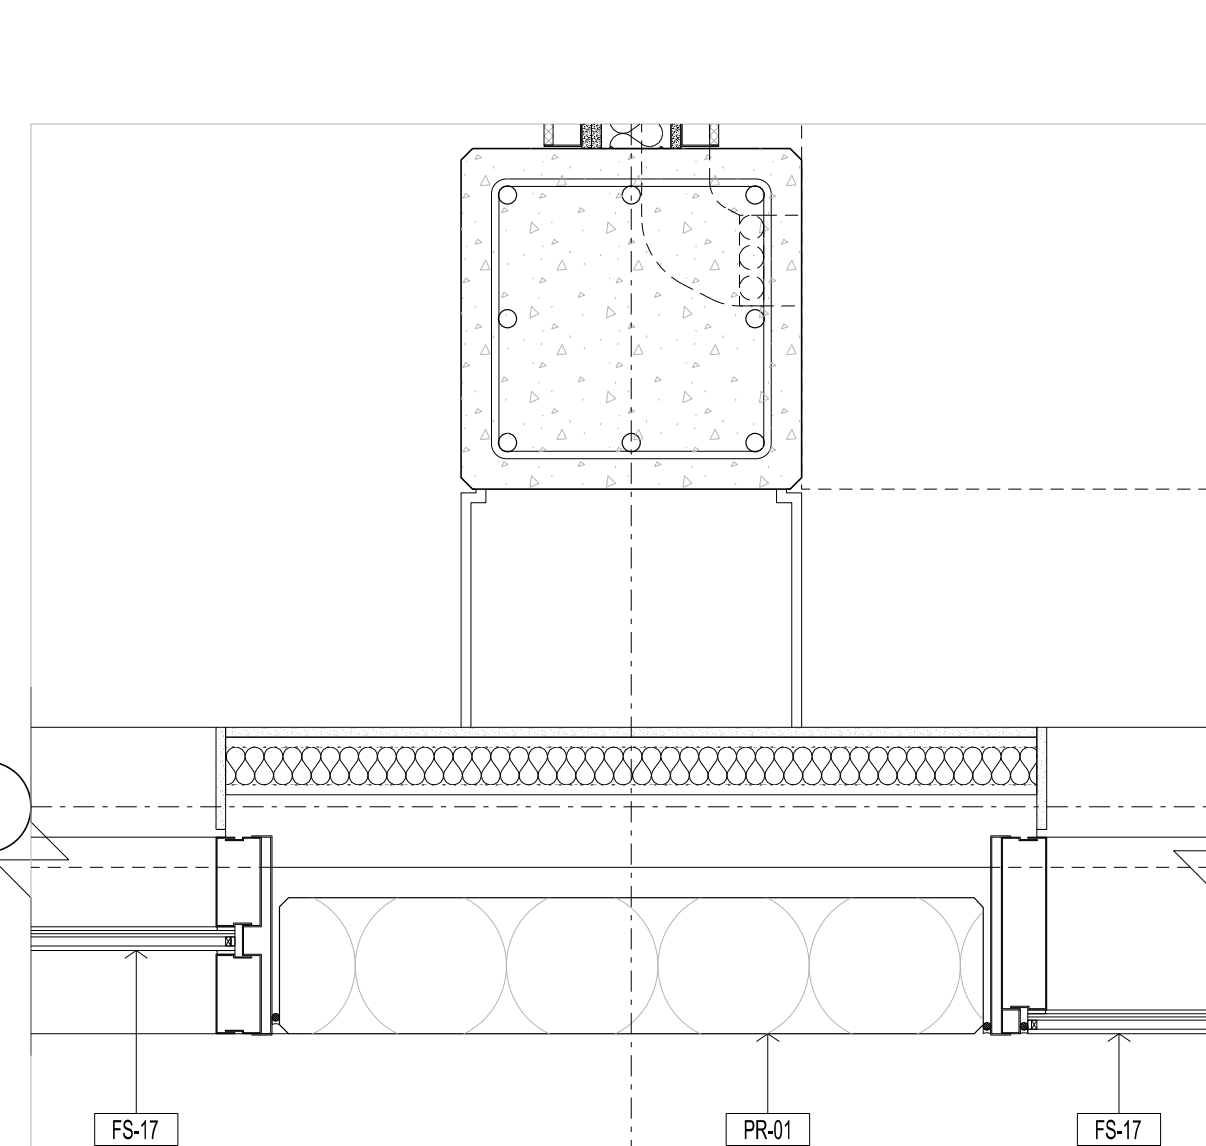


06 PLAN DETAIL - L02
1204 SCALE 1:10

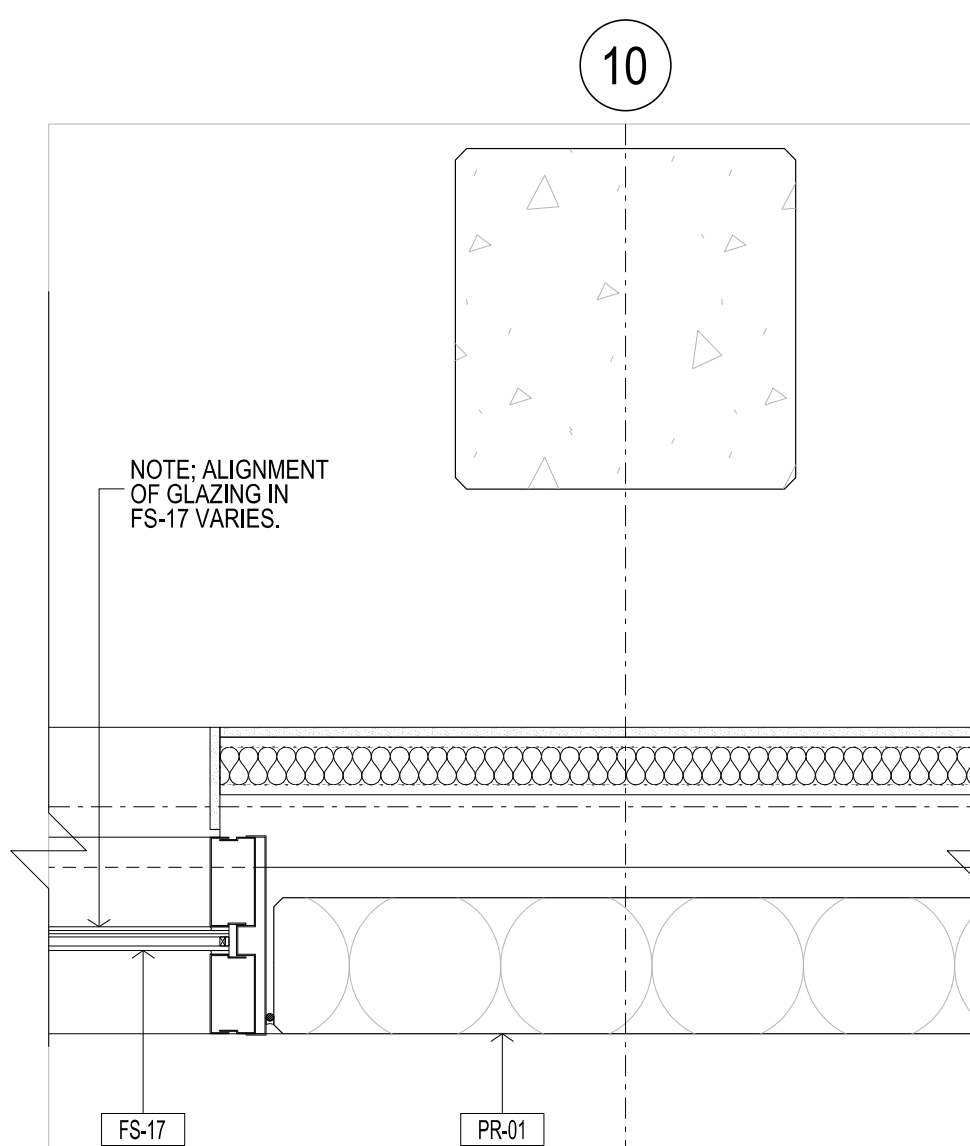


07 PLAN DETAIL - L02
1204 SCALE 1:10

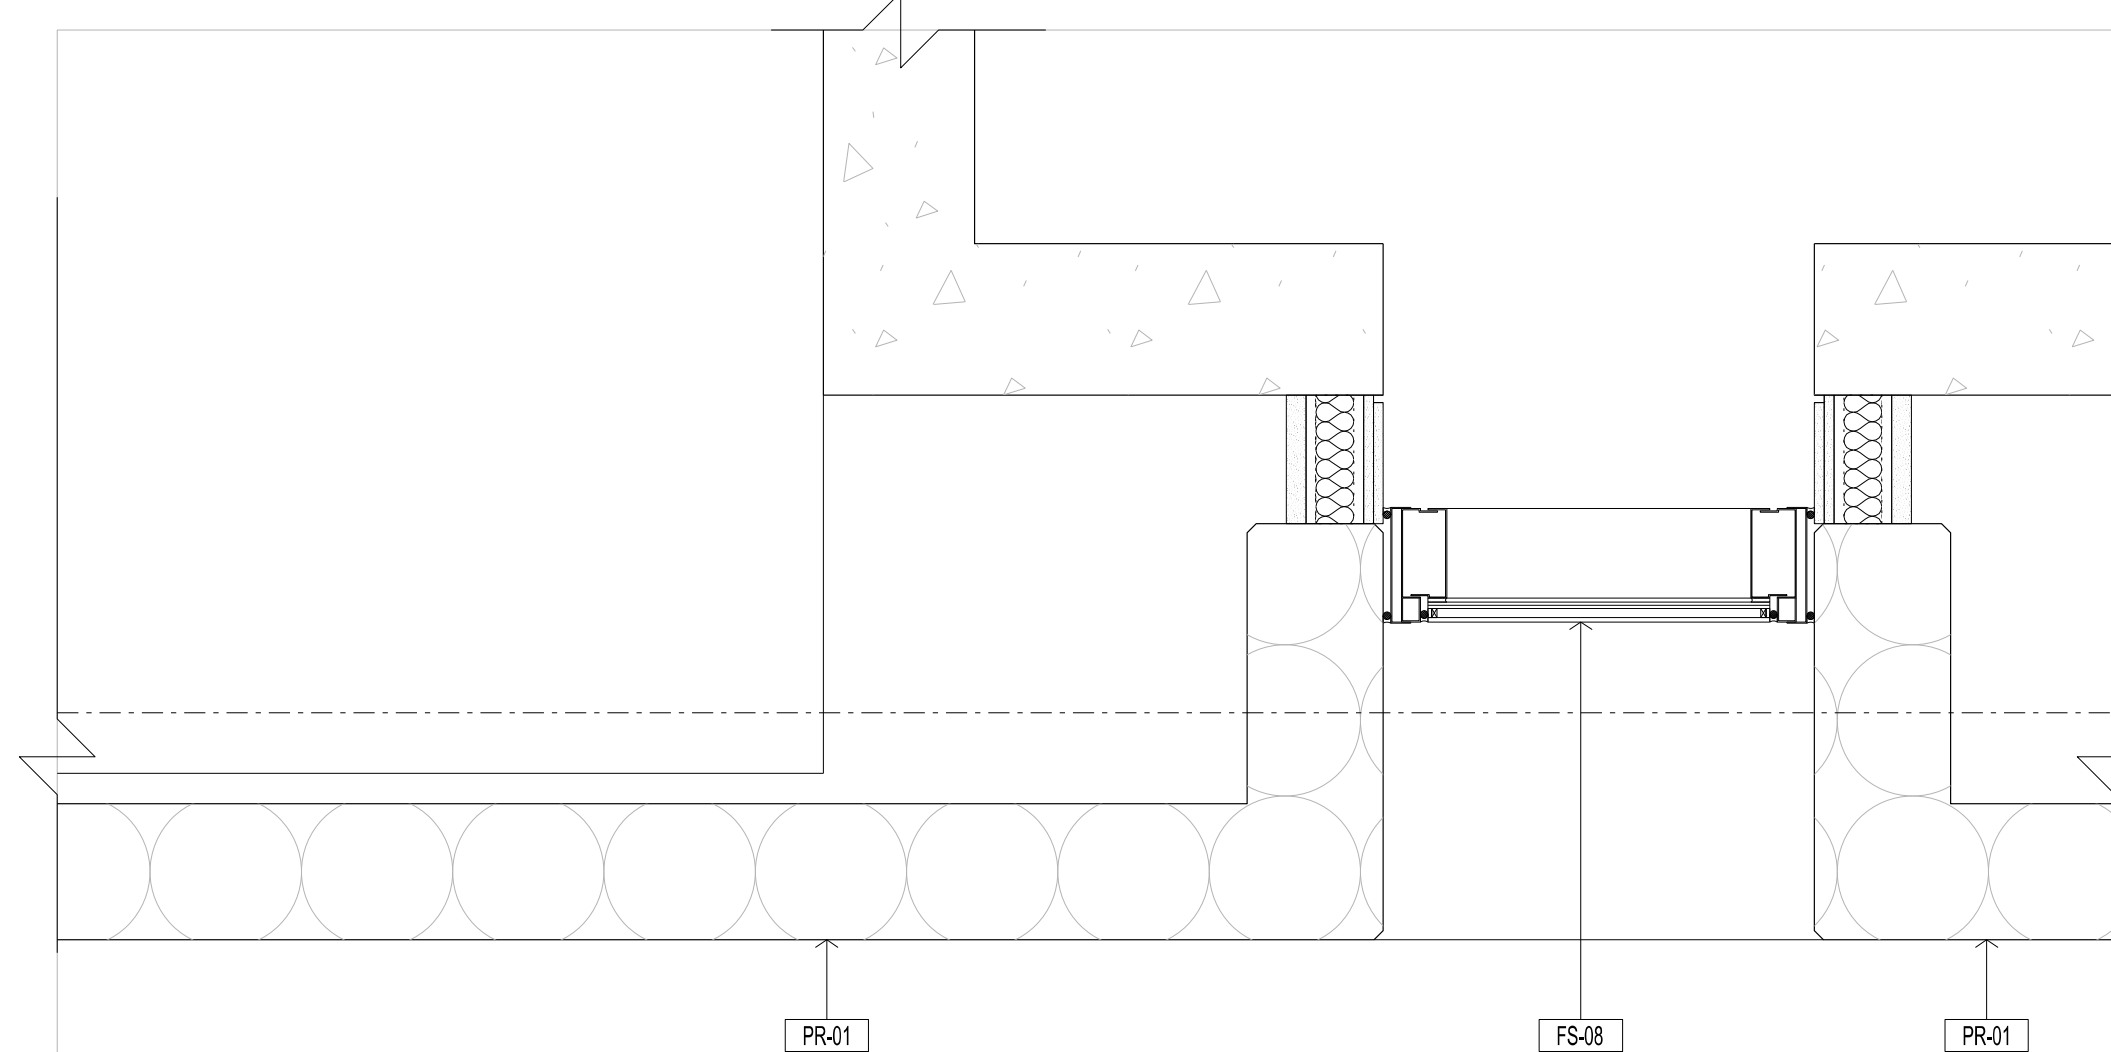

08 PLAN DETAIL - L02
1204 SCALE 1:10

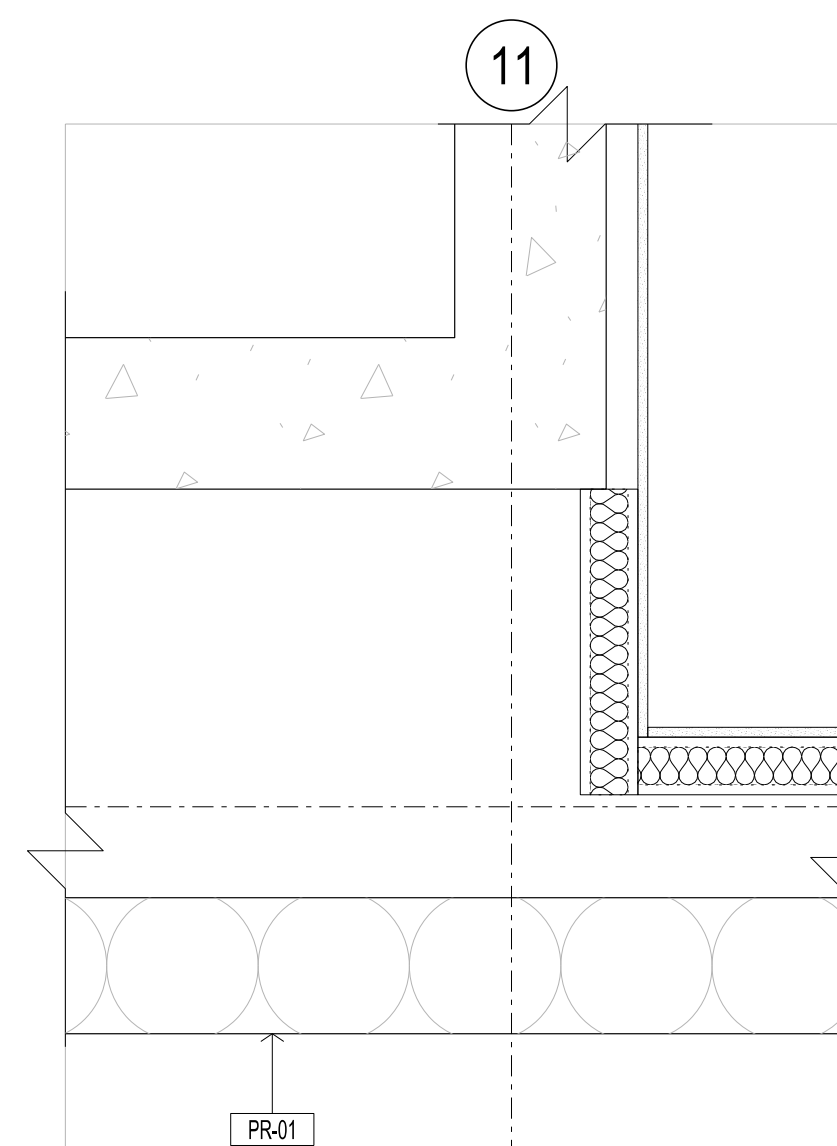

09 PLAN DETAIL - L02
1204 SCALE 1:10

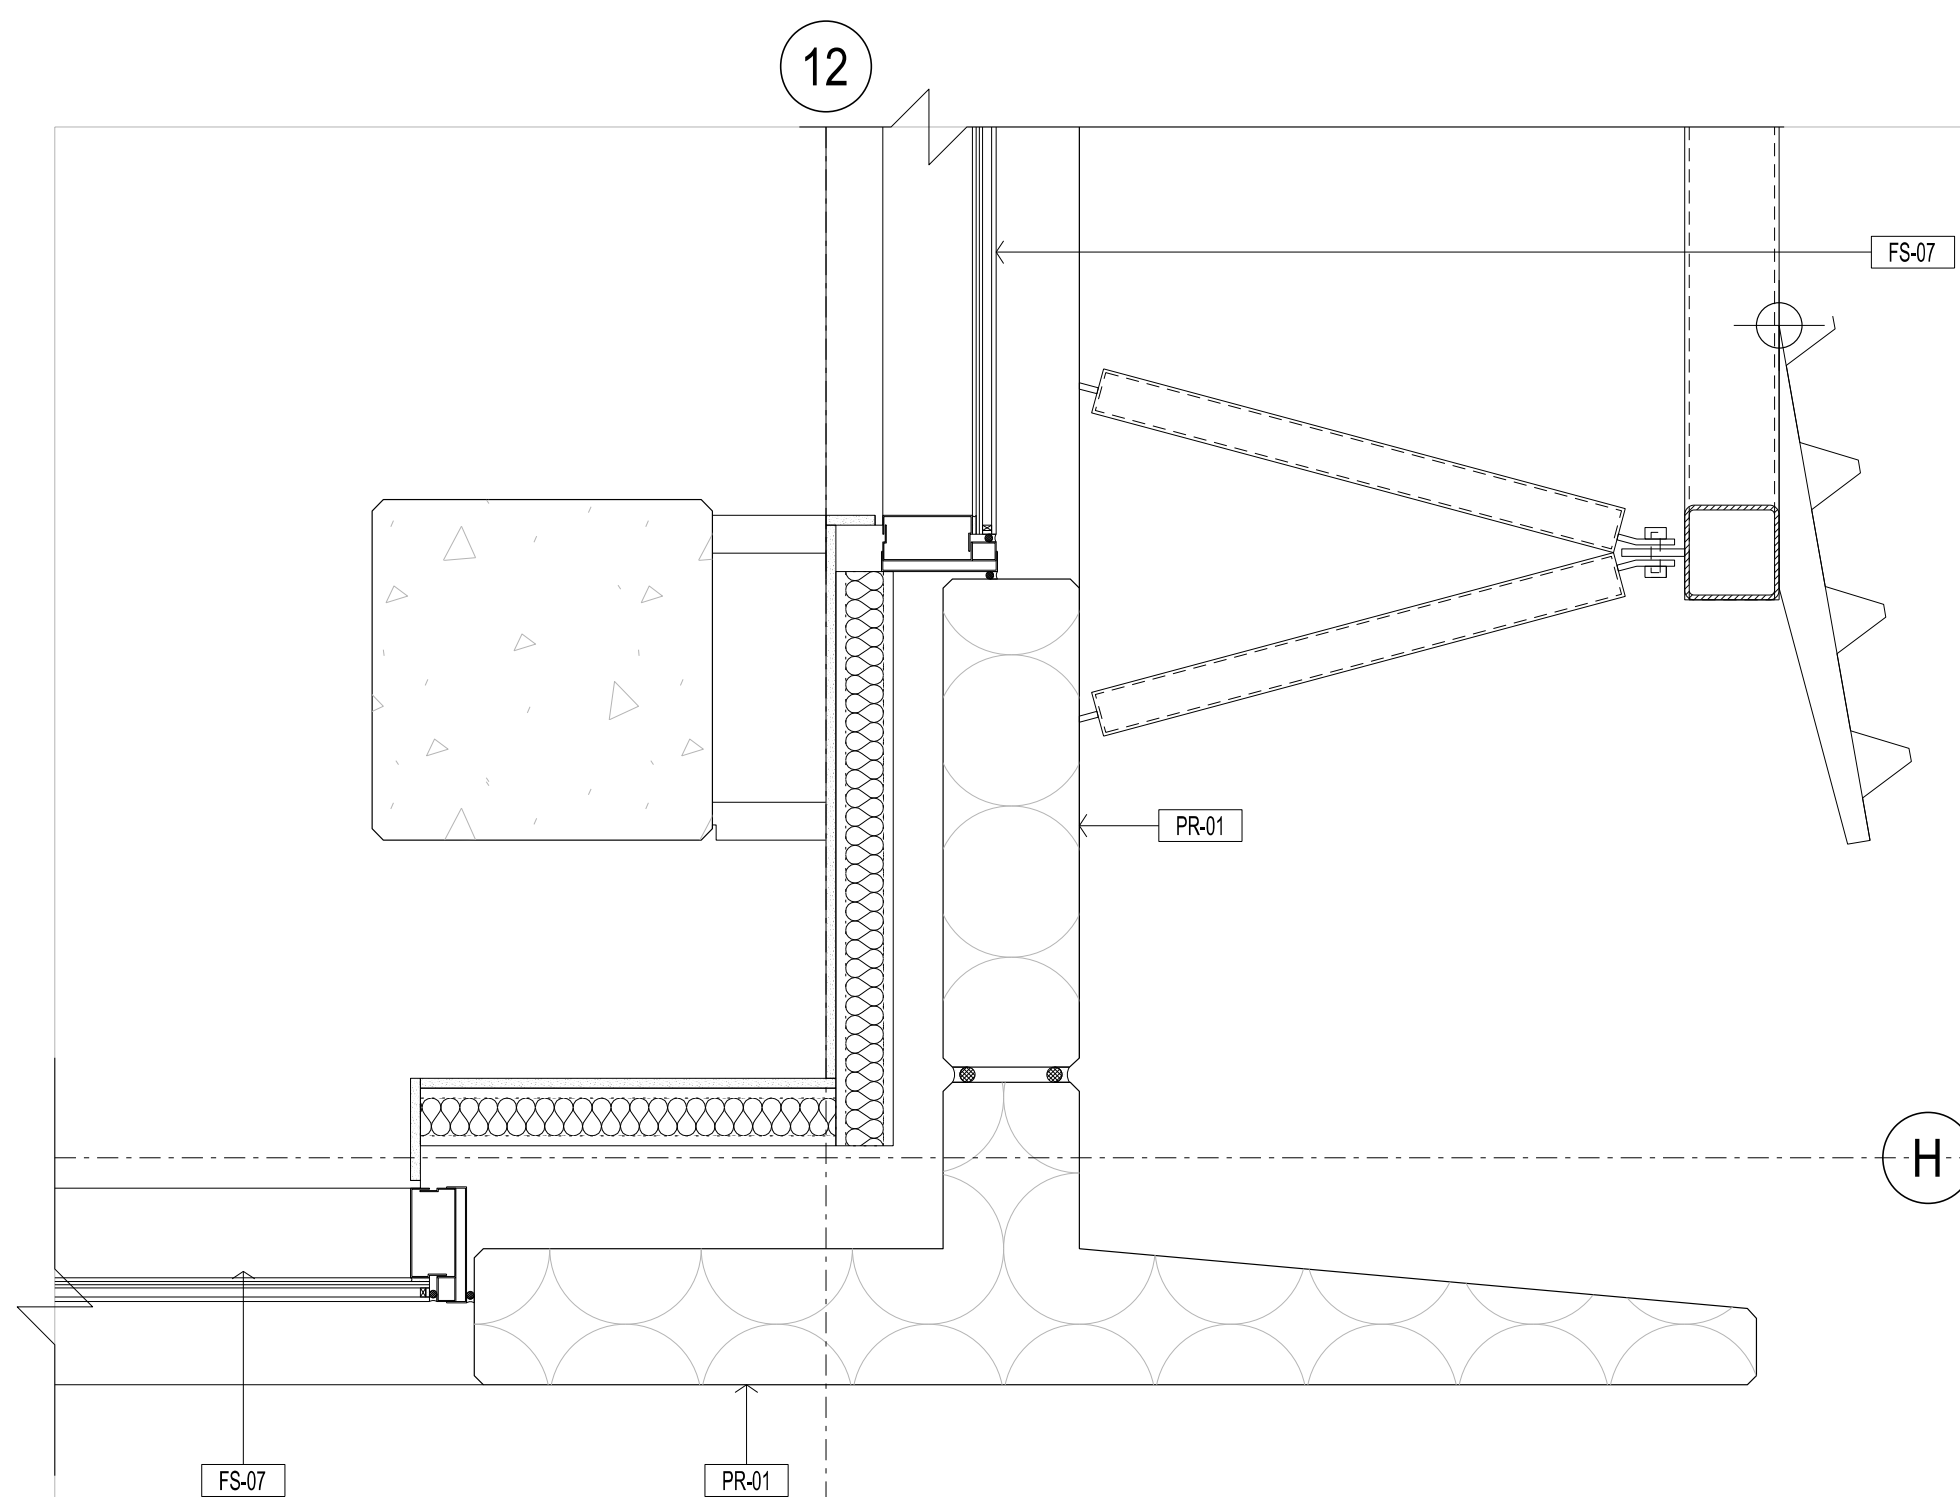

10 PLAN DETAIL - L02
1204 SCALE 1:10

Rev	Issue	Revision Description	And	Date
1	SG	PLASTERBOARD PACKAGE	-	18.09.13
2	SG	REFERENCE DWG CHANGE FROM 1503-1200'S	-	18.09.13
3	SG	TENDER ISSUE	-	16.04.13
4	SG	VALUE MANAGEMENT ISSUE	-	28.03.13
5	SG	PRECAST REVIEW	-	21.03.13
6	SG	100% CD - TENDER ISSUE	-	07.02.12
7	SG	90% CD ISSUE	-	10.02.12
8	SG	75% CD ISSUE	-	13.07.12
9	SG	55% CD ISSUE	-	08.05.12



NADAAA

NADAAA
1520 Washington Street No.2 Boston Massachusetts 02115 USA
Telephone +1 617 442 8232 Facsimile +1 688 442 1417 Email nad@nadaaa.com

John Wardle Architects

25 Rokeby Street, Collingwood, Victoria 3066 Australia
Tel: +61 3 8662 0400 www.johnwardlearchitects.com
© 2012 John Wardle Architects ABN 83 006 814 268

Client University of Melbourne Parkville Campus

Project Faculty of Architecture Building and Planning

Title PLAN DETAILS L02 - SHEET 1

Project No.	0913	Scale	1:10 @ A0 1:20 @ A2
Drawing No.	AR6008	Revision	A

Date: Dec 2011 Dwn - Co-Ord - Chk -

FILENAME - SFILES

FOR CONSTRUCTION