
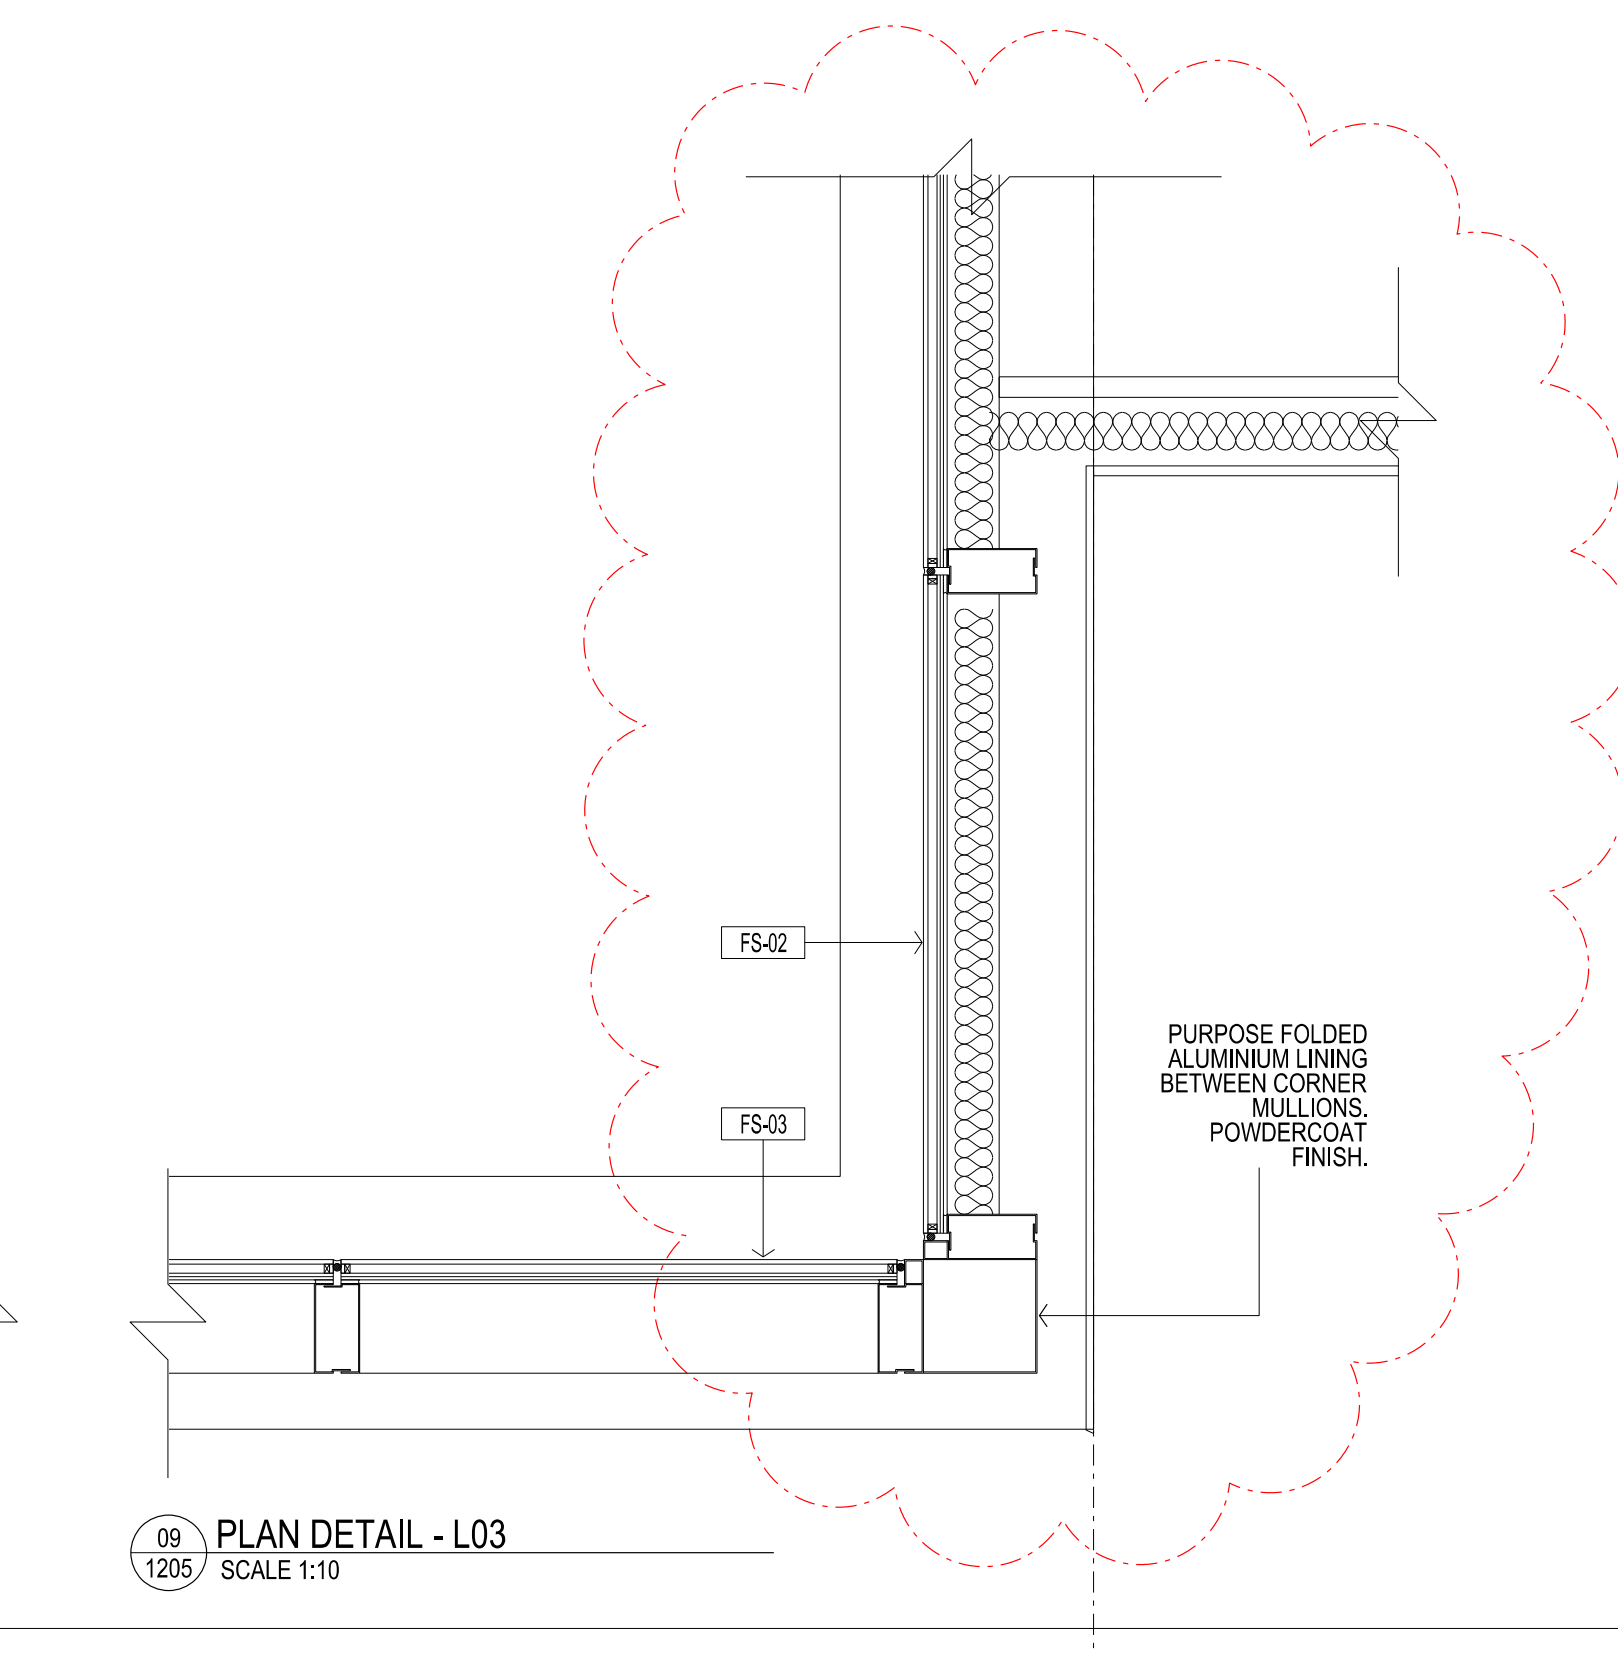
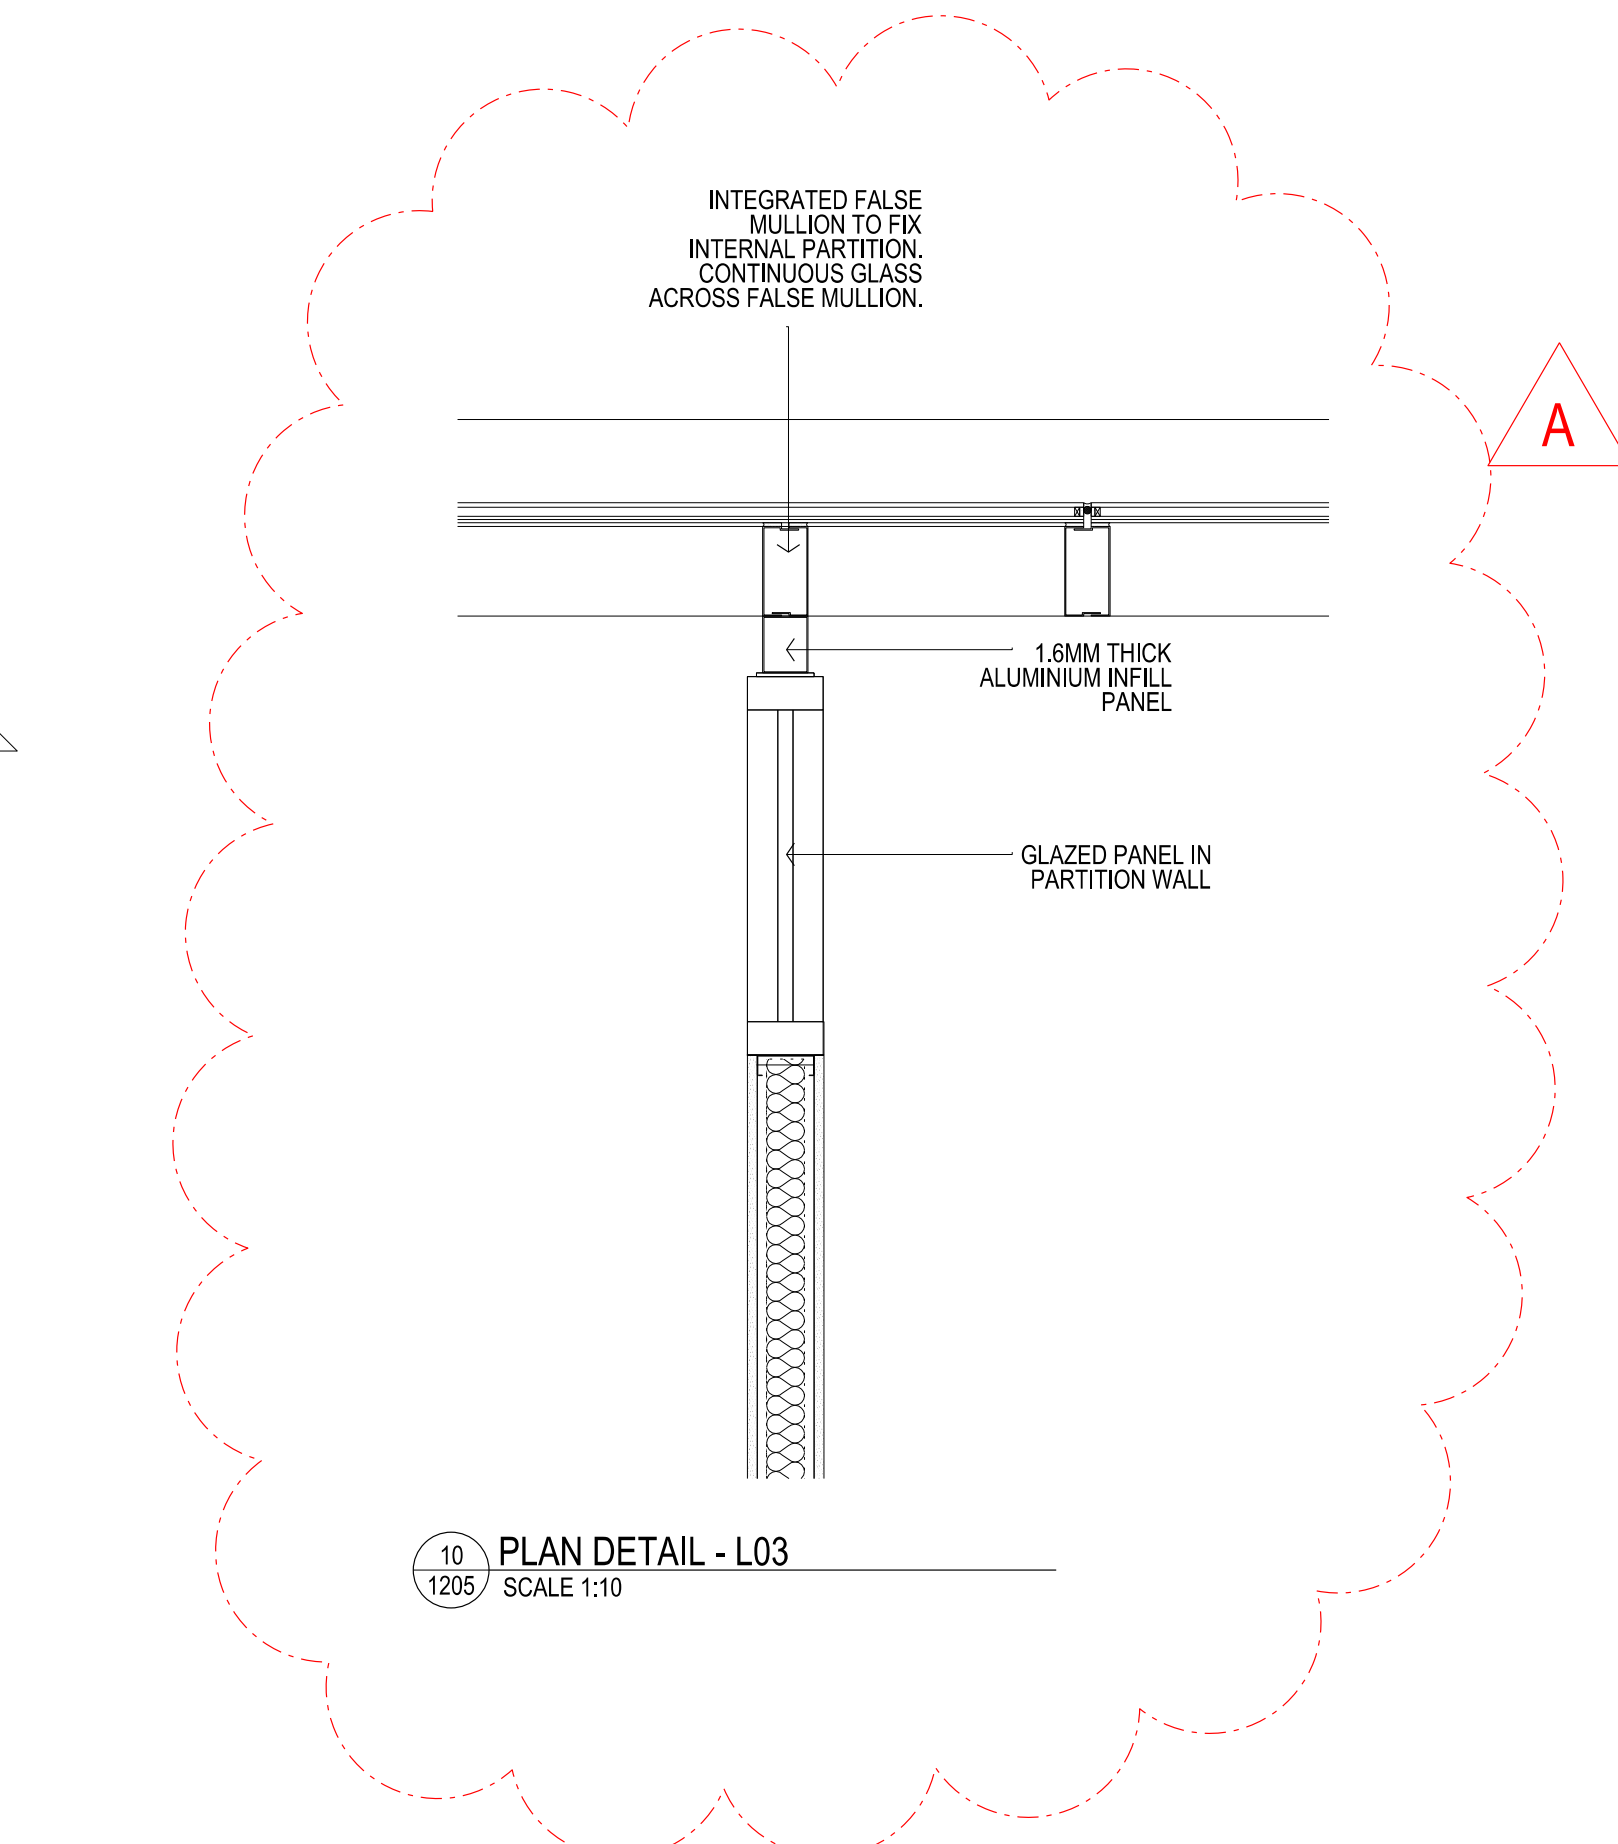
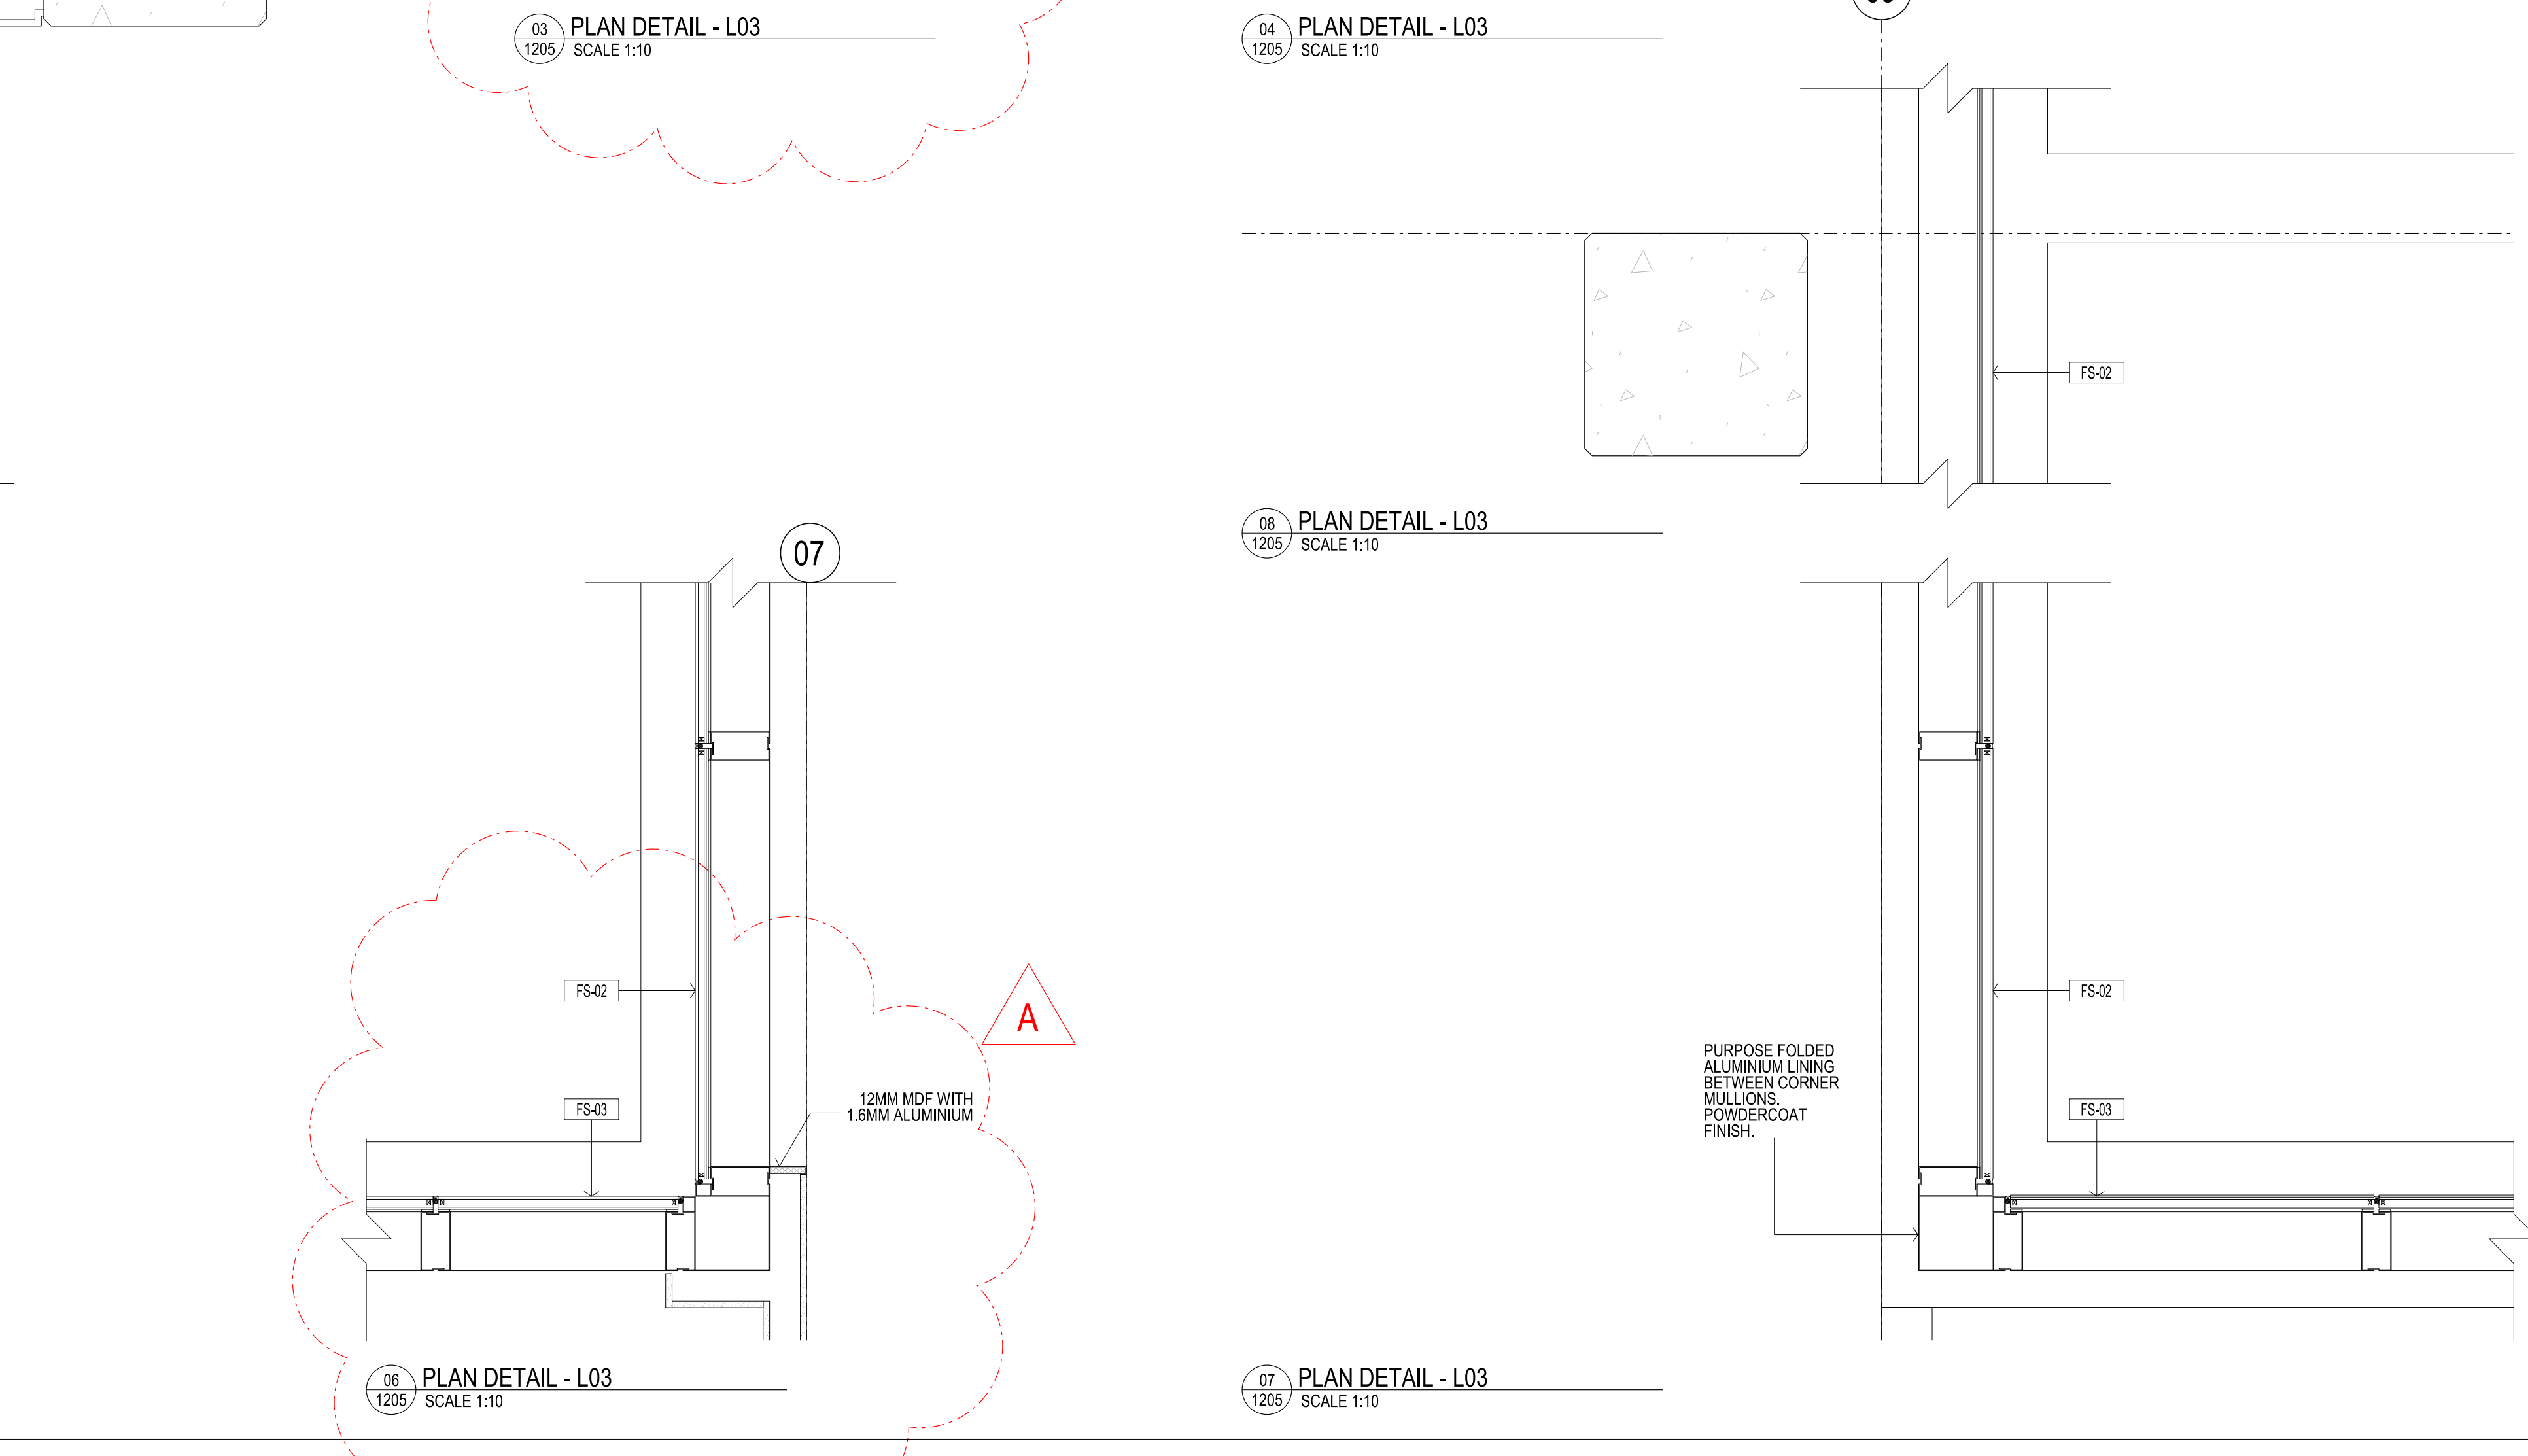
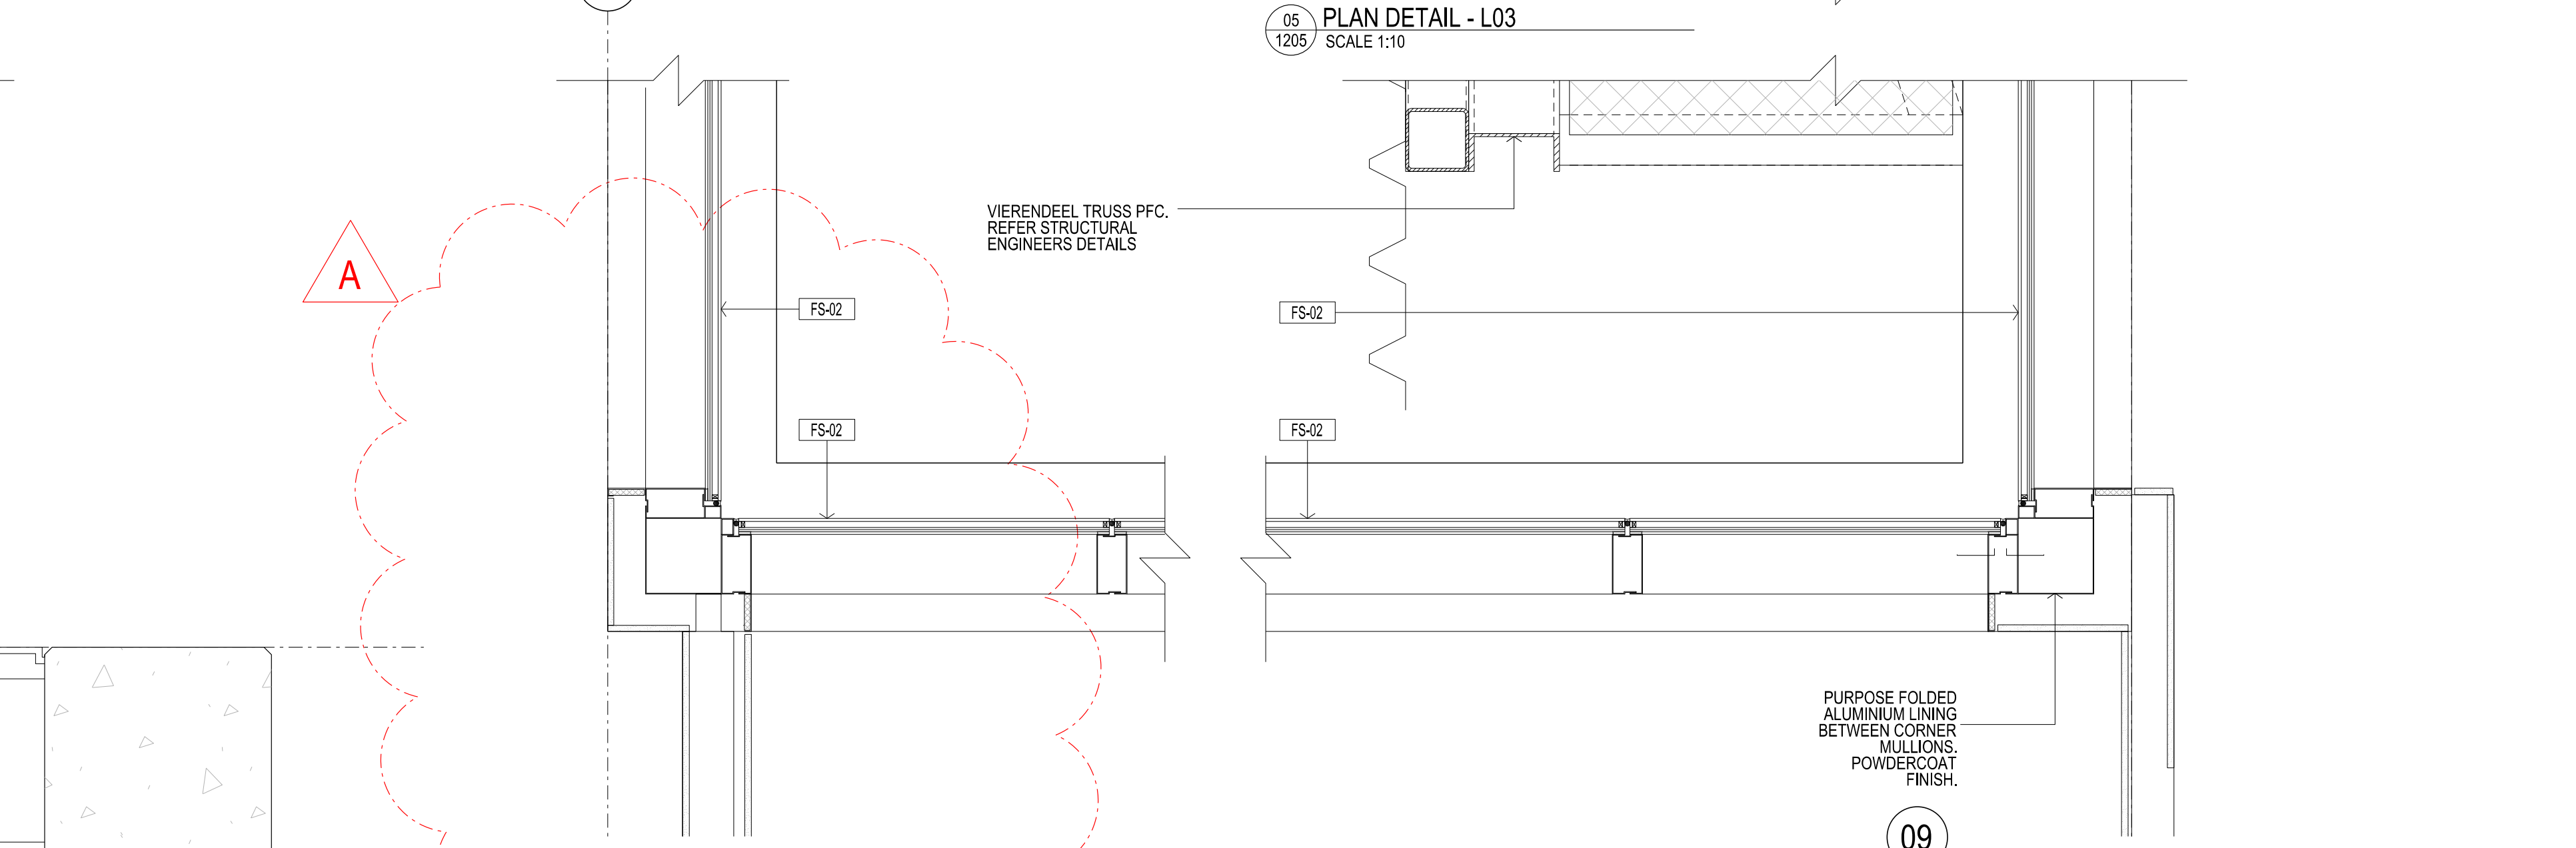
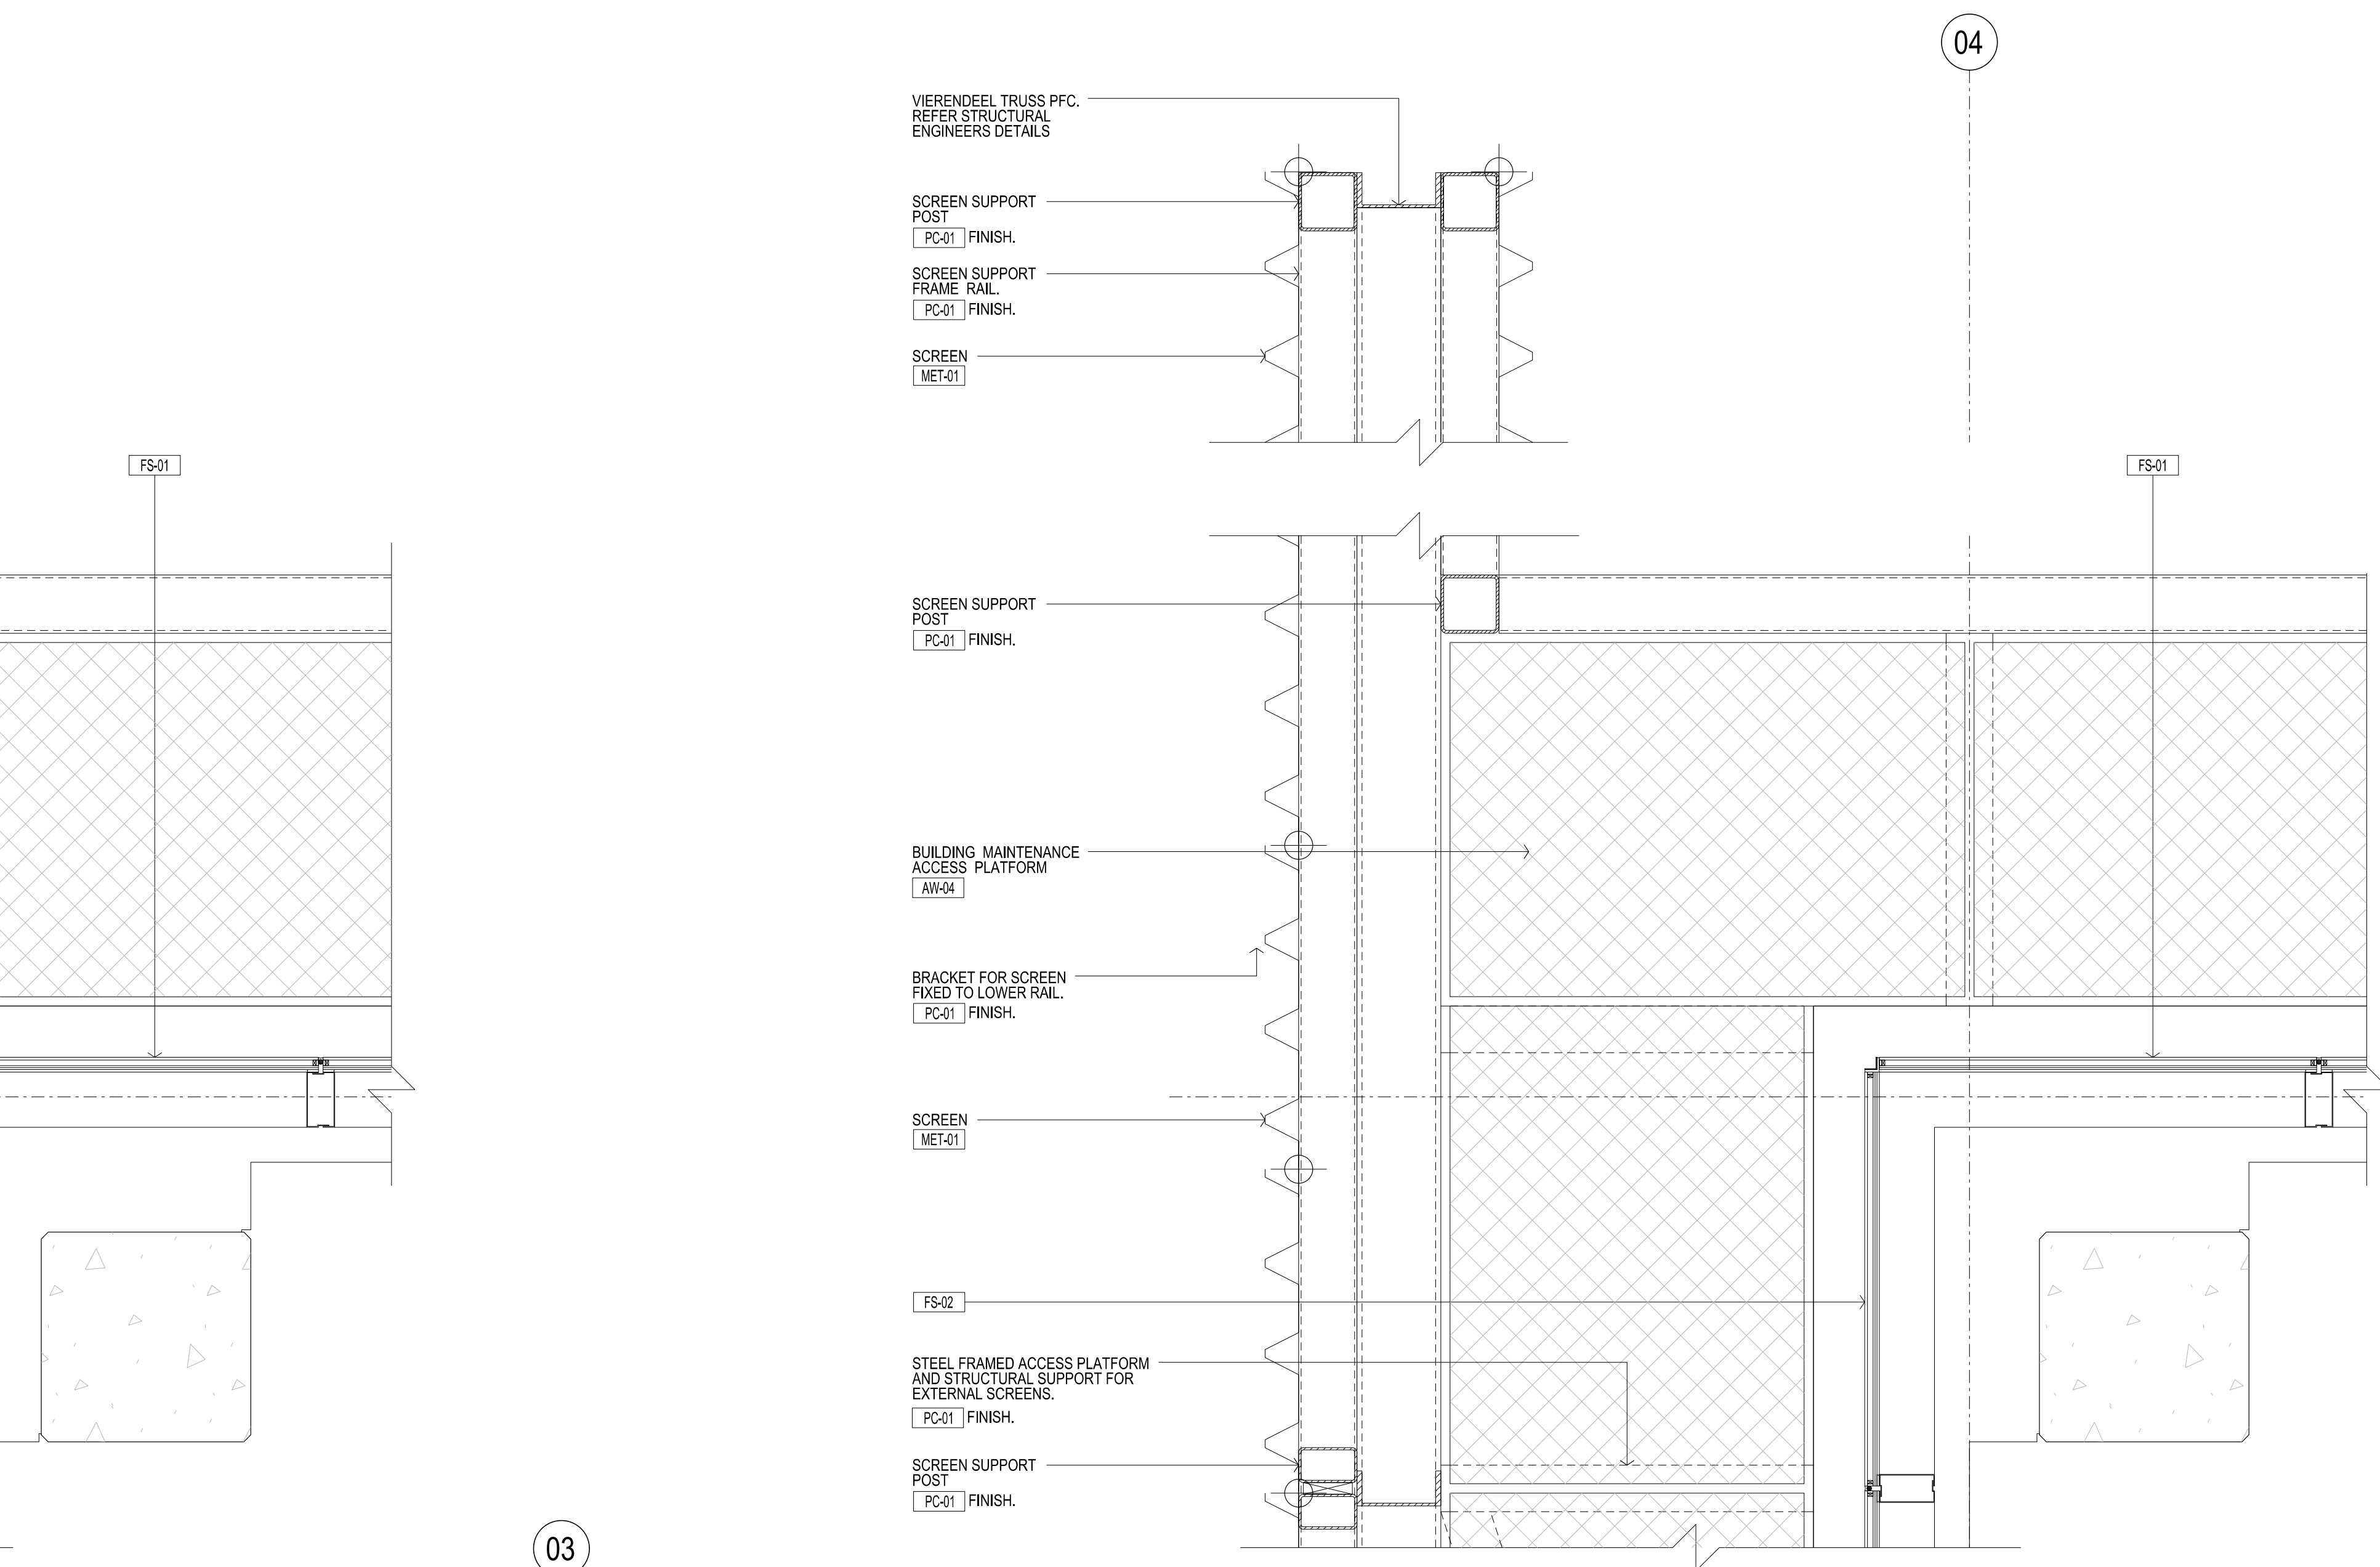
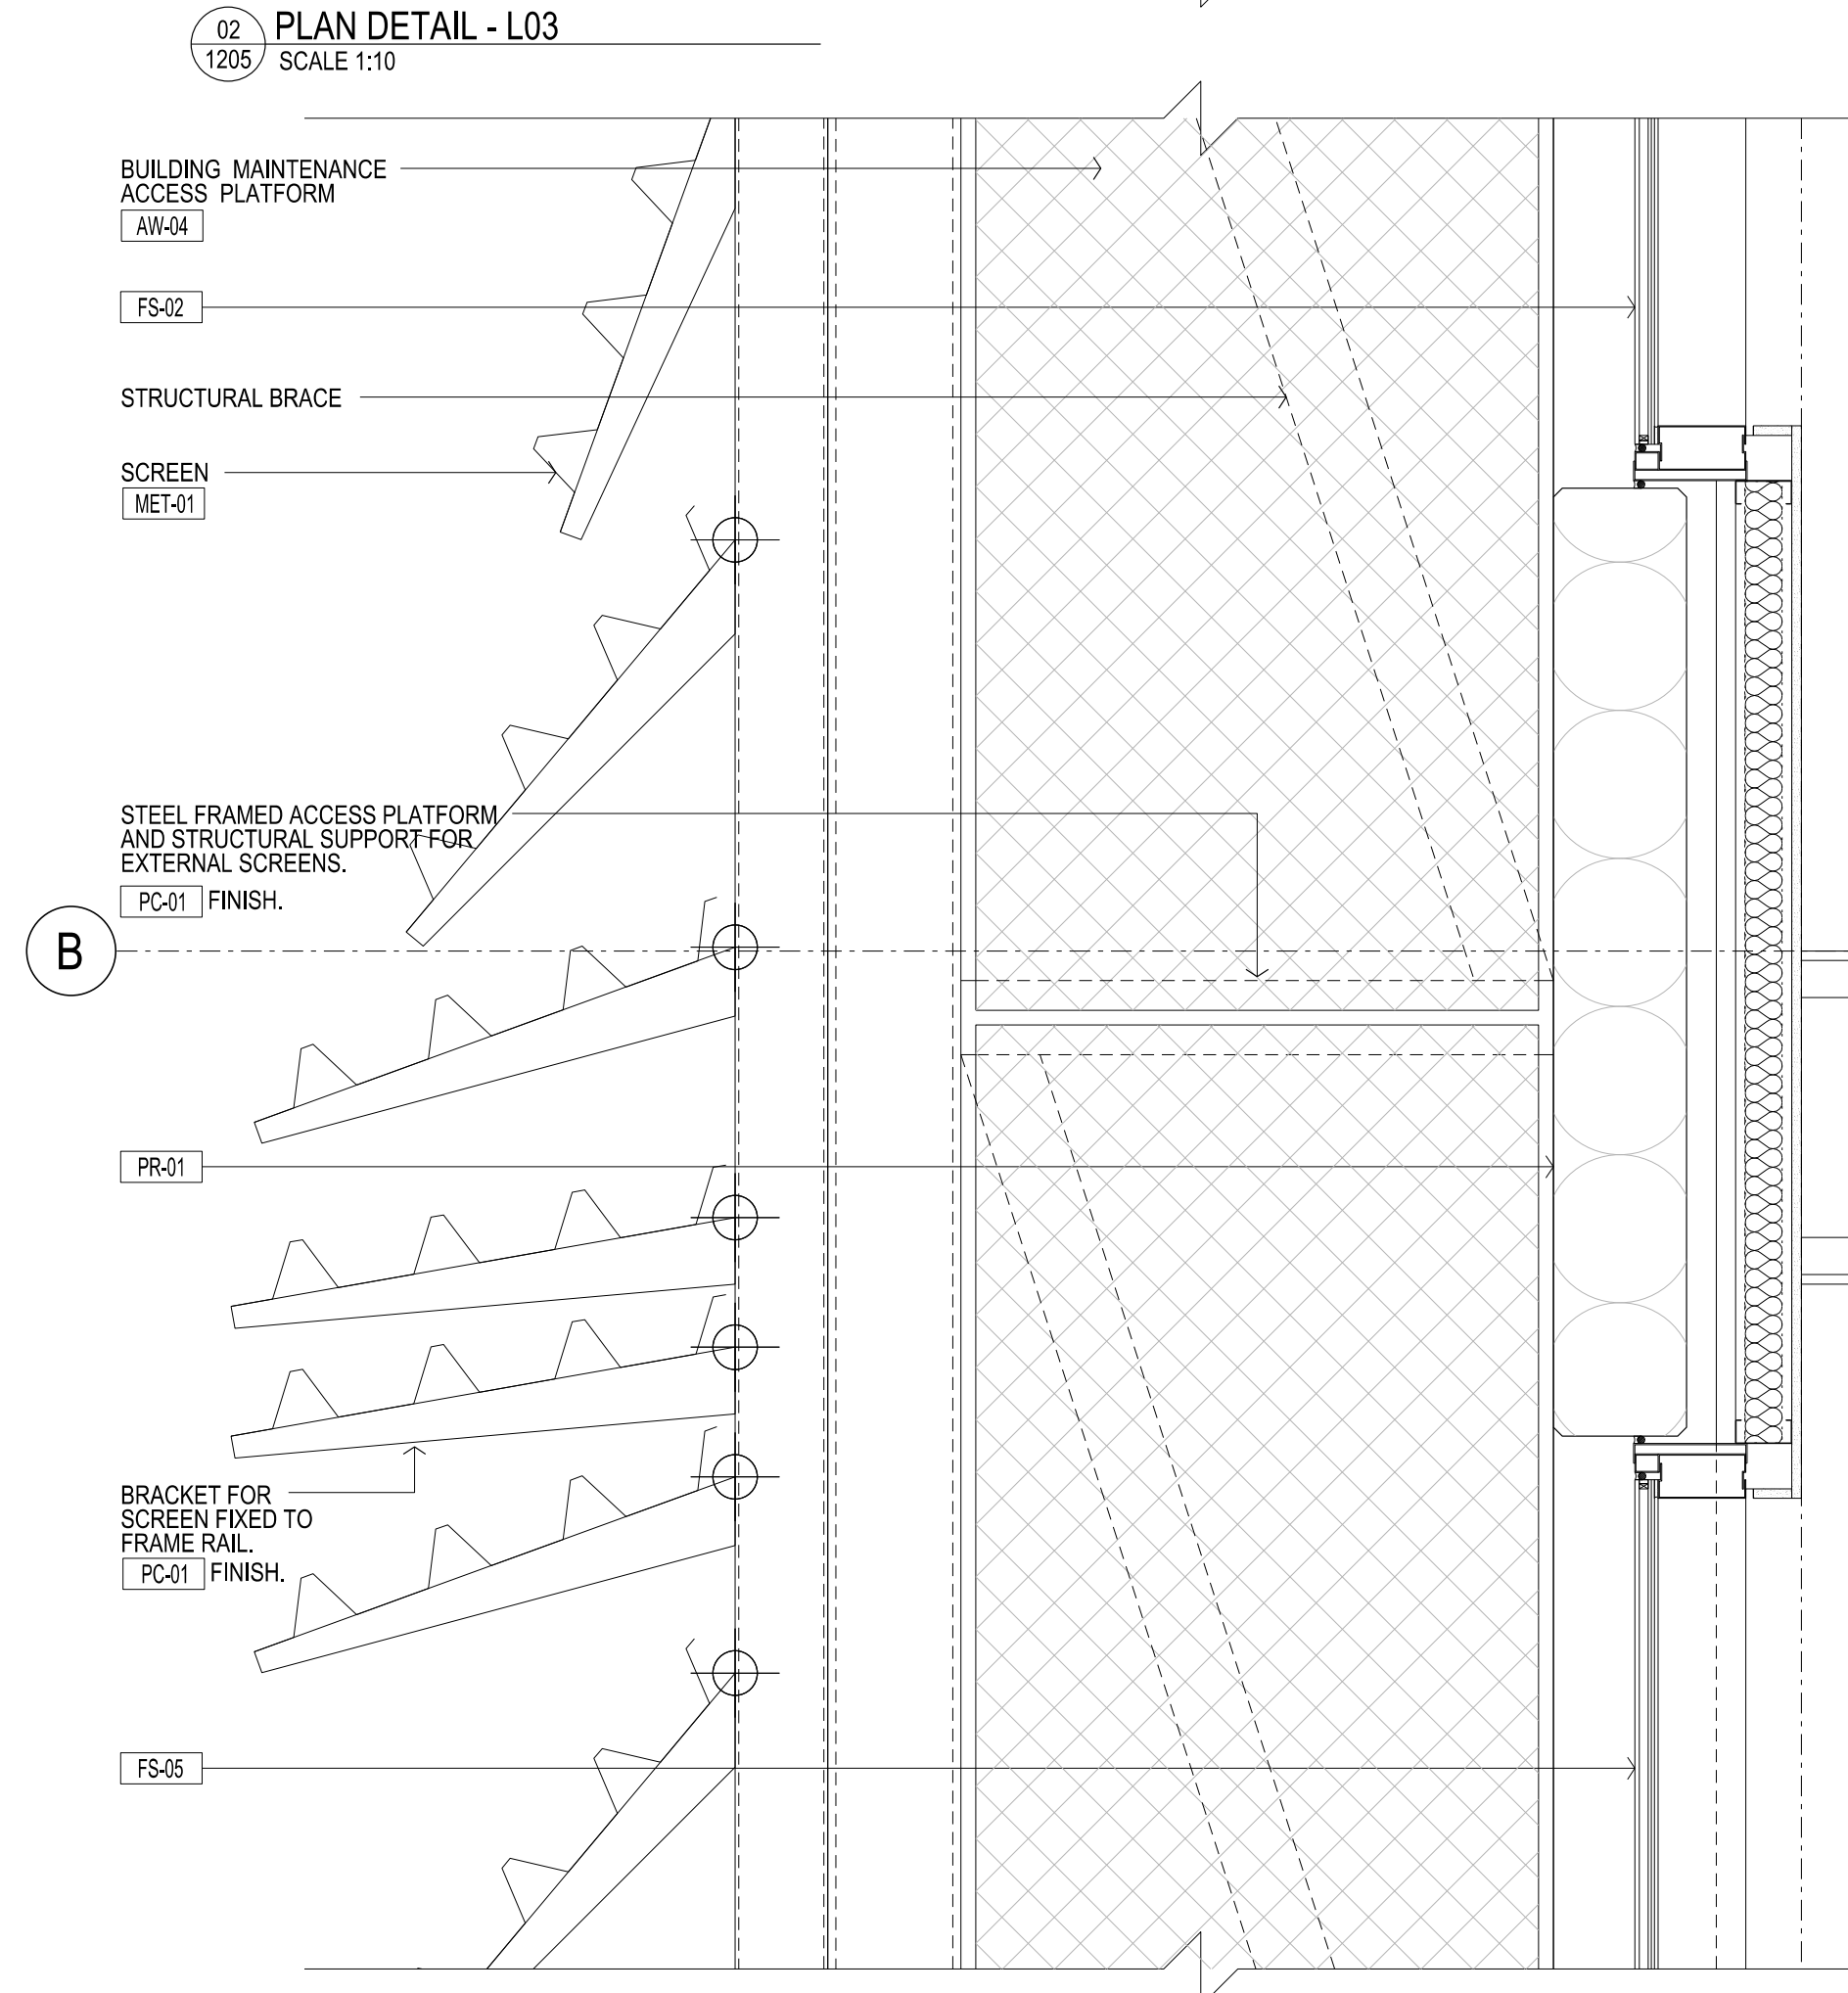


CONTRACTORS SHALL VERIFY JOB DIMENSIONS BEFORE ANY JOB COMMENCES. ALL SHOP DRAWINGS SHALL BE SUBMITTED TO THE SUPERINTENDENT AND MANUFACTURERS SHALL NOT COMMENCE PRIOR TO THE RETURN OF APPROVED SHOP DRAWINGS ISSUED BY THE CONSULTANT. FOUR-DIGIT DIMENSIONS SHALL TAKE PRECEDENCE OVER SCALED. THIS DRAWING SHALL BE USED IN CONJUNCTION WITH ALL RELATED CONTRACT SPECIFICATIONS AND DRAWINGS COPYRIGHT OF THIS DRAWING IS VESTED IN HANDLE.

General Notes

REFER ARCHITECTURAL DRAWINGS:

- FACADE SETOUT AR1502-AR1507
- PRECAST SETOUT AR1512-AR1517
- SCREEN SETOUT AR1502-AR1557
- SCREEN DETAILS AR6550-AR6554

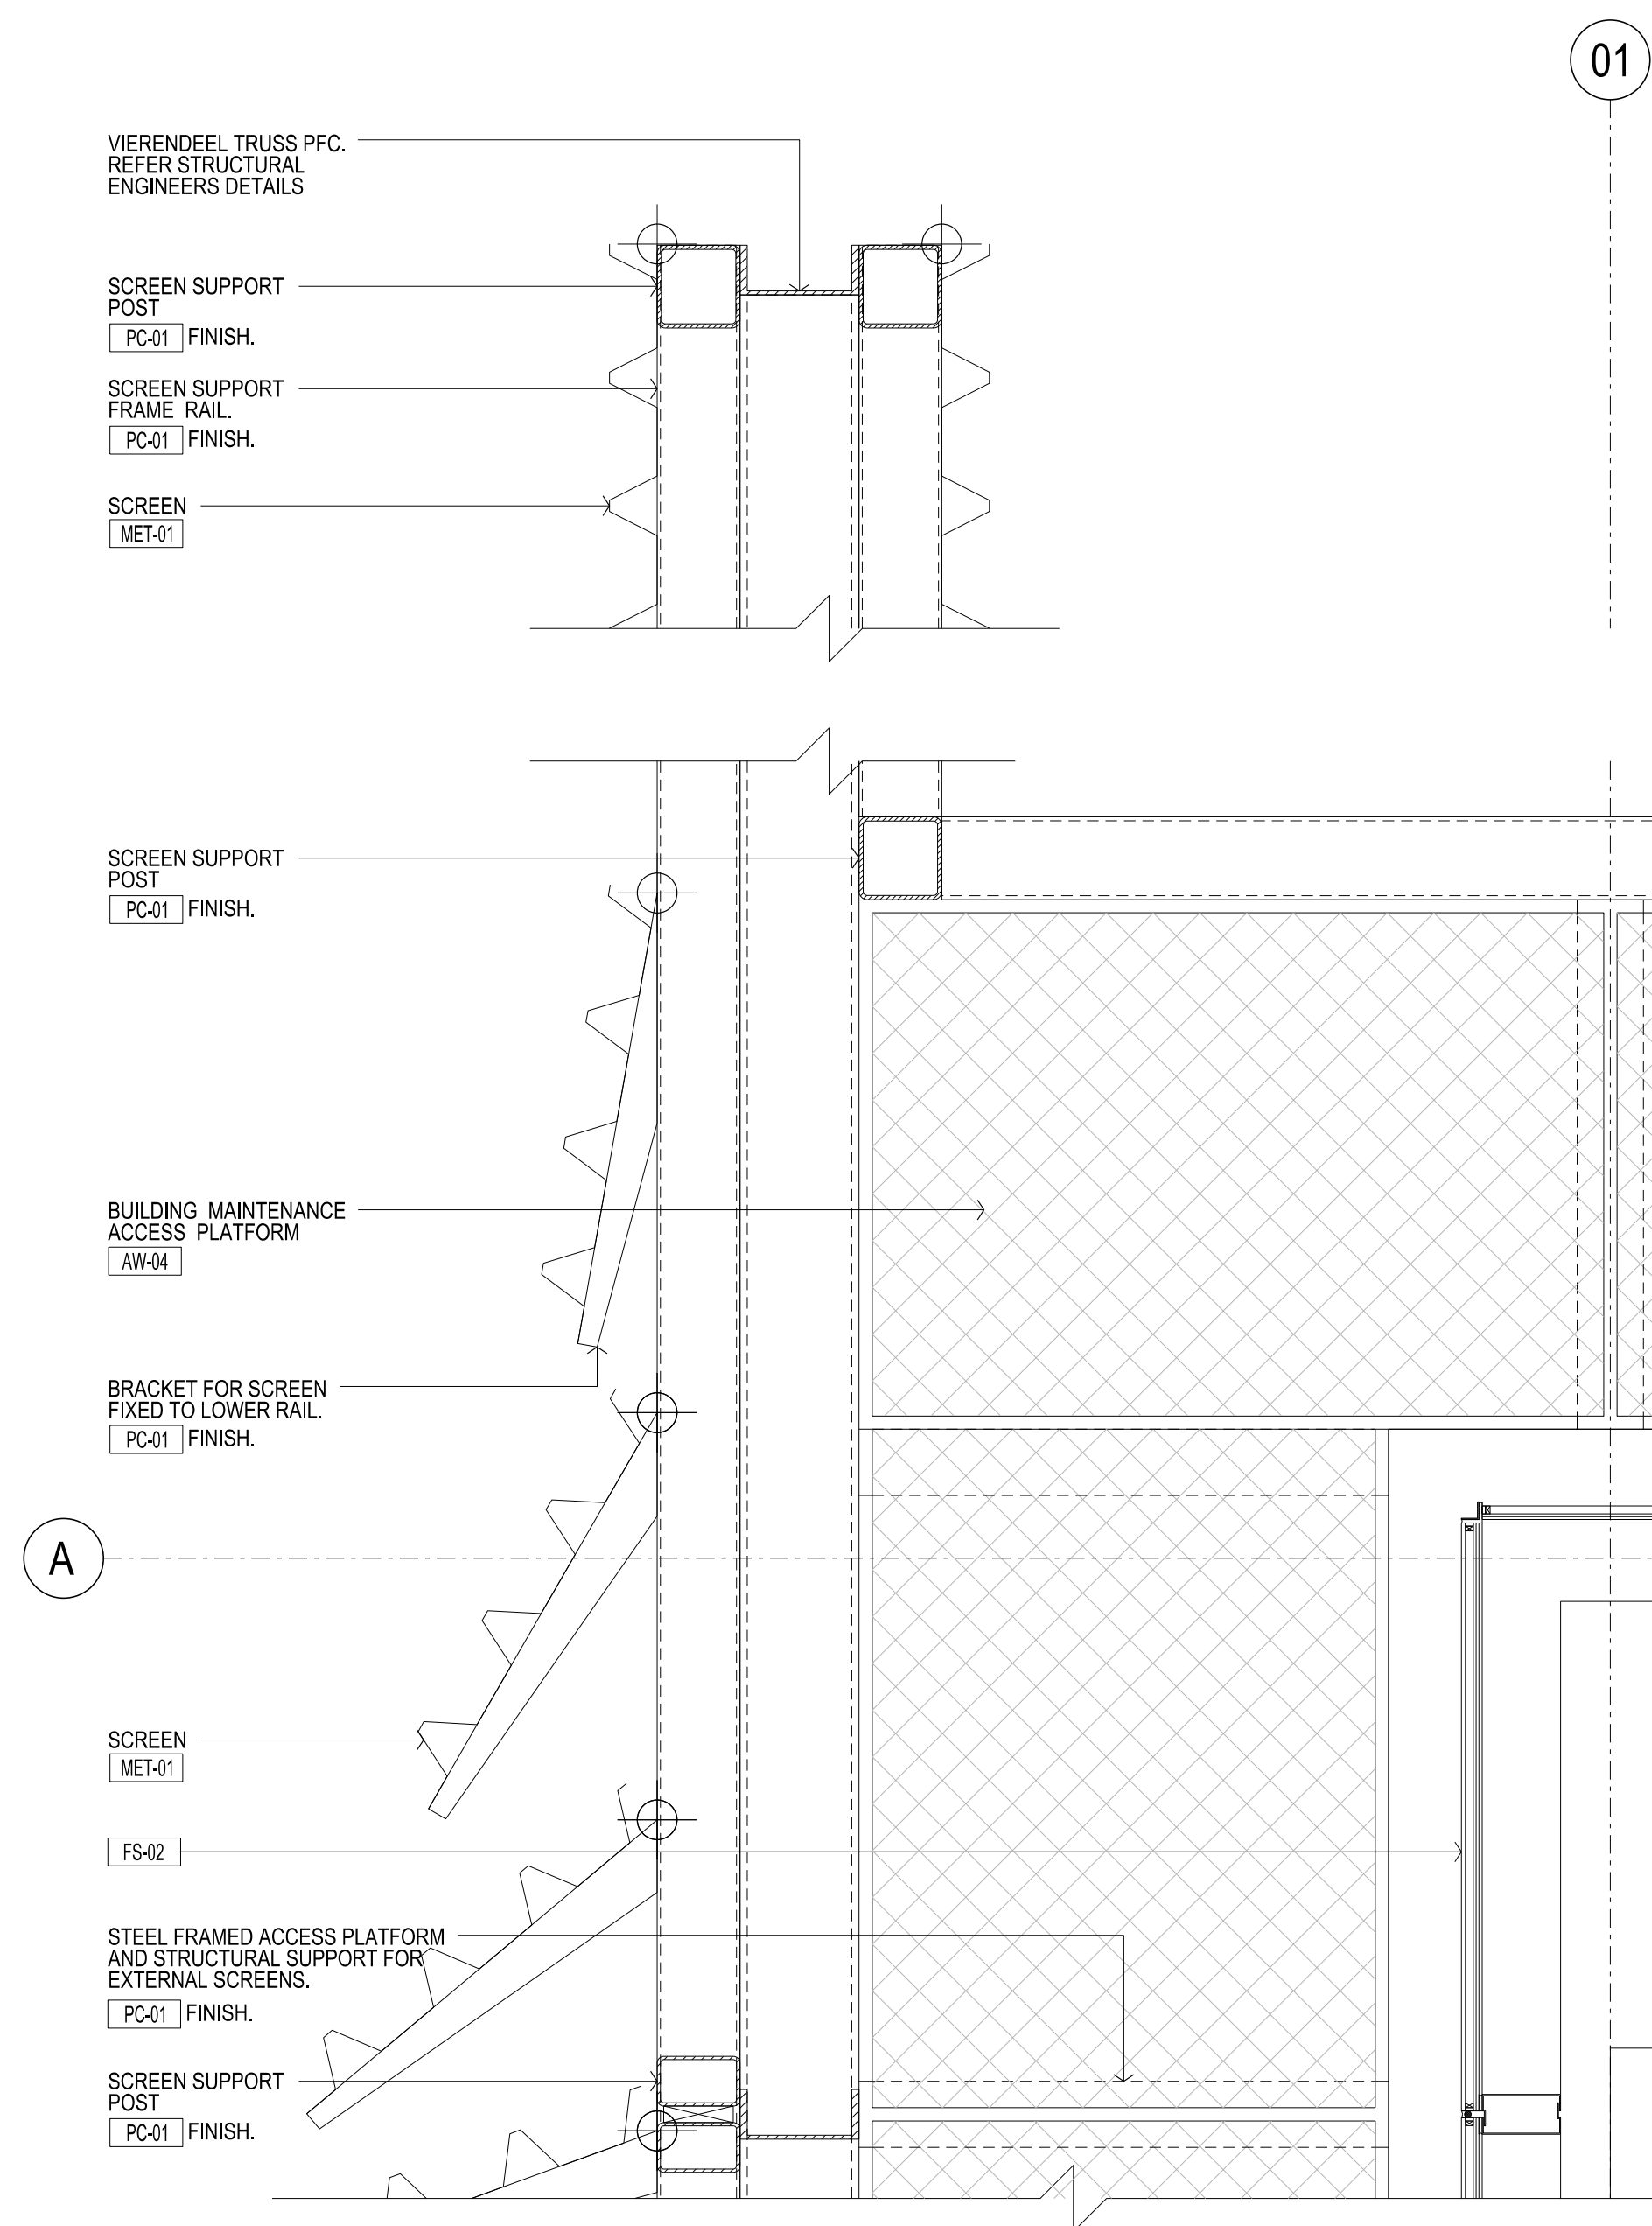

Rev	Issue	Revision Description	And	Date
A	SG	PLASTERBOARD PACKAGE	-	18.09.13
		REFERENCE DWG CHANGE FROM 1500-1200'S		
07	SG	TENDER ISSUE	-	16.04.13
06	SG	VALUE MANAGEMENT ISSUE	-	28.03.13
05	SG	PRECAST REVIEW	-	21.03.13
04	SG	100% CD - TENDER ISSUE	-	07.09.12
03	SG	90% CD ISSUE	-	10.08.12
02	SG	75% CD ISSUE	-	13.07.12
01	SG	55% CD ISSUE	-	08.06.12



**NADAAA**  
 NADAAA Telephone +1 517 442 8232  
 1520 Washington Street No.2 Facsimile +1 588 442 1417  
 Boston Massachusetts Email nad@nadaaa.com  
 02115 USA

**John Wardle Architects**  
 25 Rokeby Street, Collingwood, Victoria 3066 Australia  
 Tel: +61 3 8662 0400 www.johnwardlearchitects.com  
 © 2012 John Wardle Architects ABN 83 006 814 268

Client **University of Melbourne Parkville Campus**  
 Project **Faculty of Architecture Building and Planning**

Title **PLAN DETAILS L03 - SHEET 2**

Project No.	<b>0913</b>	Scale	1:10 @ A0 1:20 @ A2
Drawing No.	<b>AR6012</b>	Revision	<b>A</b>

Date: Dec 2011 Dwn - Co-Ord - Chk -

FILENAME - \$FILES  
**FOR CONSTRUCTION**