


04 PLAN DETAIL - L04 1206 SCALE 1:10

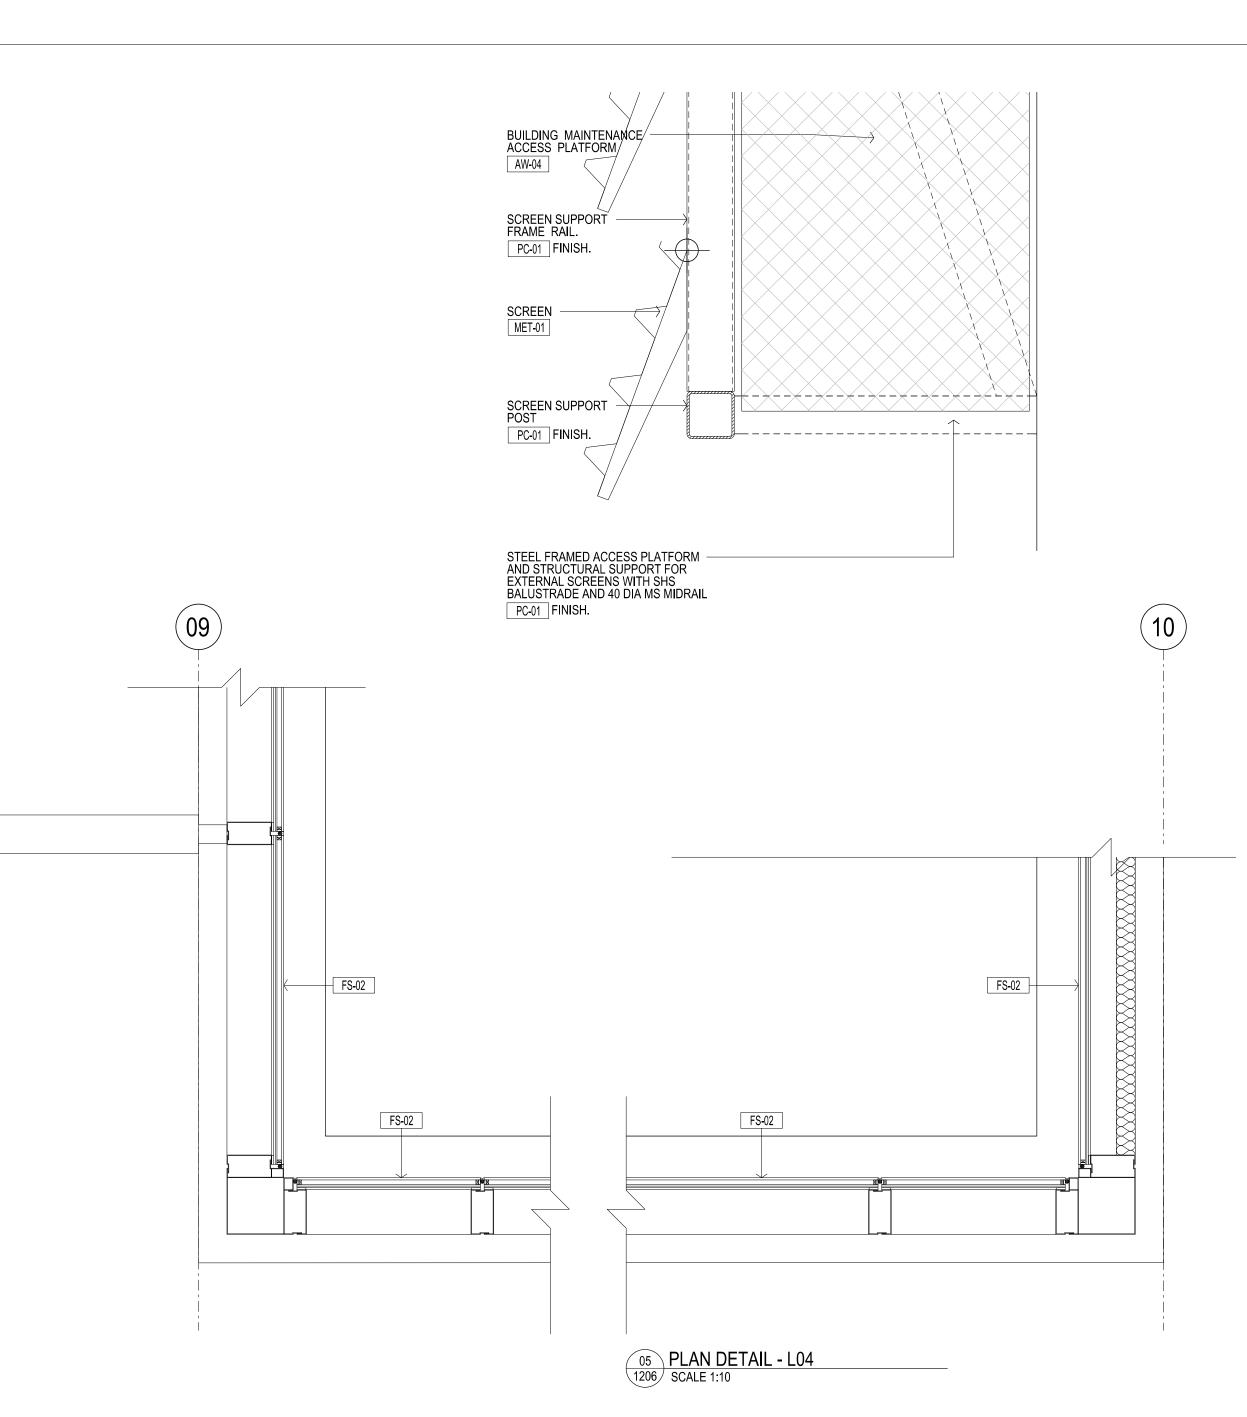

REFER A	ARCHITECT	URAL DRAW	INGS:			
FACADE	SETOUT	AR1502-AF	R1507			
SCREEN	SETOUT	AR1512-AF AR1552-AF AR6550-AF	R1557			
						40.00.40
A SG	PLASTE				_	180913
A SG 05 SG 04 SG	REFERE TENDER		HANGE FROM	1500-1200'S	-	18.09.13 16.04.13 07.09.12
05 SG	REFERE TENDER	NCE DWG C ISSUE - TENDER IS SSUE SSUE	HANGE FROM	1500-1200'S	-	16.04.13
05 SG 04 SG 03 SG 02 SG	REFERE TENDER 100% CD 90% CD 75% CD 50% CD	NCE DWG C ISSUE - TENDER IS SSUE SSUE	HANGE FROM	1500-1200'S	- - -	16.04.13 07.09.12 10.08.12 13.07.12
05 SG 04 SG 03 SG 02 SG 01 SG Rev Issue	REFERE TENDER 100% CD 90% CD I 75% CD I 50% CD I 8	NCE DWG C ISSUE - TENDER IS SSUE SSUE SSUE Description	HANGE FROM		- - - -	16.04.13 07.09.12 10.08.12 13.07.12 08.06.12
05 SG 04 SG 03 SG 02 SG 01 SG Rev Issue	REFERE TENDER 100% CD I 90% CD I 50% CD I 8 Revision	NCE DWG C ISSUE - TENDER IS SSUE SSUE SSUE Description	HANGE FROM		- - - -	16.04.13 07.09.12 10.08.12 13.07.12 08.06.12
05 SG 04 SG 03 SG 02 SG 01 SG Rev Issue	REFERE TENDER 100% CD I 90% CD I 50% CD I 8 Revision	NCE DWG C ISSUE - TENDER IS SSUE SSUE SSUE Description	HANGE FROM SSUE		- - - -	16.04.13 07.09.12 10.08.12 13.07.12 08.06.12
05 SG 04 SG 03 SG 02 SG 01 SG Rev Issue	REFERE TENDER 100% CD I 90% CD I 50% CD I 8 Revision	NCE DWG C ISSUE - TENDER IS SSUE SSUE SSUE Description	HANGE FROM SSUE		- - - -	16.04.13 07.09.12 10.08.12 13.07.12 08.06.12
05 SG 04 SG 03 SG 02 SG 01 SG Rev Issue B M	REFERE TENDER 100% CD I 90% CD I 50% CD I Revision	NCE DWG C ISSUE - TENDER IS SSUE SSUE SSUE Description	Ield Ield		- - - -	16.04.13 07.09.12 10.08.12 13.07.12 08.06.12
05 SG 04 SG 03 SG 02 SG 01 SG Rev Issue B M NAD/ 1920 Stree Bosto	REFERE TENDER 100% CD I 90% CD I 50% CD I Revision	NCE DWG C ISSUE - TENDER IS SSUE SSUE SSUE Description	HANGE FROM		- - - -	16.04.13 07.09.12 10.08.12 13.07.12 08.06.12
05 SG 04 SG 03 SG 02 SG 01 SG Rev Issue Bosto NAD/ 1920 Stree Bosto Mass	REFERE TENDER 100% CD I 90% CD I 50% CD I Revision	NCE DWG C ISSUE - TENDER IS SSUE SSUE SSUE Description	HANGE FROM		- - - -	16.04.13 07.09.12 10.08.12 13.07.12 08.06.12
05 SG 04 SG 03 SG 02 SG 01 SG Rev Issue Bosto NAD/ 1920 Stree Bosto Mass	REFERE TENDER 100% CD I 90% CD I 50% CD I Revision	NCE DWG C ISSUE - TENDER IS SSUE SSUE SSUE Description	HANGE FROM	A	- - - - Amd	16.04.13 07.09.12 10.08.12 13.07.12 08.06.12 Date
05 SG 04 SG 03 SG 02 SG 01 SG Rev Issue Bosto NAD/ 1920 Stree Bosto Mass	REFERE TENDER 100% CD I 90% CD I 50% CD I Revision	NCE DWG C ISSUE - TENDER IS SSUE SSUE SSUE Description	HANGE FROM	A	- - - - Amd	16.04.13 07.09.12 10.08.12 13.07.12 08.06.12 Date
05 SG 04 SG 03 SG 02 SG 01 SG Rev Issue B B NAD, 1920 Stree Bosto Mass 0211	REFERE TENDER 100% CD I 90% CD I 50% CD I Revision Revision CONT AAA Washington th No.2 on achusetts 8 USA	NCE DWG C ISSUE SSUE SSUE SSUE Description	HANGE FROM	A Wa itec	- - - - Amd	16.04.13 07.09.12 10.08.12 13.07.12 08.06.12 Date
05 SG 04 SG 03 SG 02 SG 01 SG Rev Issue B NAD/ 1920 Stree Bosto MAD/ 1920 Stree Bosto Mass 0211 Stree Bosto Mass 0211	REFERE TENDER 100% CD I 90% CD I 50% CD I Revision Revision CONT AAA Washington th No.2 on achusetts 8 USA	NCE DWG C ISSUE - TENDER IS SSUE SSUE SSUE Description	HANGE FROM		- - - - Amd	16.04.13 07.09.12 10.08.12 13.07.12 08.06.12 Date
05 SG 04 SG 03 SG 02 SG 01 SG Rev Issue B B NAD, 1920 Stree Bosto Mass 0211 Client Ur	REFERE TENDER 100% CD I 90% CD I 50% CD I Revision Revision CONCONT Revision CONCONT Revision CONCONT Revision CONCONT Revision CONCONT Revision CONCONT Revision CONCONT Revision CONCONT Revision CONCONT Revision CONCONT Revision CONCONT Revision CONCONT CONCONT Revision CONCONT CONCONT Revision CONCONT CONCONT Revision CONCONT CONCONT Revision CONCONT CONT	NCE DWG C ISSUE ISSUE SSUE SSUE Description	HANGE FROM	A Wa itec	- - - - Amd	16.04.13 07.09.12 10.08.12 13.07.12 08.06.12 Date
05 SG 04 SG 03 SG 02 SG 01 SG Rev Issue B B NAD, 1920 Stree Bosto Mass 0211 Client Ur Project Fa	REFERE TENDER 100% CD I 90% CD I 50% CD I Revision Revision CONCONT Revision CONCONT Solution CONCONT Revision CONCONT Revision CONCONT Revision CONCONT Revision CONCONT Revision CONCONT CONT	NCE DWG C ISSUE ISSUE SSUE SSUE SSUE Description SCR ID I I I I I I I I I I I I I	HANGE FROM	A Wa itec	- - - - Amd	16.04.13 07.09.12 10.08.12 13.07.12 08.06.12 Date
05 SG 04 SG 03 SG 02 SG 01 SG Rev Issue B B M M M M M M M M M M M M M	REFERE TENDER 100% CD I 90% CD I 50% CD I Revision Revision CONTON Revision CONTON Rokeby S +61 3 866 12 John W Noversit rkville Culty C ilding	NCE DWG C ISSUE ISSUE SSUE SSUE SSUE Description ID I I I I I I I I I I I I I	HANGE FROM SSUE SSUE IEICA IIIIA SSUE IIIIA SSUE IIIIA SSUE IIIIA SSUE IIIIA SSUE IIIIA SSUE IIIIA SSUE IIIIA SSUE	A Wa itec	- - - - Amd	16.04.13 07.09.12 10.08.12 13.07.12 08.06.12 Date
05 SG 04 SG 03 SG 02 SG 01 SG Rev Issue B B M M M M M M M M M M M M M	REFERE TENDER 100% CD I 90% CD I 50% CD I Revision Revision CONT CONT CONT CONT CONT CONT CONT CONT	NCE DWG C ISSUE ISSUE SSUE SSUE SSUE Description SSUE Description Campu Arele +1 (Fac +1 (Fac) +1 (Fac +1 (Fac +1)	HANGE FROM SSUE SSUE IEICA IIIIA SSUE IIIIA SSUE IIIIA SSUE IIIIA SSUE IIIIA SSUE IIIIA SSUE IIIIA SSUE IIIIA SSUE	A Wa itec	- - - - - - - - - - - - - - - - - - -	16.04.13 07.09.12 10.08.12 13.07.12 08.06.12 Date
05 SG 04 SG 03 SG 02 SG 01 SG Rev Issue B B M M M M M M M M M M M M M	REFERE TENDER 100% CD I 90% CD I 50% CD I Revision Revision CONTON CONTON Revision CONTON CON	NCE DWG C ISSUE ISSUE SSUE SSUE SSUE Description ID I I I I I I I I I I I I I	HANGE FROM SSUE SSUE IEICA IIIIA SSUE IIIIA SSUE IIIIA SSUE IIIIA SSUE IIIIA SSUE IIIIA SSUE IIIIA SSUE IIIIA SSUE	ictoria 306 ohnwardlea ABN 83	- - - - Amd	16.04.13 07.09.12 10.08.12 13.07.12 08.06.12 Date Ile stralia cts.com 14 268